


- PLAN NOTES:**
- COORDINATE LOCATION OF FURNACE WITH GC.
 - NOTE NOT USED.
 - NOTE NOT USED.
 - NOTE NOT USED.
 - PROVIDE 7 DAY FULLY PROGRAMMABLE THERMOSTATS WITH SENSORS AS SHOWN ON PLAN. THERMOSTATS AND SENSORS MUST BE CAPABLE OF CONTROLLING ALL FUNCTIONALITY OF EQUIPMENT BEING CONTROLLED. MOUNT THERMOSTATS AT 48" AFF. PROVIDE LOW VOLTAGE CONTROL WIRING AND MAKE SYSTEM FULLY FUNCTIONAL.
 - DUCT UP TO ROOFTOP UNIT. COORDINATE DUCT PENETRATIONS WITH EXISTING OPENINGS. COORDINATE WITH STRUCTURAL REINFORCEMENTS.



**WATER LILY
LEARNING CENTER**
1808 CENTRAL PARKWAY
CINCINNATI, OH, 45214

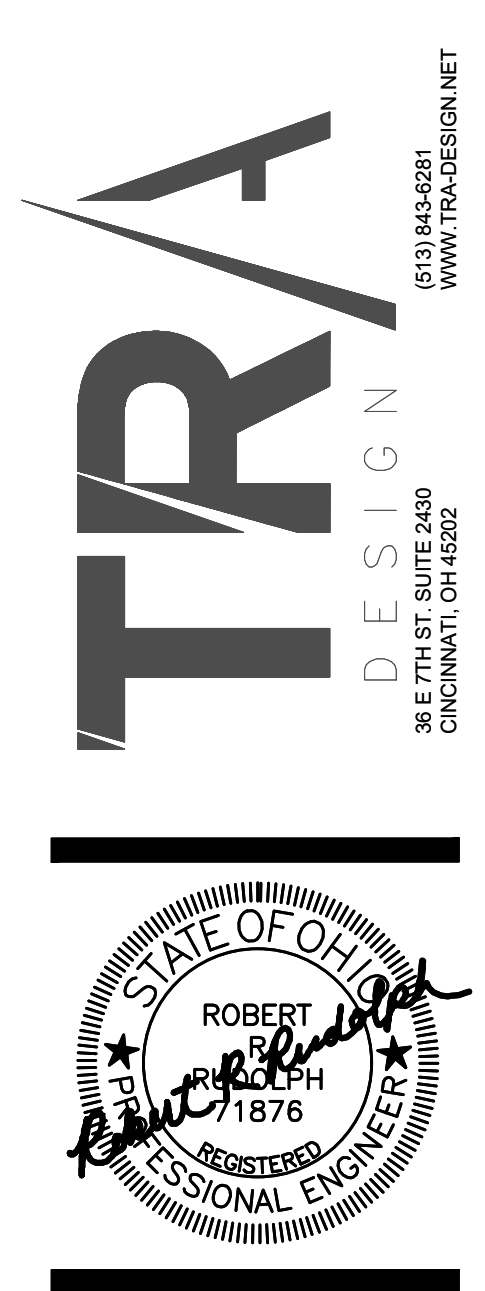

REVISIONS	
1	PLAN REVIEW RESPONSE 05/31/23
2	PLAN REVIEW RESPONSE 07/11/23
4	CONSTR. BULLETIN 04 02.12.24

DATE: 04.18.23
DRAWN BY: STAFF
SCALE: AS NOTED
JOB NO.: 23012



TITLE:
3RD FLOOR MECHANICAL
PLAN - A

SHEET NO:
M-1.31

CONTRACTOR NOTE


IT IS THE RESPONSIBILITY OF THE CONTRACTOR TO NOTIFY THE ARCHITECT, LANDLORD AND TENANT OF ANY DISCREPANCIES ENCOUNTERED ON THE PLANS OR IN EXISTING SITE CONDITIONS PRIOR TO SUBMISSION OF BID.

BIDDERS ARE TO VISIT THE SITE AND FAMILIARIZE THEMSELVES WITH EXISTING CONDITIONS AND SATISFY THEMSELVES AS TO THE NATURE AND SCOPE OF THE WORK. THE BASE BID SHALL REFLECT MODIFICATIONS TO SYSTEMS AND DEVICES AS REQUIRED BY STATE, LOCAL AND FEDERAL CODES WHETHER INDICATED OR NOT ON CONTRACT DOCUMENTS. THE SUBMISSIONS OF A BID WILL BE EVIDENCE THAT SUCH AN EXAMINATION AND COMPLIANCE WITH GOVERNING CODES/REQUIREMENTS HAS BEEN MADE. LATER CLAIMS FOR LABOR, EQUIPMENT, OR MATERIALS REQUIRED, OR FOR DIFFICULTIES ENCOUNTERED WHICH COULD HAVE BEEN FORESEEN HAD AN EXAMINATION AND CODE/REQUIREMENTS REVIEW BEEN MADE, WILL NOT BE ALLOWED.

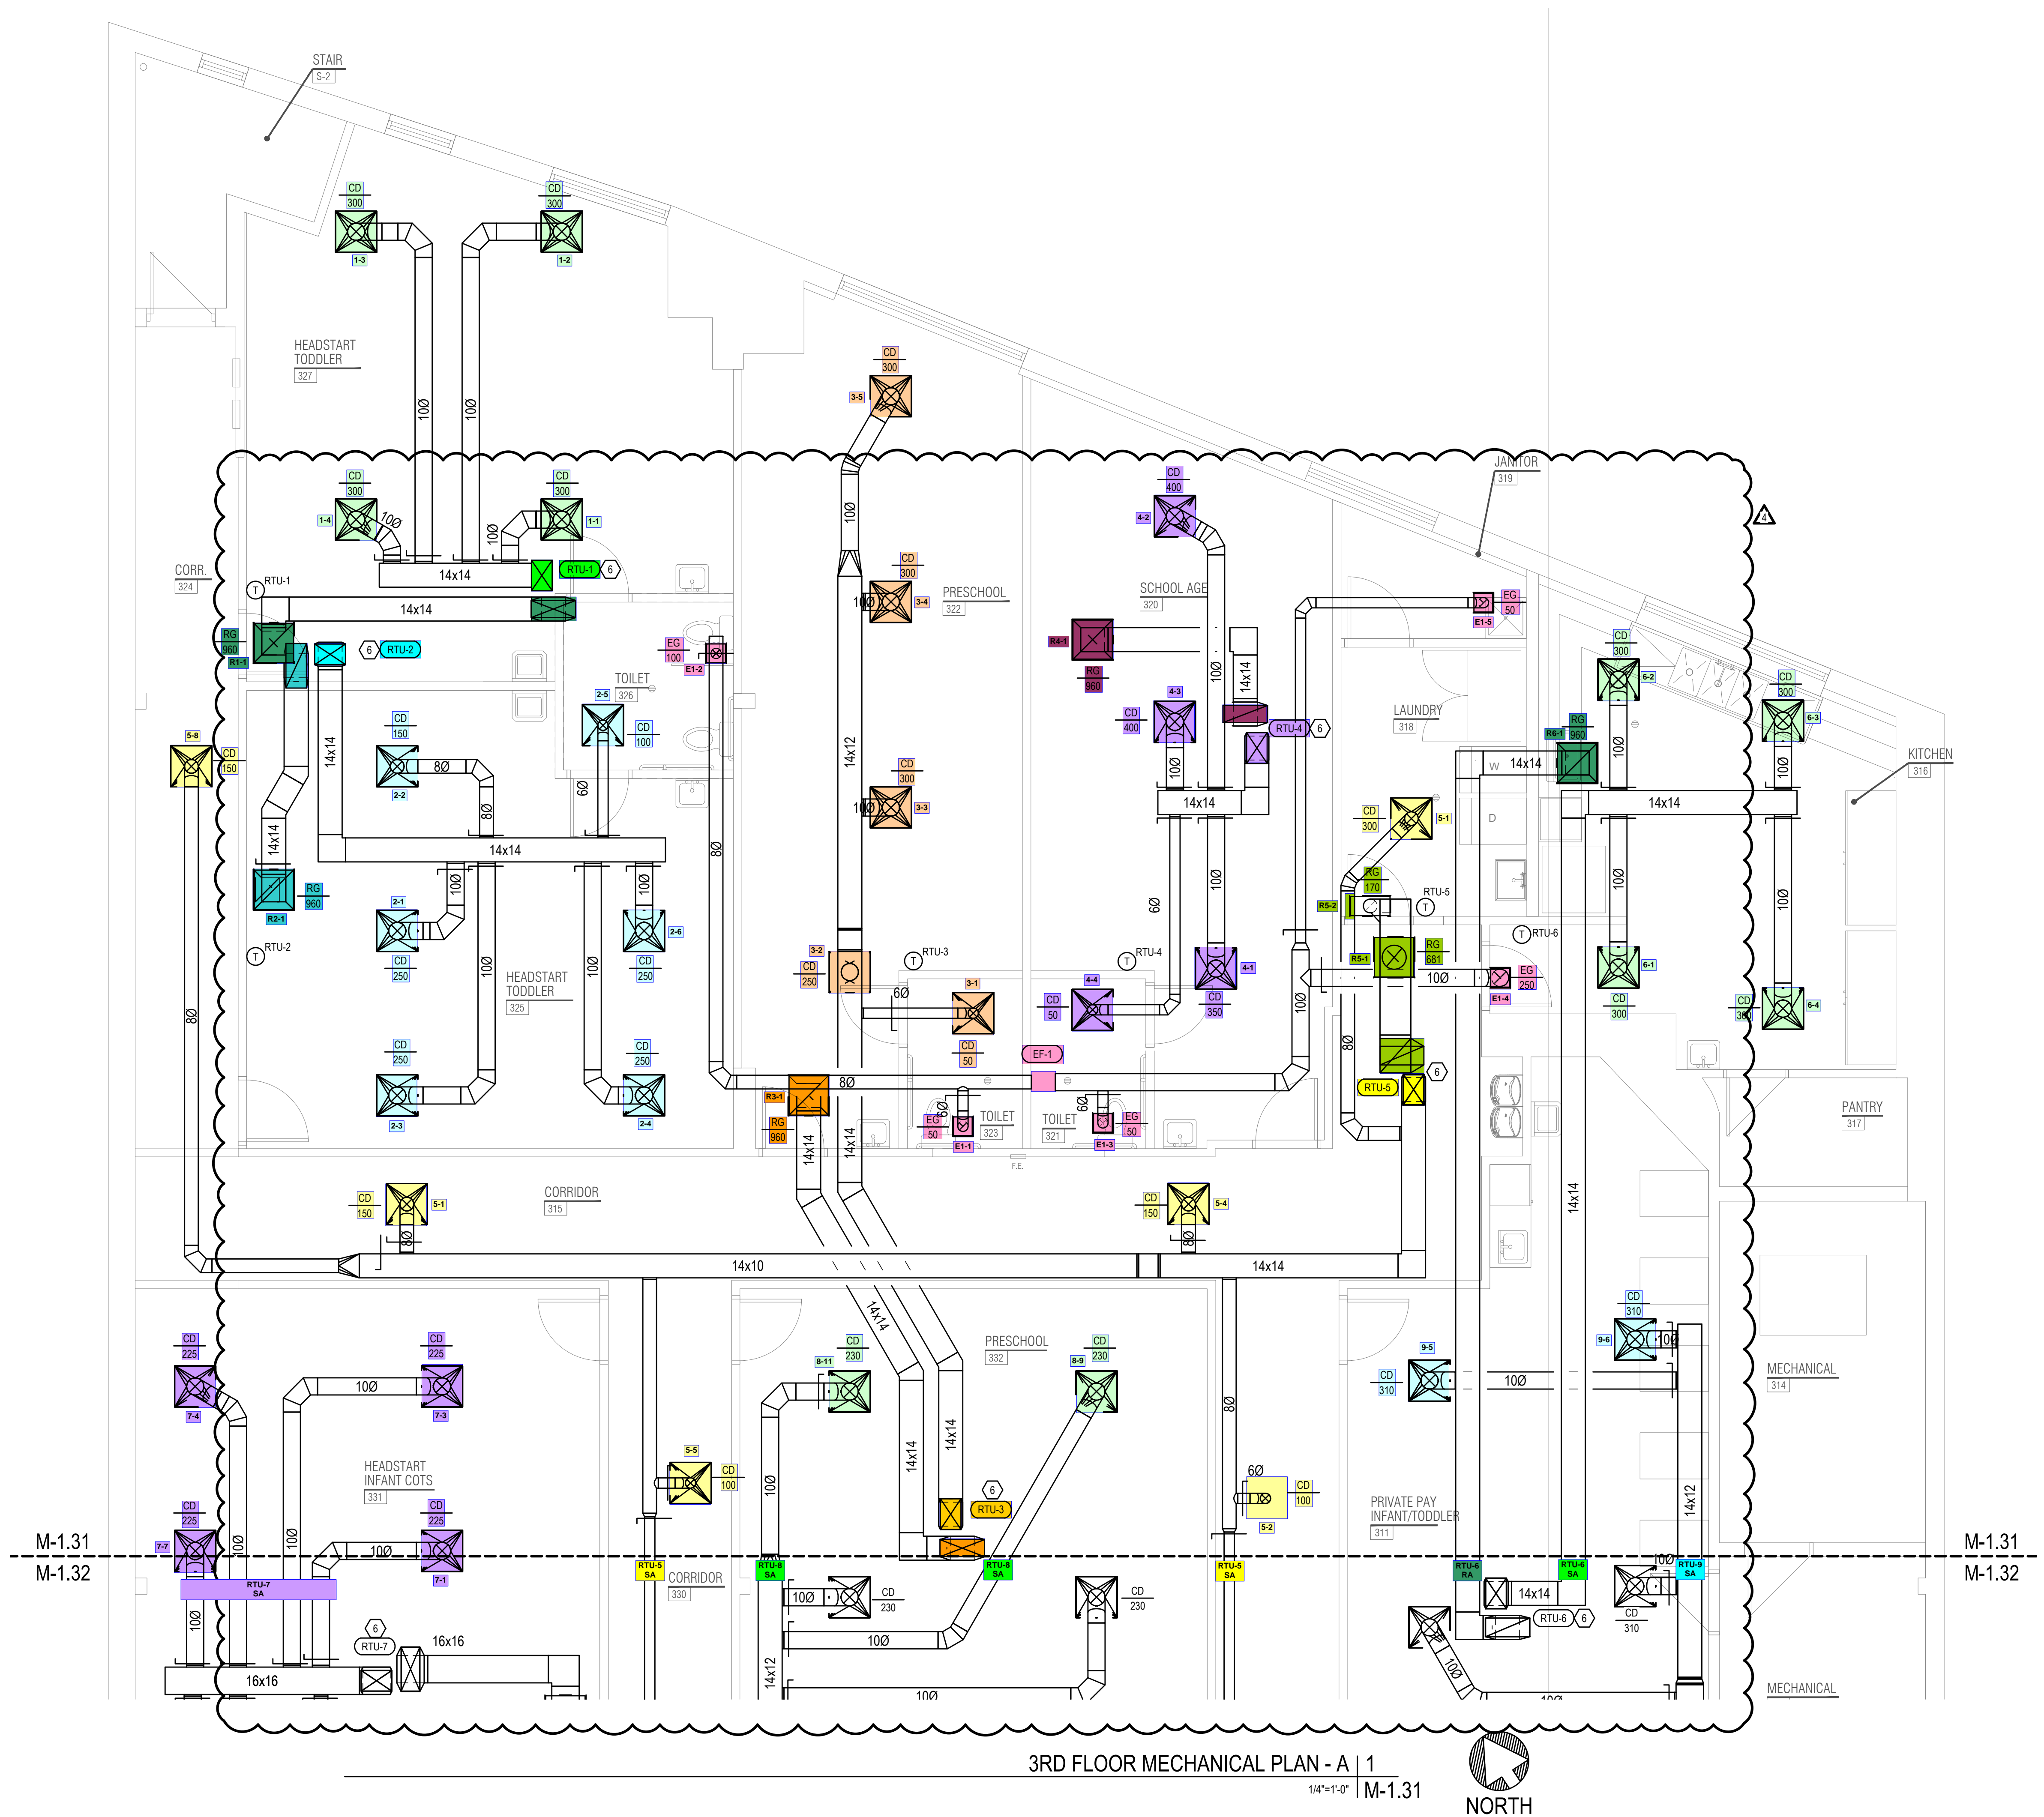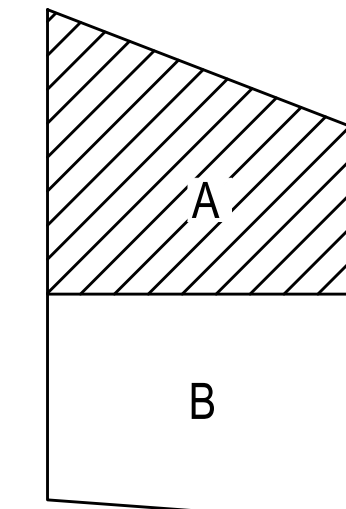

3RD FLOOR MECHANICAL PLAN - A | 1
1/4"=1'-0" M-1.31



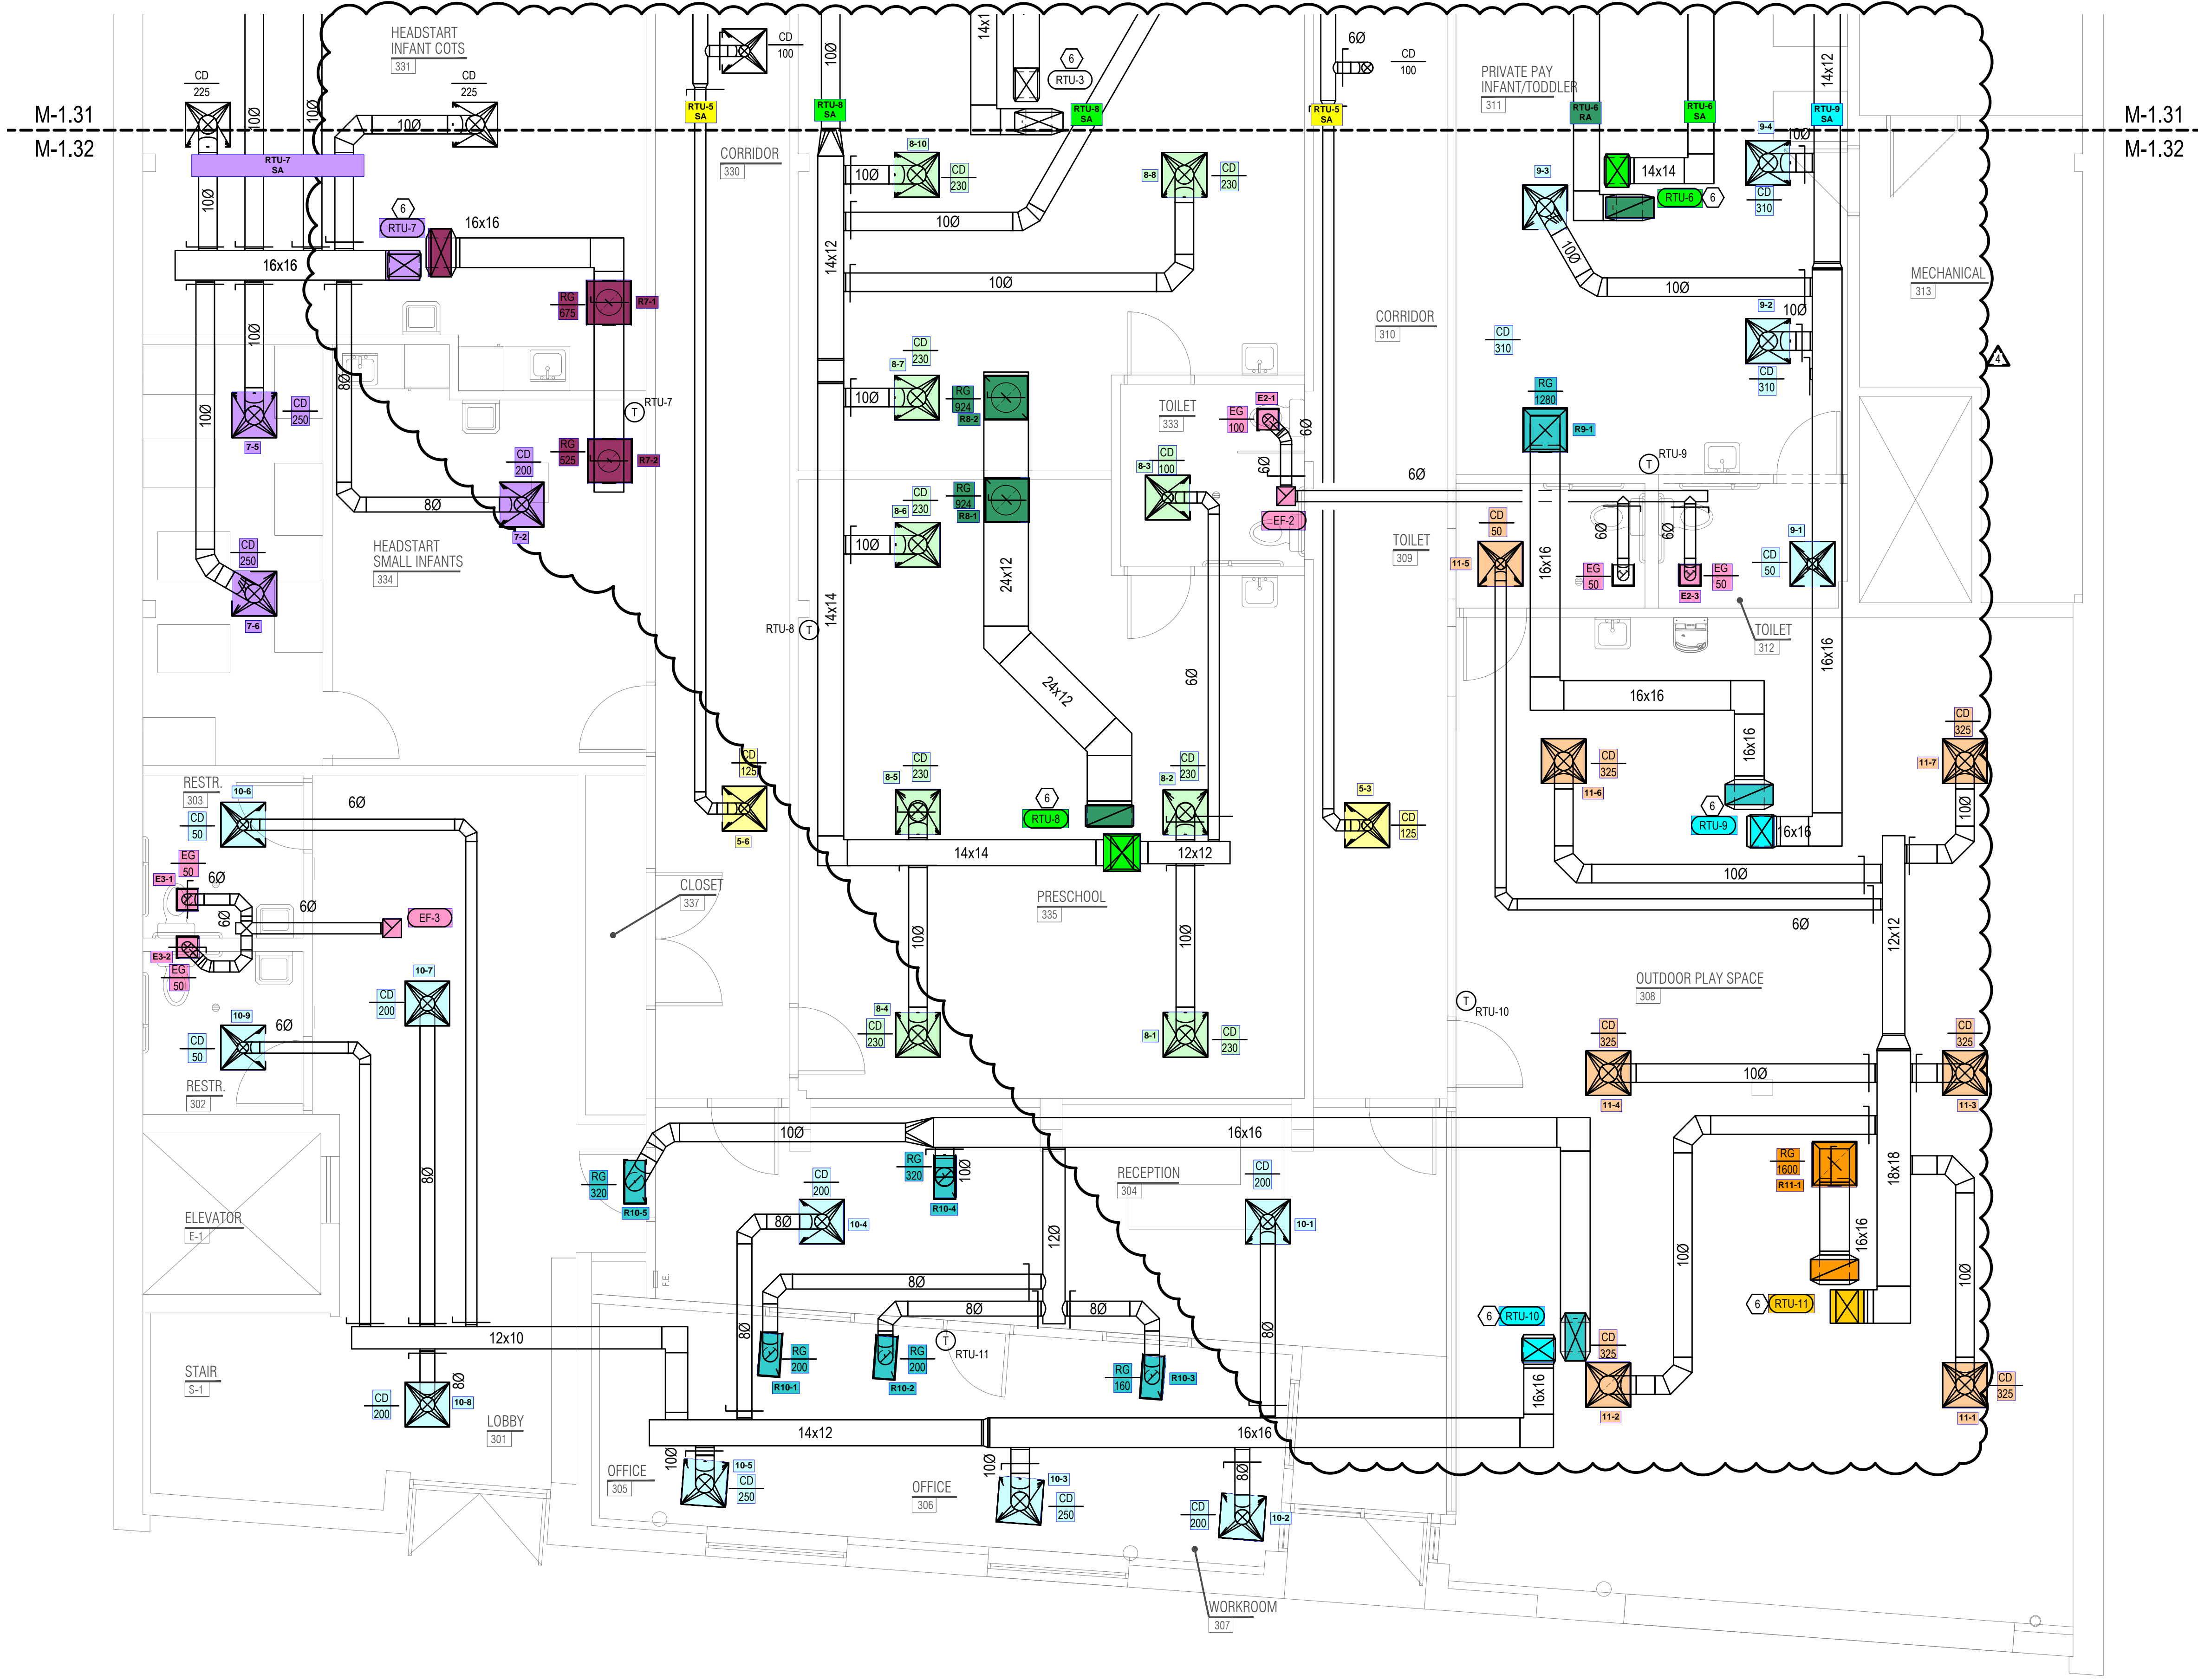

- PLAN NOTES:
- COORDINATE LOCATION OF FURNACE WITH GC.
 - NOTE NOT USED.
 - NOTE NOT USED.
 - NOTE NOT USED.
 - PROVIDE 7 DAY FULLY PROGRAMMABLE THERMOSTATS WITH SENSORS AS SHOWN ON PLAN. THERMOSTATS AND SENSORS MUST BE CAPABLE OF CONTROLLING ALL FUNCTIONALITY OF EQUIPMENT BEING CONTROLLED. MOUNT THERMOSTATS AT 48" AFF. PROVIDE LOW VOLTAGE CONTROL WIRING AND MAKE SYSTEM FULLY FUNCTIONAL.
 - DUCT UP TO ROOFTOP UNIT. COORDINATE DUCT PENETRATIONS WITH EXISTING OPENINGS. COORDINATE WITH STRUCTURAL REINFORCEMENTS.




WATER LILY
LEARNING CENTER
1808 CENTRAL PARKWAY
CINCINNATI, OH, 45214



REVISIONS

1	PLAN REVIEW RESPONSE	05/31/23
2	PLAN REVIEW RESPONSE	07/11/23
4	CONSTR. BULLETIN 04	02.12.24

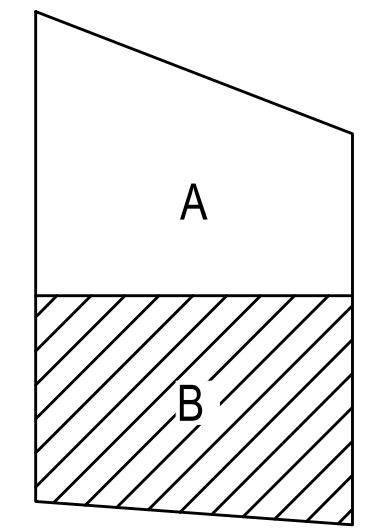

3RD FLOOR MECHANICAL PLAN - B | 1
1/4"=1'-0" M-1.32



CONTRACTOR NOTE

IT IS THE RESPONSIBILITY OF THE CONTRACTOR TO NOTIFY THE ARCHITECT, LANDLORD AND TENANT OF ANY DISCREPANCIES ENCOUNTERED ON THE PLANS OR IN EXISTING SITE CONDITIONS PRIOR TO SUBMISSION OF BID.


BIDDERS ARE TO VISIT THE SITE AND FAMILIARIZE THEMSELVES AS TO THE NATURE AND SCOPE OF THE WORK. THE BASE BID SHALL REFLECT MODIFICATIONS TO SYSTEMS AND DEVICES AS REQUIRED BY STATE, LOCAL AND FEDERAL CODES WHETHER INDICATED OR NOT ON CONTRACT DOCUMENTS. THE SUBMISSIONS OF A BID WILL BE EVIDENCE THAT SUCH AN EXAMINATION AND COMPLIANCE WITH GOVERNING CODES/REQUIREMENTS HAS BEEN MADE. LATER CLAIMS FOR LABOR, EQUIPMENT, OR MATERIALS REQUIRED, OR FOR DIFFICULTIES ENCOUNTERED WHICH COULD HAVE BEEN FORESEEN HAD AN EXAMINATION AND CODE/REQUIREMENTS REVIEW BEEN MADE, WILL NOT BE ALLOWED.

KEYPLAN:

DATE:	04.18.23
DRAWN BY:	STAFF
SCALE:	AS NOTED
JOB NO.:	23012


TITLE:
3RD FLOOR MECHANICAL
PLAN - B

SHEET NO:
M-1.32

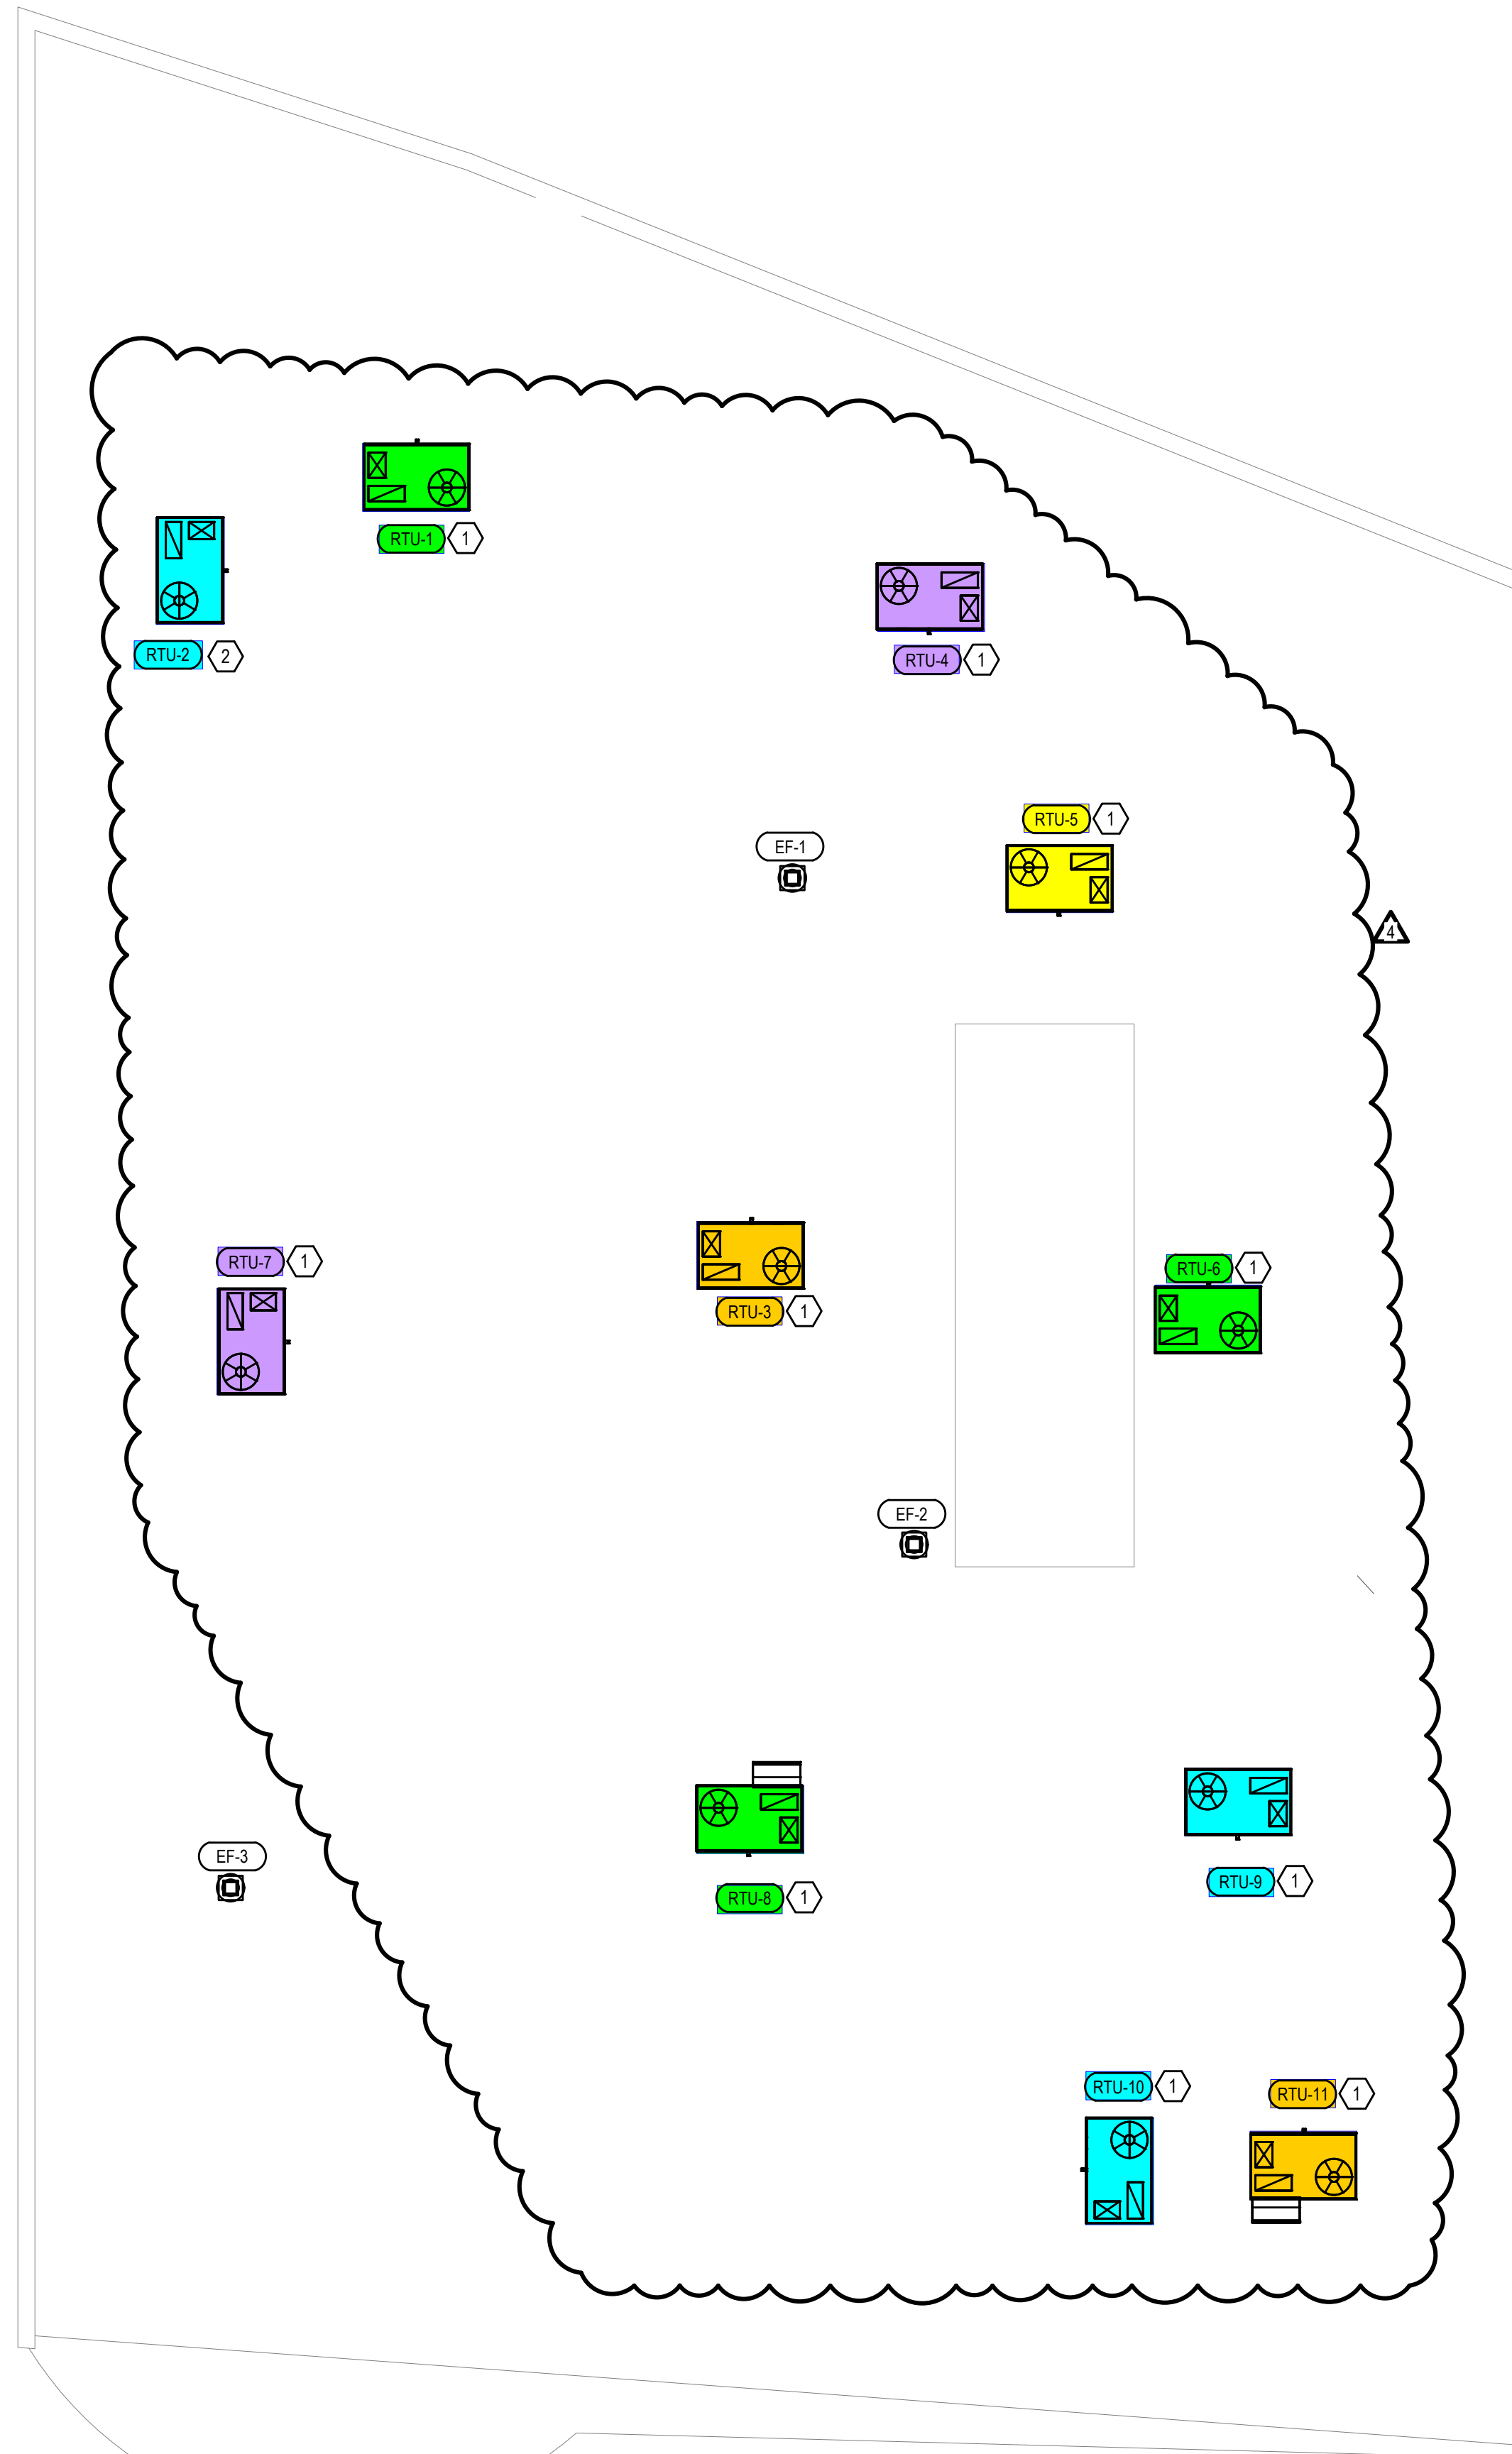

- PLAN NOTES:
1. NEW ROOFTOP UNIT ON NEW CURB. COORDINATE INSTALLATION WITH GC. FOR RE-USE OF EXISTING ROOF OPENING.
 2. NEW ROOFTOP UNIT ON NEW CURB.
 3. NOTE NOT USED.
 4. NOTE NOT USED.
 5. NOTE NOT USED.

MECHANICAL ROOF PLAN | 1
1/8"=1'-0" | M-2.1

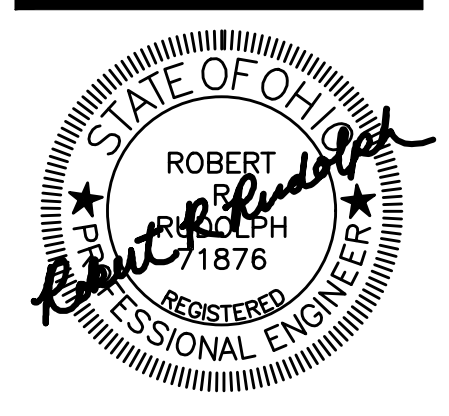

**WATER LILY
LEARNING CENTER**
1808 CENTRAL PARKWAY
CINCINNATI, OH, 45214



REVISIONS	
1	PLAN REVIEW RESPONSE 05/31/23
2	PLAN REVIEW RESPONSE 07/11/23
4	CONSTR. BULLETIN 04 02.12.24

CONTRACTOR NOTE

IT IS THE RESPONSIBILITY OF THE CONTRACTOR TO NOTIFY THE ARCHITECT, LANDLORD AND TENANT OF ANY DISCREPANCIES ENCOUNTERED ON THE PLANS OR IN EXISTING SITE CONDITIONS PRIOR TO SUBMISSION OF BID.

BIDDERS ARE TO VISIT THE SITE AND FAMILIARIZE THEMSELVES WITH EXISTING CONDITIONS AND SATISFY THEMSELVES AS TO THE NATURE AND SCOPE OF THE WORK. THE BASE BID SHALL REFLECT MODIFICATIONS TO SYSTEMS AND DEVICES AS REQUIRED BY STATE, LOCAL AND FEDERAL CODES WHETHER INDICATED OR NOT ON CONTRACT DOCUMENTS. THE SUBMISSIONS OF A BID WILL BE EVIDENCE THAT SUCH AN EXAMINATION AND COMPLIANCE WITH GOVERNING CODES/REQUIREMENTS HAS BEEN MADE. LATER CLAIMS FOR LABOR, EQUIPMENT, OR MATERIALS REQUIRED, OR FOR DIFFICULTIES ENCOUNTERED WHICH COULD HAVE BEEN FORESEEN HAD AN EXAMINATION AND CODE/REQUIREMENTS REVIEW BEEN MADE, WILL NOT BE ALLOWED.

DATE:	04.18.23
DRAWN BY:	STAFF
SCALE:	AS NOTED
JOB NO.:	23012

TITLE:
MECHANICAL ROOF PLAN

SHEET NO:
M-2.1