



NOTE: THE DESIGNER HAS CONDUCTED VISUAL VERIFICATION OF THE EXISTING CONDITIONS OF THE BUILDING TO CORROBORATE THE INFORMATION PROVIDED BY THE ARCHITECT. THE DESIGNER HAS CONDUCTED VISUAL VERIFICATION OF THE EXISTING CONDITIONS OF THE BUILDING TO CORROBORATE THE INFORMATION PROVIDED BY THE ARCHITECT. THE DESIGNER HAS CONDUCTED VISUAL VERIFICATION OF THE EXISTING CONDITIONS OF THE BUILDING TO CORROBORATE THE INFORMATION PROVIDED BY THE ARCHITECT.

65 TELON STREET  
DENVER, CO  
PHONE (303) 778-3056  
FAX (303) 871-9262

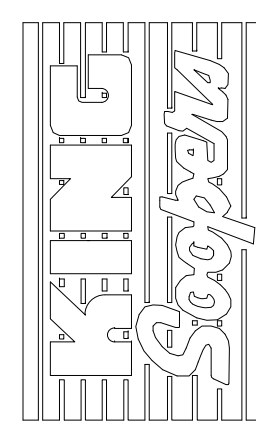

(EXIST) BOUNTIFUL


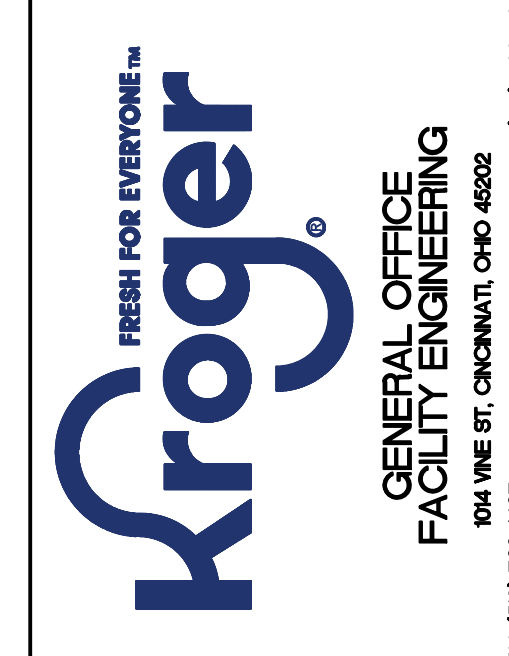


EXISTING  
**KS-080**  
995 S. HOVER RD.  
LONGMONT, CO

CURRENT PLAN DATE  
**11/3/2021**  
ORIGINAL PLAN DATE  
11/3/2021  
DRAWN  
M. PATTERSON  
CHECKED

STANDARD PLOTTED SCALE	
1/16" = 1'-0"	
<b>BUILDING STATS:</b>	
TOTAL SHELVING	2,748 LF
SALES AREA	49,126 SF
% OF GROSS BUILDING	67.8
BASE STORE	69,930 SF
MEZZANINE	3,237 SF
DOCK / UTILITY	0 SF
<b>GROSS BUILDING</b>	<b>73,167 SF</b>
<b>AS-BUILT</b>	<b>FIXTURE PLAN</b>
STEEL PACKAGE ID	Not Applicable

CAD FILE KS080NFDWG  
SHEET  
**KS-080**  
**XF1**

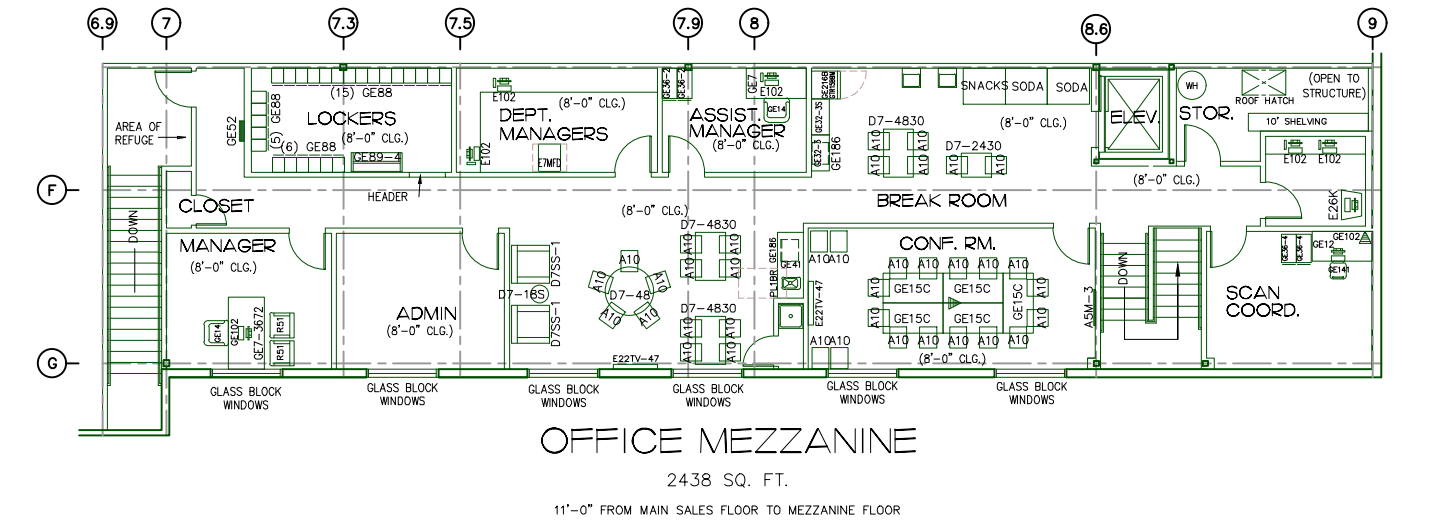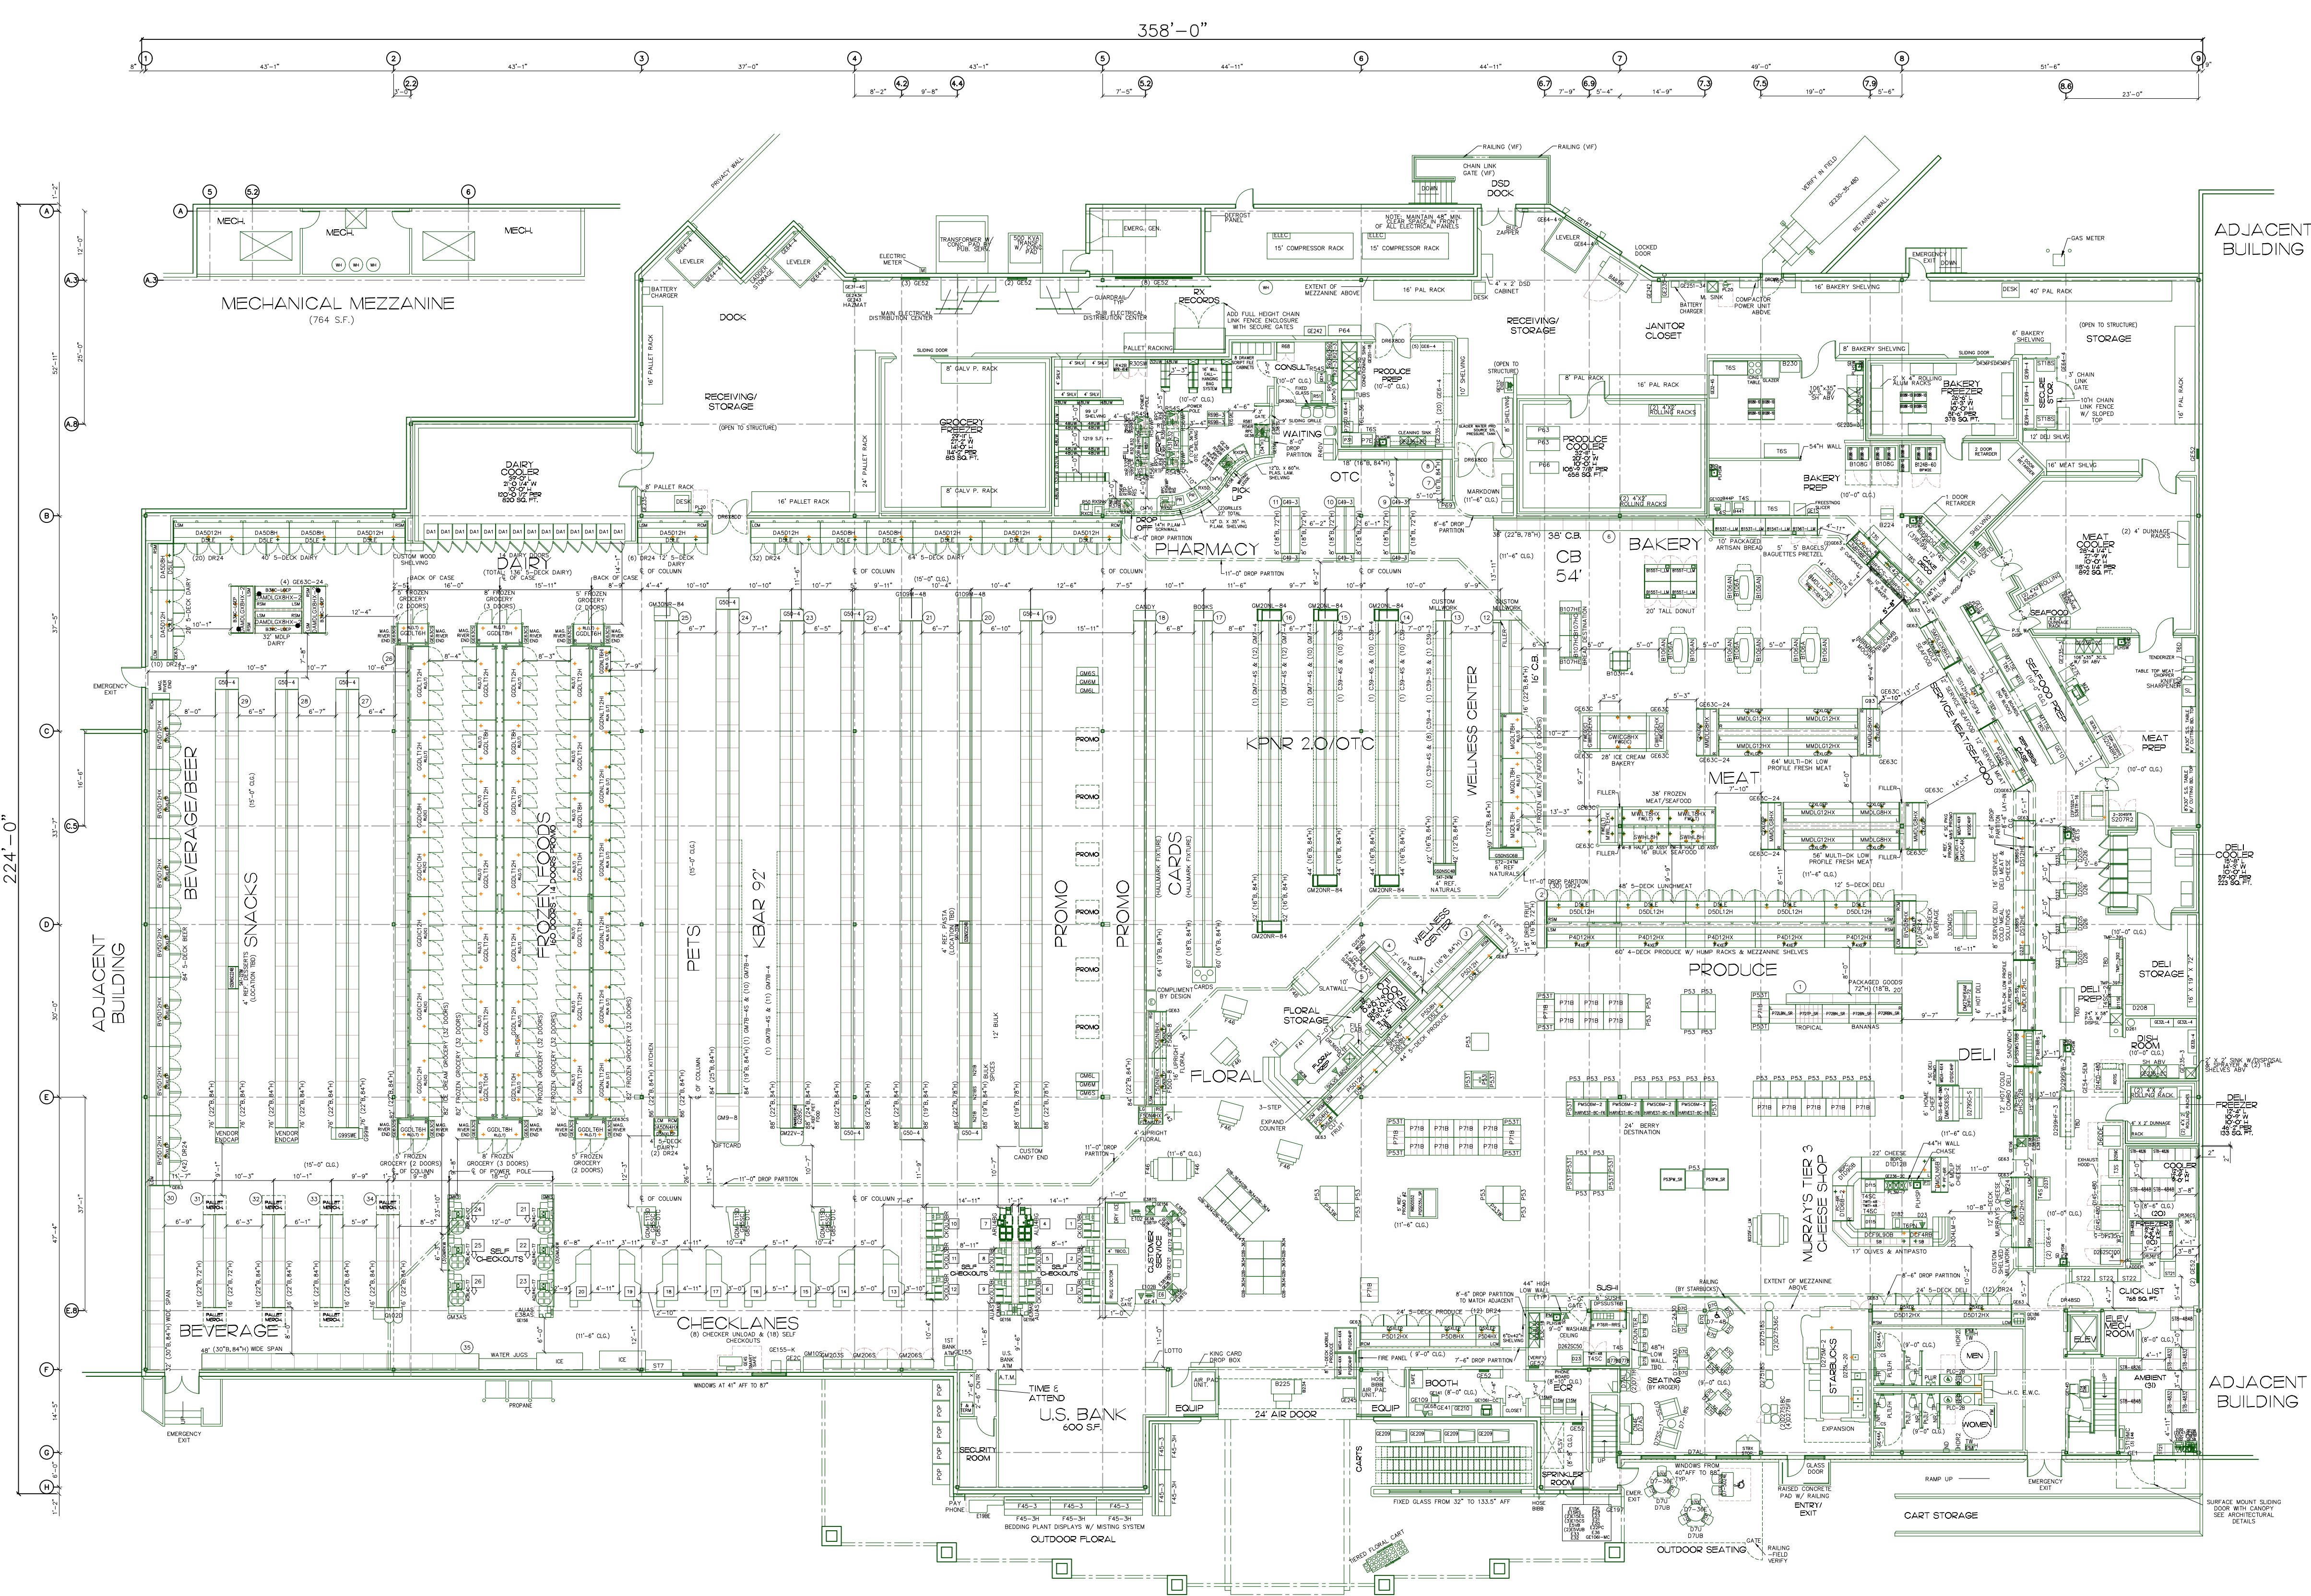

NO.	DESCRIPTION
1	MECHANICAL MEZZANINE (784 SF)
2	OFFICE MEZZANINE (2438 SF)
3	BEVERAGE
4	SNACKS
5	FROZEN FOODS
6	PETS
7	NEAR 92
8	PROMO
9	CARDS
10	PHARMACY
11	WELLNESS CENTER
12	BAKERY
13	NEAT
14	PRODUCE
15	DELI
16	LOCAL SUSHI

NO.	DESCRIPTION
17	MECHANICAL MEZZANINE (784 SF)
18	OFFICE MEZZANINE (2438 SF)
19	BEVERAGE
20	SNACKS
21	FROZEN FOODS
22	PETS
23	NEAR 92
24	PROMO
25	CARDS
26	PHARMACY
27	WELLNESS CENTER
28	BAKERY
29	NEAT
30	PRODUCE
31	DELI
32	LOCAL SUSHI

COLOR KEY




EXISTING FIXTURES
RELOCATED FIXTURES
NEW FIXTURES
RIS FIXTURES

EXISTING PLAN



**COLOR KEY**

- EXISTING FIXTURES
- RELOCATED FIXTURES
- NEW FIXTURES
- RIS FIXTURES

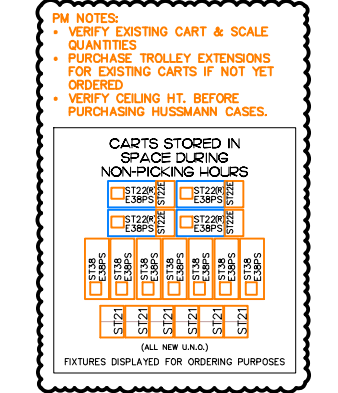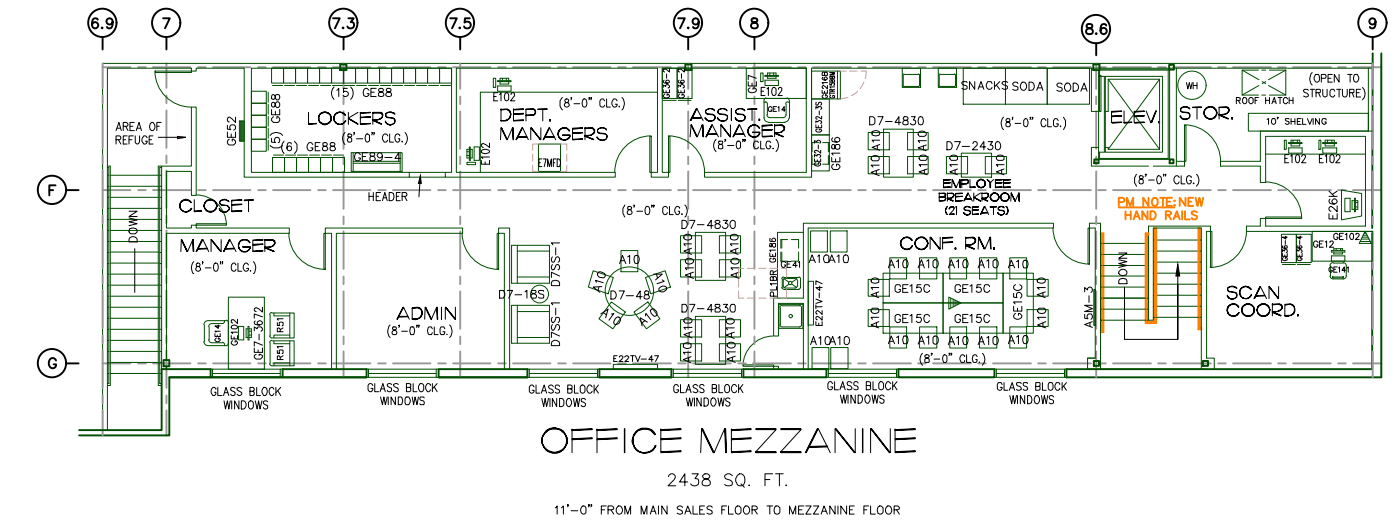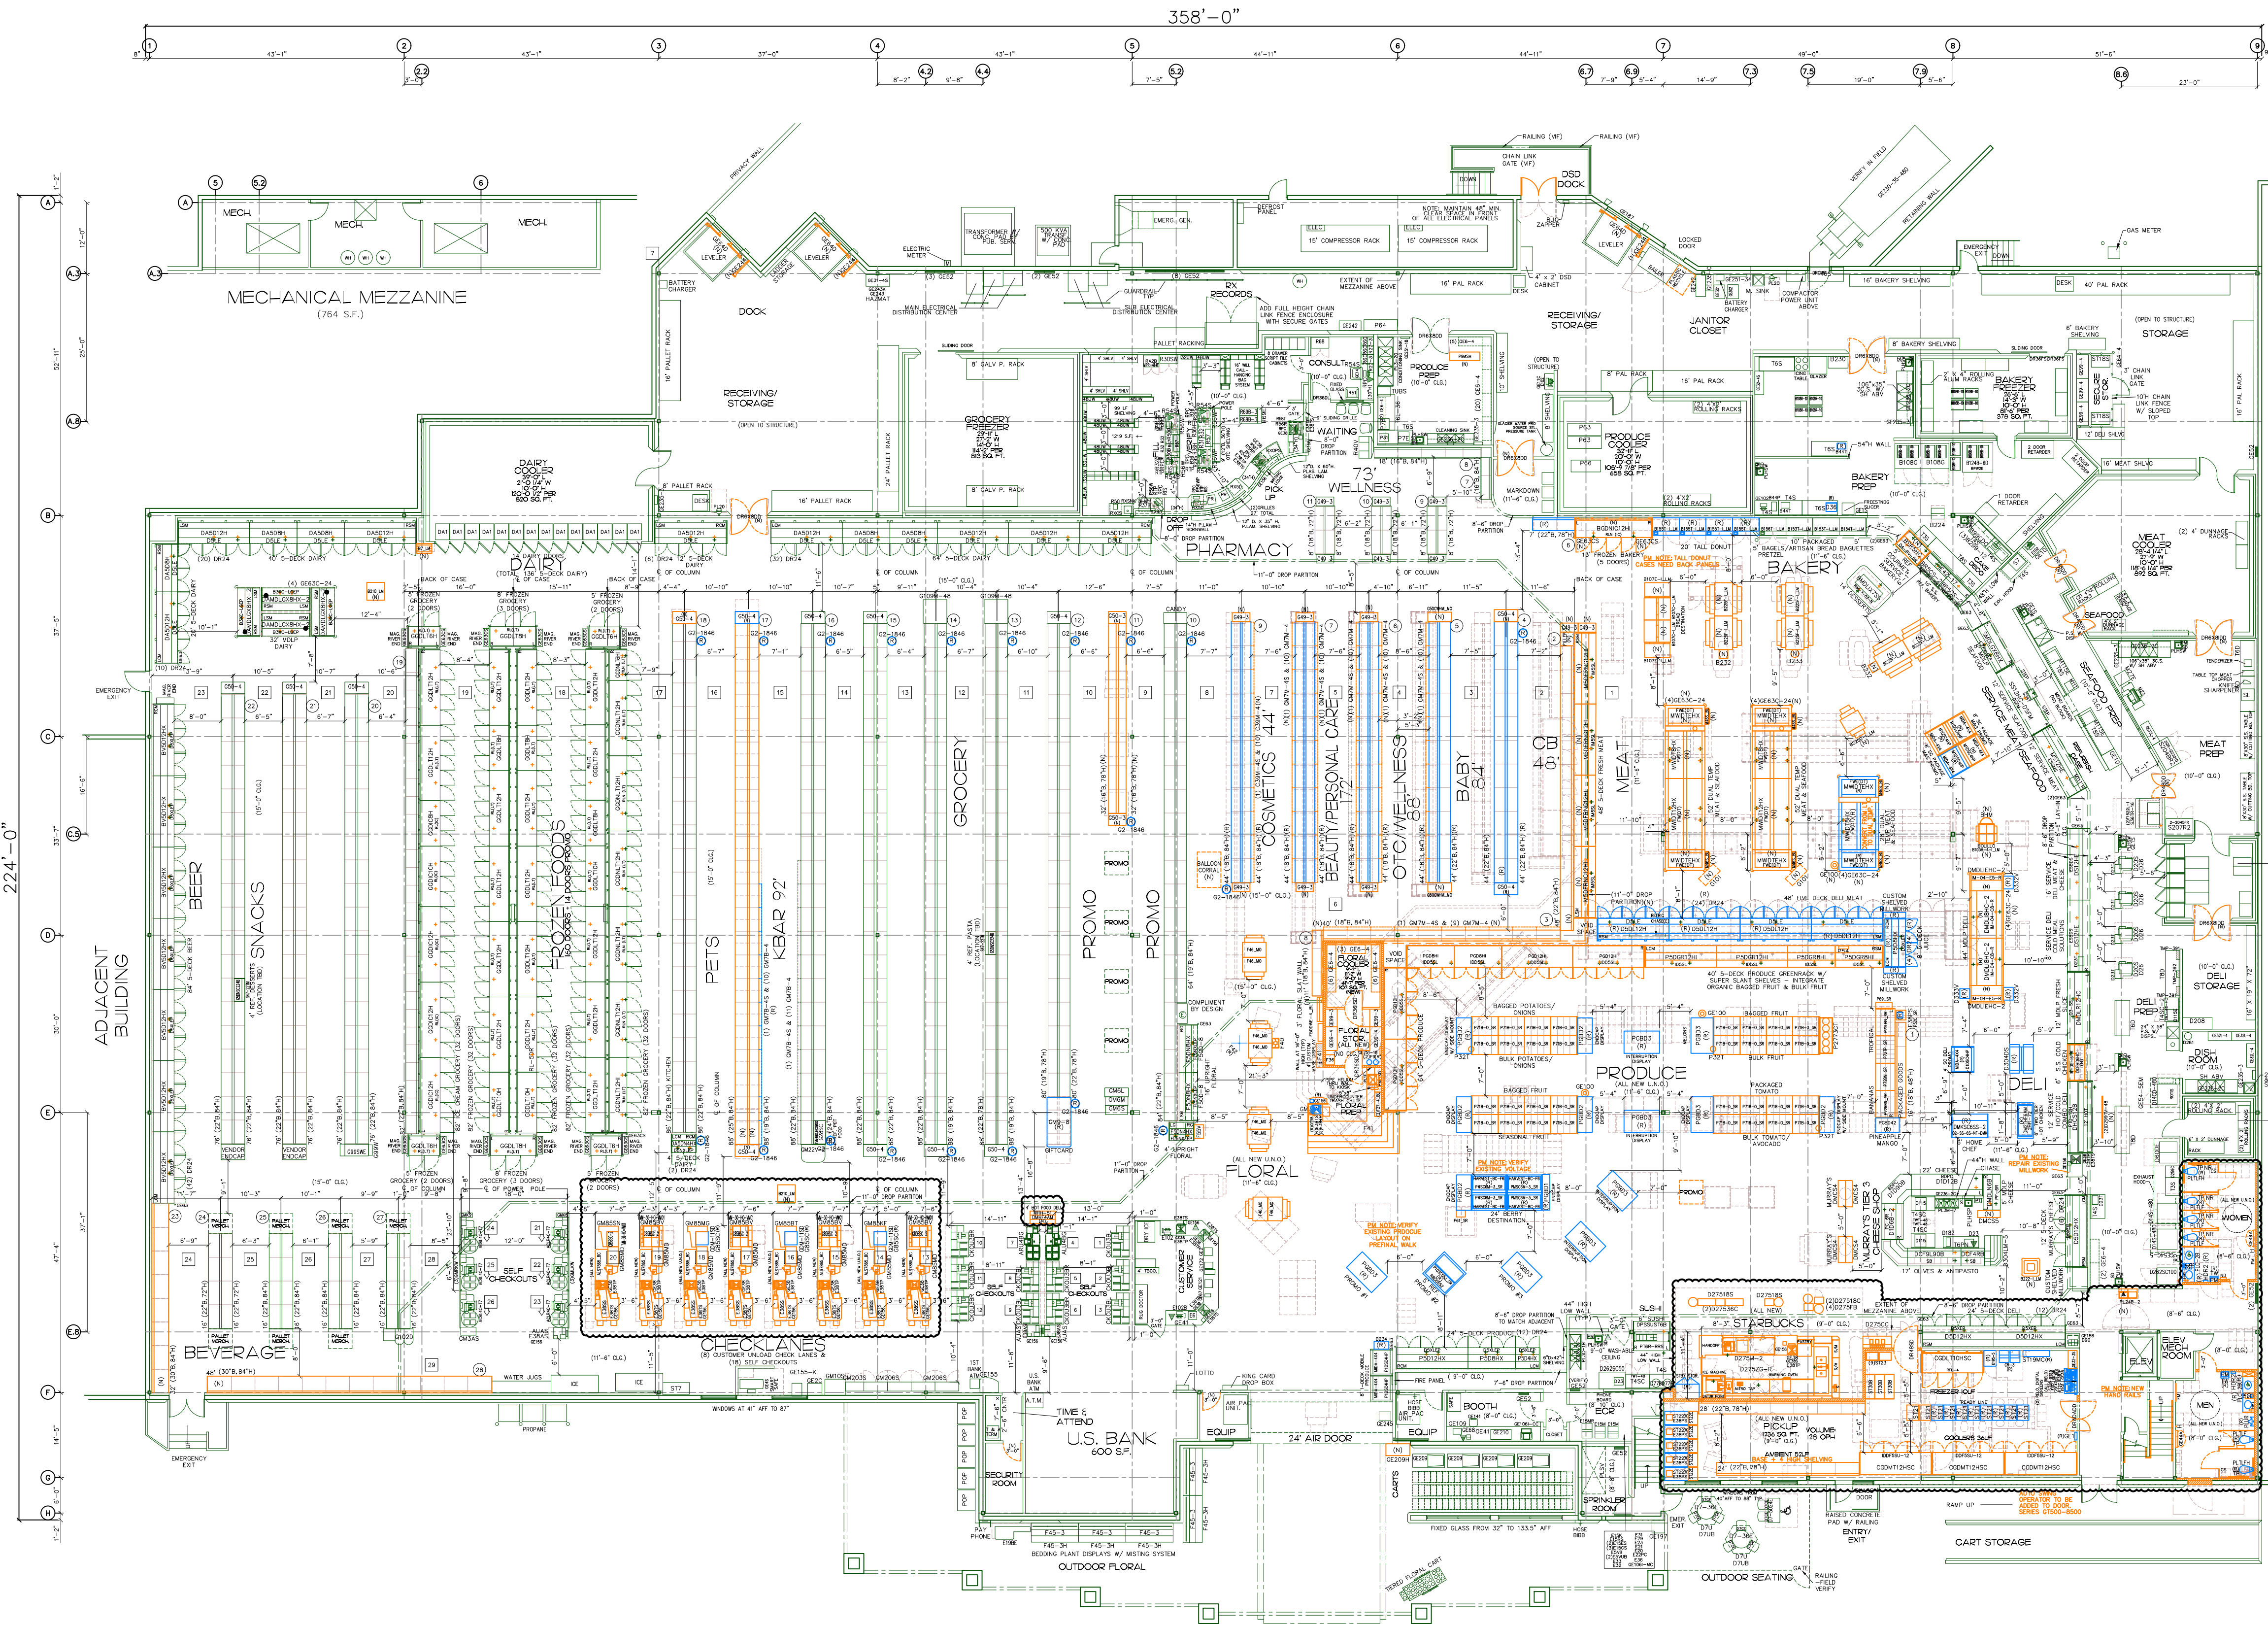

NO.	DESCRIPTION	DATE
1	MECHANICAL MEZZANINE	12/13/2020
2	PHARMACY	12/13/2020
3	BAKERY	12/13/2020
4	PRODUCE	12/13/2020
5	GROCERY	12/13/2020
6	BEVERAGE	12/13/2020
7	SNACKS	12/13/2020
8	FROZEN FOODS	12/13/2020
9	PETS	12/13/2020
10	BEAUTY	12/13/2020
11	WELLNESS	12/13/2020
12	MECHANICAL	12/13/2020
13	STORAGE	12/13/2020
14	RESTROOMS	12/13/2020
15	OFFICE MEZZANINE	12/13/2020
16	ADJACENT BUILDING	12/13/2020
17	MECHANICAL MEZZANINE	12/13/2020
18	PHARMACY	12/13/2020
19	BAKERY	12/13/2020
20	PRODUCE	12/13/2020
21	GROCERY	12/13/2020
22	BEVERAGE	12/13/2020
23	SNACKS	12/13/2020
24	FROZEN FOODS	12/13/2020
25	PETS	12/13/2020
26	BEAUTY	12/13/2020
27	WELLNESS	12/13/2020
28	MECHANICAL	12/13/2020
29	STORAGE	12/13/2020
30	RESTROOMS	12/13/2020
31	OFFICE MEZZANINE	12/13/2020
32	ADJACENT BUILDING	12/13/2020
33	MECHANICAL MEZZANINE	12/13/2020
34	PHARMACY	12/13/2020
35	BAKERY	12/13/2020
36	PRODUCE	12/13/2020
37	GROCERY	12/13/2020
38	BEVERAGE	12/13/2020
39	SNACKS	12/13/2020
40	FROZEN FOODS	12/13/2020
41	PETS	12/13/2020
42	BEAUTY	12/13/2020
43	WELLNESS	12/13/2020
44	MECHANICAL	12/13/2020
45	STORAGE	12/13/2020
46	RESTROOMS	12/13/2020
47	OFFICE MEZZANINE	12/13/2020
48	ADJACENT BUILDING	12/13/2020
49	MECHANICAL MEZZANINE	12/13/2020
50	PHARMACY	12/13/2020
51	BAKERY	12/13/2020
52	PRODUCE	12/13/2020
53	GROCERY	12/13/2020
54	BEVERAGE	12/13/2020
55	SNACKS	12/13/2020
56	FROZEN FOODS	12/13/2020
57	PETS	12/13/2020
58	BEAUTY	12/13/2020
59	WELLNESS	12/13/2020
60	MECHANICAL	12/13/2020
61	STORAGE	12/13/2020
62	RESTROOMS	12/13/2020
63	OFFICE MEZZANINE	12/13/2020
64	ADJACENT BUILDING	12/13/2020
65	MECHANICAL MEZZANINE	12/13/2020
66	PHARMACY	12/13/2020
67	BAKERY	12/13/2020
68	PRODUCE	12/13/2020
69	GROCERY	12/13/2020
70	BEVERAGE	12/13/2020
71	SNACKS	12/13/2020
72	FROZEN FOODS	12/13/2020
73	PETS	12/13/2020
74	BEAUTY	12/13/2020
75	WELLNESS	12/13/2020
76	MECHANICAL	12/13/2020
77	STORAGE	12/13/2020
78	RESTROOMS	12/13/2020
79	OFFICE MEZZANINE	12/13/2020
80	ADJACENT BUILDING	12/13/2020
81	MECHANICAL MEZZANINE	12/13/2020
82	PHARMACY	12/13/2020
83	BAKERY	12/13/2020
84	PRODUCE	12/13/2020
85	GROCERY	12/13/2020
86	BEVERAGE	12/13/2020
87	SNACKS	12/13/2020
88	FROZEN FOODS	12/13/2020
89	PETS	12/13/2020
90	BEAUTY	12/13/2020
91	WELLNESS	12/13/2020
92	MECHANICAL	12/13/2020
93	STORAGE	12/13/2020
94	RESTROOMS	12/13/2020
95	OFFICE MEZZANINE	12/13/2020
96	ADJACENT BUILDING	12/13/2020
97	MECHANICAL MEZZANINE	12/13/2020
98	PHARMACY	12/13/2020
99	BAKERY	12/13/2020
100	PRODUCE	12/13/2020
101	GROCERY	12/13/2020
102	BEVERAGE	12/13/2020
103	SNACKS	12/13/2020
104	FROZEN FOODS	12/13/2020
105	PETS	12/13/2020
106	BEAUTY	12/13/2020
107	WELLNESS	12/13/2020
108	MECHANICAL	12/13/2020
109	STORAGE	12/13/2020
110	RESTROOMS	12/13/2020
111	OFFICE MEZZANINE	12/13/2020
112	ADJACENT BUILDING	12/13/2020
113	MECHANICAL MEZZANINE	12/13/2020
114	PHARMACY	12/13/2020
115	BAKERY	12/13/2020
116	PRODUCE	12/13/2020
117	GROCERY	12/13/2020
118	BEVERAGE	12/13/2020
119	SNACKS	12/13/2020
120	FROZEN FOODS	12/13/2020
121	PETS	12/13/2020
122	BEAUTY	12/13/2020
123	WELLNESS	12/13/2020
124	MECHANICAL	12/13/2020
125	STORAGE	12/13/2020
126	RESTROOMS	12/13/2020
127	OFFICE MEZZANINE	12/13/2020
128	ADJACENT BUILDING	12/13/2020
129	MECHANICAL MEZZANINE	12/13/2020
130	PHARMACY	12/13/2020
131	BAKERY	12/13/2020
132	PRODUCE	12/13/2020
133	GROCERY	12/13/2020
134	BEVERAGE	12/13/2020
135	SNACKS	12/13/2020
136	FROZEN FOODS	12/13/2020
137	PETS	12/13/2020
138	BEAUTY	12/13/2020
139	WELLNESS	12/13/2020
140	MECHANICAL	12/13/2020
141	STORAGE	12/13/2020
142	RESTROOMS	12/13/2020
143	OFFICE MEZZANINE	12/13/2020
144	ADJACENT BUILDING	12/13/2020
145	MECHANICAL MEZZANINE	12/13/2020
146	PHARMACY	12/13/2020
147	BAKERY	12/13/2020
148	PRODUCE	12/13/2020
149	GROCERY	12/13/2020
150	BEVERAGE	12/13/2020
151	SNACKS	12/13/2020
152	FROZEN FOODS	12/13/2020
153	PETS	12/13/2020
154	BEAUTY	12/13/2020
155	WELLNESS	12/13/2020
156	MECHANICAL	12/13/2020
157	STORAGE	12/13/2020
158	RESTROOMS	12/13/2020
159	OFFICE MEZZANINE	12/13/2020
160	ADJACENT BUILDING	12/13/2020
161	MECHANICAL MEZZANINE	12/13/2020
162	PHARMACY	12/13/2020
163	BAKERY	12/13/2020
164	PRODUCE	12/13/2020
165	GROCERY	12/13/2020
166	BEVERAGE	12/13/2020
167	SNACKS	12/13/2020
168	FROZEN FOODS	12/13/2020
169	PETS	12/13/2020
170	BEAUTY	12/13/2020
171	WELLNESS	12/13/2020
172	MECHANICAL	12/13/2020
173	STORAGE	12/13/2020
174	RESTROOMS	12/13/2020
175	OFFICE MEZZANINE	12/13/2020
176	ADJACENT BUILDING	12/13/2020
177	MECHANICAL MEZZANINE	12/13/2020
178	PHARMACY	12/13/2020
179	BAKERY	12/13/2020
180	PRODUCE	12/13/2020
181	GROCERY	12/13/2020
182	BEVERAGE	12/13/2020
183	SNACKS	12/13/2020
184	FROZEN FOODS	12/13/2020
185	PETS	12/13/2020
186	BEAUTY	12/13/2020
187	WELLNESS	12/13/2020
188	MECHANICAL	12/13/2020
189	STORAGE	12/13/2020
190	RESTROOMS	12/13/2020
191	OFFICE MEZZANINE	12/13/2020
192	ADJACENT BUILDING	12/13/2020
193	MECHANICAL MEZZANINE	12/13/2020
194	PHARMACY	12/13/2020
195	BAKERY	12/13/2020
196	PRODUCE	12/13/2020
197	GROCERY	12/13/2020
198	BEVERAGE	12/13/2020
199	SNACKS	12/13/2020
200	FROZEN FOODS	12/13/2020
201	PETS	12/13/2020
202	BEAUTY	12/13/2020
203	WELLNESS	12/13/2020
204	MECHANICAL	12/13/2020
205	STORAGE	12/13/2020
206	RESTROOMS	12/13/2020
207	OFFICE MEZZANINE	12/13/2020
208	ADJACENT BUILDING	12/13/2020
209	MECHANICAL MEZZANINE	12/13/2020
210	PHARMACY	12/13/2020
211	BAKERY	12/13/2020
212	PRODUCE	12/13/2020
213	GROCERY	12/13/2020
214	BEVERAGE	12/13/2020
215	SNACKS	12/13/2020
216	FROZEN FOODS	12/13/2020
217	PETS	12/13/2020
218	BEAUTY	12/13/2020
219	WELLNESS	12/13/2020
220	MECHANICAL	12/13/2020
221	STORAGE	12/13/2020
222	RESTROOMS	12/13/2020
223	OFFICE MEZZANINE	12/13/2020
224	ADJACENT BUILDING	12/13/2020
225	MECHANICAL MEZZANINE	12/13/2020
226	PHARMACY	12/13/2020
227	BAKERY	12/13/2020
228	PRODUCE	12/13/2020
229	GROCERY	12/13/2020
230	BEVERAGE	12/13/2020
231	SNACKS	12/13/2020
232	FROZEN FOODS	12/13/2020
233	PETS	12/13/2020
234	BEAUTY	12/13/2020
235	WELLNESS	12/13/2020
236	MECHANICAL	12/13/2020
237	STORAGE	12/13/2020
238	RESTROOMS	12/13/2020
239	OFFICE MEZZANINE	12/13/2020
240	ADJACENT BUILDING	12/13/2020
241	MECHANICAL MEZZANINE	12/13/2020
242	PHARMACY	12/13/2020
243	BAKERY	12/13/2020
244	PRODUCE	12/13/2020
245	GROCERY	12/13/2020
246	BEVERAGE	12/13/2020
247	SNACKS	12/13/2020
248	FROZEN FOODS	12/13/2020
249	PETS	12/13/2020
250	BEAUTY	12/13/2020
251	WELLNESS	12/13/2020
252	MECHANICAL	12/13/2020
253	STORAGE	12/13/2020
254	RESTROOMS	12/13/2020
255	OFFICE MEZZANINE	12/13/2020
256	ADJACENT BUILDING	12/13/2020
257	MECHANICAL MEZZANINE	12/13/2020
258	PHARMACY	12/13/2020
259	BAKERY	12/13/2020
260	PRODUCE	12/13/2020
261	GROCERY	12/13/2020
262	BEVERAGE	12/13/2020
263	SNACKS	12/13/2020
264	FROZEN FOODS	12/13/2020
265	PETS	12/13/2020
266	BEAUTY	12/13/2020
267	WELLNESS	12/13/2020
268	MECHANICAL	12/13/2020
269	STORAGE	12/13/2020
270	RESTROOMS	12/13/2020
271	OFFICE MEZZANINE	12/13/2020
272	ADJACENT BUILDING	12/13/2020
273	MECHANICAL MEZZANINE	12/13/2020
274	PHARMACY	12/13/2020
275	BAKERY	12/13/2020
276	PRODUCE	12/13/2020
277	GROCERY	12/13/2020
278	BEVERAGE	12/13/2020
279	SNACKS	12/13/2020
280	FROZEN FOODS	12/13/2020
281	PETS	12/13/2020
282	BEAUTY	12/13/2020
283	WELLNESS	12/13/2020
284	MECHANICAL	12/13/2020
285	STORAGE	12/13/2020
286	RESTROOMS	12/13/2020
287	OFFICE MEZZANINE	12/13/2020
288	ADJACENT BUILDING	12/13/2020
289	MECHANICAL MEZZANINE	12/13/2020
290	PHARMACY	12/13/2020
291	BAKERY	12/13/2020
292	PRODUCE	12/13/2020
293	GROCERY	12/13/2020
294	BEVERAGE	12/13/2020
295	SNACKS	12/13/2020
296	FROZEN FOODS	12/13/2020
297	PETS	12/13/2020
298	BEAUTY	12/13/2020
299	WELLNESS	12/13/2020
300	MECHANICAL	12/13/2020
301	STORAGE	12/13/2020
302	RESTROOMS	12/13/2020
303	OFFICE MEZZANINE	12/13/2020
304	ADJACENT BUILDING	12/13/2020
305	MECHANICAL MEZZANINE	12/13/2020
306	PHARMACY	12/13/2020
307	BAKERY	12/13/2020
308	PRODUCE	12/13/2020
309	GROCERY	12/13/2020
310	BEVERAGE	12/13/2020
311	SNACKS	12/13/2020
312	FROZEN FOODS	12/13/2020
313	PETS	12/13/2020
314	BEAUTY	12/13/2020
315	WELLNESS	12/13/2020
316	MECHANICAL	12/13/2020
317	STORAGE	12/13/2020
318	RESTROOMS	12/13/2020
319	OFFICE MEZZANINE	12/13/2020
320	ADJACENT BUILDING	12/13/2020
321	MECHANICAL MEZZANINE	12/13/2020
322	PHARMACY	12/13/2020
323	BAKERY	12/13/2020
324	PRODUCE	12/13/2020
325	GROCERY	12/13/2020
326	BEVERAGE	12/13/2020
327	SNACKS	12/13/2020
328	FROZEN FOODS	12/13/2020
329	PETS	12/13/2020
330	BEAUTY	12/13/2020
331	WELLNESS	12/13/2020
332	MECHANICAL	12/13/2020
333	STORAGE	12/13

