

SYMBOLS (NOT ALL USED)


ABBREVIATIONS (NOT ALL USED)

GENERAL NOTES


MECHANICAL NOTES

CODES AND STANDARDS


GENERAL

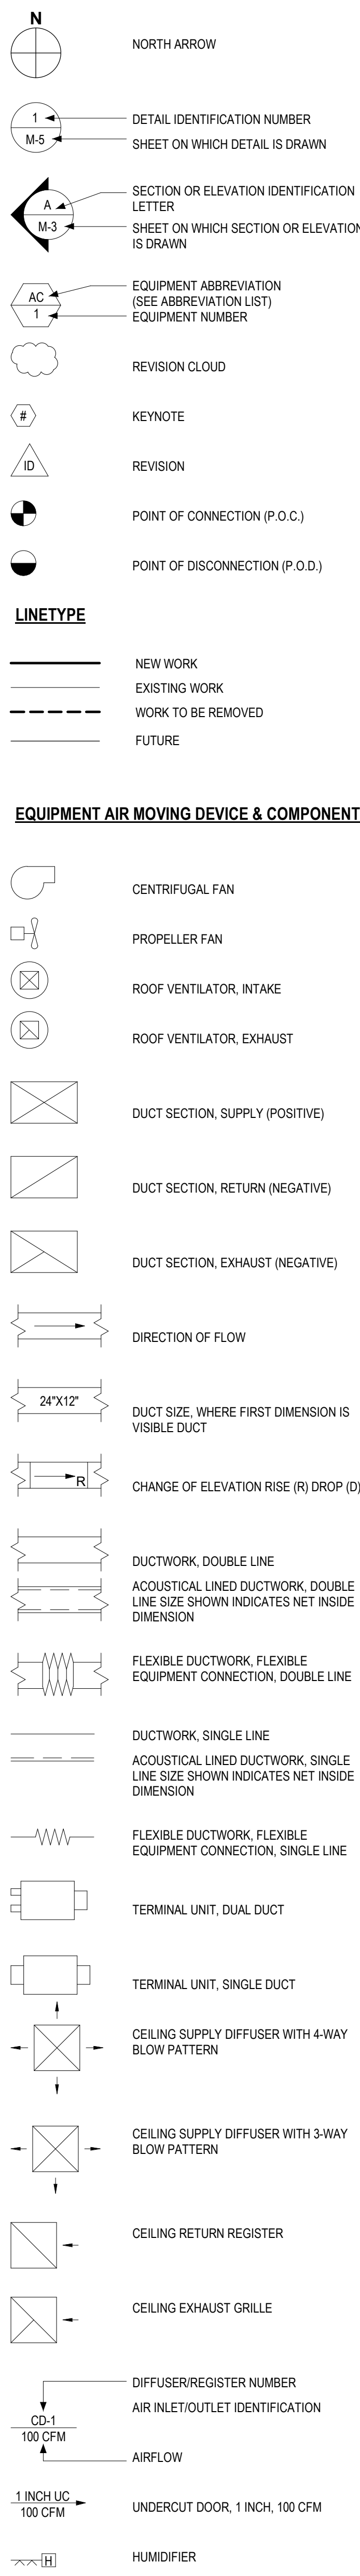


DUCT ACCESSORIES & CONTROLS INSTRUMENTATION

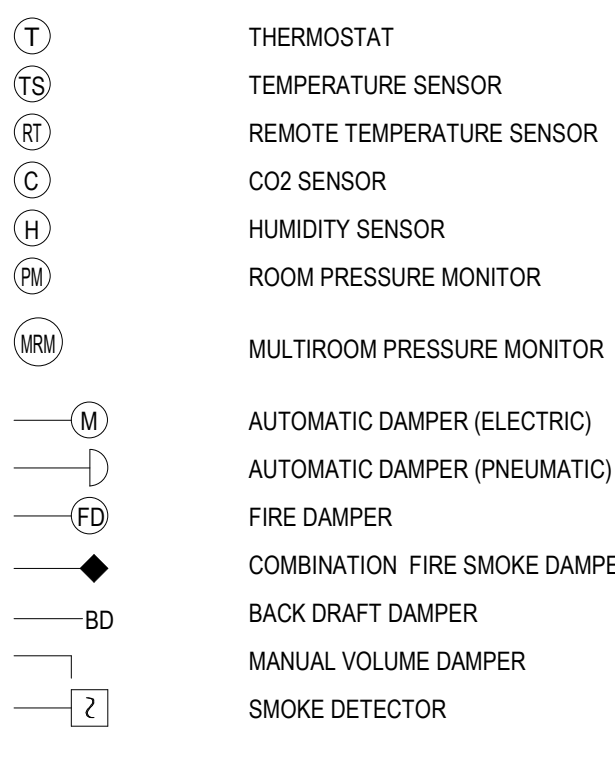


PIPING

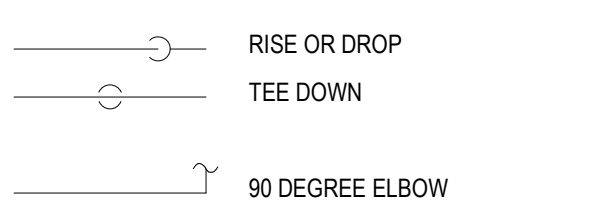


SLOPE

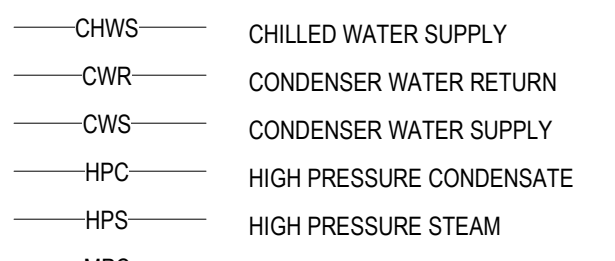

EQUIPMENT AIR MOVING DEVICE & COMPONENTS

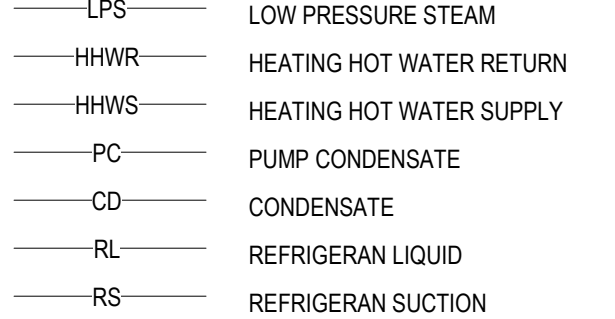

VALVES

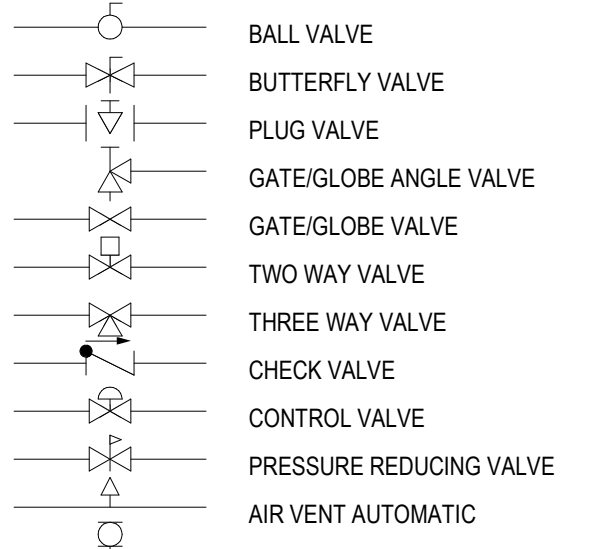

FITTING & PIPING SPECIALTIES

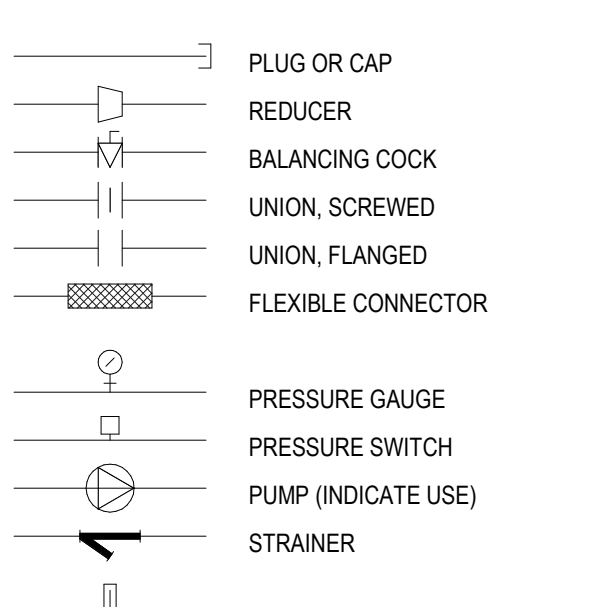


Table of abbreviations: AFF (Above Finished Floor), AHU (Air Handling Unit), AL (Aluminum), AMB (Ambient), ARCH (Architectural), BDD (Backdraft Damper), BHP (Brake Horsepower), BMS (Building Management System), BTU (British Thermal Unit), BTUH (BTU per Hour), °C (Degrees Centigrade), CBC (California Building Code), CC (Cooling Coil), CD (Ceiling Diffuser), CDD (Condensate Drain), CFC (California Fire Code), CFM (Cubic Foot/Minute), CFM2 (Combination Fire/Smoke Damper), CG (Ceiling Grille), CHWP (Chilled Water Pump), CHWR (Chilled Water Return), CHWS (Chilled Water Supply), CLG (Ceiling), CMC (California Mechanical Code), COND (Condensate), CONN (Connection), CONT (Continuation), CR (Ceiling Return), CU FT (Cubic Feet), CU IN (Cubic Inches), DN (Down), DWG (Drawing), EA (Exhaust Air), EAT (Entering Air Temperature), EDB (Entering Dry Bulb Temperature), EES (Energy Efficiency Standard), EF (Exhaust Fan), EL (Elevation), ELEC (Electrical), ENT (Entering), EQPM (Equipment), ESP (External Static Pressure), EWB (Entering Wet Bulb Temperature), EWT (Entering Water Temperature), EXH (Exhaust), °F (Degrees Fahrenheit), FD (Fire Damper), FF (Final Filter), FLA (Full Load Amperes), FLR (Floor), FLX (Flexible Connection), FPM (Feet per Minute), FPS (Feet per Second), FT (Feet), GA (Gauge), GAL (Gallon), GC (General Contractor), GPH (Gallon per Hour), GPM (Gallon per Minute), HGHT (Height), HC (Heating Coil), HD (Hot Deck/Hot Duct), HHWR (Heating Hot Water Return), HHWS (Heating Hot Water Supply), KW (Kilowatt), L (Length), LD (Lined Ductwork), LAT (Leaving Air Temperature), LBS (Pounds), LBD (Leaving Dry Bulb Temperature), LN FT (Leaving Linear Feet), LNV (Leaving), LWB (Leaving Wet Bulb Temperature), LWT (Leaving Water Temperature), MAX (Maximum), MB (Mixing Box), MBH (Thousand BTU per Hour), MIN (Minimum), MUA (Make-up Air), INCT (In Contact), NOT (Not to Scale), NTS (Noted), OSA/OA (Outside Air), OD (Outside Diameter), POC (Point of Connection), PDD (Point of Disconnection), RA (Return Air), RG (Return Grille), RGS (Refrigeration Gas Line), RH (Reheat Coil), RLS (Refrigeration Gas Line), RM (Room), RPM (Revolutions per Minute), SA (Supply Air), SF (Supply Fan), SHOT (Shut Off Valve), SP (Static Pressure), SPEC (Specification), SQ FT (Square Foot), SS (Stainless Steel), TA (Transfer Air), TF (Transfer Fan), TG (Transfer Grille), TV (Turning Vanes), UN (Unless Otherwise Noted), UTR (Through Roof), V (Volts), VAV (Variable Air Volume), VD (Volume Damper), VENT (Ventilation Air), W (Width), WI (With), W/O (Without), WB (Wet Bulb), WC (Water Column), WG (Water Gauge), WM (Wire Mesh Screen).

1. ALL WORK, INSTALLATION, AND MATERIALS SHALL COMPLY WITH ALL CURRENT GOVERNING CODES, BUILDING STANDARDS, REGULATIONS, SPECIFICATIONS, AND ALL OTHER REQUIREMENTS OF THE AUTHORITIES HAVING JURISDICTION. WHERE REQUIREMENTS BETWEEN THESE VARY, THE MOST STRINGENT SHALL APPLY.

2. ALL WORK SHALL BE PERMITTED. CONTRACTOR SHALL OBTAIN AND PAY FOR ALL REQUIRED PERMITS, FEES, AND LICENSES, UNLESS OTHERWISE DEFINED BY OWNER.

3. CONTRACTOR SHALL EXAMINE THE COMPLETE SET OF DRAWINGS AND SPECIFICATIONS FOR ALL TRADES PRIOR TO SUBMITTING AND START OF WORK.

4. CONTRACTOR SHALL VISIT THE SITE PRIOR TO BID AND THOROUGHLY FAMILIARIZE THEMSELVES WITH THE EXISTING FIELD CONDITIONS, INCLUDING BUT NOT LIMITED TO DIMENSIONS, THE EXISTING INSTALLATIONS, POINTS OF DISCONTINUITY, AND REQUIRED CLEARANCES. CONTRACTOR SHALL MAKE ANY MINOR ADJUSTMENTS NECESSARY TO AVOID CONFLICTS WITH THE BUILDING STRUCTURE AND THE WORK OF OTHER TRADES. THIS SHALL BE VERIFIED PRIOR TO BID SUBMITTAL. START OF CONSTRUCTION AND/OR FABRICATION OF MATERIALS, BY THE ACT OF SUBMITTING A BID, THE CONTRACTOR ACCEPTS THE GIVEN WORKING CONDITIONS.

5. IF DISCREPANCIES ARE ENCOUNTERED BETWEEN THE DRAWINGS, BUILDING STANDARDS, SPECIFICATIONS, AND/OR CURRENT CONDITIONS, THE ENGINEER AND ARCHITECT SHALL BE NOTIFIED WITH A REQUEST FOR CLARIFICATION, AND THE OWNER SHALL BE NOTIFIED IN WRITING PRIOR TO COMMENCEMENT OF WORK. IF WORK IS DONE WITHOUT WRITTEN APPROVAL FROM OWNER REPRESENTATIVE, THE WORK SHALL BE CONSIDERED AT-RISK, AND A NON-COMFORMABLE INSTALLATION.

6. ALL DRAWINGS AND LAYOUTS ARE DIAGRAMMATIC TO SHOW DESIGN INTENT ONLY. CONTRACTOR SHALL COORDINATE NEW WORK WITH THE WORK OF ALL OTHER TRADES AND EXISTING CONDITIONS. IT SHALL BE THE CONTRACTOR'S RESPONSIBILITY TO INSTALL ALL WORK IN SUCH A MANNER AS TO AVOID OBSTRUCTIONS, PRESERVE HEADROOM, KEEP OPENINGS AND PASSAGEWAYS CLEAR, AND MAKE ALL EQUIPMENT REQUIRING INSPECTION, MAINTENANCE, AND REPAIR ACCESSIBLE WITHOUT EXTRA COST TO THE OWNER. NO CONSIDERATION SHALL BE GRANTED DUE TO LACK OF FAMILIARITY ON THE PART OF THE CONTRACTOR WITH ACTUAL PHYSICAL CONDITIONS, REQUIREMENTS, AND PRACTICES AT THE SITE.

7. SUBMIT ELECTRONIC PDF COPIES OF SUBMITTAL DOCUMENTS WITH DESCRIPTIVE DATA AND PROJECT-SPECIFIC PERFORMANCE FOR ALL PRODUCTS AND MATERIALS PROPOSED FOR THE PROJECT. CLEARLY INDICATE EXACT MAKE/MODEL, INCLUDING ANY ACCESSORIES AND OPTIONS PROPOSED. SHOP DRAWINGS AT THE SAME SCALE AS THE CONSTRUCTION DOCUMENTS OR LARGER SHALL BE INCLUDED WITH SUBMITTALS AS REQUIRED. HARD COPY SUBMITTALS WILL NOT BE ACCEPTED. ALLOW A MINIMUM OF FIVE (5) WORKING DAYS FOR ENGINEER TO REVIEW SUBMITTALS. SUBMITTALS SHALL BE FOR A COMPLETE SYSTEM AND NOT A PARTIAL REPRESENTATION OF A SYSTEM.

8. SUBMIT REQUEST FOR INFORMATION (RFI) IN ELECTRONIC PDF FORMAT WITH PROPOSED SOLUTION INCLUDED, IF APPLICABLE. ALLOW MINIMUM OF THREE (3) WORKING DAYS FOR ENGINEER TO REVIEW AND RESPOND.

9. PREPARE COORDINATED SHOP DRAWINGS WITH ALL TRADES, INCLUDING BUT NOT LIMITED TO MECHANICAL, PLUMBING, ELECTRICAL, FIRE PROTECTION, STRUCTURAL, ETC. SHOP DRAWINGS SHALL BE SUBMITTED FOR APPROVAL PRIOR TO INSTALLATION OF NEW/LOCATED COMPONENTS. CONTRACTOR SHALL NOT USE THE ENGINEERED CAD FILES AS SHOP DRAWINGS. SHOP DRAWINGS SHALL CONFORM TO ALL SECTIONS OF AIA 201.

10. CONTRACTOR SHALL COMPLY WITH ALL CONTRACT DOCUMENTS IN LAYING OUT AND INSTALLING THEIR WORK AND EQUIPMENT. PRIOR TO INSTALLATION, COORDINATE WORK WITH THE WORK OF ALL OTHER TRADES AND JOB CONDITIONS.

11. CONTRACTOR SHALL OBTAIN AND FOLLOW ALL LANDLORD/OVERSEER REQUIREMENTS, GUIDELINES, RULES, AND PROCEDURES FOR CONSTRUCTION. CONTRACTOR SHALL PROVIDE INSURANCE IN ACCORDANCE WITH THE BUILDING'S CERTIFICATE OF INSURANCE REQUIREMENTS.

12. IF ANY EQUIPMENT SUBMITTED BY THE CONTRACTOR IS DIFFERENT FROM THE BASIS OF DESIGN SPECIFIED, CHANGES SHALL BE SUBMITTED TO THE OWNER'S REPRESENTATIVE FOR APPROVAL. SUBMITTALS SHALL INDICATE ANY RESULTING CREDIT, ADDED COST, AND/OR ADJUSTMENT IN LEAD TIME. CONTRACTOR SHALL ALSO BE RESPONSIBLE FOR PAYMENT OF ALL CHARGES RESULTING FROM ADDITIONS OR CHANGES IN THE WORK OF OTHER TRADES THAT ARE NECESSARY TO ACCOMMODATE THE REQUESTED SUBSTITUTION, UNLESS APPROVED BY OWNER. CONTRACTOR WILL PROCEED AT THEIR OWN RISK IF CHANGES OCCUR WITHOUT PRIOR APPROVAL.

13. ALL PENETRATIONS OF DUCTWORK, PIPING, CONDUCITS, AND VENTS THROUGH FIRE, SMOKE, OR COMBINATION FIRE/SMOKE RATED BARRIERS SHALL HAVE FIRESTOP AND/OR SMOKE SEAL PROTECTION IN ACCORDANCE WITH THE STATE MINIMUM BUILDING CODE AND AUTHORITIES HAVING JURISDICTION. FIRESTOP AND SMOKE STOP PRODUCTS SHALL BE UL LISTED.

14. ALL PENETRATIONS OF DUCTWORK, PIPING, CONDUCITS, AND VENTS THROUGH NON-RATED CONSTRUCTION SHALL BE PROPERLY AND GENEROUSLY CAULKED WITH SOUND-RESISTANT AND NON-HARDENING MATERIAL, SUCH AS SILICONE.

15. COORDINATE WITH OWNER'S ROOFING CONTRACTOR PRIOR TO MAKING ANY PENETRATIONS THROUGH ROOF. ROOF WARRANTY SHALL BE MAINTAINED.

16. FLASHING, COUNTER-FLASHING, AND ROOF MEMBRANE PATCHES AT ALL ROOF OPENINGS SHALL MATCH AND BE IN ACCORDANCE WITH THE REQUIREMENTS OF THE EXISTING ROOFING SYSTEM.

17. PROVIDE GENERAL CONTRACTOR WITH FINAL SIZES AND LOCATIONS OF ALL WALL, FLOOR, AND ROOF PENETRATIONS TO COORDINATE REQUIRED STRUCTURAL FRAMING MEMBERS.

18. COORDINATE ALL CUTTING, DRILLING, PATCHING, AND REINFORCING REQUIRED FOR WORK WITH THE GENERAL CONTRACTOR.

19. PROVIDE ACCESS PANELS/DOORS FOR ALL EQUIPMENT LOCATED IN INACCESSIBLE AREAS, SUCH AS ABOVE HARD LID CEILING OR BEHIND WALLS. ALL ACCESS PANEL/DOOR LOCATIONS SHALL BE COORDINATED WITH ARCHITECT.

20. REQUIRED ACCESS AND WORKING SPACE CLEARANCES FOR ALL EQUIPMENT AND CONTROL DEVICES MUST BE MAINTAINED TO ALLOW READY AND SAFE OPERATION, EXAMINATION, AND MAINTENANCE. REQUIRED CLEARANCES SHALL BE PER MANUFACTURER'S RECOMMENDATION AND GOVERNING CODES.

21. CONTRACTOR SHALL SECURE SITE WHILE WORK IS IN PROGRESS AND UNTIL THE WORK IS ACCEPTED BY OWNER'S REPRESENTATIVE.

22. THE CONTRACTOR IS SOLELY RESPONSIBLE TO PROVIDE METHODS OF PROCEDURE AND PERFORM ALL CONSTRUCTION MEANS AND METHODS.

23. CONTRACTOR SHALL BE RESPONSIBLE FOR ANY DAMAGE, CAUSED BY THE WORK, TO EXISTING CONDITIONS OR THE WORK OF OTHER TRADES.

24. CONTRACTOR SHALL COORDINATE MOVEMENT AND STORAGE OF EQUIPMENT AND ALL OTHER COMPONENTS, INCLUDING TAKING ALL NECESSARY PRECAUTIONS TO COVER ALL EQUIPMENT COMPONENTS TO PROTECT THEM FROM EXPOSURE TO OUTDOOR ELEMENTS, CONDITIONS OUTSIDE OF MANUFACTURER'S STORAGE CONDITIONS, AND CONSTRUCTION DEBRIS, WHETHER OR NOT EQUIPMENT IS POWERED OR IN USE.

25. ALL MATERIALS SHALL BE NEW, BEAR THE UNDERWRITERS LABORATORIES (UL) OR EQUIVALENT TESTING AGENCY LABEL, AND BE APPROVED BY THE AUTHORITIES HAVING JURISDICTION. CONTRACTOR SHALL MAINTAIN RED-LINED AS-BUILT DRAWINGS DURING CONSTRUCTION TO DOCUMENT ALL CHANGES AND MODIFICATIONS TO THE CONTRACT DOCUMENTS. CONTRACTOR SHALL SUBMIT COMPLETE RED-LINED AS-BUILT DRAWINGS UPON COMPLETION OF THE WORK, FOR REVIEW BY THE ARCHITECT/ENGINEER.

26. FURNISH FINAL CERTIFICATE OF INSPECTION OR WRITTEN EVIDENCE OF ACCEPTANCE BY INSPECTION AUTHORITIES FOR ALL WORK INSTALLED.

27. CONTRACTOR SHALL BE RESPONSIBLE FOR MAINTAINING A CLEAN AND SAFE WORK ENVIRONMENT THROUGHOUT THE DURATION OF CONSTRUCTION. CONTRACTOR SHALL BE RESPONSIBLE FOR REMOVING ALL CONSTRUCTION DEBRIS, WITH ALL COSTS FOR DISPOSAL BORNE BY CONTRACTOR, UPON COMPLETION OF WORK. AREAS OF WORK SHALL BE LEFT IN A CLEAN CONDITION, ACCEPTABLE TO OWNER.

28. ALL CONSTRUCTION DEBRIS SHALL BE DISPOSED OF IN AN ENVIRONMENTALLY RESPONSIBLE FASHION. RECYCLABLE MATERIAL SHALL BE PROPERLY RECYCLED, AND HAZARDOUS MATERIALS SHALL BE DISPOSED OF WITH PROPER CHAIN OF CUSTODY.

29. ALL PLANS APPROVED BY GOVERNING AGENCIES SHALL BE KEPT IN A SECURE PLACE AND SHALL NOT BE USED BY WORKERS. CONTRACTOR SHALL FURNISH ALL SUBCONTRACTORS CONSTRUCTION SETS REFLECTING THE APPROVED PLANS. CONTRACTOR SHALL ALSO MAINTAIN IN GOOD CONDITION ONE COMPLETE SET OF PLANS WITH ALL REVISIONS, ADDENDA, AND CHANGE ORDERS. THIS COMPLETE SET SHALL REMAIN ON PREMISES AT ALL TIMES, UNDER CARE OF THE JOB SUPERINTENDENT.

30. CONTRACTOR SHALL PROVIDE A WRITTEN WARRANTY TO REPAIR OR REMEDY ALL FAULTY, IMPROPER, OR DEFECTIVE MATERIALS AND/OR CORRECT FAULTY INSTALLATION AT NO COST TO OWNER, INCLUDING PARTS AND LABOR, FOR A PERIOD OF ONE (1) YEAR FROM DATE OF OWNER'S WRITTEN ACCEPTANCE OF ALL WORK INSTALLED.

31. PROVIDE OWNER WITH OPERATION AND MAINTENANCE MANUALS, GUARANTEES, AND WARRANTIES FOR ALL EQUIPMENT INSTALLED IN THE PROJECT.

1. ALL DRAWINGS AND LAYOUTS ARE DIAGRAMMATIC TO SHOW DESIGN INTENT ONLY. LOCATIONS OF DUCTWORK, PIPING, AND EQUIPMENT ARE APPROXIMATE. DUCTPIPE OFFSETS, TRANSITIONS, SUPPORTS, AND HANGERS MAY NOT BE INDICATED. CONTRACTOR SHALL PROVIDE ALL TRANSITIONS AND FITTINGS NECESSARY TO CONNECT AND FLOOR AND CEILING SYSTEMS. IF FIELD CONDITIONS DIFFER SIGNIFICANTLY FROM THOSE SHOWN ON THE DRAWINGS AND AFFECT MECHANICAL WORK, INFORM ENGINEER OF RECORD IMMEDIATELY AND CONFIRM FURTHER BEFORE PROCEEDING WITH THE WORK IN THAT AREA.

2. DUE TO STRUCTURAL CONDITIONS, DUCTWORK OR PIPING INTERFERENCE EXISTING OBSTRUCTIONS, OR OTHER REASONS, THE CONTRACTOR MAY WANT TO INSTALL WORK IN A MANNER DIFFERENT FROM THAT SHOWN IN THE CONTRACT DOCUMENTS. SUCH CHANGES SHALL BE PRESENTED TO THE ENGINEER OF RECORD AND OWNER'S REPRESENTATIVE FOR APPROVAL BEFORE PROCEEDING, AND THE RECORD DRAWING SHALL BE ACCURATELY REVISED TO SHOW THE CHANGES AS COMPLETED.

3. ALL DUCT DIMENSIONS SHOWN ON DRAWINGS ARE NET CLEAR INSIDE DIMENSIONS AFTER INSULATION/LINING HAS BEEN INSTALLED.

4. PIPING ANCHORAGE, SUPPORT, AND THERMAL EXPANSION DEVICES ARE TO BE PROVIDED BY THE CONTRACTOR TO MEET ALL CODE REQUIREMENTS. PIPING SUPPORTS AND THERMAL EXPANSION DEVICES SHALL BE INCORPORATED INTO THE SHOP DRAWINGS. SHOP DRAWINGS SHALL BE SUBMITTED TO THE STRUCTURAL ENGINEER FOR APPROVAL.

5. ALL DUCTWORK AND PIPING SHALL BE ROUTED TIGHT TO STRUCTURE.

6. WHERE DEMOLITION IS NOT ALLOWED FOR MAINTAINING EXISTING HVAC SERVICE, CONTRACTOR SHALL PROVIDE TEMPORARY COOLING AND/OR HEATING WITH SUFFICIENT CAPACITY TO MAINTAIN COMFORT COOLING AND/OR HEATING, AT NO ADDITIONAL COST TO OWNER.

7. DUCTWORK, PIPING, AND FITTINGS SHALL CONFORM TO THE REQUIREMENTS OF THE WORKING PRESSURES INDICATED IN THE SPECIFICATIONS.

8. ALL DUCTWORK SHALL BE CONSTRUCTED, ERECTED, AND TESTED IN ACCORDANCE WITH THE MOST RESTRICTIVE OF LOCAL REGULATIONS AND PROCEDURES DETAILED IN THE ASHRAE HANDBOOK OF FUNDAMENTALS AND THE ASHRAE STANDARDS ADOPTED BY SMACNA. PROVIDE RECTANGULAR DUCTS OF GALVANIZED STEEL AND PREFABRICATED SPIRAL LOCKSEAM DUCTS AND FITTINGS.

9. DUCTWORK SHALL BE CONSTRUCTED AND INSTALLED IN ACCORDANCE WITH CHAPTER 6 OF THE CMC.

10. AT THE TIME OF ROUGH INSTALLATION AND DURING STORAGE ON THE CONSTRUCTION SITE, ALL DUCT AND OTHER RELATED AIR DISTRIBUTION COMPONENT OPENINGS SHALL BE COVERED WITH TAPE, PLASTIC, SHEET METAL, OR OTHER METHODS ACCEPTABLE TO THE ENFORCING AGENCY TO REDUCE THE AMOUNT OF DUST, WATER, AND DEBRIS WHICH MAY ENTER THE SYSTEM.

11. ALL PIPING AND ASSOCIATED FITTINGS AND VALVES SHALL BE OF SIMILAR MATERIAL PER CODE, UNLESS APPROVED OTHERWISE. DISSIMILAR MATERIALS SHALL BE CONNECTED OR FASTENED BY DIELECTRIC MEANS APPROPRIATE.

12. ALL PIPING AND DUCTWORK SHALL BE INSULATED CONSISTENT WITH THE REQUIREMENTS IN SECTIONS 120.3 AND 120.4 OF THE BUILDING ENERGY EFFICIENCY STANDARDS AND CHAPTER 6 OF THE CMC.

13. FLEXIBLE CONNECTIONS SHALL BE PROVIDED AT ALL EQUIPMENT CONNECTIONS, UNLESS OTHERWISE NOTED.

14. ALL MECHANICAL EQUIPMENT PADS SHALL EXTEND A MINIMUM OF 6' BEYOND THE FOOTPRINT OF THE UNIT ON ALL SIDES. MECHANICAL EQUIPMENT PADS LOCATED ON THE ROOF SHALL BE A MINIMUM OF 8' HIGH FOR FLOOD PROTECTION.

15. SUPPORT ALL SUSPENDED MECHANICAL EQUIPMENT WITH FULLY THREADED RODS AND VIBRATION ISOLATORS PER THE ASHRAE HANDBOOK OF HVAC APPLICATIONS.

16. ALL SUSPENDED CEILING MECHANICAL FIXTURES SHALL BE SUPPORTED BY ADDITIONAL INDEPENDENT 12 GAGE WIRES ATTACHED TO EACH CORNER OF FIXTURES. (ASCE 7 SECTION 13.5.5.2, CISCA)

17. FIRE DAMPERS AND/OR SMOKE DAMPERS AND THE NECESSARY ACCESS PANELS SHALL BE PROVIDED FOR ALL DUCTS PENETRATING FIRE AND/OR SMOKE BARRIERS/PARTITIONS, AS REQUIRED BY CODE. SEE ARCHITECTURAL DRAWINGS FOR THE EXACT LOCATIONS OF FIRE AND/OR SMOKE RATED BARRIERS/PARTITIONS.

18. SMOKE DETECTORS AND REMOTE ANNUNCIATOR ARE SUPPLIED BY MECHANICAL CONTRACTOR. SMOKE DETECTORS SHALL BE INSTALLED AND INTERLOCKED FOR SHUTDOWN IN ACCORDANCE WITH DIVISION 23. SEE SPECIFICATIONS.

19. ALL DUCT SMOKE DETECTORS INDICATED ON MECHANICAL DRAWINGS ARE FOR REFERENCE ONLY AND SHALL BE FURNISHED, INSTALLED AND WIRED UNDER ELECTRICAL WORK DIVISION "20000" OF SPECIFICATIONS.

20. MATERIALS EXPOSED WITHIN DUCTWORK OR PIPINGS SHALL HAVE A MAXIMUM FLAME SPREAD INDEX OF 25 AND A MAXIMUM SMOKE DEVELOPMENT RATING OF 50, WHEN TESTED IN ACCORDANCE WITH ASTM E84.

21. ALL NEW THERMOSTATS SHALL COMPLY WITH THE LATEST BUILDING ENERGY EFFICIENCY STANDARDS REFERENCE JOINT APPENDIX JAS.

22. ROOM THERMOSTATS SHALL BE CAPABLE OF BEING SET TO MAINTAIN SPACE TEMPERATURE SET POINTS FROM 55°F TO 85°F AND BE CAPABLE OF OPERATING THE HEATING AND COOLING IN SEQUENCE. THERMOSTATS SHALL BE ADJUSTABLE TO PROVIDE A TEMPERATURE RANGE OF UP TO 10°F BETWEEN HEATING AND COOLING SETPOINTS. CONTROLS SHALL HAVE CAPABILITY OF LIMITING HEATING SETPOINT ADJUSTMENT TO A MAXIMUM OF 70°F AND LIMITING COOLING SETPOINT ADJUSTMENT TO A MINIMUM OF 78°F.

23. THERMOSTATS SHALL BE LOCATED PER CBC FOR ADA COMPLIANCE AND CENTERED DIRECTLY ABOVE LIGHT SWITCHES UNLESS OTHERWISE NOTED. COORDINATE WITH ARCHITECT PRIOR TO INSTALLATION.

24. CO SENSORS SHALL BE LOCATED BETWEEN 3 TO 6' AFF. COORDINATE WITH ARCHITECT PRIOR TO INSTALLATION.

25. CONTRACTOR SHALL COORDINATE ALL NEW EQUIPMENT DESIGNATIONS WITH OWNER.

26. PROVIDE STEEL SUPPORTS FOR ALL WORK AS REQUIRED FOR A COMPLETE INSTALLATION IN ACCORDANCE WITH APPLICABLE CODES AND STANDARDS. PROVIDE SUPPLEMENTARY FRAMING AS REQUIRED FOR ATTACHMENT OF HANGERS, SUPPORTS, AND ANCHORS. DESIGN SUPPLEMENTAL FRAMING UNDER DIRECT SUPERVISION OF STRUCTURAL ENGINEER LICENSED IN THE STATE OF CALIFORNIA AND SUBMIT FOR ARCHITECT/ENGINEER REVIEW.

27. CONTRACTOR SHALL COORDINATE AND PROVIDE STRUCTURAL MOUNTING FOR ALL EQUIPMENT SHOWN ON THE PLANS OR SPECIFIED, INCLUDING THOSE SHOWN SPECIFICALLY ON THE DETAIL SHEETS).

28. CONTRACTOR SHALL COORDINATE VOLTAGE AND PHASE OF EACH PIECE OF EQUIPMENT REQUIRING POWER WITH THE ELECTRICAL CONTRACTOR.

29. PROVIDE MANUAL BALANCING DAMPER AT EACH SUPPLY/RETURN/EXHAUST BRANCH DUCT AS FAR FROM AIR INLET/OUTLET AS POSSIBLE. PROVIDE MANUAL BALANCING DAMPER WITH REMOTE CONTROL WHEN IS LOCATED ABOVE GYPOBOARD CEILING.

30. ALL BRANCH DUCT SIZES SHALL MATCH AIR INLET/OUTLET NECK SIZE UN.

1. ALL DRAWINGS AND LAYOUTS ARE DIAGRAMMATIC TO SHOW DESIGN INTENT ONLY. LOCATIONS OF DUCTWORK, PIPING, AND EQUIPMENT ARE APPROXIMATE. DUCTPIPE OFFSETS, TRANSITIONS, SUPPORTS, AND HANGERS MAY NOT BE INDICATED. CONTRACTOR SHALL PROVIDE ALL TRANSITIONS AND FITTINGS NECESSARY TO CONNECT AND FLOOR AND CEILING SYSTEMS. IF FIELD CONDITIONS DIFFER SIGNIFICANTLY FROM THOSE SHOWN ON THE DRAWINGS AND AFFECT MECHANICAL WORK, INFORM ENGINEER OF RECORD IMMEDIATELY AND CONFIRM FURTHER BEFORE PROCEEDING, AND THE RECORD DRAWING SHALL BE ACCURATELY REVISED TO SHOW THE CHANGES AS COMPLETED.

2. DUE TO STRUCTURAL CONDITIONS, DUCTWORK OR PIPING INTERFERENCE EXISTING OBSTRUCTIONS, OR OTHER REASONS, THE CONTRACTOR MAY WANT TO INSTALL WORK IN A MANNER DIFFERENT FROM THAT SHOWN IN THE CONTRACT DOCUMENTS. SUCH CHANGES SHALL BE PRESENTED TO THE ENGINEER OF RECORD AND OWNER'S REPRESENTATIVE FOR APPROVAL BEFORE PROCEEDING, AND THE RECORD DRAWING SHALL BE ACCURATELY REVISED TO SHOW THE CHANGES AS COMPLETED.

3. ALL DUCT DIMENSIONS SHOWN ON DRAWINGS ARE NET CLEAR INSIDE DIMENSIONS AFTER INSULATION/LINING HAS BEEN INSTALLED.

4. PIPING ANCHORAGE, SUPPORT, AND THERMAL EXPANSION DEVICES ARE TO BE PROVIDED BY THE CONTRACTOR TO MEET ALL CODE REQUIREMENTS. PIPING SUPPORTS AND THERMAL EXPANSION DEVICES SHALL BE INCORPORATED INTO THE SHOP DRAWINGS. SHOP DRAWINGS SHALL BE SUBMITTED TO THE STRUCTURAL ENGINEER FOR APPROVAL.

5. ALL DUCTWORK AND PIPING SHALL BE ROUTED TIGHT TO STRUCTURE.

6. WHERE DEMOLITION IS NOT ALLOWED FOR MAINTAINING EXISTING HVAC SERVICE, CONTRACTOR SHALL PROVIDE TEMPORARY COOLING AND/OR HEATING WITH SUFFICIENT CAPACITY TO MAINTAIN COMFORT COOLING AND/OR HEATING, AT NO ADDITIONAL COST TO OWNER.

7. DUCTWORK, PIPING, AND FITTINGS SHALL CONFORM TO THE REQUIREMENTS OF THE WORKING PRESSURES INDICATED IN THE SPECIFICATIONS.

8. ALL DUCTWORK SHALL BE CONSTRUCTED, ERECTED, AND TESTED IN ACCORDANCE WITH THE MOST RESTRICTIVE OF LOCAL REGULATIONS AND PROCEDURES DETAILED IN THE ASHRAE HANDBOOK OF FUNDAMENTALS AND THE ASHRAE STANDARDS ADOPTED BY SMACNA. PROVIDE RECTANGULAR DUCTS OF GALVANIZED STEEL AND PREFABRICATED SPIRAL LOCKSEAM DUCTS AND FITTINGS.

9. DUCTWORK SHALL BE CONSTRUCTED AND INSTALLED IN ACCORDANCE WITH CHAPTER 6 OF THE CMC.

10. AT THE TIME OF ROUGH INSTALLATION AND DURING STORAGE ON THE CONSTRUCTION SITE, ALL DUCT AND OTHER RELATED AIR DISTRIBUTION COMPONENT OPENINGS SHALL BE COVERED WITH TAPE, PLASTIC, SHEET METAL, OR OTHER METHODS ACCEPTABLE TO THE ENFORCING AGENCY TO REDUCE THE AMOUNT OF DUST, WATER, AND DEBRIS WHICH MAY ENTER THE SYSTEM.

11. ALL PIPING AND ASSOCIATED FITTINGS AND VALVES SHALL BE OF SIMILAR MATERIAL PER CODE, UNLESS APPROVED OTHERWISE. DISSIMILAR MATERIALS SHALL BE CONNECTED OR FASTENED BY DIELECTRIC MEANS APPROPRIATE.

12. ALL PIPING AND DUCTWORK SHALL BE INSULATED CONSISTENT WITH THE REQUIREMENTS IN SECTIONS 120.3 AND 120.4 OF THE BUILDING ENERGY EFFICIENCY STANDARDS AND CHAPTER 6 OF THE CMC.

13. FLEXIBLE CONNECTIONS SHALL BE PROVIDED AT ALL EQUIPMENT CONNECTIONS, UNLESS OTHERWISE NOTED.

14. ALL MECHANICAL EQUIPMENT PADS SHALL EXTEND A MINIMUM OF 6' BEYOND THE FOOTPRINT OF THE UNIT ON ALL SIDES. MECHANICAL EQUIPMENT PADS LOCATED ON THE ROOF SHALL BE A MINIMUM OF 8' HIGH FOR FLOOD PROTECTION.

15. SUPPORT ALL SUSPENDED MECHANICAL EQUIPMENT WITH FULLY THREADED RODS AND VIBRATION ISOLATORS PER THE ASHRAE HANDBOOK OF HVAC APPLICATIONS.

16. ALL SUSPENDED CEILING MECHANICAL FIXTURES SHALL BE SUPPORTED BY ADDITIONAL INDEPENDENT 12 GAGE WIRES ATTACHED TO EACH CORNER OF FIXTURES. (ASCE 7 SECTION 13.5.5.2, CISCA)

17. FIRE DAMPERS AND/OR SMOKE DAMPERS AND THE NECESSARY ACCESS PANELS SHALL BE PROVIDED FOR ALL DUCTS PENETRATING FIRE AND/OR SMOKE BARRIERS/PARTITIONS, AS REQUIRED BY CODE. SEE ARCHITECTURAL DRAWINGS FOR THE EXACT LOCATIONS OF FIRE AND/OR SMOKE RATED BARRIERS/PARTITIONS.

18. SMOKE DETECTORS AND REMOTE ANNUNCIATOR ARE SUPPLIED BY MECHANICAL CONTRACTOR. SMOKE DETECTORS SHALL BE INSTALLED AND INTERLOCKED FOR SHUTDOWN IN ACCORDANCE WITH DIVISION 23. SEE SPECIFICATIONS.

19. ALL DUCT SMOKE DETECTORS INDICATED ON MECHANICAL DRAWINGS ARE FOR REFERENCE ONLY AND SHALL BE FURNISHED, INSTALLED AND WIRED UNDER ELECTRICAL WORK DIVISION "20000" OF SPECIFICATIONS.

20. MATERIALS EXPOSED WITHIN DUCTWORK OR PIPINGS SHALL HAVE A MAXIMUM FLAME SPREAD INDEX OF 25 AND A MAXIMUM SMOKE DEVELOPMENT RATING OF 50, WHEN TESTED IN ACCORDANCE WITH ASTM E84.

21. ALL NEW THERMOSTATS SHALL COMPLY WITH THE LATEST BUILDING ENERGY EFFICIENCY STANDARDS REFERENCE JOINT APPENDIX JAS.

22. ROOM THERMOSTATS SHALL BE CAPABLE OF BEING SET TO MAINTAIN SPACE TEMPERATURE SET POINTS FROM 55°F TO 85°F AND BE CAPABLE OF OPERATING THE HEATING AND COOLING IN SEQUENCE. THERMOSTATS SHALL BE ADJUSTABLE TO PROVIDE A TEMPERATURE RANGE OF UP TO 10°F BETWEEN HEATING AND COOLING SETPOINTS. CONTROLS SHALL HAVE CAPABILITY OF LIMITING HEATING SETPOINT ADJUSTMENT TO A MAXIMUM OF 70°F AND LIMITING COOLING SETPOINT ADJUSTMENT TO A MINIMUM OF 78°F.

23. THERMOSTATS SHALL BE LOCATED PER CBC FOR ADA COMPLIANCE AND CENTERED DIRECTLY ABOVE LIGHT SWITCHES UNLESS OTHERWISE NOTED. COORDINATE WITH ARCHITECT PRIOR TO INSTALLATION.

24. CO SENSORS SHALL BE LOCATED BETWEEN 3 TO 6' AFF. COORDINATE WITH ARCHITECT PRIOR TO INSTALLATION.

25. CONTRACTOR SHALL COORDINATE ALL NEW EQUIPMENT DESIGNATIONS WITH OWNER.

26. PROVIDE STEEL SUPPORTS FOR ALL WORK AS REQUIRED FOR A COMPLETE INSTALLATION IN ACCORDANCE WITH APPLICABLE CODES AND STANDARDS. PROVIDE SUPPLEMENTARY FRAMING AS REQUIRED FOR ATTACHMENT OF HANGERS, SUPPORTS, AND ANCHORS. DESIGN SUPPLEMENTAL FRAMING UNDER DIRECT SUPERVISION OF STRUCTURAL ENGINEER LICENSED IN THE STATE OF CALIFORNIA AND SUBMIT FOR ARCHITECT/ENGINEER REVIEW.

27. CONTRACTOR SHALL COORDINATE AND PROVIDE STRUCTURAL MOUNTING FOR ALL EQUIPMENT SHOWN ON THE PLANS OR SPECIFIED, INCLUDING THOSE SHOWN SPECIFICALLY ON THE DETAIL SHEETS).

28. CONTRACTOR SHALL COORDINATE VOLTAGE AND PHASE OF EACH PIECE OF EQUIPMENT REQUIRING POWER WITH THE ELECTRICAL CONTRACTOR.

29. PROVIDE MANUAL BALANCING DAMPER AT EACH SUPPLY/RETURN/EXHAUST BRANCH DUCT AS FAR FROM AIR INLET/OUTLET AS POSSIBLE. PROVIDE MANUAL BALANCING DAMPER WITH REMOTE CONTROL WHEN IS LOCATED ABOVE GYPOBOARD CEILING.

30. ALL BRANCH DUCT SIZES SHALL MATCH AIR INLET/OUTLET NECK SIZE UN.

- CALIFORNIA CODE OF REGULATIONS (CCR)
- TITLE 19: STATE FIRE MARSHAL REGULATIONS
- TITLE 20: CALIFORNIA CODE OF REGULATIONS
- TITLE 24: CALIFORNIA BUILDING STANDARDS CODE
- PART 2: 2019 CALIFORNIA BUILDING CODE (CBC)
- PART 3: 2019 CALIFORNIA ELECTRICAL CODE (CEC)
- PART 4: 2019 CALIFORNIA MECHANICAL CODE (CMC)
- PART 5: 2019 CALIFORNIA PLUMBING CODE (CPC)
- PART 6: 2019 CALIFORNIA FIRE CODE (CFC)
- PART 9: 2019 CALIFORNIA FIRE CODE (CFC)
- PART 12: 2019 CALIFORNIA REFERENCED STANDARDS
- AMERICAN SOCIETY OF HEATING, REFRIGERATING & AIR CONDITIONING ENGINEERS (ASHRAE) HANDBOOKS AND STANDARDS
- ASHRAE 2019 HANDBOOK, HVAC APPLICATIONS
- ASHRAE 2019 HANDBOOK, HVAC SYSTEMS AND APPLICATIONS
- ASHRAE 2021 HANDBOOK, FUNDAMENTALS
- ASHRAE 2018 HANDBOOK, REFRIGERATION
- AMERICAN SOCIETY OF MECHANICAL ENGINEERS (ASME) STANDARDS
- SHEET METAL AND AIR CONDITIONING CONTRACTORS NATIONAL ASSOCIATION (SMACNA) STANDARDS
- NATIONAL FIRE PROTECTION ASSOCIATION (NFPA) CODES AND STANDARDS
- NFPA 13: STANDARD FOR THE INSTALLATION OF SPRINKLER SYSTEMS, 2019
- NFPA 10: STANDARD FOR PORTABLE FIRE EXTINGUISHER, 2018
- NFPA 25: STANDARD FOR THE INSPECTION, TESTING, AND MAINTENANCE OF WATER-BASED FIRE PROTECTION SYSTEMS, 2017
- NFPA 70: NATIONAL ELECTRICAL CODE (NEC), 2017
- NFPA 72: NATIONAL FIRE ALARM AND SIGNALING CODE, 2019
- NFPA 101: LIFE SAFETY CODE, 2015
- NFPA 110: STANDARD FOR EMERGENCY AND STANDBY POWER SYSTEMS, 2019
- NFPA 111: STANDARD ON STORED ELECTRICAL ENERGY EMERGENCY AND STANDBY POWER SYSTEMS, 2019
- OCCUPATIONAL SAFETY AND HEALTH ADMINISTRATION (OSHA)
- ENVIRONMENTAL PROTECTION AGENCY (EPA)
- AMERICAN NATIONAL STANDARDS INSTITUTE (ANSI)
- UNDERWRITERS LABORATORY (UL)

zebra PROJECTS, INC. 14614 N KIERLAND BLVD, SUITE N 300 SCOTTSDALE, ARIZONA 85254 PHONE: 480.912.1169 www.zbr.co.uk

INFRASTRUCTURE FACTOR CONSULTING, INC. 2361 Rosecrans Ave, Suite 368, El Segundo, CA 90245 P: 310.725.1500 F: 310.725.0215 www.Factor.com

STORE NO: CA #1398

SHAKE SHACK SHAKE SHACK - KOREATOWN 376 WILSHIRE BLVD, LOS ANGELES, CA 90010

MECHANICAL SHEET INDEX

Table with columns: NO., MECHANICAL - NOTES, SYMBOLS AND ABBREVIATIONS, MECHANICAL - TITLE 24 FORMS, MECHANICAL OVERALL DEMOLITION 1ST FLOOR PLAN, MECHANICAL BASEMENT REMODEL PLAN, MECHANICAL FIRST FLOOR REMODEL PLAN, MECHANICAL PIPING FIRST FLOOR REMODEL PLAN, MECHANICAL THIRD FLOOR REMODEL PLAN, MECHANICAL SECTION, MECHANICAL DETAILS, MECHANICAL GREASE DUCT DETAILS, MECHANICAL FLUE VENTILATION AIR AND SUPPLEMENTAL DOCUMENTS, MECHANICAL SPECIFICATIONS, MECHANICAL AIRFLOW DIAGRAMS, MECHANICAL CONTROLS, MECHANICAL SCHEDULES, KITCHEN EQUIPMENT LIST, CAPTIVEFARE DRAWINGS, CAPTIVEFARE DRAWINGS, CAPTIVEFARE DRAWINGS, CAPTIVEFARE DRAWINGS, CAPTIVEFARE DRAWINGS, CAPTIVEFARE DRAWINGS, CAPTIVEFARE DRAWINGS, CAPTIVEFARE DRAWINGS, CAPTIVEFARE DRAWINGS.

DEMOLITION NOTES

1. ALL DEMOLITION SHALL BE PERFORMED IN ACCORDANCE WITH THE SPECIFICATIONS AND DRAWINGS.

2. THE CONTRACTOR SHALL FIELD SURVEY THE EXISTING CONDITIONS PRIOR TO STARTING ANY WORK.

3. DURING DEMOLITION, THE CONTRACTOR SHALL ALWAYS BE AWARE OF THE INTENDED FINAL RENOVATED CONDITIONS OF THE BUILDING AND THE REASON OF DEMOLITION WORK IS BEING DONE.

4. THE CONTRACTOR SHALL RESTORE TO ITS EXISTING CONDITION ANY EXISTING WORK DAMAGED DURING DEMOLITION INDICATED "EXISTING TO REMAIN" ON THE DRAWINGS.

5. THE CONTRACTOR SHALL TURN OVER ALL DEMOLISHED EQUIPMENT AND MATERIALS, OR DISPOSE AS DIRECTED BY THE OWNER. CONTRACTOR SHALL INCLUDE ANY DISPOSAL FEE AS REQUIRED AS PART OF THE BID.

6. PROVIDE TEMPORARY ENCLOSURE/PROTECTION/BARRICADES OR WARNING WHERE REQUIRED BY APPLICABLE SAFETY ORDINANCES PRIOR TO START OF DEMOLITION. REMOVE WHEN NO LONGER NEEDED.

7. CONTRACTOR SHALL DEMOLISH AS REQUIRED TO PROVIDE THE NEW LAYOUT ON THIS PLAN.

8. DEMOLISH ALL SERVICES BACK TO MAIN AND CAP AS APPLICABLE.

RESPONSIBILITY MATRIX

Table with columns: DESCRIPTION, FURNISHED, INSTALLED, REMARKS. Includes items like DIVISION 23: HEATING, VENTILATING, AND AIR CONDITIONING, 23.1.1. FLOOR SYSTEM, 23.1.2. FLOOR SYSTEM, 23.1.3. FLOOR SYSTEM, 23.1.99. FLOOR SYSTEM, 23.1.100. FLOOR SYSTEM.

REVISION table with columns: NO., DATE, DESCRIPTION. Includes revisions 1, 2, 3, 4.

STATUS: PERMIT/BID SET

PRELIMINARY: Preliminary Documents Are For Design Review only and not intended for construction. The contractor shall verify all dimensions and location of the project site and verify Zebra Projects, Inc. of any dimensional errors, or omissions or discrepancies before beginning or releasing any work. Do not scale these.



FIELD VERIFICATION: The contractor shall verify all signed dimensions and location of the project site and verify Zebra Projects, Inc. of any dimensional errors, or omissions or discrepancies before beginning or releasing any work. Do not scale these.

COPYRIGHT © 2021: Zebra Projects, Inc. shall retain all common law, statutory, and all other reserved rights. Neither the documents nor the information herein is to be reproduced, distributed, stored, or otherwise used without the written consent of Zebra Projects, Inc.

SHEET NAME: MECHANICAL - NOTES, SYMBOLS AND ABBREVIATIONS

DATE: 11/05/21 PROJECT NO: SHK-21-008

DRAWN: SK SCALE: As indicated

SHEET NO: M001

STORE NO:
 CA #1398

SHAKE SHACK
 SHAKE SHACK - KOREA TOWN
 3786 WILSHIRE BLVD. LOS ANGELES, CA 90010

REVISION	
DATE	DESCRIPTION
11/08/21	PERMIT/BID SET
A 01/26/22	REVISION A
T 07/01/22	REVISION 1
4 09/16/22	REVISION 4

STATUS:
 PERMIT/BID SET

PRELIMINARY:
 Preliminary Documents Are for Design Review only and not intended for permitting, permitting or construction purposes. They were prepared by or under the supervision of Zebra Projects, INC.



FIELD VERIFICATION:
 The contractor shall verify all signed dimensions and location at the project site and notify Zebra Projects, INC. of any dimensional errors, or omissions or discrepancies within beginning of fabricating any work. Do not scale these drawings.

COPYRIGHT © 2021:
 Zebra Projects, INC. shall retain all common law, statutory and all other reserved rights. Neither the documents nor the information herein is to be reproduced, distributed, disclosed or otherwise used without the written consent of Zebra Projects, INC.

SHEET NAME:
MECHANICAL TITLE 24 FORMS

DATE: 11/08/21 PROJECT NO: SHK-21-008
 DRAWN: SK SCALE: 12" = 1'-0"

SHEET NO:
M003

STATE OF CALIFORNIA
Mechanical Systems
 NRCC-MCH-E (Created 09/2020) CALIFORNIA ENERGY COMMISSION

CERTIFICATE OF COMPLIANCE
 Project Name: SHAKE SHACK KOREA TOWN Report Page: Page 10 of 13
 Project Address: 3786 WILSHIRE AVENUE, LOS ANGELES, CA 90010 Date Prepared: 11/02/2021

Form	Compliance	Field Inspector	Pass	Fail
NRCA-MCH-12-A FDD for Packaged Direct Expansion Units	<input checked="" type="radio"/>		<input type="checkbox"/>	<input type="checkbox"/>
NRCA-MCH-13-A Automatic FDD for Air Handling Units and Zone Terminal Units Acceptance	<input checked="" type="radio"/>		<input type="checkbox"/>	<input type="checkbox"/>
NRCA-MCH-14-A Distributed Energy Storage DX AC Systems Acceptance NOTE: This form does not automatically move to "Yes". If Distributed Energy Storage DX AC Systems are included in the scope, permit applicant should move this form to "Yes".	<input checked="" type="radio"/>		<input type="checkbox"/>	<input type="checkbox"/>
NRCA-MCH-15-A Thermal Energy Storage (TES) System Acceptance NOTE: This form does not automatically move to "Yes". If Chilled Water Storage, Ice-on-Cool Internal Melt, Ice-on-Cool External Melt, Ice Harvester, Brine, Ice Slurry, Eutectic Salt, Clathrate Hydrate Slurry (CHS), Cryogenic or Encapsulated (Ice Ball) Systems are included in the scope, permit applicant should move this form to "Yes".	<input checked="" type="radio"/>		<input type="checkbox"/>	<input type="checkbox"/>
NRCA-MCH-16-A Supply Air Temperature Reset Controls	<input checked="" type="radio"/>		<input type="checkbox"/>	<input type="checkbox"/>
NRCA-MCH-17-A Condenser Water Temperature Reset Controls	<input checked="" type="radio"/>		<input type="checkbox"/>	<input type="checkbox"/>
NRCA-MCH-18 Energy Management Control Systems	<input checked="" type="radio"/>		<input type="checkbox"/>	<input type="checkbox"/>
NRCA-MCH-19 Occupancy Sensor Controls	<input checked="" type="radio"/>		<input type="checkbox"/>	<input type="checkbox"/>
NRCA-MCH-20 Multi-Family Ventilation	<input checked="" type="radio"/>		<input type="checkbox"/>	<input type="checkbox"/>
NRCA-MCH-21 Multi-Family Envelope Leakage	<input checked="" type="radio"/>		<input type="checkbox"/>	<input type="checkbox"/>

CA Building Energy Efficiency Standards - 2019 Nonresidential Compliance: <http://www.energy.ca.gov/title24/2019standards> September 2020

STATE OF CALIFORNIA
Mechanical Systems
 NRCC-MCH-E (Created 09/2020) CALIFORNIA ENERGY COMMISSION

CERTIFICATE OF COMPLIANCE
 Project Name: SHAKE SHACK KOREA TOWN Report Page: Page 11 of 13
 Project Address: 3786 WILSHIRE AVENUE, LOS ANGELES, CA 90010 Date Prepared: 11/02/2021

P. DECLARATION OF REQUIRED CERTIFICATES OF VERIFICATION

Table Instructions: Selections have been made based on information provided in previous tables of this document. If any selection needs to be changed, please explain why in Table E. Additional Remarks: These documents must be completed by a HERS Rater and provided to the building inspector during construction. The final documents must be created by a HERS Providers registry, but drafts can be found online at https://www.energy.ca.gov/title24/2019standards/2019_compliance_documents/Nonresidential_Documents/NRCV/

YES	NO	Form/Title	Field Inspector	
			Pass	Fail
<input type="radio"/>	<input checked="" type="radio"/>	NRCV-MCH-04-H Duct Leakage Test NOTE: Must be completed by a HERS Rater	<input type="checkbox"/>	<input type="checkbox"/>
<input type="radio"/>	<input checked="" type="radio"/>	NRCV-MCH-24 Enclosure Air Leakage Worksheet NOTE: Must be completed by a HERS Rater	<input type="checkbox"/>	<input type="checkbox"/>
<input type="radio"/>	<input checked="" type="radio"/>	NRCV-MCH-27 High-rise Residential NOTE: Must be completed by a HERS Rater	<input type="checkbox"/>	<input type="checkbox"/>
<input type="radio"/>	<input checked="" type="radio"/>	NRCV-MCH-32 Local Mechanical Exhaust NOTE: Must be completed by a HERS Rater	<input type="checkbox"/>	<input type="checkbox"/>

CA Building Energy Efficiency Standards - 2019 Nonresidential Compliance: <http://www.energy.ca.gov/title24/2019standards> September 2020

STATE OF CALIFORNIA
Mechanical Systems
 NRCC-MCH-E (Created 09/2020) CALIFORNIA ENERGY COMMISSION

CERTIFICATE OF COMPLIANCE
 Project Name: SHAKE SHACK KOREA TOWN Report Page: Page 12 of 13
 Project Address: 3786 WILSHIRE AVENUE, LOS ANGELES, CA 90010 Date Prepared: 11/02/2021

Q. MANDATORY MEASURES DOCUMENTATION LOCATION

Table Instructions: Indicate where mandatory measures are documented in the plan set or construction documentation. For any mandatory measures that do not apply, mark the plan sheet or construction document location as "N/A", any active cells that are left blank will result in non-compliance in Table C.

Compliance with Mandatory Measures documented through MCH Mandatory Measures Note Block:	Yes	01	02
			Plan sheet or construction document location
			M001

CA Building Energy Efficiency Standards - 2019 Nonresidential Compliance: <http://www.energy.ca.gov/title24/2019standards> September 2020

STATE OF CALIFORNIA
Mechanical Systems
 NRCC-MCH-E (Created 09/2020) CALIFORNIA ENERGY COMMISSION

CERTIFICATE OF COMPLIANCE
 Project Name: SHAKE SHACK KOREA TOWN Report Page: Page 13 of 13
 Project Address: 3786 WILSHIRE AVENUE, LOS ANGELES, CA 90010 Date Prepared: 11/02/2021

DOCUMENTATION AUTHOR'S DECLARATION STATEMENT

1. I certify that this Certificate of Compliance documentation is accurate and complete.

Documentation Author Name: SAMANTHA KELLEY
 Company: INFRASTRUCTURE FACTOR CONSULTING INC.
 Address: 2361 ROSECRANS AVE
 City/State/Zip: EL SEGUNDO/CALIFORNIA/90245

Documentation Author Signature: *S.Kelley*
 Signature Date: 11/3/21
 CEA/ HERS Certification Identification (if applicable):
 Phone: (310) 725-1500

RESPONSIBLE PERSON'S DECLARATION STATEMENT

1. I certify the following under penalty of perjury, under the laws of the State of California: The information provided on this Certificate of Compliance is true and correct.

2. I am eligible under Division 3 of the Business and Professions Code to accept responsibility for the building design or system design identified on this Certificate of Compliance (responsible designer)

3. The energy features and performance specifications, materials, components, and manufactured devices for the building design or system design identified on this Certificate of Compliance conform to the requirements of Title 24, Part 1 and Part 6 of the California Code of Regulations.


4. The building design features or system design features identified on this Certificate of Compliance are consistent with the information provided on other applicable compliance documents, worksheets, calculations, plans and specifications submitted to the enforcement agency for approval with this building permit application.

5. I will ensure that a completed signed copy of this Certificate of Compliance shall be made available with the building permit(s) issued for the building, and made available to the enforcement agency for all applicable inspections. I understand that a completed signed copy of this Certificate of Compliance is required to be included with the documentation the builder provides to the building owner at occupancy.

Responsible Designer Name: OTHON ESTRADA
 Company: INFRASTRUCTURE FACTOR CONSULTING INC.
 Address: 2361 ROSECRANS AVE
 City/State/Zip: EL SEGUNDO/CALIFORNIA/90245

Responsible Designer Signature: *O. Estrada*
 Date Signed: 11/3/21
 License: M36244
 Phone: (310) 725-1500

CA Building Energy Efficiency Standards - 2019 Nonresidential Compliance: <http://www.energy.ca.gov/title24/2019standards>

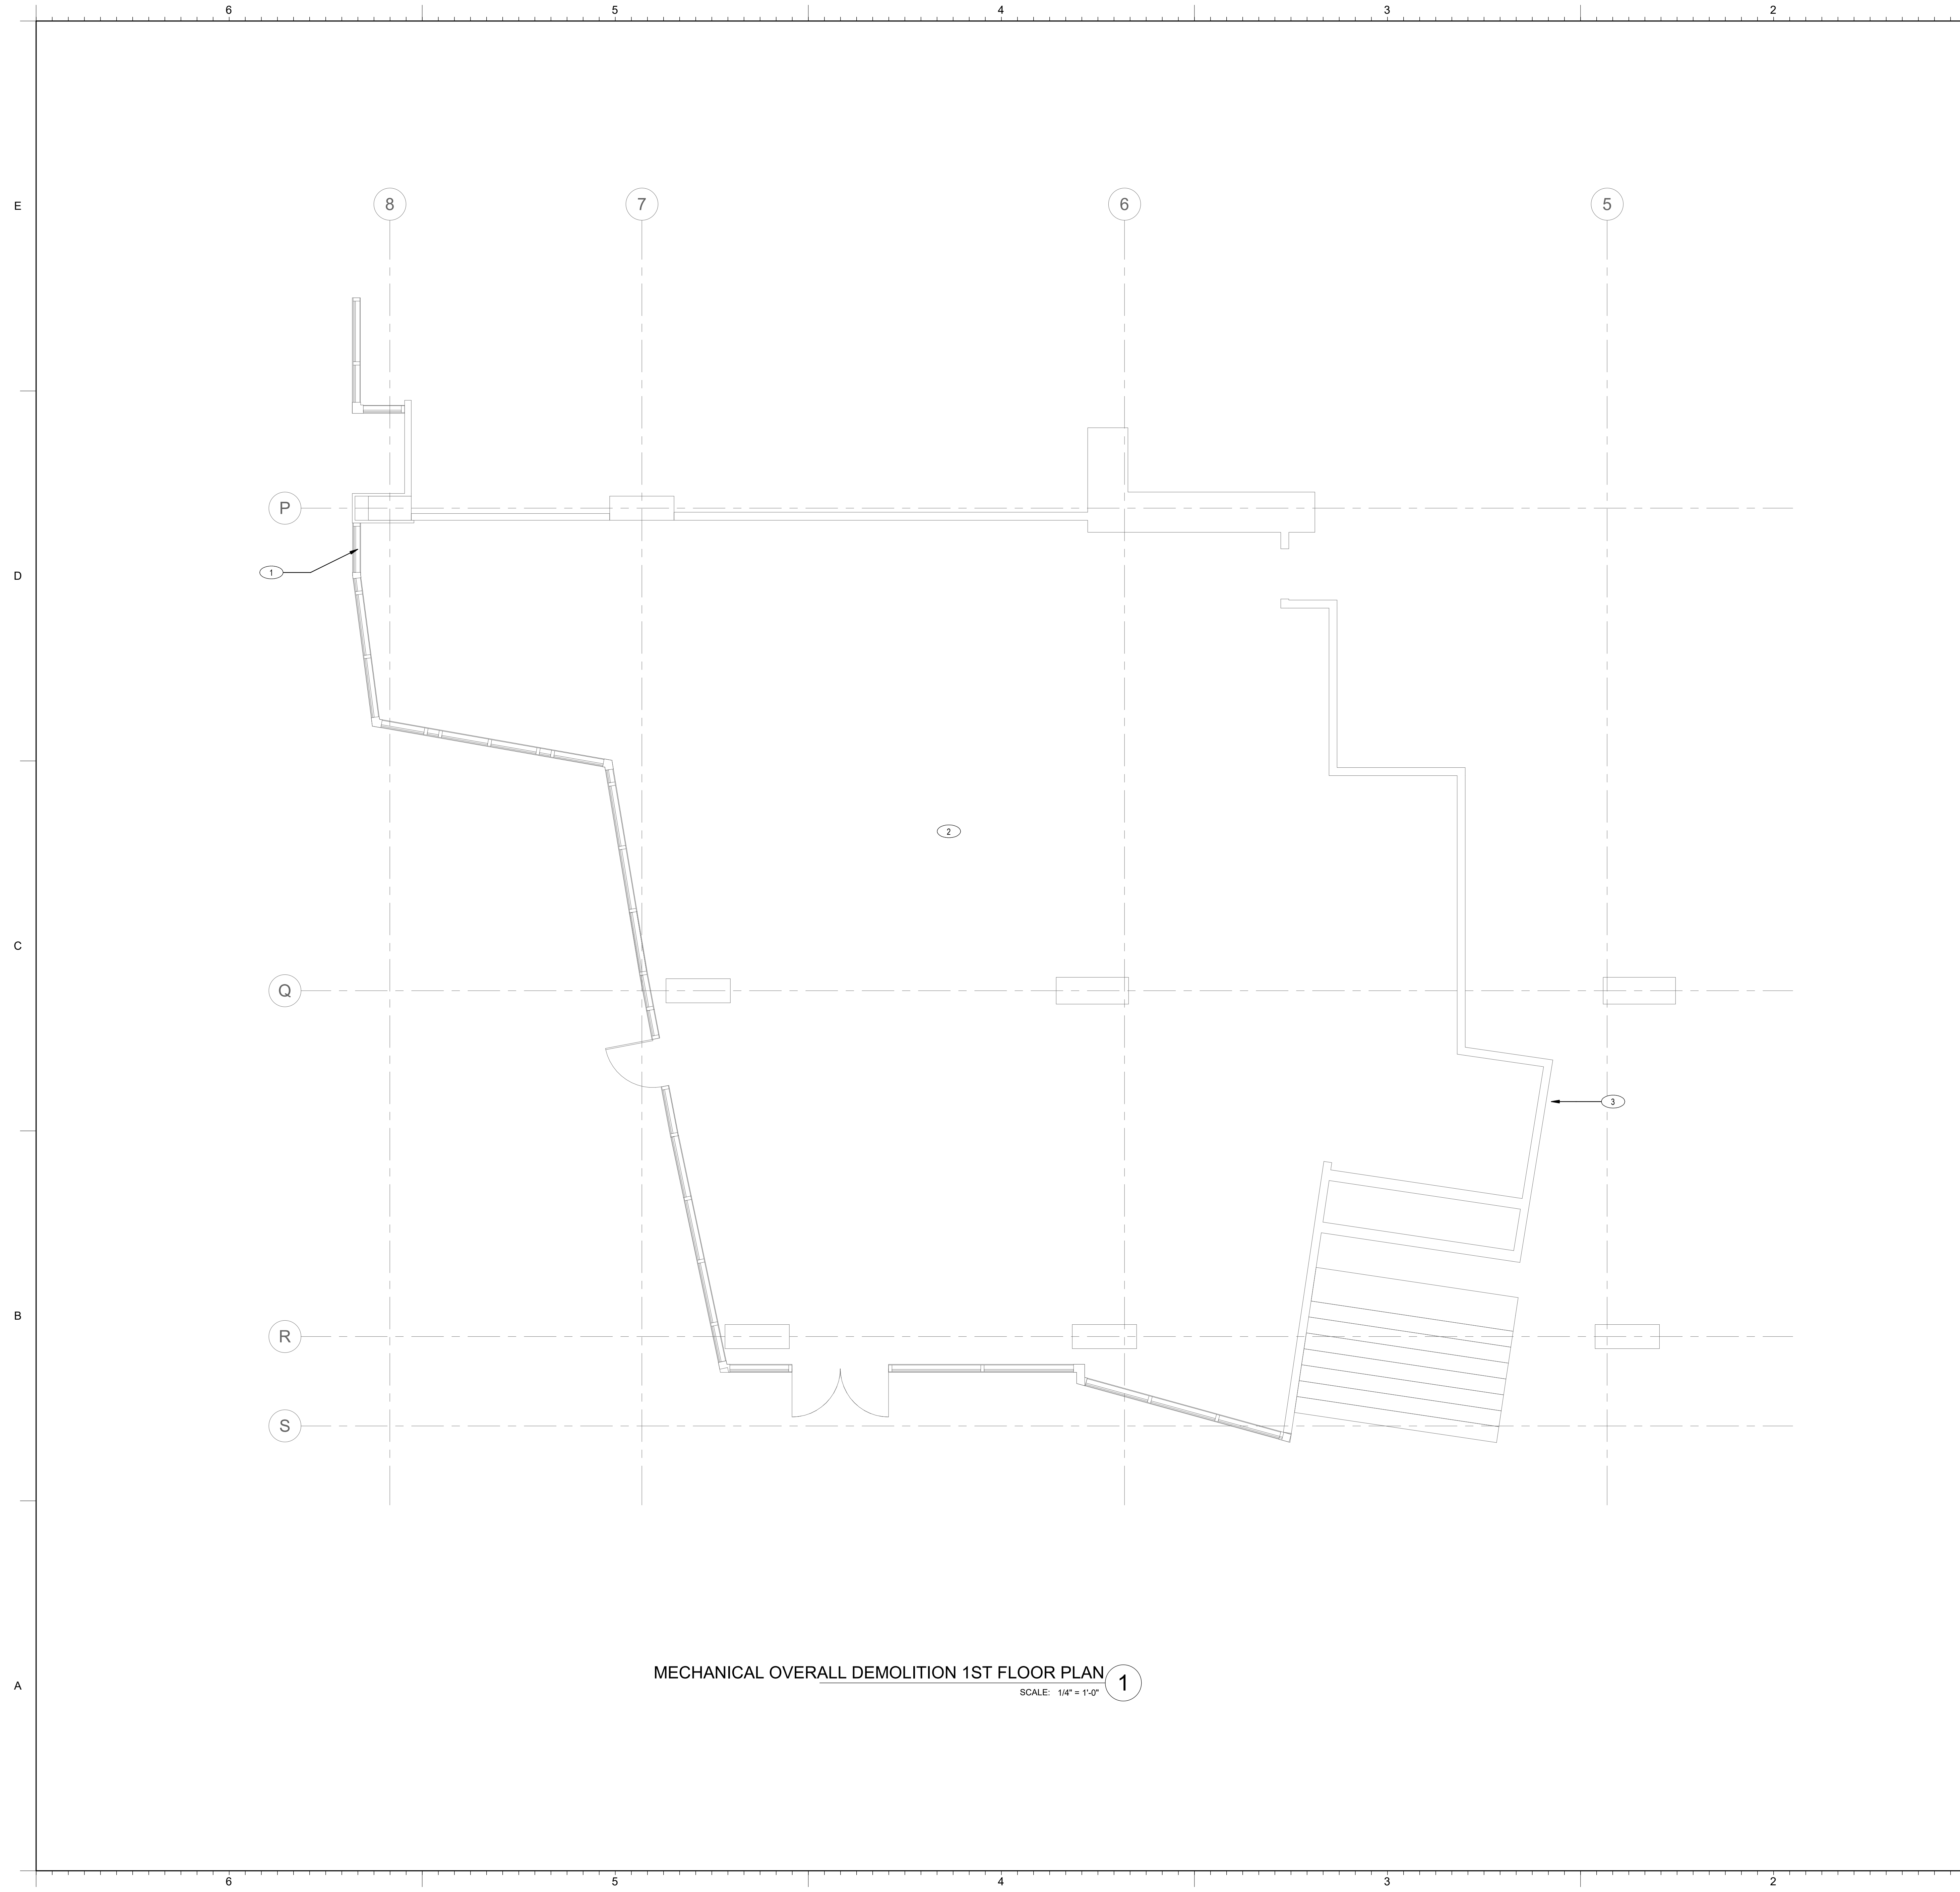

DEMOLITION KEY NOTES

- 1 EXISTING LOUVER TO BE DEMOLISHED AND CAP TO MATCH EXISTING EXTERIOR FINISH. COORDINATE WITH ARCHITECT FOR FINAL FINISH LOOK.
- 2 ALL EXISTING MECHANICAL PIPING, DUCTWORK, EQUIPMENT, AIR TERMINALS, ETC., TO BE DEMOLISHED.
- 3 EXISTING LOUVER FOR RESTROOM EXHAUST TO BE PRESERVED AND PROTECTED IN PLACE FOR REUSE.

zebra
 ZEBRA PROJECTS, INC.
 14814 N KIERLAND BLVD, SUITE N 300
 SCOTTSDALE, ARIZONA 85254
 PHONE: 480.912.1169 www.zbr.co.uk

INFRASTRUCTURE FACTOR CONSULTING, INC.
 2361 Rosecrans Ave. Suite 368, El Segundo, CA 90245
 P: 310.725.1500 F: 310.725.0215 www.iFactor.com

STORE NO:
CA #1398

SHAKE SHACK
 SHAKE SHACK - KOREATOWN
 3786 WILSHIRE BLVD. LOS ANGELES, CA 90010

DEMOLITION NOTES

1. ALL DEMOLITION SHALL BE PERFORMED IN ACCORDANCE WITH THE SPECIFICATIONS AND DRAWINGS.
2. THE CONTRACTOR SHALL FIELD SURVEY THE EXISTING CONDITIONS PRIOR TO STARTING ANY WORK.
3. DURING DEMOLITION, THE CONTRACTOR SHALL ALWAYS BE AWARE OF THE INTENDED FINAL RENOVATED CONDITIONS OF THE BUILDING AND THE REASON OF DEMOLITION WORK IS BEING DONE.
4. THE CONTRACTOR SHALL RESTORE TO ITS EXISTING CONDITION ANY EXISTING WORK DAMAGED DURING DEMOLITION INDICATED "EXISTING TO REMAIN" ON THE DRAWINGS.
5. THE CONTRACTOR SHALL TURN OVER ALL DEMOLISHED EQUIPMENT AND MATERIALS, OR DISPOSE AS DIRECTED BY THE OWNER. CONTRACTOR SHALL INCLUDE ANY DISPOSAL FEE AS REQUIRED AS PART OF BASE BID.
6. PROVIDE TEMPORARY ENCLOSURE/PROTECTION BARRICADES OR WARNING WHERE REQUIRED BY APPLICABLE SAFETY ORDINANCES PRIOR TO START OF DEMOLITION. REMOVE WHEN NO LONGER NEEDED.
7. CONTRACTOR SHALL DEMOLISH AS REQUIRED TO PROVIDE THE NEW LAYOUT ON THIS PLAN.
8. DEMOLISH ALL SERVICES BACK TO MAIN AND CAP AS APPLICABLE.

REVISION

NO.	DATE	DESCRIPTION
1	11/08/21	PERMIT/BID SET
A	01/26/22	REVISION A
T	07/01/22	REVISION 1
4	09/16/22	REVISION 4

STATUS:
PERMIT/BID SET

PRELIMINARY:
Preliminary Documents Are for Design Review only and not intended for building, engineering, permitting or construction purposes. They were prepared by or under the supervision of Zebra Projects, INC.



FIELD VERIFICATION:
The contractor shall verify all signed dimensions and condition at the project site and notify Zebra Projects, INC. of any dimensional errors, or omissions or discrepancies before beginning or indicating any work. Do not scale these drawings.

COPYRIGHT © 2021:
Zebra Projects, INC. shall retain all common law, statutory and all other reserved rights. Neither the documents nor the information herein is to be reproduced, distributed, reflected or otherwise without the written consent of Zebra Projects, INC.


SHEET NAME:
MECHANICAL OVERALL DEMOLITION 1ST FLOOR PLAN

DATE: 11/08/21 PROJECT NO: SHK-21-008
 DRAWN: SK SCALE: 1/4" = 1'-0"

SHEET NO:
M111

6 5 4 3 2 1

E
D
C
B
A

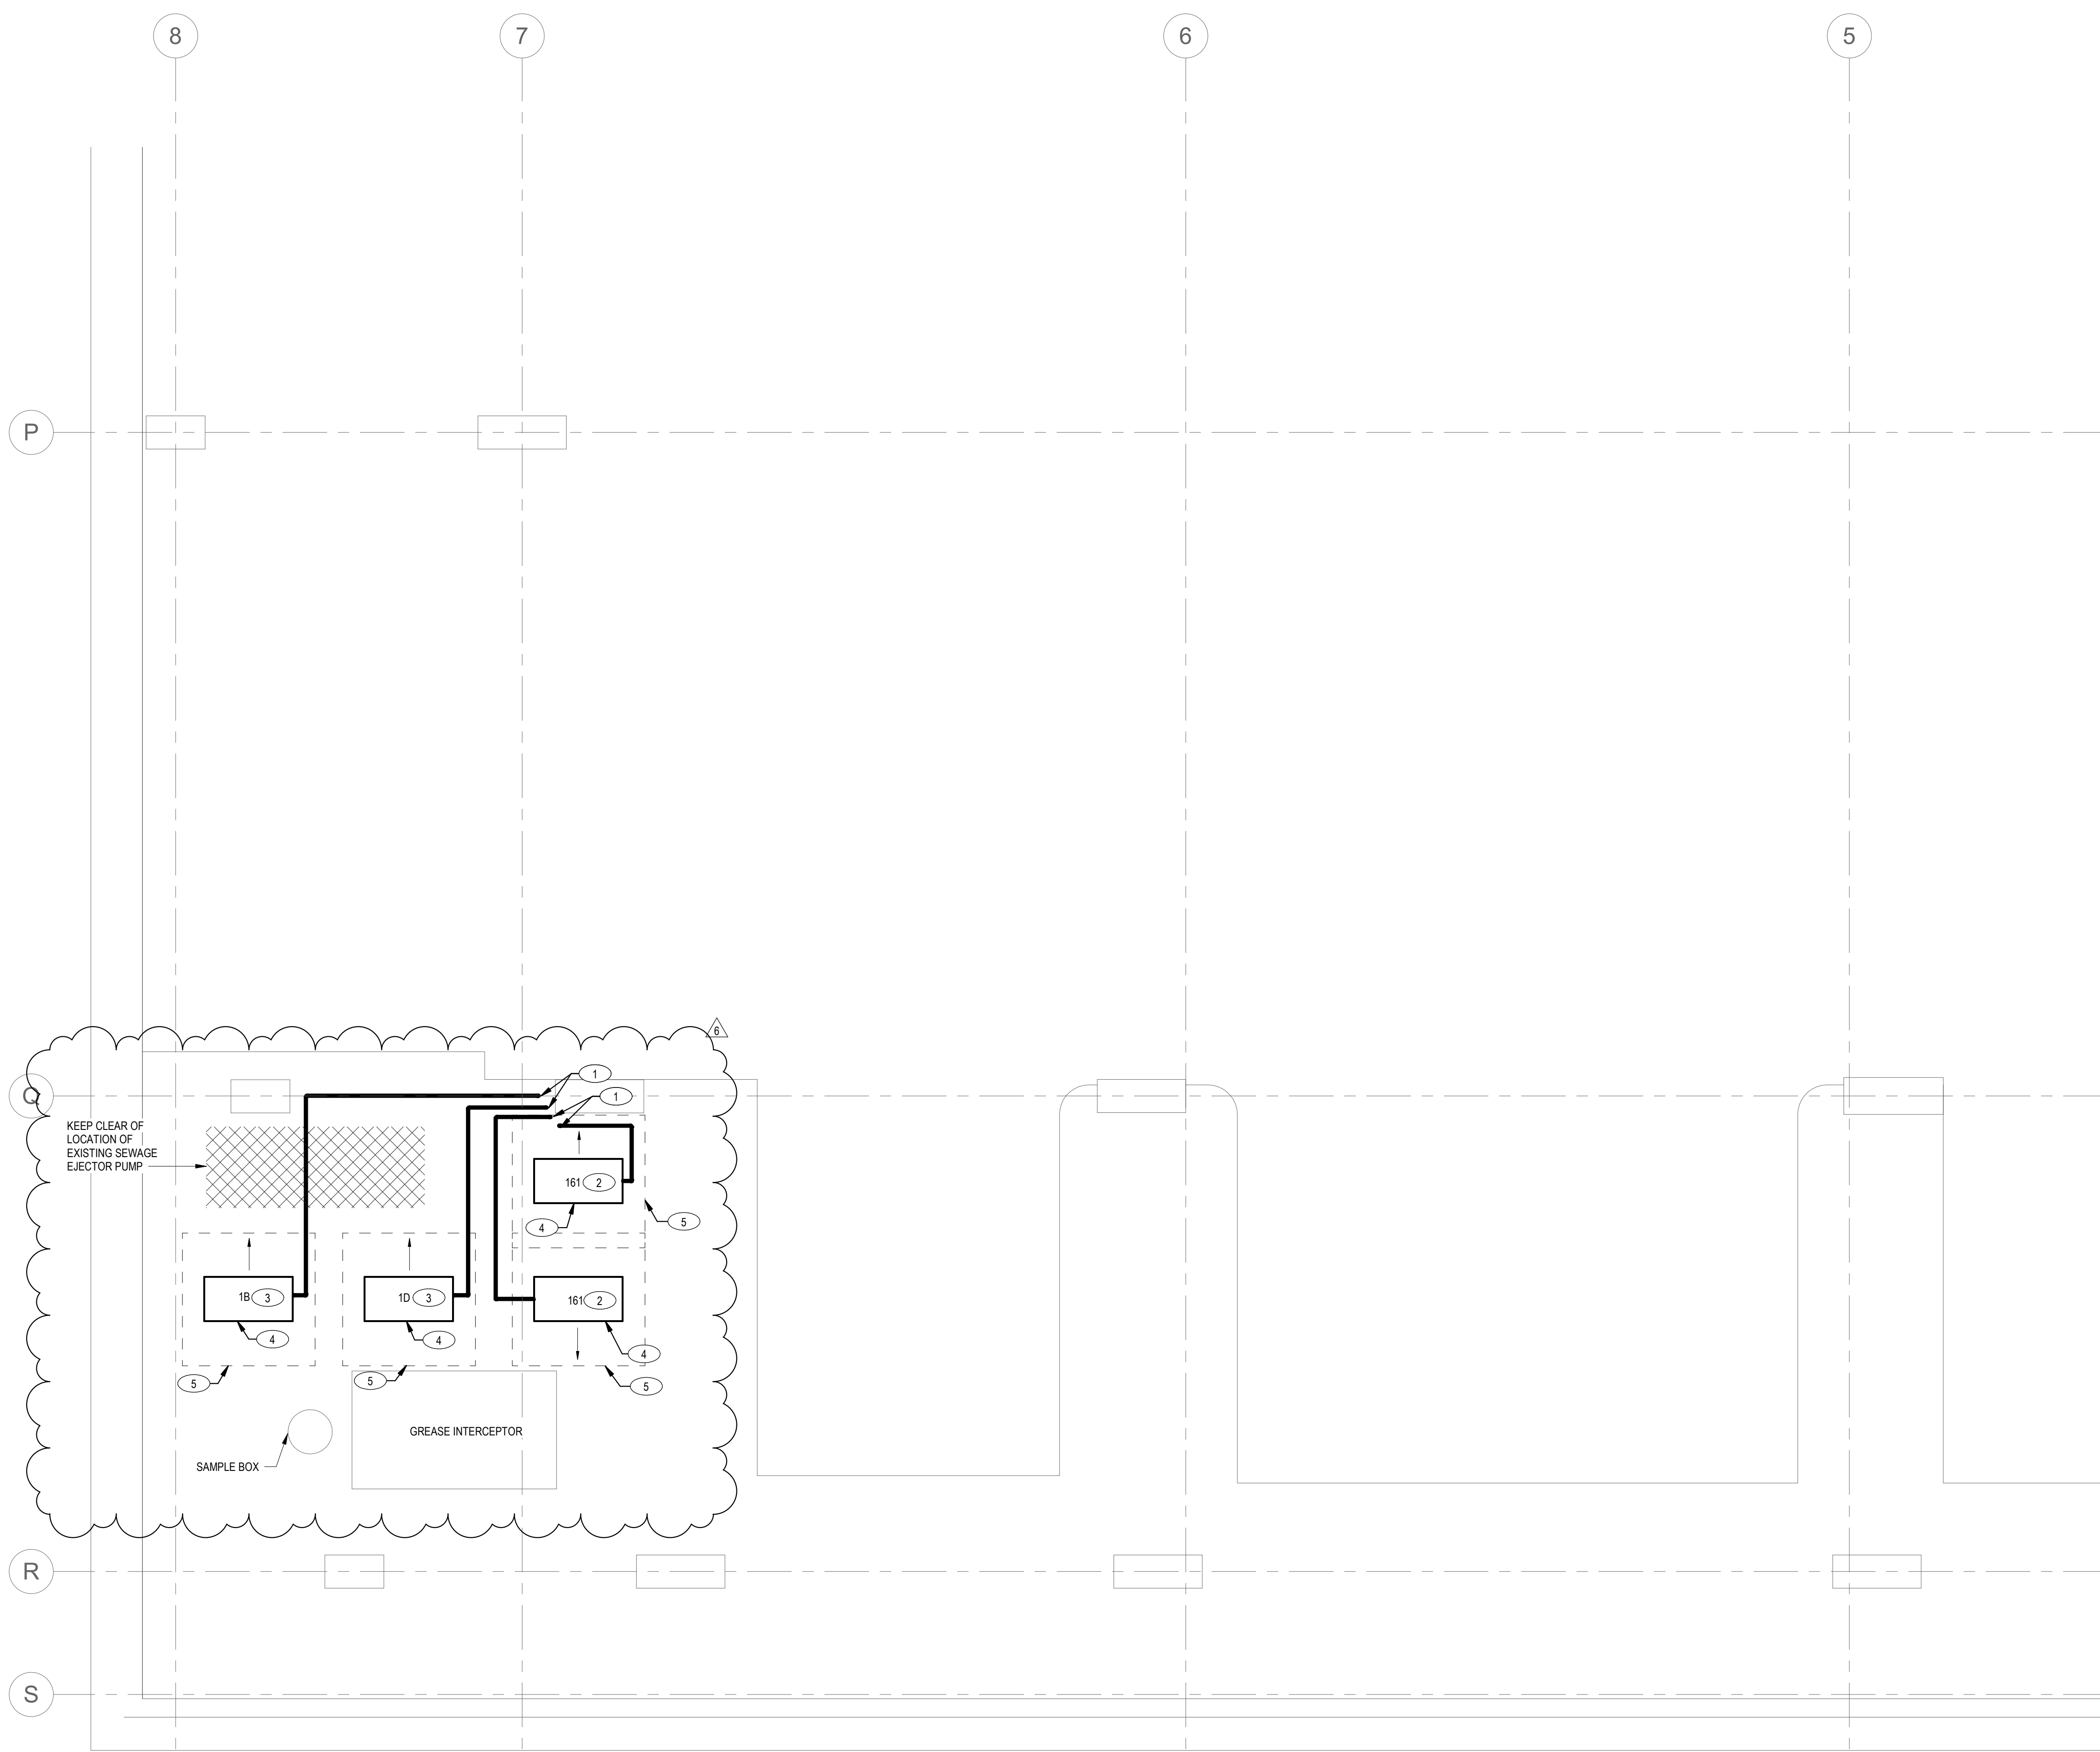

MECHANICAL REMODEL GARAGE LEVEL BASEMENT PLAN 1
SCALE: 1/4" = 1'-0"

RENOVATION KEY NOTES

- REFRIGERATION PIPING ROUTED UP TO LEVEL ONE RESTAURANT SPACE THROUGH NEW PIPE CHASE. PROVIDE JACKETING ON ALL REFRIGERATION LINES. CONTRACTOR TO CONFIRM EXACT ROUTING IN FIELD AND COORDINATE WITH ARCHITECT AND LANDLORD.
- CUSTARD MACHINE CONDENSING UNIT BY OTHERS.
- COOLER/FREEZER CONDENSING UNITS BY OTHERS.
- OWNER FURNISHED EQUIPMENT, AND CONTRACTOR INSTALLED CONDENSING UNIT. REFER TO KITCHEN DRAWINGS. COORDINATE HOUSEKEEPING PADS WITH STRUCTURAL ENGINEER. MINIMUM 4" THICK PAD.
- SERVICE CLEARANCE FOR CONDENSING UNITS. SERVICE CLEARANCES MAY OVERLAP, BUT NO EQUIPMENT MAY BE PLACED WITHIN THE AREA.

GENERAL NOTES

- WHERE ENCLOSURES ARE NOT REQUIRED, HOODS, GREASE REMOVAL DEVICES, EXHAUST FANS, AND DUCTS SHALL HAVE A CLEARANCE OF NOT LESS THAN 18" TO COMBUSTIBLE MATERIAL, 6" TO LIMITED COMBUSTIBLE MATERIAL, AND 0" TO NONCOMBUSTIBLE MATERIAL, PER ALL APPLICABLE CODE SECTIONS.
- PROVIDE MANUAL BALANCING DAMPER FOR ALL BRANCH DUCTWORK FOR PROPER BALANCING OF ALL AIR SYSTEMS, WHETHER SHOWN ON DRAWINGS OR NOT.
- SEE SHEET M501 FOR PIPING DIAGRAM DETAIL.
- ENVIRONMENTAL EXHAUST OUTLETS SHALL TERMINATE NO LESS THAN 3' FROM PROPERTY LINE, 3' FROM OPENINGS INTO THE BUILDING AND 10' FROM ANY FORCED AIR INTAKE.
- OUTSIDE AIR FOR A HEATING OR COOLING SYSTEM SHALL NOT BE TAKEN FROM LESS THAN 10' IN DISTANCE FROM AN APPLIANCE VENT OUTLET, A VENT OPENING OF A PLUMBING DRAINAGE SYSTEM, THE DISCHARGE OUTLET OF AN EXHAUST FAN, OR A MEDICAL-SURGICAL VACUUM OUTLET UNLESS THE OUTLET IS 5' ABOVE THE OUTSIDE-AIR INLET.
- 510 7.3 CLEARANCE: CLEARANCE FROM THE DUCT OR THE EXHAUST FAN TO THE INTERIOR SURFACE OF ENCLOSURES OF COMBUSTIBLE CONSTRUCTION SHALL BE NOT LESS THAN 18 INCHES (457 MM), AND CLEARANCE FROM THE DUCT TO THE INTERIOR SURFACE OF ENCLOSURES OF NONCOMBUSTIBLE OR LIMITED-COMBUSTIBLE CONSTRUCTION SHALL BE NOT LESS THAN 6 INCHES (152 MM). PROVISIONS FOR REDUCING CLEARANCES AS DESCRIBED IN SECTION 507.4 THROUGH SECTION 507.4.3.3 SHALL NOT BE APPLICABLE TO ENCLOSURES. [NFPA 967.7.2.2.1 - 7.7.2.2.3] EXCEPTION: CLEARANCE FROM THE OUTER SURFACES OF FIELD APPLIED GREASE DUCT ENCLOSURES AND FACTORY-BUILT GREASE DUCT ENCLOSURES TO THE INTERIOR SURFACES OF CONSTRUCTION INSTALLED AROUND THEM SHALL BE PERMITTED TO BE REDUCED WHERE THE FIELD-APPLIED GREASE DUCT ENCLOSURE MATERIALS AND THE FACTORY-BUILT GREASE DUCT ENCLOSURES ARE INSTALLED IN ACCORDANCE WITH THE CONDITIONS OF THE LISTINGS AND THE MANUFACTURER'S INSTALLATION INSTRUCTIONS AND ARE ACCEPTABLE TO THE AUTHORITY HAVING JURISDICTION. [NFPA 967.7.2.2.4]

zebra
ZEBRA PROJECTS, INC.
14814 N KIERLAND BLVD, SUITE N 300
SCOTTSDALE, ARIZONA 85254
PHONE: 480.912.1169 www.zbr.co.uk

INFRASTRUCTURE FACTOR CONSULTING, INC.
2361 Rosecrans Ave. Suite 368, El Segundo, CA 90245
P: 310.725.1500 F: 310.725.0215 www.iFactor.com

STORE NO:
CA #1398

SHAKE SHACK
SHAKE SHACK - KOREATOWN
3786 WILSHIRE BLVD. LOS ANGELES, CA 90010

REVISION

NO.	DATE	DESCRIPTION
1	11/08/21	PERMIT/BID SET
2	01/26/22	REVISION A
3	07/01/22	REVISION 1
4	09/16/22	REVISION 4
5	10/11/22	REVISION 6

STATUS:
PERMIT/BID SET

PRELIMINARY:
Preliminary Documents Are for Design Review only and not intended for building, permitting, or construction purposes. They were prepared by or under the supervision of Zebra Projects, INC.



FIELD VERIFICATION:
The contractor shall verify all signed dimensions and condition at the project site and notify Zebra Projects, INC. of any dimensional errors, or omissions or discrepancies before beginning or resuming any work. Do not scale these drawings.


COPYRIGHT © 2021:
Zebra Projects, INC. shall retain all common law, statutory and all other reserved rights. Neither the documents nor the information herein is to be reproduced, distributed, disclosed or otherwise used without the written consent of Zebra Projects, INC.

SHEET NAME:
MECHANICAL BASEMENT REMODEL PLAN

DATE: 11/08/21 PROJECT NO: SHK-21-008
DRAWN: SK SCALE: 1/4" = 1'-0"

SHEET NO:
M201

6 5 4 3 2 1

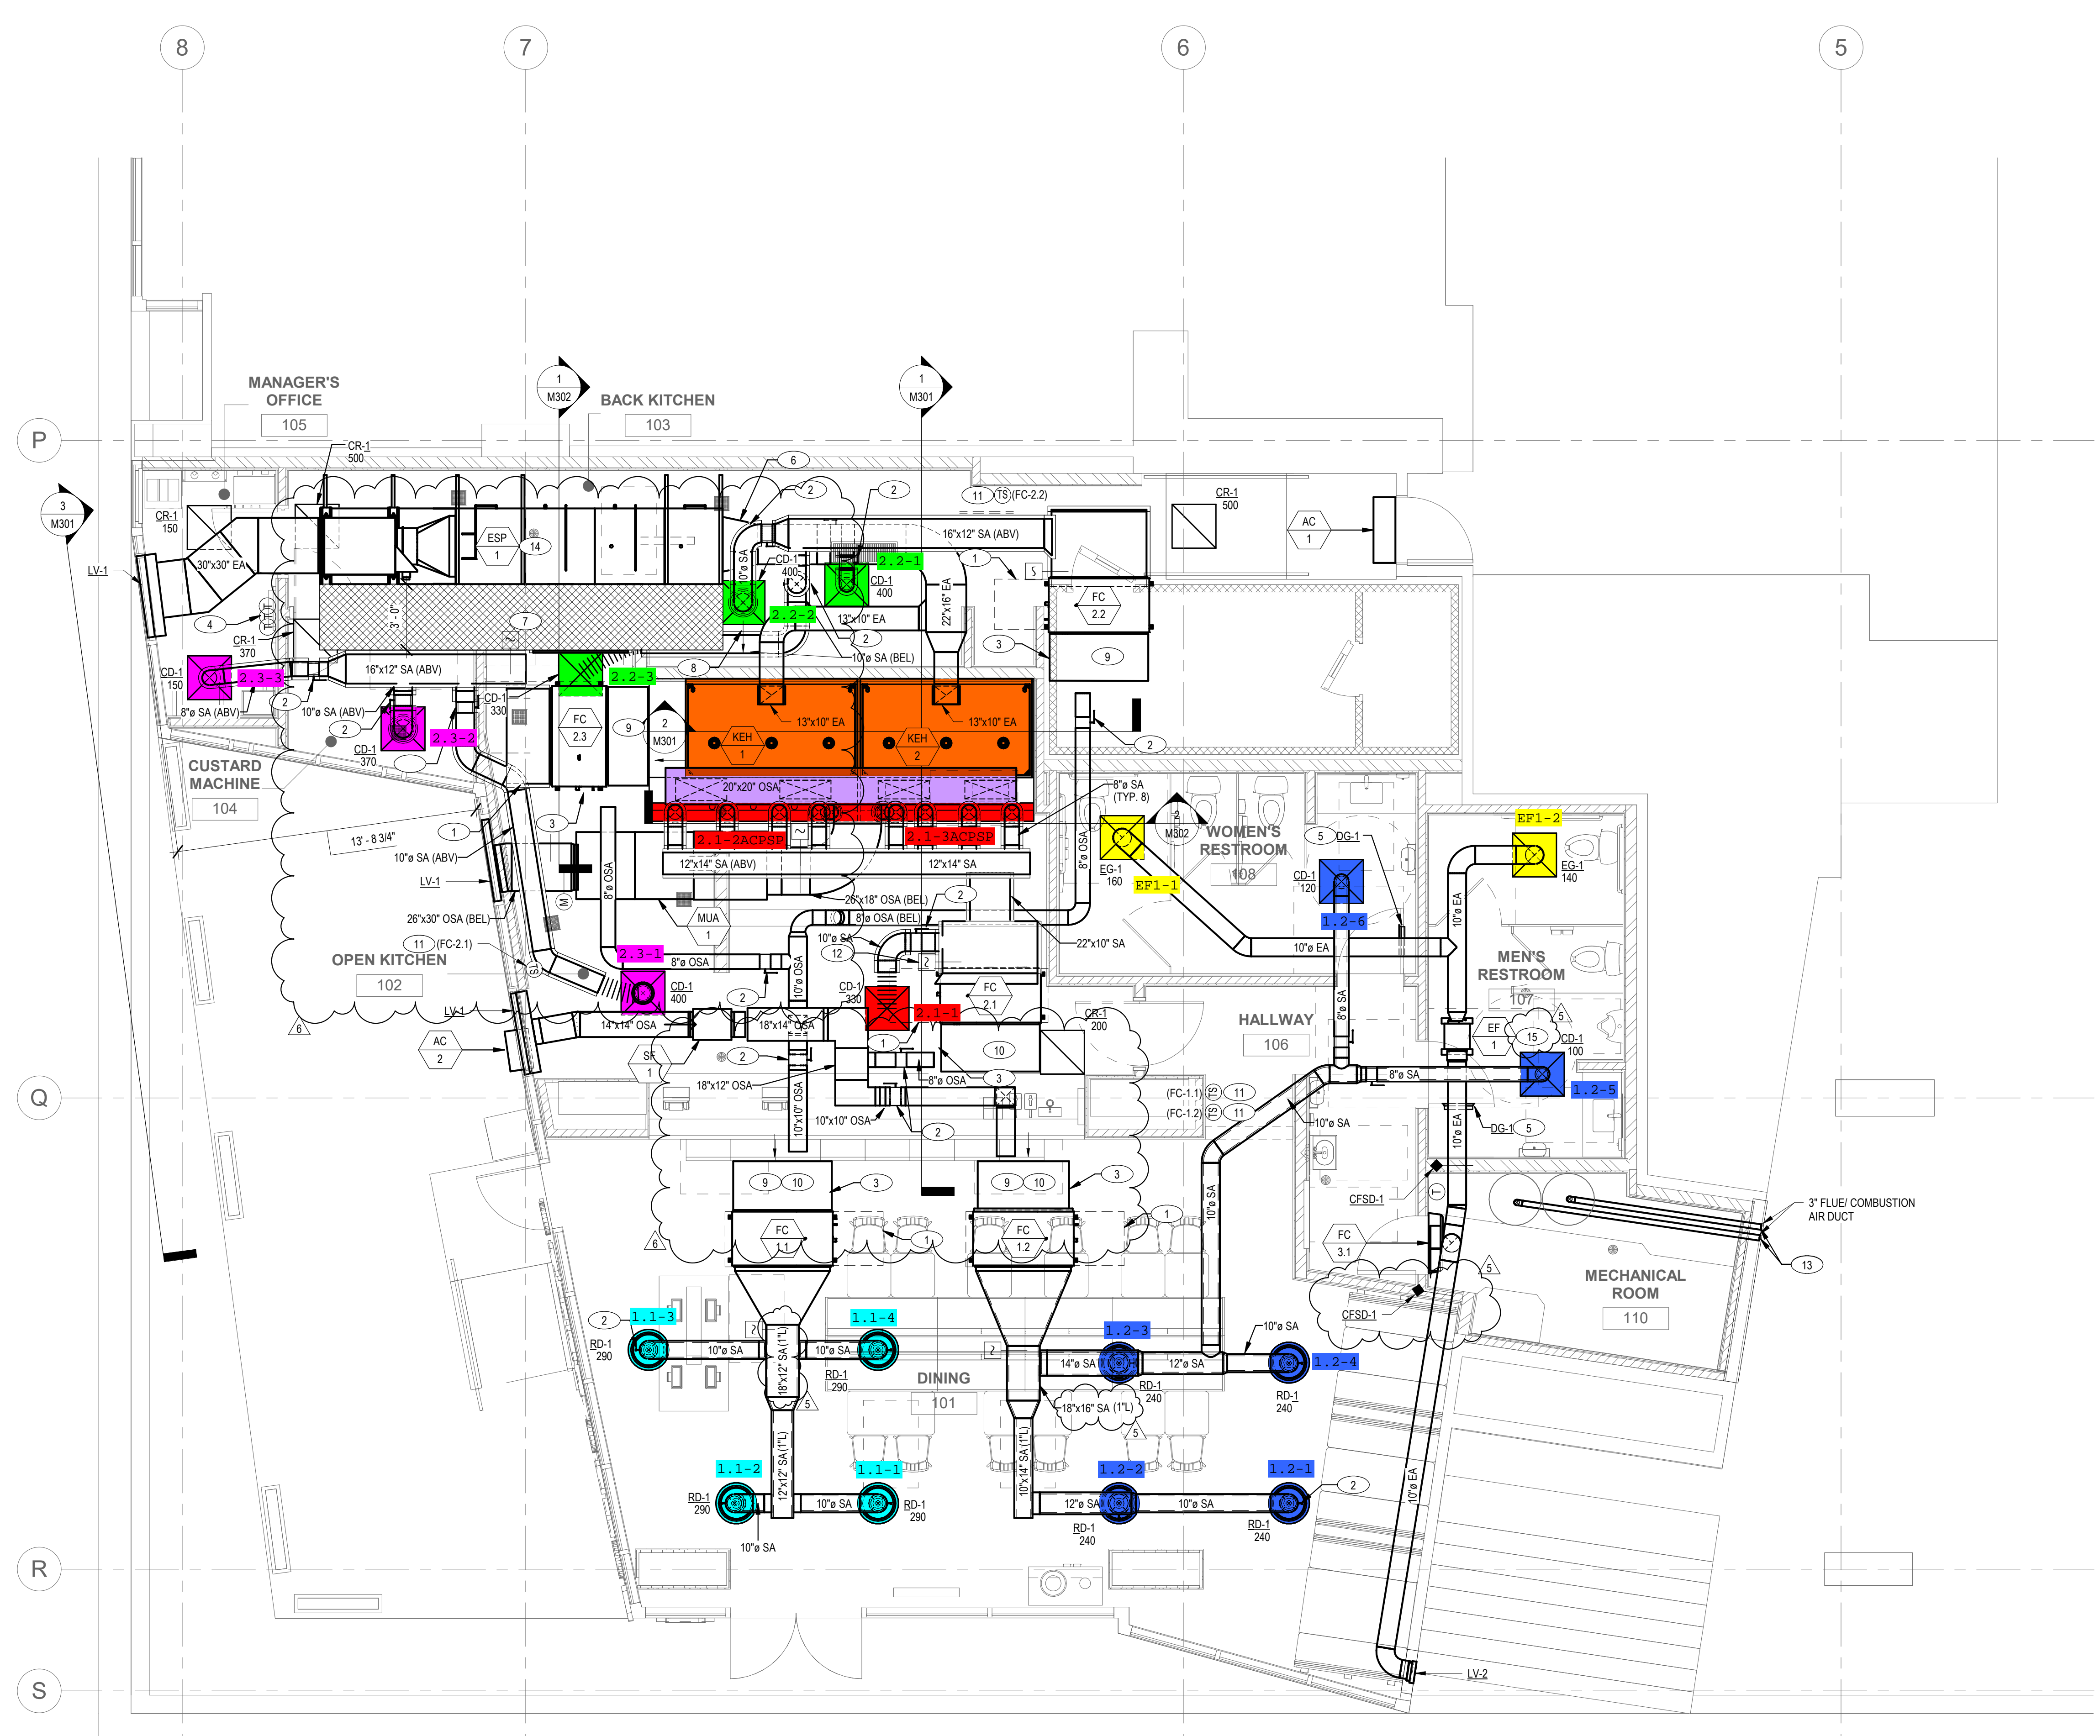

MECHANICAL REMODEL LEVEL 01 REMODEL PLAN 1
SCALE: 1/4" = 1'-0"

RENOVATION KEY NOTES

- KEEP SERVICE AREA CLEAR FOR OPERATION AND MAINTENANCE ACCESS. WHERE REQUIRED, PROVIDE ACCESS PANEL.
- LOCATION OF MANUAL BALANCING VOLUME DAMPER, (TYP.)
- PROVIDE SERVICE CLEARANCE TO SERVICE FILTERS.
- ALL THERMOSTATS SERVING ALL FAN COIL UNITS TO BE LOCATED IN MANAGER'S OFFICE. COORDINATE WITH ARCHITECT FOR FINAL LOCATION.
- TRANSFER AIR GRILLE FROM RESTROOM TO ADJACENT SPACE. SEE M701 REFRIGERANT VOLUME CALCULATION TABLE - NOTE 3.
- SEE MANUFACTURER DETAILS FOR THE TRANSITION REQUIREMENTS. DUCT MUST BE GRADUALLY TRANSITIONED FOR OPTIMAL ODOOR AND SMOKE CONTROL. PROPER AIR VELOCITY MUST BE MAINTAINED.
- 3 FOOT WIDE PLATFORM TO BE INSTALLED THE LENGTH OF THE UNIT TO PROVIDE MAINTENANCE. SEE STRUCTURAL DRAWINGS FOR INSTALLATION DETAILS.
- DIRECTIONAL DIFFUSER TO BE INSTALLED TO BLOW AIR IN ONE DIRECTION PER FLOW ARROW.
- INSTALL FILTER BOX AT INLET OF FAN COIL PER MANUFACTURER'S INSTRUCTIONS.
- PROVIDE FILTER BOX WITH REAR INLET OPENING.
- COORDINATE FINAL LOCATION OF REMOTE TEMPERATURE SENSORS WITH ARCHITECT.
- DUCT SMOKE DETECTOR TO BE SUPERVISED BY FIRE ALARM SYSTEM.
- PROVIDE WITH LOCHINVAR CONCENTRIC COMBUSTION AIR AND VENT PIPE TERMINATION KIT 40014480 FOR 3" DIAMETER MODEL. PROVIDE ONE KIT PER WATER HEATER. PROVIDE WITH MANUFACTURER'S RECOMMENDED CAPS AND GASKETS.
- PER CALIFORNIA MECHANICAL CODE AND NFPA 96, GREASE DUCT SHALL HAVE A CLEARANCE OF NOT LESS THAN 18" TO COMBUSTIBLE MATERIAL, 6" TO LIMITED-COMBUSTIBLE MATERIAL, AND 0" TO NONCOMBUSTIBLE MATERIAL (NFPA 96 7.2.2). PER BUILDING REQUIREMENTS, ALL MATERIALS IN PLENUM SPACE ARE NONCOMBUSTIBLE OR LIMITED-COMBUSTIBLE. SEE SECTION DETAIL IM002 FOR ADDITIONAL INFORMATION. SEE ARCHITECTURAL SET FOR CONSTRUCTION DETAILS OF THE PLENUM. ALL PLENUM MATERIALS ARE OF NON-COMBUSTIBLE OR LIMITED-COMBUSTIBLE CONSTRUCTION.
- PROVIDE ACCESS PANEL FOR SERVICING EXHAUST FAN.

GENERAL NOTES

- WHERE ENCLOSURES ARE NOT REQUIRED, HOODS, GREASE REMOVAL DEVICES, EXHAUST FANS, AND DUCTS SHALL HAVE A CLEARANCE OF NOT LESS THAN 18" TO COMBUSTIBLE MATERIAL, 6" TO LIMITED-COMBUSTIBLE MATERIAL, AND 0" TO NONCOMBUSTIBLE MATERIAL PER ALL APPLICABLE CODE SECTIONS.
- PROVIDE MANUAL BALANCING DAMPER FOR ALL BRANCH DUCTWORK FOR PROPER BALANCING OF ALL AIR SYSTEMS, WHETHER SHOWN ON DRAWINGS OR NOT.
- SEE SHEET M501 FOR PIPING PROGRAM DETAILS.
- ENVIRONMENTAL EXHAUST OUTLETS SHALL TERMINATE NO LESS THAN 3' FROM PROPERTY LINE, 3' FROM OPENINGS INTO THE BUILDING AND 10' FROM ANY FORCED AIR INTAKE.
- OUTSIDE AIR FOR HEATING OR COOLING SYSTEM SHALL NOT BE TAKEN FROM LESS THAN 10' IN DISTANCE FROM AN APPLIANCE VENT OUTLET, A VENT OPENING OF A PLUMBING DRAINAGE SYSTEM, THE DISCHARGE OUTLET OF AN EXHAUST FAN, OR A MEDICAL SURGICAL VACUUM OUTLET UNLESS THE OUTLET IS ABOVE THE OUTSIDE AIR INLET.
- SAFETY CLEARANCE: CLEARANCE FROM THE DUCT OR EXHAUST FAN TO THE INTERIOR SURFACE OF ENCLOSURES OF COMBUSTIBLE CONSTRUCTION SHALL BE NOT LESS THAN 6 INCHES (152 MM), AND CLEARANCE FROM THE DUCT TO THE INTERIOR SURFACE OF ENCLOSURES OF NONCOMBUSTIBLE OR LIMITED-COMBUSTIBLE CONSTRUCTION SHALL BE NOT LESS THAN 6 INCHES (152 MM). PROVISIONS FOR REDUCING CLEARANCES AS DESCRIBED IN SECTION 507.4 THROUGH SECTION 507.4.3.3 SHALL NOT BE APPLICABLE TO ENCLOSURES. (NFPA 96 7.2.2.1 - 7.2.2.3) EXCEPTION: CLEARANCE FROM THE OUTER SURFACES OF FIELD APPLIED GREASE DUCT ENCLOSURES AND FACTORY-BUILT GREASE DUCT ENCLOSURES TO THE INTERIOR SURFACES OF CONSTRUCTION INSTALLED AROUND THEM SHALL BE PERMITTED TO BE REDUCED WHERE THE FIELD-APPLIED GREASE DUCT ENCLOSURE MATERIALS AND THE FACTORY-BUILT GREASE DUCT ENCLOSURES ARE INSTALLED IN ACCORDANCE WITH THE CONDITIONS OF THE LISTINGS AND THE MANUFACTURER'S INSTALLATION INSTRUCTIONS AND ARE ACCEPTABLE TO THE AUTHORITY HAVING JURISDICTION. (NFPA 96 7.2.2.4)

zebra
ZEBRA PROJECTS, INC.
14814 N KIERNLAND BLVD, SUITE 300
SCOTTSDALE, ARIZONA 85254
PHONE: 480.912.1169 www.zbr.co.uk

INFRASTRUCTURE FACTOR CONSULTING, INC.
2361 Rosecrans Ave, Suite 368, El Segundo, CA 90245
P: 310.725.1500 F: 310.725.0215 www.Factor.com

STORE NO:
CA #1398

SHAKE SHACK
SHAKE SHACK - KOREATOWN
3786 WILSHIRE BLVD. LOS ANGELES, CA 90010

REVISION	
DATE	DESCRIPTION
04/04/22	REVISION D
11/07/12	REVISION 1
08/23/22	SK001
09/16/22	REVISION 4
10/19/22	REVISION 5
10/11/22	REVISION 6

STATUS:
PERMIT/BID SET

PRELIMINARY:
Preliminary Documents Are for Design Review only and not intended for bidding, permitting, or construction purposes. They were prepared by or under the supervision of Zebra Projects, INC.




FIELD VERIFICATION:
The contractor shall verify all signed dimensions and condition at the project site and notify Zebra Projects, INC. of any dimensional errors, or omissions or discrepancies before beginning or fabricating any work. Do not scale these drawings.

COPYRIGHT © 2021:
Zebra Projects, INC. shall retain all common law, statutory and all other reserved rights. Neither the documents nor the information herein is to be reproduced, distributed, disclosed or otherwise used without the written consent of Zebra Projects, INC.

SHEET NAME:
MECHANICAL FIRST FLOOR REMODEL PLAN

DATE: 11/08/21 PROJECT NO: SHK-21-008
DRAWN: SK SCALE: 1/4" = 1'-0"

SHEET NO:
M211

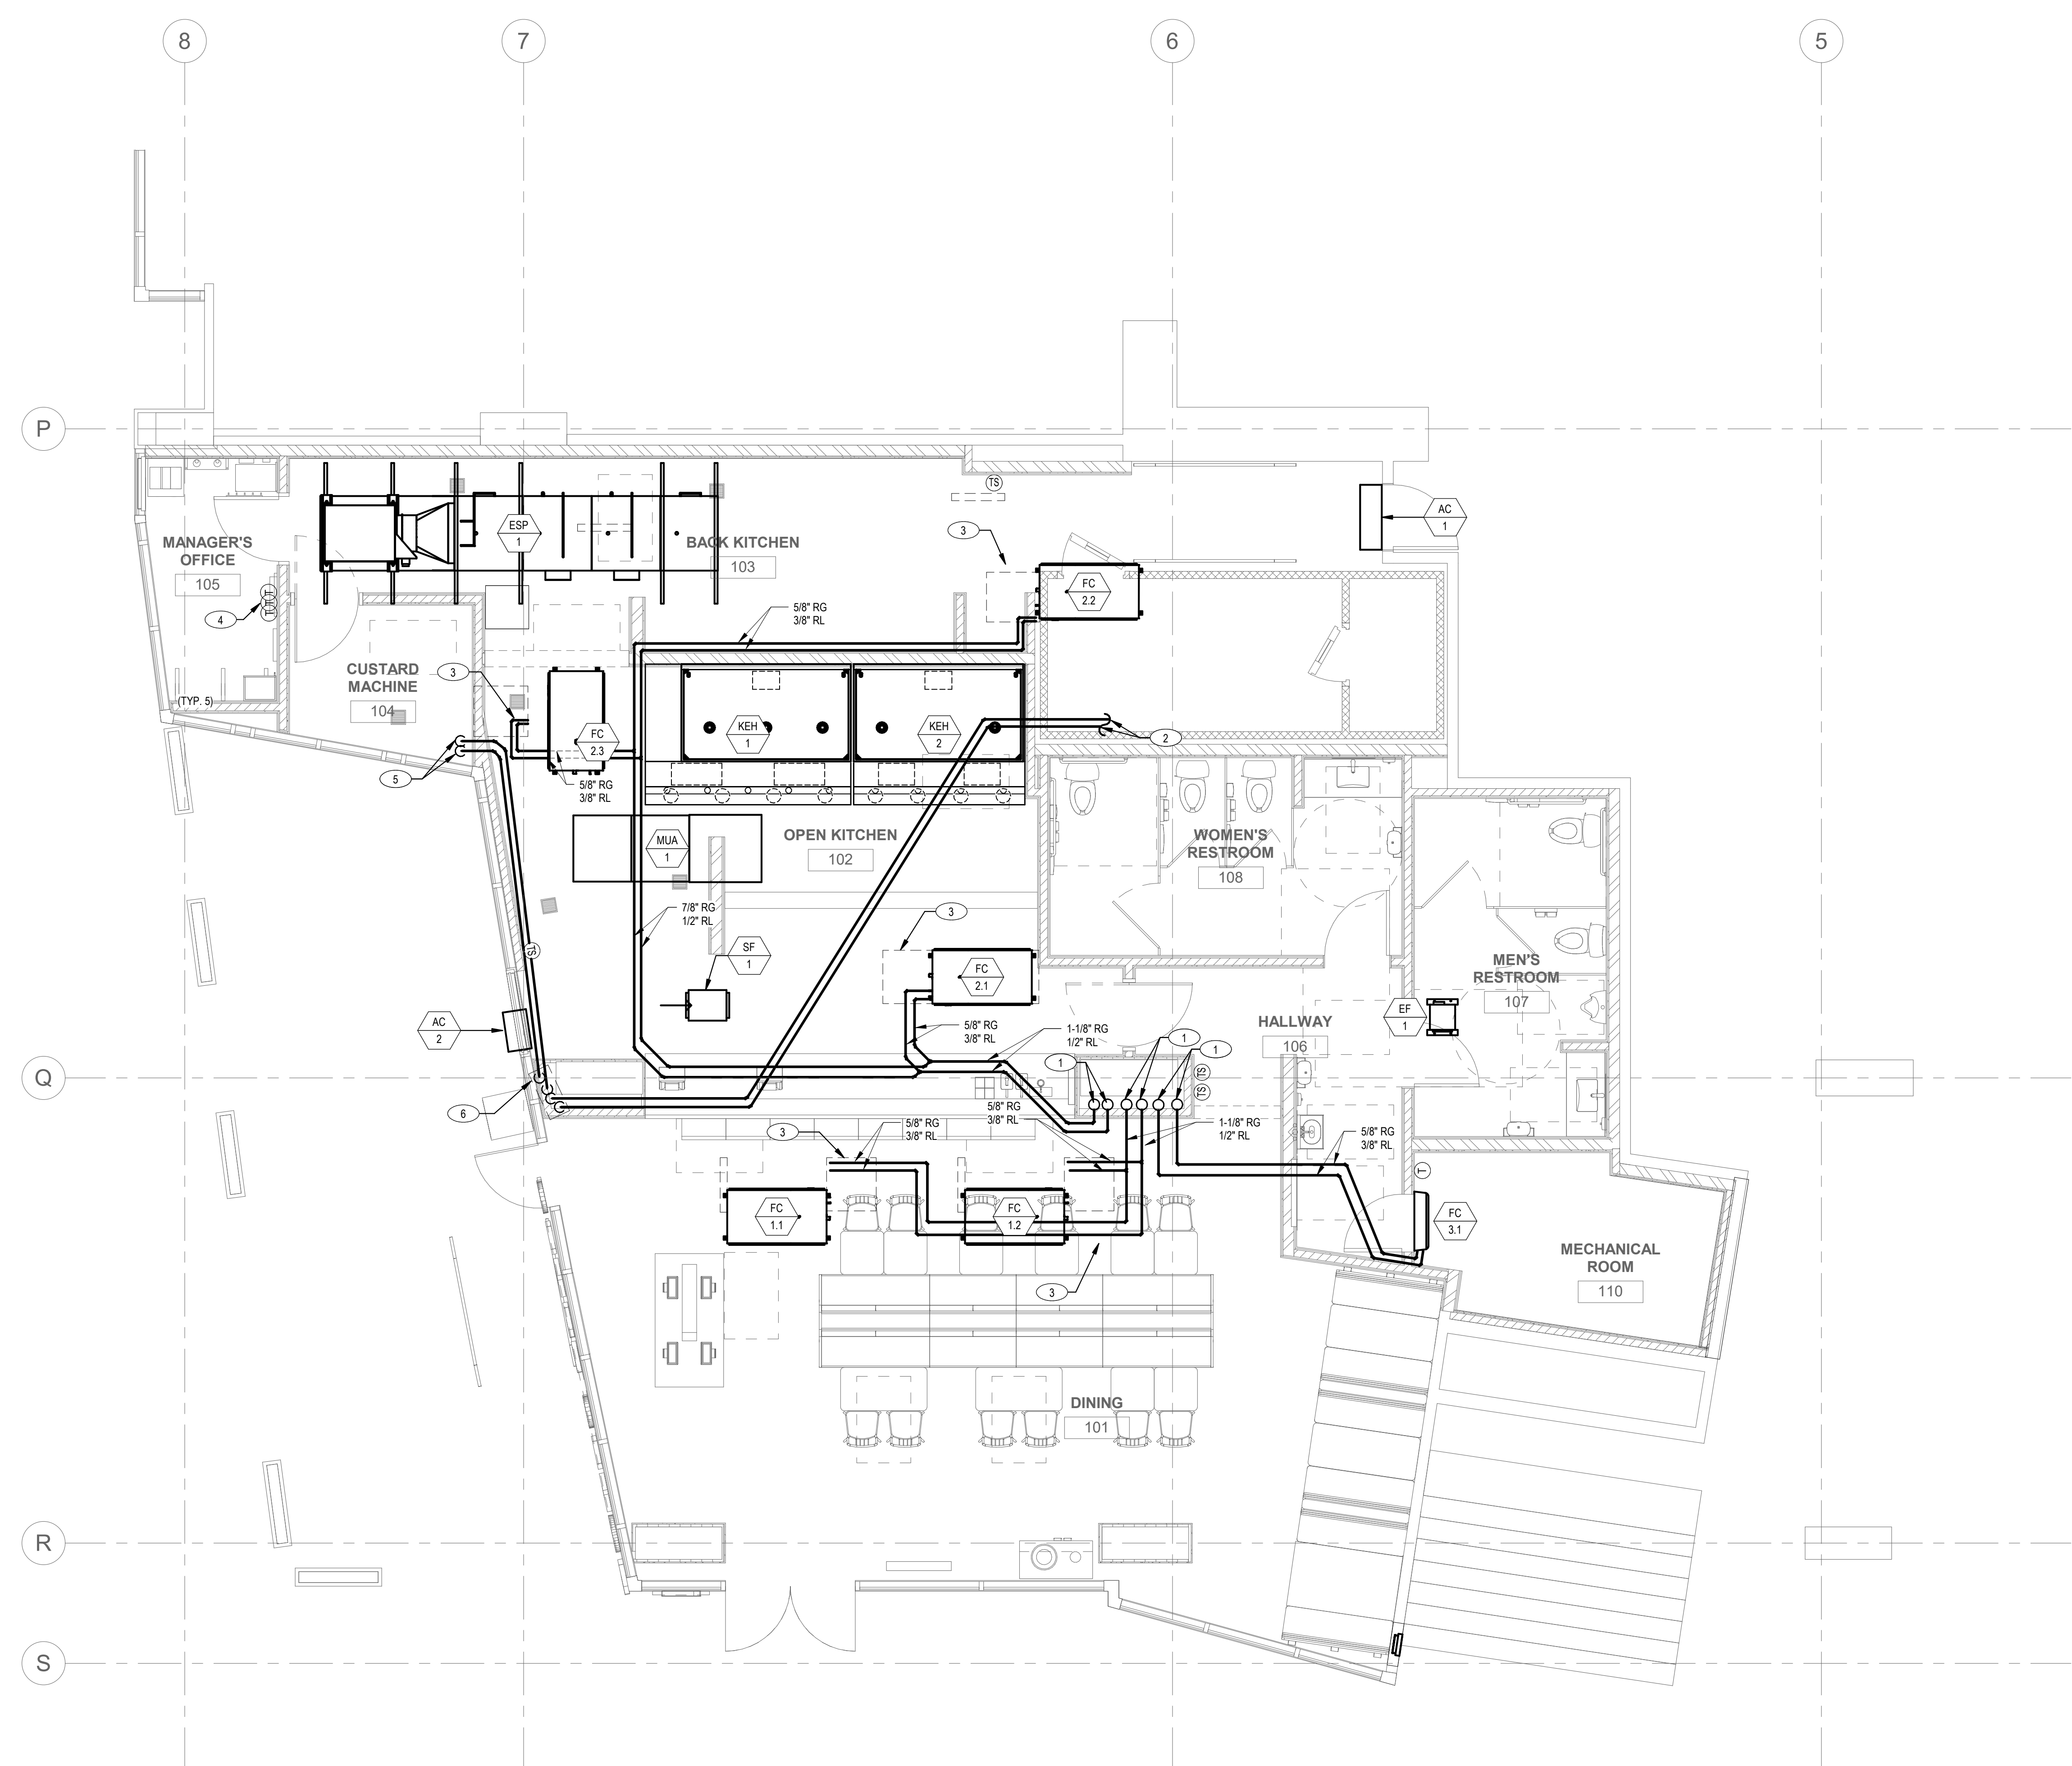

MECHANICAL PIPING LEVEL 01 REMODEL PLAN 1
SCALE: 1/4" = 1'-0"

RENOVATION KEY NOTES

- REFRIGERATION PIPING ROUTED FROM CONDENSER UNITS IN THE THIRD FLOOR PARKING GARAGE DOWN TO SERVE FAN COILS THROUGH EXISTING PIPE CHASE. PROVIDE JACKETING ON ALL REFRIGERATION LINES.
- REFRIGERANT LINES FROM CONDENSER IN THE BASEMENT PARKING GARAGE SERVING KITCHEN EQUIPMENT 1B AND 1D. SEE KITCHEN DRAWINGS FOR ADDITIONAL INFORMATION.
- KEEP SERVICE AREA CLEAR FOR OPERATION AND MAINTENANCE ACCESS. WHERE REQUIRED, PROVIDE ACCESS PANEL.
- ALL THERMOSTATS SERVING ALL FAN COIL UNITS TO BE LOCATED IN MANAGER'S OFFICE. COORDINATE WITH ARCHITECT FOR FINAL LOCATION.
- REFRIGERANT LINES FROM CONDENSER IN THE BASEMENT PARKING GARAGE SERVING KITCHEN EQUIPMENT 1E1. SEE KITCHEN DRAWINGS FOR ADDITIONAL INFORMATION.
- EACH PIPE ROUTING SHOWN REPRESENTS A PAIR OF PIPES BACK TO THE CONDENSER UNIT.

zebra
ZEBRA PROJECTS, INC.
14814 N KIERLAND BLVD, SUITE N 300
SCOTTSDALE, ARIZONA 85254
PHONE: 480.912.1169 www.zbr.co.uk

INFRASTRUCTURE FACTOR CONSULTING, INC.
2361 Rosecrans Ave. Suite 368, El Segundo, CA 90245
P: 310.725.1500 F: 310.725.0215 www.IFactor.com

STORE NO:
CA #1398

SHAKE SHACK
SHAKE SHACK - KOREATOWN
3786 WILSHIRE BLVD. LOS ANGELES, CA 90010

GENERAL NOTES

- WHERE ENCLOSURES ARE NOT REQUIRED, HOODS, GREASE REMOVAL DEVICES, EXHAUST FANS, AND DUCTS SHALL HAVE A CLEARANCE OF NOT LESS THAN 18" TO COMBUSTIBLE MATERIAL, 6" TO LIMITED-COMBUSTIBLE MATERIAL, AND 0" TO NONCOMBUSTIBLE MATERIAL PER ALL APPLICABLE CODE SECTIONS.
- PROVIDE MANUAL BALANCING DAMPER FOR ALL BRANCH DUCTWORK FOR PROPER BALANCING OF ALL AIR SYSTEMS, WHETHER SHOWN ON DRAWINGS OR NOT.
- SEE SHEET M101 FOR PIPING DIAGRAM DETAIL.
- ENVIRONMENTAL EXHAUST OUTLETS SHALL TERMINATE NO LESS THAN 3' FROM PROPERTY LINE, 3' FROM OPENINGS INTO THE BUILDING AND 10' FROM ANY FORCED AIR INTAKE.
- OUTSIDE AIR FOR A HEATING OR COOLING SYSTEM SHALL NOT BE TAKEN FROM LESS THAN 10' IN DISTANCE FROM AN APPLIANCE VENT OUTLET, A VENT OPENING OF A PLUMBING DRAINAGE SYSTEM, THE DISCHARGE OUTLET OF AN EXHAUST FAN, OR A MEDICAL/SURGICAL VACUUM OUTLET UNLESS THE OUTLET IS 3' ABOVE THE OUTSIDE-AIR INLET.
- 510.7.3 CLEARANCE: CLEARANCE FROM THE DUCT OR THE EXHAUST FAN TO THE INTERIOR SURFACE OF ENCLOSURES OF NONCOMBUSTIBLE OR LIMITED-COMBUSTIBLE CONSTRUCTION SHALL BE NOT LESS THAN 6 INCHES (152 MM). PROVISIONS FOR REDUCING CLEARANCES AS DESCRIBED IN SECTION 507.4 THROUGH SECTION 507.4.3.3 SHALL NOT BE APPLICABLE TO ENCLOSURES. [NFPA 96:7.2.2.1, 7.2.2.3] EXCEPTION: CLEARANCE FROM THE OUTER SURFACES OF FIELD-APPLIED GREASE DUCT ENCLOSURES AND FACTORY-BUILT GREASE DUCT ENCLOSURES TO THE INTERIOR SURFACES OF CONSTRUCTION INSTALLED AROUND THEM SHALL BE PERMITTED TO BE REDUCED WHERE THE FIELD-APPLIED GREASE DUCT ENCLOSURE MATERIALS AND THE FACTORY-BUILT GREASE DUCT ENCLOSURES ARE INSTALLED IN ACCORDANCE WITH THE CONDITIONS OF THE LISTINGS AND THE MANUFACTURER'S INSTALLATION INSTRUCTIONS AND ARE ACCEPTABLE TO THE AUTHORITY HAVING JURISDICTION. [NFPA 96:7.2.2.4]

REVISION	
NO.	DESCRIPTION
1	11/08/21 PERMIT/BID SET
2	01/26/22 REVISION A
3	07/01/22 REVISION 1
4	09/16/22 REVISION 4

STATUS:
PERMIT/BID SET

PRELIMINARY:
Preliminary Documents Are for Design Review only and not intended for bidding, permitting, or construction purposes. They were prepared by or under the supervision of Zebra Projects, Inc.




FIELD VERIFICATION:
The contractor shall verify all signed dimensions and condition at the project site and notify Zebra Projects, Inc. of any dimensional errors, or omissions or discrepancies before beginning or resuming any work. Do not scale these drawings.

COPYRIGHT © 2021:
Zebra Projects, Inc. shall retain all common law, statutory and all other reserved rights. Neither the documents nor the information herein is to be reproduced, distributed, photocopied or otherwise used without the written consent of Zebra Projects, Inc.

SHEET NAME:
MECHANICAL PIPING FIRST FLOOR REMODEL PLAN

DATE: 11/08/21 PROJECT NO: SHK-21-008
DRAWN: SK SCALE: 1/4" = 1'-0"

SHEET NO:
M212

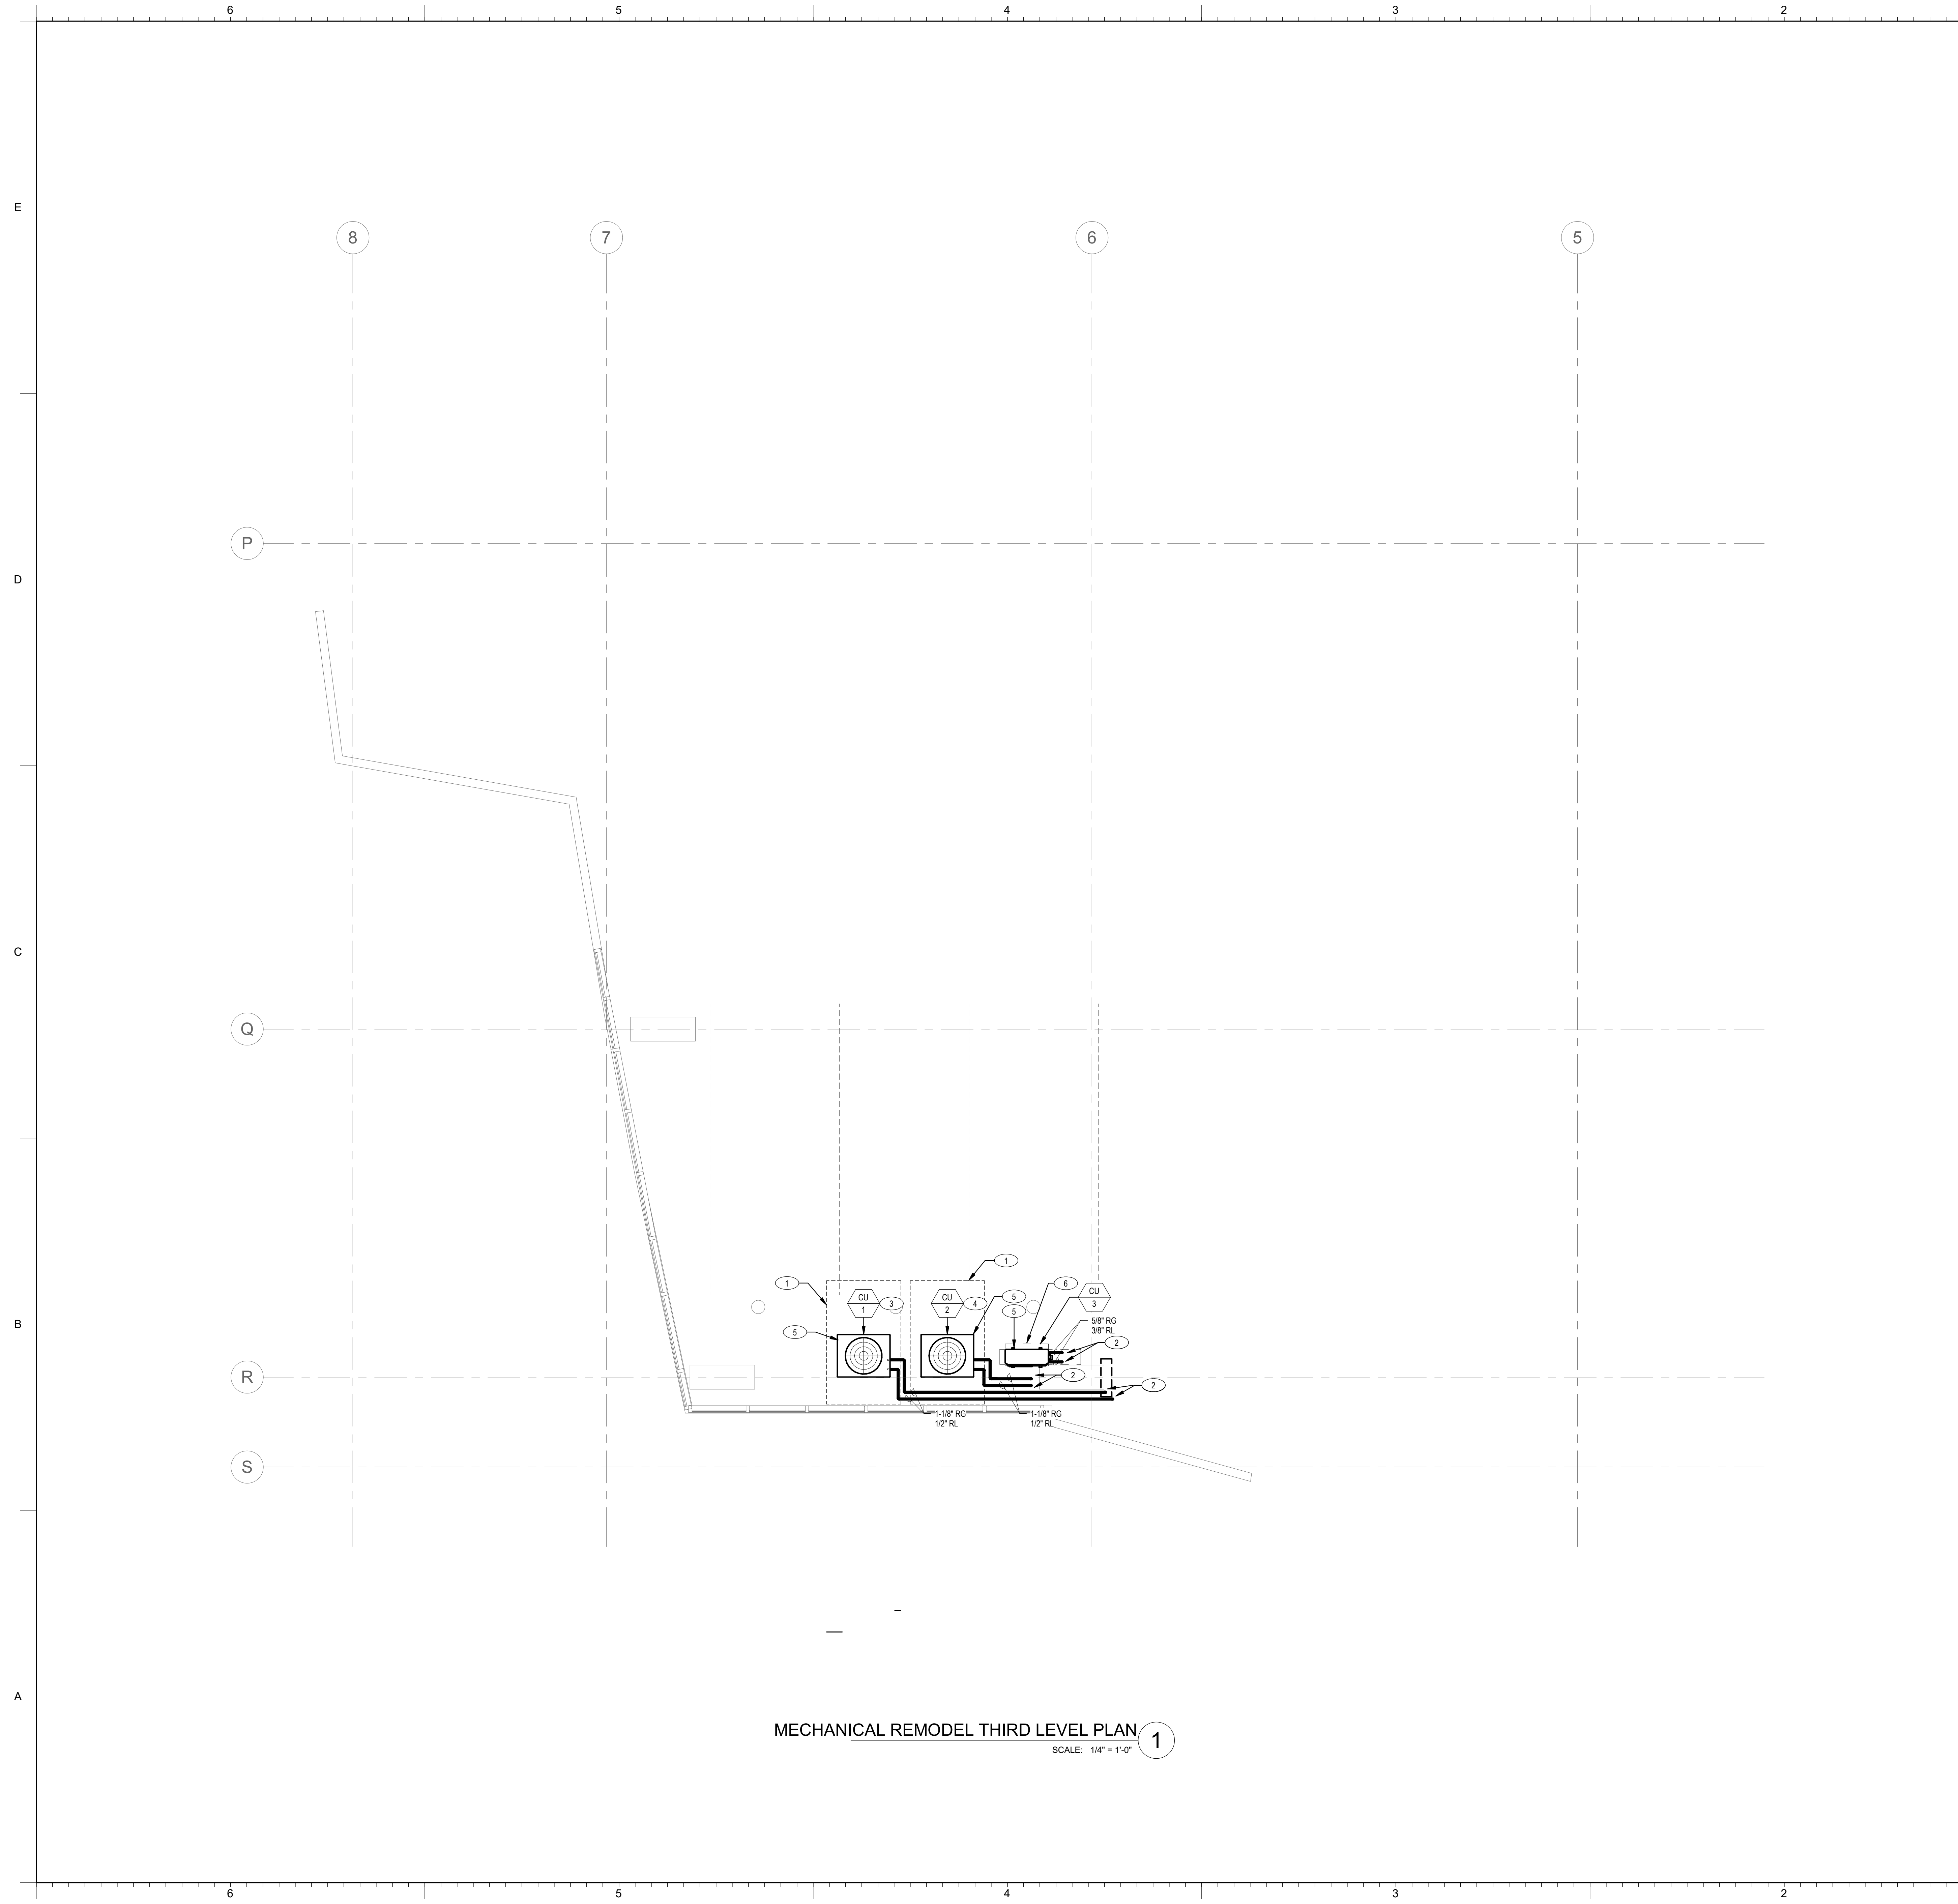

MECHANICAL REMODEL THIRD LEVEL PLAN 1
SCALE: 1/4" = 1'-0"

RENOVATION KEY NOTES

- 1 UNITS TO BE LOCATED AT A MINIMUM OF 20" FROM THE EXTERIOR BUILDING WALL, 6" BETWEEN THE UNITS, AND WITH 40" OF SERVICE CLEARANCE ON THE FRONT SIDE OF THE UNIT.
- 2 REFRIGERATION PIPING ROUTED DOWN TO LEVEL ONE RESTAURANT SPACE THROUGH EXISTING PIPE CHASE. PROVIDE JACKETING ON ALL REFRIGERATION LINES. CONTRACTOR TO CONFIRM EXACT ROUTING IN FIELD.
- 3 CONDENSING UNIT SERVING FAN COILS IN DINING AREA.
- 4 CONDENSING UNIT SERVING FAN COILS IN KITCHEN/BACK OF HOUSE AREA.
- 5 COORDINATE WITH STRUCTURAL ENGINEER TO PROVIDE HOUSEKEEPING PADS, MINIMUM HEIGHT 4".
- 6 SERVICE CLEARANCE FOR CONDENSING UNITS. SERVICE CLEARANCES MAY OVERLAP, BUT NO EQUIPMENT MAY BE PLACED WITHIN THE AREA.

zebra
ZEBRA PROJECTS, INC.
14814 N KIERLAND BLVD, SUITE N 300
SCOTTSDALE, ARIZONA 85254
PHONE: 480.912.1169 www.zbr.co.uk

INFRASTRUCTURE FACTOR CONSULTING, INC.
2361 Rosecrans Ave, Suite 368, El Segundo, CA 90245
P: 310.725.1500 F: 310.725.0215 www.IFactor.com

STORE NO:
CA #1398

SHAKE SHACK
SHAKE SHACK - KOREATOWN
3786 WILSHIRE BLVD. LOS ANGELES, CA 90010

GENERAL NOTES

- 1 WHERE ENCLOSURES ARE NOT REQUIRED, HOODS, GREASE REMOVAL DEVICES, EXHAUST FANS, AND DUCTS SHALL HAVE A CLEARANCE OF NOT LESS THAN 18" TO COMBUSTIBLE MATERIAL, 6" TO LIMITED-COMBUSTIBLE MATERIAL, AND 0" TO NONCOMBUSTIBLE MATERIAL PER ALL APPLICABLE CODE SECTIONS.
- 2 PROVIDE MANUAL BALANCING DAMPER FOR ALL BRANCH DUCTWORK FOR PROPER BALANCING OF ALL AIR SYSTEMS, WHETHER SHOWN ON DRAWINGS OR NOT.
- 3 SEE SHEET MS01 FOR PIPING DIAGRAM DETAIL.
- 4 ENVIRONMENTAL EXHAUST OUTLETS SHALL TERMINATE NO LESS THAN 3' FROM PROPERTY LINE, 3' FROM OPENINGS INTO THE BUILDING AND 10' FROM ANY FORCED AIR INTAKE.
- 5 OUTSIDE AIR FOR A HEATING OR COOLING SYSTEM SHALL NOT BE TAKEN FROM LESS THAN 10' IN DISTANCE FROM AN APPLIANCE VENT OUTLET, A VENT OPENING OF A PLUMBING DRAINAGE SYSTEM, THE DISCHARGE OUTLET OF AN EXHAUST FAN, OR A MEDICAL/SURGICAL VACUUM OUTLET UNLESS THE OUTLET IS 3' ABOVE THE OUTSIDE-AIR INLET.
- 6 510.7.3 CLEARANCE. CLEARANCE FROM THE DUCT OR THE EXHAUST FAN TO THE INTERIOR SURFACE OF ENCLOSURES OF COMBUSTIBLE CONSTRUCTION SHALL BE NOT LESS THAN 18 INCHES (457 MM), AND CLEARANCE FROM THE DUCT TO THE INTERIOR SURFACE OF ENCLOSURES OF NONCOMBUSTIBLE OR LIMITED-COMBUSTIBLE CONSTRUCTION SHALL BE NOT LESS THAN 6 INCHES (152 MM). PROVISIONS FOR REDUCING CLEARANCES AS DESCRIBED IN SECTION 507.4 THROUGH SECTION 507.4.3.3 SHALL NOT BE APPLICABLE TO ENCLOSURES. [NFPA 96.7.7.2.1, 7.7.2.2.3] EXCEPTION: CLEARANCE FROM THE OUTER SURFACES OF FIELD-APPLIED GREASE DUCT ENCLOSURES AND FACTORY-BUILT GREASE DUCT ENCLOSURES TO THE INTERIOR SURFACES OF CONSTRUCTION INSTALLED AROUND THEM SHALL BE PERMITTED TO BE REDUCED WHERE THE FIELD-APPLIED GREASE DUCT ENCLOSURE MATERIALS AND THE FACTORY-BUILT GREASE DUCT ENCLOSURES ARE INSTALLED IN ACCORDANCE WITH THE CONDITIONS OF THE LISTINGS AND THE MANUFACTURER'S INSTALLATION INSTRUCTIONS AND ARE ACCEPTABLE TO THE AUTHORITY HAVING JURISDICTION. [NFPA 96.7.7.2.4]

REVISION

NO.	DATE	DESCRIPTION
1	11/08/21	PERMIT/BID SET
2	01/26/22	REVISION A
3	07/01/22	REVISION 1
4	09/16/22	REVISION 4

STATUS:
PERMIT/BID SET

PRELIMINARY:
Preliminary Documents Are for Design Review only and not for construction. They were prepared by or under the supervision of Zebra Projects, INC.



FIELD VERIFICATION:
The contractor shall verify all signed dimensions and condition at the project site and notify Zebra Projects, INC. of any dimensional errors, or omissions or discrepancies before beginning or fabricating any work. Do not scale these drawings.

COPYRIGHT © 2021:
Zebra Projects, INC. shall retain all common law, statutory and all other reserved rights. Neither the documents nor the information herein is to be reproduced, distributed, disclosed or otherwise used without the written consent of Zebra Projects, INC.

SHEET NAME:
MECHANICAL THIRD FLOOR REMODEL PLAN

DATE: 11/08/21	PROJECT NO: SHK-21-008
DRAWN: SK	SCALE: 1/4" = 1'-0"

SHEET NO:
M221

STORE NO: CA #1398

SHAKE SHACK
 SHAKE SHACK - KOREATOWN
 3786 WILSHIRE BLVD. LOS ANGELES, CA 90010

REVISION	
DATE	DESCRIPTION
11/08/21	PERMIT/BID SET
A 01/26/22	REVISION A
B 02/18/22	REVISION B
C 03/11/22	REVISION C
T 07/01/22	REVISION 1
H 09/16/22	REVISION 4

STATUS: PERMIT/BID SET

PRELIMINARY:
 Preliminary Documents Are for Design Review only and not intended for bidding, permitting, or construction purposes. They were prepared by or under the supervision of Zebra Projects, Inc.



FIELD VERIFICATION:
 The contractor shall verify all signed dimensions and conditions at the project site and notify Zebra Projects, Inc. of any dimensional errors, or omissions or discrepancies, before beginning or fabricating any work. Do not scale these drawings.


COPYRIGHT © 2021:
 Zebra Projects, Inc. shall retain all common law, statutory, and all other reserved rights. Neither the documents nor the information herein is to be reproduced, distributed, filed, or otherwise used without the written consent of Zebra Projects, Inc.

SHEET NAME: MECHANICAL SECTION


DATE: 11/08/21 PROJECT NO: SHK-21-008

DRAWN: SK SCALE: As indicated


SHEET NO: M301

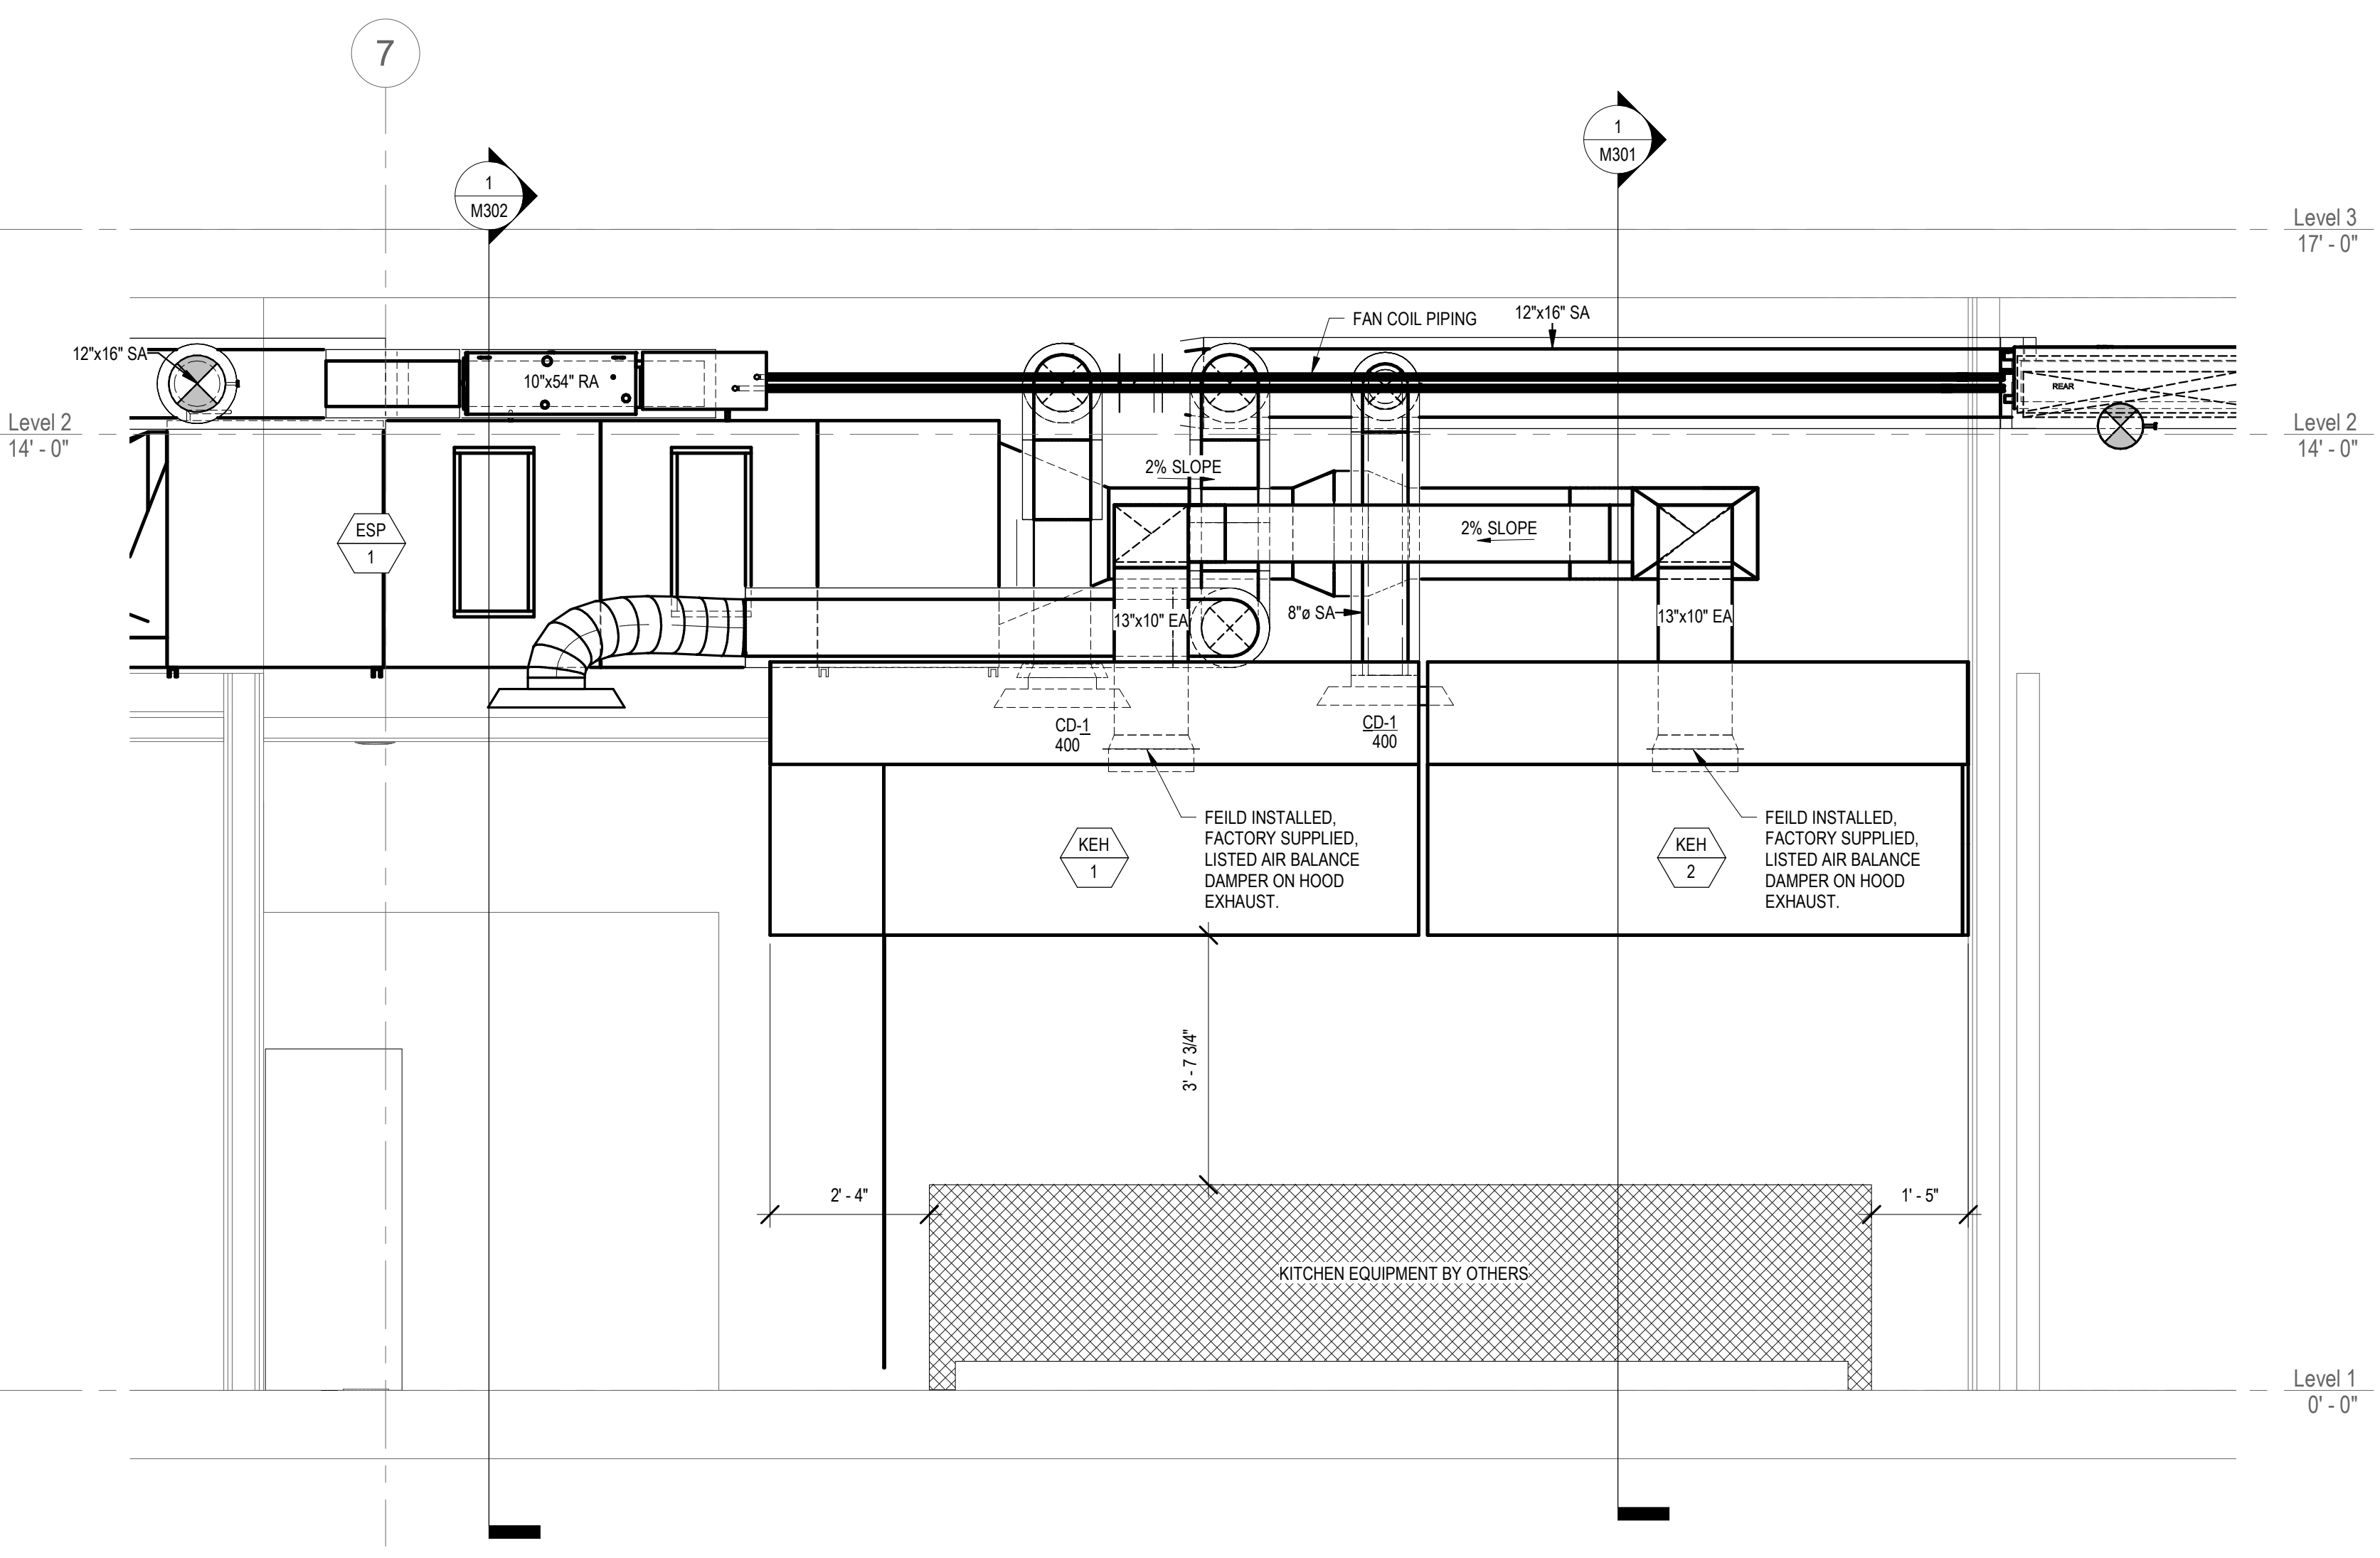

MECHANICAL SECTION - BACK OF HOUSE 2
 SCALE: 1/2" = 1'-0"

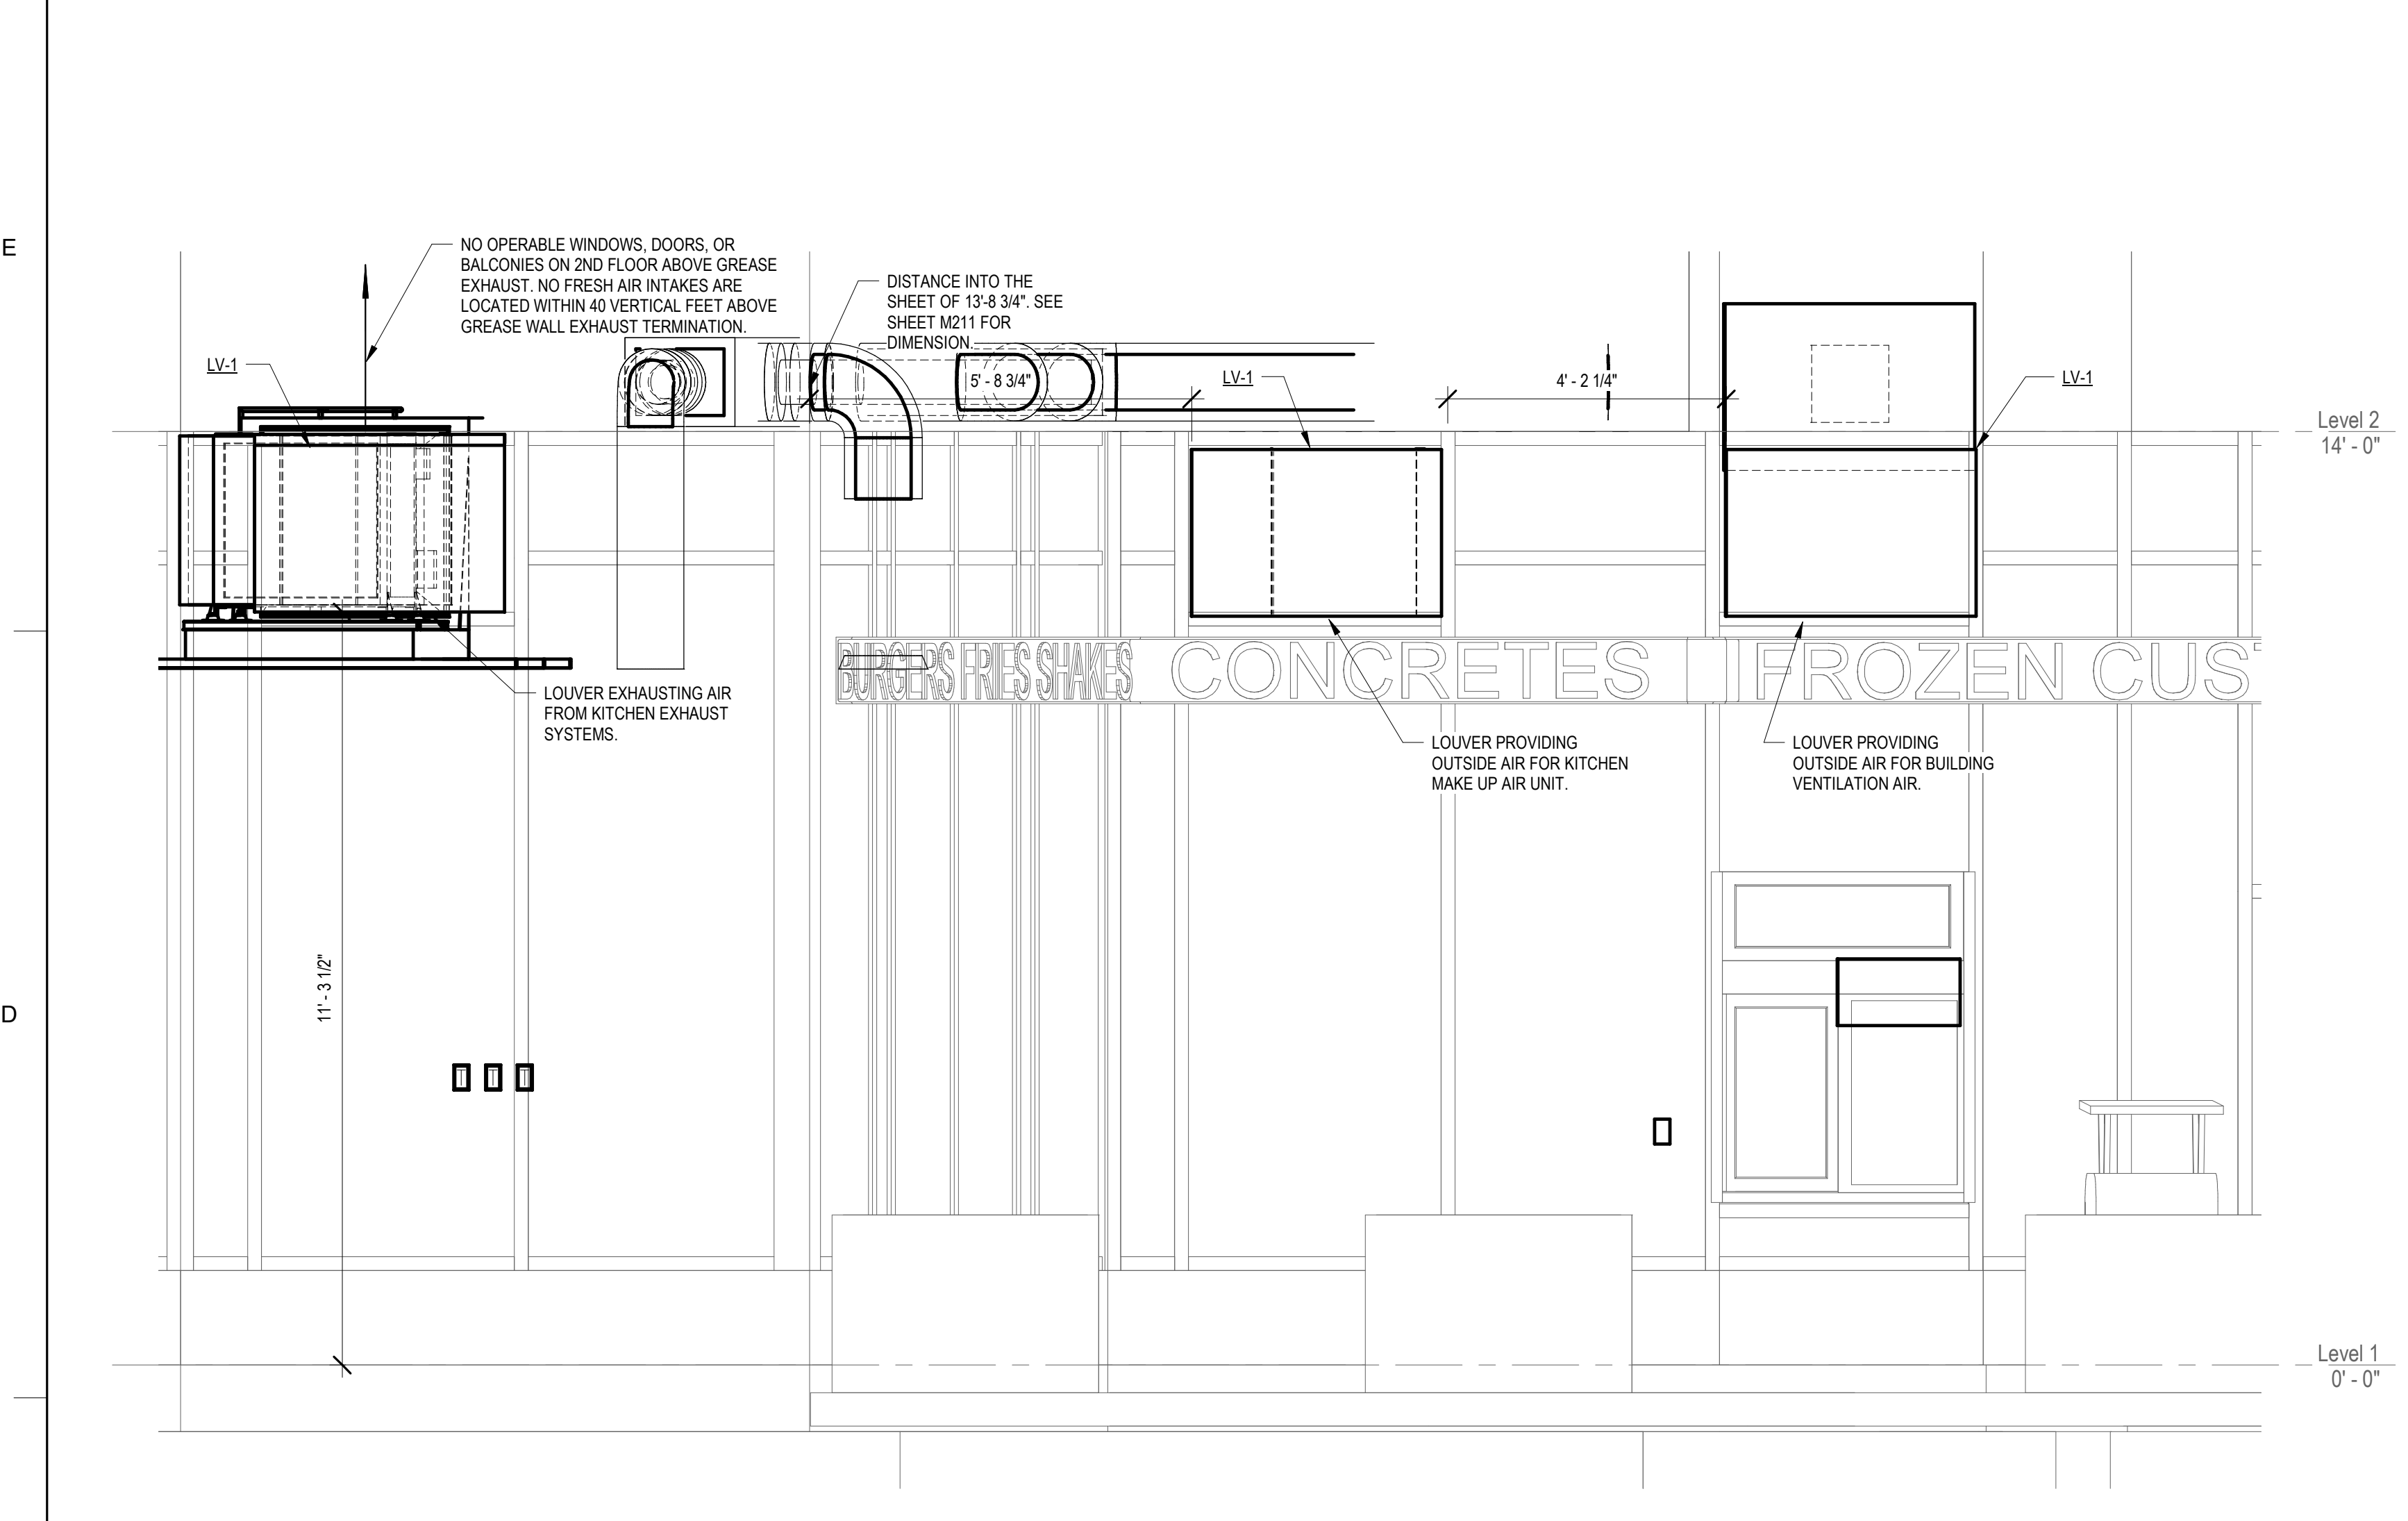

MECHANICAL SECTION - EXTERNAL LOUVERS 3
 SCALE: 1/2" = 1'-0"

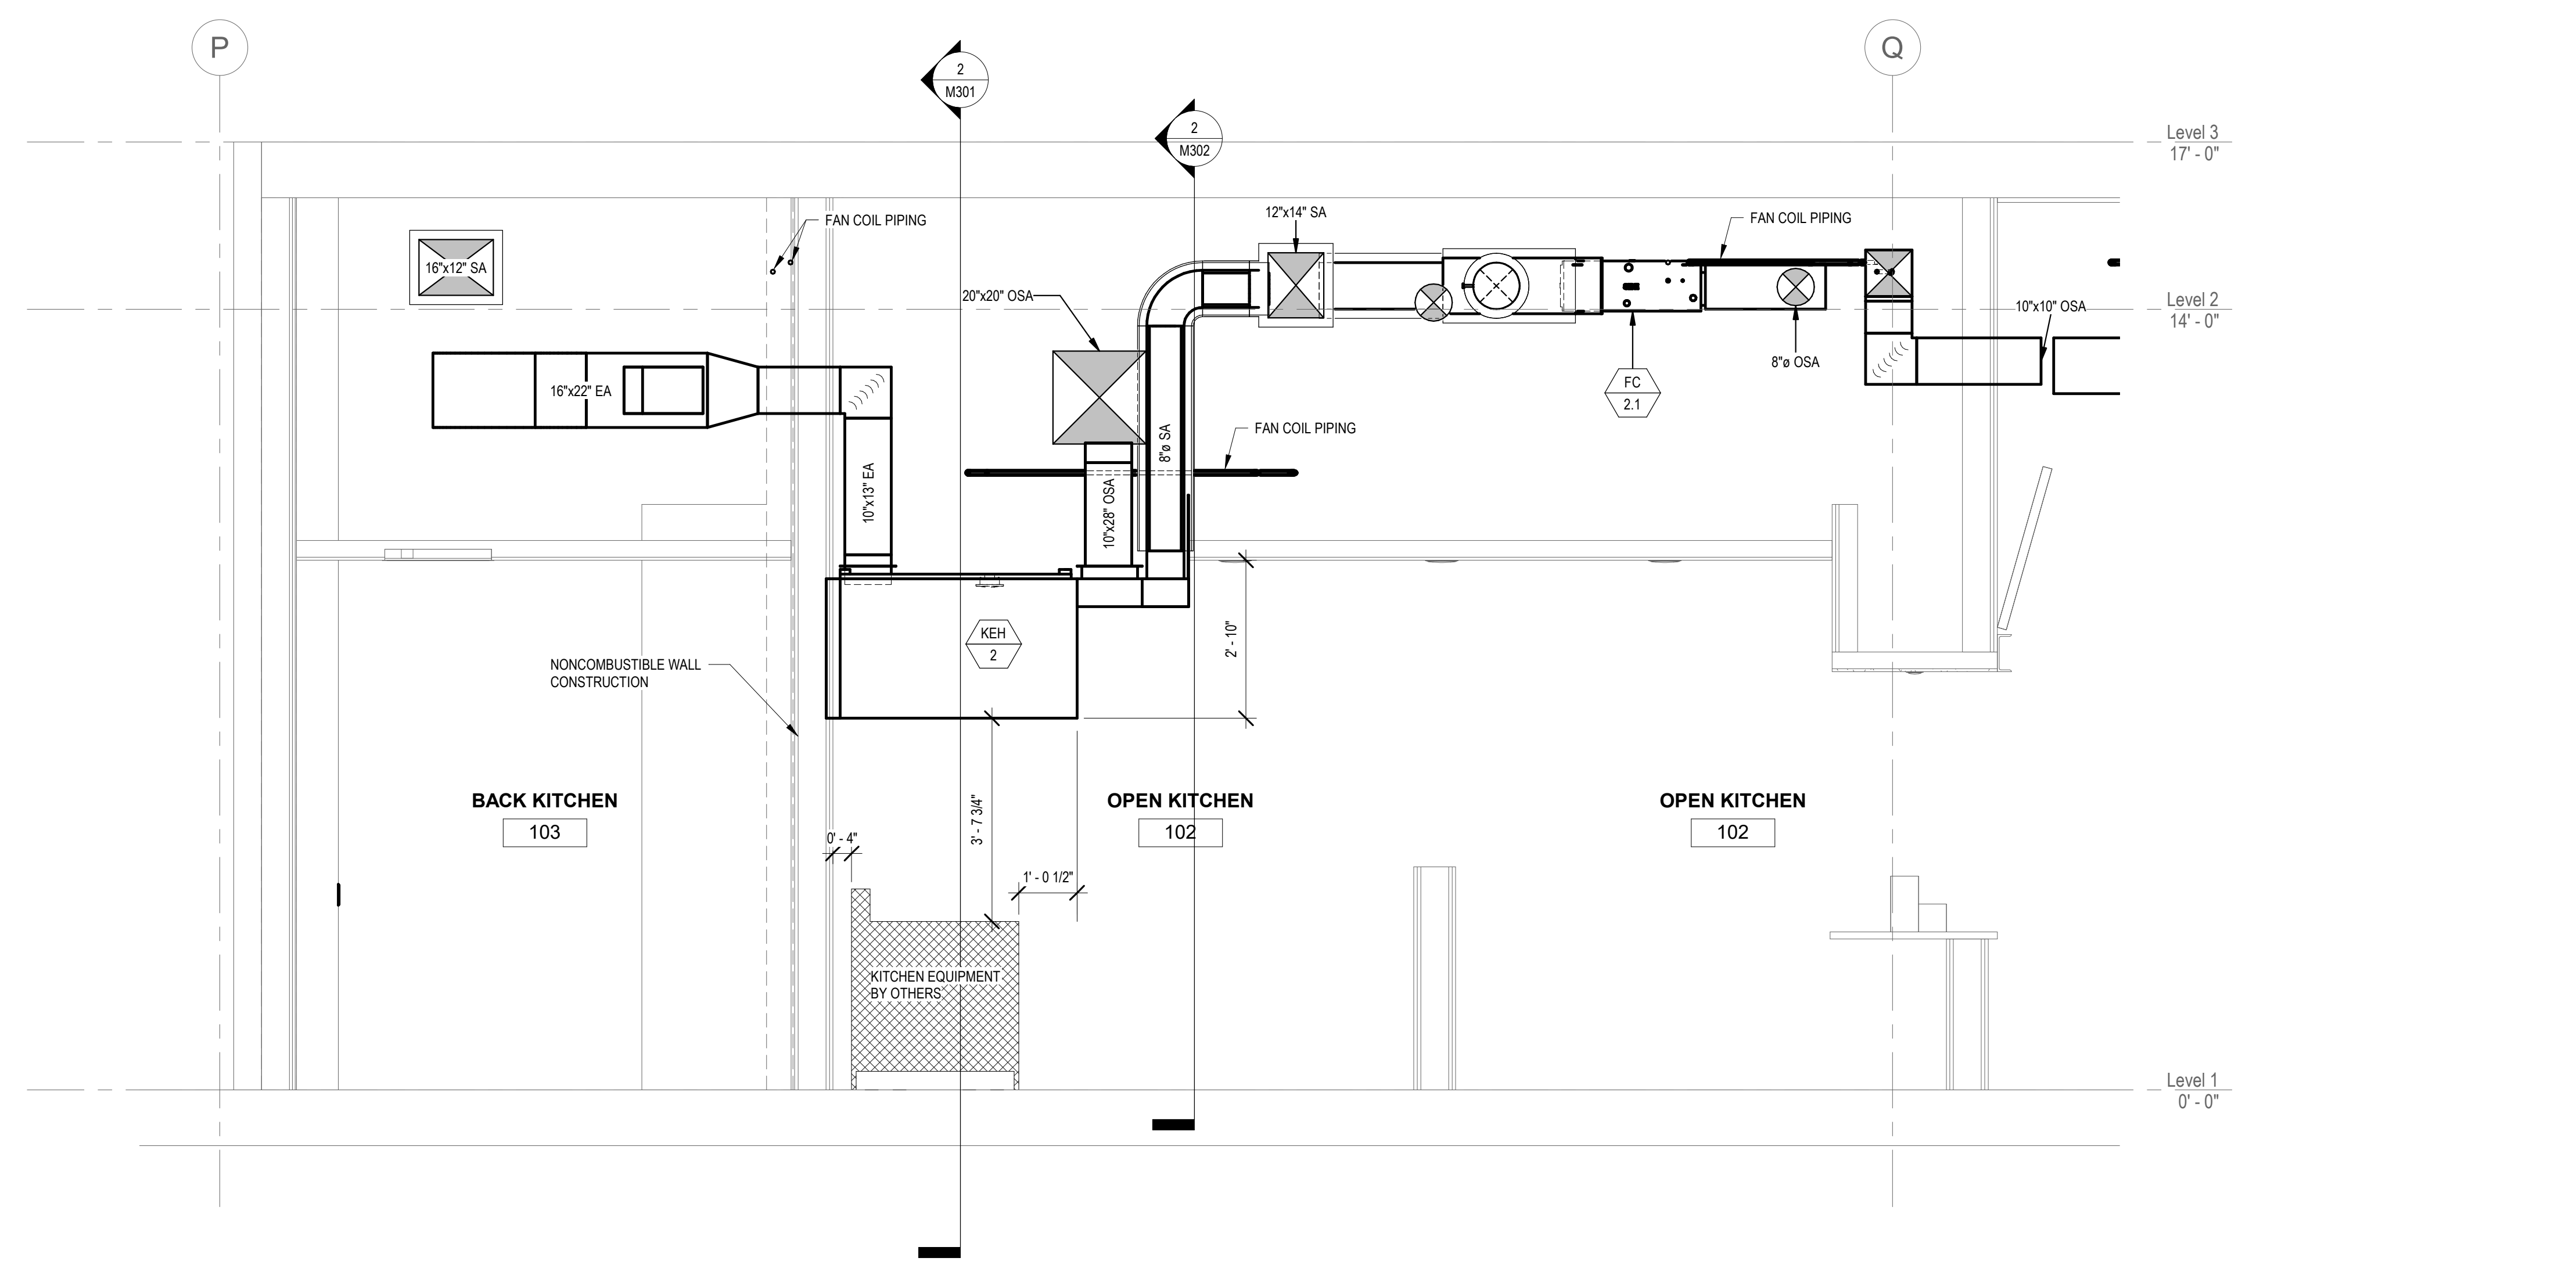

MECHANICAL SECTION - KITCHEN HOODS 1
 SCALE: 1/2" = 1'-0"

STATIC PRESSURE CALCULATIONS: ESP-1

EXHAUST FAN CFM = 2742 CFM
 EXHAUST DUCT VELOCITY TO FAN = 1520 FPM

STATIC PRESSURE LOSSES:
 HOOD RISERS AND GREASE FILTERS = 0.61"

DUCT SIZE	CFM	LENGTH	VELOCITY	DUCTS AND FITTINGS
30"x30"	2742	8 FEET	560 FPM	0.02"
22"x16"	2742	10 FEET	1122 FPM	0.13"
13"x10"	1371	8 FEET	1520 FPM	0.15"

20% SAFETY FACTOR = 0.20"
 TOTAL S.P. = 1.11"

STORE NO:
CA #1398

SHAKE SHACK
SHAKE SHACK - KOREATOWN
3786 WILSHIRE BLVD. LOS ANGELES, CA 90010

REVISION	
DATE	DESCRIPTION
1 10/7/12	REVISION 1
4 09/16/22	REVISION 4
5 10/19/22	REVISION 5
6 10/11/22	REVISION 6

STATUS:
PERMIT/BID SET

PRELIMINARY:
Preliminary Documents Are for Design Review only and not intended for bidding, permitting, or construction purposes. They were prepared by or under the supervision of Zebra Projects, Inc.



FIELD VERIFICATION:
The contractor shall verify all signed dimensions and condition at the project site and notify Zebra Projects, Inc. of any dimensional errors, or omissions or discrepancies before beginning or fabricating any work. Do not scale these drawings.

COPYRIGHT © 2021:
Zebra Projects, Inc. shall retain all common law, statutory and all other reserved rights. Neither the documents nor the information herein is to be reproduced, distributed, photocopied or otherwise without the written consent of Zebra Projects, Inc.

SHEET NAME:
MECHANICAL SECTION


DATE:
06/29/22

PROJECT NO:
SHK-21-008

DRAWN:
Author


SCALE:
1/2" = 1'-0"

SHEET NO:
M302

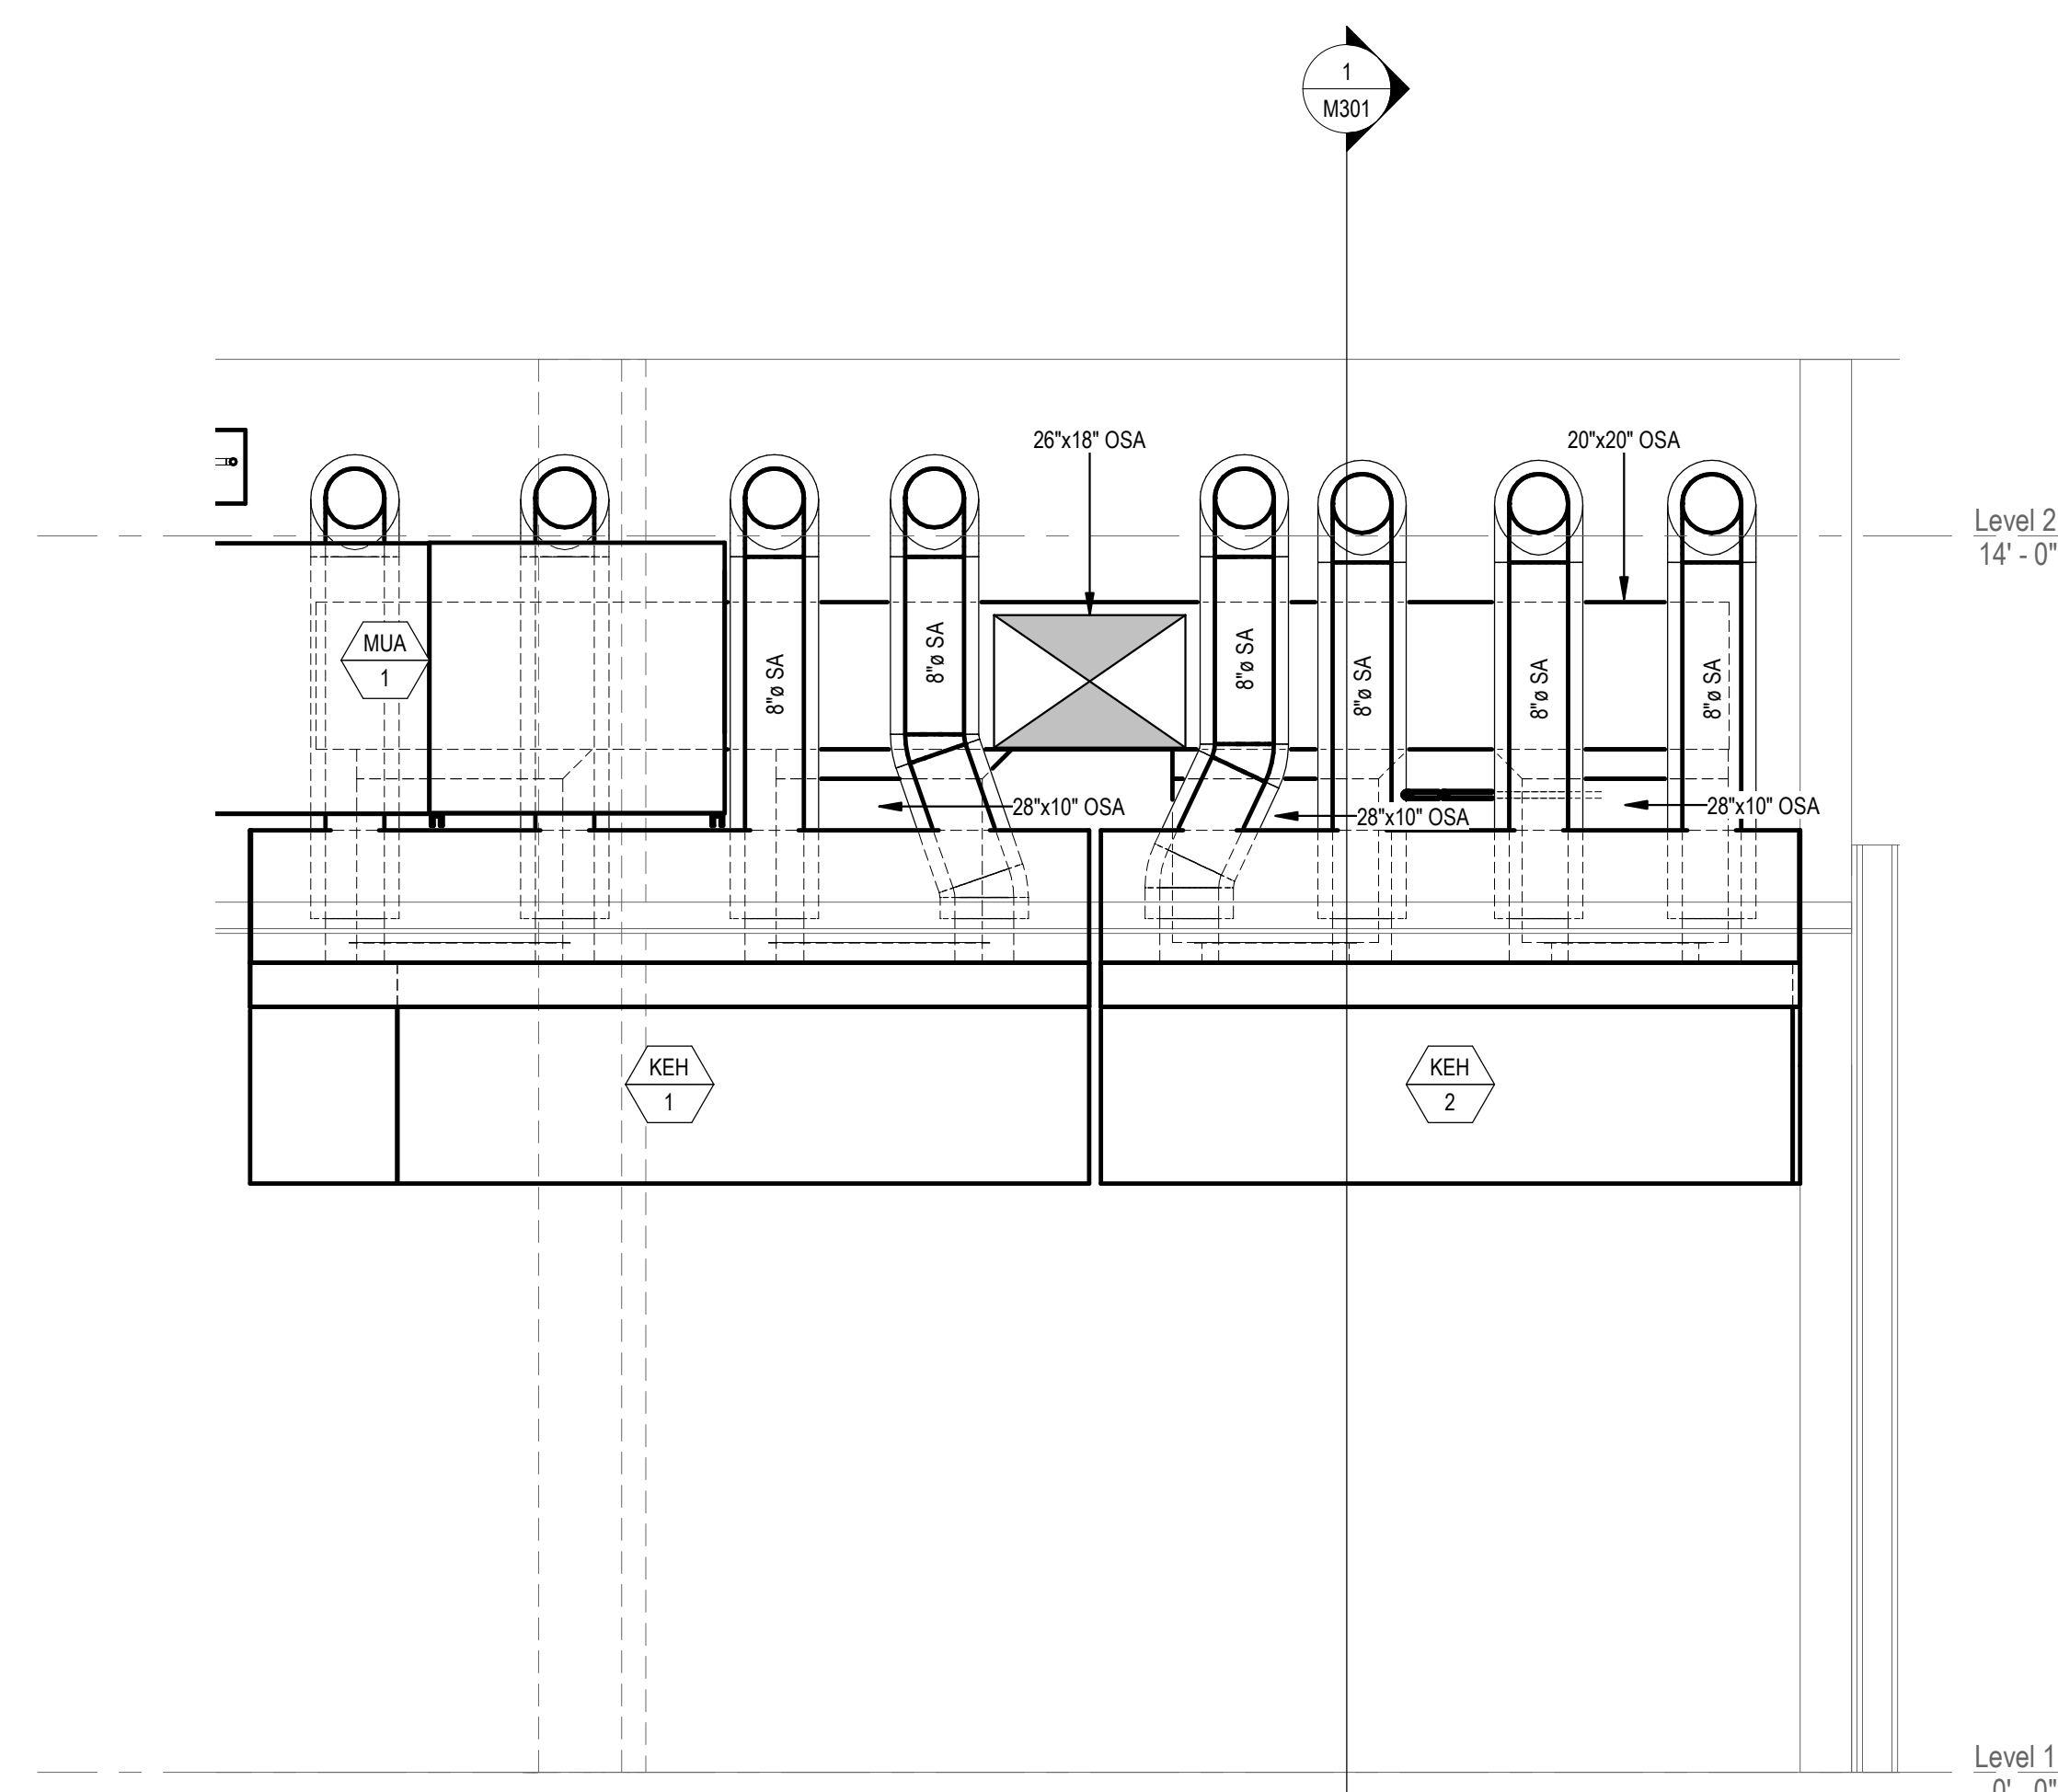

MECHANICAL SECTION - SUPPLY AIR TO KITCHEN HOODS 2

SCALE: 1/2" = 1'-0"

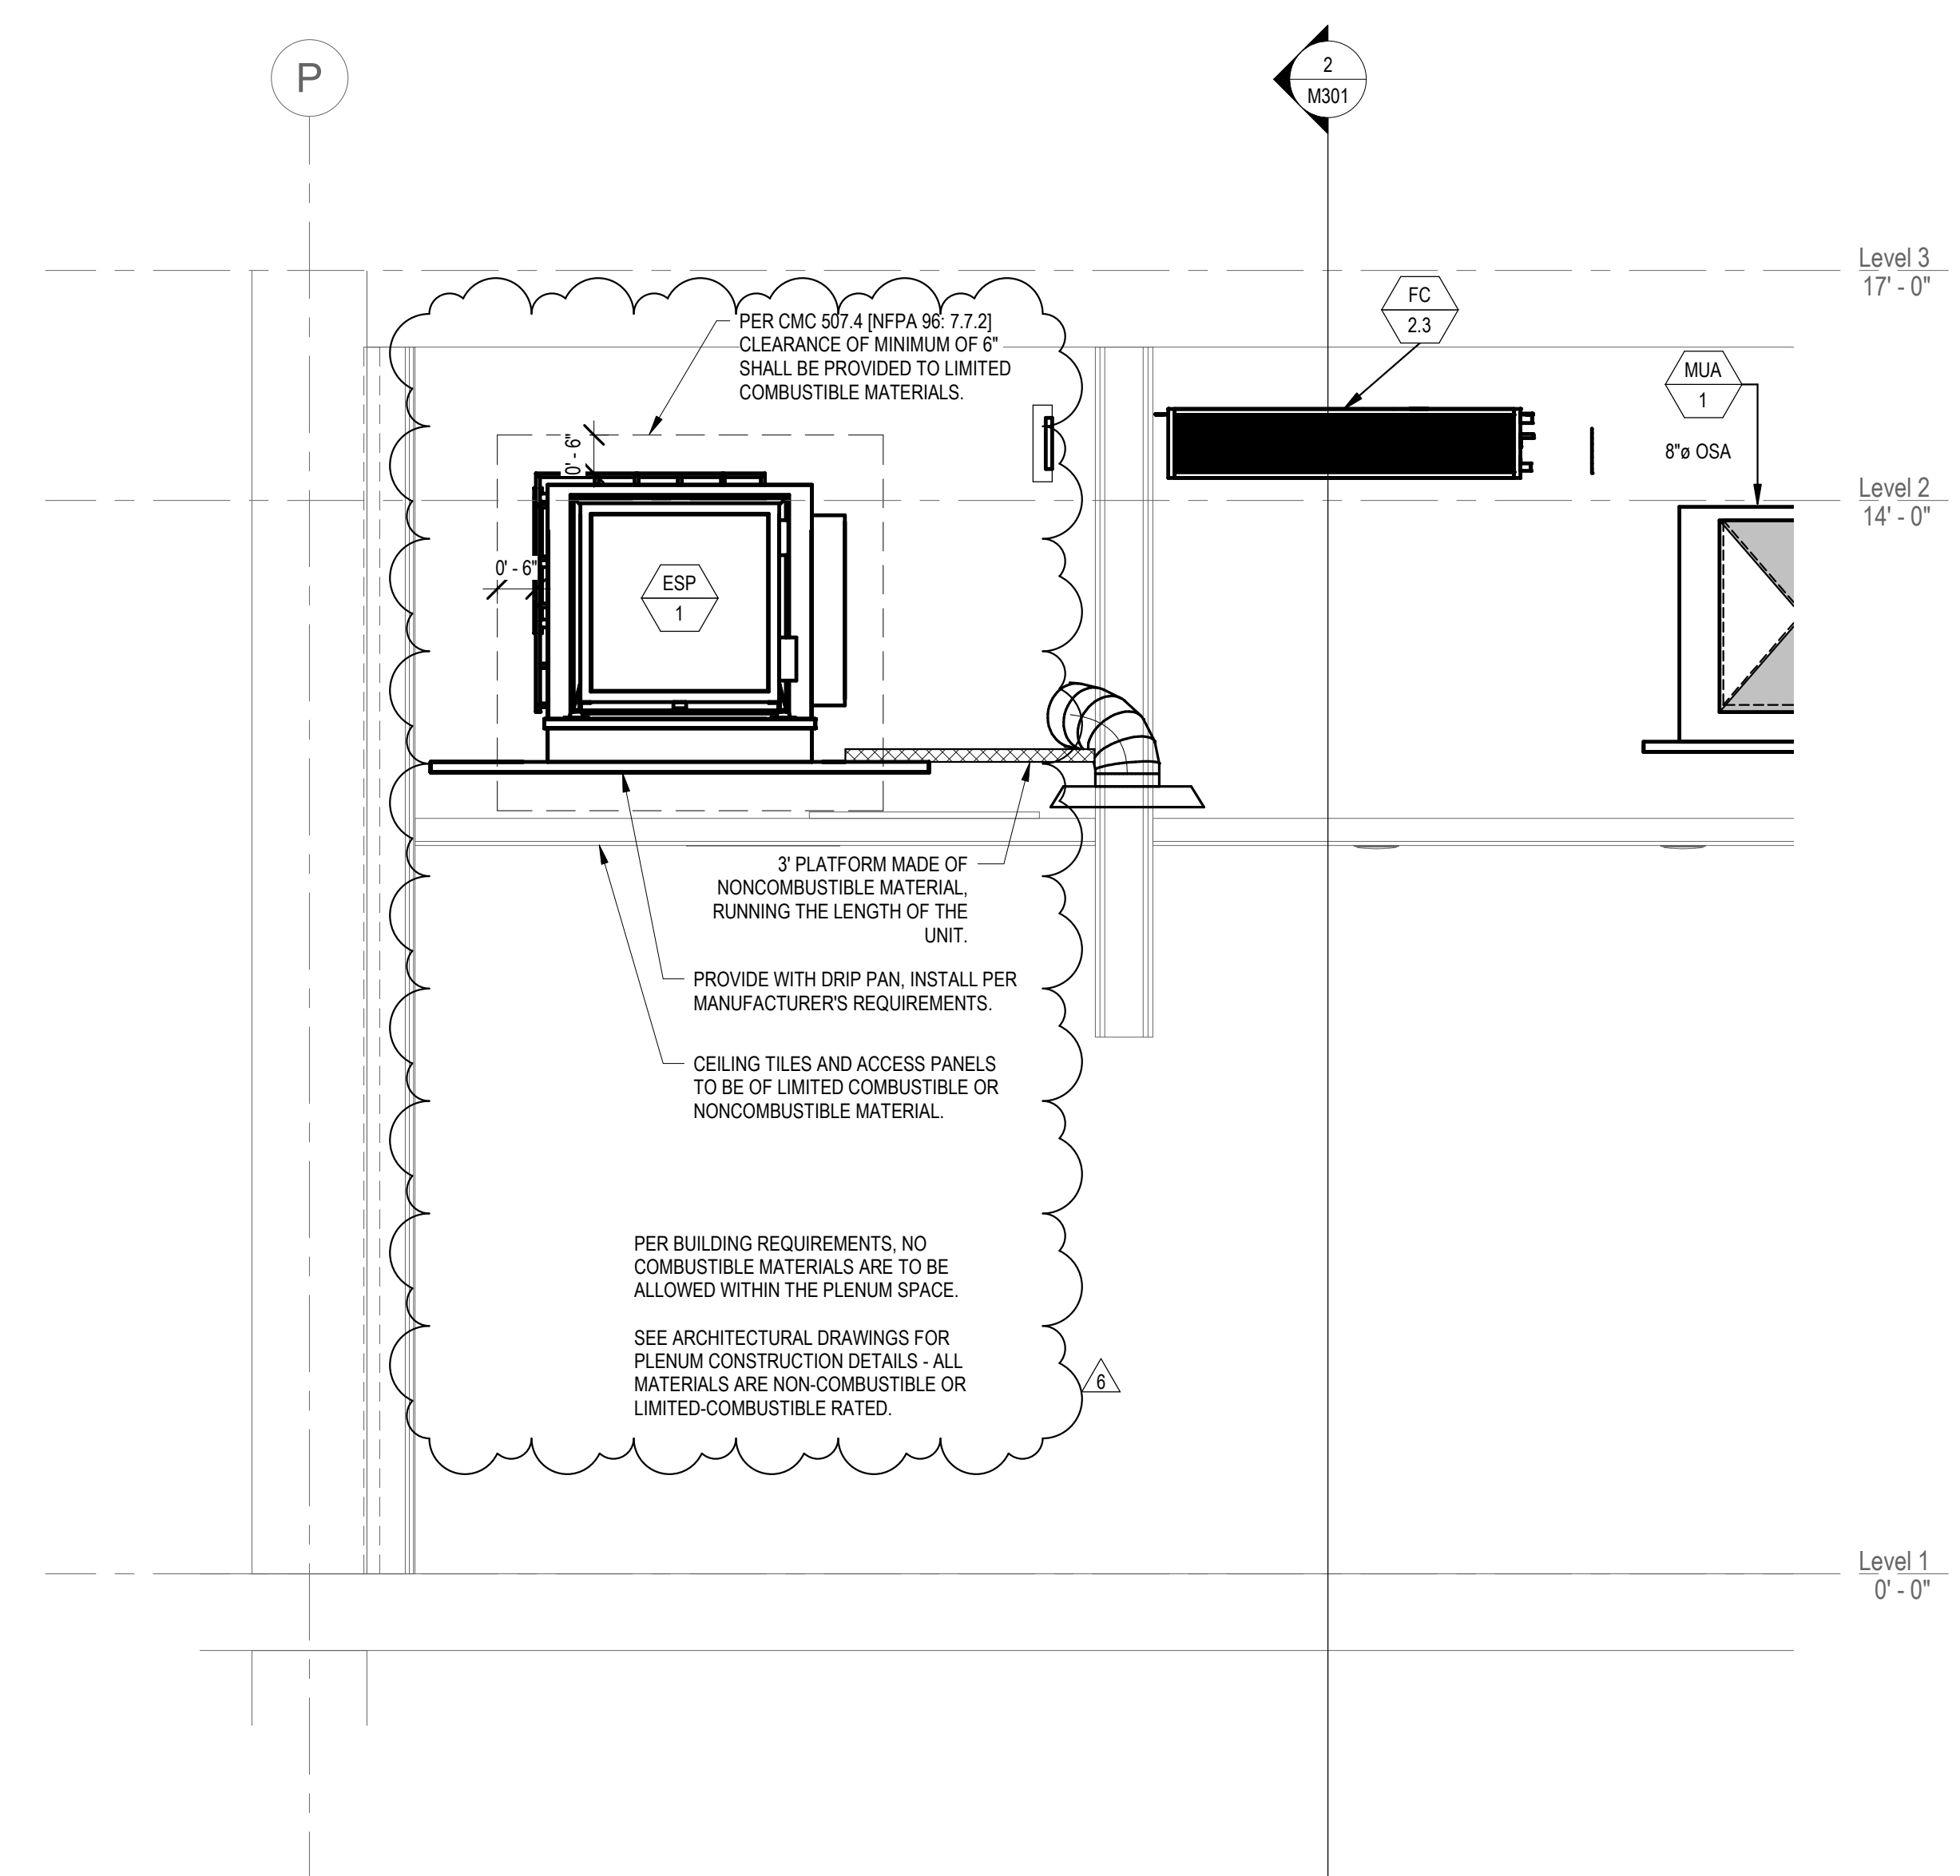

MECHANICAL SECTION - ESP UNIT 1

SCALE: 1/2" = 1'-0"

STORE NO:
CA #1398

SHAKE SHACK
SHAKE SHACK - KOREATOWN
3786 WILSHIRE BLVD. LOS ANGELES, CA 90010

REVISION	
DATE	DESCRIPTION
11/08/21	PERMIT/BID SET
A 01/26/22	REVISION 1
1 07/01/22	REVISION 1
4 09/16/22	REVISION 4
5 10/19/22	REVISION 5
6 10/11/22	REVISION 6

STATUS:
PERMIT/BID SET

PRELIMINARY:
The contractor shall verify all signed dimensions and conditions at the project site and notify Zebra Projects, INC. of any dimensional errors, or omissions or discrepancies, before beginning or resuming any work. Do not scale these drawings.



FIELD VERIFICATION:
The contractor shall verify all signed dimensions and conditions at the project site and notify Zebra Projects, INC. of any dimensional errors, or omissions or discrepancies, before beginning or resuming any work. Do not scale these drawings.


COPYRIGHT © 2021:
Zebra Projects, INC. shall retain all common law, statutory, and all other reserved rights. Neither the documents nor the information herein is to be reproduced, distributed, filed, or otherwise used without the written consent of Zebra Projects, INC.

SHEET NAME:
MECHANICAL DETAILS


DATE: 11/08/21 PROJECT NO: SHK-21-008

DRAWN: SK SCALE:

SHEET NO:
M501

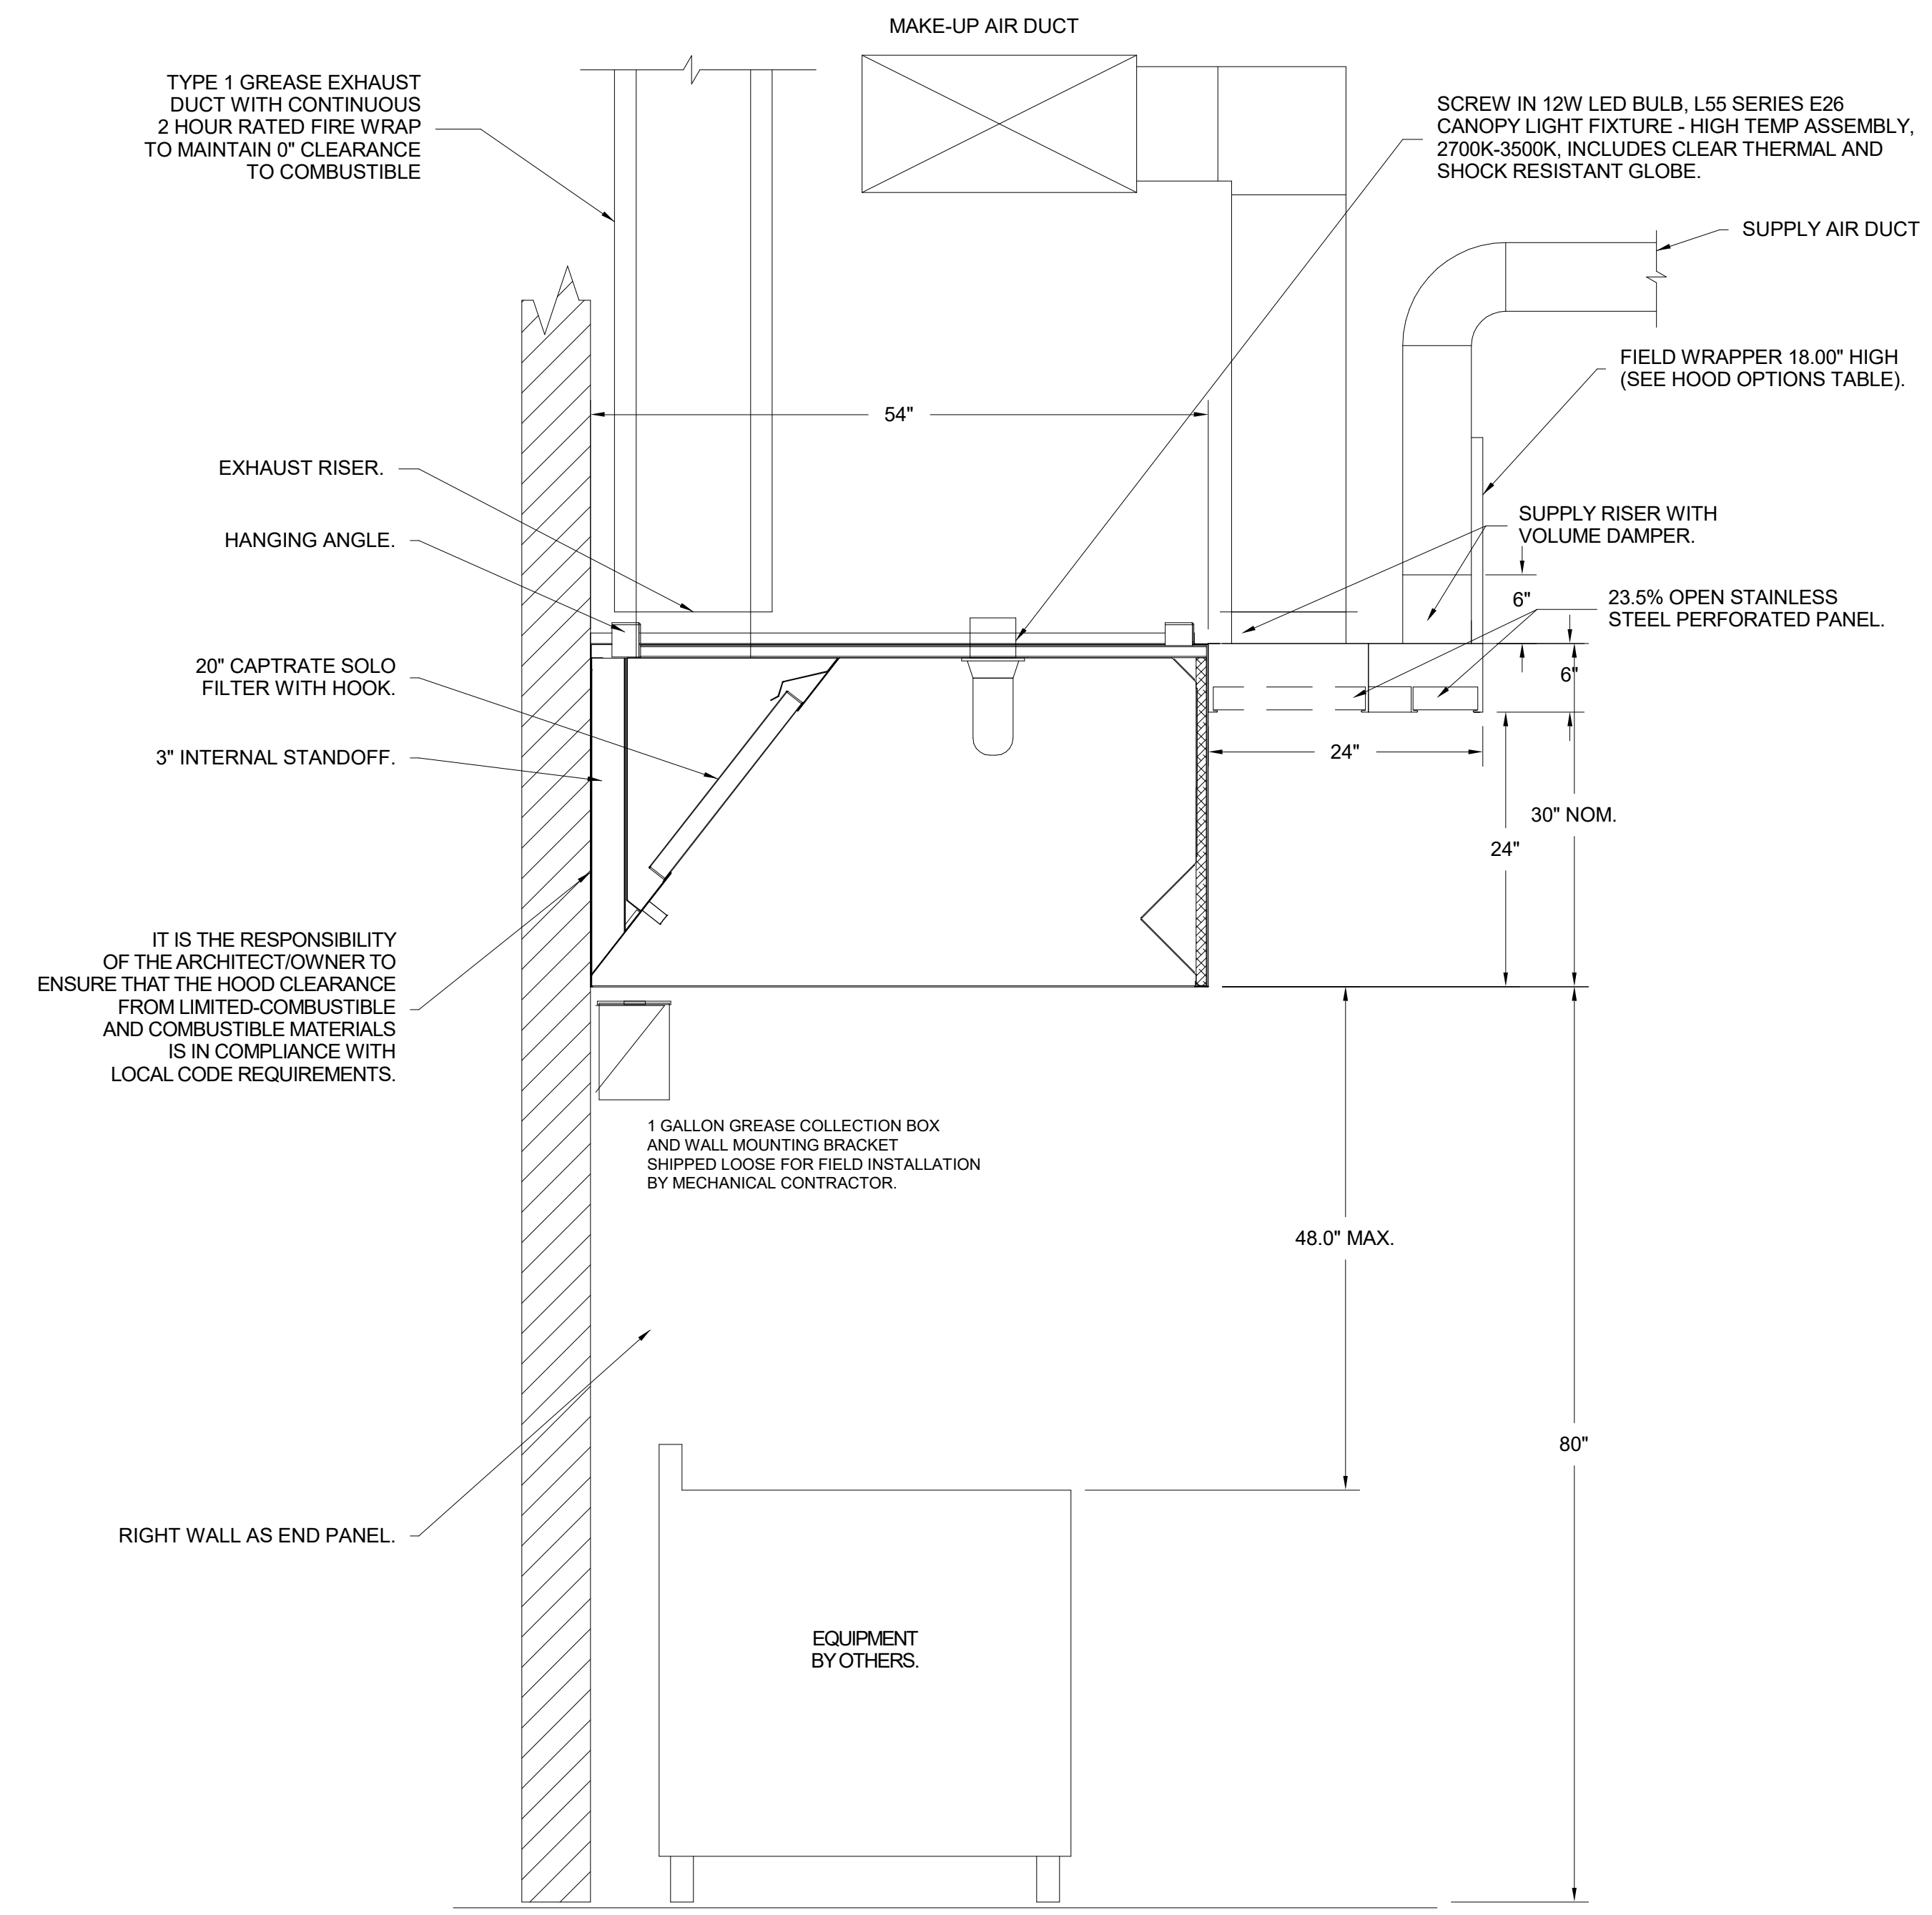


KITCHEN HOOD ELEVATION
SCALE: NTS

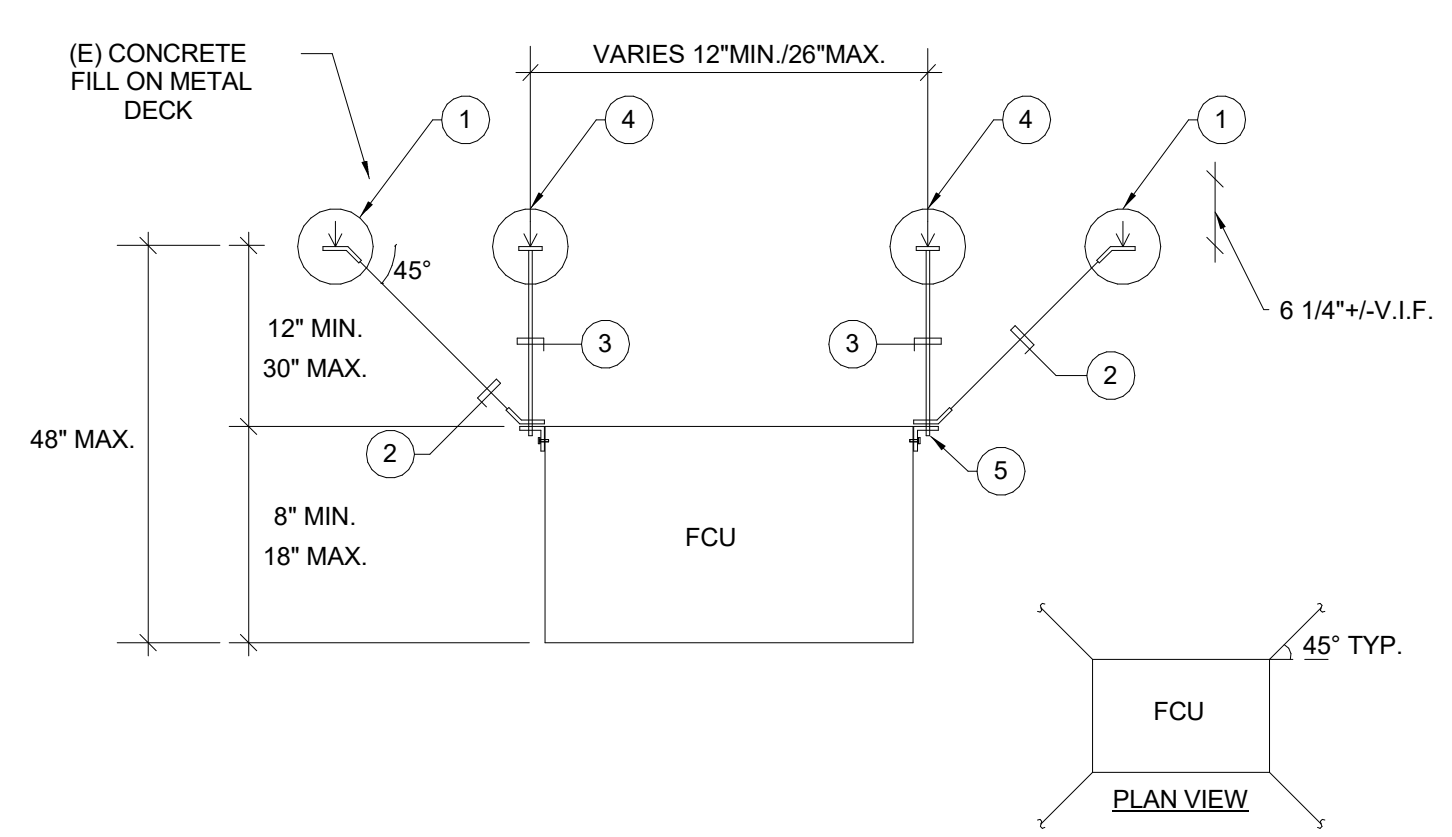


- NOTES:
- 3/8" HILTI KBTZ W/ 2" EMBED AT CENTERLINE OF BOTTOM FLUTE, TYPICAL.
 - MASON SCBA-1 SEISMIC CABLE BRACE AND ANCHOR, TYPICAL OF (4), NOT REQUIRED IF WEIGHT IS LESS THAN 75 LBS.
 - 1/2" HANGER ROD, WITH ROD STIFFENERS (TYP-4), USE DBL NUT AND WASHERS AT ROD CONNECTION TO UNIT MOUNTING BRACKET AND SINGLE NUT AND WASHER AT TOP CONNECTION.
 - 3/8" HILTI KBTZ WITH 2" EMBED AT CENTERLINE OF LOW FLUTE WITH COUPLING NUT FOR 1/2" ROD. (TYP. OF 4)
 - BUILT-IN MOUNTING BRACKET BY MANUFACTURER.


FAN COIL MOUNTING DETAIL
SCALE: NTS

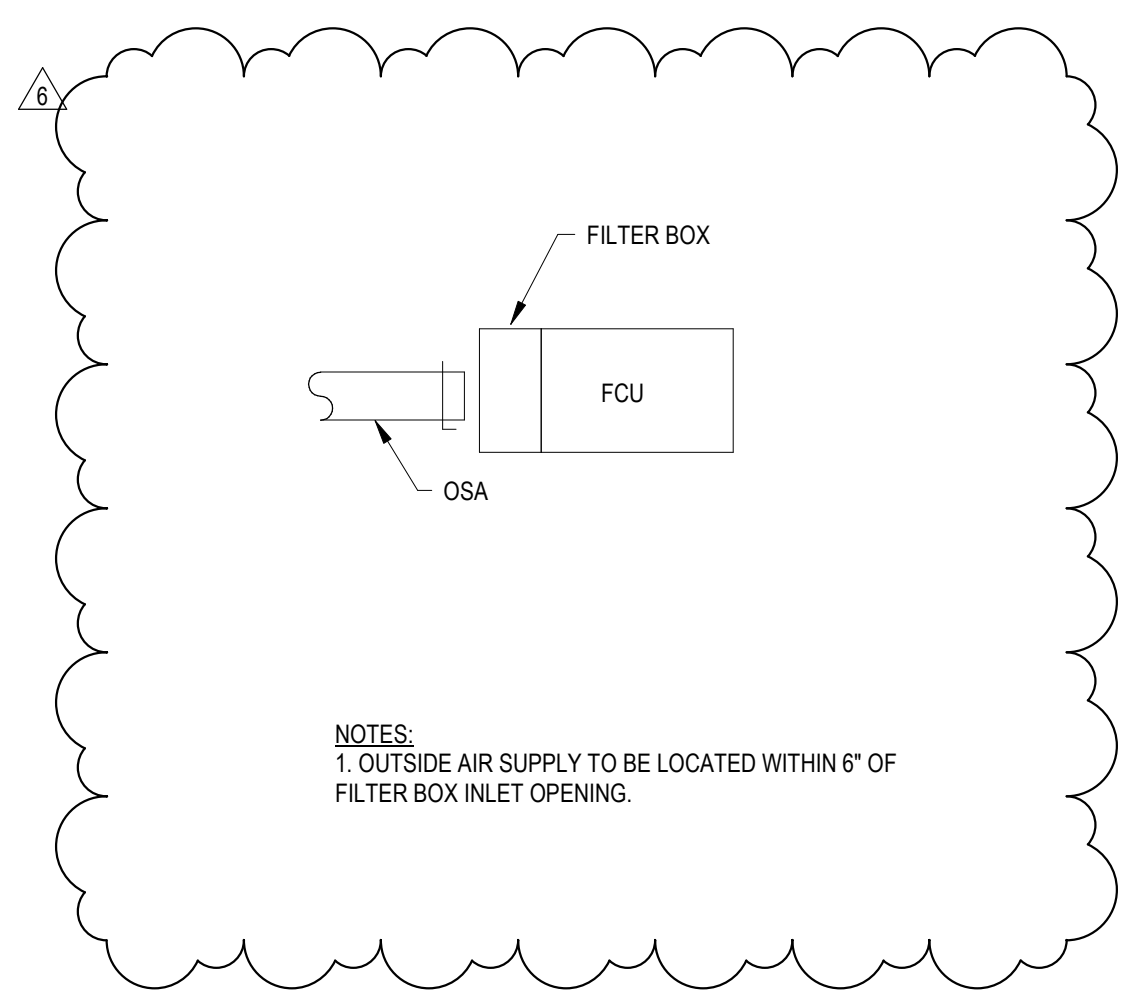


OSA FILTER BOX CONNECTION DETAIL
SCALE: 12" = 1'-0"

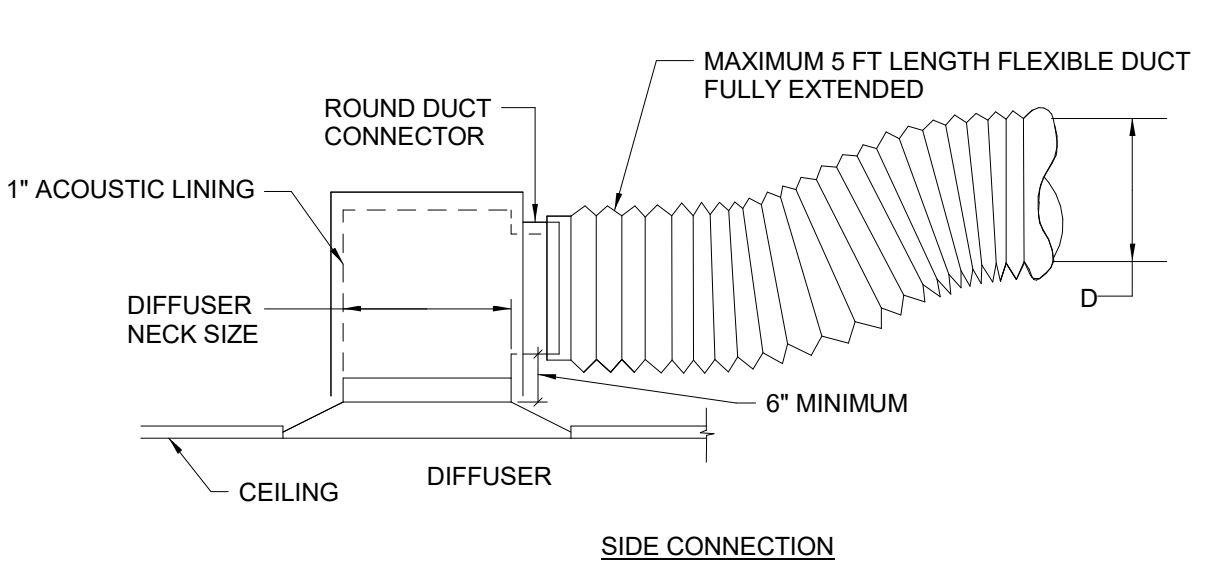

SIDE CONNECTION

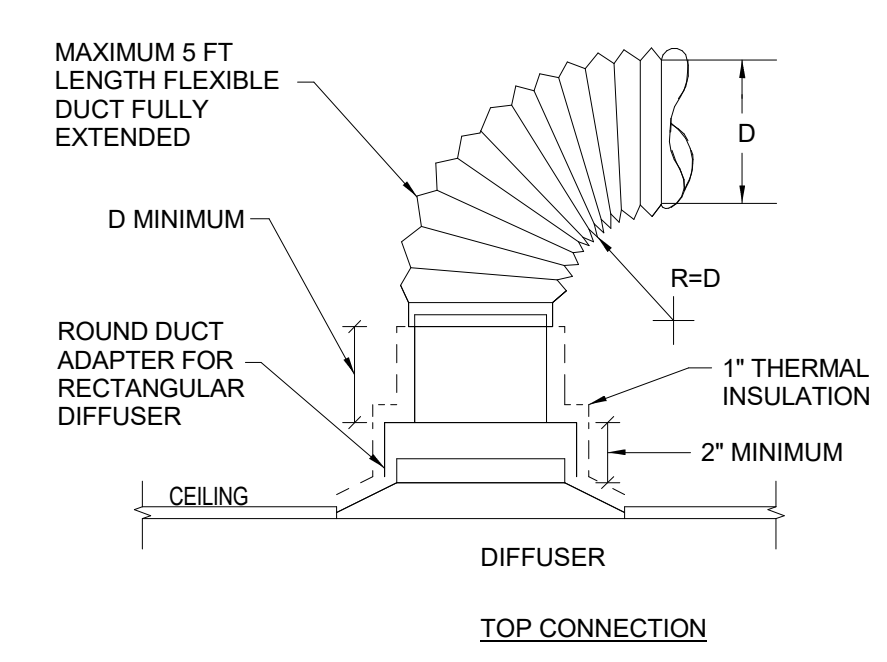


TOP CONNECTION

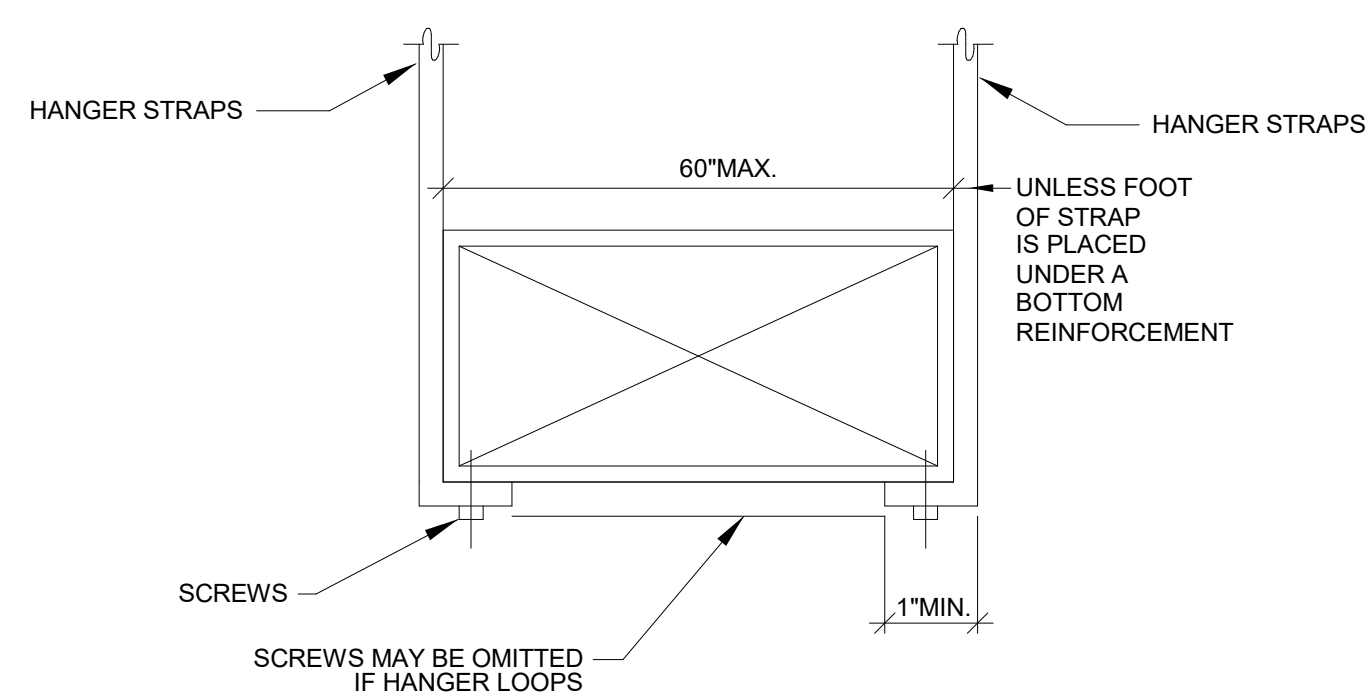

- NOTES:
- FOR HANGER SIZE AND SPACING, SEE SMACNA HVAC DUCT CONSTRUCTION STANDARDS TABLE.
 - FOR UPPER ATTACHMENT TO BUILDING SEE SMACNA HVAC DUCT CONSTRUCTION STANDARDS, WITH SPECIFIC STRUCTURAL ENGINEER APPROVAL.
 - FOR BRACING AND OTHER SEISMIC REQUIREMENTS SEE SPECIFICATIONS

DUCT SUPPORT DETAIL
SCALE: NTS

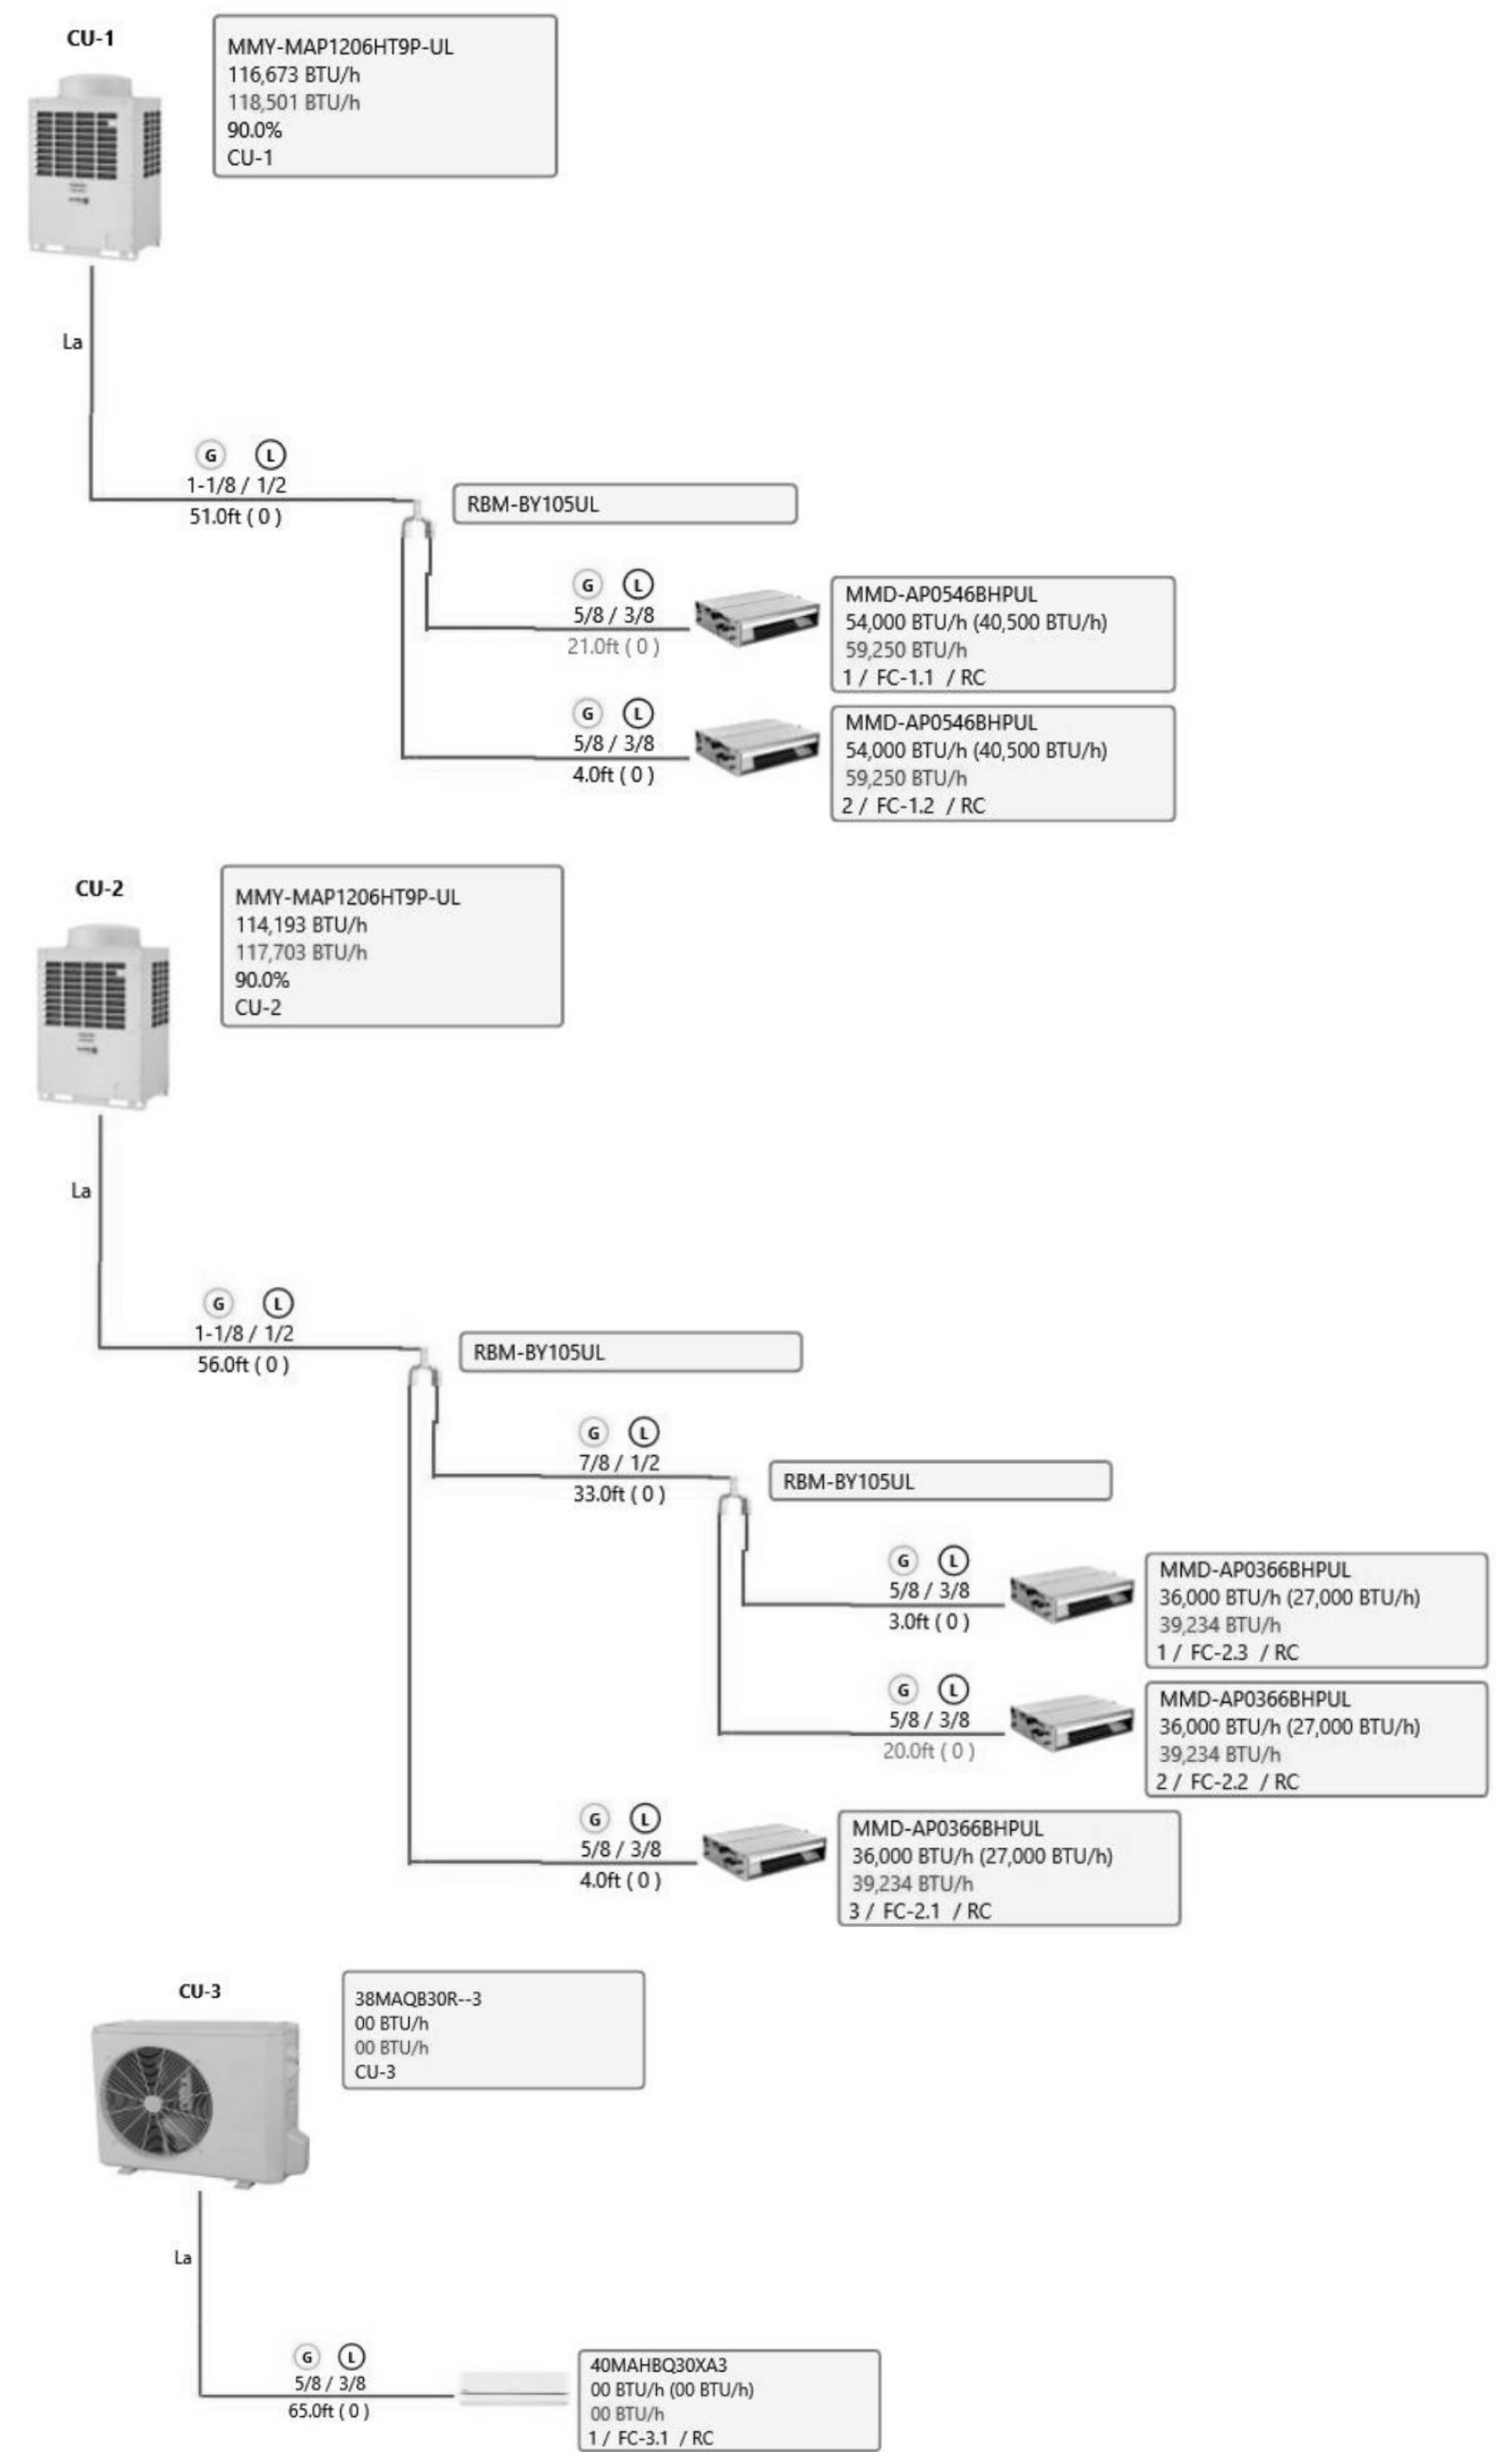

SV-DTL-08_CU PIPING
SCALE: 12" = 1'-0"

DIFFUSER CONNECTION DETAIL
SCALE: NTS



Atlanta, Austin, Chicago,
Columbus, Dallas, Denver, Des
Moines, Houston, Kansas City,
Mpls, Orlando, St Louis
TOLL FREE
800-325-VIRO(8476)

Water Leak Testing of New and Existing Grease exhaust vent systems.
Summary: A high pressure multi-nozzle spinjet in conjunction (where needed) with a 15 degree or wider single nozzle lance is to be passed through all new grease exhaust vent systems with the water spray contacting all interior portions of the duct. This is to check for any liquid leakage in the system plus to check for adequate access and other problems that can be repaired during the construction or leak testing phase. All water used in the test must be collected in some fashion for discharge to a sanitary drain.

1. The water testing job shall be scheduled after the welded grease exhaust system with the hood and all access plates installed. The leaktesting can be done in multi stages for tall multi story runs or multi story multi duct runs, but there must be one final test of all connection joints.
2. All testing is to be done before any fire-wrap is installed or with fire wrap removed.
3. Testing Contractor shall verify water availability, building access, electrical availability, amount of high pressure hose needed to reach all areas of system, and any needed roof access with Job Superintendent when scheduling job.
4. The testing company should also re-verify during job reminder phone call that is to be made by Testing Contractor to the Job site Superintendent the working day before the job is scheduled.
5. A water source where a hose can be connected shall be available
6. A high pressure washer with minimum capabilities of 1000PSI @ 3GPM. (minimum requirements to run a multi nozzle duct cleaner known as a spinjet or roto-nozzle)
7. Adequate high pressure hose along with a 6" or 12" spinjet (or Roto-nozzle) shall be required.
8. The work should normally start at the intake(Hood) portion of the system (or at the electrostatic precipitator where applicable). The leaktest may start from other areas of the system depending on layout.
9. The nozzles shall progress through the system at a rate of approximately one foot every five seconds until it reaches the end point.
10. With the hood in place, the Testing Company shall collect the wastewater similar to a routine cleaning with the hood taped and clamped up with at least two mil or thicker clear poly (Plastic) funneling into a large watertight brute (or similar) bucket.
11. A water vacuum shall be used to make sure all excess water is removed from hood and ductwork when done.
12. The general contractor's welder shall be on-site during the leaktesting with proper welding equipment(A MIG welder is highly recommended), a bright portable light, with access to all parts of the system.
13. A spotter with the welder shall access the outside of the ductwork to spot any leaks.
14. If the duct leaks, the leaks shall be repaired and the test is to be redone
15. Additional leaks shall continue to be repaired and re-tested until no leaks exist.
16. When testing is completed, The Testing Company shall dry out the duct, remove the plastic and return system
17. The Testing Company will take pictures of the system and procedure, then e-mail them to Enviromatic to verify the job is done correctly.

18. A leaktest form shall be filled out and signed that system is liquid tight as specified by NFPA96 guidelines.
19. The leaktest form shall note number of leaks found, number of re-testing required in needed, rough drawing of the system with access plate locations and where the leaks were found and repaired. The form shall have signature lines for both the job site representative and the testing company representative.
20. If any sealant (EX: JB Weld, epoxies,etc) is found in a welded duct, the test shall immediately fail and the leaktesting will cease immediately until all sealant is removed to bare metal or bare welds.
21. For listed ducts with sealed joints, only the listed sealant shall be used. The leaktesting will progress in the same manner as the welded ducts EXCEPT leakage requiring sealant repairs will need to cure for the required time before re-testing.

STORE NO:
CA #1398



REVISION	
DATE	DESCRIPTION
11/08/21	PERMIT/BID SET
A 01/28/22	REVISION A
1 07/01/22	REVISION 1
4 09/16/22	REVISION 4
5 10/19/22	REVISION 5
6 10/11/22	REVISION 6

STATUS:
PERMIT/BID SET

PRELIMINARY:
Preliminary Documents Are for Design Review only and not intended for bidding, permitting, or construction purposes. They were prepared by or under the supervision of Zebra Projects, INC.



FIELD VERIFICATION:
The contractor shall verify all signed dimensions and condition at the project site and notify Zebra Projects, INC. of any dimensional errors, or omissions or discrepancies before beginning or fabricating any work. Do not scale these drawings.

COPYRIGHT © 2021:
Zebra Projects, INC. shall retain all common law, statutory and all other reserved rights. Neither the documents nor the information herein is to be reproduced, distributed, photocopied or otherwise without the written consent of Zebra Projects, INC.

SHEET NAME:
**MECHANICAL GREASE
DUCT DETAILS**

DATE: 11/08/21 PROJECT NO: SHK-21-008
DRAWN: SK SCALE: 12" = 1'-0"

SHEET NO:
M502



Refrigerant Concentration Limits and Sizing Acknowledgment form

Date: 03/25/2022
Project Address: 3785 W WILSHIRE BLVD
Permit Application Number: 21044-10000-28036

The undersigned hereby certify that I am the Mechanical Engineer of Record of the property located at the address above and I certify that the size and location of the permanent openings provided for connecting spaces together is adequate to dilute the concentration of refrigerant that could potentially leak into these spaces.

OTHON ESTRADA, JR.

Full Name (Engineer)

Signature (Engineer)

03/25/2022

Date

Lou DeAngelis

Full Name []Owner [X]Owner's Representative

Signature

3-31-22

Date




3 Sidewall direct venting
Sidewall termination - optional concentric vent

Description and usage
Lochinvar offers optional concentric combustion air and vent pipe termination kits (Factory Kit #100140480 for 3" diameter - Models 125 - 200 and #100140484 for 4" diameter - Models 285 - 500). Both combustion air and vent pipes must attach to the termination kit.

The required combustion vent pipe materials are listed in Table 2C, on page 20 of this manual.

Figure 3-6 Concentric Sidewall Termination

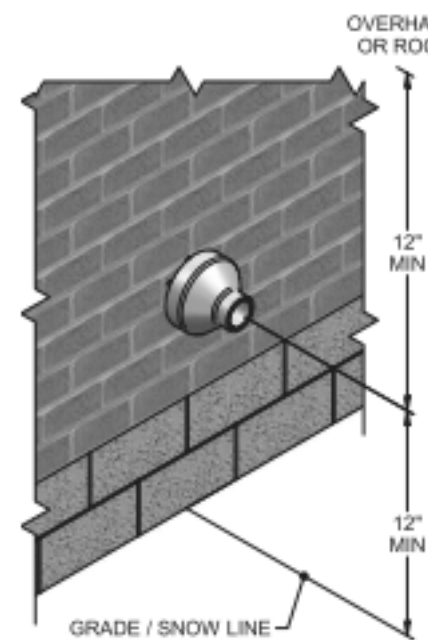

Sidewall termination installation

- 1. Determine the best location for the termination kit (see FIG. 4-6).
2. Reference the Determine Location Section on page 23 of this manual for general termination considerations.
3. Cut one (1) hole (5 inch diameter for #100140480 installations or 7 inch diameter for #100140484 installations) into the structure to install the termination kit.
4. Partially assemble the concentric vent termination kit. Clean and cement using the procedures found in these instructions.
a. Cement the Y concentric fitting to the larger kit pipe (FIG.'s 3-7 and 3-8).
b. Cement the rain cap to the smaller diameter kit pipe (FIG.'s 3-7 and 3-8).

Figure 3-7 Kit Contents_100140480 - 125 - 200

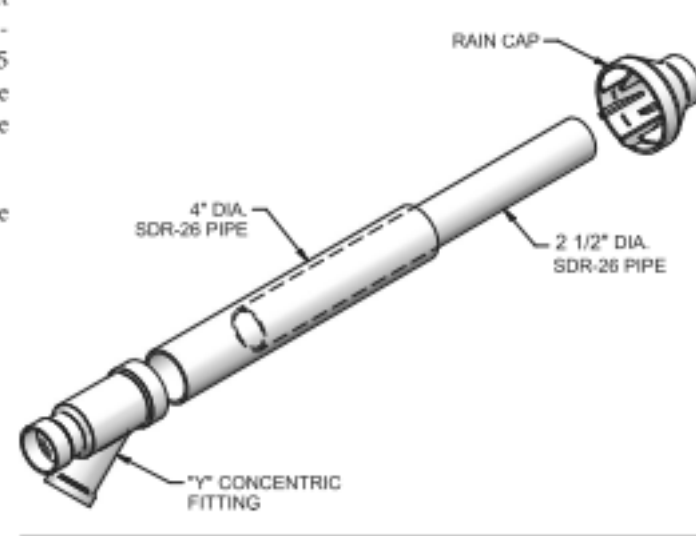


Figure 3-8 Kit Contents_100140484 - 285 - 500

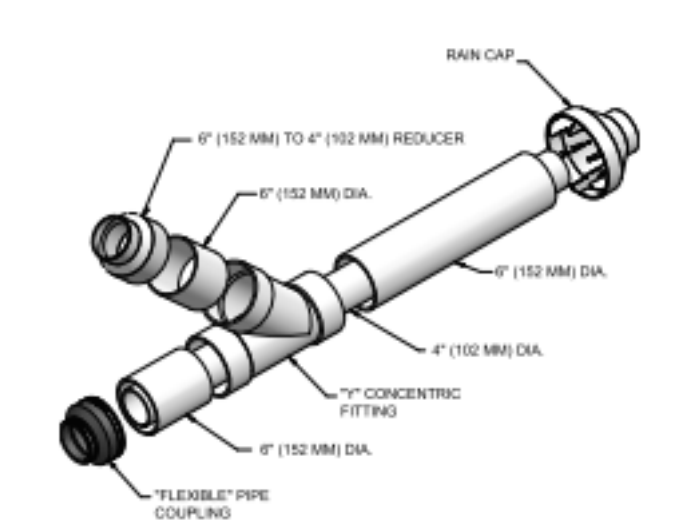


Table 3E Alternate Concentric Vent Terminations

Table with 2 columns: Size and Part No. for Roof and Wall Terminations.



Typical Specification SWH-SPEC-09

Typical Specification for Lochinvar SHIELD Water Heater

Non-ASME models: SWR125(N,L); SWR150(N,L); SWR200(N,L); SWR285(N,L); SWR400(N,L)
ASME models: SWA150(N,L); SWA200(N,L); SWA285(N,L); SWA400(N,L); SWA500(N,L)

The WATER HEATER shall be a LOCHINVAR SHIELD Model (SWR/L) (N,L) having a maximum input rating of ... Bu/Hr. The WATER HEATER shall be capable of full modulation firing down to 20% of rated input with a 5:1 turndown ratio.

The WATER HEATER shall consist of a direct fired Stainless Steel heat exchanger mounted on top of a glass lined storage tank in a fashion that will reduce the amount of scale build-up that is known to reduce efficiency.

Specified "SNA" SHIELD WATER HEATERS shall bear the ASME "HLW" stamp and shall be National Board listed. The tank shall have a working pressure of 150 psi.

The WATER HEATER shall be certified and listed by C.S.A. International under the latest edition of the harmonized ANSI Z21.10.3 test standard for the US and Canada. The WATER HEATER shall comply with the energy efficiency requirements of the latest edition of the ASHRAE 90.1 standard.

The WATER HEATER shall be constructed with a heavy gauge steel jacket assembly, primed and pre-painted on both sides. The combustion chamber shall be sealed and completely enclosed, independent of the outer jacket assembly.

The WATER HEATER shall utilize a 24 VAC control circuit and components. The control system shall have an electronic display for setup, status and diagnostics. All electronic circuitry shall be easily accessed and serviceable from the front of the jacket.

The WATER HEATER shall feature the SMART CONTROL platform with pump delay, freeze protection, pump exercise and Start-Up Wizard operating with an LCD display and soft key pad.

The WATER HEATER shall be installed and vented with a (select one):

- (a) Direct Vent Sidewall system with a horizontal sidewall termination of both the vent and combustion air. The flue shall be PVC, CPVC, Polypropylene or Stainless Steel sealed vent material terminating at the sidewall with the manufacturers specified vent termination.
(b) Direct Vent Vertical system with a vertical roof top termination of both the vent and combustion air. The flue shall be PVC, CPVC, Polypropylene or Stainless Steel sealed vent material terminating at the roof top with the manufacturers specified vent termination.
(c) Sidewall Vent with Room Air system with a horizontal sidewall termination of the vent with the combustion air drawn from the interior of the building.
(d) Vertical Vent with Room Air system with a vertical rooftop termination of the vent with the combustion air drawn from the interior of the building.
(e) Vertical Vent with Sidewall Air system with a vertical rooftop termination of the vent with the combustion air being drawn horizontally from a sidewall.

The WATER HEATER shall be approved for 180°F operation. The WATER HEATER shall have an independent laboratory rating for Oxides of Nitrogen (NOx) of 20 ppm or less, corrected to 3% O2.

Maximum unit dimensions shall be: Width inches and Height inches. Maximum unit weight shall be pounds.

The Firing Control System shall be M9, Direct Spark Ignition with Electronic Supervision.



STORE NO: CA #1398



REVISION table with columns: DATE, DESCRIPTION, and revision numbers.

STATUS: PERMIT/BID SET

PRELIMINARY: Preliminary Documents Are for Design Review only and not intended for bidding, permitting, or construction purposes.



FIELD VERIFICATION: The contractor shall verify all signed dimensions and location at the project site and notify Zebra Projects, INC. of any dimensional errors, omissions or discrepancies.

COPYRIGHT © 2021: Zebra Projects, INC. shall retain all common law, statutory and all other reserved rights. Neither the documents nor the information herein is to be reproduced, distributed, retransmitted or otherwise used without the written consent of Zebra Projects, INC.

SHEET NAME: MECHANICAL FLUE VENTILATION AIR AND SUPPLEMENTAL DOCUMENTS

DATE: 01/26/22 PROJECT NO: SHK-21-008

DRAWN: Author SCALE:

SHEET NO: M503

SPECIFICATION TABLE OF CONTENTS

SECTION 23000 - ENERGY CONSERVATION

SECTION 23050 - COMMON WORK RESULTS FOR HVAC

SECTION 23055 - HANGERS AND SUPPORTS

SECTION 23055 - IDENTIFICATION

SECTION 23055 - TESTING, ADJUSTING, AND BALANCING FOR HVAC

SECTION 23070 - HVAC INSULATION

SECTION 23080 - COMMISSIONING

SECTION 23200 - REFRIGERANT PIPING

SECTION 23313 - METAL DUCTS

SECTION 23330 - AIR DUCT ACCESSORIES

SECTION 23313 - DIFFUSERS, REGISTERS AND GRILLES

C. WHERE JOB CONDITIONS REQUIRE REASONABLE CHANGES IN ORDER TO COORDINATE INSTALLATION WITH OTHER TRADES, THESE CHANGES SHALL BE MADE WITHOUT EXTRA COST TO THE OWNER.

1.10 DEMOLITION

A. PROTECT ADJACENT MATERIALS INDICATED TO REMAIN, INSTALL AND MAINTAIN DUST AND NOISE BARRIERS TO KEEP DIRT, DUST, AND NOISE FROM BEING TRANSMITTED TO ADJACENT AREAS. REMOVE PROTECTION AND BARRIERS AFTER DEMOLITION OPERATIONS ARE COMPLETE.

B. LOCATE, IDENTIFY, AND PROTECT MECHANICAL SERVICES PASSING THROUGH DEMOLITION AREA AND SERVING OTHER AREAS OUTSIDE THE DEMOLITION LIMITS. MAINTAIN SERVICES TO AREAS OUTSIDE DEMOLITION LIMITS. WHEN SERVICES MUST BE INTERRUPTED, INSTALL TEMPORARY SERVICES FOR AFFECTED AREAS.

C. MATERIALS AND EQUIPMENT TO BE SALVAGED, REMOVE, DEMOUNT, AND DISCONNECT EXISTING MECHANICAL MATERIALS AND EQUIPMENT INDICATED TO BE REMOVED AND SALVAGED, AND DELIVER MATERIALS AND EQUIPMENT TO THE OWNER.

D. REPAIR OR REPLACE EQUIPMENT OR MATERIALS DAMAGED DURING DEMOLITION TO SATISFACTION OF OWNERS DESIGNATED REPRESENTATIVE.

1.11 INTERRUPTION OF EXISTING UTILITY SERVICE:

A. COORDINATE THE SHUT-OFF AND DISCONNECTION OF UTILITY SERVICES WITH THE OWNER AND THE UTILITY COMPANY.

B. NOTIFY THE OWNERS REPRESENTATIVE OWNERS PROJECT REPRESENTATIVE AT LEAST 5 DAYS PRIOR TO COMMENCING DEMOLITION OPERATIONS.

1.12 SCHEDULING

A. SUBMIT SCHEDULES INDICATING PROPOSED METHODS AND SEQUENCE OF OPERATIONS FOR DEMOLITION PRIOR TO COMMENCEMENT OF WORK. INCLUDE COORDINATION FOR SHUT-OFF OF UTILITY SERVICES AND DETAILS FOR DUST AND NOISE CONTROL.

B. COORDINATE SEQUENCING WITH CONSTRUCTION PHASING AND OWNER OCCUPANCY.

1.13 MAINTENANCE OF EXISTING UTILITY SERVICES

A. UNINTERRUPTED NORMAL USE OF THE EXISTING FACILITIES MUST BE MAINTAINED DURING THE TIME REQUIRED TO PERFORM THE COMPLETE INSTALLATION OF THE WORK INDICATED IN THE CONTRACT DOCUMENTS. IT IS MANDATORY THAT THE EXISTING BUILDINGS BE MAINTAINED IN SERVICE.

B. INVESTIGATE EXISTING CONDITIONS AND THE LOCATION OF ALL EXISTING EQUIPMENT AND THE LOCATION OF ALL EXISTING SERVICES BEFORE STARTING.

C. IF A SERVICE IS DISTURBED, IMMEDIATELY WITHOUT REGARD FOR WORKING HOURS, PLACE THE SERVICE BACK INTO OPERATION.

D. SUFFICIENT ADVANCE NOTICE SHALL BE GIVEN TO THE OWNER AND ITS PERMISSION OBTAINED PRIOR TO INTERRUPTION OF PRESENT SERVICES. IT SHOULD BE ASSUMED THAT DISRUPTION OF UTILITIES AND SERVICES WILL BE DONE AT OTHER THAN NORMAL WORKING HOURS. NO ADDITIONAL OR EXTRA PAYMENT WILL BE AUTHORIZED TO COMPLY WITH THESE REQUIREMENTS.

E. REPAIR, REPLACE AND MAINTAIN IN SERVICE ALL UTILITIES, FACILITIES, OR SERVICES (UNDERGROUND, OVERGROUND, INTERIOR OR EXTERIOR) DAMAGED, BROKEN OR OTHERWISE RENDERED INOPERATIVE DURING THE COURSE OF CONSTRUCTION OF THE WORK INDICATED IN THE CONTRACT DOCUMENTS.

F. ALL OPENINGS MUST BE SECURELY COVERED, OR OTHERWISE PROTECTED, TO PREVENT INJURY DUE TO CARELESSLY OR MALICIOUSLY DROPPED TOOLS OR MATERIALS, RIFT, DIRT, OR ANY FOREIGN MATTER. DAMAGED WORK SHALL BE REPAIRED OR REPLACED UNTIL WORK IS FULLY AND FINALLY ACCEPTED.

G. PROTECT HEATING EQUIPMENT AND ALL SIMILAR ITEMS OF EQUIPMENT FROM DIRT, CRIME, PLASTER, PAINT AND WATER DURING ALL PHASES OF CONSTRUCTION. THIS PROTECTION SHALL BE PROVIDED BY COVERING WITH TRANSPARENT PLASTIC SHEETING.

H. MAKE ALL CONNECTIONS TO EXISTING SYSTEM PIPING AND EQUIPMENT SYSTEMS DURING DESIGNATED PERIODS UPON APPROVAL OF THE OWNER AND AT NO INCREASE IN THE CONTRACT SUM.

I. DO NOT INTERRUPT EXISTING UTILITIES UTILIZED BY THE OWNER, EXCEPT AS APPROVED BY THE OWNER. INTERRUPTIONS MUST BE SCHEDULED TO SUIT THE OWNERS REQUIREMENTS.

VERIFY ALL EXISTING WORK, WHERE EXISTING CONNECTIONS ARE PARTIAL, PROVIDE AS-BUILT DRAWINGS FOR REVIEW SUBMITTALS.

MODIFY EXISTING WORK, IN ADDITION, MAINTAIN INTEGRITY OF THE EXISTING SYSTEMS, RECTIFY ANY CONTAMINATION, DEGRADATION OF CLEANLINESS OR DAMAGE TO THE EXISTING SYSTEMS TO THE SATISFACTION OF THE OWNER.

SECTION 23000 - ENERGY CONSERVATION

A. HVAC SYSTEMS AND EQUIPMENT CAPACITIES DO NOT EXCEED CALCULATED LOADS.

B. THERMOSTATIC CONTROLS

- THERMOSTATIC CONTROLS SHALL HAVE A DEAD-BAND.
- THERMOSTATIC CONTROLS SHALL BE CAPABLE OF OPERATING THE DOWN TO 58 DEGREE F OR UP TO 65 DEGREE F.
- EACH ZONE SHALL BE PROVIDED WITH AUTOMATIC TIME CLOCK OR PROGRAMMABLE CONTROLS FOR STARTING AND STOPPING THE SYSTEM FOR SEVERAL DIFFERENT DAILY SCHEDULES PER WEEK.

SECTION 23050 - COMMON WORK RESULTS FOR HVAC

PART 1 - GENERAL

1.1 GENERAL PROVISIONS

A. DRAWINGS AND GENERAL PROVISIONS OF THE CONTRACT, INCLUDING GENERAL AND SUPPLEMENTARY CONDITIONS, AND DIVISION 1 SPECIFICATION SECTIONS, APPLY TO THIS SECTION.

1.2 SCOPE OF WORK

A. PROVIDE LABOR, INCLUDING FIELD ERECTION AND SUPERVISION, MATERIALS, EQUIPMENT AND ANCILLARIES, AND COORDINATE, PROCURE, FABRICATE, DELIVER, ERECT OR INSTALL, INTERFACE WITH EXISTING WORK, START, DEBUG AND TEST ALL SYSTEMS AS NECESSARY TO PROVIDE THE OWNER WITH A COMPLETE OPERATING FACILITY IN CONFORMANCE WITH THE CONTRACT DOCUMENTS AND IN CONFORMITY WITH REQUIREMENTS OF ALL AUTHORITIES HAVING JURISDICTION.

B. THE WORK SHALL INCLUDE, BUT NOT BE LIMITED TO, THE FOLLOWING:

- DEMOLITION AND REMOVAL OF MECHANICAL WORK.
- DUCTWORK AND AIR OUTLETS
- AIR CONDITIONING AND EXHAUST SYSTEMS.
- KITCHEN HOOD AND EXHAUST SYSTEMS.
- MAKEUP AIR SYSTEMS.
- THERMAL INSULATION.
- COORDINATION WITH OTHER TRADES FOR LOCATION OF DUCTWORK AND TO REMOVE THE GENERAL CONTRACTOR VIA DIMENSIONAL DRAWINGS OF THE EXACT SIZE AND LOCATION OF ALL ROOF AND WALL OPENINGS.
- MISCELLANEOUS STEEL WORK, SUPPORTS, HANGERS AND HANGERS AND CUTTING AND PATCHING OF ROOF, WALLS AND PARTITIONS.
- RECORD DRAWINGS.
- CONTROL, SEQUENCE AND SYSTEM DRAWINGS.
- TESTING, ADJUSTING, AND BALANCING.

C. RELATED WORK INCLUDED IN THIS SECTION AND IN OTHER SECTIONS.

- GENERAL CONTRACTOR IS RESPONSIBLE FOR ALL WORK DESCRIBED IN THE CONSTRUCTION DOCUMENTS.
- REFER TO THE RESPONSIBILITY MATRIX FOR ADDITIONAL INFORMATION.

1.3 SUBMITTALS

A. PROVIDE CONTRACTOR SUBMITTAL MATERIAL WITH DESCRIPTIVE DATA FOR ALL PRODUCTS AND MATERIALS, INCLUDING BUT NOT LIMITED TO THE FOLLOWING, PRIOR TO INSTALLATION. ALL SUBMITTALS SHALL BE HIGHLIGHTED TO IDENTIFY SPECIFIC PRODUCTS OR MATERIALS BEING USED. ALLOW 10 WORKING DAYS FOR THE GENERAL CONTRACTOR TO REVIEW SUBMITTALS.

- COORDINATED LAYOUT PLANS, SHOWING WORK OF ALL TRADES, INCLUDING BUT NOT LIMITED TO DUCTWORK, HVAC, REFRIGERANT, PLUMBING, FIRE PROTECTION PIPING, ELECTRICAL CONDUITS AND BUS DUCTS, EQUIPMENT. DRAWINGS SHALL BE 1/4" SCALE.
- DUCTWORK ACCESSORIES.
- DUCTWORK TYPICAL CONSTRUCTION.
- DUCT SEALING.
- REFRIGERANT PIPING.
- DAMPERS.
- DIFFUSERS, GRILLES AND REGISTERS.
- CERTIFIED ACOUSTICAL TEST PERFORMANCE DATA FOR DIFFUSERS, REGISTERS, GRILLES AND TERMINAL AIR UNITS.
- AIR AND WATER TEST AND BALANCE.
- COMPLETE FORMS PROPOSED FOR USE IN COMPILING AND RECORDING TEST AND BALANCE DATA.
- CONTROL, SEQUENCE AND SYSTEM DRAWINGS.
- CONTROL, SEQUENCE AND SYSTEM DRAWINGS.
- FIRE PROTECTION SYSTEM LAYOUTS IN CODE COMPLIANCE.
- VIBRATION ISOLATION.
- ONE SET OF AS-BUILT REPRODUCIBLE DRAWINGS.

B. PROVIDE 1 COPY OF APPROVED SUBMITTALS TO THE OFFICE OF THE BUILDING ENGINEER.

1.4 PRODUCT SUBSTITUTIONS

A. THE CONTRACTOR SHALL CERTIFY THE FOLLOWING ITEMS ARE CORRECT WHEN USING SUBSTITUTED PRODUCTS OTHER THAN THOSE SCHEDULED OR SHOWN ON DRAWINGS:

- THE PROPOSED SUBSTITUTION DOES NOT AFFECT DIMENSIONS SHOWN ON DRAWINGS.
- THE CONTRACTOR SHALL PAY FOR CHANGES TO BUILDING DESIGN, INCLUDING ENGINEERING DESIGN, STRUCTURAL SUPPORTS, AND CONSTRUCTION COSTS CAUSED BY PROPOSED SUBSTITUTION.
- THE PROPOSED SUBSTITUTION HAS NO ADVERSE EFFECT ON OTHER TRADES, CONSTRUCTION SCHEDULE, OR SPECIFIED WARRANTY REQUIREMENTS.
- MAINTENANCE AND SERVICE PARTS AVAILABLE LOCALLY ARE READY OBTAINABLE FOR THE PROPOSED SUBSTITUTE.

B. THE CONTRACTOR FURTHER CERTIFIES FUNCTION, APPEARANCE, AND QUALITY OF PROPOSED SUBSTITUTION ARE EQUIVALENT OR SUPERIOR TO SPECIFIED ITEM.

C. THE CONTRACTOR AGREES THAT THE TERMS AND CONDITIONS FOR THE SUBSTITUTED PRODUCT THAT ARE FOUND IN THE CONTRACT DOCUMENTS APPLY TO THIS PROPOSED SUBSTITUTION.

1.5 MAINTENANCE MANUALS AND AS-BUILT DRAWINGS

A. PROVIDE FOUR (4) COPIES OF OPERATING AND MAINTENANCE MANUAL FOR OWNERS USE FOR EACH PIECE OF EQUIPMENT WITHIN 90 DAYS OF ACCEPTANCE. EACH ITEM SHALL BE CROSS-REFERENCED AND NUMBERED WITH AS-BUILT DRAWING DESCRIPTIONS.

B. SOFT COPY OF AS-BUILT DRAWINGS ON AUTOCAD AND PDF AND ONE SET OF HARD COPY SHALL BE DELIVERED TO OWNER WITHIN 90 DAYS OF SYSTEM ACCEPTANCE.

1.6 GUARANTEES

A. GUARANTEE: ALL MATERIALS, APPARATUS AND WORKMANSHIP INSTALLED UNDER THIS SECTION SHALL BE UNCONDITIONALLY GUARANTEED FOR A PERIOD OF ONE YEAR FROM THE DATE OF ACCEPTANCE OF WORK BY THE OWNER. CONTRACTOR FAILURE DUE TO FAULTY MATERIAL OR WORKMANSHIP - THE CONTRACTOR SHALL CORRECT DEFECTS AT NO ADDITIONAL COST TO THE OWNER. LABOR AND REPLACEMENT OF PARTS TO BE ACCOMPLISHED AT NO COST TO OWNER.

1.7 SEISMIC SUPPORT

A. CONTRACTOR SHALL SUPPORT AND BRACE ALL NEW HVAC, PLUMBING AND FIRE PROTECTION SYSTEMS IN ACCORDANCE WITH REQUIREMENTS SPECIFIED.

1.8 PRODUCT HANDLING

A. PROTECTION: PROTECT MATERIALS AND EQUIPMENT FROM DAMAGE DURING SHIPPING, STORAGE AND HANDLING. REMOVE FROM THE SITE ANY WET OR DAMAGED DUCT LINER OR INSULATION.

B. STORAGE: WHERE POSSIBLE, STORE MATERIALS AND EQUIPMENT INSIDE AND PROTECT FROM THE WEATHER. WHERE NECESSARY TO STORE OUTSIDE, STORE ABOVE GRADE AND ENCLOSE WITH WATERPROOF WRAPPING.

C. REPLACEMENT: IN THE EVENT OF DAMAGE, IMMEDIATELY REPAIR ALL DAMAGED AND DEFECTIVE WORK TO THE APPROVAL OF THE ENGINEER AT NO ADDITIONAL COST TO THE OWNER.

1.9 CONTRACT DRAWING

A. CONTRACT DRAWINGS FOR MECHANICAL WORK ARE DIAGRAMMATIC, INTENDED TO CONVEY THE SCOPE OF THE WORK AND INDICATE GENERAL ARRANGEMENT OF EQUIPMENT, DUCTS, PIPING AND APPROXIMATE SIZES AND LOCATIONS OF EQUIPMENT AND OUTLETS. DO NOT SCALE DRAWINGS FOR MEASUREMENTS.

B. CONSULT KITCHEN, MECHANICAL, PLUMBING, ARCHITECTURAL, STRUCTURAL AND ELECTRICAL CONTRACT DRAWINGS AND SPECIFICATIONS TO BECOME FAMILIAR WITH ALL CONDITIONS AFFECTING THE WORK. COORDINATE INTERCONNECTING WORK WITH OTHER TRADES AFFECTED, AND VERIFY ALL SPACES IN WHICH THE WORK WILL BE INSTALLED.

1.10 PROJECT CLOSE-OUT

A. AFTER FINAL OPERATION FOR INSPECTION AND ACCEPTANCE DELIVER ALL COPIES OF OPERATION INSTRUCTIONS, MAINTENANCE MANUALS AND PARTS DESCRIPTIONS TO THE ENGINEER.

B. ALL TOOLS SUPPLIED WITH THE EQUIPMENT FOR MAINTENANCE SHALL BE TAGGED AND TEMPORARILY SECURED TO THE UNIT, OR TURNED OVER TO THE OWNER.

1.11 ELECTRICAL

A. GENERAL:

- ALL ELECTRICAL MATERIAL, EQUIPMENT, AND APPARATUS SPECIFIED HEREIN SHALL CONFORM TO THE REQUIREMENTS OF DIVISION 26. REFER TO THE RESPONSIBILITY MATRIX FOR ADDITIONAL INFORMATION.
- PROVIDE ALL MOTORS FOR EQUIPMENT SPECIFIED HEREIN. PROVIDE MOTOR STARTERS, CONTROLLERS, AND OTHER ELECTRICAL APPARATUS AND WIRING WHICH ARE REQUIRED FOR THE OPERATION OF THE EQUIPMENT SPECIFIED HEREIN.
- SET AND ALIGN ALL MOTORS AND DRIVES IN EQUIPMENT SPECIFIED HEREIN.
- SPECIFIC ELECTRICAL REQUIREMENTS (I.E. HORSEPOWER AND ELECTRICAL CHARACTERISTICS) FOR MECHANICAL EQUIPMENT ARE SCHEDULED ON THE DRAWINGS.

B. QUALITY ASSURANCE:

- ELECTRICAL COMPONENTS AND MATERIALS SHALL BE UL OR ETL LISTED/LABELED AS SUITABLE FOR LOCATION AND USE - NO EXCEPTIONS.

C. STARTERS AND ELECTRICAL DEVICES:

- MOTOR STARTER CHARACTERISTICS:

 - ENCLOSURES: NEMA 1, GENERAL PURPOSE ENCLOSURES WITH PADLOCK EARS, EXCEPT IN NET LOCATIONS SHALL BE NEMA 3R WITH CONDUIT HUBS.
 - TYPE AND SIZE OF STARTER SHALL BE AS RECOMMENDED BY MOTOR MANUFACTURER AND THE DRIVE/EQUIPMENT MANUFACTURER FOR APPLICABLE PROTECTION AND START UP CONDITION.
 - MANUAL SWITCHES SHALL HAVE PILOT LIGHTS AND ALL REQUIRED SWITCH POSITIONS FOR MULTI SPEED MOTORS, OVERLOAD PROTECTION, MELTING ALLOY OR IN METALLIC TYPE THERMAL OVERLOAD RELAYS, SIZED ACCORDING TO ACTUAL OPERATING CURRENT (FIELD MEASURED).
 - MAGNETIC STARTERS:

 - HEAVY DUTY, OR RESISTANT, HAND-OFF-AUTO (H/OA), OR AS INDICATED, AND PILOT LIGHTS, PROPERLY ARRANGED FOR SINGLE SPEED OR MULTI SPEED OPERATION AS NOTED.
 - Trip FREE THERMAL OVERLOAD RELAYS, EACH PHASE, SIZED ACCORDING TO ACTUAL OPERATING CURRENT (FIELD MEASURED).
 - INTERLOCKS: PNEUMATIC SWITCHES AND SIMILAR DEVICES AS REQUIRED FOR COORDINATION WITH CONTROL REQUIREMENTS OF DIVISION 23 CONTROL SECTIONS.
 - BUILT IN PRIMARY AND SECONDARY FUSE CONTROL CIRCUIT TRANSFORMER, SUPPLIED FROM LOAD SIDE OF EQUIPMENT DISCONNECT, EXTERNALLY OPERATED MANUAL RESET.
 - UNDER VOLTAGE RELEASE OR PROTECTION FOR ALL MOTORS OVER 20 HP.
 - MOTOR CONNECTIONS TO BE MADE IN ACCORDANCE WITH THE CURRENT PRACTICES FOR ELECTRICAL DEVICES AS SPECIFICALLY INDICATED.

D. LOW VOLTAGE CONTROL WIRING:

 - GENERAL: 14 GAUGE, TYPE THHN, COLOR CODED, INSTALLED IN CONDUIT.
 - MANUFACTURER, GENERAL CABLE CORP., ALCAN CABLE, AMERICAN INSULATED WIRE CORP., SENATOR WIRE AND CABLE CO., OR SOUTHWIRE CO. SHALL BE AUTHORIZED TO COMPLY WITH THESE REQUIREMENTS.

E. DISCONNECT SWITCHES:

 - FUSIBLE SWITCHES: FOR EQUIPMENT 1/2 HP OR LARGER, PROVIDE FUSE, EACH PHASE, HEAVY DUTY, HORSEPOWER RATED, SPRING LOADED QUICK MAKE, QUICK BREAK MECHANISM, DEAD FRONT LINE SIDE SHELD, SOLID BRASS LOWER END OF COPPER CONDUCTORS, SPRING REINFORCED FUSE CLIPS, ELECTRO SILVER PLATED CURRENT CARRYING PARTS, HINGED DOORS, OPERATING LEVER ARRANGED FOR LOCKING IN THE "OPEN" POSITION, ARC QUENCHERS, CAPACITY AND CHARACTERISTICS AS INDICATED.
 - NON FUSIBLE SWITCHES: FOR EQUIPMENT LESS THAN 1/2 HORSEPOWER, SWITCH SHALL BE HORSEPOWER RATED, TIGHT SWITCH TYPE WITH THERMAL OVERLOAD QUANTITY OF POLES AND VOLTAGE RATINGS AS REQUIRED.

2. EXECUTION

2.1 GENERAL

A. WORKMANSHIP SHALL BE PERFORMED BY LICENSED JOURNEMEN OR MASTER MECHANICS AND SHALL RESULT IN AN INSTALLATION CONSISTENT WITH THE BEST PRACTICES OF TRADES.

B. INSTALL WORK UNIFORM, LEVEL AND PLUMB, IN RELATIONSHIP TO LINES OF BUILDING. DO NOT INSTALL ANY DIAGONAL, OR OTHERWISE IRREGULAR WORK UNLESS SO INDICATED ON DRAWINGS OR APPROVED BY ARCHITECT.

2.2 MANUFACTURERS DIRECTIONS

A. FOLLOW MANUFACTURERS DIRECTIONS AND RECOMMENDATIONS IN ALL CASES WHERE THE MANUFACTURERS OR ARTICLES USED ON THIS CONTRACT FURNISH DIRECTIONS OR POINTS NOT SHOWN ON THE DRAWINGS OR COVERED IN THESE SPECIFICATIONS.

2.3 INSTALLATION

A. COORDINATE THE WORK BETWEEN THE VARIOUS MECHANICAL SECTIONS AND WITH THE WORK SPECIFIED UNDER OTHER DIVISIONS. IF ANY COOPERATIVE WORK MUST BE ALTERED DUE TO LACK OF PROPER SUPERVISION OR FAILURE TO MAKE PROPER AND TIMELY PROVISIONS, THE ALTERATIONS SHALL BE MADE TO THE SATISFACTION OF THE ARCHITECT AT THE CONTRACTORS COST. COORDINATE WALL AND CEILING WORK WITH THE GENERAL CONTRACTOR, AND HIS SUBCONTRACTORS IN LOCATING CEILING AIR OUTLETS, WALL REGISTERS, ETC.

B. INSPECT ALL MATERIAL, EQUIPMENT, AND APPARATUS UPON DELIVERY AND DO NOT INSTALL ANY DAMAGED OR DEFECTIVE MATERIALS.

2.4 ELECTRICAL REQUIREMENTS

A. MECHANICAL CONTRACTOR SHALL COORDINATE WITH DIVISION 26 WORK TO PROVIDE COMPLETE SYSTEMS AS REQUIRED TO OPERATE ALL MECHANICAL DEVICES INSTALLED UNDER THIS DIVISION OF WORK.

B. INSTALLATION OF ELECTRICAL CONNECTIONS, FURNISH, INSTALL AND WIRE (EXCEPT AS MAY BE OTHERWISE INDICATED) ALL HEATING, VENTILATING, AIR CONDITIONING, PLUMBING AND FIRE PROTECTION, ETC., MOTORS AND CONTROLS IN ACCORDANCE WITH THE FOLLOWING SCHEDULE AND IN ACCORDANCE WITH EQUIPMENT MANUFACTURERS INSTALLATION INSTRUCTIONS AND WITH RECOGNIZED INDUSTRY PRACTICES, AND COMPLYING WITH APPLICABLE REQUIREMENTS OF UL, NEC, AND NECTAS STANDARD OF INSTALLATION TO ENSURE THAT PRODUCTS FULLY REQUIREMENTS, CAREFULLY COORDINATE WITH WORK PERFORMED UNDER THE MECHANICAL DIVISION OF THESE SPECIFICATIONS.

C. DIVISION 23 HAS RESPONSIBILITIES FOR ELECTRICALLY POWERED OR CONTROLLED MECHANICAL EQUIPMENT WHICH IS SPECIFIED IN DIVISION 23 SPECIFICATIONS OR SCHEDULED ON DIVISION 23 DRAWINGS. THE SPECIFIC DIVISION OR RESPONSIBILITIES BETWEEN DIVISION 23 AND 26 FOR FURNISHING OR WIRING THIS EQUIPMENT IS AS FOLLOWS:

- DIVISION 26 MECHANICAL RESPONSIBILITIES:
 - MOTORS: FURNISH AND INSTALL ALL MOTORS NECESSARY FOR MECHANICAL EQUIPMENT.
 - DISCONNECTS: PROVIDE THE DISCONNECTS WHICH ARE PART OF FACTORY WIRING DIVISION 23 EQUIPMENT. FACTORY WIRING TO INCLUDE WIRING BETWEEN MOTOR AND DISCONNECT OR COMBINATION STARTER/DISCONNECT.
 - CONTROLS: DIVISION 23 CONTRACTOR (INCLUDING THE TEMPERATURE CONTROL SUBCONTRACTOR) IS RESPONSIBLE FOR PROVIDING THE MECHANICAL EQUIPMENT IN ITS ENTIRETY. THIS EQUIPMENT INCLUDES BUT IS NOT LIMITED TO THE FOLLOWING:
 - CONTROL RELAYS NECESSARY FOR CONTROLLING DIVISION 23 EQUIPMENT.
 - CONTROL TRANSFORMERS NECESSARY FOR PROVIDING POWER TO CONTROLS FOR DIVISION 23 EQUIPMENT.
 - LINE VOLTAGE THERMOSTATS.
 - LOW OR NON-LOAD VOLTAGE CONTROL COMPONENTS.
 - REMOTE BULB THERMOSTATS.
 - NON-LIFE SAFETY RELATED VALVE OR DAMPER ACTUATORS.
 - FLOAT SWITCHES.
 - SOLENOID VALVES, SP AND NC SWITCHES.
 - REFRIGERATION CONTROLS. DIVISION 26 PROVIDES POWER TO REFRIGERATION PANELS.
 - PNEUMATIC THERMOSTATS.
 - FIRE AND LIFE SAFETY EQUIPMENT:
 - FIRE/SMOKE DAMPERS: DIVISION 23 IS RESPONSIBLE FOR PROVIDING AND PHYSICALLY INSTALLING THE DAMPER AND FOR INSTALLING ANY REQUIRED CONTROL INTERFACE WIRING TO DIVISION 23 CONTROLS.
 - WHERE FIRE/SMOKE DAMPERS ARE PART OF AN INTEGRATED SMOKE CONTROL SYSTEM, DIVISION 23 IS RESPONSIBLE FOR PROVIDING DAMPERS WITH NECESSARY END SWITCHES FOR PROOF OF CLOSURE.
 - WHERE THESE DAMPERS ARE NOT PART OF AN INTEGRATED AREA WIDE SMOKE DETECTION SYSTEM, DIVISION 23 IS RESPONSIBLE FOR PROVIDING EACH FIRE/SMOKE DAMPER WITH A DESIGNATED DUCT DETECTOR INSTALLED PER THE REQUIREMENTS OF THE BUILDING CODE. IF NOT INTEGRAL WITH THE DAMPER ASSEMBLY, THE DETECTOR IS TO BE INSTALLED BY DIV. 23 BUT WIRED FOR DAMPER CONTROL, BY DIV. 26.
 - FIRE SPRINKLER SYSTEM: DIVISION 23 IS RESPONSIBLE FOR PROVIDING NECESSARY CONTROLS INCLUDING FLOW SWITCHES AND ALARM BELLS.
 - FIRE SUPPRESSION SYSTEM: DIVISION 23 IS RESPONSIBLE FOR PROVIDING NECESSARY SYSTEM CONTROLS AND ANY REQUIRED CONTROL INTERFACE TO THESE CONTROLS.
 - DIVISION 23 IS RESPONSIBLE FOR BRINGING POWER TO POINT OF CONNECTION WITH THE SYSTEM.
- DIVISION 26 HAS RESPONSIBILITIES FOR ELECTRICALLY POWERED OR CONTROLLED MECHANICAL EQUIPMENT WHICH IS SPECIFIED IN DIVISION 23 SPECIFICATIONS OR SCHEDULED ON DIVISION 23 DRAWINGS. THE SPECIFIC DIVISION OR RESPONSIBILITIES BETWEEN DIVISION 23 AND 26 FOR FURNISHING

OR WIRING THIS EQUIPMENT IS AS FOLLOWS:

- DIVISION 26 ELECTRICAL RESPONSIBILITIES
- MOTORS: PROVIDE THE POWER WIRING FOR THE MOTORS.
- DISCONNECTS: PROVIDE ALL DISCONNECTS NECESSARY FOR DIVISION 23 MECHANICAL EQUIPMENT WHICH ARE NOT PROVIDED AS PART OF FACTORY WIRING DIVISION 23 EQUIPMENT. PROVIDE POWER WIRING TO ALL DISCONNECTS, IN ADDITION PROVIDE POWER WIRING BETWEEN MOTOR AND VARIABLE FREQUENCY DRIVE ABOVE FOR SPECIAL WIRING REQUIREMENTS.
 - CONTROLS: DIVISION 26 CONTRACTOR IS RESPONSIBLE FOR PROVIDING POWER TO CONTROL PANELS AND CONTROL CIRCUIT OUTLETS.
 - FIRE AND LIFE SAFETY EQUIPMENT:
 - FIRE/SMOKE DAMPERS: DIVISION 26 IS RESPONSIBLE FOR POWER WIRING TO THE DAMPER AND AS FOLLOWS:
 - WHERE THESE DAMPERS ARE PART OF AN INTEGRATED SMOKE CONTROL SYSTEM, DIVISION 26 IS RESPONSIBLE FOR PROVIDING THE DETECTORS AND FOR ALL FIRE DETECTION SYSTEM WIRING NECESSARY TO INTEGRATE DAMPERS AND RELATED END SWITCHES INTO THE SYSTEM.
 - WHERE THESE DAMPERS ARE NOT PART OF AN INTEGRATED AREA WIDE SMOKE DETECTION SYSTEM, DIVISION 26 IS RESPONSIBLE FOR PROVIDING EACH FIRE/SMOKE DAMPER WITH A DESIGNATED DUCT DETECTOR INSTALLED PER THE REQUIREMENTS OF THE BUILDING CODE. IF NOT INTEGRAL WITH THE DAMPER ASSEMBLY, THE DETECTOR IS TO BE INSTALLED BY DIV. 23 BUT WIRED FOR DAMPER CONTROL, BY DIV. 26.
 - FIRE SPRINKLER SYSTEM: DIVISION 26 IS RESPONSIBLE FOR PROVIDING POWER WIRING TO FIRE PROTECTION CONTROLS INCLUDING FLOW SWITCHES AND ALARM BELLS.
 - SPECIALIZED FIRE SUPPRESSION SYSTEMS: DIVISION 26 IS RESPONSIBLE FOR PROVIDING NECESSARY SYSTEM CONTROLS AND ANY REQUIRED CONTROL INTERFACE TO THESE CONTROLS.
- COORDINATE WITH OTHER WORK, INCLUDING WIRELESS CABLES, RACEWAY AND EQUIPMENT INSTALLATION, AS NECESSARY TO PROPERLY INTERFACE INSTALLATION OF ELECTRICAL CONNECTIONS FOR EQUIPMENT WITH OTHER WORK.
- CONNECT ELECTRICAL POWER SUPPLY CONDUCTORS TO EQUIPMENT CONDUCTORS IN ACCORDANCE WITH EQUIPMENT MANUFACTURERS WRITTEN INSTRUCTIONS AND WIRING DIAGRAMS. MAKE SURE THE ELECTRICAL CONNECTIONS FOR PROPER INTERFACE BETWEEN ELECTRICAL POWER SUPPLIES AND INSTALLED EQUIPMENT.
- MAINTAIN EXISTING ELECTRICAL SERVICE AND FEEDERS TO OCCUPIED AREAS AND OPERATIONAL FACILITIES, UNLESS OTHERWISE INDICATED, OR WHEN AUTHORIZED OTHERWISE IN WRITING BY OWNER OR ARCHITECT/ENGINEER. PROVIDE TEMPORARY SERVICE DURING INTERRUPTIONS TO EXISTING FACILITIES. WHEN NECESSARY, SCHEDULE MOMENTARY OUTAGES FOR REPLACING EXISTING WIRING SYSTEMS WITH NEW WIRING SYSTEMS. WHEN THAT "OUTTING-OVER" HAS BEEN SUCCESSFULLY ACCOMPLISHED, REMOVE, RELOCATE, OR ABANDON EXISTING WIRING AS INDICATED.
- COVER SPACES WITH ELECTRICAL INSULATING MATERIAL, EQUIVALENT TO, OR GREATER INSULATION RESISTIVITY RATING, THAN ELECTRICAL INSULATION RATING OF THOSE CONDUCTORS BEING SPACED.
- PREPARE CABLES AND WIRES, BY CUTTING AND STRIPPING COVERING, ARMOR, JACKET, AND INSULATION PROPERLY TO ENSURE UNIFORM AND NEAT APPEARANCE WHERE CABLES AND WIRES ARE TERMINATED. EXERCISE CARE TO AVOID CUTTING THROUGH TAPES WHICH WILL REMAIN ON CONDUCTORS. ALSO AVOID "RINGING" COPPER CONDUCTORS WHILE SKINNING WIRE.
- MOTORS AND MOTOR CONTROL EQUIPMENT: CONFORM TO THE STANDARDS OF THE NEMA. EQUIP MOTORS WITH MAGNETIC OR MANUAL LINE STARTERS WITH OVERLOAD PROTECTION. MOTOR STARTERS AND LINE VOLTAGE CONTROLS SHALL BE INSTALLED UNDER ELECTRICAL SECTION BUT LOCATED AND COORDINATED AS REQUIRED UNDER THIS SECTION OF THE WORK. STARTERS SHALL BE COMBINATION TYPE WITH NON-FUSIBLE DISCONNECT SWITCHES. ALL SINGLE PHASE FRACTIONAL HORSEPOWER MOTORS SHALL HAVE BUILT IN OVERLOAD PROTECTION.

SECTION 23050 - COMMON WORK RESULTS FOR HVAC

PART 1 - GENERAL

1.1 GENERAL PROVISIONS

A. DRAWINGS AND GENERAL PROVISIONS OF THE CONTRACT, INCLUDING GENERAL AND SUPPLEMENTARY CONDITIONS, AND DIVISION 1 SPECIFICATION SECTIONS, APPLY TO THIS SECTION.

1.2 SCOPE OF WORK

A. PROVIDE LABOR, INCLUDING FIELD ERECTION AND SUPERVISION, MATERIALS, EQUIPMENT AND ANCILLARIES, AND COORDINATE, PROCURE, FABRICATE, DELIVER, ERECT OR INSTALL, INTERFACE WITH EXISTING WORK, START, DEBUG AND TEST ALL SYSTEMS AS NECESSARY TO PROVIDE THE OWNER WITH A COMPLETE OPERATING FACILITY IN CONFORMANCE WITH THE CONTRACT DOCUMENTS AND IN CONFORMITY WITH REQUIREMENTS OF ALL AUTHORITIES HAVING JURISDICTION.

B. THE WORK SHALL INCLUDE, BUT NOT BE LIMITED TO, THE FOLLOWING:

- DEMOLITION AND REMOVAL OF MECHANICAL WORK.
- DUCTWORK AND AIR OUTLETS
- AIR CONDITIONING AND EXHAUST SYSTEMS.
- KITCHEN HOOD AND EXHAUST SYSTEMS.
- MAKEUP AIR SYSTEMS.
- THERMAL INSULATION.
- COORDINATION WITH OTHER TRADES FOR LOCATION OF DUCTWORK AND TO REMOVE THE GENERAL CONTRACTOR VIA DIMENSIONAL DRAWINGS OF THE EXACT SIZE AND LOCATION OF ALL ROOF AND WALL OPENINGS.
- MISCELLANEOUS STEEL WORK, SUPPORTS, HANGERS AND HANGERS AND CUTTING AND PATCHING OF ROOF, WALLS AND PARTITIONS.
- RECORD DRAWINGS.
- CONTROL, SEQUENCE AND SYSTEM DRAWINGS.
- TESTING, ADJUSTING, AND BALANCING.

C. RELATED WORK INCLUDED IN THIS SECTION AND IN OTHER SECTIONS.

- GENERAL CONTRACTOR IS RESPONSIBLE FOR ALL WORK DESCRIBED IN THE CONSTRUCTION DOCUMENTS.
- REFER TO THE RESPONSIBILITY MATRIX FOR ADDITIONAL INFORMATION.

1.3 SUBMITTALS

A. PROVIDE CONTRACTOR SUBMITTAL MATERIAL WITH DESCRIPTIVE DATA FOR ALL PRODUCTS AND MATERIALS, INCLUDING BUT NOT LIMITED TO THE FOLLOWING, PRIOR TO INSTALLATION. ALL SUBMITTALS SHALL BE HIGHLIGHTED TO IDENTIFY SPECIFIC PRODUCTS OR MATERIALS BEING USED. ALLOW 10 WORKING DAYS FOR THE GENERAL CONTRACTOR TO REVIEW SUBMITTALS.

- COORDINATED LAYOUT PLANS, SHOWING WORK OF ALL TRADES, INCLUDING BUT NOT LIMITED TO DUCTWORK, HVAC, REFRIGERANT, PLUMBING, FIRE PROTECTION PIPING, ELECTRICAL CONDUITS AND BUS DUCTS, EQUIPMENT. DRAWINGS SHALL BE 1/4" SCALE.
- DUCTWORK ACCESSORIES.
- DUCTWORK TYPICAL CONSTRUCTION.
- DUCT SEALING.
- REFRIGERANT PIPING.
- DAMPERS.
- DIFFUSERS, GRILLES AND REGISTERS.
- CERTIFIED ACOUSTICAL TEST PERFORMANCE DATA FOR DIFFUSERS, REGISTERS, GRILLES AND TERMINAL AIR UNITS.
- AIR AND WATER TEST AND BALANCE.
- COMPLETE FORMS PROPOSED FOR USE IN COMPILING AND RECORDING TEST AND BALANCE DATA.
- CONTROL, SEQUENCE AND SYSTEM DRAWINGS.
- CONTROL, SEQUENCE AND SYSTEM DRAWINGS.
- FIRE PROTECTION SYSTEM LAYOUTS IN CODE COMPLIANCE.
- VIBRATION ISOLATION.
- ONE SET OF AS-BUILT REPRODUCIBLE DRAWINGS.

B. PROVIDE 1 COPY OF APPROVED SUBMITTALS TO THE OFFICE OF THE BUILDING ENGINEER.

1.4 PRODUCT SUBSTITUTIONS

A. THE CONTRACTOR SHALL CERTIFY THE FOLLOWING ITEMS ARE CORRECT WHEN USING SUBSTITUTED PRODUCTS OTHER THAN THOSE SCHEDULED OR SHOWN ON DRAWINGS:

- THE PROPOSED SUBSTITUTION DOES NOT AFFECT DIMENSIONS SHOWN ON DRAWINGS.
- THE CONTRACTOR SHALL PAY FOR CHANGES TO BUILDING DESIGN, INCLUDING ENGINEERING DESIGN, STRUCTURAL SUPPORTS, AND CONSTRUCTION COSTS CAUSED BY PROPOSED SUBSTITUTION.
- THE PROPOSED SUBSTITUTION HAS NO ADVERSE EFFECT ON OTHER TRADES, CONSTRUCTION SCHEDULE, OR SPECIFIED WARRANTY REQUIREMENTS.
- MAINTENANCE AND SERVICE PARTS AVAILABLE LOCALLY ARE READY OBTAINABLE FOR THE PROPOSED SUBSTITUTE.

B. THE CONTRACTOR FURTHER CERTIFIES FUNCTION, APPEARANCE, AND QUALITY OF PROPOSED SUBSTITUTION ARE EQUIVALENT OR SUPERIOR TO SPECIFIED ITEM.

C. THE CONTRACTOR AGREES THAT THE TERMS AND CONDITIONS FOR THE SUBSTITUTED PRODUCT THAT ARE FOUND IN THE CONTRACT DOCUMENTS APPLY TO THIS PROPOSED SUBSTITUTION.

1.5 MAINTENANCE MANUALS AND AS-BUILT DRAWINGS

A. PROVIDE FOUR (4) COPIES OF OPERATING AND MAINTENANCE MANUAL FOR OWNERS USE FOR EACH PIECE OF EQUIPMENT WITHIN 90 DAYS OF ACCEPTANCE. EACH ITEM SHALL BE CROSS-REFERENCED AND NUMBERED WITH AS-BUILT DRAWING DESCRIPTIONS.

B. SOFT COPY OF AS-BUILT DRAWINGS ON AUTOCAD AND PDF AND ONE SET OF HARD COPY SHALL BE DELIVERED TO OWNER WITHIN 90 DAYS OF SYSTEM ACCEPTANCE.

1.6 GUARANTEES

A. GUARANTEE: ALL MATERIALS, APPARATUS AND WORKMANSHIP INSTALLED UNDER THIS SECTION SHALL BE UNCONDITIONALLY GUARANTEED FOR A PERIOD OF ONE YEAR FROM THE DATE OF ACCEPTANCE OF WORK BY THE OWNER. CONTRACTOR FAILURE DUE TO FAULTY MATERIAL OR WORKMANSHIP - THE CONTRACTOR SHALL CORRECT DEFECTS AT NO ADDITIONAL COST TO THE OWNER. LABOR AND REPLACEMENT OF PARTS TO BE ACCOMPLISHED AT NO COST TO OWNER.

1.7 SEISMIC SUPPORT

A. CONTRACTOR SHALL SUPPORT AND BRACE ALL NEW HVAC, PLUMBING AND FIRE PROTECTION SYSTEMS IN ACCORDANCE WITH REQUIREMENTS SPECIFIED.

1.8 PRODUCT HANDLING

A. PROTECTION: PROTECT MATERIALS AND EQUIPMENT FROM DAMAGE DURING SHIPPING, STORAGE AND HANDLING. REMOVE FROM THE SITE ANY WET OR DAMAGED DUCT LINER OR INSULATION.

B. STORAGE: WHERE POSSIBLE, STORE MATERIALS AND EQUIPMENT INSIDE AND PROTECT FROM THE WEATHER. WHERE NECESSARY TO STORE OUTSIDE, STORE ABOVE GRADE AND ENCLOSE WITH WATERPROOF WRAPPING.

C. REPLACEMENT: IN THE EVENT OF DAMAGE, IMMEDIATELY REPAIR ALL DAMAGED AND DEFECTIVE WORK TO THE APPROVAL OF THE ENGINEER AT NO ADDITIONAL COST TO THE OWNER.

1.9 CONTRACT DRAWING

A. CONTRACT DRAWINGS FOR MECHANICAL WORK ARE DIAGRAMMATIC, INTENDED TO CONVEY THE SCOPE OF THE WORK AND INDICATE GENERAL ARRANGEMENT OF EQUIPMENT, DUCTS, PIPING AND APPROXIMATE SIZES AND LOCATIONS OF EQUIPMENT AND OUTLETS. DO NOT SCALE DRAWINGS FOR MEASUREMENTS.

B. CONSULT KITCHEN, MECHANICAL, PLUMBING, ARCHITECTURAL, STRUCTURAL AND ELECTRICAL CONTRACT DRAWINGS AND SPECIFICATIONS TO BECOME FAMILIAR WITH ALL CONDITIONS AFFECTING THE WORK. COORDINATE INTERCONNECTING WORK WITH OTHER TRADES AFFECTED, AND VERIFY ALL SPACES IN WHICH THE WORK WILL BE INSTALLED.

1.10 PROJECT CLOSE-OUT

A. AFTER FINAL OPERATION FOR INSPECTION AND ACCEPTANCE DELIVER ALL COPIES OF OPERATION INSTRUCTIONS, MAINTENANCE MANUALS AND PARTS DESCRIPTIONS TO THE ENGINEER.

B. ALL TOOLS SUPPLIED WITH THE EQUIPMENT FOR MAINTENANCE SHALL BE TAGGED AND TEMPORARILY SECURED TO THE UNIT, OR TURNED OVER TO THE OWNER.

1.11 ELECTRICAL

A. GENERAL:

- ALL ELECTRICAL MATERIAL, EQUIPMENT, AND APPARATUS SPECIFIED HEREIN SHALL CONFORM TO THE REQUIREMENTS OF DIVISION 26. REFER TO THE RESPONSIBILITY MATRIX FOR ADDITIONAL INFORMATION.
- PROVIDE ALL MOTORS FOR EQUIPMENT SPECIFIED HEREIN. PROVIDE MOTOR STARTERS, CONTROLLERS, AND OTHER ELECTRICAL APPARATUS AND WIRING WHICH ARE REQUIRED FOR THE OPERATION OF THE EQUIPMENT SPECIFIED HEREIN.
- SET AND ALIGN ALL MOTORS AND DRIVES IN EQUIPMENT SPECIFIED HEREIN.
- SPECIFIC ELECTRICAL REQUIREMENTS (I.E. HORSEPOWER AND ELECTRICAL CHARACTERISTICS) FOR MECHANICAL EQUIPMENT ARE SCHEDULED ON THE DRAWINGS.

B. QUALITY ASSURANCE:

- ELECTRICAL COMPONENTS AND MATERIALS SHALL BE UL OR ETL LISTED/LABELED AS SUITABLE FOR LOCATION AND USE - NO EXCEPTIONS.

C. STARTERS AND ELECTRICAL DEVICES:

- MOTOR STARTER CHARACTERISTICS:
 - ENCLOSURES: NEMA 1, GENERAL PURPOSE ENCLOSURES WITH PADLOCK EARS, EXCEPT IN NET LOCATIONS SHALL BE NEMA 3R WITH CONDUIT HUBS.
 - TYPE AND SIZE OF STARTER SHALL BE AS RECOMMENDED BY MOTOR MANUFACTURER AND THE DRIVE/EQUIPMENT MANUFACTURER FOR APPLICABLE PROTECTION AND START UP CONDITION.
 - MANUAL SWITCHES SHALL HAVE PILOT LIGHTS AND ALL REQUIRED SWITCH POSITIONS FOR MULTI SPEED MOTORS, OVERLOAD PROTECTION, MELTING ALLOY OR IN METALLIC TYPE THERMAL OVERLOAD RELAYS, SIZED ACCORDING TO ACTUAL OPERATING CURRENT (FIELD MEASURED).
 - MAGNETIC STARTERS:
 - HEAVY DUTY, OR RESISTANT, HAND-OFF-AUTO (H/OA), OR AS INDICATED, AND PILOT LIGHTS, PROPERLY ARRANGED FOR SINGLE SPEED OR MULTI SPEED OPERATION AS NOTED.
 - Trip FREE THERMAL OVERLOAD RELAYS, EACH PHASE, SIZED ACCORDING TO ACTUAL OPERATING CURRENT (FIELD MEASURED).
 - INTERLOCKS: PNEUMATIC SWITCHES AND SIMILAR DEVICES AS REQUIRED FOR COORDINATION WITH CONTROL REQUIREMENTS OF DIVISION 23 CONTROL SECTIONS.
 - BUILT IN PRIMARY AND SECONDARY FUSE CONTROL CIRCUIT TRANSFORMER, SUPPLIED FROM LOAD SIDE OF EQUIPMENT DISCONNECT, EXTERNALLY OPERATED MANUAL RESET.
 - UNDER VOLTAGE RELEASE OR PROTECTION FOR ALL MOTORS OVER 20 HP.
 - MOTOR CONNECTIONS TO BE MADE IN ACCORDANCE WITH THE CURRENT PRACTICES FOR ELECTRICAL DEVICES AS SPECIFICALLY INDICATED.

D. LOW VOLTAGE CONTROL WIRING:

 - GENERAL: 14 GAUGE, TYPE THHN, COLOR CODED, INSTALLED IN CONDUIT.
 - MANUFACTURER, GENERAL CABLE CORP., ALCAN CABLE, AMERICAN INSULATED WIRE CORP., SENATOR WIRE AND CABLE CO., OR SOUTHWIRE CO. SHALL BE AUTHORIZED TO COMPLY WITH THESE REQUIREMENTS.

E. DISCONNECT SWITCHES:

 - FUSIBLE SWITCHES: FOR EQUIPMENT 1/2 HP OR LARGER, PROVIDE FUSE, EACH PHASE, HEAVY DUTY, HORSEPOWER RATED, SPRING LOADED QUICK MAKE, QUICK BREAK MECHANISM, DEAD FRONT LINE SIDE SHELD, SOLID BRASS LOWER END OF COPPER CONDUCTORS, SPRING REINFORCED FUSE CLIPS, ELECTRO SILVER PLATED CURRENT CARRYING PARTS, HINGED DOORS, OPERATING LEVER ARRANGED FOR LOCKING IN THE "OPEN" POSITION, ARC QUENCHERS, CAPACITY AND CHARACTERISTICS AS INDICATED.
 - NON FUSIBLE SWITCHES: FOR EQUIPMENT LESS THAN 1/2 HORSEPOWER, SWITCH SHALL BE HORSEPOWER RATED, TIGHT SWITCH TYPE WITH THERMAL OVERLOAD QUANTITY OF POLES AND VOLTAGE RATINGS AS REQUIRED.

2. EXECUTION

2.1 GENERAL

A. WORKMANSHIP SHALL BE PERFORMED BY LICENSED JOURNEMEN OR MASTER MECHANICS AND SHALL RESULT IN AN INSTALLATION CONSISTENT WITH THE BEST PRACTICES OF TRADES.

B. INSTALL WORK UNIFORM, LEVEL AND PLUMB, IN RELATIONSHIP TO LINES OF BUILDING. DO NOT INSTALL ANY DIAGONAL, OR OTHERWISE IRREGULAR WORK UNLESS SO INDICATED ON DRAWINGS OR APPROVED BY ARCHITECT.

2.2 MANUFACTURERS DIRECTIONS

A. FOLLOW MANUFACTURERS DIRECTIONS AND RECOMMENDATIONS IN ALL CASES WHERE THE MANUFACTURERS OR ARTICLES USED ON THIS CONTRACT FURNISH DIRECTIONS OR POINTS NOT SHOWN ON THE DRAWINGS OR COVERED IN THESE SPECIFICATIONS.

2.3 INSTALLATION

A. COORDINATE THE WORK BETWEEN THE VARIOUS MECHANICAL SECTIONS AND WITH THE WORK SPECIFIED UNDER OTHER DIVISIONS. IF ANY COOPERATIVE WORK MUST BE ALTERED DUE TO LACK OF PROPER SUPERVISION OR FAILURE TO MAKE PROPER AND TIMELY PROVISIONS, THE ALTERATIONS SHALL BE MADE TO THE SATISFACTION OF THE ARCHITECT AT THE CONTRACTORS COST. COORDINATE WALL AND CEILING WORK WITH THE GENERAL CONTRACTOR, AND HIS SUBCONTRACTORS IN LOCATING CEILING AIR OUTLETS, WALL REGISTERS, ETC.

B. INSPECT ALL MATERIAL, EQUIPMENT, AND APPARATUS UPON DELIVERY AND DO NOT INSTALL ANY DAMAGED OR DEFECTIVE MATERIALS.

2.4 ELECTRICAL REQUIREMENTS

A. MECHANICAL CONTRACTOR SHALL COORDINATE WITH DIVISION 26 WORK TO PROVIDE COMPLETE SYSTEMS AS REQUIRED TO OPERATE ALL MECHANICAL DEVICES INSTALLED UNDER THIS DIVISION OF WORK.

B. INSTALLATION OF ELECTRICAL CONNECTIONS, FURNISH, INSTALL AND WIRE (EXCEPT AS MAY BE OTHERWISE INDICATED) ALL HEATING, VENTILATING, AIR CONDITIONING, PLUMBING AND FIRE PROTECTION, ETC., MOTORS AND CONTROLS IN ACCORDANCE WITH THE FOLLOWING SCHEDULE AND IN ACCORDANCE WITH EQUIPMENT MANUFACTURERS INSTALLATION INSTRUCTIONS AND WITH RECOGNIZED INDUSTRY PRACTICES, AND COMPLYING WITH APPLICABLE REQUIREMENTS OF UL, NEC, AND NECTAS STANDARD OF INSTALLATION TO ENSURE THAT PRODUCTS FULLY REQUIREMENTS, CAREFULLY COORDINATE WITH WORK PERFORMED UNDER THE MECHANICAL DIVISION OF THESE SPECIFICATIONS.

C. DIVISION 23 HAS RESPONSIBILITIES FOR ELECTRICALLY POWERED OR CONTROLLED MECHANICAL EQUIPMENT WHICH IS SPECIFIED IN DIVISION 23 SPECIFICATIONS OR SCHEDULED ON DIVISION 23 DRAWINGS. THE SPECIFIC DIVISION OR RESPONSIBILITIES BETWEEN DIVISION 23 AND 26 FOR FURNISHING OR WIRING THIS EQUIPMENT IS AS FOLLOWS:


- DIVISION 26 MECHANICAL RESPONSIBILITIES:
 - MOTORS: FURNISH AND INSTALL ALL MOTORS NECESSARY FOR MECHANICAL EQUIPMENT.
 - DISCONNECTS: PROVIDE THE DISCONNECTS WHICH ARE PART OF FACTORY WIRING DIVISION 23 EQUIPMENT. FACTORY WIRING TO INCLUDE WIRING BETWEEN MOTOR AND DISCONNECT OR COMBINATION STARTER/DISCONNECT.
 - CONTROLS: DIVISION 23 CONTRACTOR (INCLUDING THE TEMPERATURE CONTROL SUBCONTRACTOR) IS RESPONSIBLE FOR PROVIDING THE MECHANICAL EQUIPMENT IN ITS ENTIRETY. THIS EQUIPMENT INCLUDES BUT IS NOT LIMITED TO THE FOLLOWING:
 - CONTROL RELAYS NECESSARY FOR CONTROLLING DIVISION 23 EQUIPMENT.
 - CONTROL TRANSFORMERS NECESSARY FOR PROVIDING POWER TO CONTROLS FOR DIVISION 23 EQUIPMENT.
 - LINE VOLTAGE THERMOSTATS.
 - LOW OR NON-LOAD VOLTAGE CONTROL COMPONENTS.
 - REMOTE BULB THERMOSTATS.
 - NON-LIFE SAFETY RELATED VALVE OR DAMPER ACTUATORS.
 - FLOAT SWITCHES.
 - SOLENOID VALVES, SP AND NC SWITCHES.
 - REFRIGERATION CONTROLS. DIVISION 26 PROVIDES POWER TO REFRIGERATION PANELS.
 - PNEUMATIC THERMOSTATS.
 - FIRE AND LIFE SAFETY EQUIPMENT:
 - FIRE/SMOKE DAMPERS: DIVISION 23 IS RESPONSIBLE FOR PROVIDING AND PHYSICALLY INSTALLING THE DAMPER AND FOR INSTALLING ANY REQUIRED CONTROL INTERFACE WIRING TO DIVISION 23 CONTROLS.
 - WHERE FIRE/SMOKE DAMPERS ARE PART OF AN INTEGRATED SMOKE CONTROL SYSTEM, DIVISION 23 IS RESPONSIBLE FOR PROVIDING DAMPERS WITH NECESSARY END SWITCHES FOR PROOF OF CLOSURE.
 - WHERE THESE DAMPERS ARE NOT PART OF AN INTEGRATED AREA WIDE SMOKE DETECTION SYSTEM, DIVISION 23 IS RESPONSIBLE FOR PROVIDING EACH FIRE/SMOKE DAMPER WITH A DESIGNATED DUCT DETECTOR INSTALLED PER THE REQUIREMENTS OF THE BUILDING CODE. IF NOT INTEGRAL WITH THE DAMPER ASSEMBLY, THE DETECTOR IS TO BE INSTALLED BY DIV. 23 BUT WIRED FOR DAMPER CONTROL, BY DIV. 26.
 - FIRE SPRINKLER SYSTEM: DIVISION 23 IS RESPONSIBLE FOR PROVIDING NECESSARY CONTROLS INCLUDING FLOW SWITCHES AND ALARM BELLS.
 - FIRE SUPPRESSION SYSTEM: DIVISION 23 IS RESPONSIBLE FOR PROVIDING NECESSARY SYSTEM CONTROLS AND ANY REQUIRED CONTROL INTERFACE TO THESE CONTROLS.
 - DIVISION 23 IS RESPONSIBLE FOR BRINGING POWER TO POINT OF CONNECTION WITH THE SYSTEM.
- DIVISION 26 HAS RESPONSIBILITIES FOR ELECTRICALLY POWERED OR CONTROLLED MECHANICAL EQUIPMENT WHICH IS SPECIFIED IN DIVISION 23 SPECIFICATIONS OR SCHEDULED ON DIVISION 23 DRAWINGS. THE SPECIFIC DIVISION OR RESPONSIBILITIES BETWEEN DIVISION 23 AND 26 FOR FURNISHING

OR WIRING THIS EQUIPMENT IS AS FOLLOWS:

- DIVISION 26 ELECTRICAL RESPONSIBILITIES
- MOTORS: PROVIDE THE POWER WIRING FOR THE MOTORS.
- DISCONNECTS: PROVIDE ALL DISCONNECTS NECESSARY FOR DIVISION 23 MECHANICAL EQUIPMENT WHICH ARE NOT PROVIDED AS PART OF FACTORY WIRING DIVISION 23 EQUIPMENT. PROVIDE POWER WIRING TO ALL DISCONNECTS, IN ADDITION PROVIDE POWER WIRING BETWEEN MOTOR AND VARIABLE FREQUENCY DRIVE ABOVE FOR SPECIAL WIRING REQUIREMENTS.
 - CONTROLS: DIVISION 26 CONTRACTOR IS RESPONSIBLE FOR PROVIDING POWER TO CONTROL PANELS AND CONTROL CIRCUIT OUTLETS.
 - FIRE AND LIFE SAFETY EQUIPMENT:
 - FIRE/SMOKE DAMPERS: DIVISION 26 IS RESPONSIBLE FOR POWER WIRING TO THE DAMPER AND AS FOLLOWS:
 - WHERE THESE DAMPERS ARE PART OF AN INTEGRATED SMOKE CONTROL SYSTEM, DIVISION 26 IS RESPONSIBLE FOR PROVIDING THE DETECTORS AND FOR ALL FIRE DETECTION SYSTEM WIRING NECESSARY TO INTEGRATE DAMPERS AND RELATED END SWITCHES INTO THE SYSTEM.
 - WHERE THESE DAMPERS ARE NOT PART OF AN INTEGRATED AREA WIDE SMOKE DETECTION SYSTEM, DIVISION 26 IS RESPONSIBLE FOR PROVIDING EACH FIRE/SMOKE DAMPER WITH A DESIGNATED DUCT DETECTOR INSTALLED PER THE REQUIREMENTS OF THE BUILDING CODE. IF NOT INTEGRAL WITH THE DAMPER ASSEMBLY, THE DETECTOR IS TO BE INSTALLED BY DIV. 23 BUT WIRED FOR DAMPER CONTROL, BY DIV. 26.
 - FIRE SPRINKLER SYSTEM: DIVISION 26 IS RESPONSIBLE FOR PROVIDING POWER WIRING TO FIRE PROTECTION CONTROLS INCLUDING FLOW SWITCHES AND ALARM BELLS.
 - SPECIALIZED FIRE SUPPRESSION SYSTEMS: DIVISION 26 IS RESPONSIBLE FOR PROVIDING NECESS

AIR BALANCE TABLE AT DESIGN ⑦							
	HVAC SUPPLY (CFM)	HVAC RETURN (CFM)	HVAC OSA (CFM)	HOOD OSA (CFM)	HOOD EXHAUST (CFM)	GENERAL EXHAUST (CFM)	AREA SERVED
CU-1/ FC-1.1, 1.2	5,100	4,300	800	-	-	-	DINING
CU-2/ FC-2.1, 2.2, 2.3	3,720	3,420	300	-	-	-	BOH
MUA-1	-	-	-	2,194	-	-	KEH-1/2
ESP-1	-	-	-	-	2,742	-	KEH-1/2
EF-1	-	-	-	-	-	300	RESTROOMS
TOTAL	8,820	7,720	1,100	2,194	2,742	300	
OSA			3,294		-3,042		

TOTAL PRESSURIZATION DIFFERENCE = +252

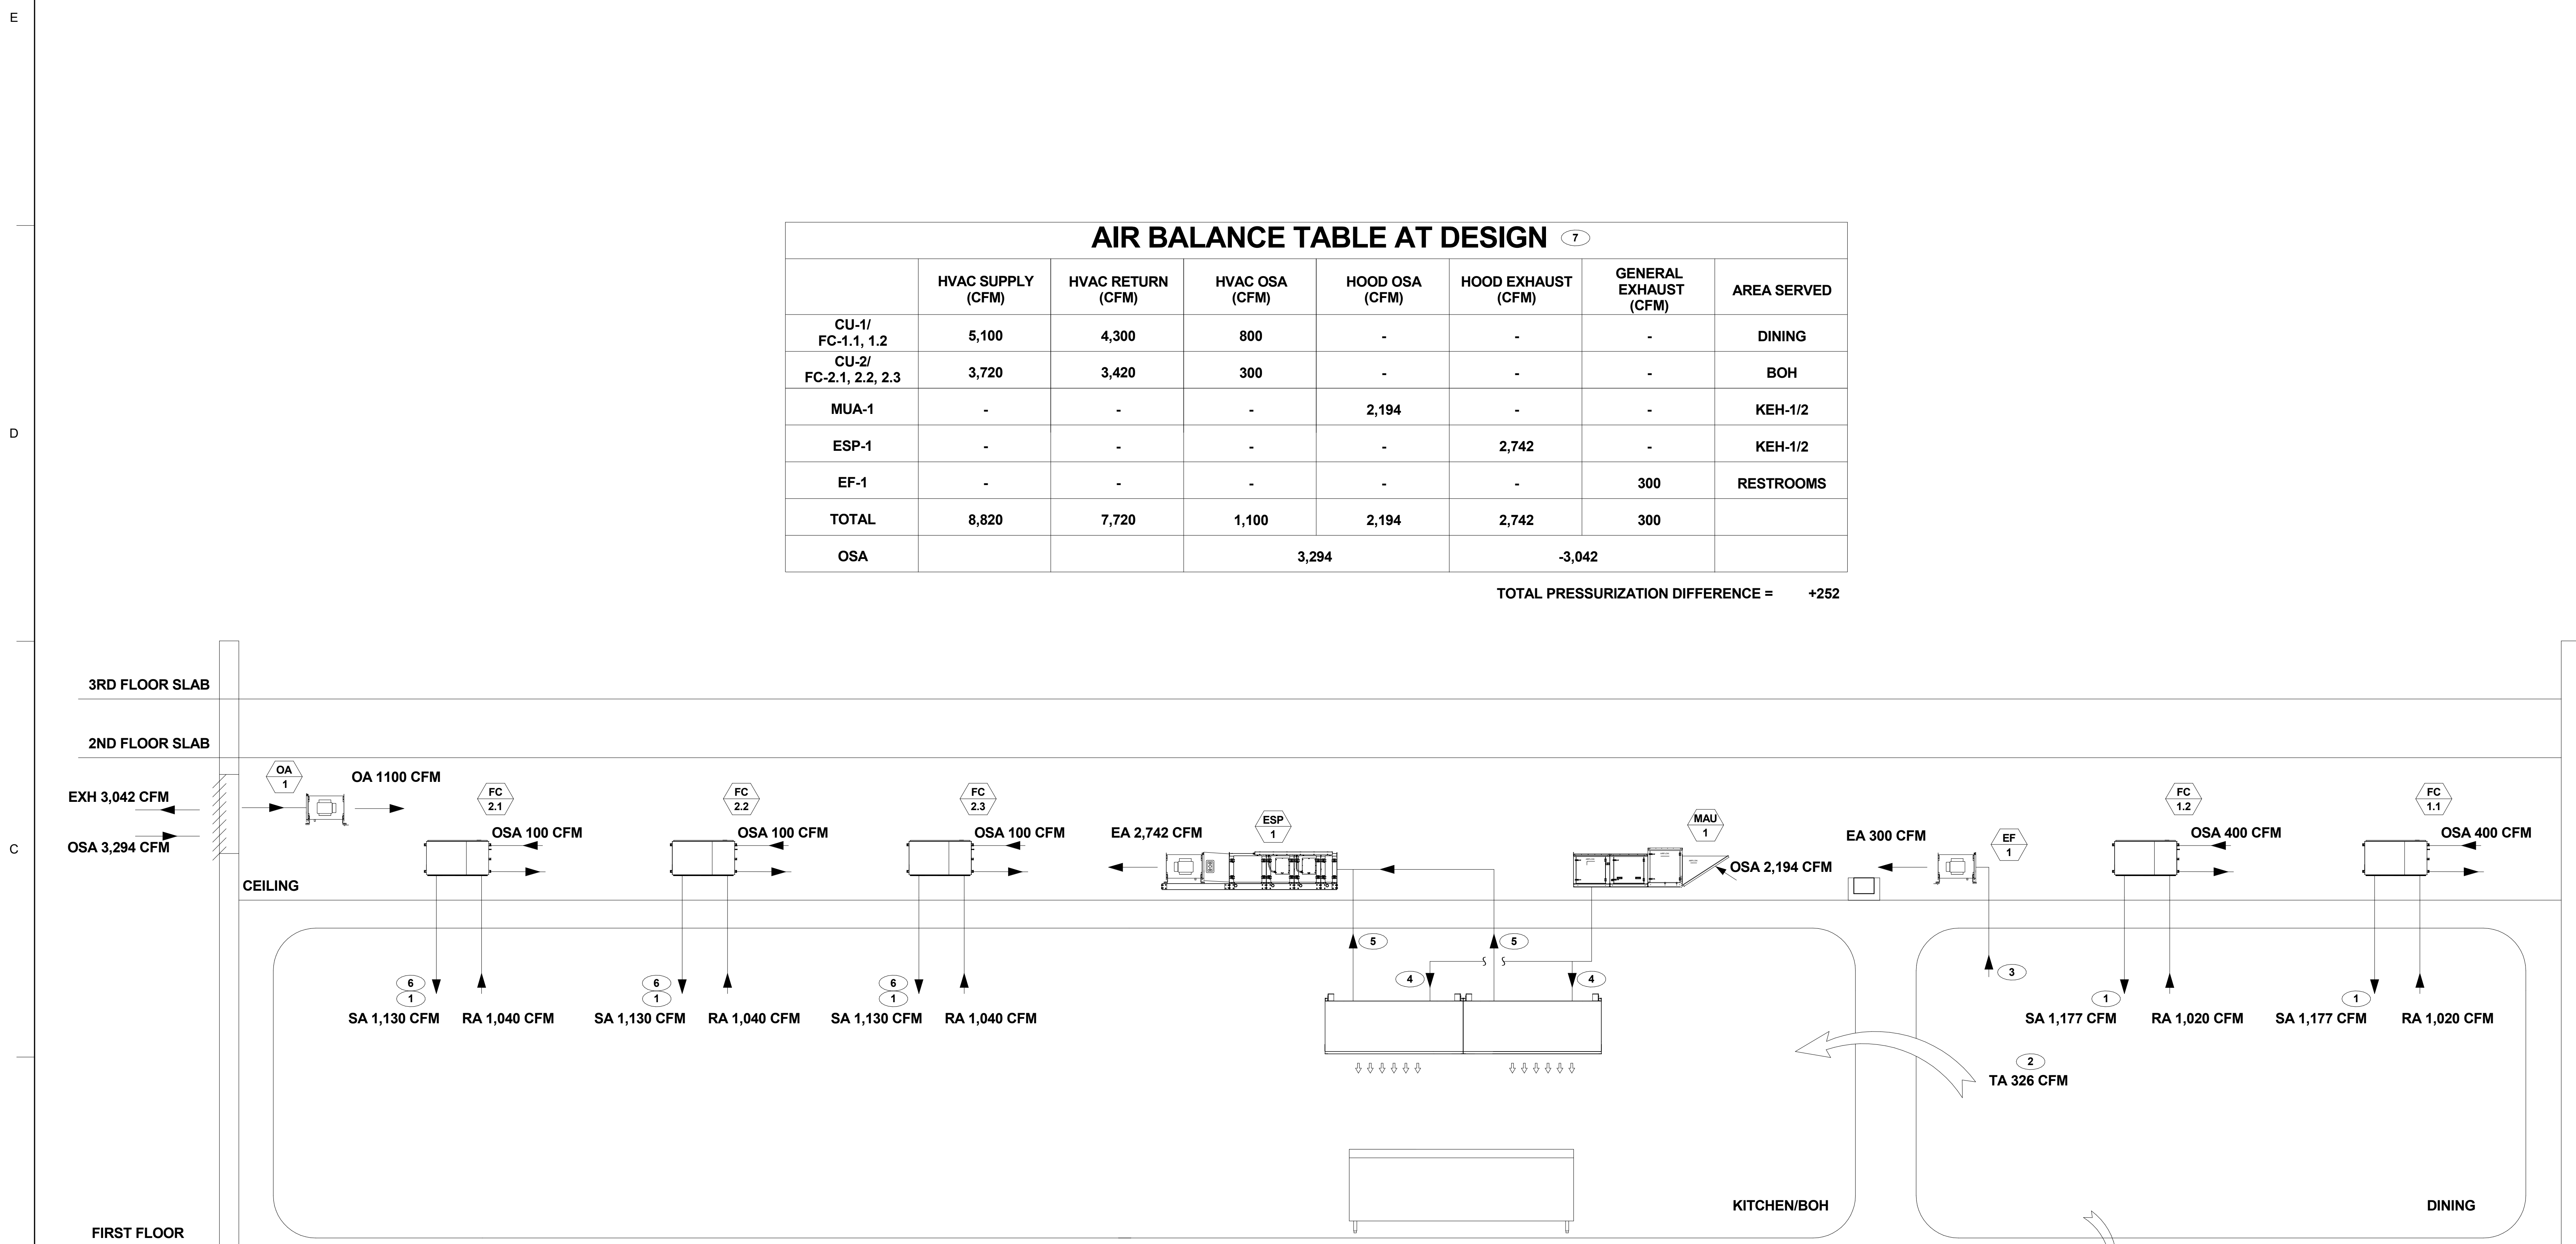

- KEYNOTES:
- TOTAL OF AIR INLETS / OUTLETS.
 - TRANSFER AIR TO KITCHEN FROM ADJACENT SPACE.
 - TOTAL OF RESTROOM EXHAUST FANS.
 - MAKE UP AIR TO SUPPLY KITCHEN HOOD.
 - KITCHEN HOOD EXHAUST.
 - INCLUDES SUPPLY TO KITCHEN HOOD.
 - KITCHEN HVAC EQUIPMENT TO ALL BE ELECTRONICALLY INTERLOCKED. SEE KITCHEN EQUIPMENT WIRING DETAILS ON SHEETS M806-M808.

MECHANICAL AIRFLOW DIAGRAM ①
 SCALE: NTS

STORE NO:
CA #1398

SHAKE SHACK
 SHAKE SHACK - KOREATOWN
 3786 WILSHIRE BLVD. LOS ANGELES, CA 90010

REVISION	
DATE	DESCRIPTION
11/08/21	PERMIT/BID SET
A 01/26/22	REVISION 1
T 07/01/22	REVISION 1
4 09/16/22	REVISION 4

STATUS:
PERMIT/BID SET

PRELIMINARY:
 Preliminary Documents Are for Design Review only and not intended for bidding, permitting or construction purposes. They were prepared by or under the supervision of Zebra Projects, Inc.



FIELD VERIFICATION:
 The contractor shall verify all signed dimensions and condition at the project site and notify Zebra Projects, Inc. of any dimensional errors, or omissions or discrepancies before beginning or fabricating any work. Do not scale these drawings.

COPYRIGHT © 2021:
 Zebra Projects, Inc. shall retain all common law, statutory and all other reserved rights. Neither the documents nor the information herein is to be reproduced, distributed, disclosed or otherwise used without the written consent of Zebra Projects, Inc.

SHEET NAME:
MECHANICAL AIRFLOW DIAGRAMS

DATE: 11/08/21 PROJECT NO: SHK-21-008
 DRAWN: SK SCALE: NTS

SHEET NO:
M601



ZEBRA PROJECTS, INC.
14814 N KIERLAND BLVD, SUITE N 300
SCOTTSDALE, ARIZONA 85254
PHONE: 480.912.1169 www.zbr.co.uk



2361 Rosecrans Ave. Suite 368, El Segundo, CA 90245
P: 310.725.1500 F: 310.725.0215 www.iFactor.com

STORE NO:
CA #1398



GENERAL

1. PROVIDE ALL EQUIPMENT AND ACCESSORIES REQUIRED FOR A COMPLETE AND FUNCTIONAL CONTROL SYSTEM.
2. PROVIDE ALL NEW DDC CONTROLLERS, IOMS, ACTUATORS, CONTROL VALVES, SENSORS, HUMIDISTATS, AND THERMOSTATS.
3. ALL EQUIPMENT AND COMPONENTS SHALL BE INSTALLED IN ACCORDANCE WITH MANUFACTURER'S INSTRUCTIONS, LOCAL CODE, AND OWNER'S REQUIREMENTS.
4. COORDINATE WITH MECHANICAL AND ELECTRICAL CONTRACTORS FOR EXACT LOCATIONS OF EQUIPMENT FOR CONNECTION TO CONTROL SYSTEM.

VRF SYSTEMS

1. ALL HVAC MECHANICAL UNITS SHALL SHUT DOWN UPON ALARM FROM KITCHEN EXHAUST HOOD FIRE EXTINGUISHING SYSTEM.
2. DURING OCCUPIED HOURS, FAN COIL UNITS SUPPLY FANS SHALL RUN CONTINUOUSLY.
3. CONTROLS CONSIST OF A MICROPROCESSOR-BASED CONTROL SYSTEM WHICH CONTROLS SPACE TEMPERATURE, DETERMINE OPTIMUM FAN SPEED, AND RUN SELF DIAGNOSTICS..

MAU-1

1. MAKE-UP UNIT SUPPLY AIR FAN SHALL BE ENERGIZED AND THE OUTSIDE AIR DAMPER SHALL OPEN 100% WHEN EXHAUST FAN KEF-1 AND KEF-2 ARE ENERGIZED.
2. MAKE-UP UNIT SUPPLY AIR FAN SHALL BE DE-ENERGIZED BY ANY KITCHEN EXHAUST HOOD FIRE EXTINGUISHING SYSTEM, SMOKE DETECTOR ALARMS, OR UPON ALARM FROM DUCT MOUNTED SMOKE DETECTOR OF MAU-1.
3. EVAPORATIVE COOLING OR GAS HEAT (IF EQUIPPED) SHALL ENABLE TO MAINTAIN THE DISCHARGE AIR TEMPERATURE BETWEEN 75 DEG-F (ADJ.) AND 60 DEG-F (ADJ.).

ESP-1

1. ESP-1 SHALL BE ENERGIZED BY CONTACTORS IN HOOD CONTROL PANEL. COORDINATE INSTALLATION WITH ELECTRICAL CONTRACTOR.
2. ESP-1 FIRE SYSTEM WILL ACTIVATE WHEN THE HOOD SYSTEM ACTIVATES AND WILL ACT IN REVERSE.

RESTROOM EXHAUST FAN (EF-1)

1. EF-1 SHALL OPERATE CONTINUOUSLY DURING OCCUPIED HOURS AND SHALL BE SHUT DOWN DURING UNOCCUPIED HOURS.

OUTSIDE AIR SUPPLY FAN (SF-1)

1. SF-1 SHALL OPERATE CONTINUOUSLY DURING OCCUPIED HOURS AND SHALL BE SHUT DOWN DURING UNOCCUPIED HOURS.

KITCHEN EXHAUST HOODS (KEH-1 AND KEH-2)


1. THE ELECTRICAL PACKAGE, TYPICALLY FP, IS DESIGNED TO THERMOSTATICALLY ACTIVATE THE EXHAUST FANS FOR AN EXHAUST HOOD WHENEVER ELEVATED TEMPERATURES ARE SENSED IN THE EXHAUST SYSTEM. THIS OPTION WILL MEET THE REQUIREMENTS OF BY PROVIDING A THERMOSTAT(S) MOUNTED IN THE DUCT OR HOOD RISER TO SENSE INCREASED EXHAUST TEMPERATURES.
2. CONTROLS SHALL BE LISTED BY ETL (UL 908A). THE CONTROL ENCLOSURE SHALL BE NEMA 1 RATED AND LISTED FOR INSTALLATION INSIDE OF THE EXHAUST HOOD UTILITY CABINET. THE CONTROL ENCLOSURE MAY BE CONSTRUCTED OF STAINLESS STEEL OR PAINTED STEEL.
3. TEMPERATURE PROBES(S) LOCATED IN THE DUCT RISER SHALL BE CONSTRUCTED OF STAINLESS STEEL.
4. A ROOM TEMPERATURE SENSOR IS ALSO PROVIDED FOR FIELD INSTALLATION IN THE KITCHEN SPACE IN ORDER TO START THE FAN(S) BASED ON THE TEMPERATURE DIFFERENTIAL BETWEEN THE ROOM AND THE EXHAUST AIR IN THE DUCT, RATHER THAN FIXED SET-POINTS. THE SYSTEM IS FACTORY PRE-SET TO ACTIVATE THE FANS AT 10 DEG-F ABOVE THE ROOM TEMPERATURE.
5. ONCE THE DUCT TEMPERATURE REACHES THE ACTIVATION POINT, THE EXHAUST FANS WILL BE ACTIVATED. THE CONTROLS ALSO PROVIDE HYSTERESIS TO PREVENT CYCLING OF THE FANS AFTER THE COOKING APPLIANCES HAVE BEEN TURNED OFF AND THE HEAT IN THE EXHAUST SYSTEM IS REDUCED. THE HYSTERESIS IS FACTORY SET 2 DEGREES AND WILL KEEP THE EXHAUST RUNNING UNTIL THE TEMPERATURE FALLS 2 DEGREES BELOW THE ACTIVATION SET POINT. A HYSTERESIS TIMER ALSO EXISTS TO KEEP THE FANS RUNNING FOR AT LEAST 30 MIN AFTER BEING ACTIVATED BY THE TEMPERATURE RISE.
6. THE ACTIVATION AND HYSTERESIS SETTINGS MAY BE FIELD ADJUSTED ON THE BOARD LCD INTERFACE LOCATED INSIDE THE CONTROL ENCLOSURE TO MEET APPLICATION NEEDS. THE PANEL IS FACTORY CONFIGURED TO SHUT DOWN SUPPLY FANS, TURN ON THE EXHAUST FANS AND TURN OFF THE HOOD LIGHTS IN A FIRE CONDITION.

REVISION

Δ	DATE	DESCRIPTION
	11/08/21	PERMIT/BID SET
A	01/26/22	REVISION A
T	07/01/22	REVISION 1
4	09/16/22	REVISION 4

STATUS:
PERMIT/BID SET

PRELIMINARY:
Preliminary Documents Are for Design Review only and not intended for bidding, permitting, or construction purposes. They were prepared by or under the supervision of Zebra Projects, INC.

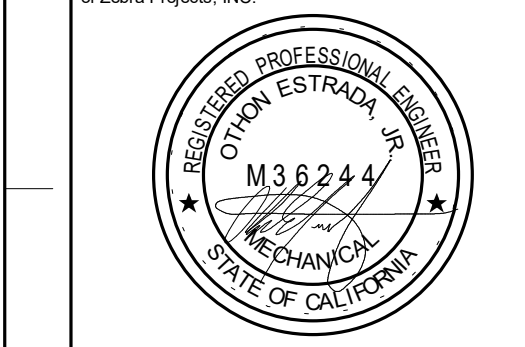

FIELD VERIFICATION:
The contractor shall verify all signed dimensions and condition at the project site and notify Zebra Projects, INC. of any dimensional errors, or omissions or discrepancies before beginning or fabricating any work. Do not scale these drawings.

COPYRIGHT © 2021:
Zebra Projects, INC. shall retain all common law, statutory, and all other reserved rights. Neither the documents nor the information herein is to be reproduced, distributed, disclosed or otherwise without the written consent of Zebra Projects, INC.

SHEET NAME:
MECHANICAL CONTROLS

DATE: 11/08/21 PROJECT NO: SHK-21-008
DRAWN: SK SCALE: NTS

SHEET NO:
M602

POLLUTION CONTROL UNIT SCHEDULE

Table with columns: ITEM, ITEM NO., MANUFACTURER, MODEL, AREA SERVED, DOP EFFICIENCY, UL LISTINGS, TOTAL QTY. OF ESP CELLS, AIR VOLUME (CFM), ESP SECTIONS, SQ. FT. OF CELL AREA, FPM VELOCITY, TRAYS, NOMINAL MEDIA (LBS.), MANUFACTURER, MODEL, CFM, TSP, TYPE, DRIVE, RPM, HP, DETERGENT PER CYCLE (GAL.), QUANTITY WASH DOWN CONNECTIONS, WATER REQUIRED @ 40 PSI, WATER REQ'D PER WASH CYCLE (GAL.), ELECTRICAL (V, PH, HZ, FLA), FIRE SYSTEM PIPING, WT. (LBS.), REMARKS.

NOTES: 1. SEE M801-M808 FOR ADDITIONAL REQUIREMENTS AND FIELD WIRING. 2. UNIT TO BE ELECTRONICALLY INTERLOCKED WITH MAU-1. SEE WIRING INTERLOCK DETAILS ON SHEETS M806, M807, AND M809.

INDOOR UNIT SCHEDULE

Table with columns: ITEM, ITEM NO., MANUFACTURER, MODEL, TYPE, AREA SERVED, TONS, SUPPLY FAN (CFM, E.S.P. (TWG), MOTOR), OSA (CFM), COOLING CAPACITY (BTUH, EAT DB (F), WB (F), LAT WB (F)), HEATING CAPACITY (BTUH, EAT DB (F), LAT DB (F)), REFRIGERANT AND PIPING (REFR., RL, RG), ELECTRICAL (MCA, MOCP, V, PH, HZ), FILTERS (QTY., SIZE, %EFF.), WT. (LBS.), REMARKS.

NOTES: 1. PROVIDE WITH REMOTE CONTROLLER (RBC-AMSS4E-UL). 2. PROVIDE MERV 13 FILTER CABINET KIT (FS-APBHP03). 3. PROVIDE WITH REMOTE CONTROLLER (KSACN0801AAA). 4. FAN COIL TO RUN 247. 5. PROVIDE WITH CONDENSATE PUMP (53DS-900-118).

OUTDOOR CONDENSING UNIT SCHEDULE

Table with columns: ITEM, ITEM NO., MANUFACTURER, MODEL, TYPE, MODULES (QUANT.), TONS, COOLING CAPACITY (BTUH, AMBIENT DB (F)), HEATING CAPACITY (BTUH, AMBIENT WB (F)), REFRIGERANT AND PIPING (REFR., RL, RG), EER, COP, ELECTRICAL (MCA, MOP, V, PH, HZ), WT. (LBS.), REFRIGERANT CHARGE (LBS.), COMPRESSOR HORSEPOWER (HP), REMARKS.

NOTES: 1. PROVIDE WITH SHRM6/SMM6 VRF OUTDOOR UNIT SNOW HOOD TO PROVIDE PROPER VENTILATION FROM AIR OUTSIDE PARKING GARAGE.

EXHAUST FAN SCHEDULE

Table with columns: ITEM, ITEM NO., MANUFACTURER, MODEL, AREA SERVED, CFM, ESP, TYPE, DRIVE, RPM, WATTS, V, PH, HZ, FLA, WT. (LBS.), REMARKS.

NOTES: 1. PROVIDE WITH VARI-GREEN ECM WITH DIAL ONLY. 2. PROVIDE WITH NEMA-1 TOGGLE SWITCH. 3. PROVIDE WITH BACKDRAFT DAMPER. 4. EXHAUST FAN TO BE ELECTRICALLY INTERLOCKED WITH RESTROOM LIGHTS. SEE KEYNOTE 4/E301 FOR ADDITIONAL INFORMATION. 5. EXHAUST FAN TO BE ELECTRICALLY INTERLOCKED WITH FC-1.2.

SUPPLY FAN SCHEDULE

Table with columns: ITEM, ITEM NO., MANUFACTURER, MODEL, SERVED, CFM, ESP, TYPE, DRIVE, RPM, HP, V, PH, HZ, WT. (LBS.), REMARKS.

NOTES: 1. PROVIDE WITH VARI-GREEN ECM WITH DIAL ONLY. 2. PROVIDE WITH NEMA-1 TOGGLE SWITCH. 3. PROVIDE WITH BACKDRAFT DAMPER.

MAKEUP AIR UNIT SCHEDULE

Table with columns: ITEM, ITEM NO., MANUFACTURER, MODEL, AREA SERVED, CFM, E.S.P. (IN. WG.), SUPPLY FAN (FAN RPM, FAN BHP, HP), COOLING (EDB (F), EWB (F), LWB (F)), HEATING (INPUT (MBH), OUTPUT (MBH), TEMP RISE (DEG-F), EFF.), ELECTRICAL (V, PH, FLA, MCA, MOCP), FILTER EFF. (%), WT. (LBS.), REMARKS.

NOTES: 1. PROVIDE WITH CASLINK BUILDING MONITORING SYSTEM FOR FUTURE CONNECTION. 2. PROVIDE WITH INLET AND MANIFOLD PRESSURE GAUGES. 3. PROVIDE WITH MOTORIZED BACKDRAFT DAMPER. 4. PROVIDE WITH FAN VFD. 5. PROVIDE WITH CURB VIBRATION ISOLATION. COORDINATE CURB REQUIREMENTS WITH MANUFACTURER. 6. SEE M806 FOR FIELD WIRING. 7. UNIT TO BE ELECTRONICALLY INTERLOCKED WITH MAU-1. SEE WIRING INTERLOCK DETAILS ON SHEETS M806, M807, AND M809.

KITCHEN EXHAUST HOOD SCHEDULE

Table with columns: ITEM, ITEM NO., MANUFACTURER, MODEL, LENGTH X WIDTH, EXHAUST COLLAR (CFM, LENGTH, WIDTH, ESP), MAKE-UP COLLAR (CFM, LENGTH, WIDTH, ESP), AC COLLAR (CFM, DIAMETER, ESP), HOOD CONSTRUCTION, FIRE SYSTEM, FIRE SYSTEM PIPING, WT. (LBS.), REMARKS.

NOTES: 1. PROVIDE WITH UL APPROVED MANUAL AIR VOLUME DAMPER ON EXHAUST COLLAR BY HOOD MANUFACTURER. 2. SEE M801-M806 FOR ADDITIONAL REQUIREMENTS AND FIELD WIRING.

AIR CURTAIN SCHEDULE

Table with columns: ITEM, ITEM NO., MANUFACTURER, MODEL, AREA SERVED, CFM, VELOCITY, HP, ELECTRICAL (V, PH, FLA, MOCP), WT. (LBS.), REMARKS.

NOTES: 1. PROVIDE WITH WALL MOUNTING BRACKET. 2. AIR CURTAIN TO BE CONTROLLED BY DOOR SWITCH. 3. PROVIDE WITH RELAY SWITCH KIT TO OPERATE UNIT WHEN WINDOW OPENS.

REFRIGERANT VOLUME CALCULATION - 3RD FLOOR PARKING

Table with columns: SPACE, SYSTEM, AREA (SQ. FT), CEILING HEIGHT (FT), VOLUME (FT^3), REFRIGERANT ALLOWED IN SPACE (LBS) (NOTE 1), SYSTEM VOLUME (LBS) (NOTE 3).

NOTES: 1. PER CALIFORNIA MECHANICAL CODE, TABLE 1102.2. REFRIGERANT TYPE 4-10A. ALLOWABLE 28LBS/1000 (FT^3). 2. REFRIGERATION MACHINERY ROOM NOT REQUIRED PER EXCEPTION CMC 1106.1.1. 3. SUM OF ALL SYSTEM VOLUME OF CU-1, CU-2, AND CU-3.

AIR DISTRIBUTION SCHEDULE

Table with columns: MARK NO., MANUFACTURE MODEL NUMBER, NECK SIZE (IN), CFM RANGE, MAX NC LEVEL, REMARKS.

NOTES: 1. FURNISH WITH OFF-WHITE BAKED ENAMEL FINISH UOJ. COORDINATE EXACT FINISHES WITH ARCH. 2. PROVIDE OPTIONAL INSULATION ON SUPPLY DIFFUSERS. OMIT INSULATION ON RETURN DIFFUSERS. 3. PROVIDE LAY IN TYPE 24x24 BORDER, OTHERWISE COORDINATE BORDER TYPE WITH ARCH. PRIOR TO ORDERING.

LOUVER SCHEDULE

Table with columns: ITEM, ITEM NO., MANUFACTURER, MODEL, NECK SIZE (L" x W"), REMARKS.

NOTES: 1. PROVIDE 1/2" MESH ALUMINUM BIRDSCREEN. 2. LOUVER COLOR SHALL MATCH WALL, COORDINATE WITH ARCHITECT. 3. PROVIDE WITH LOW-LEAKAGE BACKDRAFT DAMPER.

OUTSIDE AIR SCHEDULE

Table with columns: UNIT, AREA SERVED, AREA, NUMBER OF PEOPLE, OSA BY AREA, OSA BY PEOPLE, MINIMUM OSA REQUIRED, OSA PROVIDED.

DUCT SIZING CHART

Table with columns: AIRFLOW (CFM), SIZE (IN).

DUCT SIZING CHART

Table with columns: AIRFLOW (CFM), SIZE (IN).

FOR COMMERCIAL KITCHEN EXHAUST DUCT. AIR VELOCITY SHALL NOT BE LESS THAN 500 FPM AND NOT EXCEED 2500 FPM.

FOR LOW VELOCITY SUPPLY AND RETURN DUCT.

REFRIGERANT VOLUME CALCULATION - RESTAURANT

Table with columns: ROOMS, SYSTEM, AREA (SQ. FT), CEILING HEIGHT (FT), VOLUME (FT^3), REFRIGERANT ALLOWED IN SPACE (LBS) (NOTE 1), SYSTEM VOLUME (LBS).

NOTES: 1. PER CALIFORNIA MECHANICAL CODE, TABLE 1102.2. REFRIGERANT TYPE 4-10A. ALLOWABLE 28LBS/1000 (FT^3). 2. PER CALIFORNIA MECHANICAL CODE SECTION 1104.2.3.2 - PLENUMS AND SECTION 1104.2.3.3 - SUPPLY AND RETURN DUCTS. THE SPACE ABOVE A SUSPENDED CEILING MAY BE INCLUDED IN CALCULATING THE REFRIGERANT QUANTITY LIMIT IN THE SYSTEM WHEN SUCH SPACE IS A PART OF THE AIR SUPPLY OR RETURN SYSTEM. [ASHRAE 15.7.3.2.3]. ROOMS UTILIZE PLENUM RETURN BACK TO UNIT. PLENUM VOLUME OF OPEN KITCHEN IS INCLUDED. 3. PER CALIFORNIA MECHANICAL CODE SECTION 1104.2.2.2. SPACES CONNECTED PER PERMANENT OPENING OR HVAC DUCT ARE COUNTED TOGETHER FOR SPACE VOLUME. TRANSFER GRILLE ADDED TO CONNECT ROOM WITH DINING 101/HALLWAY 106. 4. INCLUDES VOLUME OF OPEN PLENUM - 6000 (FT^3). VOLUME OF PLENUM IS CALCULATED BY ADDING AREA WITH PLENUM. OPEN KITCHEN (875 SQFT) + MANAGERS OFFICE (65 SQFT) + CUSTARD ROOM (60 SQFT) = 1000 SQFT. MULTIPLIED BY HEIGHT OF PLENUM - 6. 5. INCLUDES VOLUME OF OPEN DINING AREA.

STORE NO. CA #1398

SHAKE SHACK SHAKESHACK - KOREATOWN 3786 WILSHIRE BLVD. LOS ANGELES, CA 90010

REVISION table with columns: DATE, DESCRIPTION.

STATUS: PERMIT/BID SET

PRELIMINARY: Preliminary Documents Are For Design Review Only and not intended for construction, permitting or construction. They were prepared by or under the supervision of Zebra Projects, Inc.



FIELD VERIFICATION: The contractor shall verify all signed dimensions and location at the project site and notify Zebra Projects, Inc. of any dimensional errors, omissions or discrepancies. Initials, beginning of fabrication any work. Do not make these changes.

COPYRIGHT © 2021: Zebra Projects, Inc. shall retain all common law, statutory and all other reserved rights. Neither the documents nor the information herein is to be reproduced, distributed, disclosed or otherwise without the written consent of Zebra Projects, Inc.

SHEET NAME: MECHANICAL SCHEDULES

DATE: 11/08/21 PROJECT NO: SHK-21-008

DRAWN: SK SCALE: NTS

SHEET NO: M701

EQUIPMENT UTILITY SCHEDULE																		
REV	ITEM NO.	QTY	ITEM DESCRIPTION	MFR	MODEL	ELECTRICAL						PLUMBING					REMARKS	ITEM NO.
						VOLTS	PH	AMPS	KW	HP	CONN.	NEMA	CW (IN)	HW (IN)	IW	DW		
	104	1	FRYER BATTERY, GAS	PITCO	SSH55-1FD	115	1	1.7									WITH FILTER DRAWER, DIGITAL CONTROLS, CASTERS, DOUBLE BASKET HANGERS.	104
	104A	1	SAFETY SYSTEM MOVEABLE GAS CONNECTOR	DORMONT	1610K0IT2548	115	1	6.1		1/3	DR	5-15P					NOT SHOWN ON PLAN.	104A
	105	1	FRENCH FRY WARMER	HATCO	GRFHS-PT16	120	1	9.1	1.09		DR	5-15P						105
	106	1	SPEED RAIL / RACK	EAGLE GROUP	500778													106
	107	1	BREADING STATION	EAGLE FOR SHAKE SHACK	YCCOUNTER-0520-00													107
	108-109	1	SPARE NUMBER	CUSTOM														108-109
	110	2	STANDOFF SHELF	EAGLE FOR SHAKE SHACK	YW5672-0001-00												ALL S/S 6" X 72"	110
	111	1	TYMER, ELECTRONIC	COOPER-ATKINS	TF34-01												NOT SHOWN ON PLAN.	111
	112-119	1	SPARE NUMBER	CUSTOM														112-119
	120	1	BUN TOASTER TABLE	EAGLE GROUP	T30485TB-BS													120
	121	1	TOASTER CONTACT GRILL, CONVEYOR TYPE	APW WYOTT	M-95-3													121
	122	1	PIZZA PREPARATION REFRIGERATOR	RANDELL	8383N-290	208	1	13.4	2.78	1/4	DR	6-20P						122
	123	1	WORKTOP FREEZER	RANDELL FOR SHAKE SHACK	9402F-290	115	1	2.2		1/4	DR	5-15P						123
	124	1	FOOD TOPPING WARMER, COUNTERTOP	SERVER PRODUCTS	81220	120	1	8.3	1.0		DR	5-15P					WITH (2) 94009 S/S JARS	124
	125	2	KDS SCREEN	BY OTHERS		120	1	15.0			DR	5-15P					ALL TRADES TO VERIFY UTILITY REQUIREMENTS.	125
	126	2	BRACKET	CDW	1711461/SHACK												NOT SHOWN ON PLAN.	126
	127-129	1	SPARE NUMBER	CUSTOM													ALL S/S SIZE AS PER PLANS	127-129
	130	1	OVERSHELF	EAGLE FOR SHAKE SHACK	120/208	120	20.0				JBW							130
	130A	1	PAN HOLDER	EAGLE FOR SHAKE SHACK	YJ-3618-00													130A
	131	1	HEATED SHELF FOOD WARMER	HATCO	GRS8-00-F	120	1	7.9	0.95		JBH							131
	132	1	S/S SANDWICH DIVIDER	EAGLE FOR SHAKE SHACK	YJ-3488-00												S/S RODS SIZED TO FIT ON HEATED SHELF.	132
	133	1	HEAT LAMP	HATCO	GRAHL-60D3	120/208	1	16.6	3.1		JBH						WITH REMOTE BOX ENCLOSURE.	133
	134	1	HEAT LAMP	HATCO	UGAHL-24D3	120/208	1	8.2	1.62		JBH						UNIT WITH CLED-2700 LED LIGHT BULBS.	134
	135	1	HEATED SHELF FOOD WARMER	HATCO	GRS8-24-F	120	1	3.5	0.42		JBH							135
	140	1	WORK CENTER	EAGLE FOR SHAKE SHACK	YT1672-0002-00												CONSISTING OF: 16" X 72", S/S TOP (2) WIRE SHELVES BELOW AND CASTERS.	140
	140A	1	WORK CENTER	EAGLE FOR SHAKE SHACK	YT1660-0002-00												CONSISTING OF: 16" X 60", S/S TOP (2) WIRE SHELVES BELOW AND CASTERS.	140A
	141	1	KDS SCREEN	BY OTHERS		120	1	15.0			DR	5-15P					ALL TRADES TO VERIFY UTILITY REQUIREMENTS.	141
	142	1	BRACKET	BY OTHERS													NOT SHOWN ON PLAN.	142
	143	1	CURVED LID DISPLAY FREEZER	EXCELLENCE IND	MB-2HCD	115	1	1		1/3	DR	5-15P						143
	144	1	SPARE NUMBER	CUSTOM														144
	145	2	FOOD TOPPING WARMER, COUNTERTOP	SERVER PRODUCTS	81195	120	1	4.3	0.517		DR	5-15P					WITH 94009 S/S JARS.	145
	146-159	1	SPARE NUMBER	CUSTOM														146-159
	160	1	FROZEN CUSTARD MACHINE	STOELTING	M202-209B0SIR	208-230	3	15.0		3	SP	1/2"		1-1/2"			REFRIGERATION INSTALLER TO PROVIDE QUICK DISCONNECT LINES.	160
	161	2	REMOTE CONDENSER UNIT	STOELTING	285091	208-230	3	15.0			JBH						REFER TO MANUFACTURER'S SHOP DRAWINGS FOR DETAILS.	161
	162	1	FROZEN CUSTARD DIPPING CABINET	C NELSON	BS2SE-RB	115	1	15.0			DR	5-15P						162
	163-169	1	SPARE NUMBER	CUSTOM														163-169
	170	1	SHAKE LEVEL TABLE	EAGLE GROUP	CUSTOM												ALL WELDED CONSTRUCTION AND TOP CUTOUT FOR ITEM 171.	170
	171	2	DIPPER WELL	T&S BRASS	B-2282-01								1/2"		1-1/2"		WITH FAUCET.	171
	172	1	DIPPING CABINET	RANDELL FOR SHAKE SHACK	69346A-SS44	115	1	6.5		1/3	DR	5-15P						172
	173	1	SHELVING, WALL-MOUNTED	EAGLE FOR SHAKE SHACK	WS1548-164												G.C. TO PROVIDE WALL BLOCKING.	173
	173A	1	CONDIMENT SHELF	EAGLE FOR SHAKE SHACK	YRHL-0026-00												G.C. TO PROVIDE WALL BLOCKING.	173A
	174	1	KDS SCREEN	BY OTHERS		120	1	15.0			DR	5-15P					ALL TRADES TO VERIFY UTILITY REQUIREMENTS.	174
	175	1	BRACKET	CDW	1711461/SHACK												NOT SHOWN ON PLAN, G.C. TO PROVIDE WALL BLOCKING.	175
	176	1	BRACKET, POWER CONDITION	EAGLE GROUP	YJ-2990-00												NOT SHOWN ON PLAN, BRACKETS FOR ITEM 174, G.C. TO PROVIDE WALL BLOCKING, NOT SHOWN ON PLAN.	176
	177	1	SHAKE TABLE W/ SINK	EAGLE FOR SHAKE SHACK	CUSTOM								1/2"	1/2"	2"		ALL S/S CONSTRUCTION L-SHAPED 11" X 42" X 30" DEEP W/ 10" X 14" X 9.5" DEEP INTEGRAL SINK W/ FAUCET W/ BASKET DRAIN, MARINE EDGES, BACK & LEFT SIDE SPLASH. P.C. TO INTERPIPE THIS CONNECTION FROM WATER FILTER, MOUNTED TO ITEM#177.	177
	177A	1	FAUCET	ELKAY FOODSERVICE	LK-1110								1/2"					177A
	178	1	WORK TABLE, STAINLESS STEEL TOP	EAGLE GROUP	CUSTOM													178
	178A	1	S/S UNDERCOUNTER WINE CABINET	EAGLE FOR SHAKE SHACK	FABRICATE													178A
	179-180	1	SPARE NUMBER	CUSTOM														179-180
	181	1	BEVERAGE DISPENSER, ELECTRIC (COLD)	GRINDMASTER-CECILWARE	C-15-16	120	1	4.0	0.46		DR	5-15P					WITH CUP ACTIVATED HANDLE OPTION AND 11161M MILK IMPELLER.	181
	182	3	MIXER, DRINK / BAR	HAMILTON BEACH	HMD400	120	1	0.9	(3) 1/3		DR	5-15P					ONE (1) BACKUP MIXER NOT SHOWN ON PLAN.	182
	183	1	SPARE NUMBER	CUSTOM														183
	184	1	MIXER, DRINK / BAR	HAMILTON BEACH	HMD900	120	1	5.2		3/4	DR	5-15P						184
	185	1	SPARE NUMBER	CUSTOM														185
	186	1	CUP & LID ORGANIZER	SAN JAMAR	C8503WF													186
	187	1	WIRE SHELVING CHROME	EAGLE FOR SHAKE SHACK	SHELVING UNIT												5-TIER UNITS, 54" POST, SIZES PER PLAN	187
	188	1	DISHWASHER, UNDERCOUNTER	ECOLAB	E-UHT	208	3	21.3		1	JBW		3/4"	1"			WITH BUILT IN HOT WATER BOOSTER.	188
	189-199	1	SPARE NUMBER	CUSTOM														189-199
	200	1	UNDERCOUNTER REFRIGERATOR	RANDELL	9404-290	115	1	2.4		1/4	DR	5-15P					WITH 3" CASTERS, DOOR HINGED RIGHT.	200
	201-202	1	SPARE NUMBER	CUSTOM														201-202
	203	1	ICE CHEST & SODA TOWER	BY OTHERS		120	1	15.0			SR	5-20P					ALL TRADES TO VERIFY UTILITY REQUIREMENTS.	203
	204	1	TEA BREWER	BY OTHERS		120	1	14.4	1.7		SR	5-20P	1/4"		3/4"		ALL TRADES TO VERIFY UTILITY REQUIREMENTS.	204
	205	1	SPARE NUMBER	CUSTOM														205
	206	1	BEVERAGE DISPENSER, ELECTRIC (COLD)	GRINDMASTER-CECILWARE	E49-3	120	1	6.0	0.66	1/5	DR	5-15P					WITH 3709 LOW FOAM IMPELLER AND 2266 CUP ACTIVATED HANDLE	206
	207	1	CUP & LID ORGANIZER	SAN JAMAR	C8503WF													207
	208	1	KDS SCREEN	BY OTHERS		120	1	15.0			DR	5-15P					ALL TRADES TO VERIFY UTILITY REQUIREMENTS.	208
	209	1	BRACKET	CDW	1711461/SHACK												NOT SHOWN ON PLAN, G.C. TO PROVIDE WALL BLOCKING.	209
	210	1	BRACKET, POWER CONDITION	EAGLE GROUP	YJ-2990-00												NOT SHOWN ON PLAN, BRACKETS FOR ITEM# 208, G.C. TO PROVIDE WALL BLOCKING, NOT SHOWN ON PLAN.	210
	211-219	1	SPARE NUMBER	CUSTOM														211-219
	220	1	FRONT COUNTER	EAGLE FOR SHAKE SHACK	FRONT COUNTER												S/S STEEL TOP	220
	221	2	P.O.S. TERMINALS	BY OTHERS		120	1	15.0			DR	5-20P					ALL TRADES TO VERIFY UTILITY REQUIREMENTS.	221
	221A	4	RISKY TERMINAL	BY OTHERS		120	1	15.0			DR	5-15P					ALL TRADES TO VERIFY UTILITY REQUIREMENTS.	221A
	222	1	BRACKET	CDW	851539												NOT SHOWN ON PLAN.	222
	223	1	3-FAUCET T-TOWER	CHILL-RITE	THT-3-S/S					1/3	SR	5-20P	1/2"		3/4"		THREE FAUCET WITH DRIP PAN.	223
	224	1	DRAFT BEER SYSTEM POWER PACK	CHILL-RITE	MLN-33	120	1	12.0										224
	223-226	1	SPARE NUMBER	CUSTOM														223-226
	226A	5	WIRE SHELVING CHROME	EAGLE FOR SHAKE SHACK	SHELVING UNIT												2-TIER UNITS WITH 33" POST, SIZES PER PLAN	226A
	227	1	SPARE NUMBER	CUSTOM														227
	228	2	SHELVING, WALL-MOUNTED	EAGLE FOR SHAKE SHACK	WS1548-164												G.C. TO PROVIDE WALL BLOCKING.	228
	228A	1	SHELVING, WALL-MOUNTED	EAGLE FOR SHAKE SHACK	WS1560-164												G.C. TO PROVIDE WALL BLOCKING.	228A
	229-230	1	SPARE NUMBER	CUSTOM														229-230
	231	6	5"X5"X3" CUSTOM PAN	EAGLE FOR SHAKE SHACK	YSHAKE-BIN-0002-00													231
	231A	3	5"X5															

FOR QUESTIONS, CALL THE
Eastern PA Mechanical
REGION 108
PHONE: (267) 504-4126
EMAIL: reg108@captiveaire.com

HOOD INFORMATION - JOB#5505815

HOOD NO	TAG	MODEL	MANUFACTURER	LENGTH	MAX COOKING TEMP	TYPE	APPLIANCE DUTY	DESIGN CFM/FT	TOTAL EXH CFM	EXHAUST PLENUM				MJA CFM	AC CFM	HOOD CONSTRUCTION	HOOD CONFIG			
										WIDTH	LENG	HEIGHT	DIA				CFM	VEL	SP	END TO END
1	Hood 1	S430 ND-2-ACPSP-F	CAPTIVEAIRE	7' 10"	600 DEG	I	HEAVY	175	1371	10'	13'	4'	1371	1519	-0.515'	1275	400	430 SS WHERE EXPOSED	LEFT	ALONE
2	Hood 2	S430 ND-2-ACPSP-F	CAPTIVEAIRE	7' 10"	600 DEG	I	HEAVY	175	1371	10'	13'	4'	1371	1519	-0.515'	919	400	430 SS WHERE EXPOSED	RIGHT	ALONE

HOOD INFORMATION




HOOD NO	TAG	FILTER(S)				LIGHT(S)			UTILITY CABINET(S)				FIRE SYSTEM PIPING	HOOD HANGING WEIGHT		
		TYPE	QTY	HEIGHT	LENGTH	EFFICIENCY @ 7 MICRONS	QTY	TYPE	WIRE GUARD	LOCATION	SIZE	FIRE SYSTEM TYPE			SIZE	ELECTRICAL MODEL #
1	Hood 1	CAPTRATE SLDL FILTER	5	20"	16"	85% SEE FILTER SPEC	3	RECESSED ROUND	NO	LEFT	20"x54"x30"	TANK FS	4.0/4.0/4.0		YES	1041 LBS
2	Hood 2	CAPTRATE SLDL FILTER	5	20"	16"	85% SEE FILTER SPEC	3	RECESSED ROUND	NO	WALL MNT	12"x36"x24"	PCU TANK	4.0/4.0		YES	554 LBS

HOOD OPTIONS

HOOD NO	TAG	OPTION
1	Hood 1	FIELD WRAPPER 18.00" HIGH FRONT, LEFT. BALANCE DAMPERS. RISER SENSOR INSTALL 6IN PLEN. LEFT WIDE VERTICAL END PANEL 42" TOP WIDTH, 36" BOTTOM WIDTH, 80" HIGH INSULATED 430 SS.
2	Hood 2	FIELD WRAPPER 18.00" HIGH FRONT, RIGHT. RIGHT END STANDOFF (FINISHED) 1" WIDE 54" LONG INSULATED. BALANCE DAMPERS. RISER SENSOR INSTALL 6IN PLEN. RIGHT WALL AS END PANEL.

PERFORATED SUPPLY PLENUM(S)

HOOD NO	TAG	POS	LENGTH	WIDTH	HEIGHT	RISER(S)				
						TYPE	WIDTH	LENG	DIA	CFM
1	Hood 1	Front	114'	22'	6'	MJA	10"	28"	637	0.160"
						MJA	10"	28"	637	0.160"
						AC	8"	100	0.032"	
						AC	8"	100	0.032"	
						AC	8"	100	0.032"	
2	Hood 2	Front	95'	22'	6'	MJA	10"	28"	459	0.101"
						MJA	10"	28"	459	0.101"
						AC	8"	100	0.032"	
						AC	8"	100	0.032"	
						AC	8"	100	0.032"	

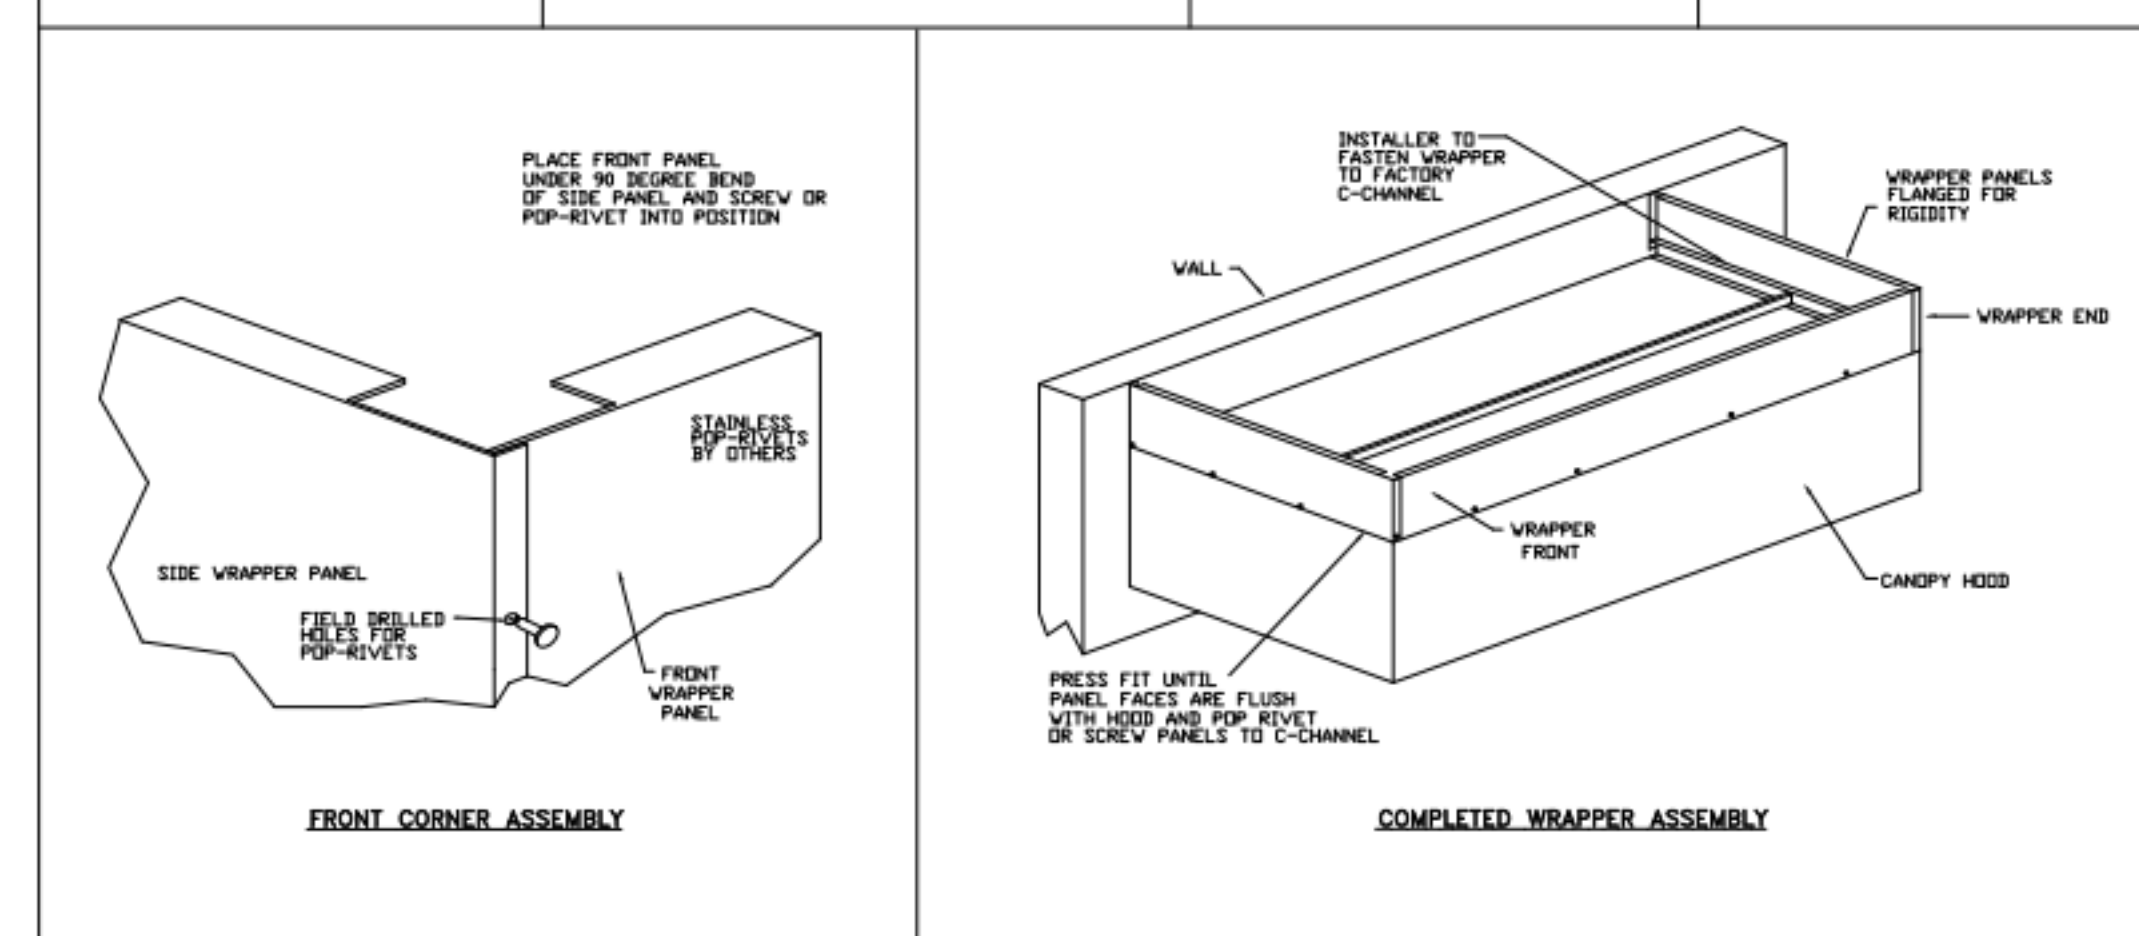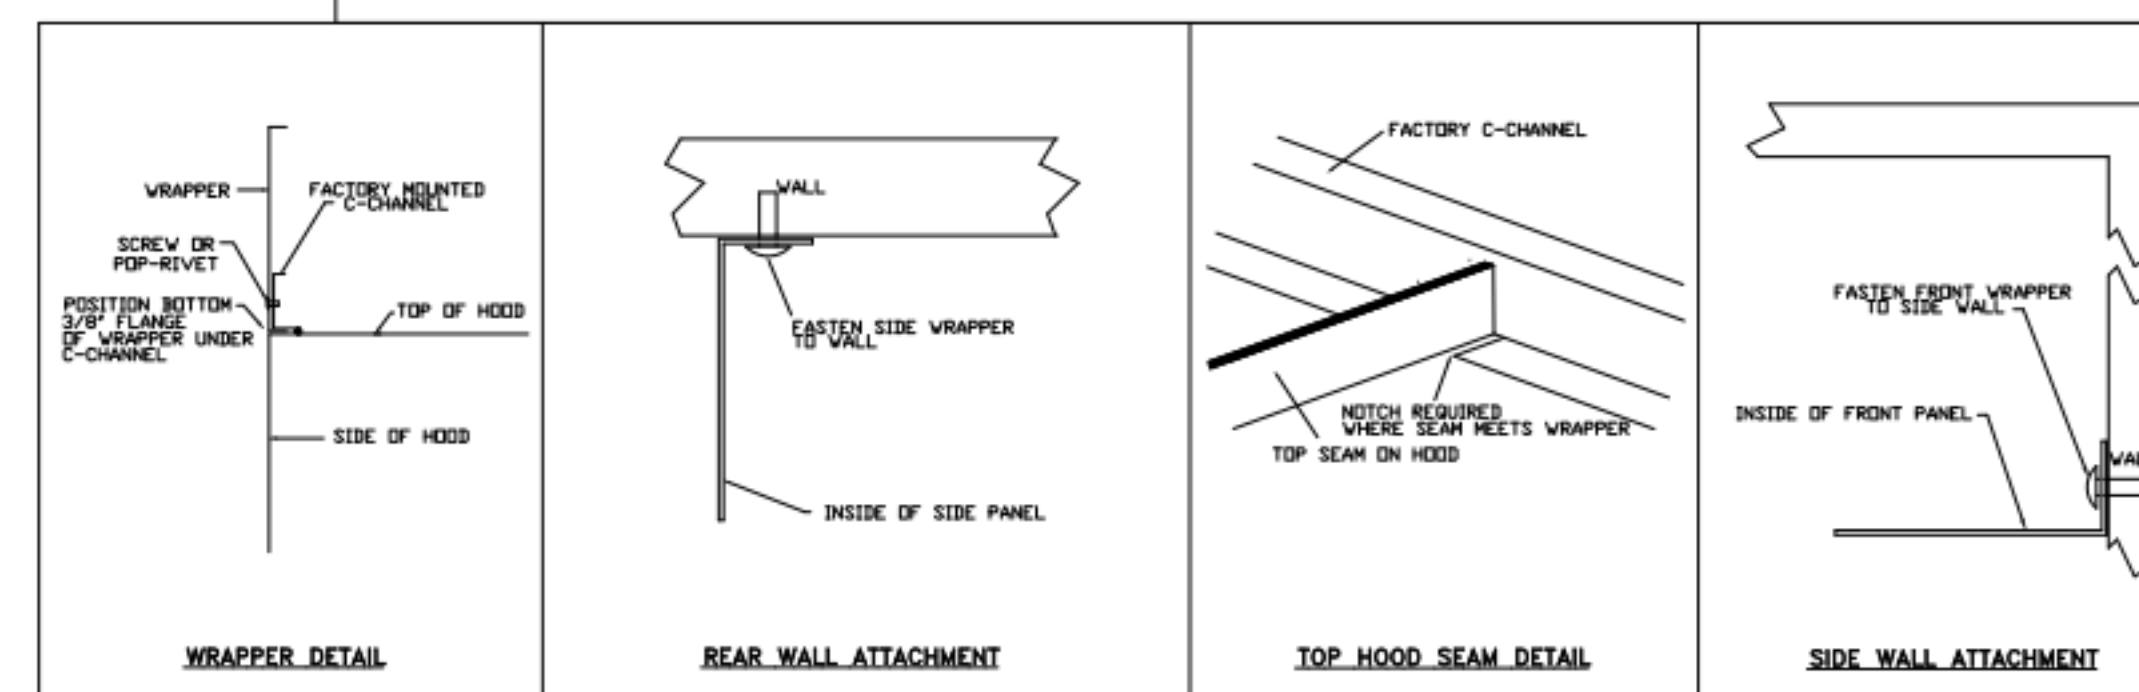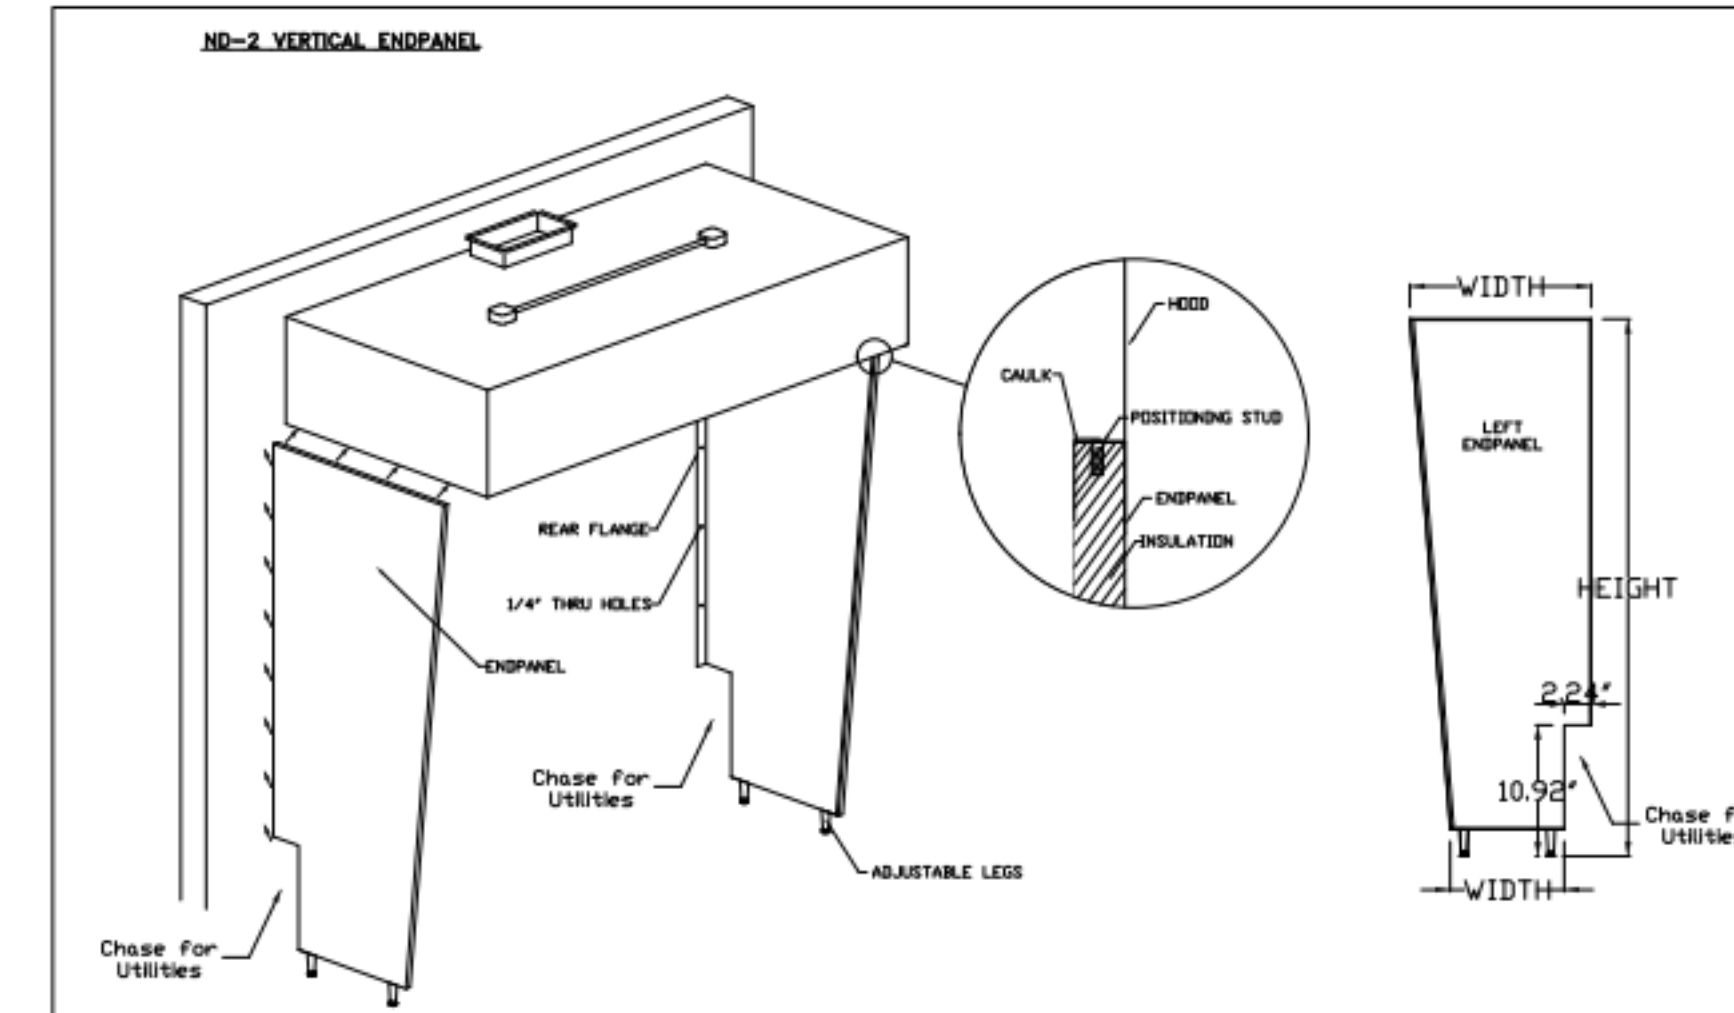

LISTINGS & CERTIFICATIONS

CAPTIVEAIRE HOODS BUILT IN COMPLIANCE WITH:
ETL LISTED
UL STANDARD 710
Intertek
BUILT TO ACCORDANCE WITH NFPA
Listed under ETL File number: 3054804-001/002

CLEARANCE TO COMBUSTIBLES

CAPTIVEAIRE HOODS HAVE OPTIONAL CLEARANCE REDUCTION SYSTEMS AVAILABLE AS FOLLOWS:
MATERIAL CLEARANCE REDUCTION SYSTEM
NON-COMBUSTIBLE NONE REQUIRED
LIMITED-COMBUSTIBLE 3" UNINSULATED STANDOFF
COMBUSTIBLE 1" INSULATED STANDOFF

GENERAL NOTES


- INSTALLATION**
- ALL ELECTRICAL "FIELD" CONNECTIONS AND RELATED INTERCONNECTIONS BY ELECTRICAL CONTRACTORS.
 - ALL PLUMBING "FIELD" CONNECTIONS AND RELATED INTERCONNECTIONS BY PLUMBING CONTRACTORS.
 - HANGING BRACKETS LOCATED AND WELDED AS SHOWN ON PLANS. ALL OTHER HANGER MATERIALS PROVIDED BY INSTALLING CONTRACTORS.
 - ALL CONNECTIONS FROM CAPTIVEAIRE HOOD PER MECHANICAL PLANS.
 - COOKING EQUIPMENT TO SHUT OFF IN EVENT OF FIRE.
 - EXHAUST FANS TO TURN ON IN EVENT OF FIRE.
 - ALL LIGHT FIXTURES SHOWN INSTALLED BY CAPTIVEAIRE ARE FACTORY PREWIRED INTERCONNECTIONS BETWEEN HOODS AND TO SWITCHES ARE BY ELECTRICAL CONTRACTOR.
 - SEISMIC RESTRAINTS ARE RESPONSIBILITY OF INSTALLING CONTRACTOR.
 - INSTALLING CONTRACTORS ASSUME ALL RELATED RESPONSIBILITY FOR VERIFICATION OF DIMENSIONAL DATA CONTAINED ON THESE DOCUMENTS FOR ACCURACY, INTEGRATION, AND ADMINISTRATION OF CODE REQUIREMENTS IN EFFECT PRIOR TO ANY RELEASE FOR PRODUCTION OF EQUIPMENT SHOWN.

- BALANCE**
- KITCHEN HOODS MUST BE BALANCED WITH KITCHEN.
 - KITCHEN SHALL BE NEGATIVE WITH RESPECT TO DINING AREA.
 - RESTAURANT SHALL BE POSITIVE WITH RESPECT TO AMBIENT PRESSURE.

- ADDITIONAL**
- WRITTEN HOOD DIMENSIONS HAVE PRECEDENCE OVER SCALE.
 - SIGNED AND "APPROVED" COPIES OF THIS DOCUMENT MUST BE OBTAINED BY THE FACTORY PRIOR TO COMMENCEMENT OF FABRICATION.

HVAC DISTRIBUTION NOTE

IT IS RECOMMENDED NOT TO INSTALL HIGH VELOCITY DIFFUSERS OR HVAC RETURNS WITHIN TEN (10) FEET OF THE EXHAUST HOOD. PERFORATED, LOW-VELOCITY, NON-DIRECTIONAL DIFFUSERS ARE RECOMMENDED.

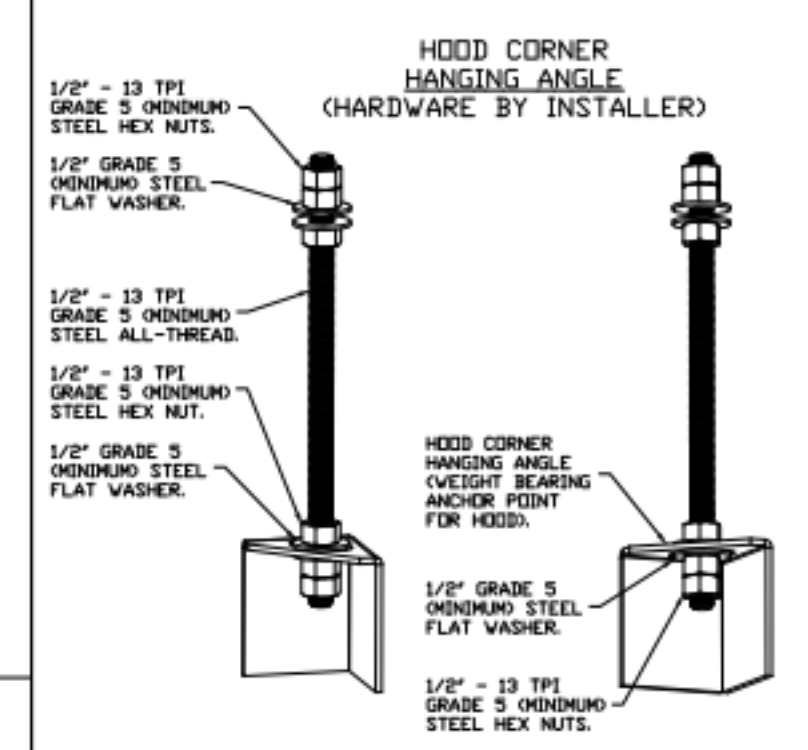

ASSEMBLY INSTRUCTIONS

HANGING ANGLE MUST BE SUPPORTED WITH 1/2" - 13 TPI GRADE 5 (MINIMUM) ALL-THREAD. SANDWICH HANGING ANGLES AND CEILING ANCHOR POINTS WITH 1/2" GRADE 5 (MINIMUM) STEEL FLAT WASHERS AND 1/2" - 13 TPI GRADE 5 (MINIMUM) HEX NUTS AS SHOWN. MUST USE DOUBLED HEX NUT CONFIGURATION BENEATH HOOD HANGING ANGLES AND ABOVE CEILING ANCHORS. MAINTAIN 1/4" OF EXPOSED THREADS BENEATH BOTTOM HEX NUT. TORQUE ALL HEX NUTS TO 57 FT-LBS.

VERIFY CEILING HEIGHT

HEIGHT REQUIRED TO VERIFY THAT HOOD FITS SPACE AND TO SIZE THE ENCLOSURE PANELS

REVISIONS

NO.	DESCRIPTION	DATE



Shake Shack-1398-Korea Town-R3
LOS ANGELES, CA, 90010

DATE: 6/9/2022

DWG.#: 5505815

DRAWN BY: EB-108

SCALE:

MASTER DRAWING

SHEET NO. 1

zebra
ZEBRA PROJECTS, INC.
14814 N KIERLAND BLVD, SUITE N 300
SCOTTSDALE, ARIZONA 85254
PHONE: 480.912.1169 www.zbr.co.uk

INFRASTRUCTURE FACTOR CONSULTING, INC.
2361 Rosecrans Ave. Suite 368, El Segundo, CA 90245
P. 310.725.1500 F. 310.725.0215 www.Factor.com

STORE NO: CA #1398

SHAKE SHACK
SHAKE SHACK - KOREA TOWN
3786 WILSHIRE BLVD. LOS ANGELES, CA 90010

REVISION

NO.	DATE	DESCRIPTION
1	11/08/21	PERMIT/BID SET
A	01/26/22	REVISION A
1	07/01/22	REVISION 1
4	09/16/22	REVISION 4

STATUS: PERMIT/BID SET

PRELIMINARY: Preliminary Documents Are For Design Review only and not intended for bidding, permitting, or construction purposes. They were prepared by or under the supervision of Zebra Projects, Inc.



FIELD VERIFICATION: The contractor shall verify all signed dimensions and location at the project site and notify Zebra Projects, Inc. of any dimensional errors, or omissions or discrepancies, before beginning or resuming any work. Do not make these corrections.


COPYRIGHT © 2021: Zebra Projects, Inc. shall retain all common law, statutory, and all other reserved rights. Neither the documents nor the information herein is to be reproduced, distributed, reflected or otherwise without the written consent of Zebra Projects, Inc.

SHEET NAME: CAPTIVEAIRE DRAWINGS


DATE: 11/08/21 PROJECT NO: SHK-21-008

DRAWN: SCALE: NTS

SHEET NO: M801

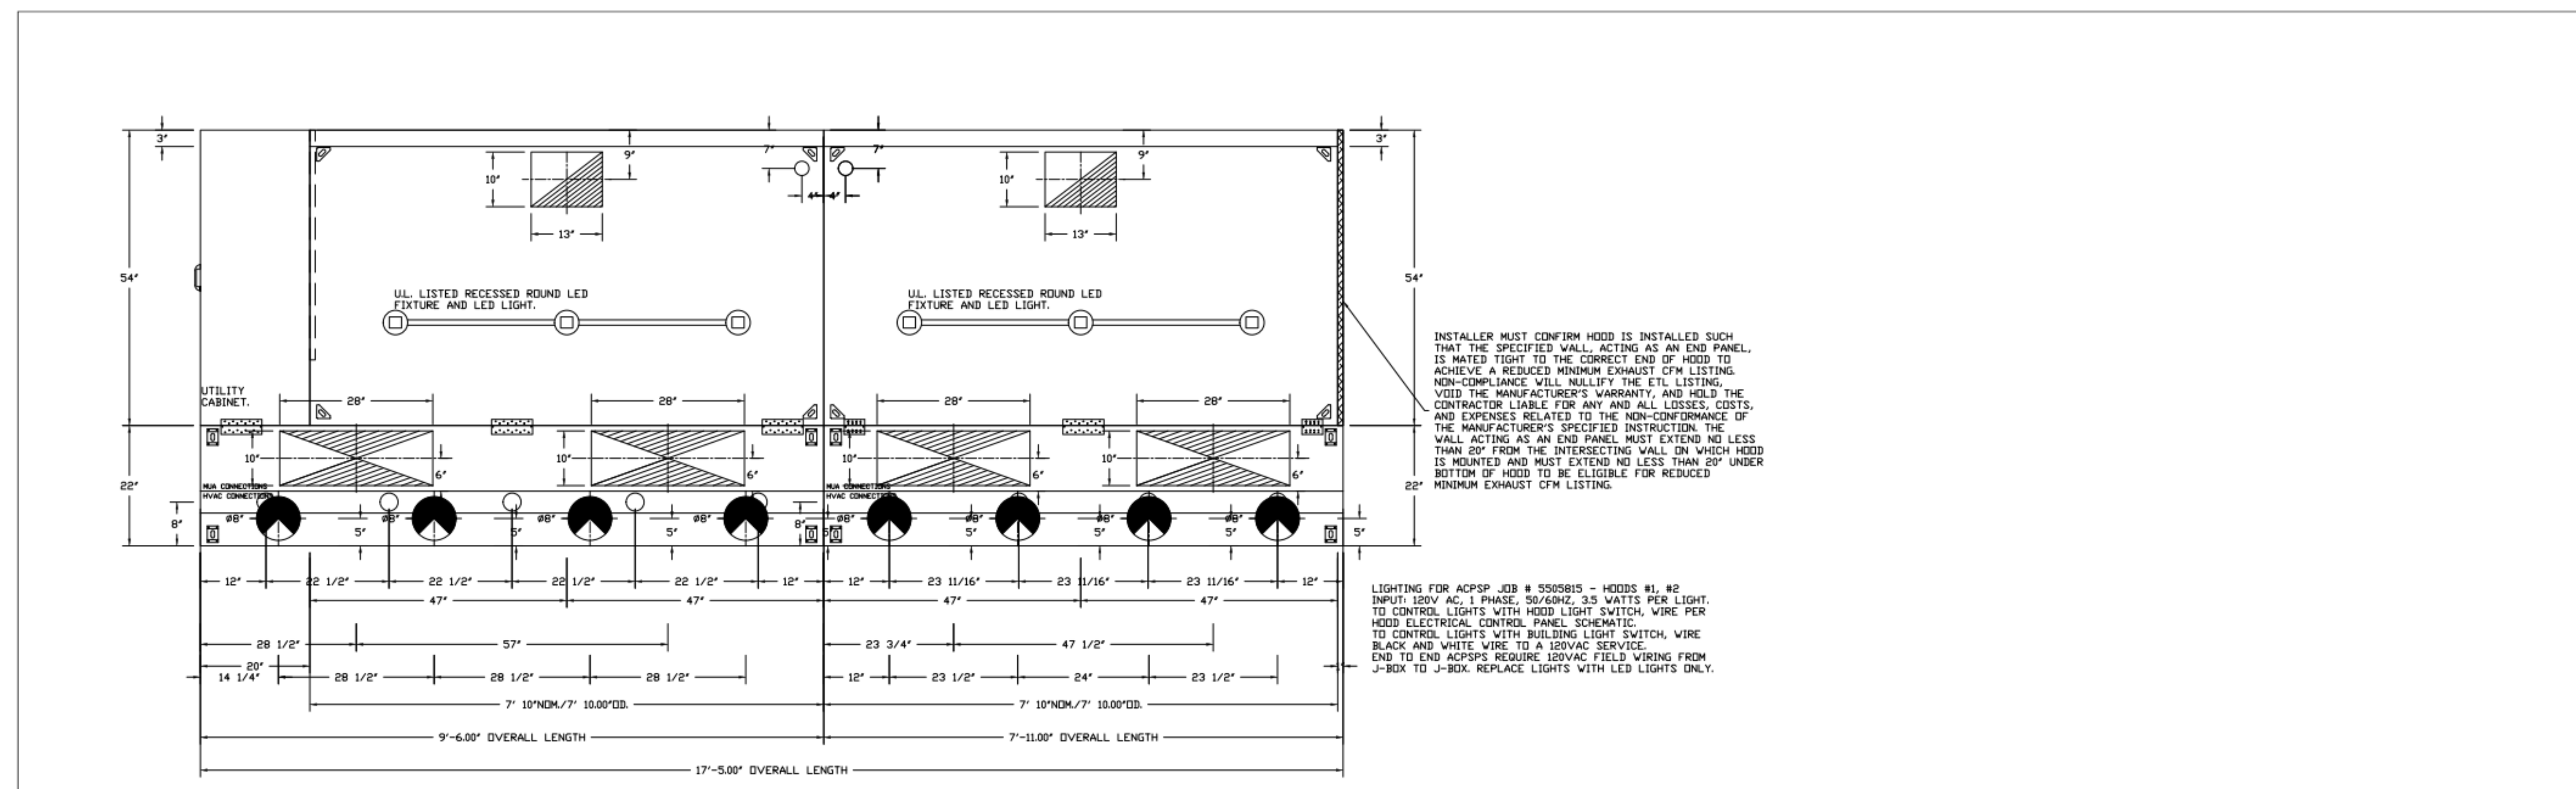

PLAN VIEW - HOOD #1 (Hood 1)
 7' 10.00\"/>

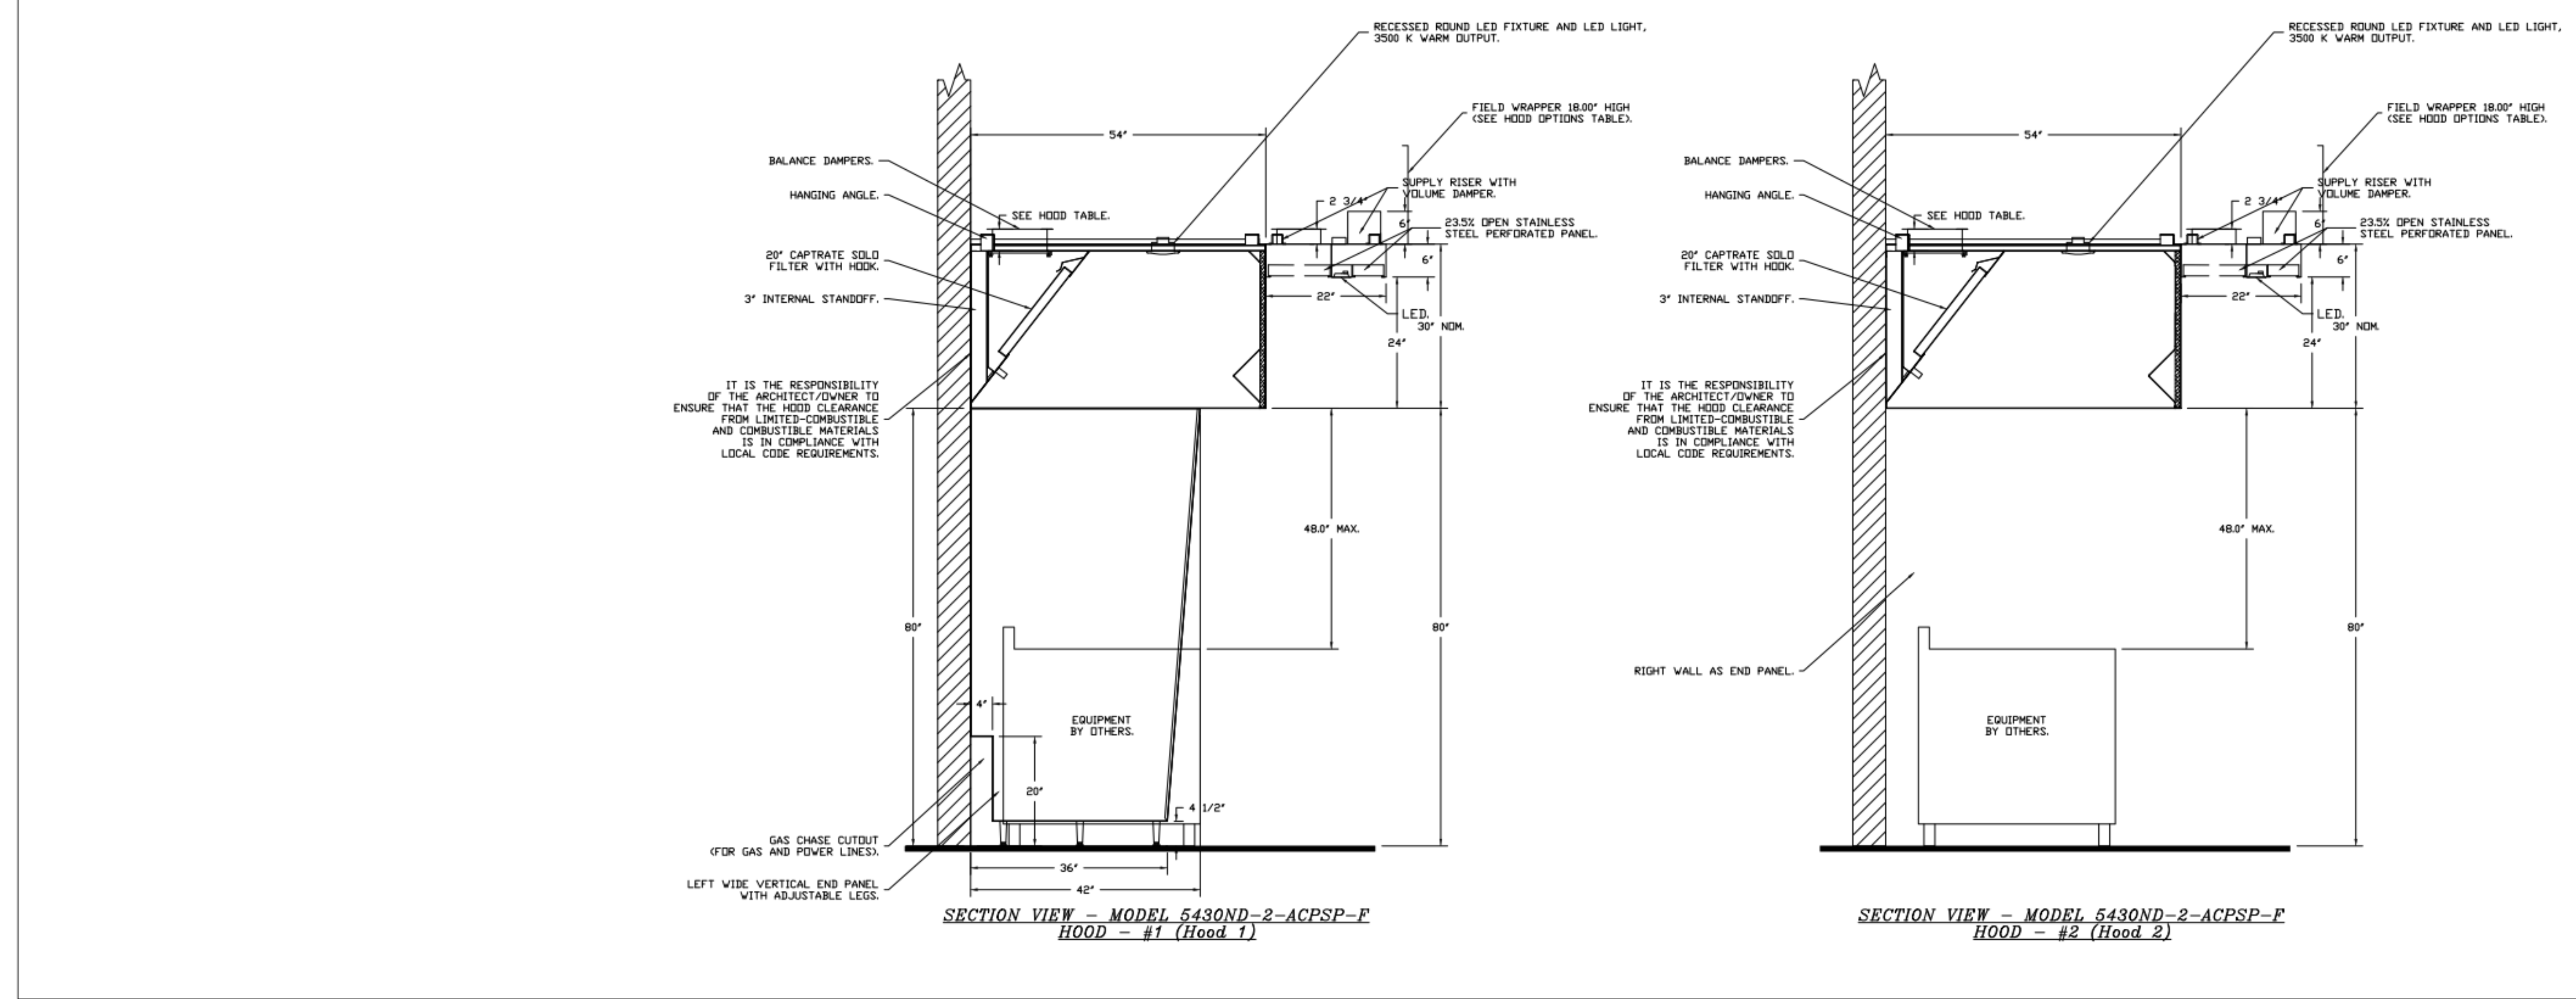

SECTION VIEW - MODEL 5430ND-2-ACPSP-F
 HOOD - #1 (Hood 1)

REVISIONS

NO.	DESCRIPTION	DATE

CAPTIVE
 Eastern PA Mechanical
 PO Box 2520, 1 Union Ave. Bala Cynwyd, PA, 19004 PHONE: (267) 504-4198 EMAIL: reg108@captiveaire.com www.captiveaire.com

Shake Shack-1398-Korea Town-R3
 LOS ANGELES, CA, 90010

DATE: 6/9/2022
DWG.#: 5505815
DRAWN BY: EB-108
SCALE:
MASTER DRAWING

SHEET NO.
 2

STORE NO:
 CA #1398

SHAKE SHACK
 SHAKE SHACK - KOREATOWN
 3786 WILSHIRE BLVD. LOS ANGELES, CA 90010

REVISION

NO.	DATE	DESCRIPTION
1	11/08/21	PERMIT/BID SET
A	01/26/22	REVISION A
1	07/01/22	REVISION 1
4	09/16/22	REVISION 4

STATUS:
 PERMIT/BID SET

PRELIMINARY:
 Primary Documents Are for Design Review only and not intended for construction. No field changes, modifications, or substitutions are permitted without the written consent of Zebra Projects, Inc.

REGISTERED PROFESSIONAL ENGINEER
 M38244
 EDWARD J. HANCOCK
 STATE OF CALIFORNIA

FIELD VERIFICATION:
 The contractor shall verify all signed dimensions and conditions at the project site and notify Zebra Projects, Inc. of any dimensional errors, or omissions or discrepancies before beginning or fabricating any work. Do not scale these drawings.

COPYRIGHT © 2021:
 Zebra Projects, Inc. shall retain all common law, statutory and all other reserved rights. Neither the documents nor the information herein is to be reproduced, distributed, disclosed or otherwise used without the written consent of Zebra Projects, Inc.

SHEET NAME:
CAPTIVEAIRE DRAWINGS

DATE:
 11/08/21

PROJECT NO:
 SHK-21-008

DRAWN:
 SCALE:
 NTS

SHEET NO:
M802

FIRE SYSTEM INFORMATION - JOB#5505815

FIRE SYSTEM NO	TAG	TYPE	SIZE	FLOW POINTS	INSTALLATION	
					SYSTEM	LOCATION ON HOOD
1		TANK FS	4.0/4.0/4.0	56	FIRE CABINET LEFT	LEFT, HOOD 1
2		PCU TANK	4.0/4.0	24	WALL UTILITY CABINET LEFT	N/A



GAS VALVE(S)

FIRE SYSTEM NO	TAG	TYPE	SIZE	SUPPLIED BY
1		SC ELECTRICAL	VERIFY	CAPTIVEAIRE SYSTEMS

WALL-MOUNT UTILITY CABINET

HOOD NO	LOCATION	SIZE	UTILITY CABINET(S)				WEIGHT
			FIRE SYSTEM	ELECTRICAL	SWITCHES		
1	WALL MNT	12"x36"x24"	PCU TANK	4.0/4.0			300.00 LBS

- SYSTEM REQUIRES A MINIMUM OF 7 FT OF EQUIVALENT PIPE LENGTH BETWEEN TANK AND NEAREST APPLIANCE NOZZLE FOR MOST APPLIANCES. EACH 90 DEGREE ELBOW ADDS 1.2 FT OF EQUIVALENT LENGTH. SEE MANUAL FOR DETAILS

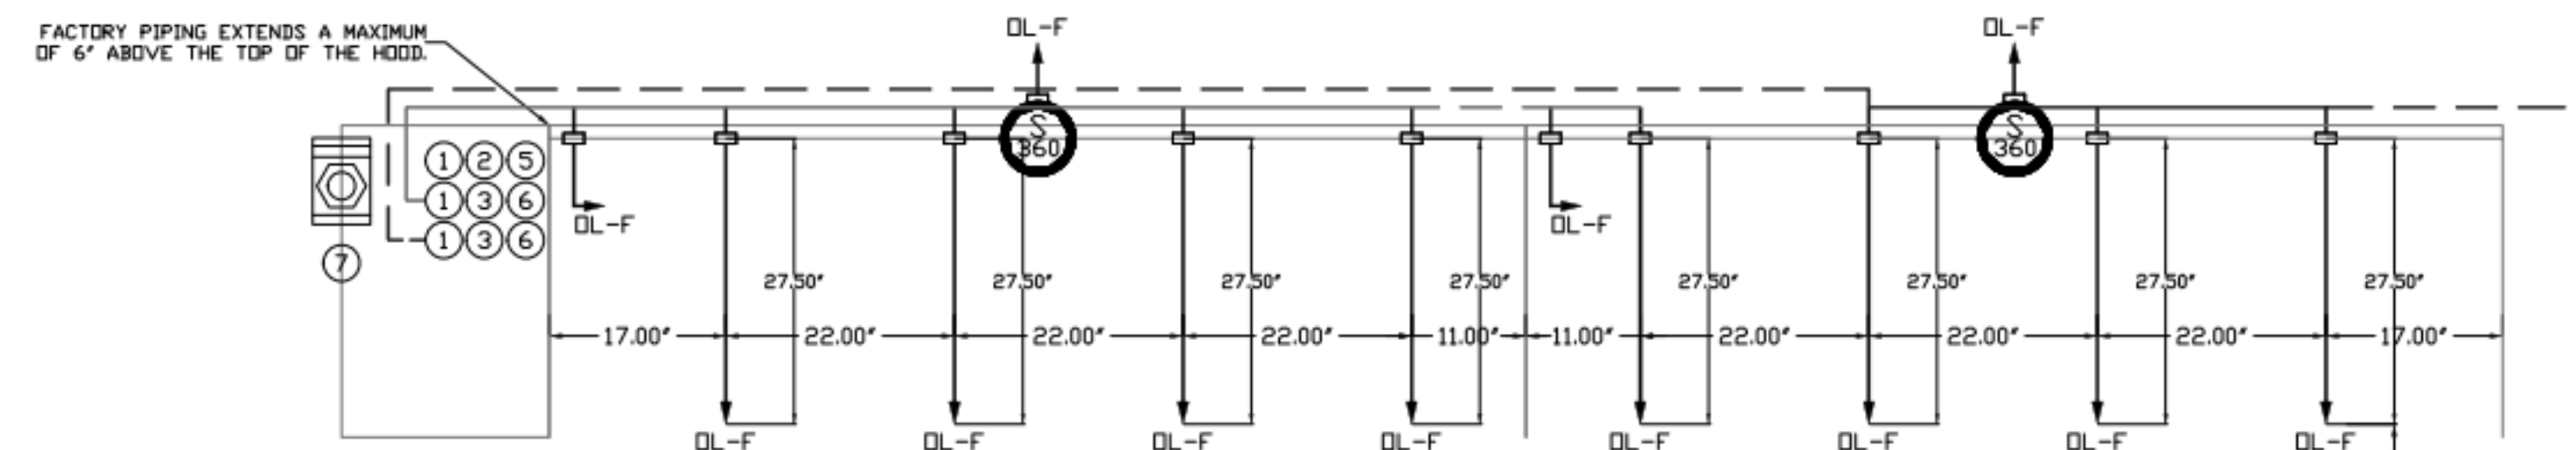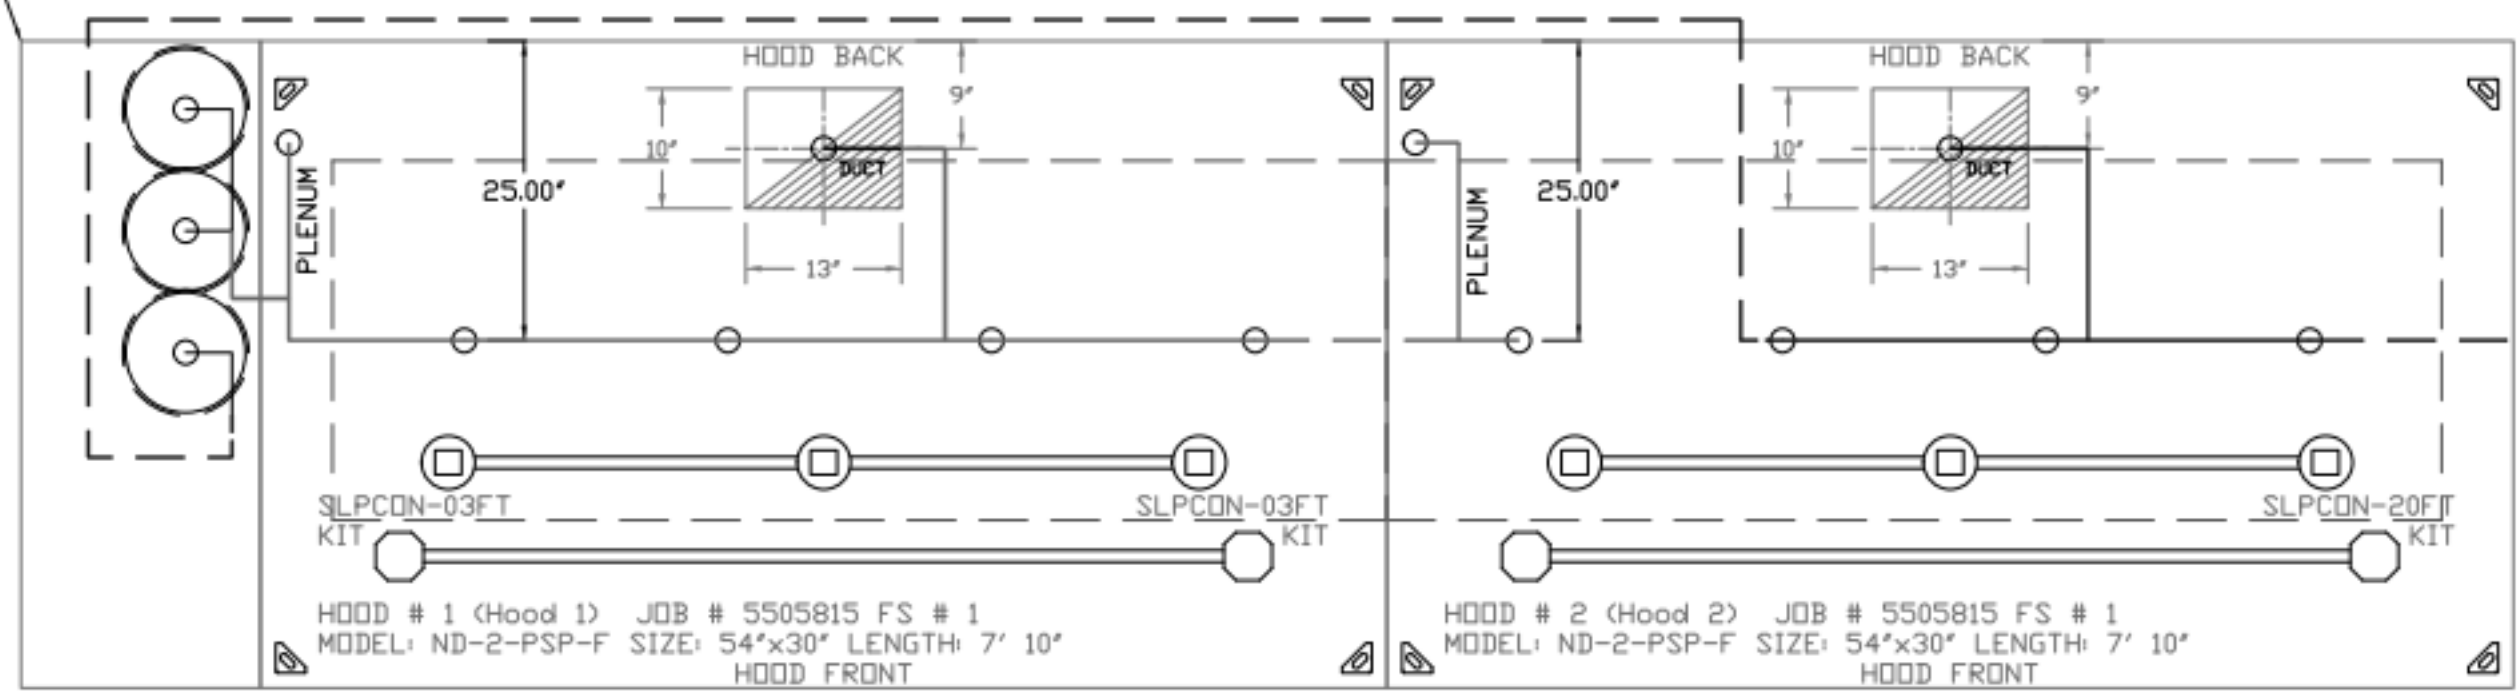

- NOTES**
- FIELD PIPE DROPS AS SHOWN
 - PIPING, ELBOWS, TEES, AND NOZZLES SUPPLIED BY CAS.
 - FIELD INSTALLED DROP: FACTORY WILL PROVIDE QTY 2 60IN LONG PIECES OF CHROME PLATED PIPING SHIPPED LOOSE TO BE FIELD-INSTALLED.
 - SHIP LOOSE DROP: FACTORY WILL PROVIDE THE EXACT CHROME PIPE LENGTH NEEDED SHIPPED LOOSE TO BE FIELD-INSTALLED.
 - RELOCATE NOZZLES IF FLOW PATTERN IS BLOCKED BY SHELVEING, SALAMANDERS, ETC.
 - OVERLAPPING COVERAGE SHALL NOT BE USED ON ANY APPLIANCE WITH AN OBSTRUCTION.
 - IF APPLICABLE, EXTENDED PRE-PIPED DROPS ARE SHIPPED LOOSE.
 - FACTORY PIPING EXTENDS A MAXIMUM OF 6" ABOVE THE TOP OF THE HOOD.

- APPLIANCE DIMENSIONS LISTED REPRESENT THE COOKING SURFACE SIZE, NOT THE OVERALL APPLIANCE SIZE.
- THIS FIRE SYSTEM COMPLIES WITH UL 300 REQUIREMENTS.
- DL-F NOZZLE PART NUMBER REPLACES 3070-3/8H-10-SS

JOB #: 5505815.
 JOB NAME: SHAKE SHACK-1398-KOREA TOWN-R3.

SYSTEM SIZE: TANK-SP-3 TOTAL FP REQUIRED: 56.
 HOOD # 1 7' 10.00" LONG x 54" WIDE x 30" HIGH.
 RISER # 1 SIZE: 10" x 13".
 HOOD # 1 METAL BLOW-OFF CAPS INCLUDED.
 HOOD # 2 7' 10.00" LONG x 54" WIDE x 30" HIGH.
 RISER # 2 SIZE: 10" x 13".
 HOOD # 2 METAL BLOW-OFF CAPS INCLUDED.


- HEAVY-DUTY APPLIANCES (RATED 600°F) WILL REQUIRE AN ADDITIONAL DOWNSTREAM FIRESTAT IN THE EVENT THAT THE DUCTWORK CONTAINS ANY HORIZONTAL RUNS OVER 25 FT IN LENGTH.
- MEDIUM TO LIGHT-DUTY APPLIANCES (RATED 450°F) WILL NOT REQUIRE ANY ADDITIONAL DOWNSTREAM DETECTION.

LEGEND - FIRE CABINET TANK SYSTEM

- 4 GALLON TANK.
- PRIMARY ACTUATOR RELEASE.
- SECONDARY ACTUATOR RELEASE.
- PRESSURE SUPERVISION SWITCH.
- PRIMARY HOSE ASSEMBLY.
- SECONDARY HOSE ASSEMBLY.
- REMOTE MANUAL ACTUATION DEVICE.

REVISIONS

NO.	DESCRIPTION	DATE

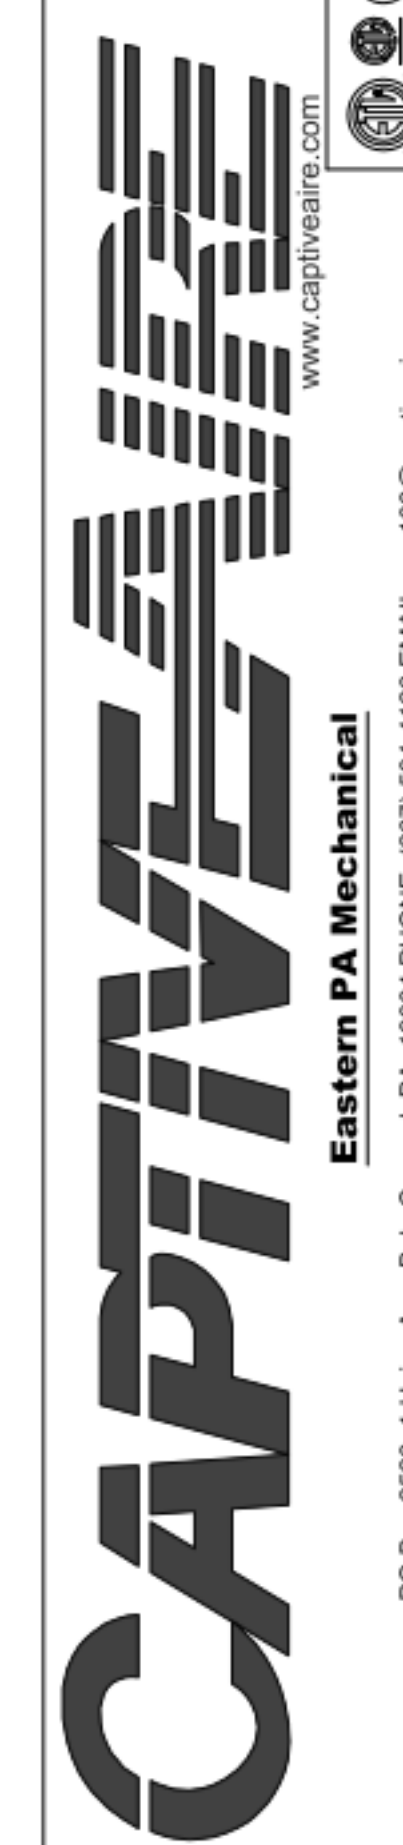

Shake Shack-1398-Korea Town-R3
 LOS ANGELES, CA, 90010

DATE: 6/9/2022
DWG.#: 5505815
DRAWN BY: EB-108
SCALE:
MASTER DRAWING
SHEET NO. 3

STORE NO: CA #1398



REVISION

NO.	DATE	DESCRIPTION

STATUS: PERMIT/BID SET

PRELIMINARY: Preliminary Documents Are for Design Review only and not intended for bidding, permitting, or construction purposes. They were prepared by or under the supervision of Zebra Projects, Inc.



FIELD VERIFICATION: The contractor shall verify all signed dimensions and conditions at the project site and notify Zebra Projects, Inc. of any dimensional errors, or omissions or discrepancies, before beginning or fabricating any work. Do not scale these drawings.
 COPYRIGHT © 2021: Zebra Projects, Inc. shall retain all common law, statutory and all other reserved rights. Neither the documents nor the information herein is to be reproduced, distributed, disclosed or otherwise without the written consent of Zebra Projects, Inc.

SHEET NAME: CAPTIVEAIRE DRAWINGS


DATE: 11/08/21 PROJECT NO: SHK-21-008

DRAWN: SCALE: NTS

SHEET NO: **M803**

POLLUTION CONTROL UNIT FIRE SYSTEM
 FAN #1 SIF2000-HESS-10.762 - EXHAUST FAN (ESP-1) - POLLUTION CONTROL UNIT WITH FIRE SYSTEM INSTALLED. INCLUDES STEEL PRE-FILTER MODULE, DUAL ESP MODULES, AND ODOR CONTROL MODULE PREPIPED WITH DOWNSTREAM PROTECTION. ELECTRIC FIRE DETECTOR AND NOZZLES ARE INCLUDED.



NOTE:
 DUCTWORK NOZZLE PART # DL-W

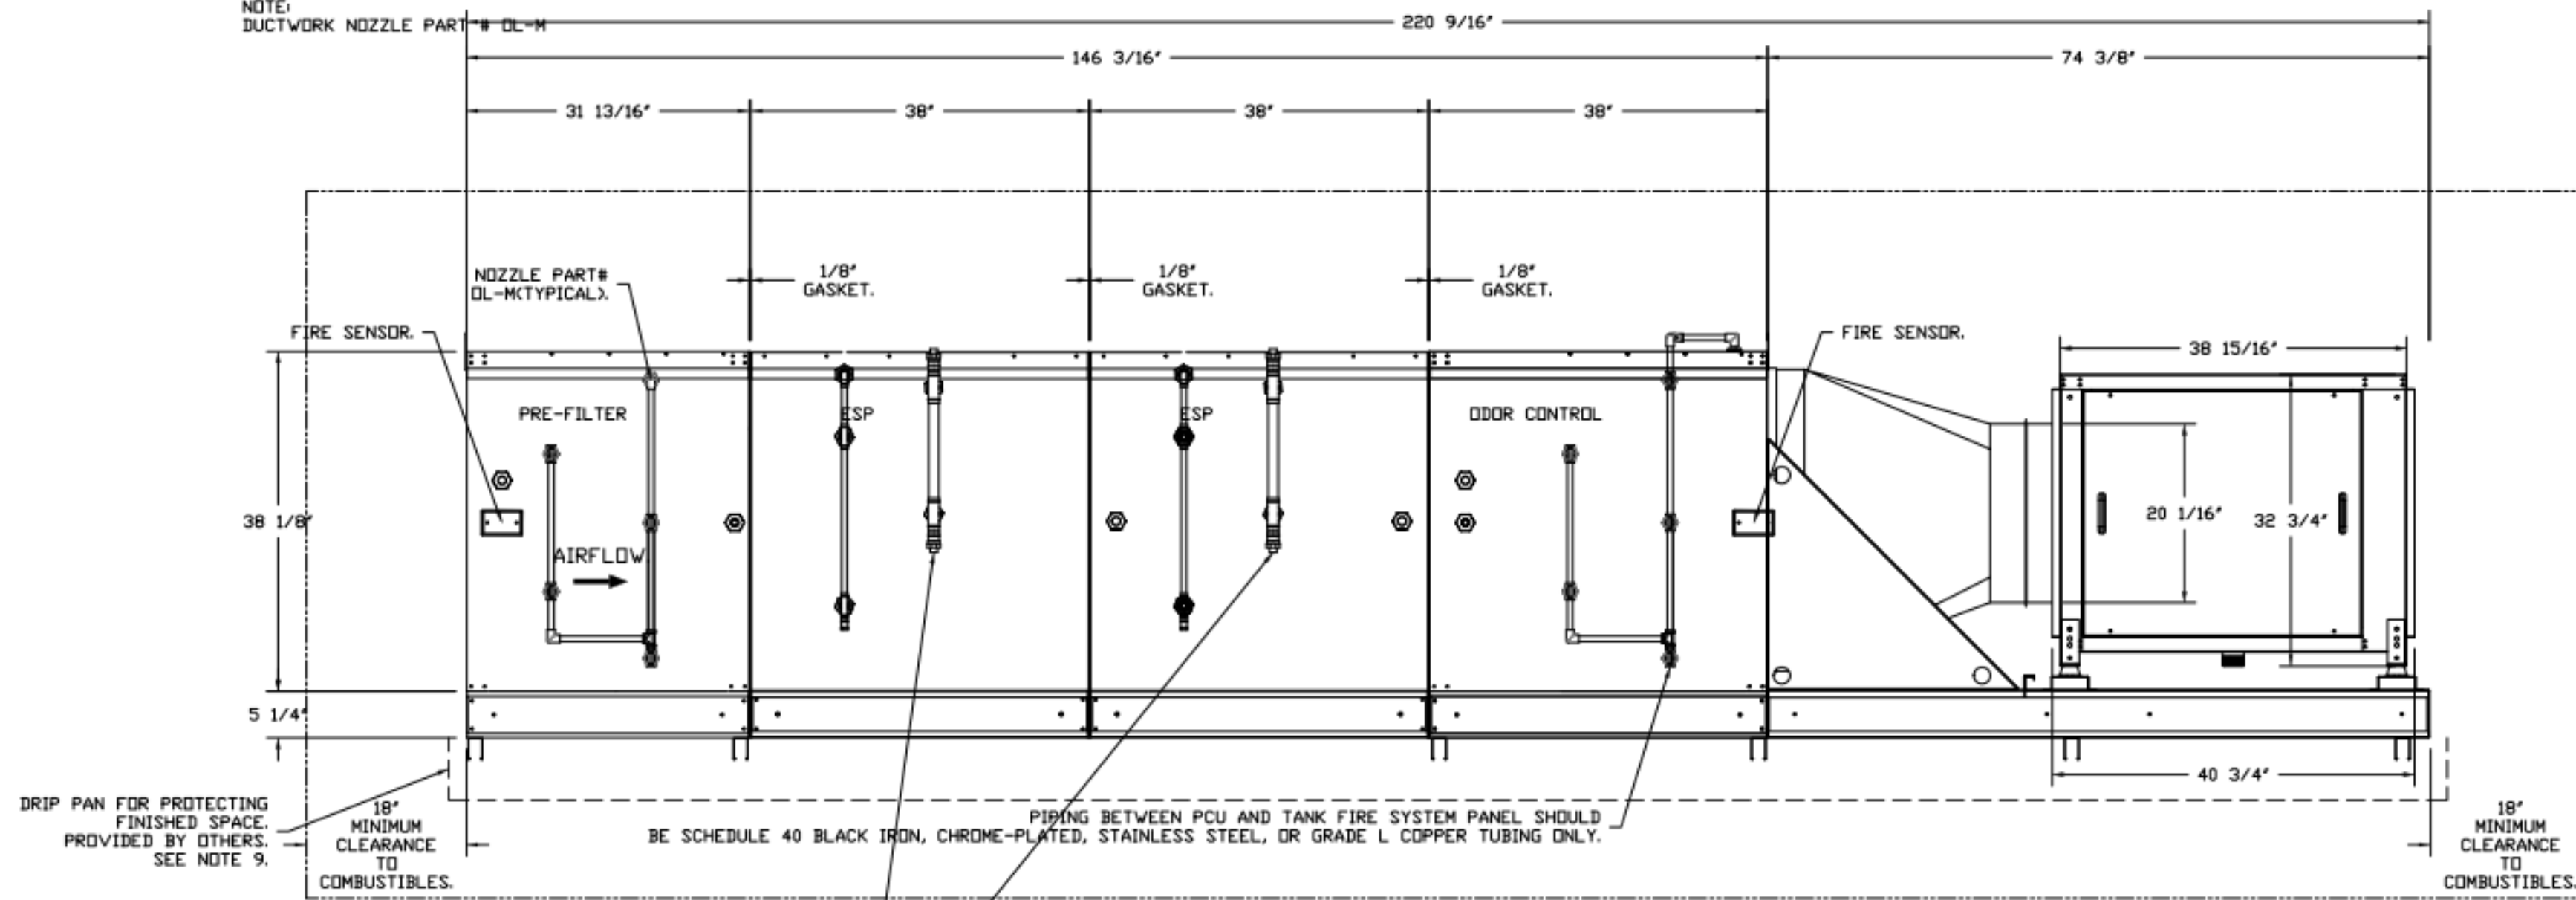

HOT WATER INLET CONNECTION:
 1" NPT FEMALE
 100 PSI MAXIMUM OPERATING PRESSURE
 20 PSI MINIMUM OPERATING PRESSURE
 140 - 170 DEG F
 15.19 GPM MINIMUM WASH ZONE L

NOTE: IF THE PCU IS MOUNTED OUTDOORS, HEAT TAPE MUST BE APPLIED TO ALL EXTERNAL PIPING FOR THE ESP SELF-CLEANING SYSTEM

WALL-MOUNT UTILITY CABINET ASSEMBLY INSTRUCTIONS
 HANGING ANGLE MUST BE SUPPORTED WITH 1/2" - 13 TPI GRADE 5 (MINIMUM) ALL-THREAD, SANDWICH HANGING ANGLES AND CEILING ANCHOR POINTS WITH 1/2" GRADE 5 (MINIMUM) STEEL FLAT WASHERS AND 1/2" - 13 TPI GRADE 5 (MINIMUM) HEX NUTS AS SHOWN. MUST USE DOUBLED HEX NUT CONFIGURATION BENEATH UTILITY CABINET HANGING ANGLES AND ABOVE CEILING ANCHORS. MAINTAIN 1/4" OF EXPOSED THREADS BENEATH BOTTOM HEX NUT. TORQUE ALL HEX NUTS TO 57 FT-LBS.

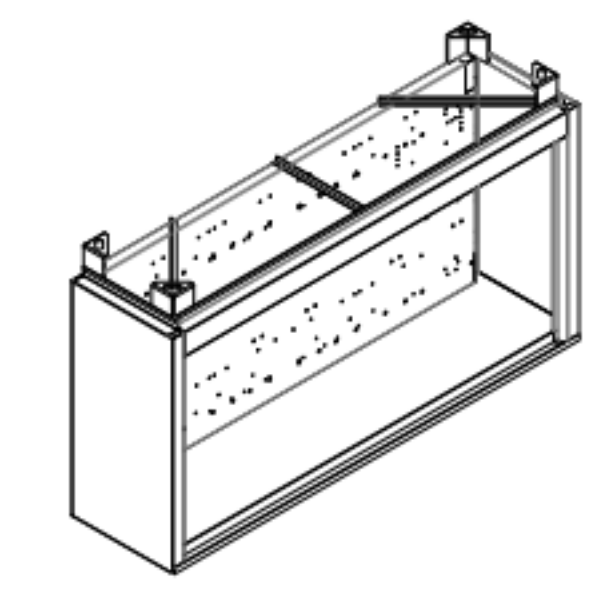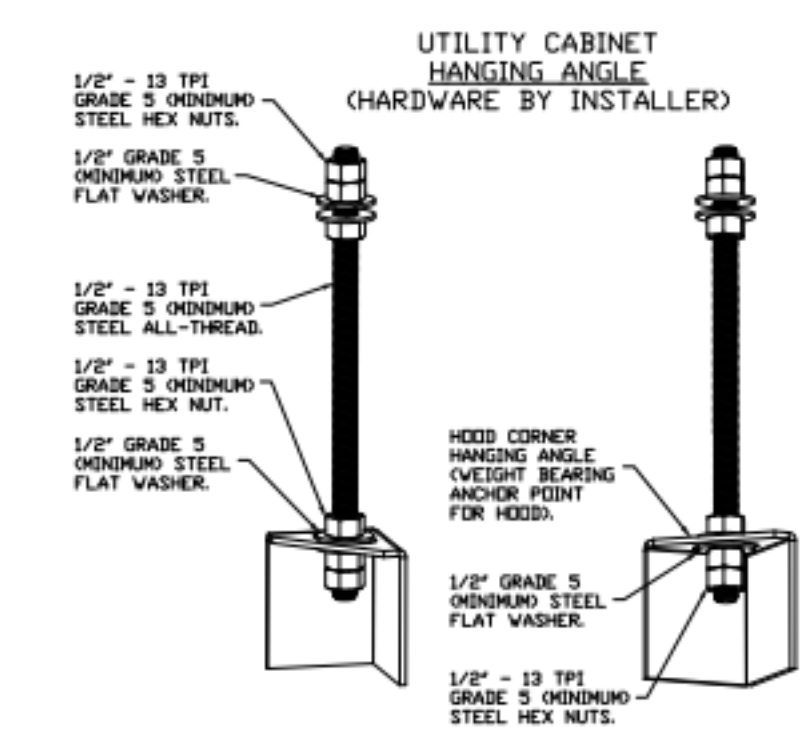

REVISIONS	
DESCRIPTION	DATE



CAPTIVE
 Eastern PA Mechanical
 www.captiveinc.com
 PO Box 2520, 1 Union Ave, Bala Cynwyd, PA 19004, PHONE: (267) 504-4126, EMAIL: reg@captivemechanical.com

Shake Shack-1398-Korea Town-R3
 LOS ANGELES, CA, 90010

DATE: 6/9/2022
 DWG.#: 5505815

DRAWN BY: CB-108
 SCALE:

MASTER DRAWING

SHEET NO.
 4

STORE NO:
 CA #1398

SHAKE SHACK
 SHAKE SHACK - KOREA TOWN
 3786 WILSHIRE BLVD, LOS ANGELES, CA 90010

REVISION	
DATE	DESCRIPTION
11/08/21	PERMIT/BID SET
A 01/26/22	REVISION A
T 07/01/22	REVISION 1
4 09/16/22	REVISION 4

STATUS:
 PERMIT/BID SET

PRELIMINARY:
 Preliminary Documents Are for Design Review only and not intended for bidding, permitting, or construction purposes. They were prepared by or under the supervision of Zebra Projects, INC.



FIELD VERIFICATION:
 The contractor shall verify all signed dimensions and conditions at the project site and notify Zebra Projects, INC. of any dimensional errors, or omissions or discrepancies, within beginning of fabricating any work. Do not scale these drawings.

COPYRIGHT © 2021:
 Zebra Projects, INC. shall retain all common law, statutory, and all other reserved rights. Neither the documents nor the information herein is to be reproduced, distributed, reflected or otherwise without the written consent of Zebra Projects, INC.

SHEET NAME:
 CAPTIVEAIRE DRAWINGS

DATE: 11/08/21 PROJECT NO: SHK-21-008
 DRAWN: SCALE: NTS

SHEET NO:
M804

EXHAUST FAN INFORMATION - JOB#5505815

FAN UNIT NO.	TAG	QTY	FAN UNIT MODEL #	MANUFACTURER	CFM	ESP	RPM	MOTOR ENCL.	HP	BHP	PHASE	VOLT	FLA	WEIGHT (LBS)	SONES
1	ESP-1	1	SIF20DD	CAPTIVEAIRE	2742	1.250	1754	TEFC,PREMIUM	5.000	3.1950	3	208	14.5	2511	25

MUA FAN INFORMATION - JOB#5505815






FAN UNIT NO.	TAG	QTY	FAN UNIT MODEL #	BLOWER	HOUSING	MIN CFM	DESIGN CFM	ESP	RPM	MOTOR ENCL.	HP	BHP	PHASE	VOLT	FLA	NCA	MDCP	EVAP FLOW RATE (Gal/Hr)	EVAP COOLER ENTERING DB TEMP	EVAP COOLER ENTERING WB TEMP	EVAP COOLER LEAVING DB TEMP	EVAP COOLER LEAVING WB TEMP	WEIGHT (LBS)	SONES
2	MAU-1	1	A2-20D	20MF-2-MOD	A2	1500	2508	0.500	1142	DDP,PREMIUM	1.000	0.8100	3	208	3.8	4.8A	15A	4	90.0°F	64.0°F	71.0°F	64.0°F	668	12.6

FAN OPTIONS

FAN UNIT NO.	TAG	QTY	DESCRIPTION		
1	ESP-1	1	SIF 20- SS L0W SP STRAIGHT DISCHARGE- SQUARE TO ROUND DISCHARGE ADAPTER		
		1	SIF20 - INLET - STANDARD 20" DUCT CONNECTION		
		1	PCU-SIZE 3 SIF-20 HESS		
		1	RUBBER VIBRATION ISOLATORS (SET OF 4), ISQ16 THRU ISQ22		
		1	SIF - HORIZONTAL FLOOR MOUNT - PRE-INSTALLED MOUNTS (11-36)		
		1	OPPOSITE SIDE CONTROLS- SIF		
		1	POLLUTION CONTROL UNIT WITH PREFILTER, DUAL ESP CELLS AND ODDOR CONTROL FILTERS WITH INSTALLED ELECTRICAL DETECTION SYSTEM. PRESET TO ACTIVATE AT 360 DEGREES F. SIZE 3		
		1	2 YEAR PARTS WARRANTY		
		2	MAU-1	1	OPPOSITE SIDE SUPPLY FAN CONTROLS
				1	EVAPORATIVE COOLER WIRING HARNESS
1	INSULATION OPTION FOR VBANK FILTER SECTION				
1	A2 INDOOR HANGING OPTION - INCLUDES 2 HSA125 HANGING SPRING ISOLATORS PER UNI-STRUT				
1	SEPARATE 120V WIRING PACKAGE (REQUIRED AND USED ONLY FOR DCV DR PREWIRE WITH VFD) - THREE PHASE ONLY				
1	2 YEAR PARTS WARRANTY				

- FAN #2 A2-20D - SUPPLY FAN (MAU-1)**
- UNTEMPERED SUPPLY UNIT WITH 20" MIXED FLOW DIRECT DRIVE FAN IN SIZE #2 HOUSING.
 - EVAP COOLER (CELLCO) & V-BANK WITH 2" EZ FILTERS - INDOOR.
 - SIDE DISCHARGE - AIR FLOW LEFT -> RIGHT.
 - MOUNT MOTOR AND DISCONNECT ON OPPOSITE SIDE OF FAN.
 - 120V WIRING CONNECTION TO ENERGIZE EVAPORATIVE COOLERS FROM UNTEMPERED SUPPLY FANS.
 - "INSULATION" FOR V-BANK INTAKE OPTION.
 - INDOOR HANGING CHAIR FOR THE SIZE 2 UNTEMPERED UNIT, 2 HSA125 HANGING ISOLATORS PER UNI-STRUT INCLUDED.
 - SEPARATE 120VAC WIRING PACKAGE FOR MAKE-UP AIR UNITS. OPTION MUST BE SELECTED WHEN MOUNTING VFD IN PREWIRE PANEL OR WITH DCV PACKAGE. PROVIDES SEPARATE 120VAC INPUT TO SUPPLY FAN. THIS 120V SIGNAL MUST BE RUN BY ELECTRICIAN FROM DCV TO MUA SWITCH.
 - HINGED DOUBLE WALL INSULATED DOOR ASSEMBLY (BURNER/BLOWER/EVAP SECTION).
 - 2 YEAR PARTS WARRANTY.

NOTE: SUPPLY DUCT MUST BE INSTALLED TO MEET SMACNA STANDARDS. A MINIMUM STRAIGHT DUCT LENGTH MUST BE MAINTAINED DOWNSTREAM OF UNIT DISCHARGE AS OUTLINED IN AMCA PUBLICATION 201. WHEN USING RECTANGULAR DUCTWORK, ELBOWS MUST BE RADIUS THROAT, RADIUS BACK WITH TURNING VANES. FLEXIBLE DUCTWORK AND SQUARE THROAT/SQUARE BACK ELBOWS SHOULD NOT BE USED. ANY TRANSITION AND/OR TURNS IN THE DUCTWORK WILL CAUSE SYSTEM EFFECT. SYSTEM EFFECT WILL DRAMATICALLY INCREASE STATIC PRESSURE AND REDUCE AIRFLOW. DO NOT RELY ON UNIT TO SUPPORT DUCT IN ANY WAY. FAILURE TO PROPERLY SIZE DUCTWORK MAY CAUSE SYSTEM EFFECTS AND REDUCE PERFORMANCE OF THE EQUIPMENT. SUGGESTED STRAIGHT DUCT SIZE IS 26" x 26".

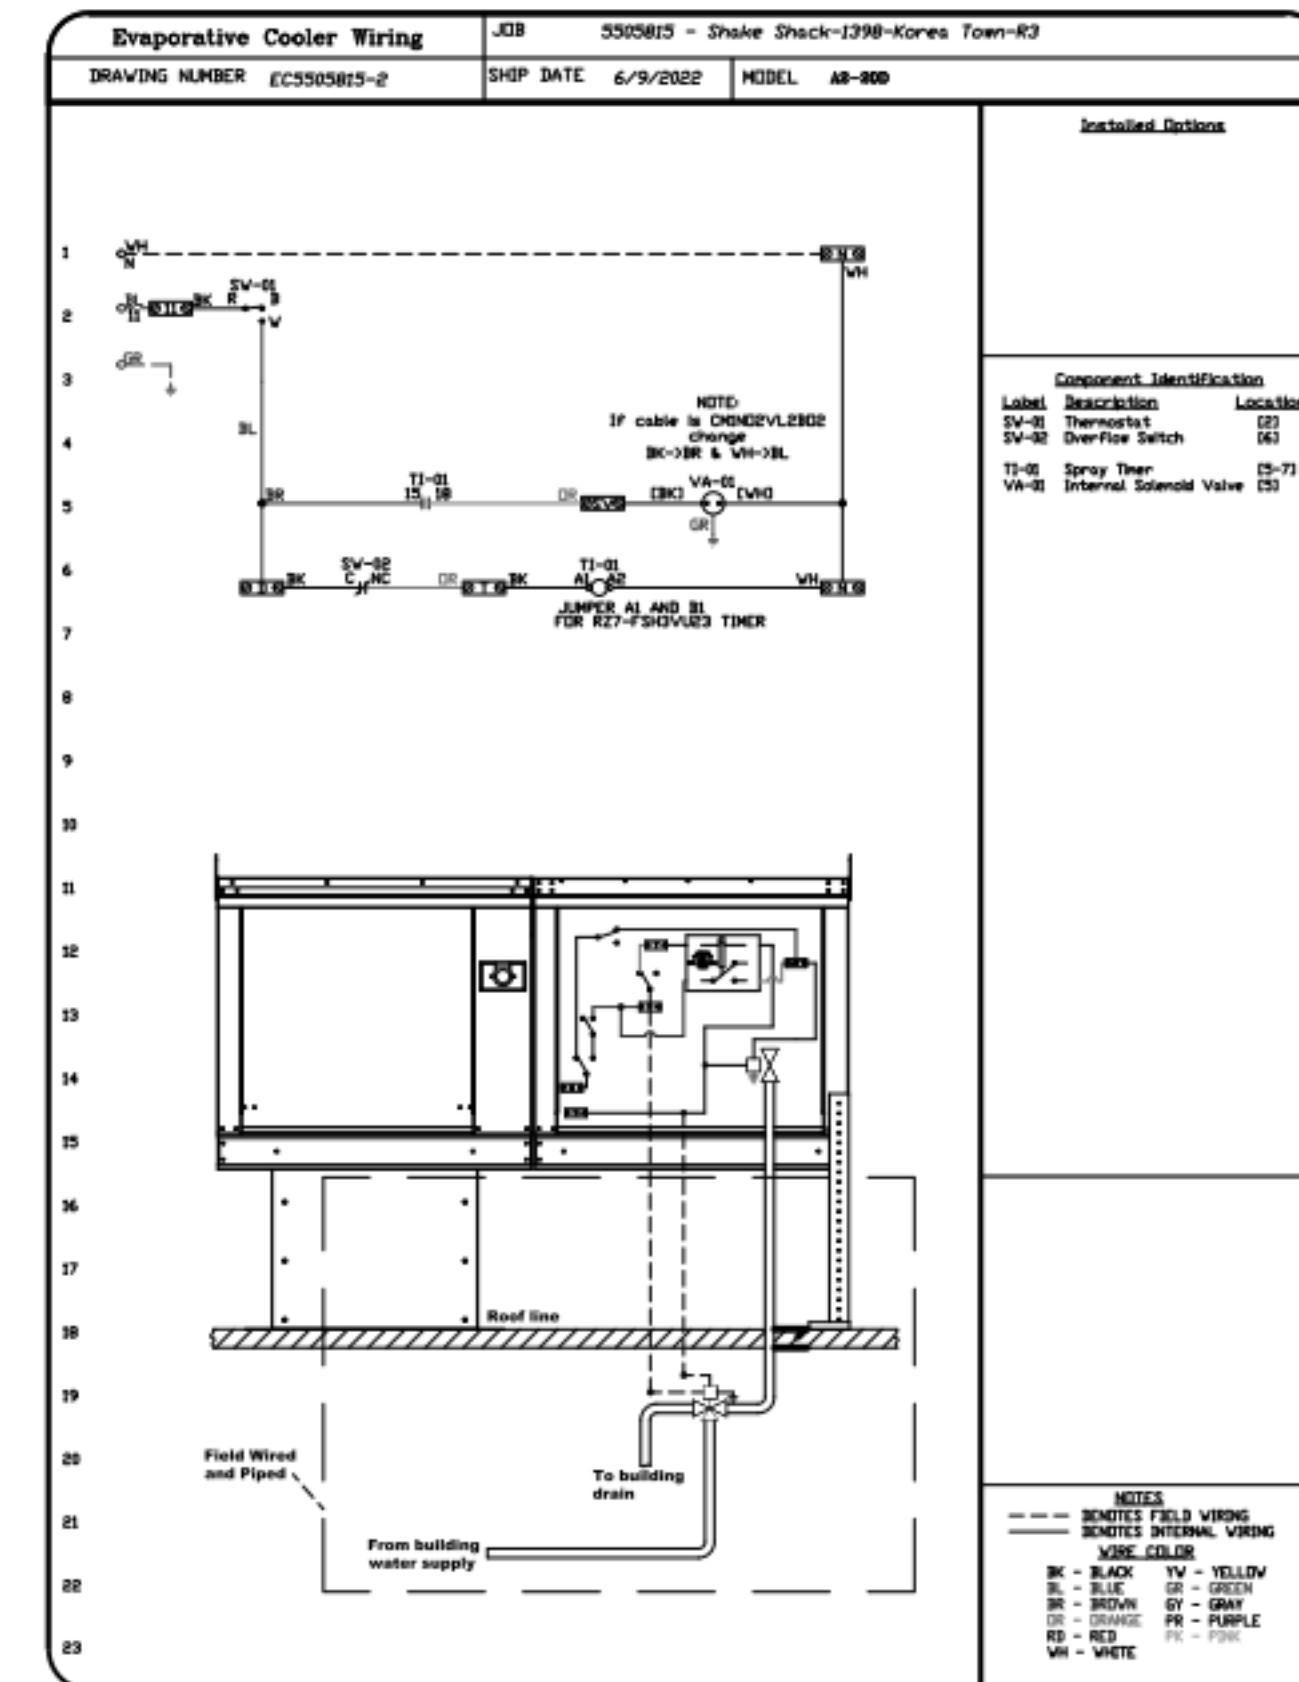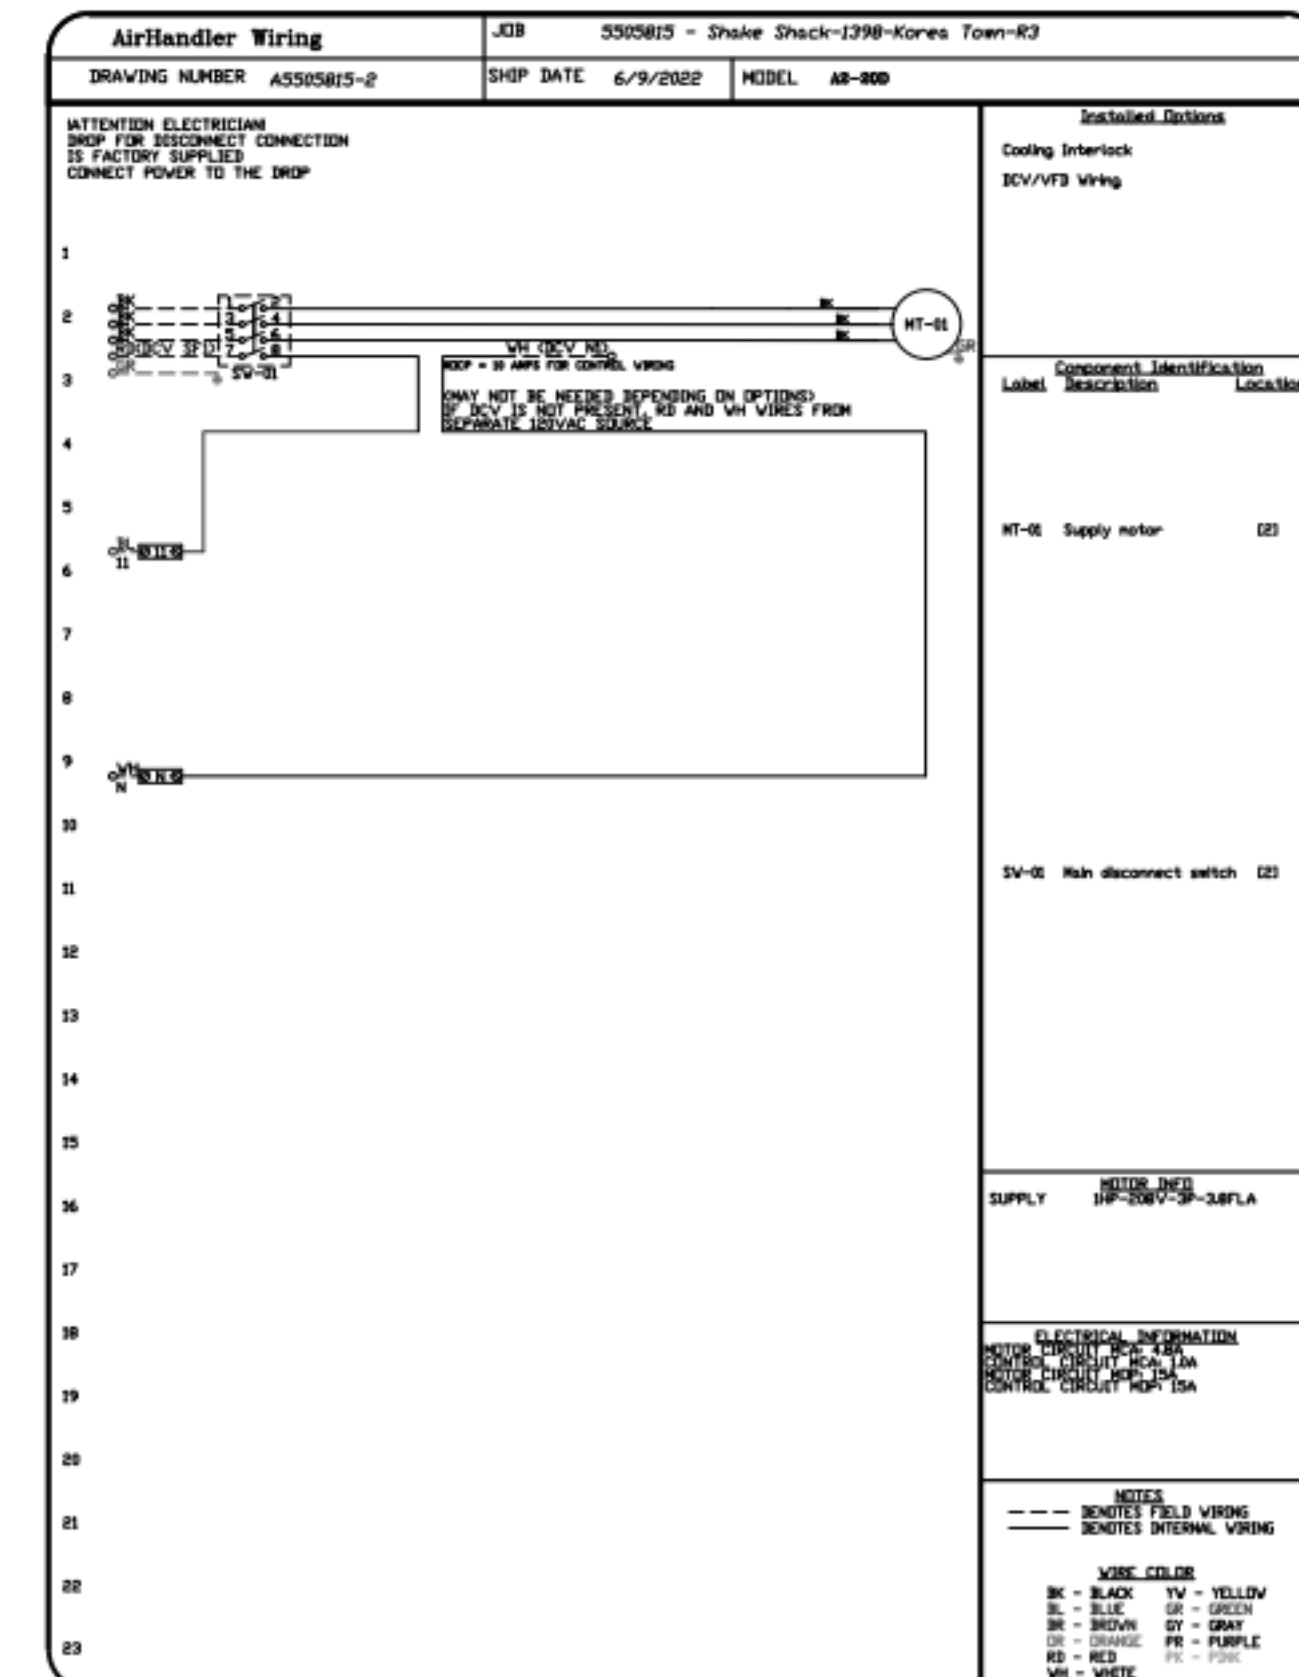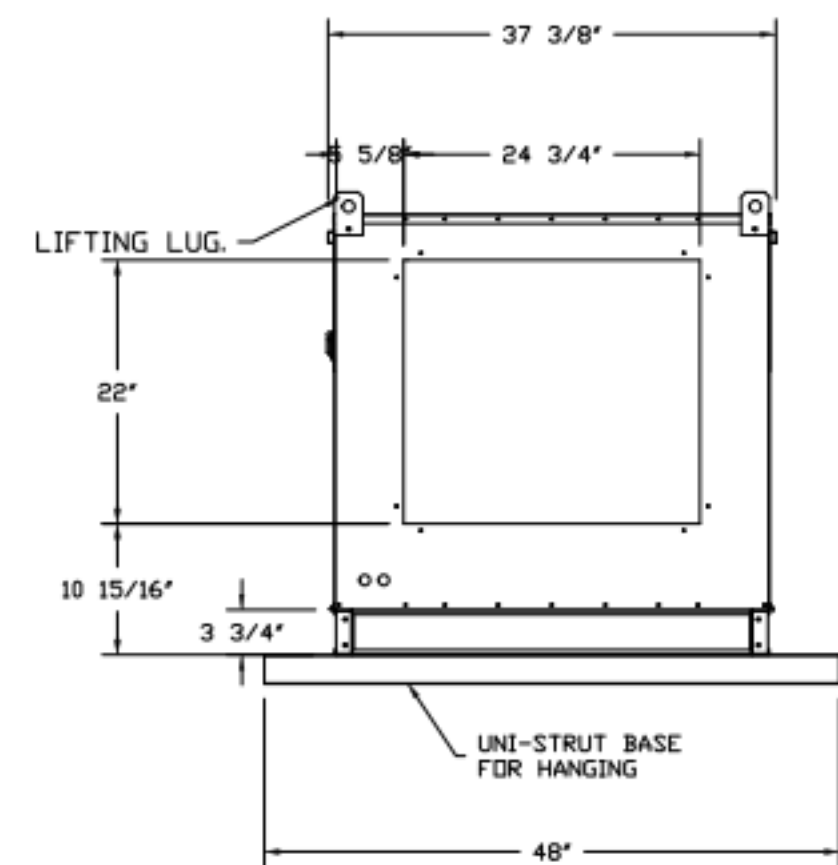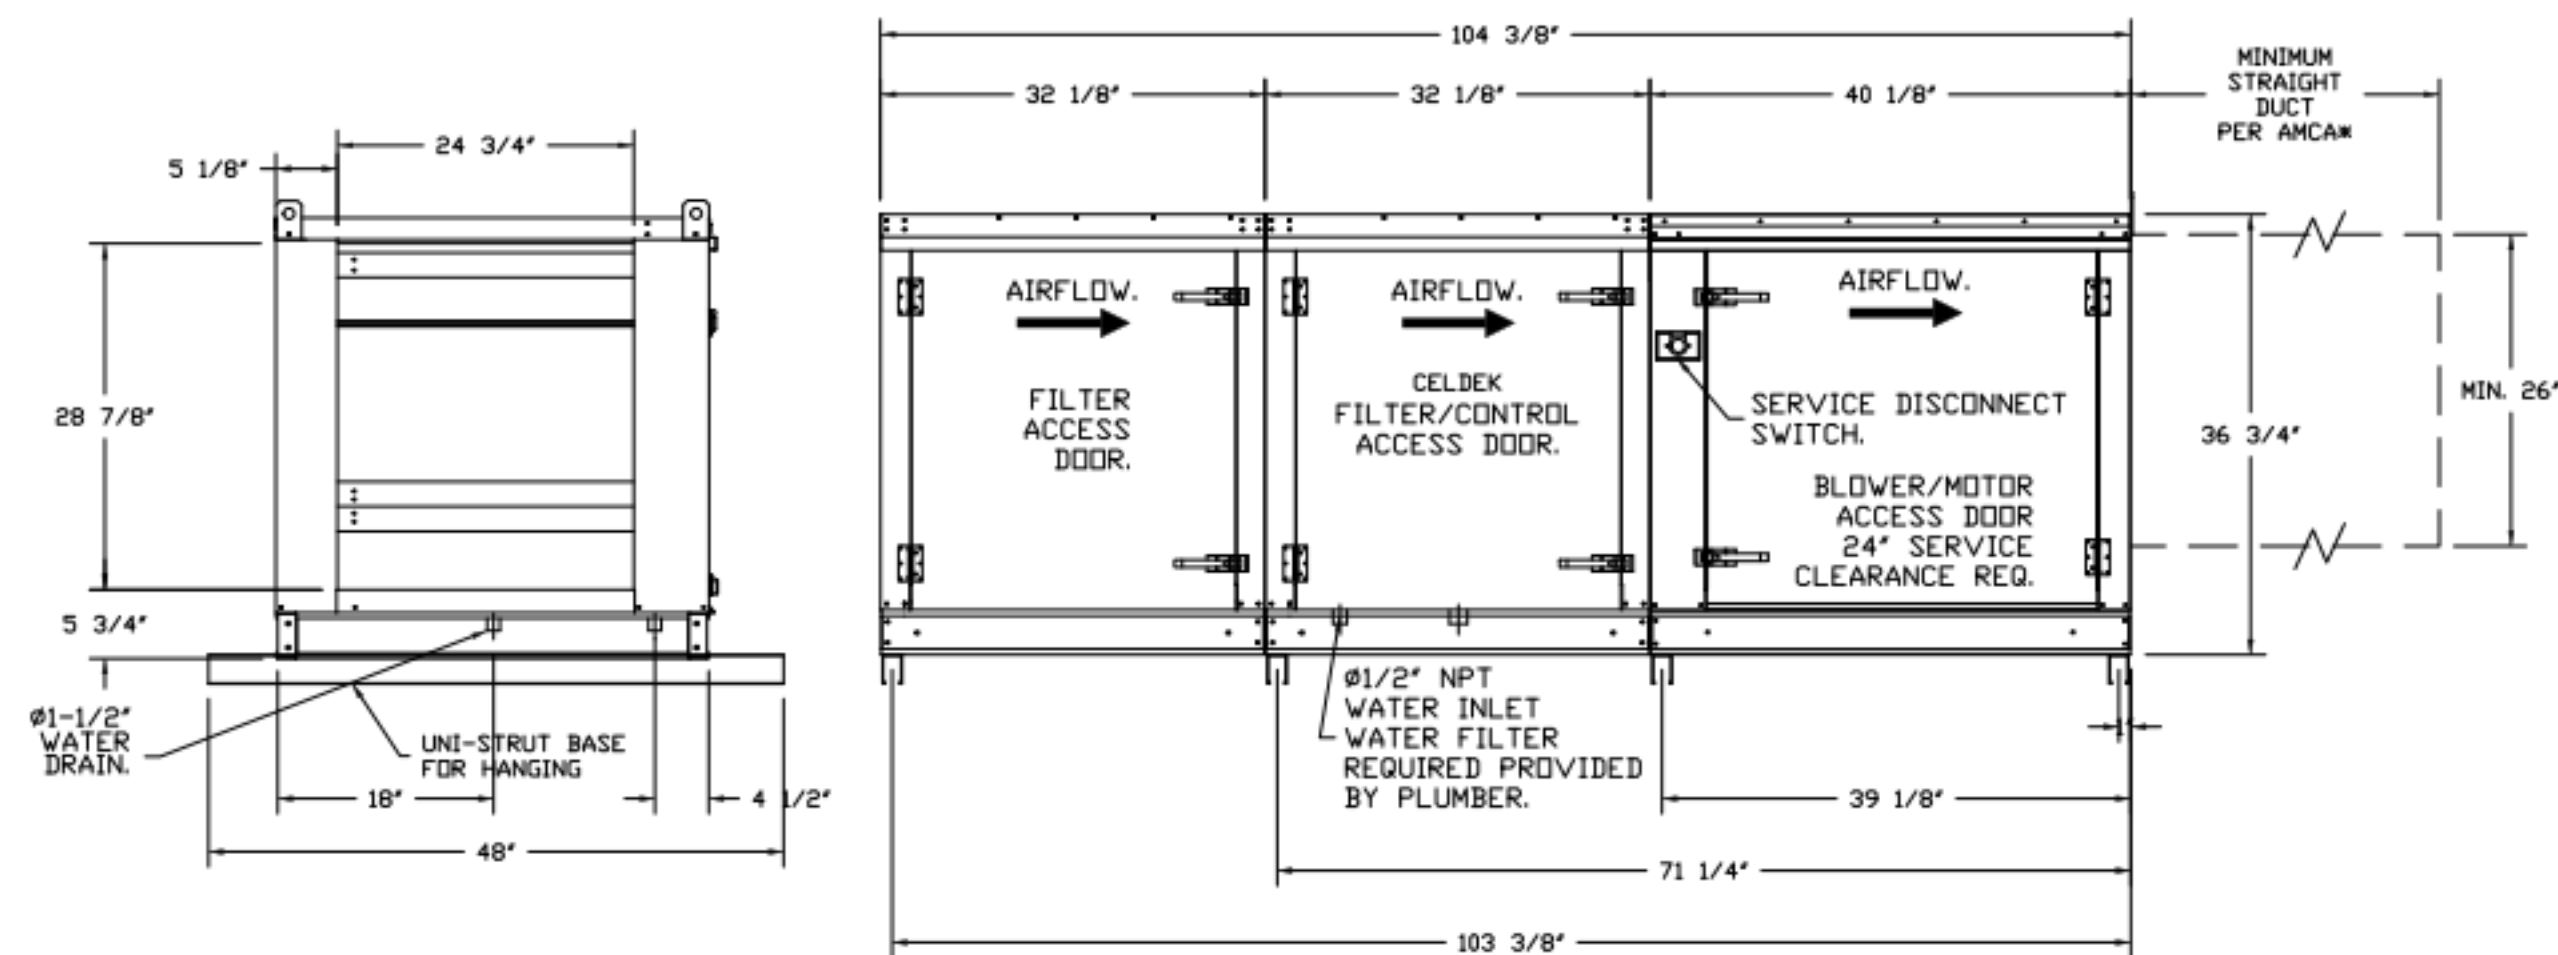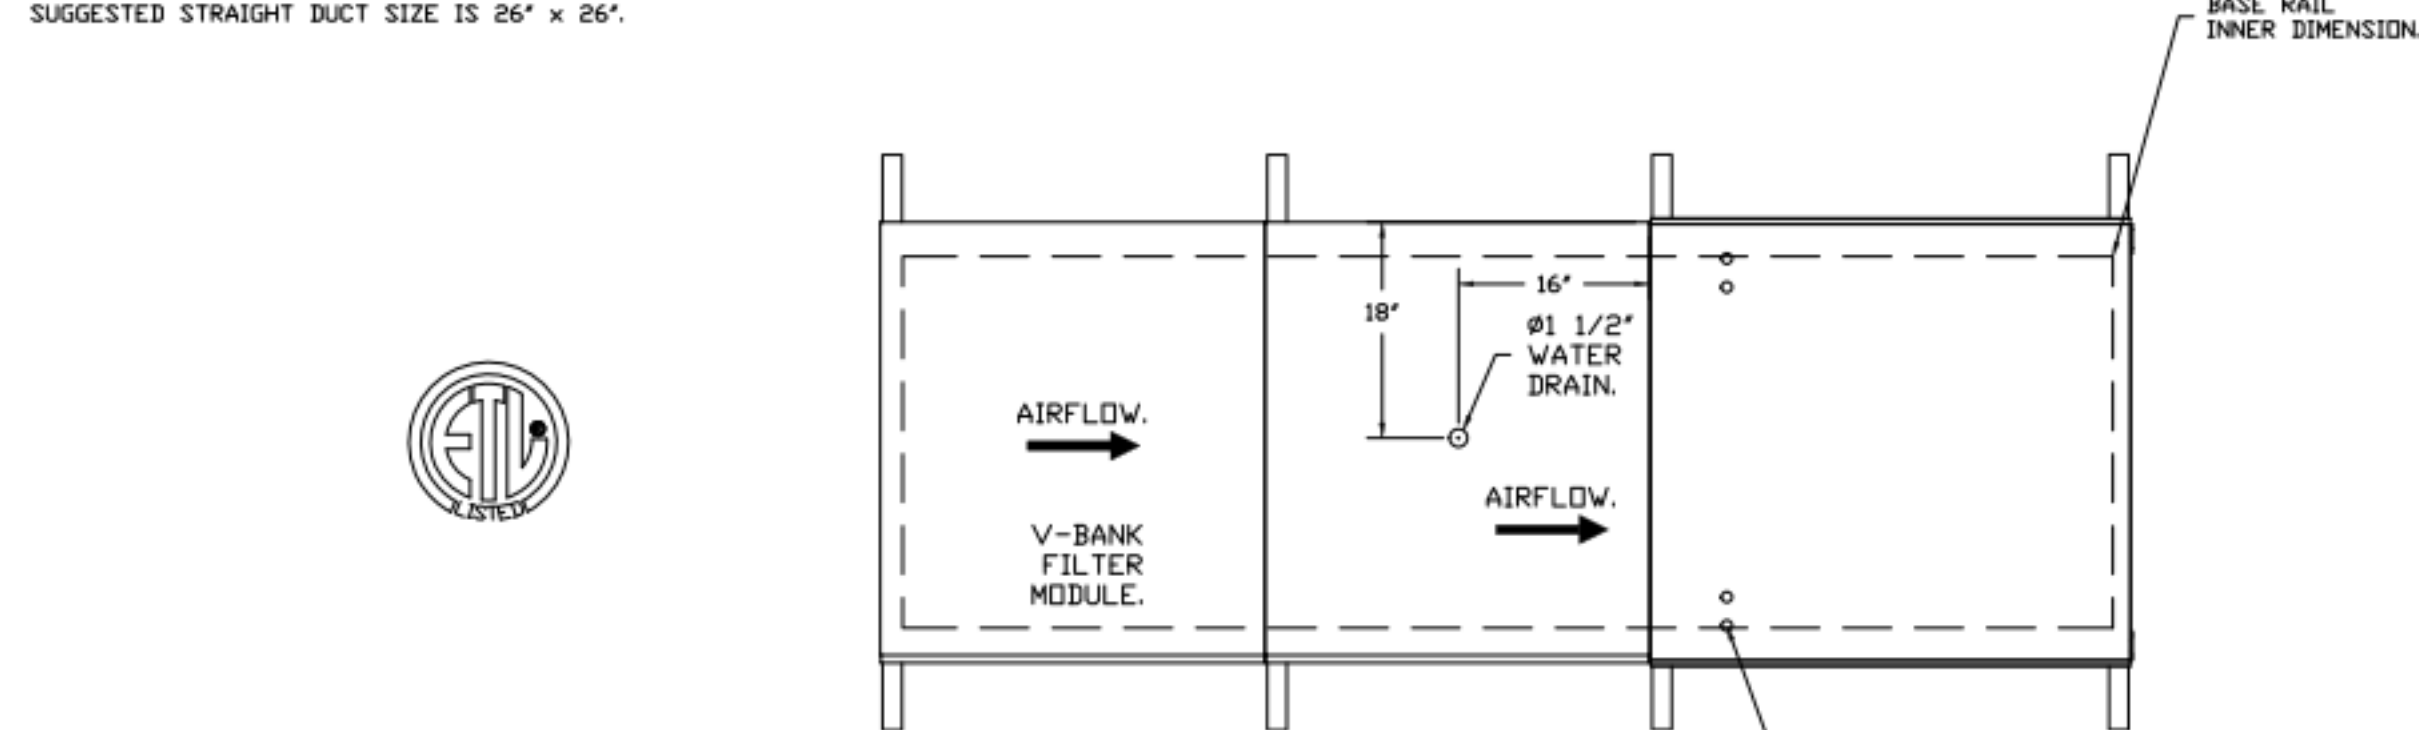

REVISIONS

NO.	DESCRIPTION	DATE

CAPTIVEAIRE

Eastern PA Mechanical

PO Box 2520, 1 Union Ave, Bala Cynwyd, PA, 19004 PHONE: (267) 504-4126 EMAIL: reg108@captiveaire.com

Shake Shack-1398-Korea Town-R3
LOS ANGELES, CA, 90010

DATE: 6/9/2022
DWG.#: 5505815
DRAWN BY: EB-108
SCALE:
MASTER DRAWING

SHEET NO.
5

zebra

ZEBRA PROJECTS, INC.
14814 N KIERLAND BLVD, SUITE N 300
SCOTTSDALE, ARIZONA 85254
PHONE: 480.912.1169 www.zbr.co.uk

INFRASTRUCTURE FACTOR CONSULTING, INC.
2361 Rosecrans Ave, Suite 368, El Segundo, CA 90245
P. 310.725.1500 F. 310.725.0215 www.Factor.com

STORE NO:
CA #1398

SHAKE SHACK

SHAKE SHACK - KOREATOWN
3786 WILSHIRE BLVD. LOS ANGELES, CA 90010

REVISION

NO.	DATE	DESCRIPTION
1	11/08/21	PERMIT/BID SET
A	01/26/22	REVISION A
1	07/01/22	REVISION 1
4	09/16/22	REVISION 4

STATUS:
PERMIT/BID SET

PRELIMINARY:
The contractor shall verify all signed dimensions and conditions at the project site and notify Zebra Projects, INC. of any dimensional errors, or omissions or discrepancies. (Initials beginning of indicating any work. Do not scale these drawings.)

COPYRIGHT © 2021:
Zebra Projects, INC. shall retain all common law, statutory and all other reserved rights. Neither the documents nor the information herein is to be reproduced, distributed, disclosed or otherwise used without the written consent of Zebra Projects, INC.

PROFESSIONAL ENGINEER
M38244
EDMUND W. HANFORD
STATE OF CALIFORNIA

FIELD VERIFICATION:
The contractor shall verify all signed dimensions and conditions at the project site and notify Zebra Projects, INC. of any dimensional errors, or omissions or discrepancies. (Initials beginning of indicating any work. Do not scale these drawings.)

SHEET NAME:
CAPTIVEAIRE DRAWINGS

DATE: 11/08/21 PROJECT NO: SHK-21-008
DRAWN: SCALE: NTS

SHEET NO:
M805

DESCRIPTION:
 FAN #1 SIF2000-HESS-UL762 - EXHAUST FAN (ESP-1) - POLLUTION CONTROL UNIT WITH FIRE SYSTEM INSTALLED. INCLUDES STEEL PRE-FILTER MODULE, DUAL ESP MODULES, AND ODOR CONTROL MODULE PREPIPED WITH DOWNSTREAM PROTECTION. ELECTRIC FIRE DETECTOR AND NOZZLES ARE INCLUDED.

NOTES:
 1. ALL DIMENSIONS ARE NOMINAL AND GIVEN IN INCHES.
 2. C/US UL710 LISTED FOR GREASE DUCT INSTALLATION.
 3. UL762 RATED DIRECT DRIVE SQUARE INLINE FAN WITH 20.7% HIGH EFFICIENCY MIXED FLOW WHEEL.
 4. WHEN USED IN KITCHEN GREASE DUCT, UNIT MUST BE INSTALLED DOWNSTREAM OF A LISTED HOOD ASSEMBLY OF A UL710 LISTED HOOD ASSEMBLY OR A NFPA 96 COMPLIANT HOOD AS LONG AS IT IS INSTALLED WITH A FIRE SUPPRESSION SYSTEM THAT IS INTERLOCKED WITH THE NFPA 96 COMPLIANT HOOD FIRE SYSTEM.
 5. CLEARANCE ON FILTER ACCESS SIDE OF THE PCU SHOULD BE A MINIMUM OF 36" FOR PROPER SERVICE OF THE UNIT. ALL OTHER SIDES SHOULD FOLLOW CLEARANCE TO COMBUSTIBLE GUIDELINES PER CODE.
 6. UNIT CONTAINS PRESSURE MONITORING SWITCH. REFER TO ELECTRICAL SCHEMATIC OR OPERATION MANUAL FOR MORE INFORMATION.
 7. 1.5" NPT BRAIN SUPPLIED IN EACH MODULE BASE. CONNECT INDIVIDUAL DRAINS TO A COMMON 2 1/2" DRAIN AND ROUTE TO GREASE INTERCEPTOR.
 8. FIRE SYSTEM TO BE INSTALLED INDOORS OR IN A WEATHERTIGHT ENCLOSURE MAINTAINED BETWEEN 30° AND 130° F. THIS ENCLOSURE IS PROVIDED BY OTHERS.
 9. WHEN THE PCU IS INSTALLED ABOVE OR NEAR A FINISHED SPACE, THE INSTALLING CONTRACTOR MUST PROTECT THE FINISHED SPACE TO PREVENT WATER DAMAGE IN THE EVENT OF A FIRE SYSTEM DISCHARGE OR WHEN REGULAR CLEANING IS PERFORMED ON THE UNIT.
 10. POLLUTION CONTROL UNIT IS RATED FOR INDOOR USE WHEN INSTALLED IN ACCORDANCE WITH IMC 506.5.2.4, INCLUDING THE USE OF A FIRE RATED ENCLOSURE AS APPLICABLE.

INLET NOTES:
 1. LENGTH OF STRAIGHT DUCT ON INLET OF PCU TO BE 3 TIMES THE EQUIVALENT DUCT DIAMETER TO AVOID SYSTEM EFFECT.
 2. MAX INLET DUCT VELOCITY TO BE 1000 FPM INTO THE PCU. DUCTWORK SHOULD BE SIZED APPROPRIATELY.
 3. DUCT MUST BE GRADUALLY TRANSITIONED TO THE INLET OPENING OF THE PCU TO SPREAD AIR OUT ON ALL PCU FILTERS. FAILURE TO DO THIS WILL RESULT IN ODOOR AND SMOKE BYPASS.
 -A SERVICE PLATFORM MUST BE INSTALLED ON THE FILTER SIDE OF THE UNIT FOR PROPER FILTER MAINTENANCE.
 -THE PLATFORM MUST BE THE SAME LENGTH AS THE PCU AND AT LEAST 3 FEET WIDE.
 -THE PLATFORM MUST BE STRUCTURALLY SUPPORTED BY THE BUILDING, INDEPENDENT OF THE PCU.
 -THE PLATFORM MUST BE DESIGNED TO PROPERLY SUPPORT THE WEIGHT OF ALL PCU FILTERS AND MAINTENANCE PERSONNEL.
 -HANDRAILS MUST BE INSTALLED ON THE SERVICE PLATFORM TO PROTECT MAINTENANCE PERSONNEL.

PCU OPTIONS:
 - INDOOR HANGING CRADLE FOR SIZE 3 PCU WITH 3 OR 4 MODULES AND USBI BLOWER. 6 PIECES OF UNI-STRUT, 64 INCHES LONG EACH. 2 HSA310 HANGING ISOLATORS PER UNI-STRUT INCLUDED. FOR USE WITH USBI BLOWERS.
 - PCUAFM WITH HMI SCREEN, BACK PLATE WITH LABEL, AIRLINES/QUICK CONNECTS/AIR PROBES, CONDUIT/FITTINGS/WIRING HARNESS.
 - INTAKE PLATE FOR SIZE 3 PCU WITH 30" X 30" HOLE FOR DUCT CONNECTIONS FOR USE WITH CUSTOM DUCT FITMENT OR FIELD FITMENT.

FAN #1 SIF2000-HESS-UL762 - EXHAUST FAN (ESP-1) - PCU #1 PCU-PF-ESP-DC-REFS-3
 FAN WEIGHT = 250LBS
 PCU LOCATION: INDOOR (CONDITIONED SPACE).
 NOTE: TWO HANGERS PER UNIVERSAL STRUT.

FAN OPTIONS:
 - SIF 20-SS LDV SP STRAIGHT DISCHARGE - SQUARE TO ROUND DISCHARGE ADAPTER
 - SIF20 CONNECTION - INLET - STANDARD 20" DUCT
 - PCU-SIZE 3 SIF-20 HESS
 - RUBBER VIBRATION ISOLATORS (SET OF 4), ISO16 THRU ISO22
 - SIF - HORIZONTAL FLOOR MOUNT - PRE-INSTALLED MOUNTS (11-36)
 - OPPOSITE SIDE CONTROLS - SIF
 - POLLUTION CONTROL UNIT WITH PREFILTER, DUAL ESP CELLS AND ODOR CONTROL FILTERS WITH INSTALLED ELECTRICAL DETECTION SYSTEM. PRESET TO ACTIVATE AT 360 DEGREES F. SIZE 3
 - 2 YEAR PARTS WARRANTY

INLET: 64" x 30" x 7 3/4"
OUTLET: 33 13/16" x 31 3/16" x 32 7/8"

MAIN UNIT DIMENSIONS: 220 9/16" x 38" x 38 1/8"
 74 3/8" x 38" x 38"
 146 3/16" x 38" x 38"
 31 13/16" x 38" x 38"
 38 15/16" x 38 3/4" x 20 1/16"
 40 3/4" x 40 3/16" x 36 7/8"

COMPONENTS: SERVICE DISCONNECT SWITCH, 1/8" GASKET, ODOR CONTROL, CONTROL CABINET, ESP, ESP, PRE-FILTER, LATCH, AIRFLOW, LIFTING LUGS, HINGE, 1/8" GASKET, 1/8" GASKET, 1/8" GASKET.

INSTALLATION NOTES:
 - 18" MINIMUM CLEARANCE TO COMBUSTIBLES.
 - DRIP PAN FOR PROTECTING FINISHED SPACE PROVIDED BY OTHERS. SEE NOTE 9.
 - MINIMUM STRAIGHT RUN AT INLET OF UNIT: 54"
 - MINIMUM DIAMETER OF 18" OR EQUIVALENT RECTANGULAR AREA AT BEGINNING OF STRAIGHT RUN. MAXIMUM DUCT VELOCITY AT BEGINNING OF TRANSITION SHOULD BE 1500 FPM.
 - DUCT MUST BE GRADUALLY TRANSITIONED TO THE INLET OPENING OF THE PCU TO SPREAD AIR OUT ON ALL PCU FILTERS. FAILURE TO DO THIS WILL RESULT IN ODOOR AND SMOKE BYPASS.
 - SIZE DUCT SUCH THAT MAXIMUM VELOCITY AT PCU INLET IS 1000 FPM.
 - DUCT SHOULD TRANSITION TO 30" HIGH X 30" WIDE FINAL DIMENSION AT INLET. FULLY WELD DUCT TO INLET PLATE.

TYPICAL "HS" UNIT SPRING MOUNTING:
 MODULAR PCU UNIT, NUT, WASHER, ADJUSTMENT NUT FOR SPRING LOADING, SPRING MOUNT, UNIVERSAL STRUT, THREADED ROD # 5/8" FOR HSA TYPE HANGER, # 3/4" FOR HSB TYPE HANGER.

REVISIONS:

NO.	DATE	DESCRIPTION
1	11/08/21	PERMIT/BID SET
2	01/26/22	REVISION A
3	07/01/22	REVISION 1
4	09/16/22	REVISION 4

DATE: 6/9/2022
DWG.#: 5505815
DRAWN BY: EB-108
SCALE:
MASTER DRAWING
SHEET NO.: 6

CAPTIVEAIRE
 Eastern PA Mechanical
 PO Box 2620, 1 Union Ave, Bliss Cymrud, PA, 19004 PHONE: (267) 504-4126 EMAIL: neg10@captivaire.com
 www.captivaire.com

Shake Shack-1398-Korea Town-R3
 LOS ANGELES, CA, 90010

STORE NO:
 CA #1398

SHAKE SHACK
 SHAKE SHACK - KOREATOWN
 3786 WILSHIRE BLVD. LOS ANGELES, CA 90010

REVISION

NO.	DATE	DESCRIPTION
1	11/08/21	PERMIT/BID SET
2	01/26/22	REVISION A
3	07/01/22	REVISION 1
4	09/16/22	REVISION 4

STATUS:
 PERMIT/BID SET

PRELIMINARY:
 Preliminary Documents Are for Design Review only and not intended for building, engineering, permitting or construction purposes. They were prepared by or under the supervision of Zebra Projects, Inc.

FIELD VERIFICATION:
 The contractor shall verify all signed dimensions and location at the project site and notify Zebra Projects, Inc. of any dimensional errors, or omissions or discrepancies, before beginning or relocating any work. Do not make these changes.

COPYRIGHT © 2021:
 Zebra Projects, Inc. shall retain all common law, statutory and all other reserved rights. Neither the documents nor the information herein is to be reproduced, distributed, disclosed or otherwise used without the written consent of Zebra Projects, Inc.

PROFESSIONAL ENGINEER:
 M38244
 ED MANNING
 STATE OF CALIFORNIA



SHEET NAME:
 CAPTIVEAIRE DRAWINGS

DATE: 11/08/21 **PROJECT NO.:** SHK-21-008
SCALE: NTS

SHEET NO.: M806

ELECTRICAL PACKAGE - JOB#5505815

NO	TAG	PACKAGE #	LOCATION	SWITCHES		OPTION	FANS CONTROLLED							
				LOCATION	QUANTITY		FAN TAG	TYPE	#	HP	VOLTS	FLA		
1		SC-311110MA	WALL MOUNT IN SS BOX	05 - SS WALL MOUNT BOX	1 LIGHT 1 FAN	SMART CONTROLS THERMOSTATIC CONTROL W/ RELAY ON/OFF WITH SUPPLY								
2		SCS150HC0		29 - SCS DDDR		SCS BASE VD OPTION								

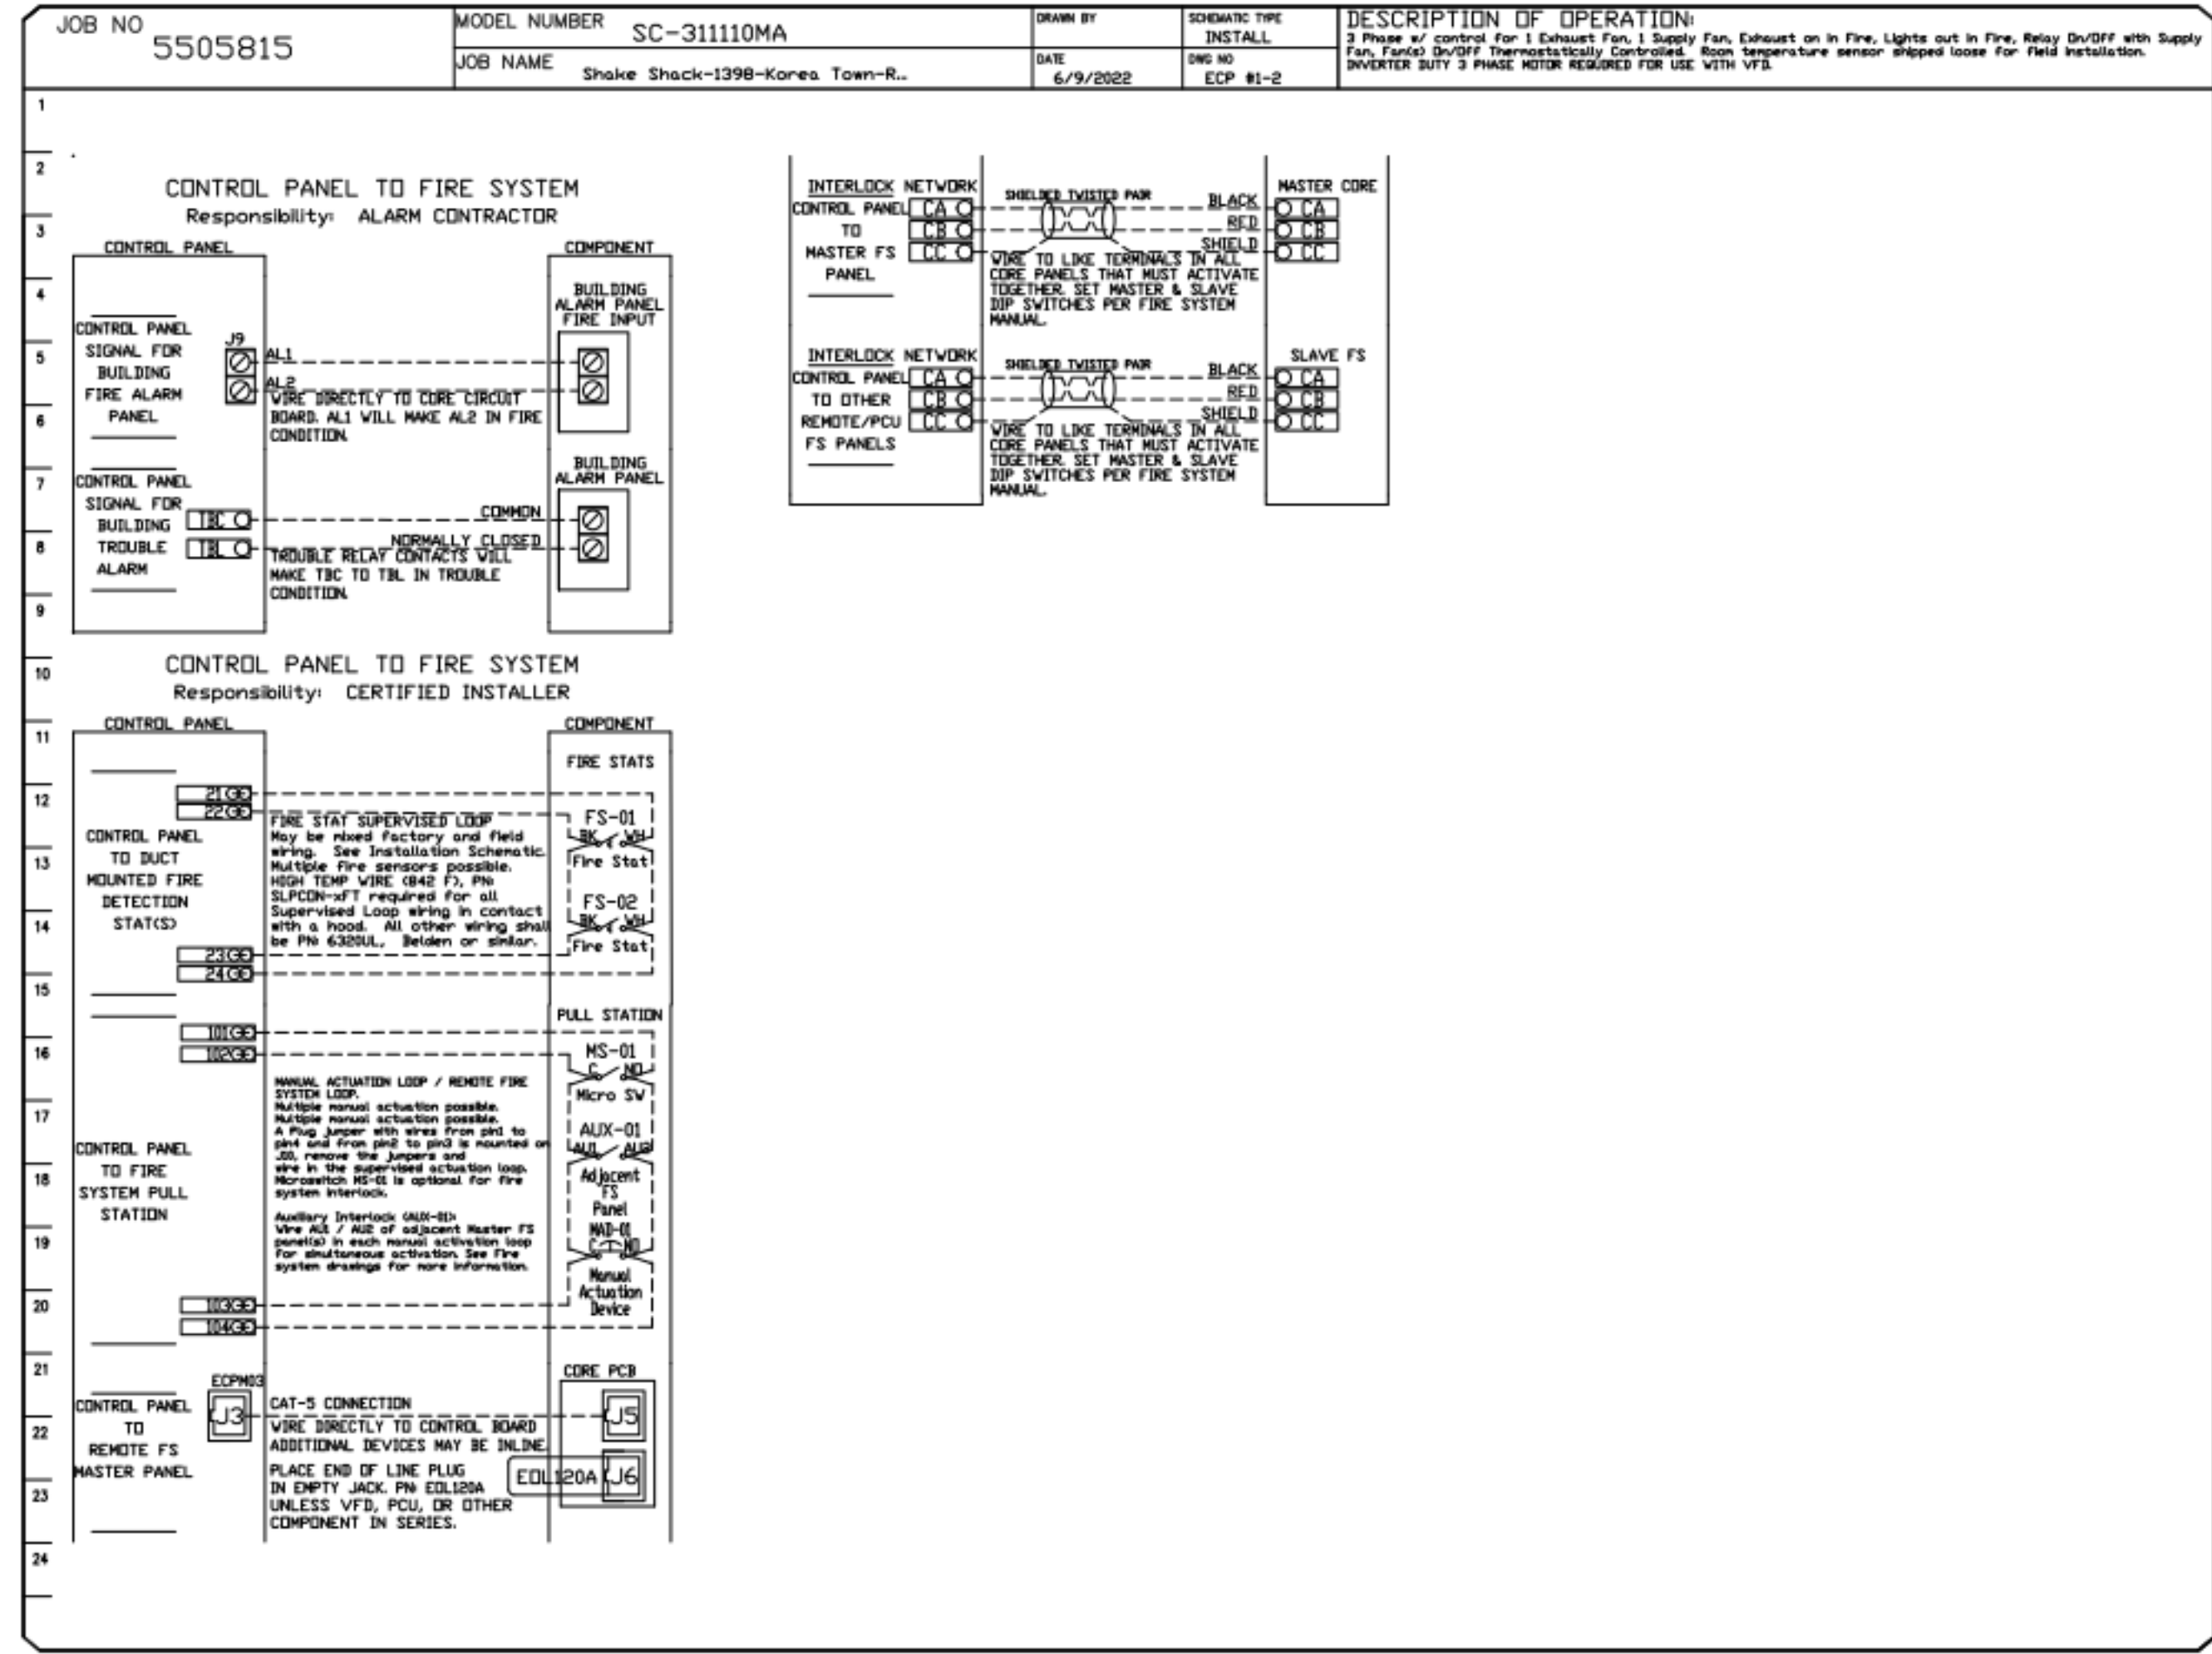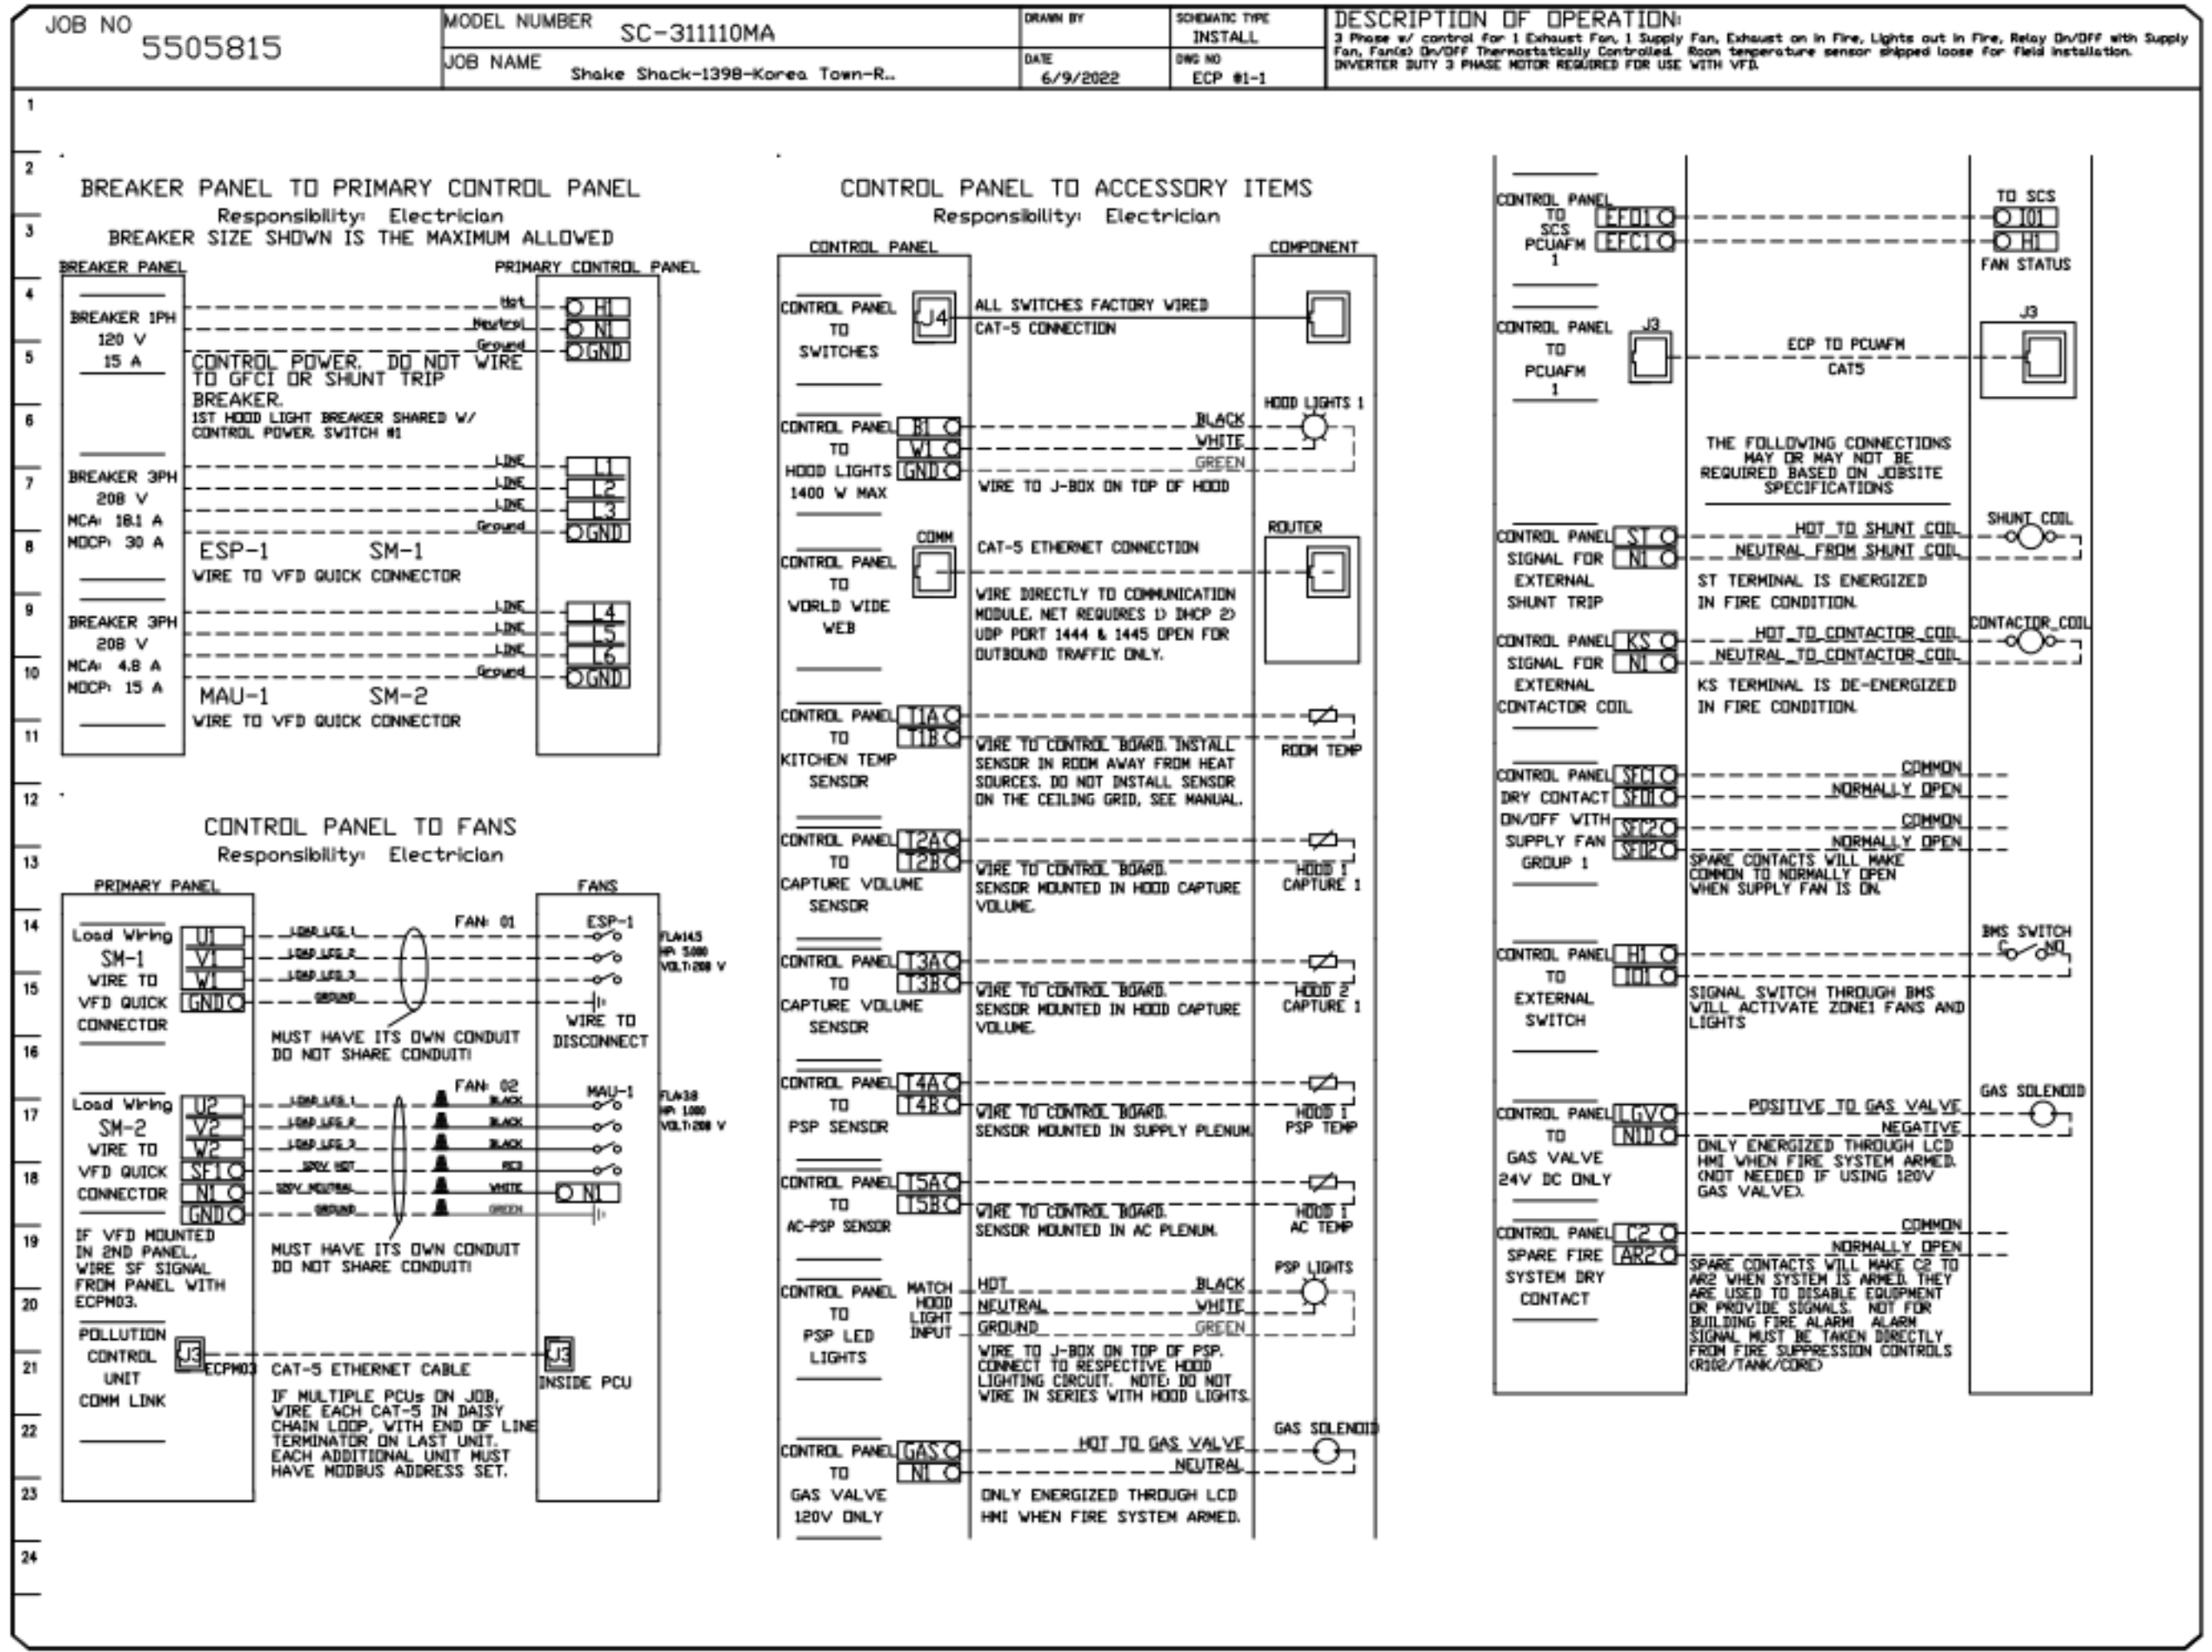

REVISIONS

NO	DATE	DESCRIPTION

CAPTIVE
 Eastern PA Mechanical
 www.captivepa.com
 PO Box 2520, 1 Union Ave, Balla Cymwyd, PA, 15004 PHONE: (267) 504-4126 EMAIL: reg108@captivepa.com

Shake Shack-1398-Korea Town-R3
 LOS ANGELES, CA, 90010

DATE: 6/9/2022
DWG.#: 5505815
DRAWN BY: EB-108
SCALE: 3/4" = 1'-0"
MASTER DRAWING

SHEET NO.
7

STORE NO: CA #1398

SHAKE SHACK
 SHAKE SHACK - KOREA TOWN
 376 WILSHIRE BLVD, LOS ANGELES, CA 90010

REVISION

NO	DATE	DESCRIPTION
1	11/08/21	PERMIT/BID SET
A	01/26/22	REVISION A
1	07/01/22	REVISION 1
4	09/16/22	REVISION 4

STATUS: PERMIT/BID SET

PRELIMINARY: Preliminary Documents are for Design Review only and not intended for construction. They are prepared by or under the supervision of Zebra Projects, Inc.



FIELD VERIFICATION: The contractor shall verify all signed dimensions and conditions at the project site and notify Zebra Projects, Inc. of any dimensional errors, or omissions or discrepancies before beginning or relocating any work. Do not scale these drawings.
 COPYRIGHT © 2021: Zebra Projects, Inc. shall retain all common law, statutory and all other reserved rights. Neither the documents nor the information herein is to be reproduced, distributed, photocopied or otherwise used without the written consent of Zebra Projects, Inc.

SHEET NAME: CAPTIVEAIRE DRAWINGS

DATE: 11/08/21 PROJECT NO: SHK-21-008

DRAWN: SCALE: NTS

SHEET NO: M807

REVISIONS





NO.	DESCRIPTION	DATE

CAPTIVE
 Eastern PA Mechanical
 www.captiveaire.com
 PO Box 2520, 1 Union Ave, Bala Cynwyd, PA 19004 PHONE: (267) 504-4128 EMAIL: reg108@captiveaire.com

Shake Shack-1398-Korea Town-R3
 LOS ANGELES, CA, 90010

DATE: 6/9/2022
DWG.#: 5505815
DRAWN BY: EB-108
SCALE: 3/4" = 1'-0"
MASTER DRAWING

SHEET NO.
 9

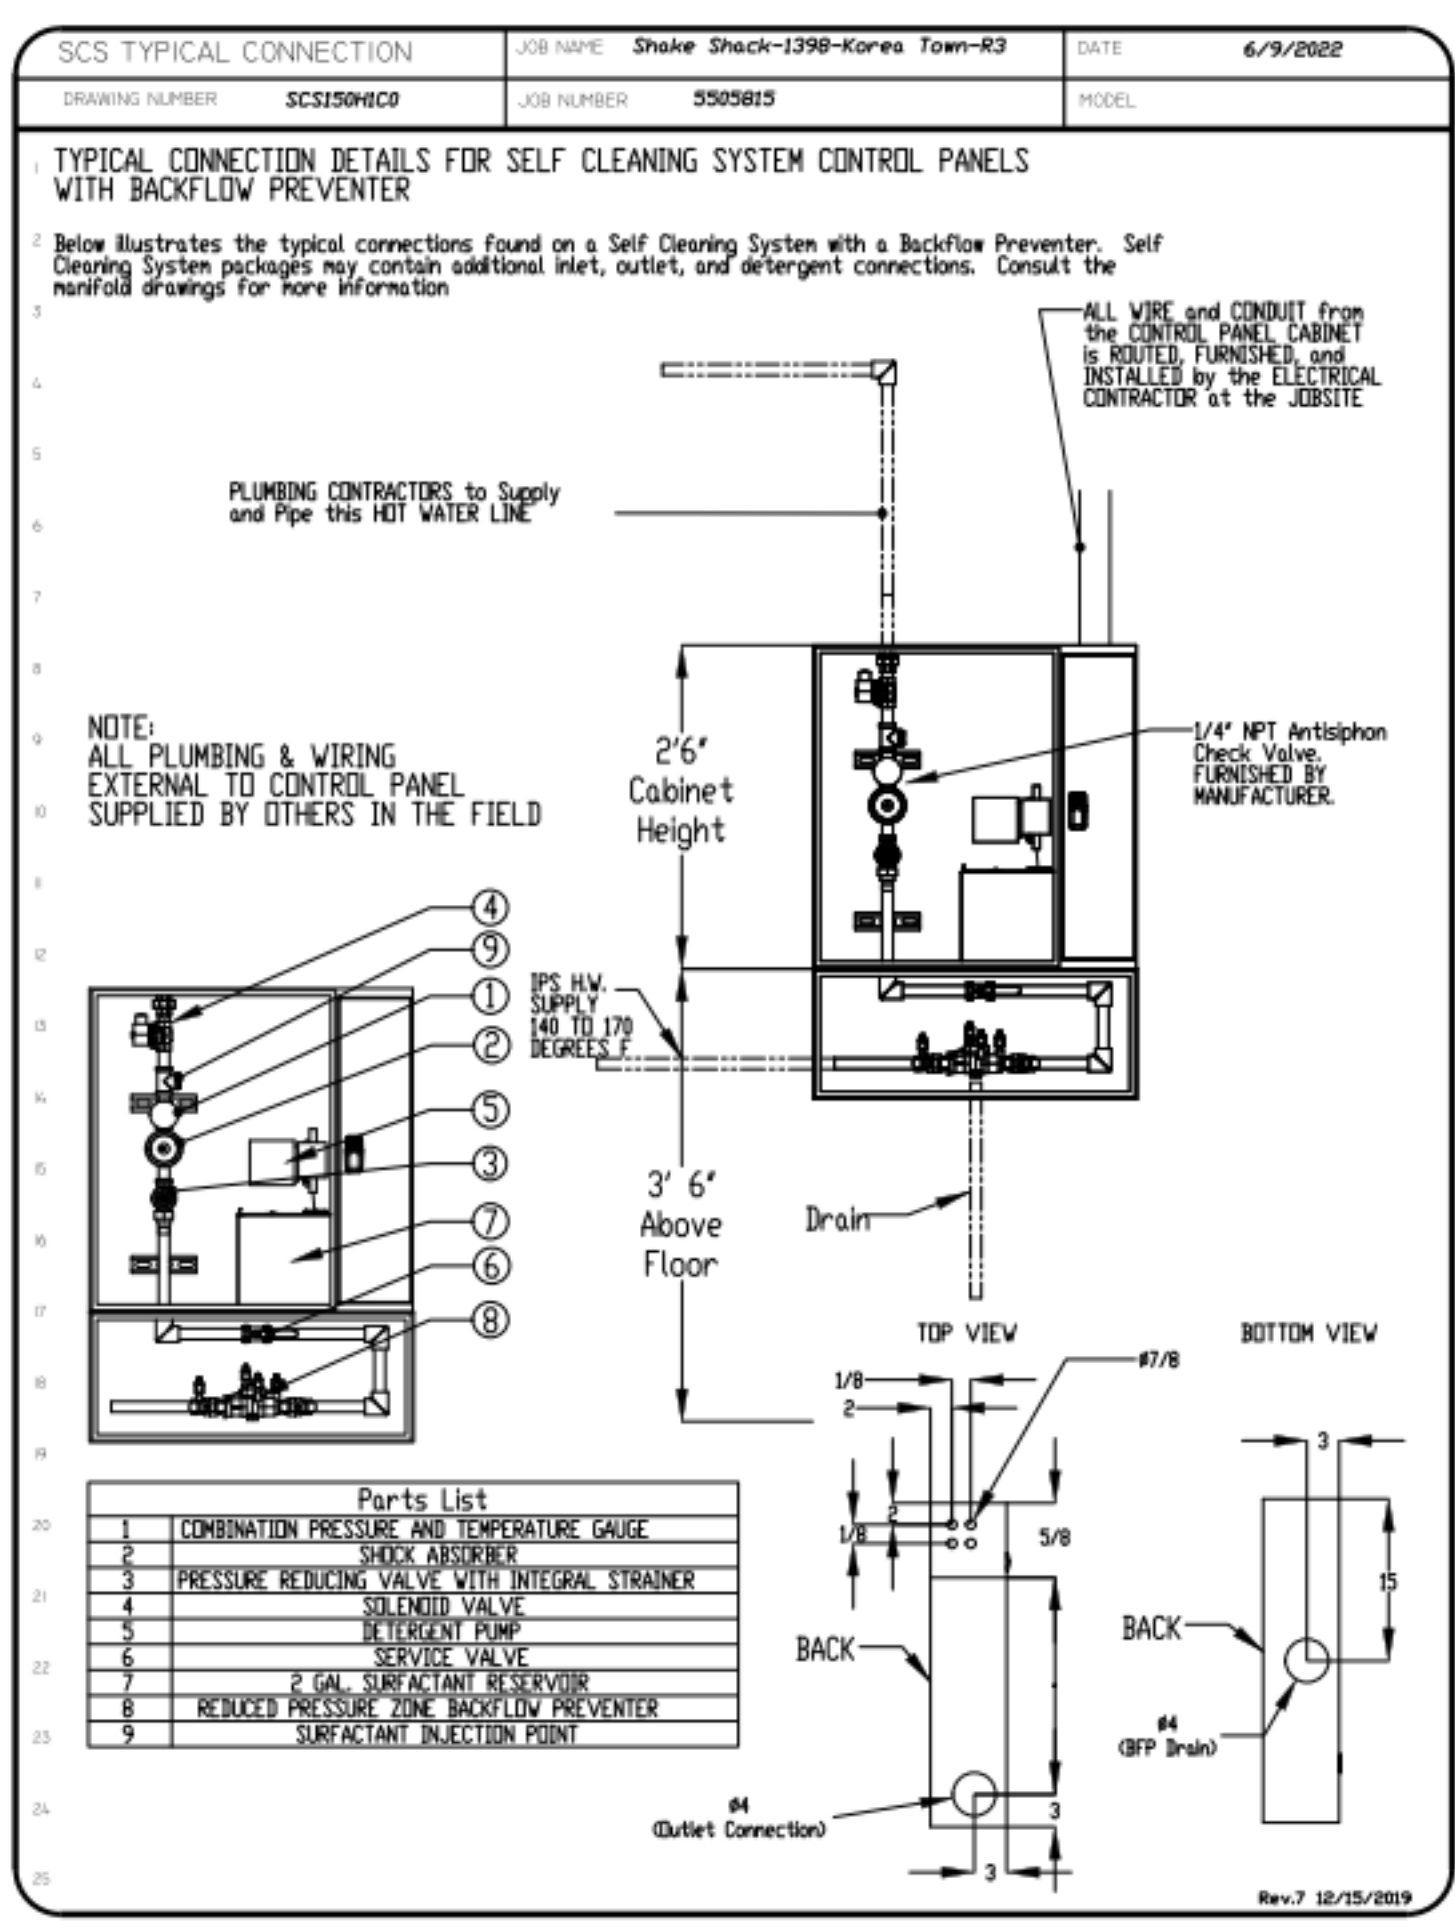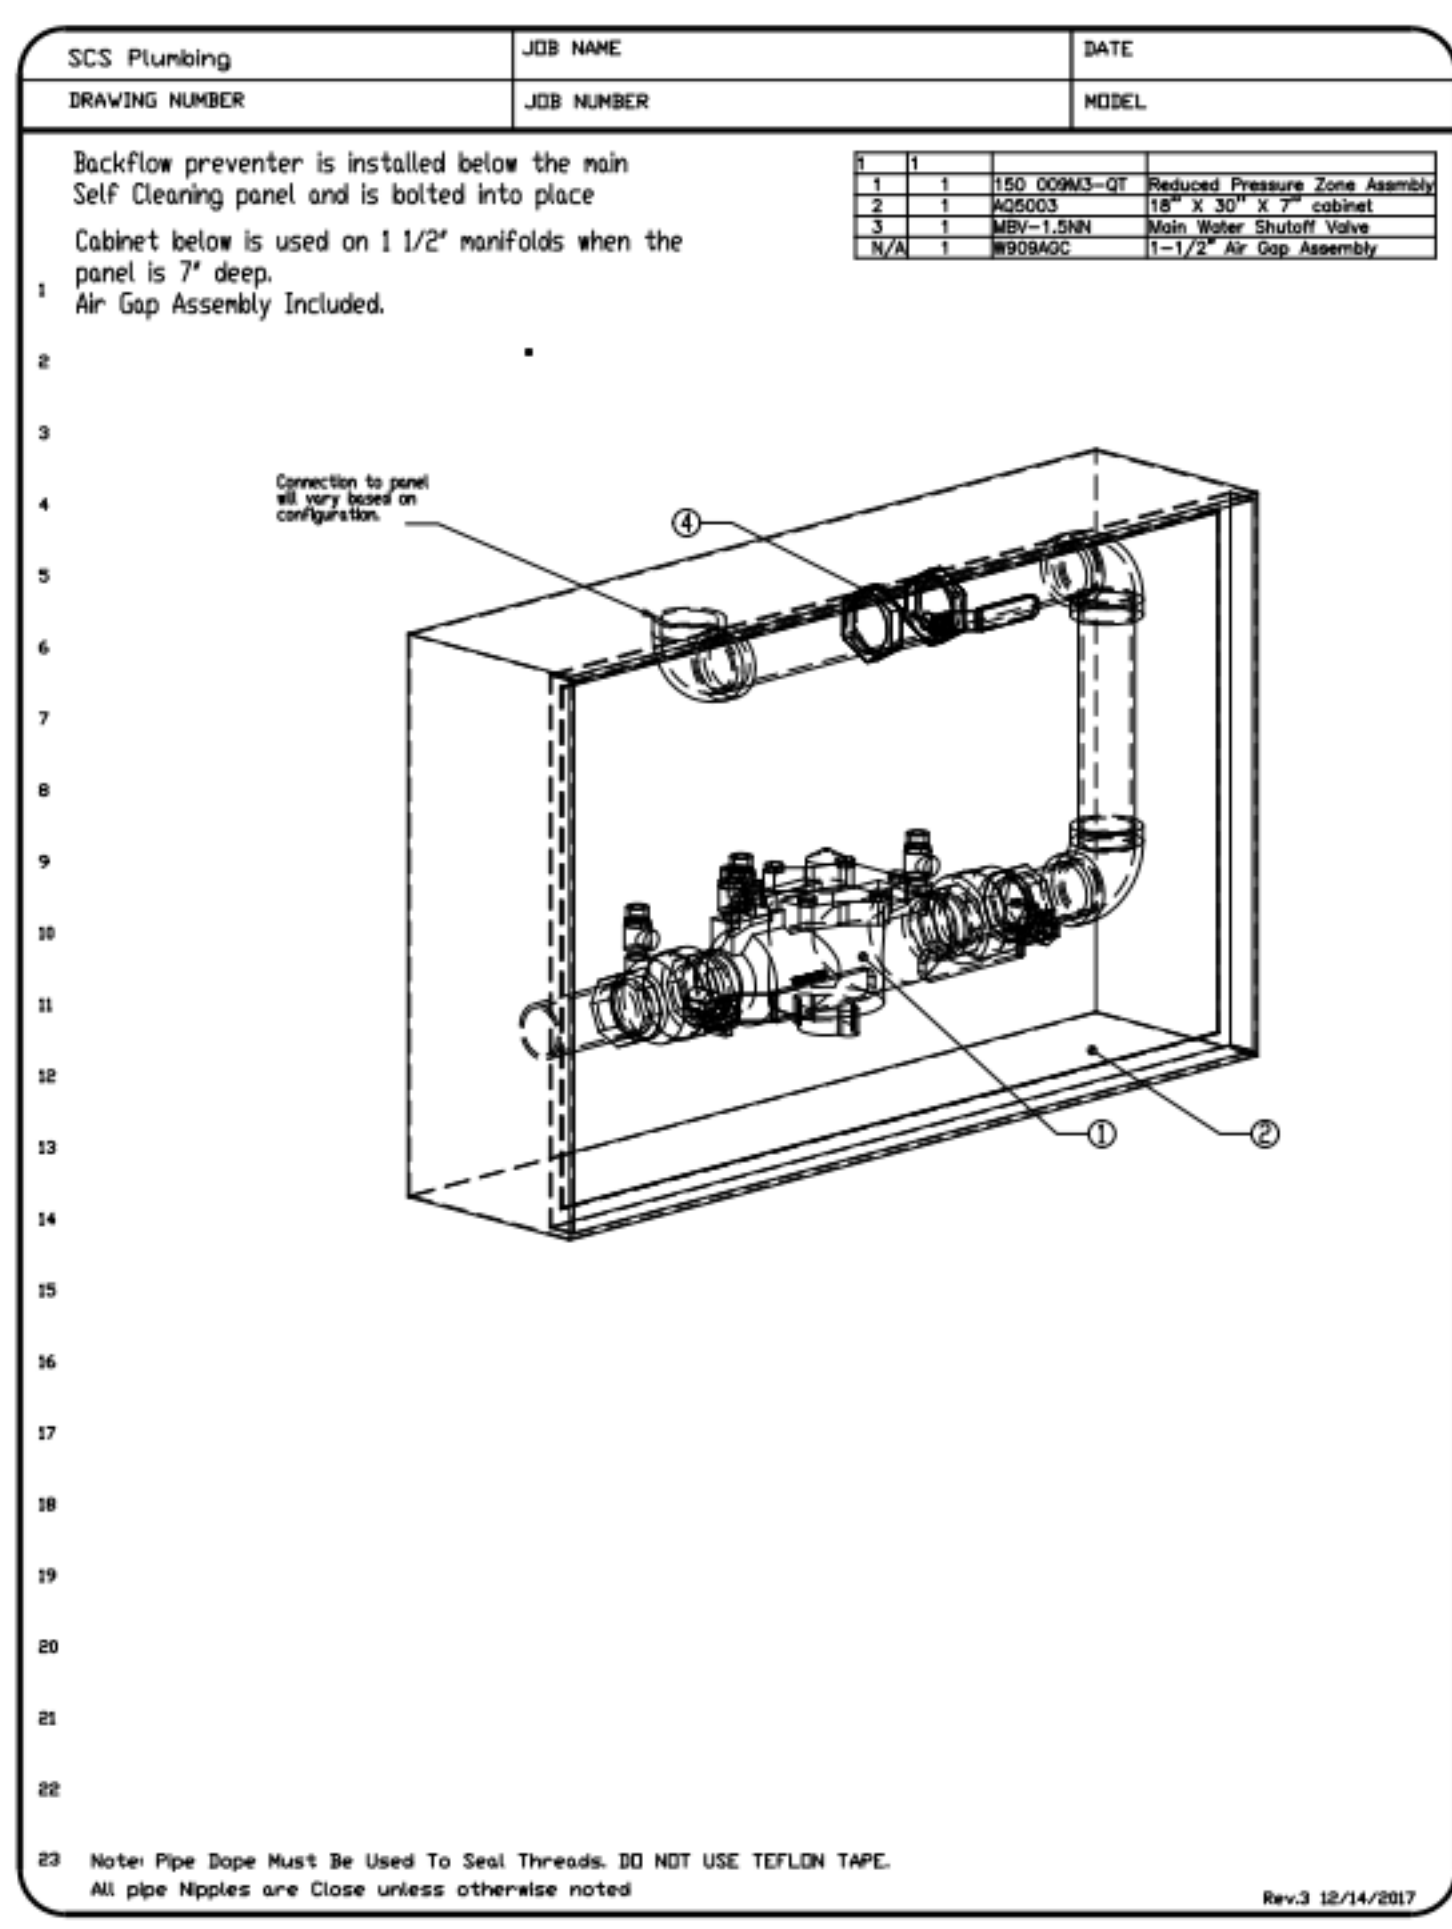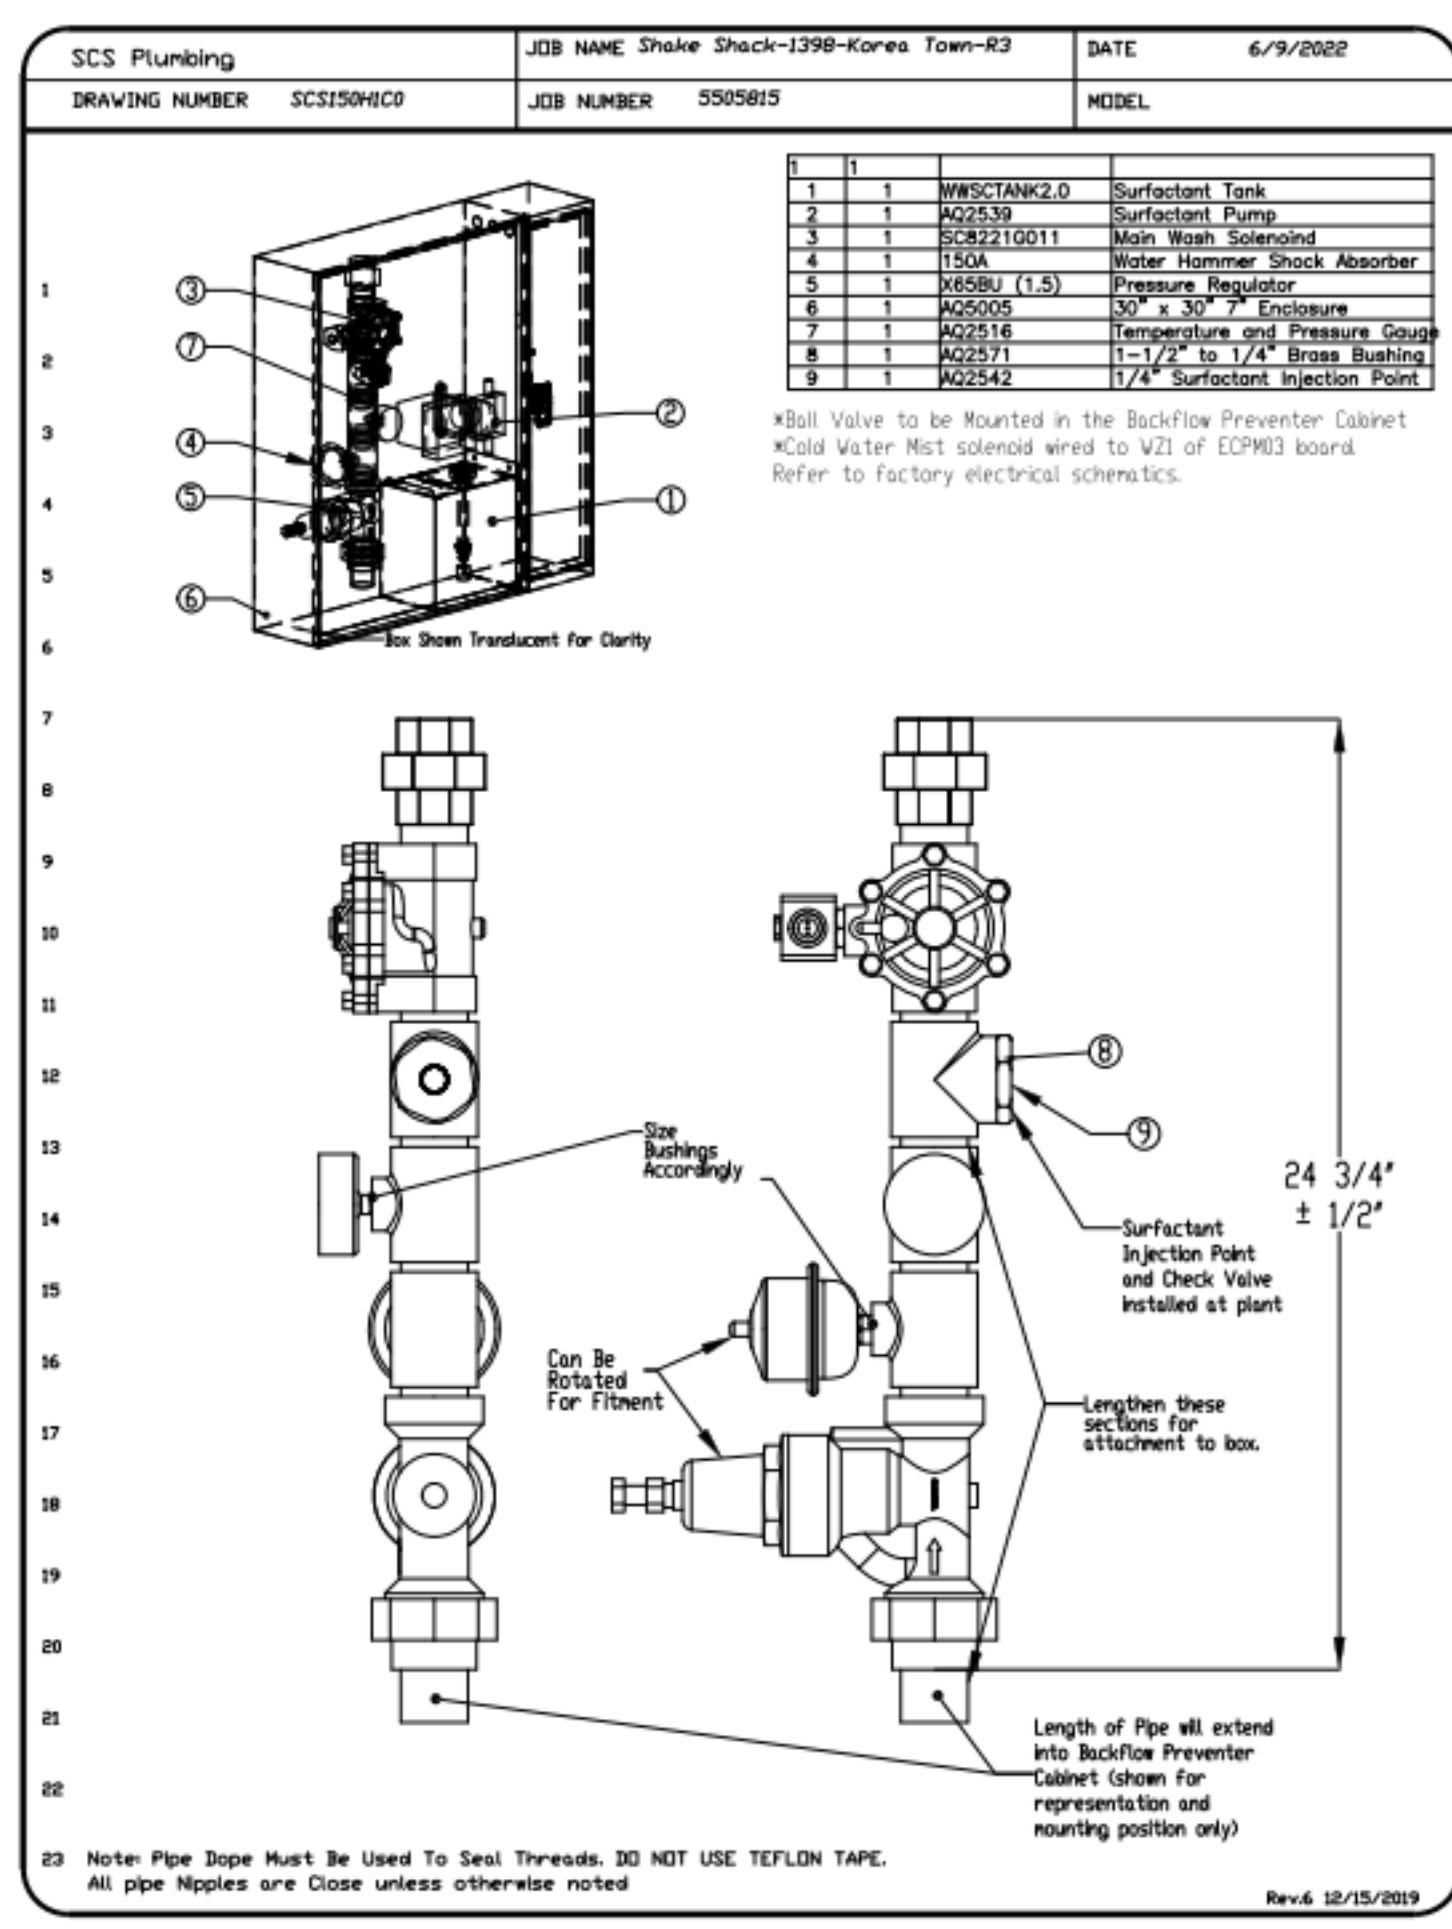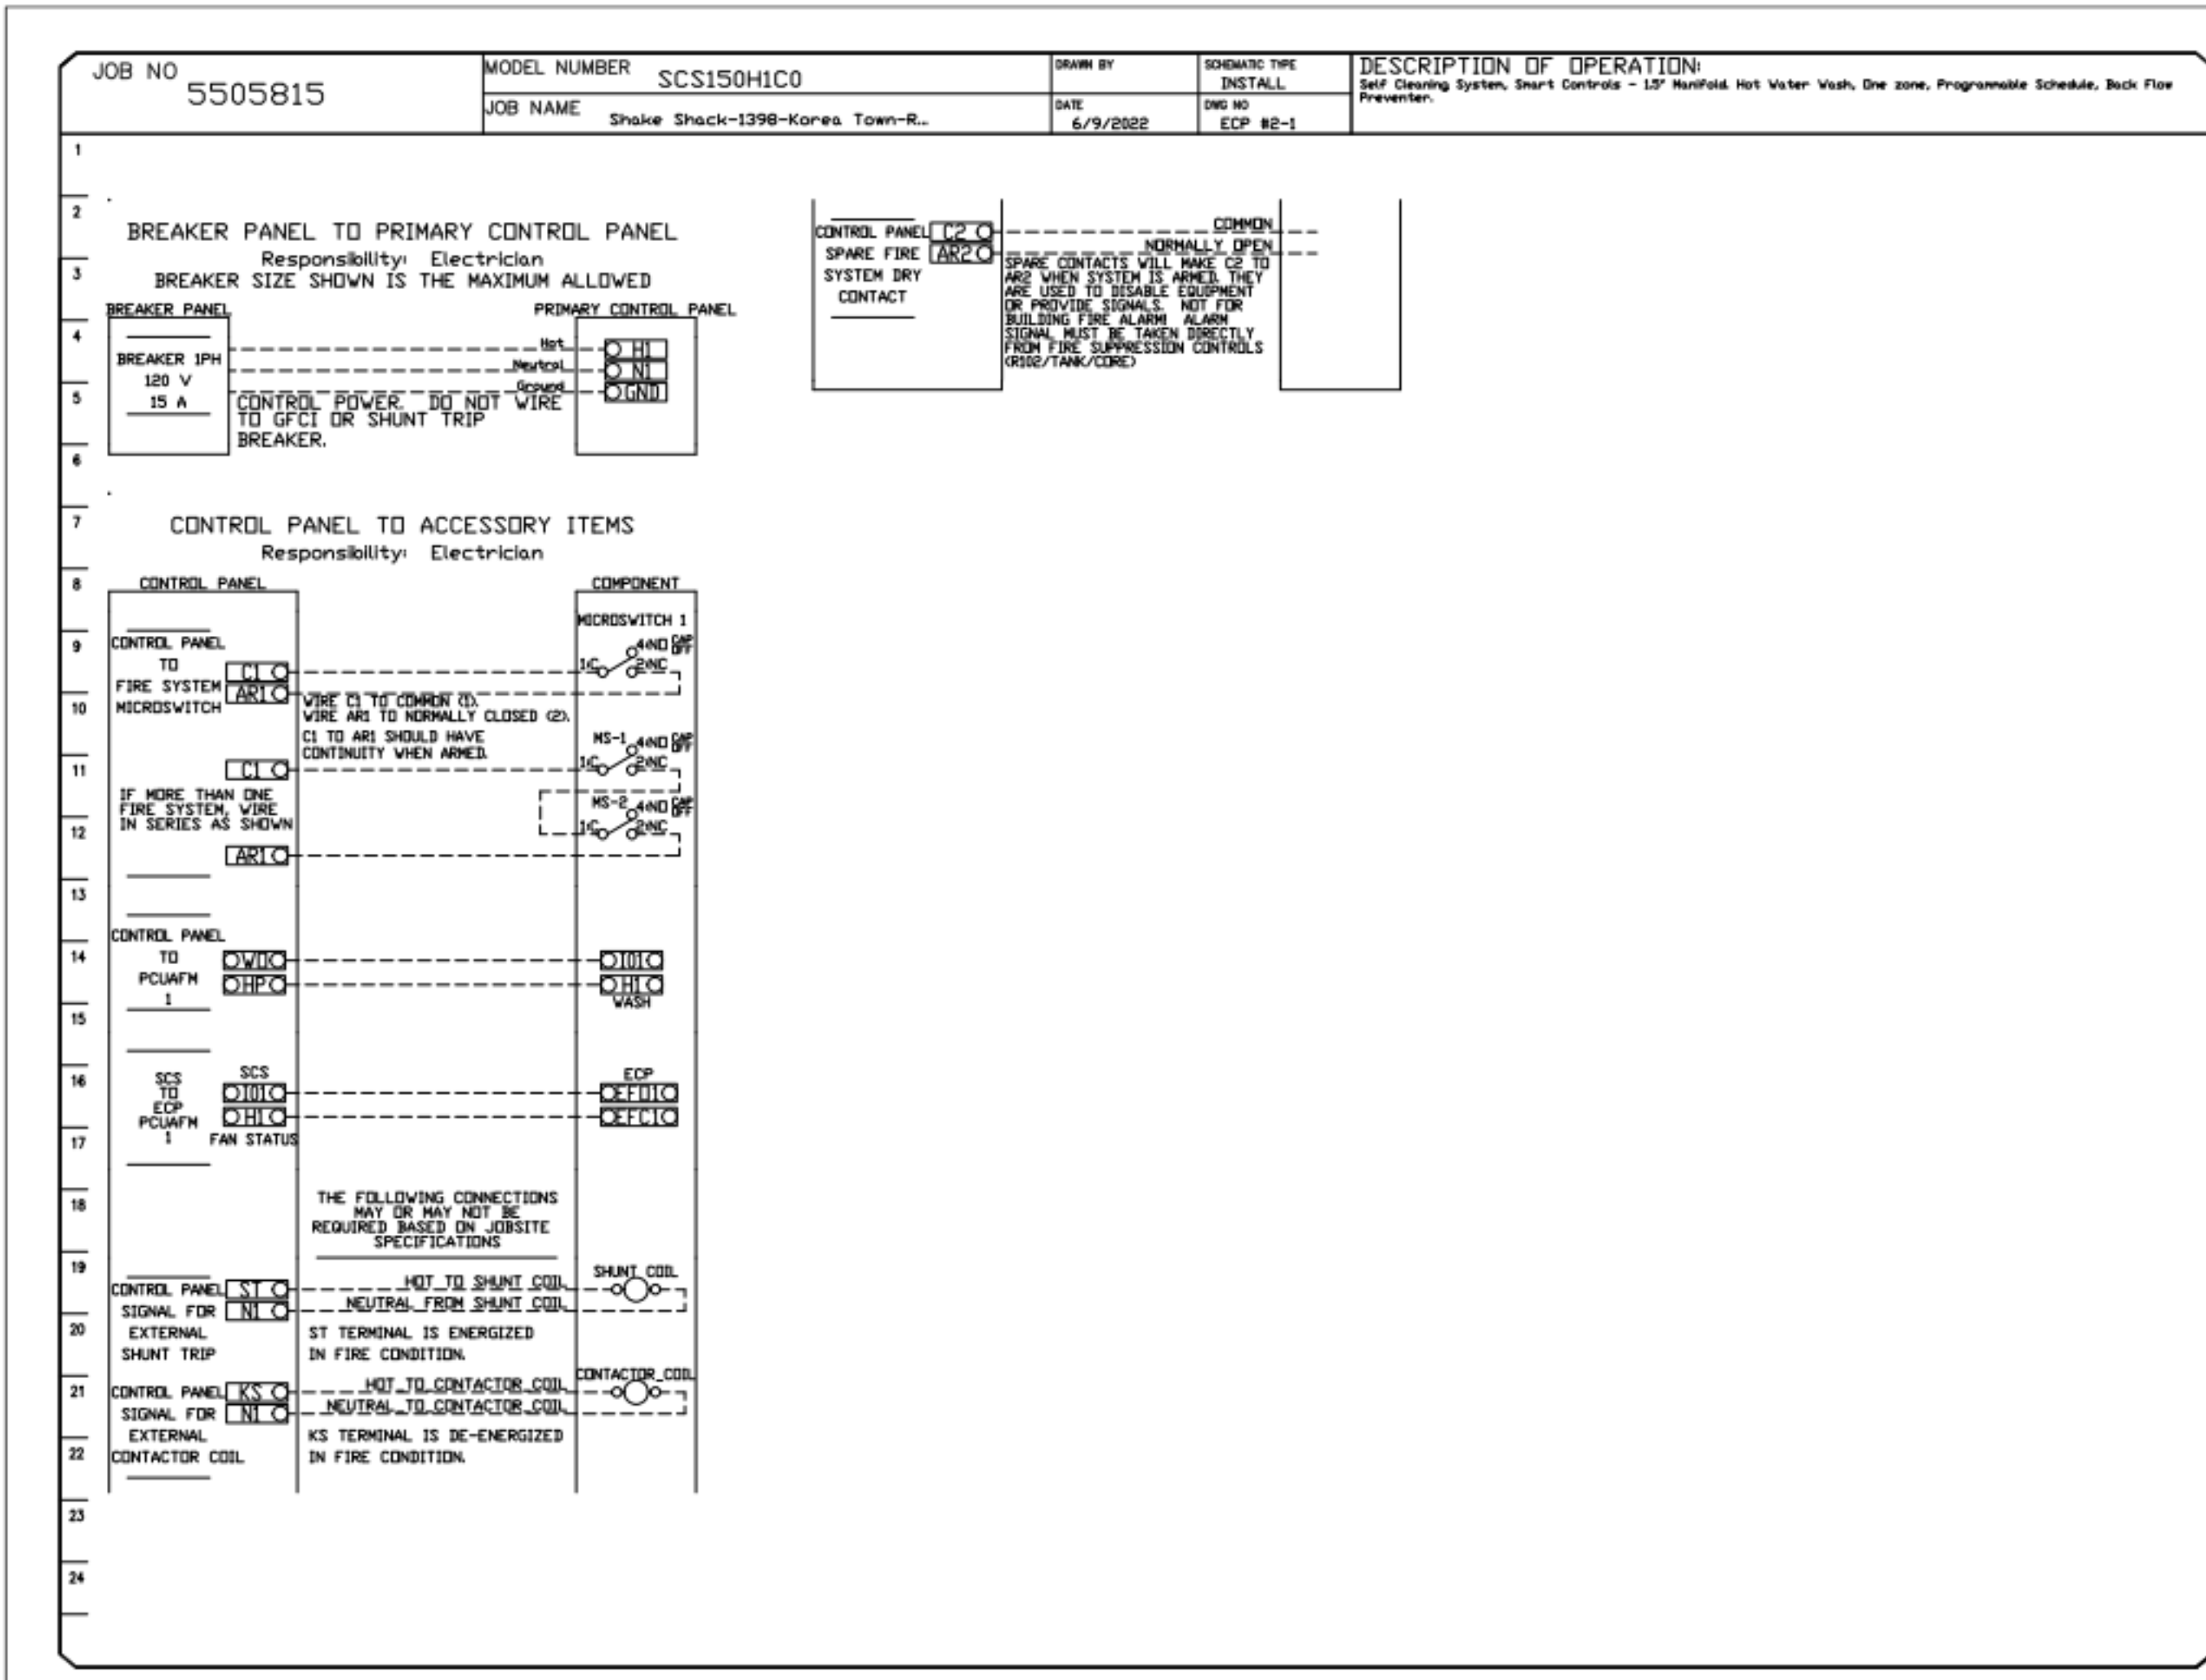

STORE NO: CA #1398

SHAKE SHACK
 SHAKE SHACK - KOREA TOWN
 376 WILSHIRE BLVD. LOS ANGELES, CA 90010

REVISION

NO.	DATE	DESCRIPTION
1	11/08/21	PERMIT/BID SET
A	01/26/22	REVISION A
T	07/01/22	REVISION T
4	09/16/22	REVISION 4

STATUS: PERMIT/BID SET

PRELIMINARY:
 Preliminary Documents Are For Design Review only and not intended for bidding, permitting, or construction purposes. They were prepared by or under the supervision of Zebra Projects, Inc.

PROFESSIONAL ENGINEER
 M.3.B.2.4.4
 ED MANNING
 STATE OF CALIFORNIA

FIELD VERIFICATION:
 The contractor shall verify all signed dimensions and conditions at the project site and notify Zebra Projects, Inc. of any dimensional errors, or omissions or discrepancies. Notice beginning of fabricating any work. Do not scale these drawings.

COPYRIGHT © 2021:
 Zebra Projects, Inc. shall retain all common law, statutory, and all other reserved rights. Neither the documents nor the information herein is to be reproduced, distributed, disclosed or otherwise used without the written consent of Zebra Projects, Inc.

SHEET NAME: CAPTIVEAIRE DRAWINGS

DATE: 11/08/21 PROJECT NO: SHK-21-008
 DRAWN: SK SCALE: NTS


SHEET NO: M809

System Design Verification (SDV)



If ordered, CAS Service will perform a System Design Verification (SDV) once all equipment has had a complete start up per the Operation and Installation Manual. Typically, the SDV will be performed after all inspections are complete.

Any field related discrepancies that are discovered during the SDV will be brought to the attention of the general contractor and corresponding trades on site. These issues will be documented and forwarded to the appropriate sales office. If CAS Service has to resolve a discrepancy that is a field issue, the general contractor will be notified and billed for the work. Should a return trip be required due to any field related discrepancy that cannot be resolved during the SDV, there will be additional trip charges.

During the SDV, CAS Service will address any discrepancy that is the fault of the manufacturer. Should a return trip be required, the general contractor and appropriate sales office will be notified. There will be no additional charges for manufacturer discrepancies.

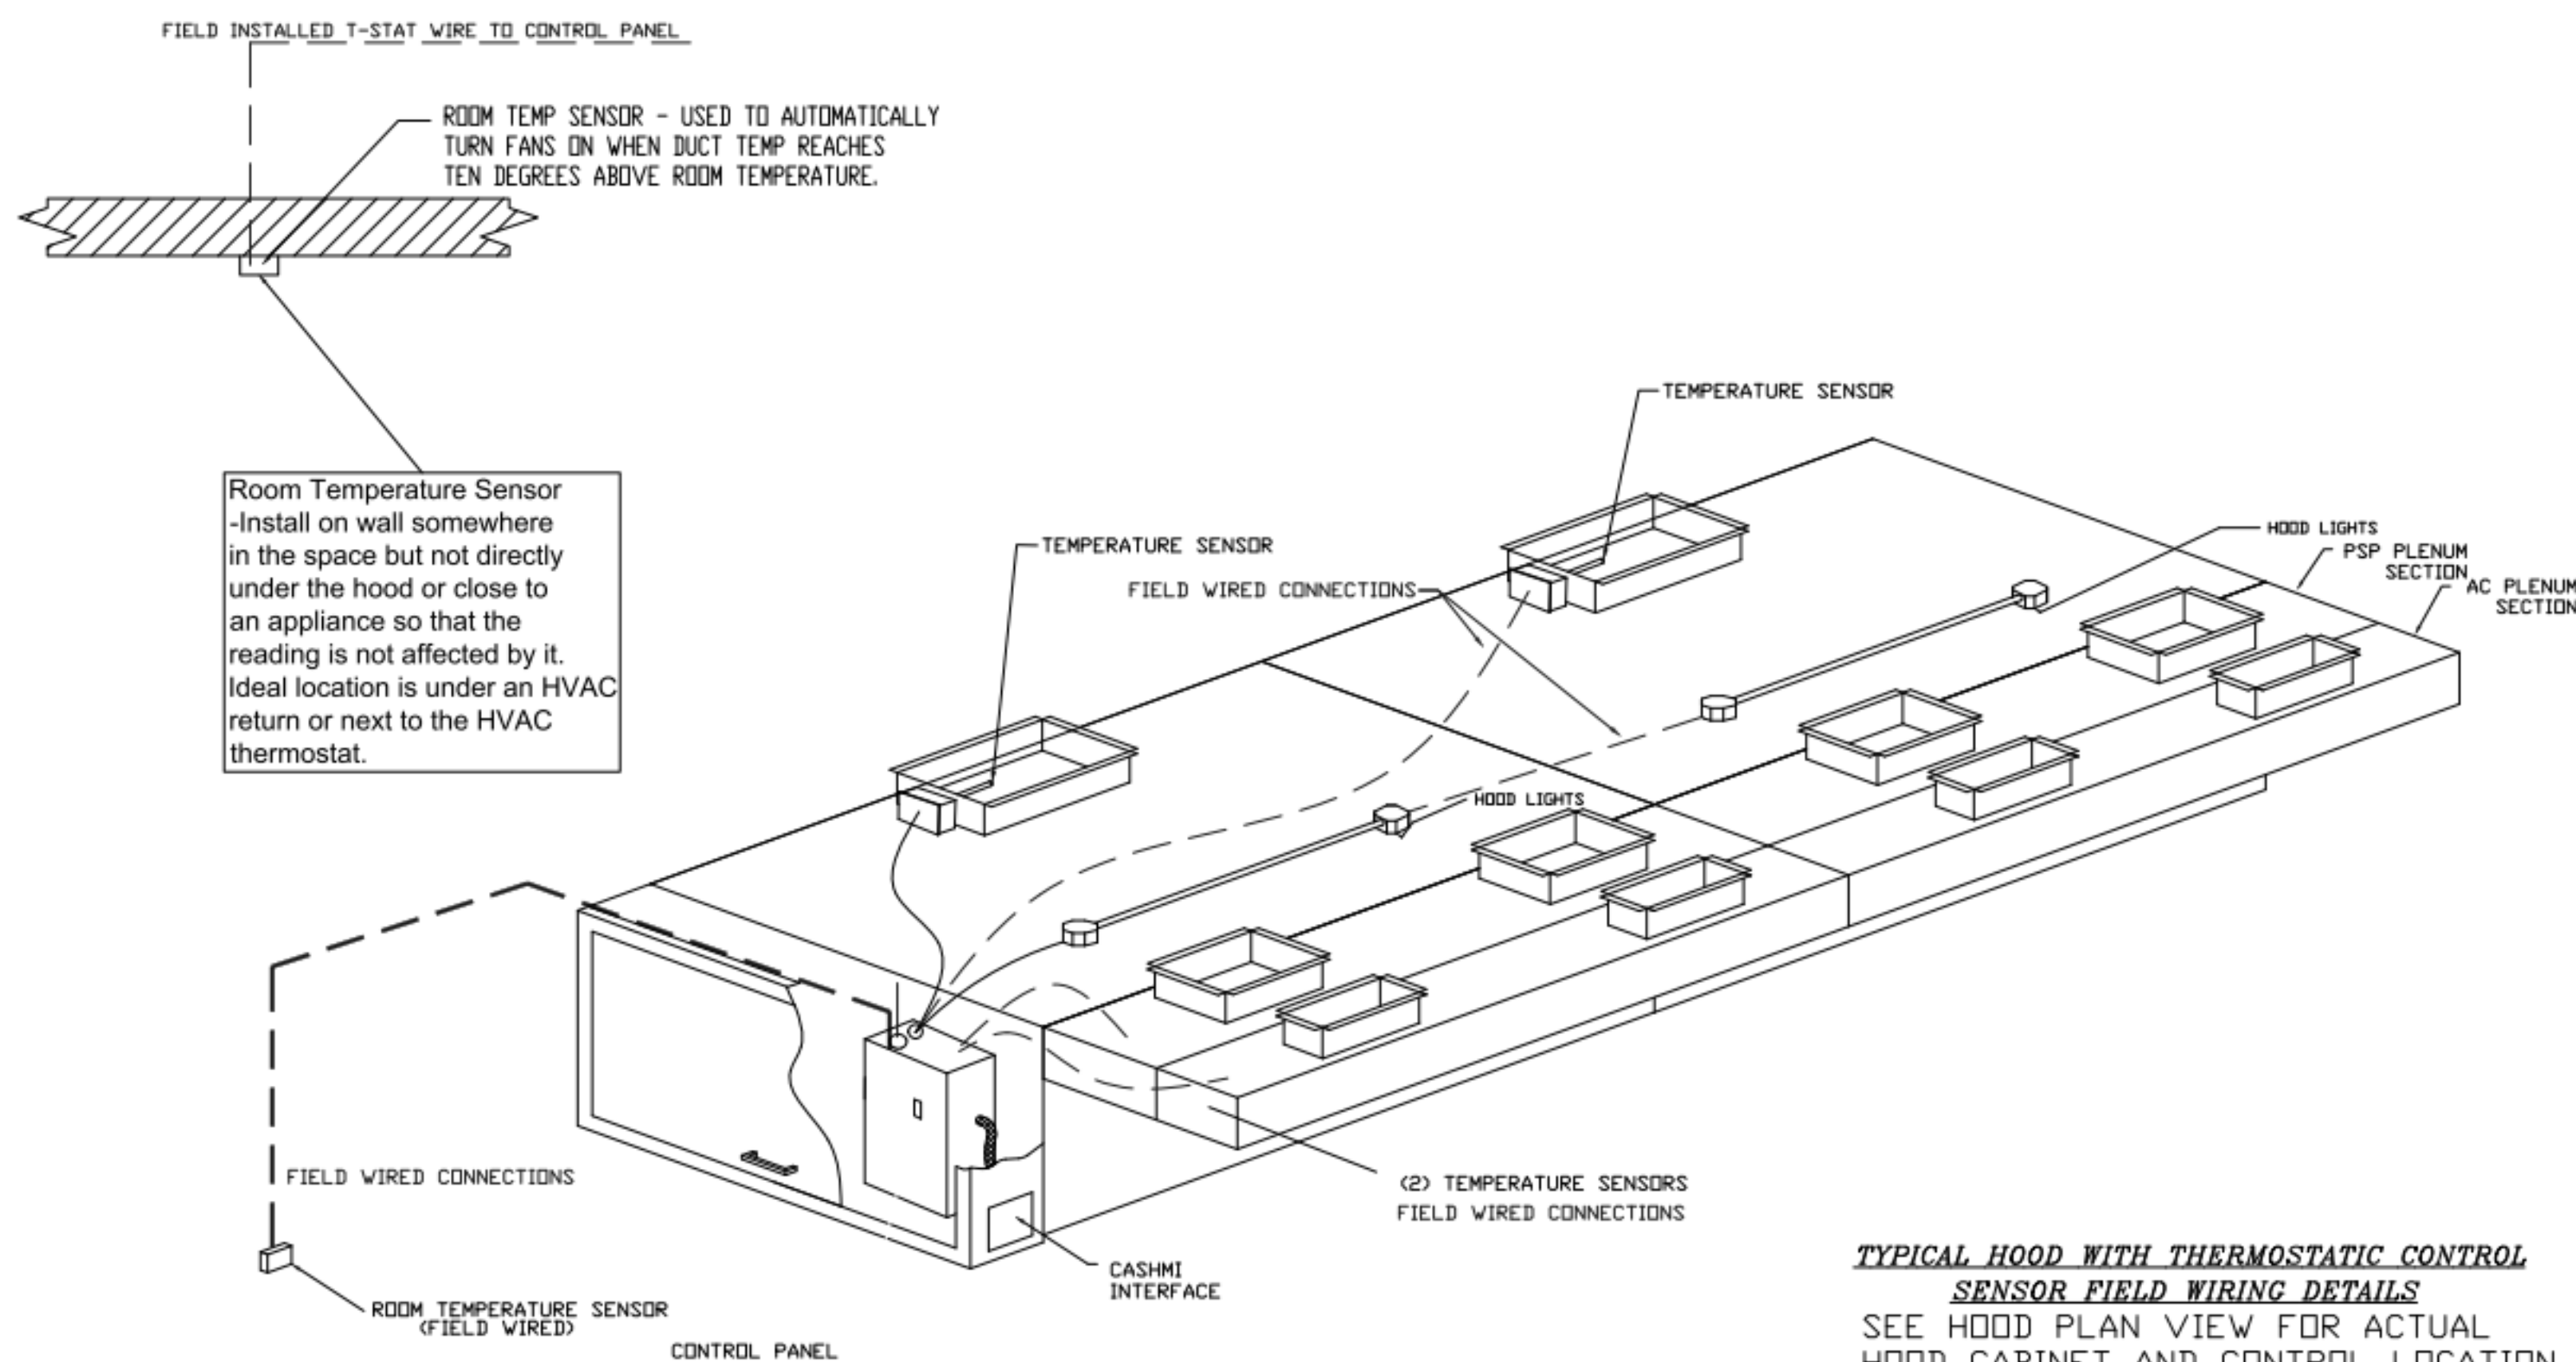

**TYPICAL HOOD WITH THERMOSTATIC CONTROL
SENSOR FIELD WIRING DETAILS**
SEE HOOD PLAN VIEW FOR ACTUAL
HOOD CABINET AND CONTROL LOCATION

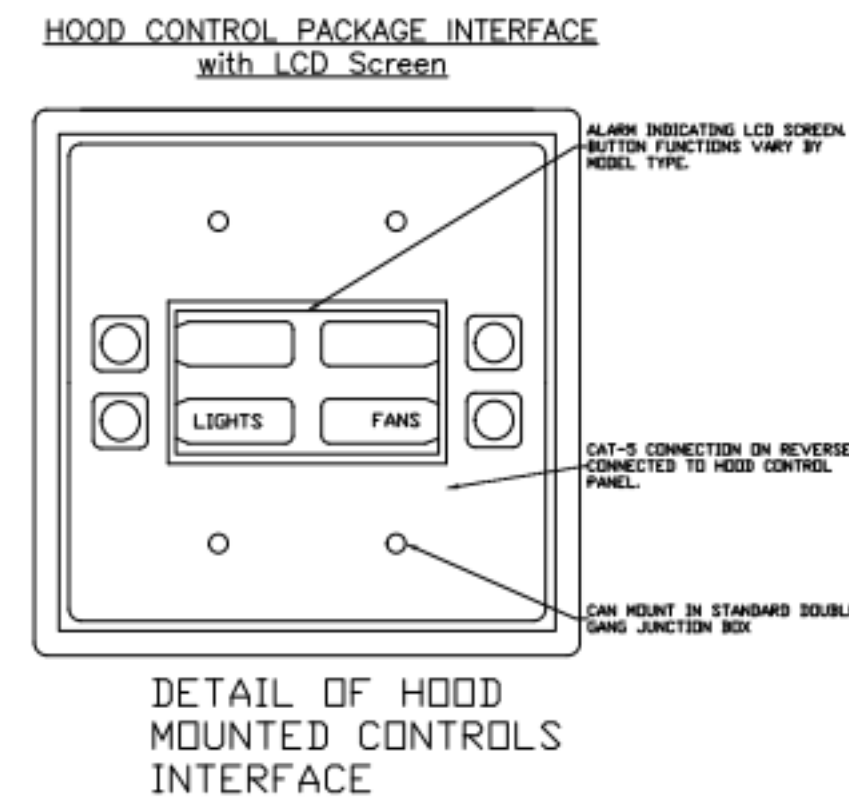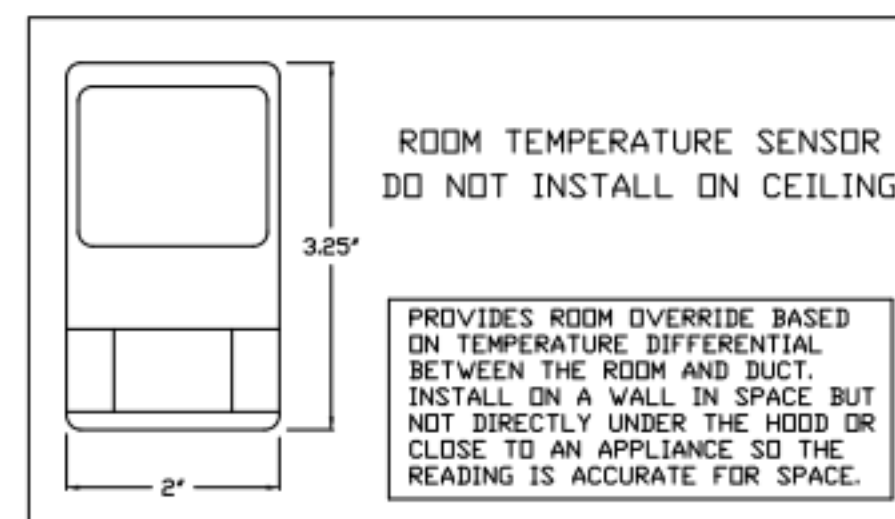

- FIELD WIRING
- (4) TEMP SENSORS TO CONTROL PANEL
 - REMOTE ROOM SENSOR TO CONTROL PANEL

NOTE: TEMP SENSOR IN HOOD THAT DOES NOT HAVE BUILT IN END CABINET AND ROOM TEMP SENSOR MUST BE FIELD WIRED TO CONTROL PANEL

SC- Specification:

The Electrical Package, typically FP, is designed to thermostatically activate the exhaust fans for an exhaust hood whenever elevated temperatures are sensed in the exhaust system. This option will meet the requirements of IMC 507.2.1.1 by providing a thermostat(s) mounted in the duct or hood riser to sense increased exhaust temperatures. Controls shall be listed by ETL (UL 508A). The control enclosure shall be NEMA 1 rated and listed for installation inside of the exhaust hood utility cabinet. The control enclosure may be constructed of stainless steel or painted steel.

Temperature probes(s) located in the duct riser shall be constructed of Stainless Steel. A room temperature sensor is also provided for field installation in the kitchen space in order to start the fan(s) based on the temperature differential between the room and the exhaust air in the duct, rather than fixed set-points. The system is factory pre-set to activate the fans at 10 deg F° above the room temperature.

Once the duct temperature reaches the activation point, the exhaust fans will be activated. The controls also provide hysteresis to prevent cycling of the fans after the cooking appliances have been turned off and the heat in the exhaust system is reduced. The hysteresis is factory set 2 degrees and will keep the exhaust running until the temperature falls 2 degrees below the activation set point. A hysteresis timer also exists to keep the fans running for at least 30 min after being activated by the temperature rise.

The activation and hysteresis settings may be field adjusted on the board LCD interface located inside the control enclosure to meet application needs. The panel is factory configured to shut down supply fans, turn on the exhaust fans and turn off the hood lights in a fire condition.

REVISIONS	
DESCRIPTION	DATE



Shake Shack-1398-Korea Town-R3
LOS ANGELES, CA, 90010

DATE: 6/9/2022
DWG.#: 5505815
DRAWN BY: EB-108
SCALE: 3/4" = 1'-0"
MASTER DRAWING


SHEET NO. 10

STORE NO: CA #1398



REVISION	
DATE	DESCRIPTION
11/08/21	PERMIT/BID SET
A 01/28/22	REVISION A
T 07/01/22	REVISION 1
4 09/16/22	REVISION 4

STATUS: PERMIT/BID SET




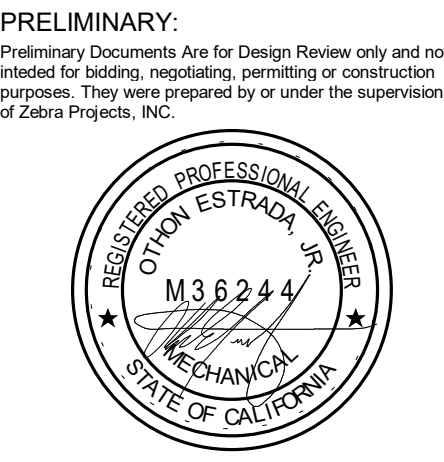


FIELD VERIFICATION:
The contractor shall verify all signed dimensions and condition at the project site and notify Zebra Projects, Inc. of any dimensional errors, or omissions or discrepancies. Notice beginning of indicating any work. Do not scale these drawings.
COPYRIGHT © 2021:
Zebra Projects, Inc. shall retain all common law, statutory and all other reserved rights. Neither the documents nor the information herein is to be reproduced, distributed, reflected or otherwise without the written consent of Zebra Projects, Inc.

SHEET NAME: CAPTIVEAIRE DRAWINGS

DATE: 11/08/21 PROJECT NO: SHK-21-008
DRAWN: SK SCALE: NTS

SHEET NO: M810

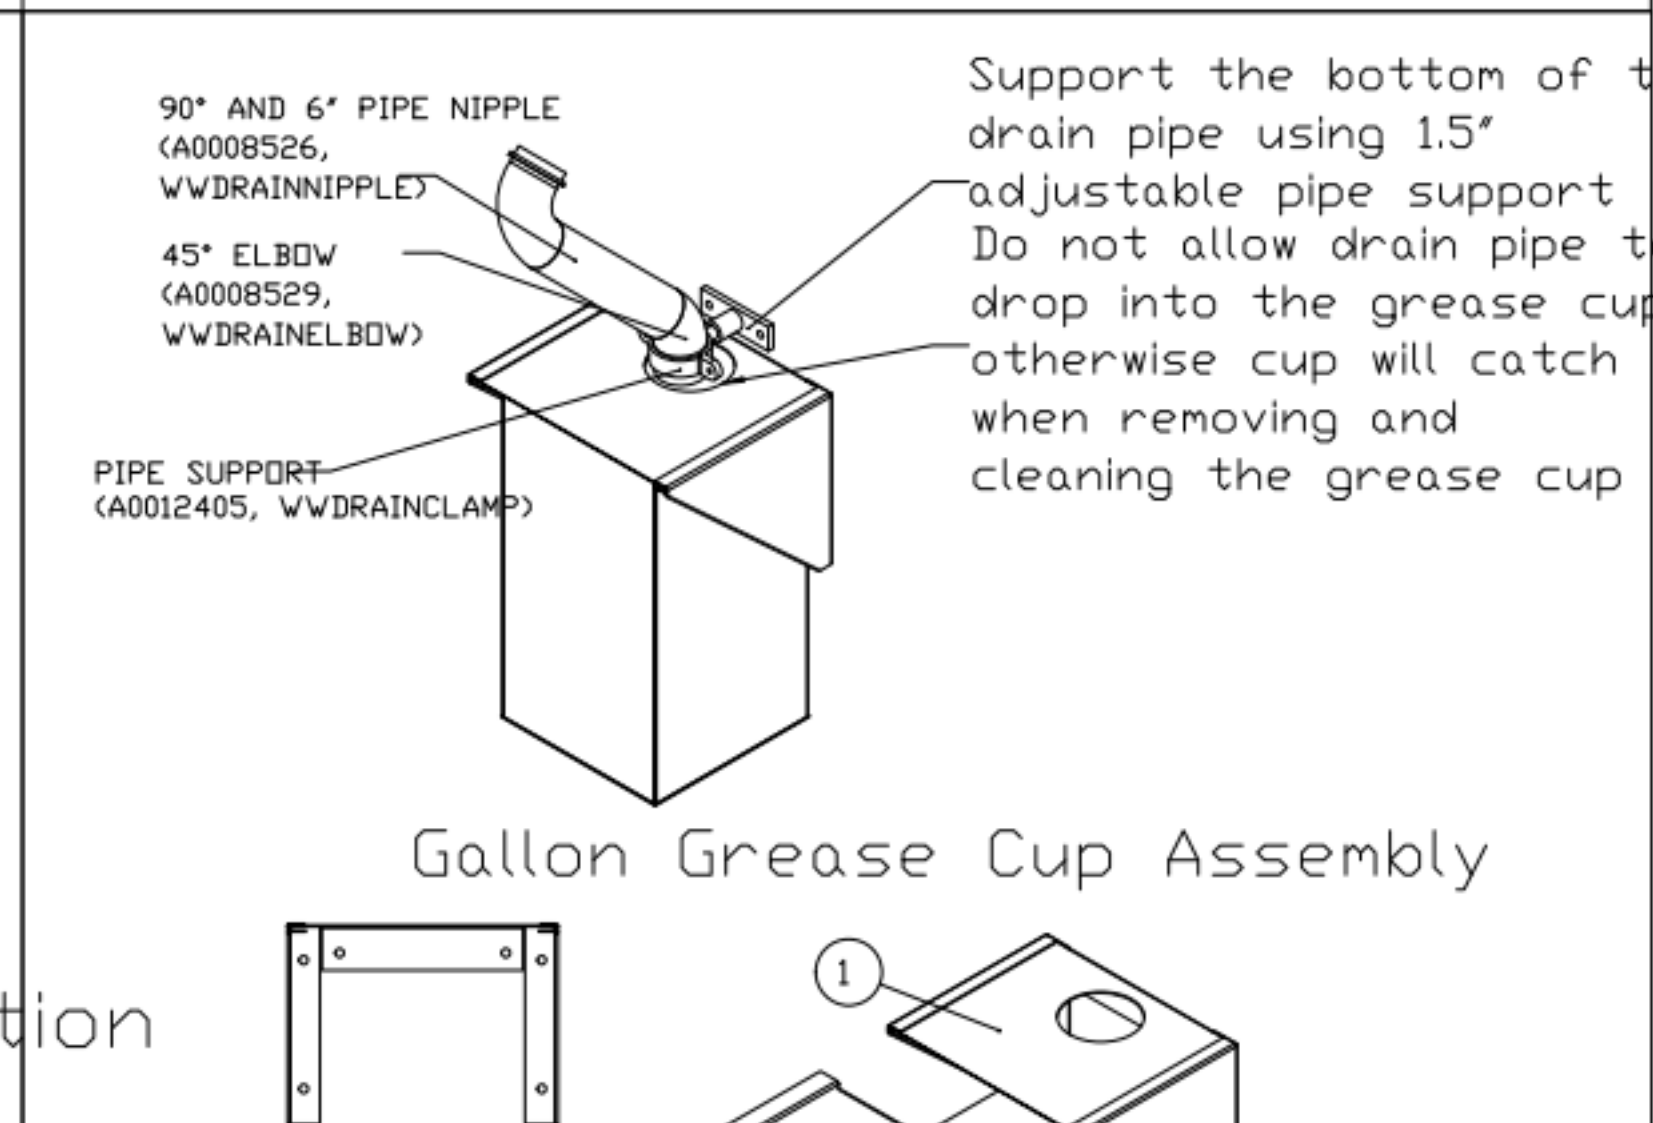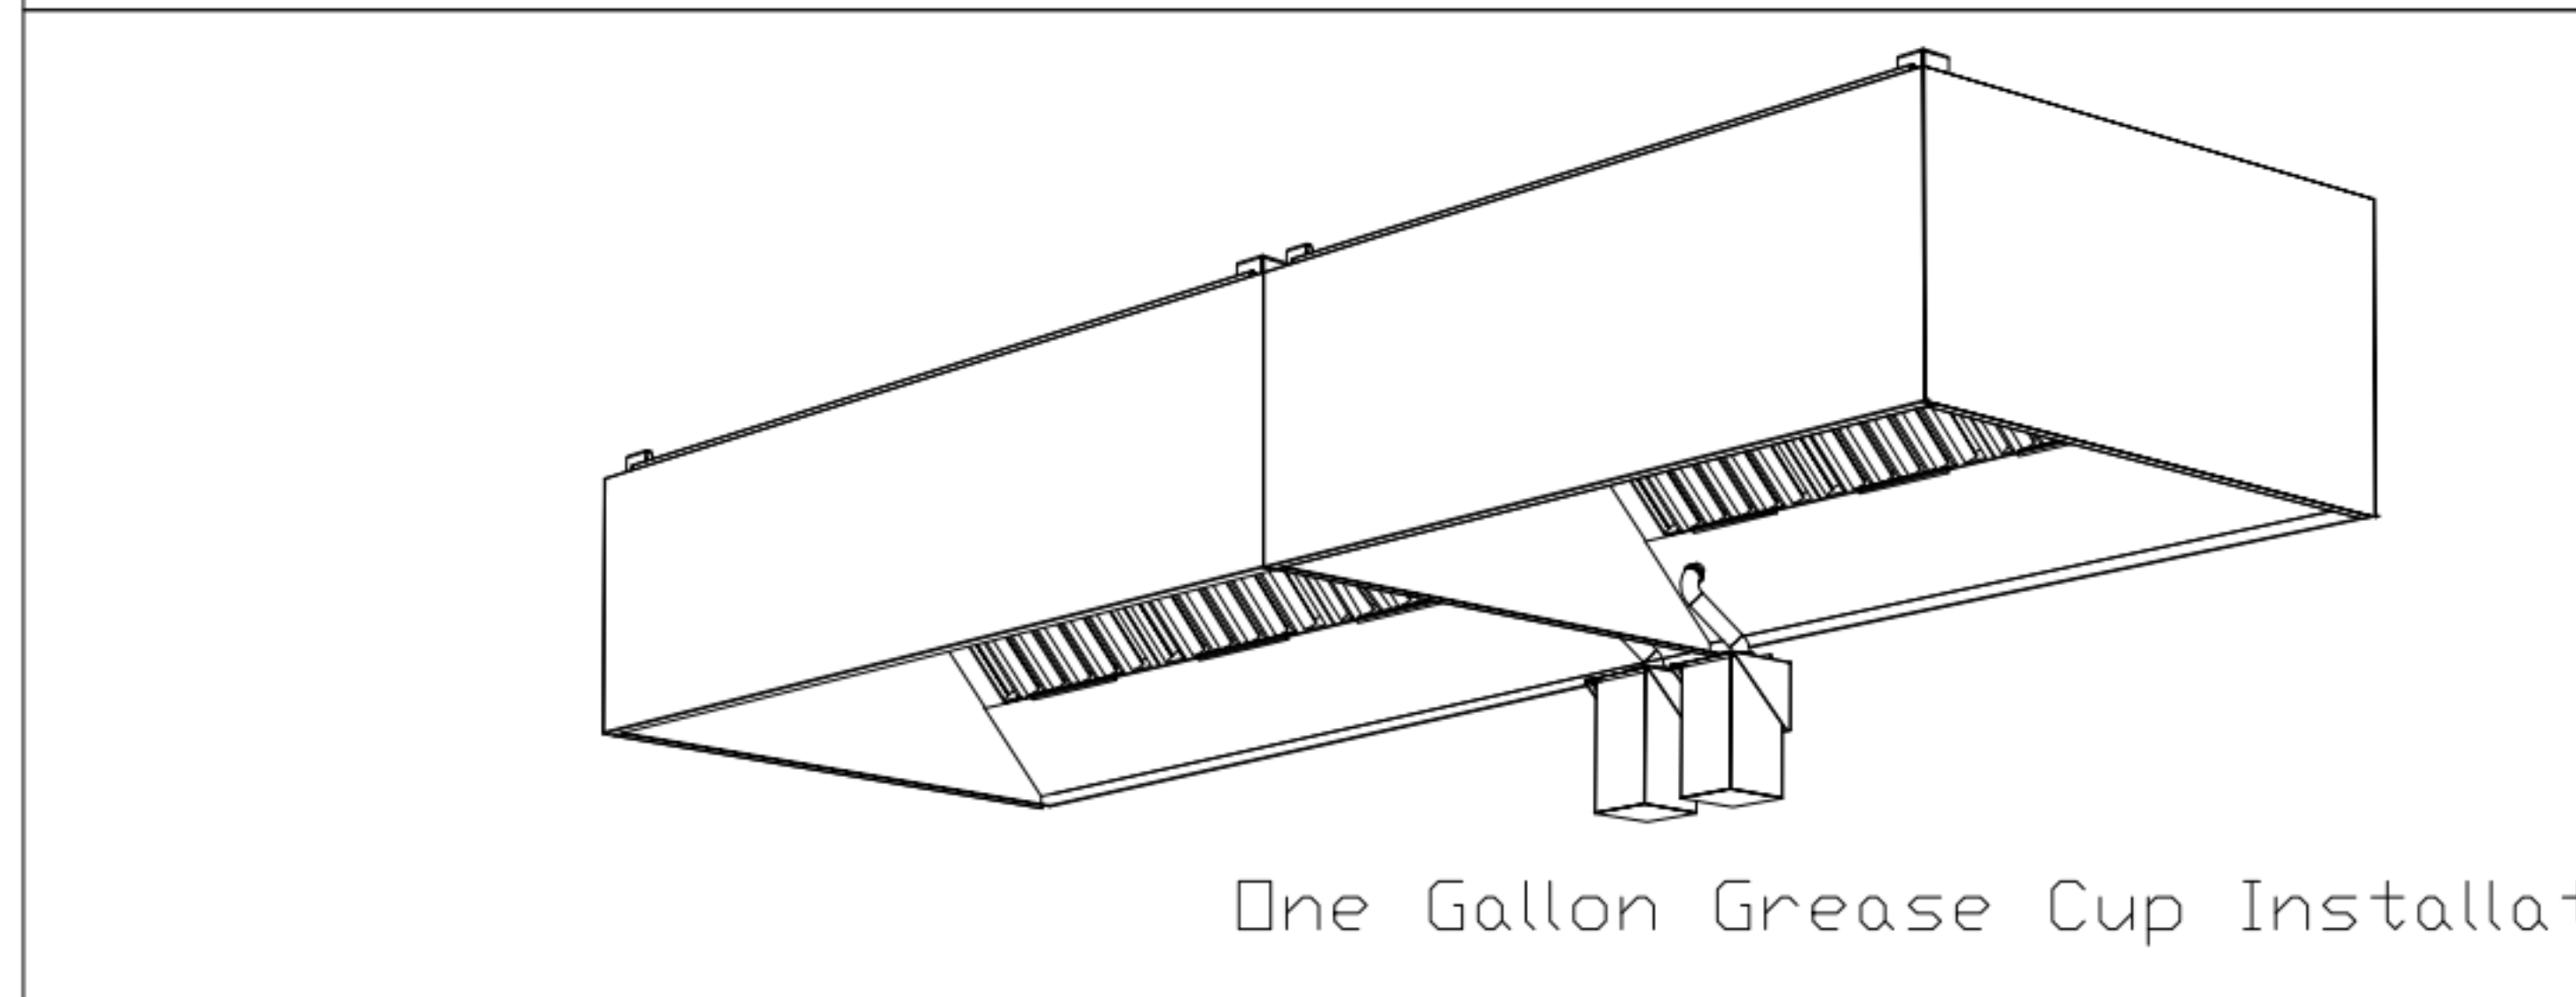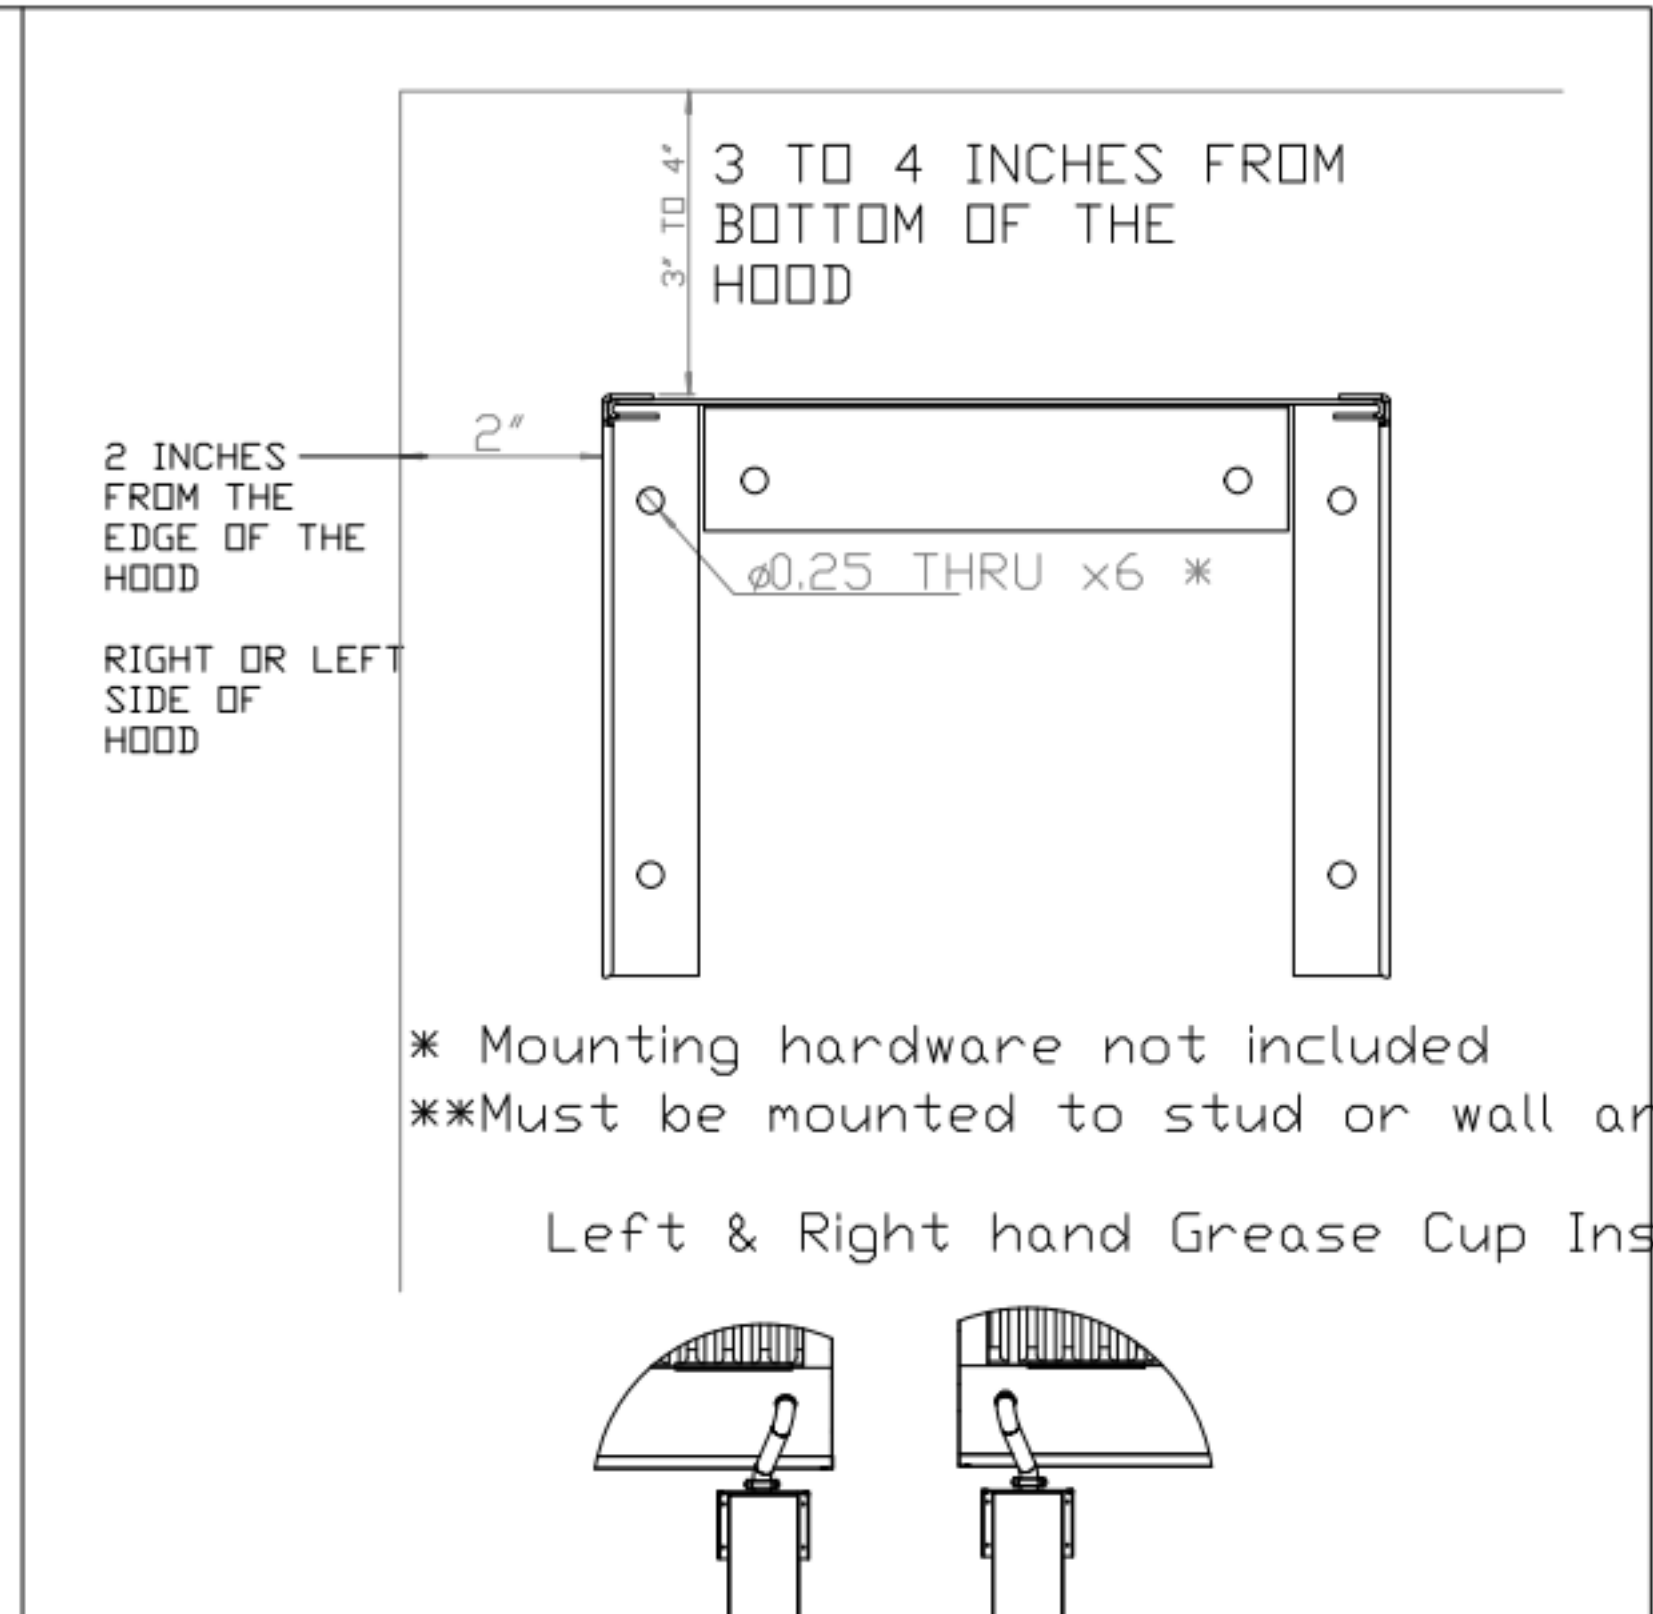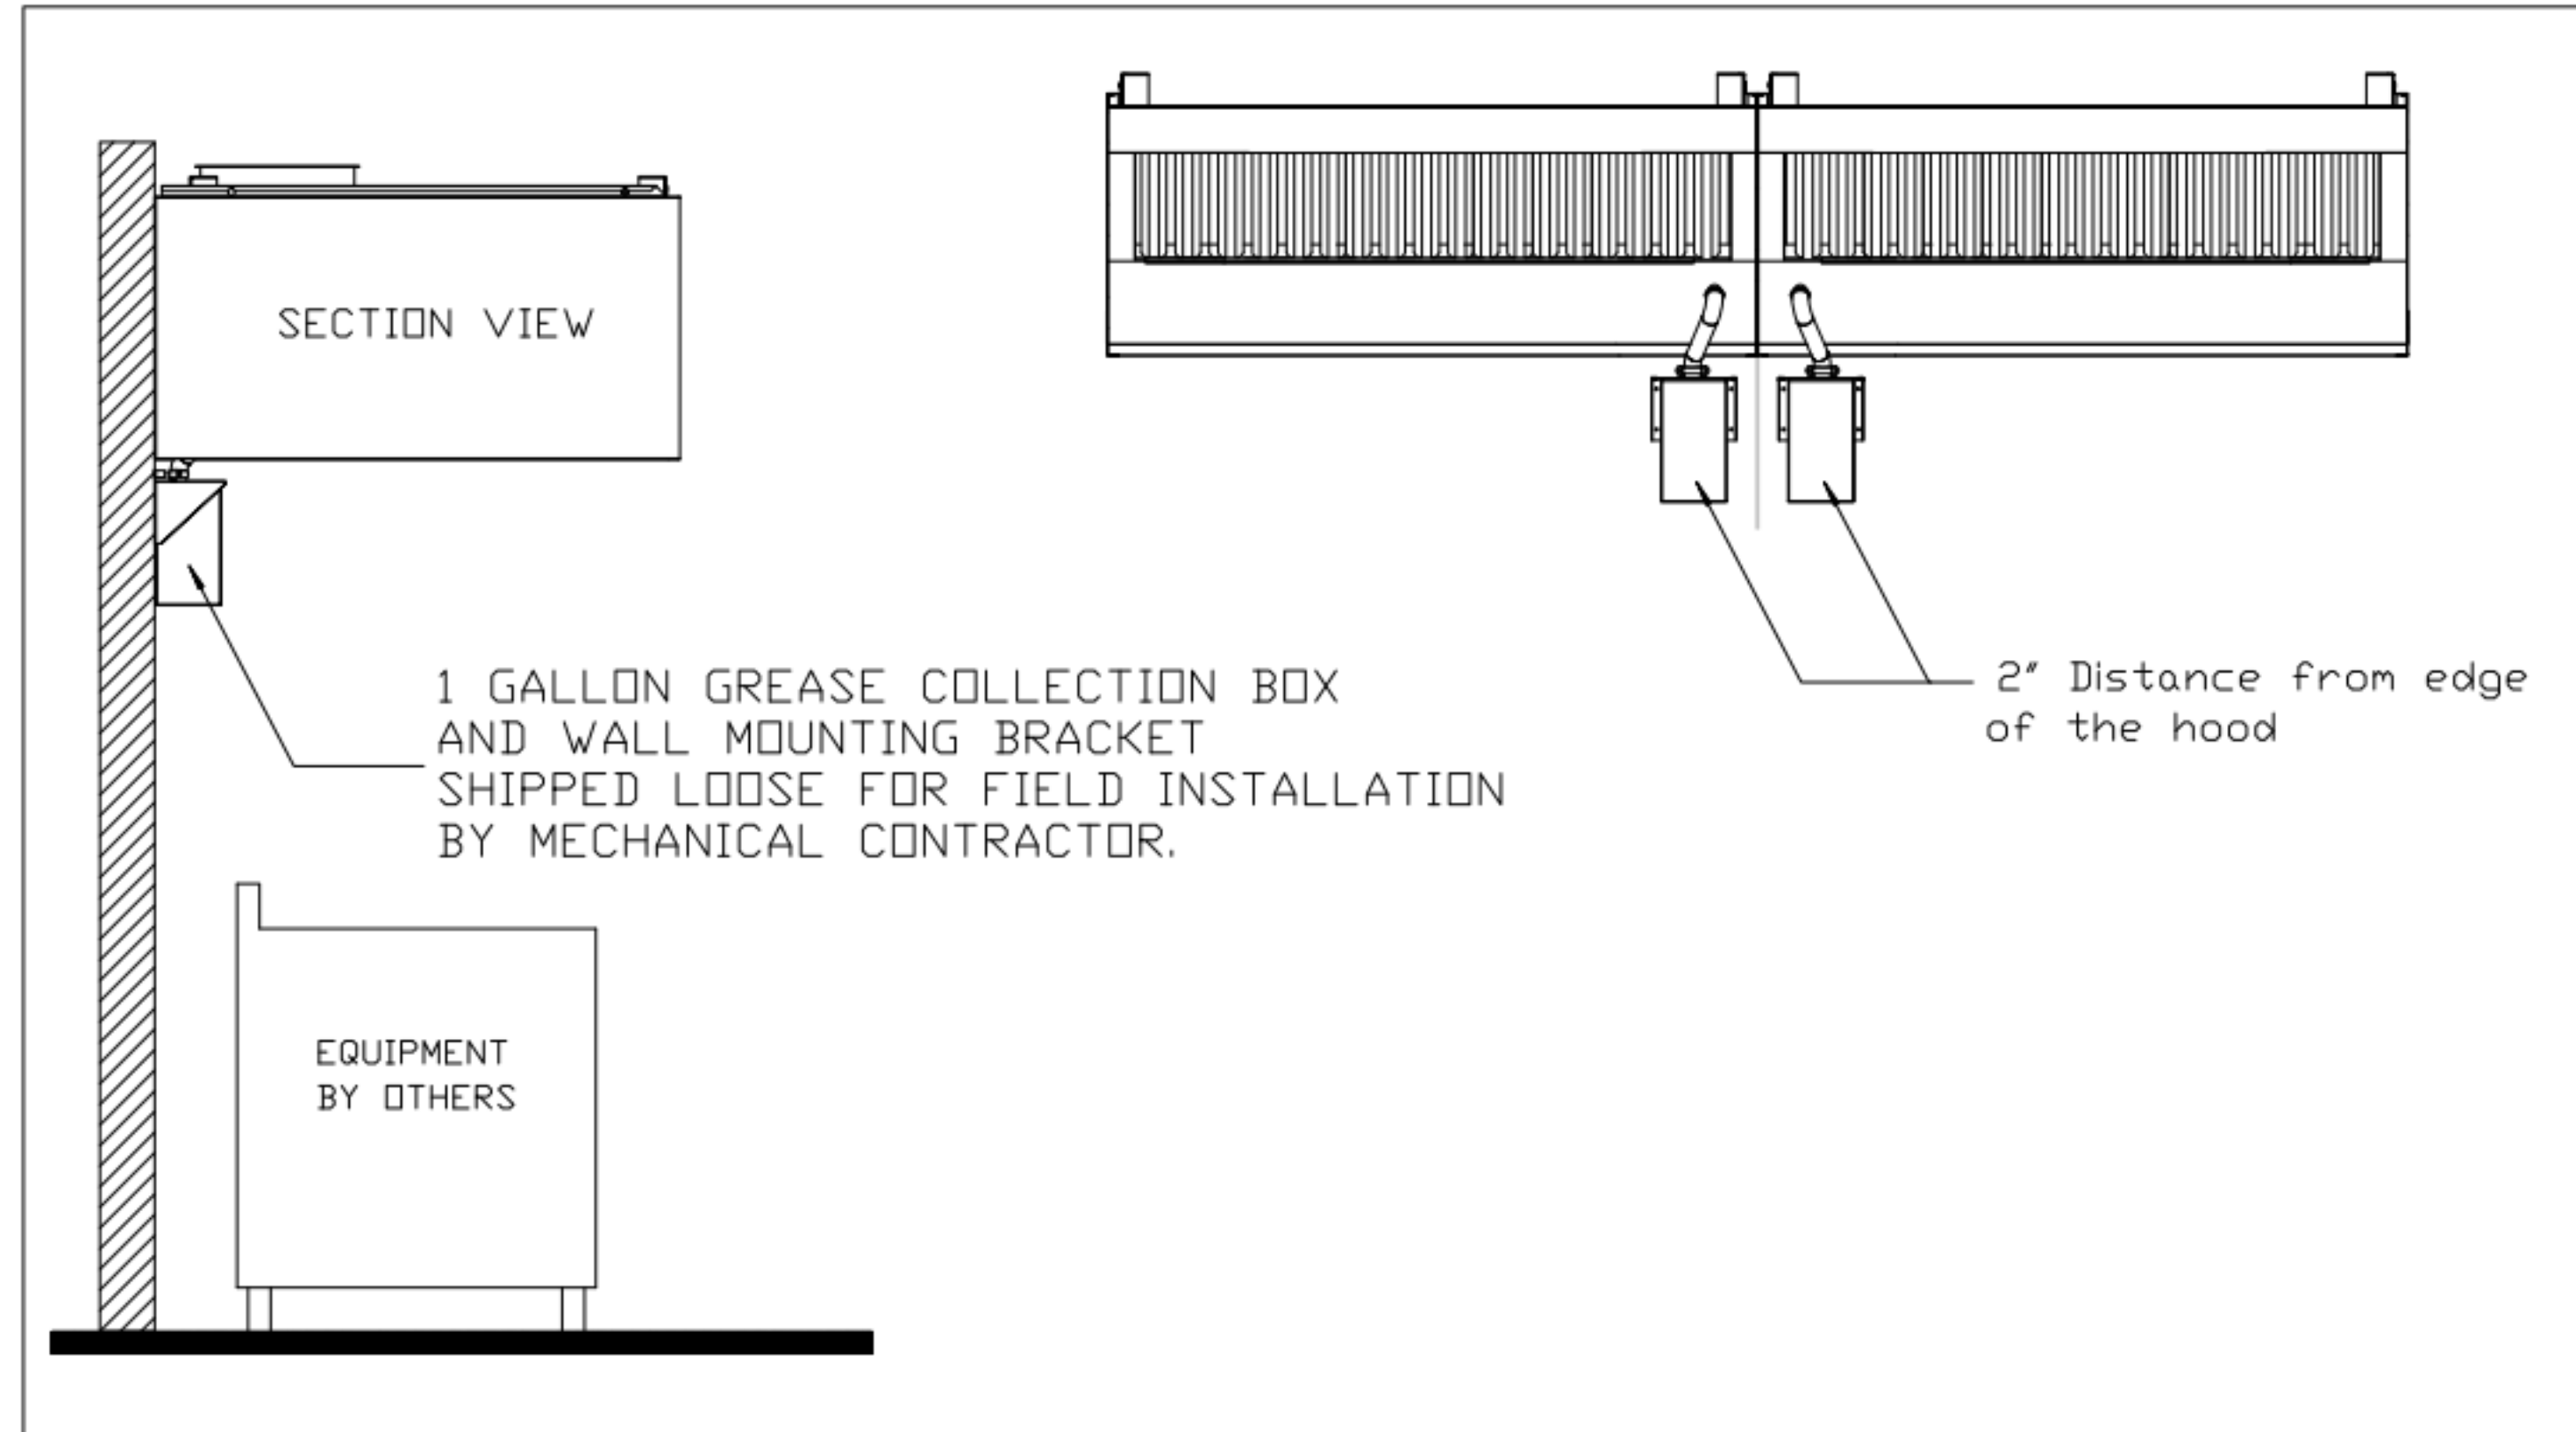

Instructions below outline single, or dual, one gallon grease cup installation for ND-2 hood models.

The one gallon grease cup comes as an assembly of stainless steel wall mounting bracket and one gallon cup. The mounting bracket should be installed 2' from the edge of the containment plenum and 3'-4' below the bottom of the hood.

Piping from the hood grease drain should route to the opening of the grease cup, but not into the cup, otherwise the cup will not be able to be removed and emptied.

1 GALLON GREASE COLLECTION BOX AND WALL MOUNTING BRACKET SHIPPED LOOSE FOR FIELD INSTALLATION BY MECHANICAL CONTRACTOR.

REVISIONS	
DESCRIPTION	DATE

CAPTIVE

Eastern PA Mechanical
PO Box 2620, 1 Union Ave, Bala Cynwyd, PA, 19004 PHONE: (267) 504-4126 EMAIL: reg108@captiveme.com

Shake Shack-1398-Korea Town-R3
LOS ANGELES, CA, 90010

DATE: 6/9/2022
DWG.#: 5505815
DRAWN BY: EB-108
SCALE: 3/4" = 1'-0"
MASTER DRAWING

SHEET NO. 11

STORE NO: CA #1398

SHAKE SHACK
SHAKE SHACK - KOREATOWN
3786 WILSHIRE BLVD. LOS ANGELES, CA 90010

REVISION	
DATE	DESCRIPTION
1 07/01/22	REVISION 1
4 09/16/22	REVISION 4

STATUS: PERMIT/BID SET

PRELIMINARY:
Preliminary Documents Are For Design Review only and not intended for bidding, permitting, or construction purposes. They were prepared by or under the supervision of Zebra Projects, INC.

FIELD VERIFICATION:
The contractor shall verify all signed dimensions and condition at the project site and notify Zebra Projects, INC. of any dimensional errors, or omissions or discrepancies within 10 days of beginning of fabricating any work. Do not scale these drawings.

COPYRIGHT © 2021:
Zebra Projects, INC. shall retain all common law, statutory, and all other reserved rights. Neither the documents nor the information herein is to be reproduced, distributed, disclosed or otherwise without the written consent of Zebra Projects, INC.

SHEET NAME: CAPTIVEAIRE DRAWINGS

DATE: 06/29/22 PROJECT NO: SHK-21-008
DRAWN: Author SCALE: 12" = 1'-0"

SHEET NO: M811