

MECHANICAL DEMO PLAN

SCALE: 1/4" = 1'-0"


PROJECT NAME
PROJECT NAME
PROJECT ADDRESS
PROJECT ADDRESS


GENERAL CONTRACTOR:
 GENERAL CONTRACTOR

- PRELIMINARY - NOT FOR CONSTRUCTION
- FOR CONSTRUCTION
- SHOP DRAWINGS
- AS-BUILT DRAWINGS

| REVISIONS | DATE |
|-----------|------|
| | |
| | |
| | |

DRAWN BY: RJM
 CHECKED BY: RJM
 PROJECT: xx-xxx
 DATE: xx/xx/xxxx
 SHEET: x OF: x

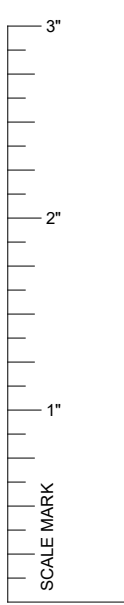

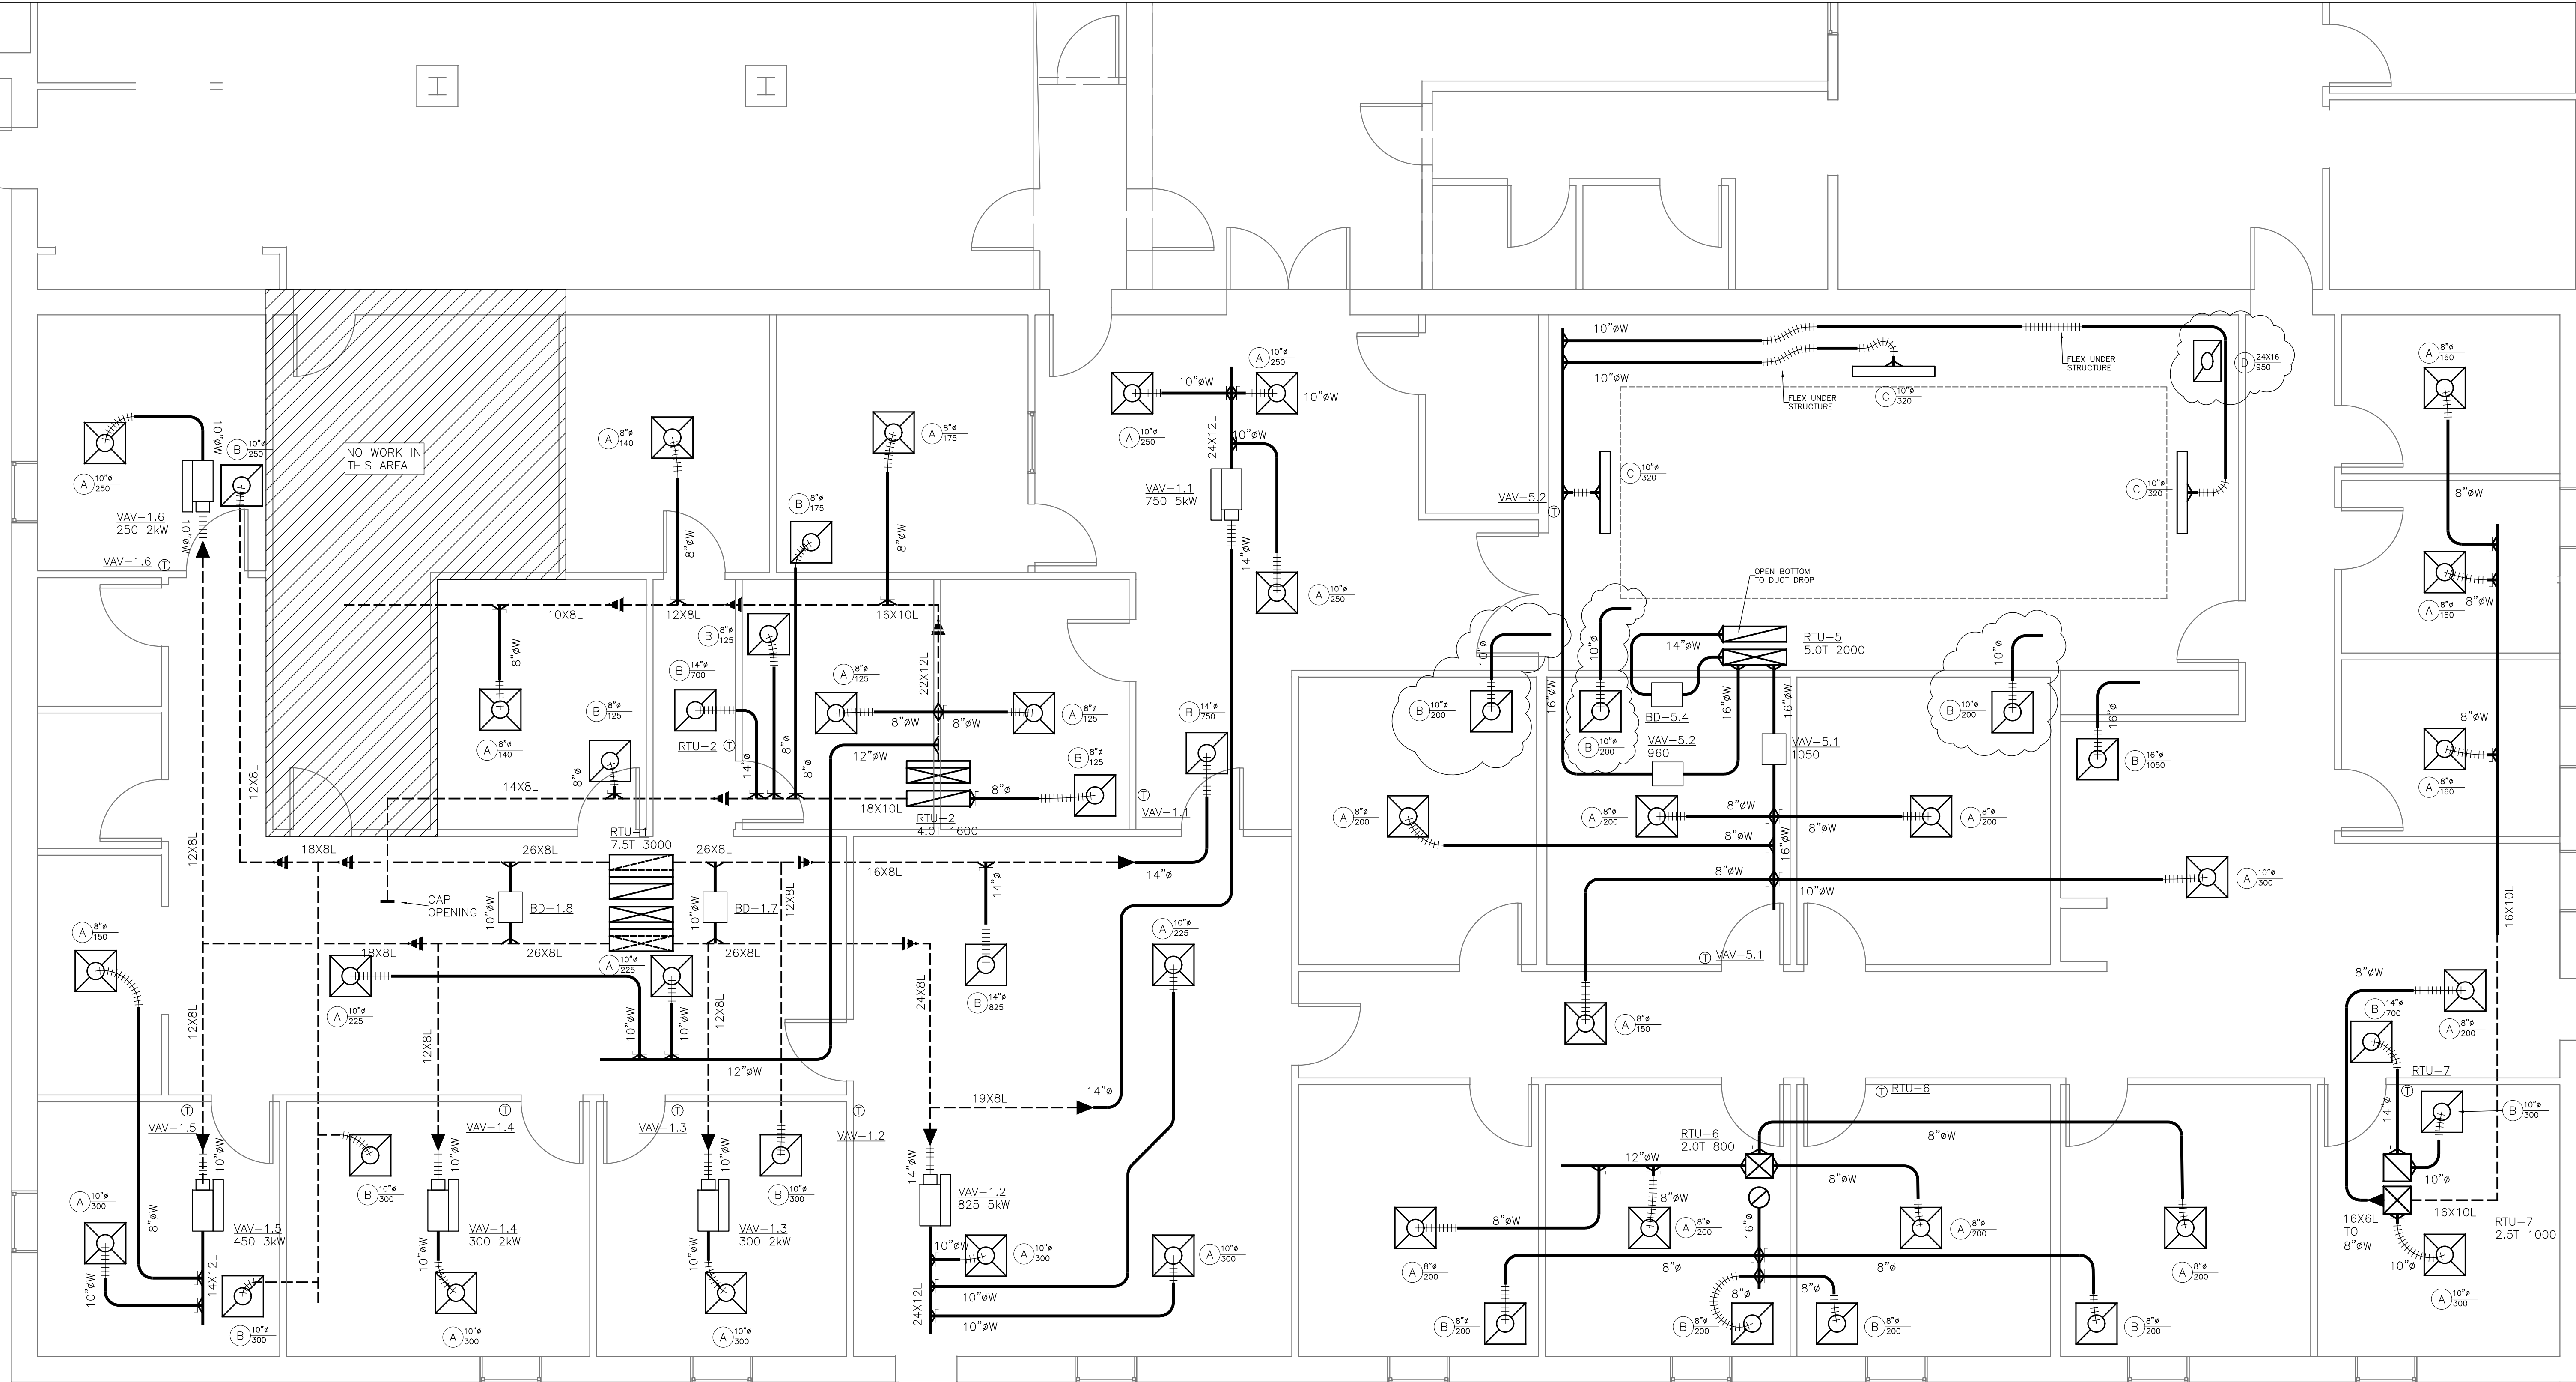

MECHANICAL NEW PLAN

SCALE: 1/4" = 1' - 0"

PROJECT NAME
PROJECT NAME
PROJECT ADDRESS
PROJECT ADDRESS

GENERAL CONTRACTOR:
 SmithCraft
 Construction

○ PRELIMINARY - NOT FOR CONSTRUCTION
 ○ FOR CONSTRUCTION
 ○ SHOP DRAWINGS
 ○ AS-BUILT DRAWINGS

| REVISIONS | DATE |
|-----------|------|
| | |
| | |
| | |
| | |

DRAWN BY: RJM
 CHECKED BY: RJM
 PROJECT: 23-750
 DATE: 2/24/2023
 SHEET: 2 OF: 2