



#	COMMENT	DATE
1	Permit Resubmission	08.20.18
2	Construction Set	08.30.18
3	DETAILS & HVAC REDESIGN REV.3	01/10/19

DESIGN OF THE NON-DUCTED RETURN AIR PLENUM CEILING IS BASED ON THE REQUIREMENT THAT ALL MATERIALS IN THE RETURN AIR PLENUM CEILING ARE ALL LABELED AS PLENUM RATED AND MEET THE FLAME & SMOKE SPREAD REQUIREMENTS FOR PLENUM INSTALLATION AND THE APPROVAL OF A RETURN AIR PLENUM FROM THE LANDLORD. IF THE ABOVE CONDITIONS CANNOT BE MET, THIS CONTRACTOR SHALL STATE THE AMOUNT TO BE ADDED TO HIS BASE BID FOR A TOTALLY DUCTED RETURN AIR SYSTEM.

THESE DRAWINGS ARE DIAGNOSTIC AND INDICATE THE GENERAL EXTENT OF THE WORK. THE CONTRACTOR SHALL BE RESPONSIBLE FOR THE COORDINATION AND PROPER INSTALLATION OF ALL MECHANICAL SYSTEMS. THE CONTRACTOR SHALL PROVIDE ALL NECESSARY OFFSETS AND FITTINGS WHICH MAY BE REQUIRED DUE TO SPACE CONSTRAINTS OR OTHER CONDITIONS.


CONTRACTOR SHALL FIELD VERIFY ALL EXISTING FIELD CONDITIONS PRIOR TO BEGINNING WORK. HOLD ALL NEW DUCTWORK AS TIGHT TO STRUCTURE ABOVE AS POSSIBLE.

MAINTAIN MINIMUM 10' FROM ALL BUILDING INTAKES AND EXHAUST.

CONTRACTOR SHALL MAINTAIN ALL REQUIRED SERVICE CLEARANCES ON EQUIPMENT PER MANUFACTURER INSTALLATION GUIDELINES AND RECOMMENDATIONS. CONTACT ENGINEER OF RECORD IMMEDIATELY WITH ANY CONFLICTS.

THE MECHANICAL CONTRACTOR SHALL PROVIDE AND INSTALL ALUMINUM EXHAUST DUCTWORK FOR DISHWASHER HOOD. M.C. SHALL PROVIDE AND INSTALL GALV. ROOF DUCT FOR RESTROOM EXHAUST DUCTWORK.

REFER TO KITCHEN VENDOR DRAWINGS FOR BALANCING AIRFLOW TO KITCHEN HOODS.

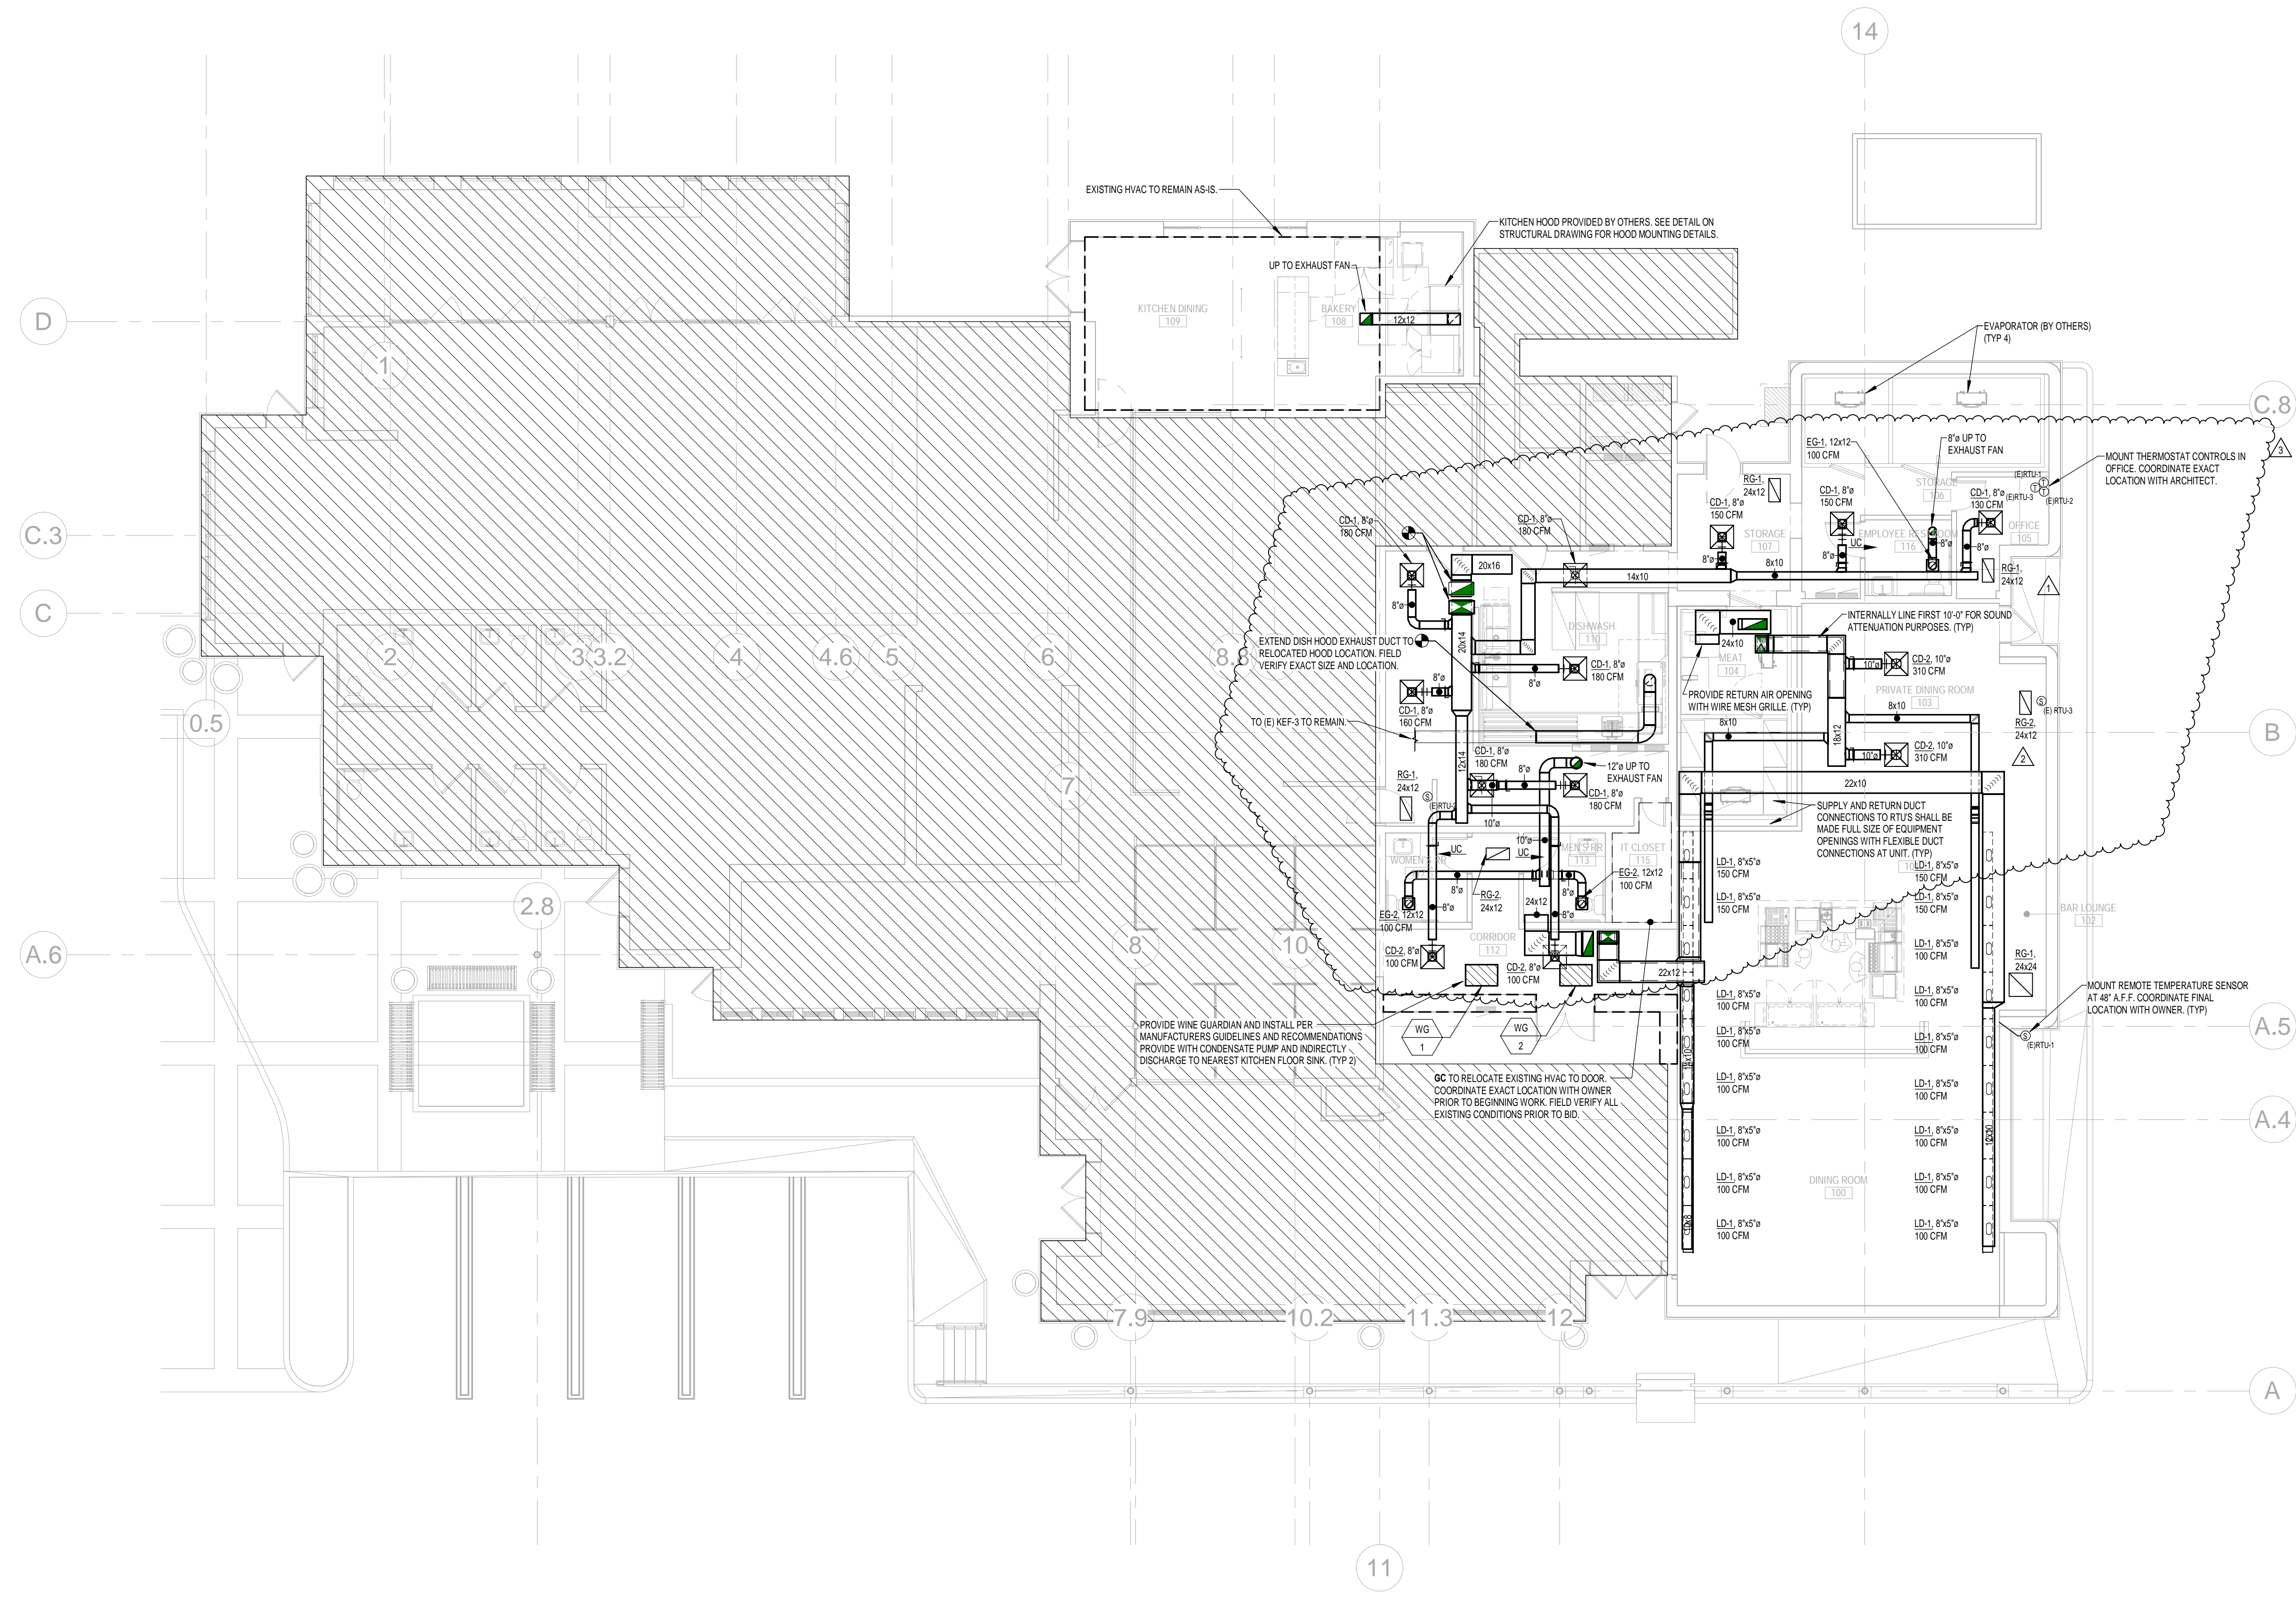


SEAL

CONSULTANTS
T3
Thorson & Associates
CONSULTING ENGINEERS
3000 West Stevenson Road | (303) 659-6668 Ph.
Boulder, CO 80508

REV SCHEDULE

#	COMMENT	DATE
1	Permit Resubmission	08.20.18
2	Construction Set	08.30.18
3	DETAILS & HVAC REDESIGN REV.3	01/10/19

- EXISTING RTU REFURBISH REQUIREMENTS:
- MECHANICAL CONTRACTOR SHALL REFURBISH EXISTING RTU TO LIKE NEW CONDITION.
 - REPLACE FILTERS.
 - LUBRICATE FAN AND SHAFT BEARINGS.
 - CLEAN FAN WHEEL.
 - RECALIBRATE AND CLEAN OUTSIDE AIR DAMPER AND LINKAGE.
 - RECALIBRATE AND CLEAN RETURN AND RELIEF AIR DAMPER AND LINKAGE.
 - CLEAN EXTERIOR FINS.
 - REPLACE FAN MOTOR BELTS.
 - CLEAN ALL ACCESS SECTIONS.
 - CLEAN AUXILIARY DRAIN PAN.
 - REMOVE ALL FOREIGN DEBRIS, VACUUM AND CLEAN INTERIOR FLOOR OF UNIT.
 - REPAIR ALL ACCESS DOORS AS REQUIRED.
 - CLEAN MAIN SUPPLY AND RETURN AIR DUCTS.
 - CHECK REFRIGERANT LEAKS AND CHARGE UNIT. REPAIR LEAKS AS REQUIRED.
 - CHECK CONDENSER FAN MOTOR FOR PROPER OPERATION.
 - CHECK ALL CONTACTS, RELAYS AND CONTROLS FOR PROPER OPERATION.
 - POWER WASH AND CHEMICALLY CLEAN EVAPORATOR AND CONDENSER COILS.
 - CHECK SMOKE DETECTOR FOR PROPER OPERATION. REPLACE IF REQUIRED.
- REFURBISH ALL EXISTING RTUS TO LIKE NEW CONDITION.

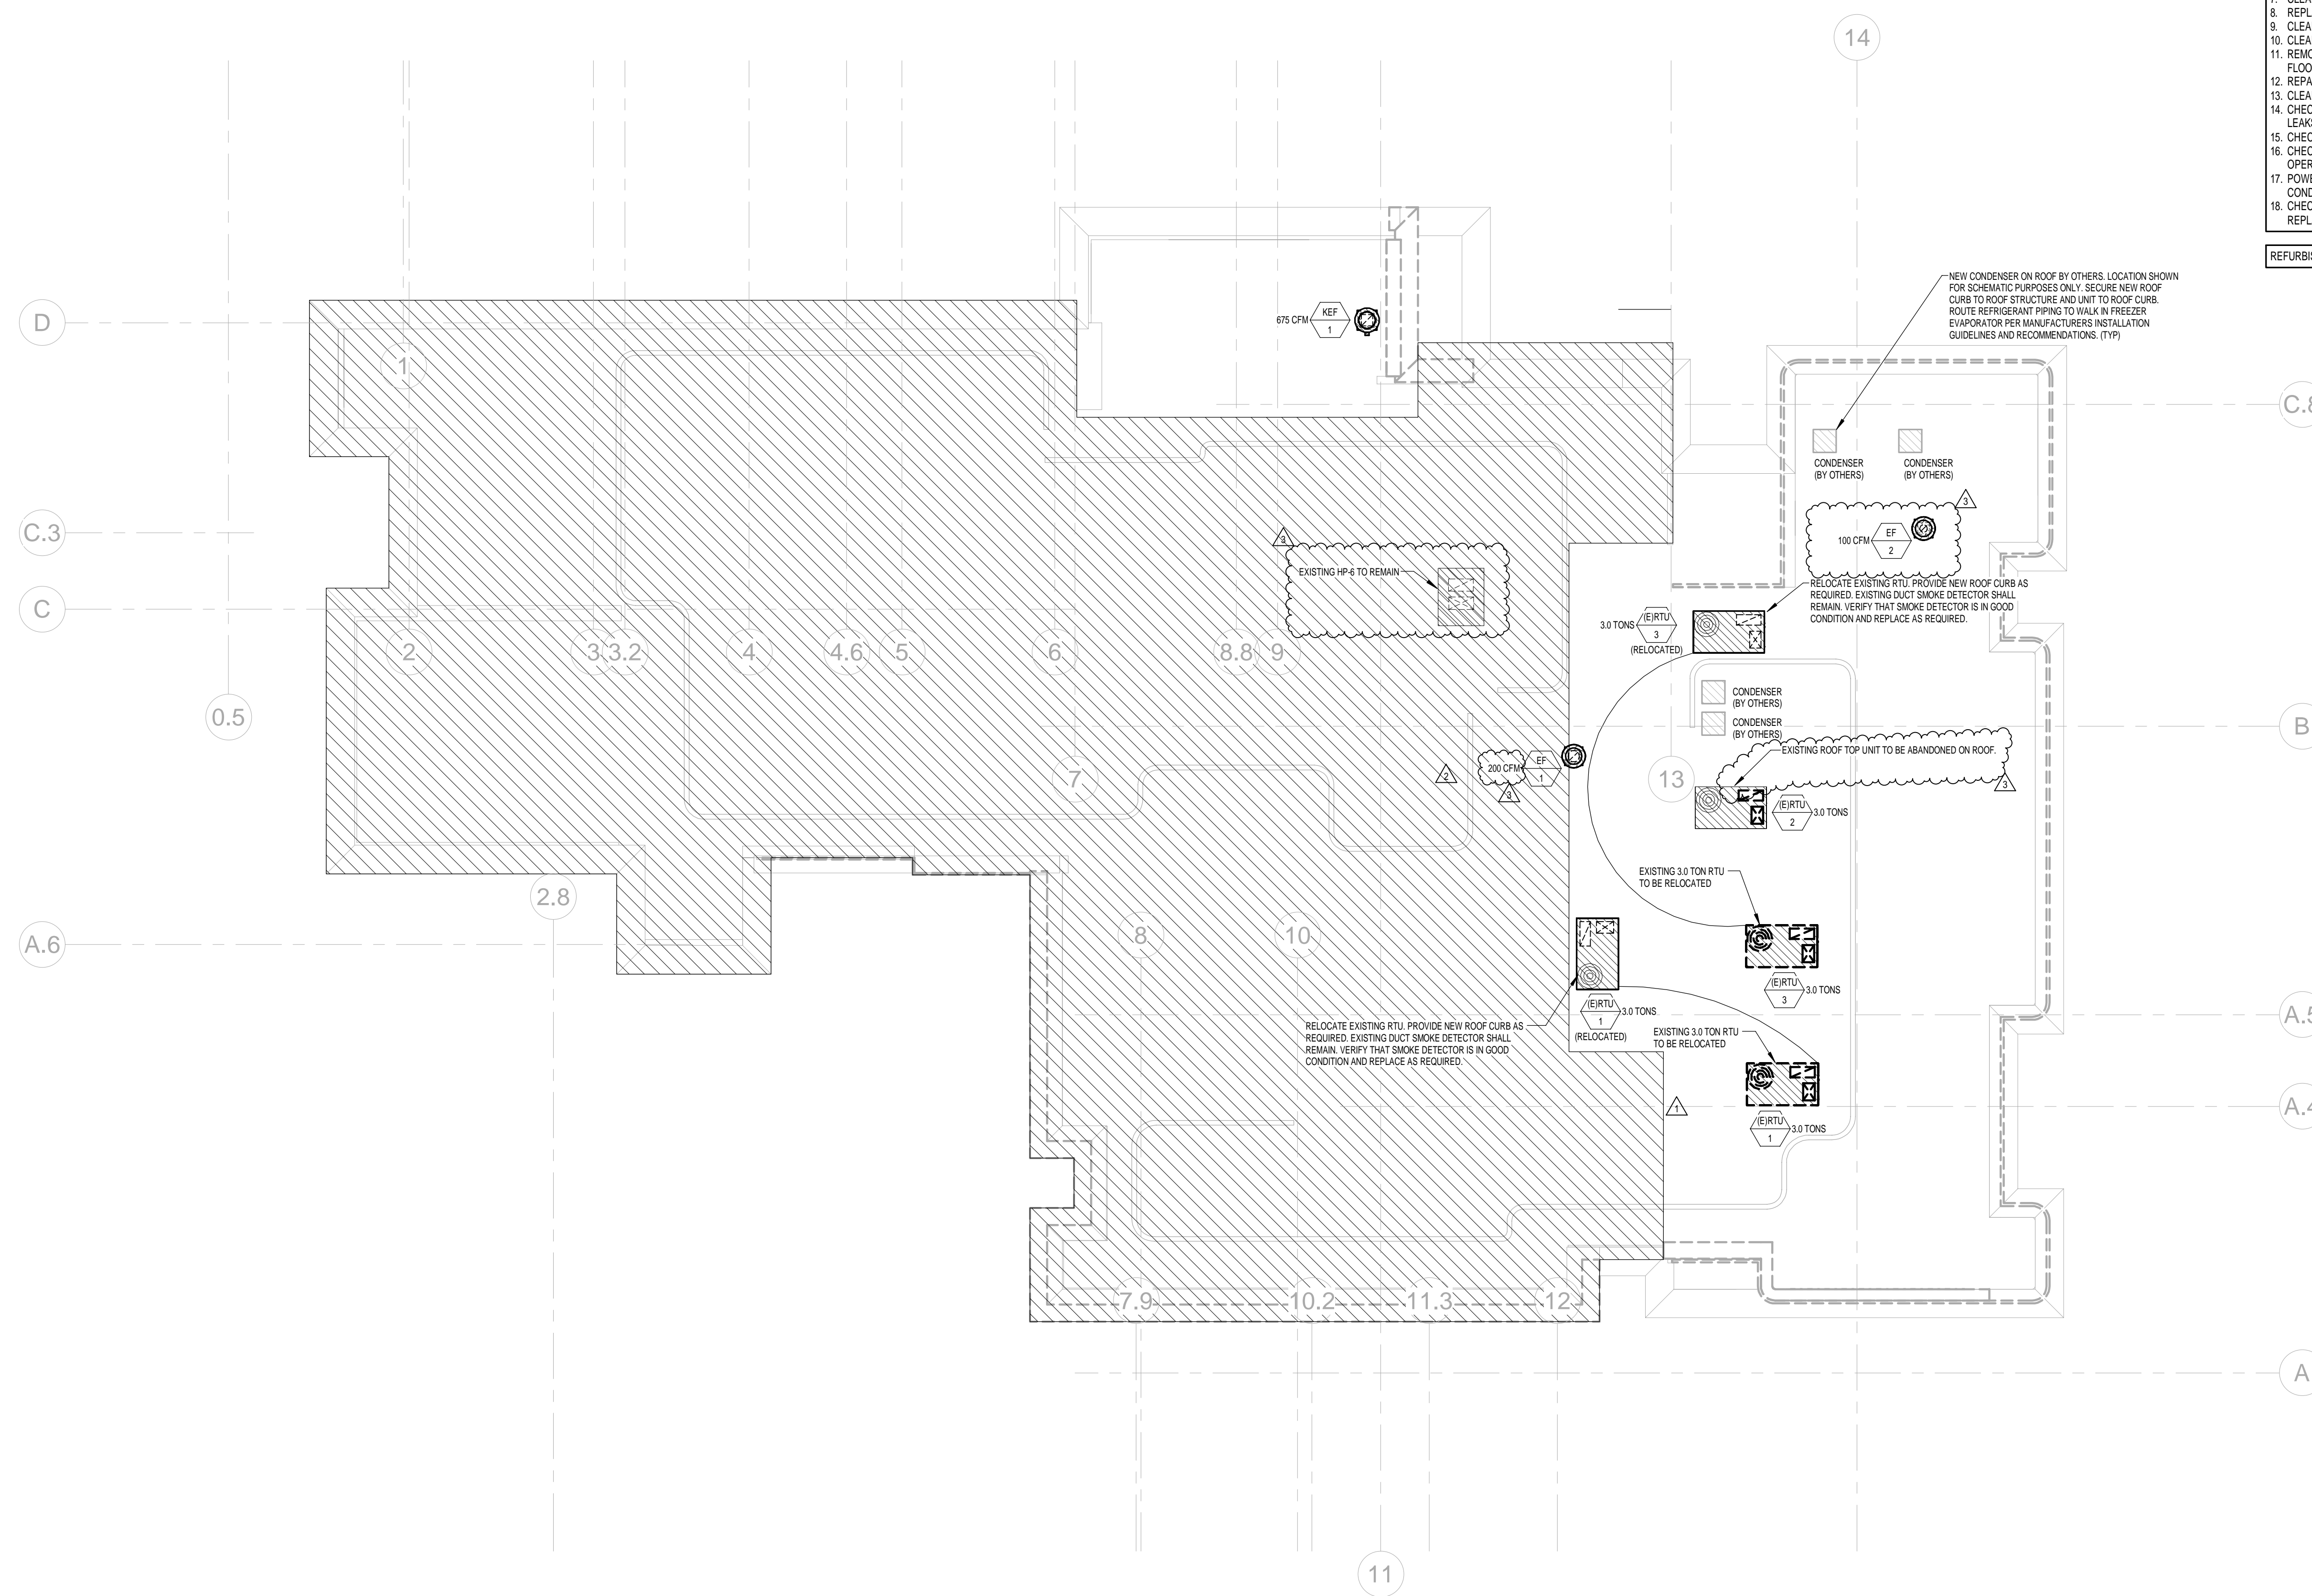

MECHANICAL ROOF PLAN
1/8" = 1'-0"

PROJECT NAME / LOCATION

STEAK 44
CAMELBACK VILLAGE CENTER,
5101 NORTH 44TH STREET,
PHOENIX, ARIZONA 85018

PROJECT INFORMATION

DATE: 2018-06-15
PROJECT NO: 2771-18
DRAWN BY: TBA

ISSUE FOR CONSTRUCTION

M-101

MECHANICAL ROOF PLAN

10/18/2018 2:48:32 PM \\ts-proj\ss04\2018\20180218\02180218-0249\Cad_Revt1 - TBA\MEP\RevtLib\ss04\20180218-0249_MEP_bk.r18.rvt



#	COMMENT	DATE
1	Permit Resubmission	08.20.18
2	Construction Set	08.30.18
3	DETAILS & HVAC REDESIGN REV.3	01/10/19

VENTILATION AIR REQUIREMENT						
HVAC UNIT	AREA SERVED	OCCUPANT LOAD	REQUIRED VENTILATION	D.A. REQUIRED (CFM)	O.A. SUPPLIED (CFM)	REMARKS
(E)RTU-1	DINING 100 (LOWER)	17 (820 SF)	7.5 CFM/PERSON 0.18 CFM/SF	275	275	PER ASHRAE STANDARD 62.1-2016
	OFFICE 106	1 (86 SF)	5 CFM/PERSON 0.06 CFM/SF	9	10	PER ASHRAE STANDARD 62.1-2016
	STORAGE 106	0 (156 SF)	7.5 CFM/PERSON 0.12 CFM/SF	19	19	PER ASHRAE STANDARD 62.1-2016
	STORAGE 107	0 (73 SF)	7.5 CFM/PERSON 0.12 CFM/SF	9	10	PER ASHRAE STANDARD 62.1-2016
	DISHWASH 110	6 (578 SF)	7.5 CFM/PERSON 0.12 CFM/SF	115	115	PER ASHRAE STANDARD 62.1-2016
	WOMENS 111	0 (62 SF)	0 CFM/PERSON 0.06 CFM/SF	3	5	PER ASHRAE STANDARD 62.1-2016
	MENS 113	0 (62 SF)	0 CFM/PERSON 0.06 CFM/SF	3	5	PER ASHRAE STANDARD 62.1-2016
	EMPLOYEE RR 114	0 (42 SF)	0 CFM/PERSON 0.06 CFM/SF	2.5	5	PER ASHRAE STANDARD 62.1-2016
	CORRIDOR 112	0 (184 SF)	0 CFM/PERSON 0.06 CFM/SF	11	11	PER ASHRAE STANDARD 62.1-2016
(E)RTU-3	PRIVATE DINING 103	16 (361 SF)	7.5 CFM/PERSON 0.18 CFM/SF	185	187	PER ASHRAE STANDARD 62.1-2016
	DINING 100 (UPPER)	13 (325 SF)	7.5 CFM/PERSON 0.18 CFM/SF	156	158	PER ASHRAE STANDARD 62.1-2016

NOTE:
ASHRAE 62.1-2016 ITEM 6.2.2.1 BREATHING ZONE OUTDOOR AIR FLOW (CFM) $V_{bz} = R_p P_2 + R_a A_z$

WHERE
 A_z = ZONE FLOOR AREA
 P_2 = POPULATION
 R_p = TABLE 6.1 OUTDOOR AIR PER PERSON
 R_a = TABLE 6.1 OUTDOOR AIR PER AREA

FAN SCHEDULE												
MARK	MANUFACTURER	MODEL No.	SERVICE	TYPE	CAPACITY (CFM)	STATIC PRESSURE (WC")	DRIVE	MOTOR HP	ELECTRICAL VOLT. PH.	OPER. WT. (LBS)	REMARKS	
EF 1	GREENHECK	GB-071	RESTROOM	ROOF	200	0.4	BELT	1/6	120	1	55	1,2
EF 2	GREENHECK	GB-071	RESTROOM	ROOF	100	0.3	BELT	1/6	120	1	55	1,2

REMARKS:
1. ACCEPTABLE MANUFACTURERS: LOREN COOK, TWINGITY.
2. CONTROL WITH ROOM LIGHT SWITCH

KITCHEN EXHAUST FAN SCHEDULE (BY OTHERS)												
MARK	MANUFACTURER	MODEL No.	SERVICE	TYPE	CAPACITY (CFM)	RPM	HP	STATIC PRESSURE (WC")	ELECTRICAL VOLT. PH.	OPER. WT. (LBS)	REMARKS	
KEE 1	CAPTIVE AIRE	DUS3HFA	HOOD	ROOF	675	1281	0.333	0.350	120	1	4.4	67

REMARKS:
1. REFER TO K.E.C. DRAWINGS FOR FINAL SPECIFICATION.

EXISTING ROOFTOP AIR CONDITIONING UNIT SCHEDULE (GAS-FIRED)											
MARK	NOMINAL TONS	MANUFACTURER	MODEL No.	SERVICE	SUPPLY AIR (CFM)	MIN. OUTDOOR AIR (CFM)	MCA	MOC	ELECTRICAL VOLT. PH.	OPER. WT. (LBS)	REMARKS
(E)RTU 1	3.0	CARRIER	50TF004	TENANT	1400	275	17.80	20	208	3	1,2,3
(E)RTU 3	3.0	CARRIER	50TF004	TENANT	1220	345	17.80	20	208	3	1,2,3


REMARKS:
1. ROOF CURB
2. SMOKE DETECTOR IN RETURN AIR INTAKE (IF NEEDED).
3. PROVIDE WITH NEW DISCONNECT SWITCH AND 115 V GFI CONVENIENCE RECEPTACLE.

GRILLE AND DIFFUSER SCHEDULE						
MARK	MANUFACTURER	MODEL No.	FRAME OR BORDER TYPE	MODULE SIZE	FINISH	REMARKS
CD 1	TITUS	TMS	LAY-IN	24x24	PER ARCH	1,2
CD 2	TITUS	TMS	SURFACE	24x24	PER ARCH	1,2,4
EG 1	TITUS	50F	LAY-IN	SEE PLAN	PER ARCH	1,2
EG 2	TITUS	50F	SURFACE	SEE PLAN	PER ARCH	1,2,4
LD 1	TITUS	ML-39	SURFACE	4'-0"	PER ARCH	1,2,3,4
RC 1	TITUS	50F	LAY-IN	SEE PLAN	PER ARCH	1,2
RG 2	TITUS	50F	SURFACE	SEE PLAN	PER ARCH	1,2

REMARKS:
1. ALL CEILING DIFFUSERS ARE 4-WAY THROW UNLESS INDICATED OTHERWISE ON PLAN.
2. ACCEPTABLE MANUFACTURERS: PRICE, TUTTLE AND BAILEY, KRUEGER, NALOR, ANEMOSTAT.
3. 2-SLOT / 1" SLOT WIDTH WITH CONTINUOUS PLENUM.
4. PROVIDE WITH YOUNGS REGULATORS.

WINE GUARDIAN SCHEDULE						
MARK	MODEL No.	MCA	MOC	VOLT. PH.	OPER. WT. (LBS)	REMARKS
WG 1	D088	11.80	20	208	1	130
WG 2	D088	11.80	20	208	1	130

REMARKS:
1. SUSPENDED ABOVE CEILING.

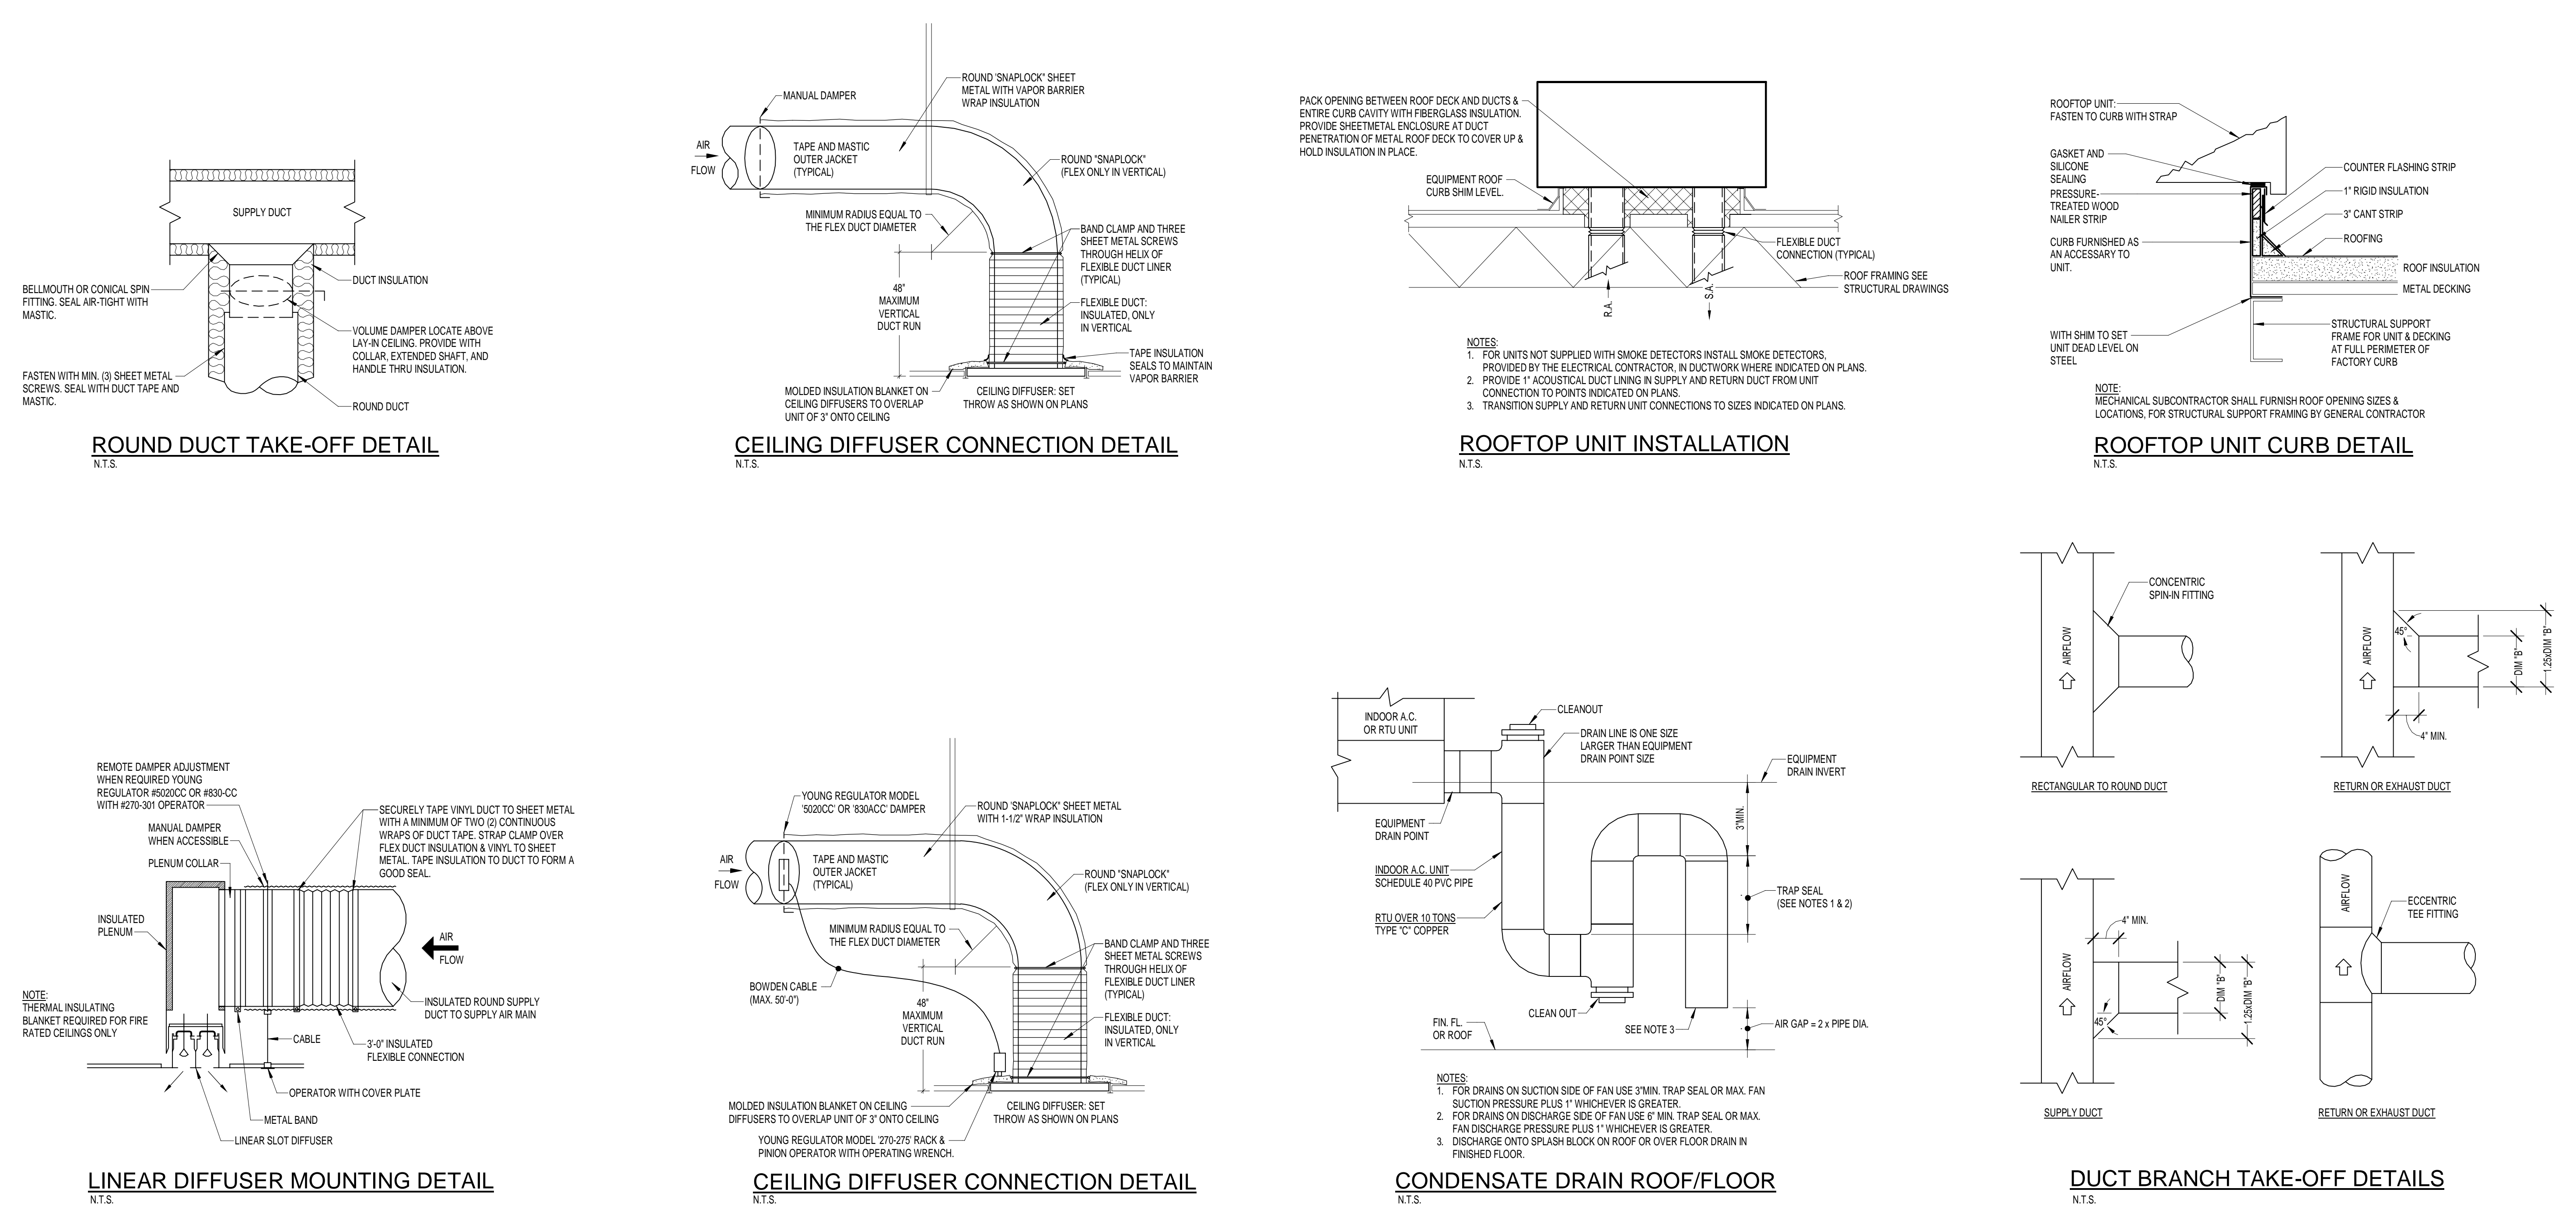

Section 200500 - General Requirements

- A. General**
- Specifications are applicable to all contractors and/or subcontractors for all mechanical systems in Divisions 01, 20, 21, 22, and 23.
 - This contractor is also referred to as the architectural, structural, electrical and all other drawings and specifications pertinent to this project and fully coordinate with all other trades, owner and architect requirements. All of the above mentioned drawings and specifications are considered a part of the contract documents.
 - Conform to all Instructions to Bidders, general and special conditions of contract as specified by architect and/or owner.
 - Refer to "Alternate Proposals" for possible changes affecting the extent of this section of work. Before submitting a bid, each contractor is requested to visit the job site to familiarize themselves with construction condition, check facilities and conditions over premises. Make all necessary observations and measurements. Note conditions under which work is to be performed and take all items into consideration in bid. No consideration will be given for his failure to do so.
 - Systems are to be complete and workable in all respects, placed in operation and properly adjusted.
 - Each contractor shall provide for his own clean-up, removal and legal disposal of all rubbish daily.
 - Each contractor shall protect his work, his existing and adjacent property against weather.
 - Each contractor shall protect his work, materials, apparatus and fixtures from damage. Any work damaged by failure to provide protection required, shall be removed and replaced with new material at the contractor's expense.
 - Each contractor must confirm all utility company requirements and connection points in field, prior to starting work. Each contractor shall include cost of utility companies work in their bid.
 - Each contractor must confirm size, location and materials at point of tie in connections in the field prior to rough-in of new work.
 - Arrange for and obtain owner's and insurance representative's permission for any service shutdowns.
 - Each contractor shall be solely responsible for construction means, methods, sequences of construction and the safety of workmen.
 - No piping, ductwork, wiring, etc., shall be installed or routed above or below electrical panels and equipment, through elevator equipment rooms or elevator shafts or stairways unless these items serve these areas only.
 - All contractors shall coordinate with the electrical contractor and obtain a written approval identifying the electrical characteristics of all mechanical equipment prior to ordering of equipment. No additional payment will be made for lack of contractor coordination of electrical characteristics.
 - Each contractor shall include modifying existing conditions to complete the project. During construction the contractors may uncover an existing condition that will have to be modified. Any such work which comes under the jurisdiction of this contractor shall be done by this contractor without extra cost to the owner and project.
 - Work related to the existing building shall be coordinated to minimize interference or interruption of normal building use by the owner. Refer to architectural plans for phasing requirements.
 - Ceiling grid systems shall not be supported from ductwork, heating or plumbing lines or any other utility lines, and vice versa. Each utility and the ceiling grid system shall be a separate installation and each shall be independently supported from the building structure - concrete, steel or masonry. Where interferences occur, in order to support ductwork, piping, ceiling grid systems, etc., trapeze type hangers or supports shall be employed which shall be located so as not to interfere with access to such mechanical equipment as valves, regulators, mixing boxes, fire dampers, etc.
- B. Work Coordination and Access**
- Each contractor under this division shall familiarize himself with the work to be done under other divisions of this specification and their related drawings and shall so coordinate and schedule his work as not to cause delays or interference with the work of others. Such coordination and scheduling shall accomplish the installation of mechanical and plumbing equipment and piping with a minimum of cutting through masonry and other adjacencies.
 - Work included under this division shall consist of furnishing all materials, supplies, equipment, tools, transportation and facilities and performing all labor and services necessary for the complete installation of the mechanical systems of plumbing, fire protection, heating, ventilating, air conditioning, and specialty systems.
 - The contractor under this division shall report discrepancies in the work of others which affect his work. Any changes made necessary by failure or neglect to report such discrepancies shall be made by and at the expense of the contractor of this division. Obtain written instructions for changes necessary to accommodate work of others.
 - The contractor under this division shall be responsible for proper size and location of anchors, chases, recesses, opening, etc., required for the proper installation of his work.
 - The division of responsibility under separate mechanical, fire protection and plumbing contracts for in-ports shall be as follows:
 - The plumbing contractor shall provide domestic water and gas to within five feet (5'-0") of equipment connection furnished by the mechanical or electrical contractor, final connection by mechanical or electrical contractor. On the water lines, the plumbing contractor shall provide the shut-off valve, check valve, backflow preventer and pressure regulator. On the gas lines, the plumbing contractor shall provide the shut-off valve and pressure regulator.
 - Plumbing contractor shall run the gas, water, sanitary and storm to 5'-0" outside the building or to points as noted on the drawings.
 - Fire protection, plumbing and mechanical contractor shall provide sleeves to the general contractor for placement in floors, walls, etc., and coordinate such location. The plumbing contractor shall be responsible for flashing at vent roof terminals.
 - The fire protection, plumbing and mechanical contractor shall check with the architectural drawings concerning the test borings to determine areas of rock which should be included in his excavation work. Failure to adjust for rock conditions shall not warrant claim for additional compensation.
 - The plumbing contractor shall rough-in and connect all other fixtures and equipment where shown on the drawings but not previously mentioned. Provide with shut-off valves and p-traps with clean-out plug.
 - The plumbing contractor shall provide gas, cold water and drain for the emergency generator and install valves, etc. Generator furnished by the electrical contractor.
 - Unless responsibility to provide or furnish is otherwise stated on the electrical or mechanical drawings and electrical and mechanical specifications the contractor, under these divisions shall provide motors, special controls, disconnects, transformers, starters and relays as required for the proper operations of all equipment furnished under this division. All electrical equipment shall conform to requirements set forth under the electrical division and be suitable for operation on 60 cycle current available at the site.
 - All motors 1/3 HP and smaller shall be single phase motors, 1/2 HP and larger, shall be three phase motors except where otherwise specified. Thermal overload protection for all motors shall be provided. Combination fused disconnect and magnetic line starters with auto-off-test switch shall be provided for all three-phase motors. Thermal overload relays shall be sized for 115 percent of full load motor current. For motors with VFD, motors shall be inverter duty motors that meets current "NEMA Part 31" specifications. Motors to have a minimum of 20:1 turn down ratio. Motors over 20 Hp shall have shaft ground rings. The installation of all motors, starters and other electrical under this mechanical division shall be done so as to conform with the National Electric Code. Each motor shall be of squirrel cage type, open-drip proof, normal starting torque, having ball bearings unless otherwise specified. For manufacturers that use PMAC motors, this contractor shall supply VFD's to operate motor.
 - Each contractor shall provide OSHA approved handrail (Guard) system for all roof mounted equipment within 10'-0" of roof edge where the roof edge does not have a 42" high parapet or higher.

- C. Codes, Permits, Standards and Regulations**
- Contractors shall install work in full accordance with rules and regulations of all applicable codes (local, city, county, state, national codes, NFPA, OSHA, etc.), government regulations, utility company requirements, and applicable standards having jurisdiction over premises. This shall include safety requirements of the state department. Do not construct this as relieving contractor from compliance with any requirements of specifications which are in excess of code requirements and not in conflict therewith.
 - Contractors shall secure and pay for all fees, permits, and certificates of inspection incidental to this work required by foregoing authorities. Arrange for all required inspections and approvals.
 - Contractor shall be responsible for payments to all public utilities for work performed by them in connection with provision of service connections required under this division of specifications.
 - Deliver all permits and certificates to architect in duplicate.

- D. Design Drawings**
- The design drawings, as submitted, are diagrammatic and are not intended to show exact position of equipment, piping and ductwork unless dimensions are given. Piping and ductwork are to be installed along the general plans shown on the drawings while conforming to actual building conditions. Each contractor shall confirm all dimensions by field measurement.
 - Before entering into a contract, the successful bidder may be required to submit satisfactory evidence to show that the manufacturer of all parts of the equipment offered have been regularly

- engaged in the manufacture of such equipment for three (3) years and have not less than three (3) installations of a similar type which have been in successful operation under conditions similar to those specified for not less than two (2) years.
- All equipment, piping and material specified herein after as shown on the drawings shall be furnished and installed by the contractor, unless specifically indicated to the contrary. Installation shall comply with all relevant Building Codes and referenced standards.
 - If this contractor proposes to install equipment requiring space conditions other than those as specified and/or shown on the design drawings, or to rearrange the equipment, he shall assume full responsibility and submit drawings for the rearrangement of the space and shall obtain the full approval of the architect prior to start of any work.
 - The exact locations for fixtures, equipment and piping which is not covered by drawings shall be obtained from the architect or his representative in the field and the work shall be laid out accordingly.
 - Drawings and specifications are intended to supplement one another. Any materials or labor called for in one but not the other shall be furnished as if both were mentioned in the specifications and shown on the drawings.

- E. Base Bid Equipment, Materials and Substitutions**
- All equipment and materials shall be new, free of defects and UL listed.
 - Base bid manufacturers are included in the specification or listed in schedules on the drawings. All other manufacturers are considered substitution.
 - The name or make of any article, device, material, form of construction, fixture, etc., stated in this specification, whether or not the words "or approved equal" are used, shall be known as a "standard".
 - All cost shall be based on "standards" specified.
 - The equipment schedules on the drawings indicate manufacturer and their equipment model numbers that shall be covered and protected with MERV 8 filtration media; openings which can remain inactive during construction shall be covered with plastic sheathing and sealed air tight. Filter media shall be replaced regularly as required during construction in order to ensure adequate airflow through all required active openings. In addition, at the end of each phase of construction and at the end of the construction project, all filtration media within each piece of equipment serving the space shall be replaced.
 - Where more than one make or name is mentioned as being acceptable, it shall be understood that only the name or make referring to the manufacturers model numbers or sizes shall be considered the "Specified Standards." It shall be further understood that other makes and names, even though mentioned, have not been checked for detail and that their size and arrangement are the contractor's responsibility the same as a proposed substitute item. The use of other manufacturer's equipment that is listed as acceptable alternatives that entails general trades, structural, mechanical, electrical, etc., revisions is this contractor's responsibility to provide revisions. Any additional cost of such changes shall be paid by the contractor submitting the acceptable alternatives which necessitates changes in installing such submitted alternate equipment, even though such costs may be part of another division of work.
 - Bids concerning the use of substitute products must be accompanied by complete specifications and performance characteristic covering these products. Contractor shall provide all available test data and experience that may be helpful to the architect in evaluating the quality and/or suitability of alternate products.
 - Contractor is also invited to bid on any other similar products the contractor desires to propose as substitutions, stating any difference in cost (add or deduct from base bid cost) for each proposed substitution use substitution sheet. If the architect decides to accept any of the proposed substitutions, proper notations thereof shall be made in the written contract. Where several makes are mentioned in the specifications and the contractor fails to state that he prefers a particular make in his bid, the owner shall have the right to object to the make or makes mentioned without change in price. No consideration will be given to proposals for alternative products unless submitted with the original bids.
 - Substitutions are subject to the approval of the owner. If a substitution is submitted, it is the contractor's responsibility to evaluate it and certify that the substitution is equivalent in all respects to the base specifications.
 - If substitutions are approved, notify all other contractors, subcontractors, etc., affected by the substitution and fully coordinate with them. Any costs resulting from substitution, whether by this contractor or others, shall be the responsibility of the contractor. Approved shop drawings do not absolve this contractor from this responsibility.
 - All equipment shall be installed in full accordance with the manufacturer's data and installation instructions and service instructions. It is this contractor's responsibility to check and confirm these requirements prior to starting of any work.

- F. Warranty**
- Fully warrant all materials, equipment and workmanship and the successful operation of all equipment and apparatus installed by this contractor for one (1) year from date of final acceptance.
 - Extend all manufacturers' warranties to owner; including five (5) year compressor and ten (10) year heat exchanger extended warranty on HVAC equipment with adequate details and scales to clearly show construction. Indicate the operating characteristics for each required item. Clearly identify each item on the submittal as to mark, location and use, using the same identification as provided on the construction documents.
 - Sheetmetal and fire protection shop drawings shall be fully dimensioned and coordinated based on field verified building dimensions and clearances and architectural ceiling layouts. Indicate structural systems, lighting, ductwork and piping at all critical locations.
 - Contractor shall review and indicate his approval of each shop drawing prior to submittal for review. Shop drawings will not be reviewed by the engineer unless the contractor's approval is noted. Do not start work or fabrication until shop drawings have been reviewed by the engineer and returned to the contractor.
 - Submittals will be reviewed only for general compliance with the contract documents and not for dimensions or quantities. The architect and engineer will make every effort to detect and correct errors, omissions, and inaccuracies in such drawings, but the failure to detect errors, omissions, and inaccuracies shall not relieve the contractor of responsibility for the proper and complete installation in accordance with the intent of the contract documents. The submittal review shall not relieve the contractor of responsibility for purchase of any item in full compliance with the contract documents or its complete and proper installation.
 - Where submittals vary from the contract requirements, the contractor shall clearly indicate on submittal or accompanying documents the nature and reason for the variations.
 - Each manufacturer or his representative must check the application of his equipment and certify at time of shop drawing submittal that the equipment specified has been properly applied and can be installed, serviced and maintained where indicated on the drawings. Advise engineer in writing with submittal drawings of any potential problems. The manufacturer shall be responsible for any changes that might be necessary because of physical characteristics of equipment that have not been called to the engineer's attention at the time of submittal.
 - Submit a minimum of one (1) print and an electronic "pdf" of shop drawings to the architect. The architect and engineer shall review and return a pdf. The contractor shall distribute copies as required to properly conduct the work, including requirements of the operating manual.

- G. Shop Drawing Submittals**
- Submit shop drawings for mechanical, plumbing, fire protection, and control systems, including but not limited to sheetmetal, plumbing fixtures and HVAC equipment with adequate details and scales to clearly show construction. Indicate the operating characteristics for each required item. Clearly identify each item on the submittal as to mark, location and use, using the same identification as provided on the construction documents.
 - Sheetmetal and fire protection shop drawings shall be fully dimensioned and coordinated based on field verified building dimensions and clearances and architectural ceiling layouts. Indicate structural systems, lighting, ductwork and piping at all critical locations.
 - Contractor shall review and indicate his approval of each shop drawing prior to submittal for review. Shop drawings will not be reviewed by the engineer unless the contractor's approval is noted. Do not start work or fabrication until shop drawings have been reviewed by the engineer and returned to the contractor.
 - Submittals will be reviewed only for general compliance with the contract documents and not for dimensions or quantities. The architect and engineer will make every effort to detect and correct errors, omissions, and inaccuracies in such drawings, but the failure to detect errors, omissions, and inaccuracies shall not relieve the contractor of responsibility for the proper and complete installation in accordance with the intent of the contract documents. The submittal review shall not relieve the contractor of responsibility for purchase of any item in full compliance with the contract documents or its complete and proper installation.
 - Where submittals vary from the contract requirements, the contractor shall clearly indicate on submittal or accompanying documents the nature and reason for the variations.
 - Each manufacturer or his representative must check the application of his equipment and certify at time of shop drawing submittal that the equipment specified has been properly applied and can be installed, serviced and maintained where indicated on the drawings. Advise engineer in writing with submittal drawings of any potential problems. The manufacturer shall be responsible for any changes that might be necessary because of physical characteristics of equipment that have not been called to the engineer's attention at the time of submittal.
 - Submit a minimum of one (1) print and an electronic "pdf" of shop drawings to the architect. The architect and engineer shall review and return a pdf. The contractor shall distribute copies as required to properly conduct the work, including requirements of the operating manual.
- H. Record Drawings**
- Each contractor or subcontractor shall keep one (1) complete set of the contract drawings and equipment submittals on the job site on which he shall regularly record any deviations or changes from such contract drawings made during construction. All recording shall be done in color ink.
 - These drawings shall record the installed location of all concealed equipment, piping, electric systems, sewers, wastes, vents, ducts, conduit, etc., by measure dimensions to each such item from column centerlines or readily identifiable and acceptable walls or corners of the building. Plans also shall show invert elevation of sewers and top elevation of all other below-grade lines.
 - Record drawings shall be kept clean and undamaged and shall not be used for any purpose other than recording deviations from working drawings and exact locations of concealed work.
 - After the project is completed, these drawings shall be scanned to an electronic "pdf" format and soft and hard drawings shall be delivered to the architect in good condition, as a permanent record of the installation as actually constructed.

- I. Supervision**
- The contractor shall have in charge of work at all times during construction a competent foreman or superintendent whose experience and background shall qualify him for the work to be performed under this division. Once assigned, the foreman or superintendent shall be retained until completion of the project and any consideration as to his removal on grounds of incompetence shall either be initiated by or referred to the architect for decision.

Section 200510 - Basic Materials and Methods

- A. General**
- Provide all materials, labor, equipment, and accessories required to furnish and install the mechanical items identified in this section.
 - This section includes basic mechanical materials and methods to complement other division

sections in this specification and requirements indicated on the mechanical drawings.

- B. Interferences**
- Before installing any work, contractor shall see that it does not interfere with clearance required for finish on beams, columns, pilasters, walls, or other structural or architectural members, as shown on architectural drawings. If any work is so installed and it later develops that architectural design cannot be followed, contractor shall, at his own expense, make such changes in his work as architect may direct to permit completion of architectural work in accordance with plans and specifications.
 - Install additional offsets on piping or ductwork where required to obtain maximum headroom or to avoid conflict with other work without additional costs to owner.
 - Report any interferences between work under this division and that of any other contractors to architect as soon as they are discovered. Architect will determine which equipment shall be relocated, regardless of which was first installed, and his decision shall be final.
- C. Protection of Work and Property**
- The contractor shall be responsible for safeguarding work, property, and facilities against damage, both his own as well as others with which he may come into contact in the performance of his work.
 - Stored materials shall be protected against damage from weather. Pipe, and duct openings shall be closed with caps or plugs during installation. All fixtures and equipment shall be covered and protected against damage. Any materials or equipment damaged at any stage in the construction shall be replaced or repaired. Final completion, all work shall be in a clean and unblemished condition.
 - During construction, all return air ductwork and transfer air openings serving new and existing air handling equipment and/or adjacent tenant spaces shall be protected. Openings which need to remain active shall be covered and protected with MERV 8 filtration media; openings which can remain inactive during construction shall be covered with plastic sheathing and sealed air tight. Filter media shall be replaced regularly as required during construction in order to ensure adequate airflow through all required active openings. In addition, at the end of each phase of construction and at the end of the construction project, all filtration media within each piece of equipment serving the space shall be replaced.
- D. Supports and Hangers**
- Hangers and supports are to be provided to properly support, secure and align piping and to meet field conditions and as manufactured by Grinnell, Michigan Hanger or Caddy.
 - All hangers, brackets, clamps, etc., shall be of standard weight steel. Perforated strap hangers shall not be used in any work. When two or more pipes are run parallel, they shall be supported on unistrut-type trapeze hangers. Other hangers for pipe 3" in size and smaller shall be clevis. For pipe transporting medium above 150 degrees F and 4" in size and above, use pipe roll. Each hanger is to be sized to include pipe insulation saddle for protection.
 - Where building service lines enter or leave building such as water, sewer, gas, etc., and are installed on filled earth, provide continuous support on a reinforced concrete beam furnished and installed under this division. Support beam on building and with vertical support down to foundation footing and on undisturbed earth at other end. Gas main shall enter building above grade.
 - All vertical piping passing through floors shall be supported at the floor by a riser clamp.
 - Isolate all copper lines form ferrous hangers or supports by using fll filler or vinyl tape.
 - Spacing to comply with ASHRAE standards and code requirements.
- E. Pipe Sleeves, Floor and Ceiling Plates**
- Inside pipes passing through floors or masonry walls shall be provided with machine-cut schedule 40 pipe steel sleeves. The sleeves shall be so sized to allow at least 1/4" clearance between the inside sleeve wall and the pipe or insulation surface. Sheet metal sleeves shall not be used in this work. Pipe sleeves are to extend 2" above finished floor and sealed. Pipe sleeves are to be full wall thickness and sealed.
 - Unused sleeves shall be plugged and finished to match adjoining surface.

- F. Escutcheons**
- Fit all pipe passing through walls, floors or ceilings in finished rooms with steel or brass escutcheons. Where surface is to receive a paint finish, make escutcheons prime painted; otherwise, make escutcheons nickel or chrome plated. Where piping is insulated, fit escutcheons outside insulation.

- G. Pipe Identification and Tags**
- Identify each pipe, valve and controls in equipment rooms, above accessible ceilings and in accessible locations with color identification bands or marker backgrounds to identify contents of pipe with initials and direction of flow located near each valve and fitting, on both sides of pipe passing through walls and on long runs at not over 20'-0" intervals.
 - At place where pipe is to have marking, covered pipe shall be properly primed with clear lacquer. After marking is applied, coat with lacquer. Apply marking adjacent to valves and equipment at major changes in directions, where pipes pass through walls or floors.
 - Each piece of pipe shall be identified by a number, together with a brief description of its purpose, e.g. "Air Handling Unit - East Lobby." Identification shall be embossed or engraved plastic or stamped brass strips firmly attached to the equipment or adjacent wall at the obvious location. The lettering for such strips shall be not less than 1/2" high.
 - All valves shall be provided with brass numbered tags attached to handle with a brass chain or ring. Wiring of tags will not be acceptable. At the completion of the work, a reproducible valve schedule shall be provided. Three (3) copies of this shall be mounted in metal, glass covered frames where requested by the architect. The schedule shall give a description of the line or equipment controlled; the normal position, emergency and/or shutdown position and location given either by description or diagram.
 - All controls, starters, switches, etc., shall be identified by embossed stencil or engraved plate as to device and/or equipment controlled. Control wiring shall be identified with program number and purpose and it services.

- H. Access Panels**
- Each contractor shall be responsible for providing all required access panels necessary for his work. This includes any access panels required for HVAC, plumbing and fire protection. Each contractor shall also provide access panels for any existing conditions as required.
 - Refer to architectural drawings and specifications for type of access panel and coordinate locations prior to any work.
 - Contractor shall mark lay-in ceiling tiles, in a method approved by the architect, where access is required to such mechanical, plumbing, and fire protection equipment, valves, regulators, mixing boxes, fire damper, etc.

- I. Expansion Joints**
- Expansion joints in piping for heating and domestic water system 2-1/2" and below shall be Flexcraft ML loop stainless steel for steel and copper pipe or Flexonics model H, stainless steel bellows, internal guides, anti-torque device for steel pipe and model HB, bronze bellows, internal guides, anti-torque device for copper pipe, end connections to match corresponding pipe construction.
 - Expansion joints in heating and domestic water systems 3" pipe size and above shall be flexonics corrugated bellows type with milled neck rings and control rings; allowable working pressure to be 300 PSIG at 850 degrees F. End connections to be flanged.
 - Pipe alignment guide to be steel spider (copper clad for copper pipe) housed in a steel sleeve with feet for attachment to structure.
 - Expansion loops shall be provided on all pipe runs over 100 ft in length. Size loop per manufacturer's recommendations and as scheduled.
- J. Thermometers and Gauges**
- Pressure gauges shall be provided in pipe lines and at inlets and outlets to equipment as called for or specified. These shall be installed to indicate pressure changes across equipment as well. This means that they will have connections installed as close as possible to equipment flanges. These shall be bourn tube type with 3" minimum dial 1/4 male NPT connection, steel cages with pressure ranges suitable for indicating the normal operating pressure at the two-third point of the scale range. Ashcroft, 3M or Taylor. Connections shall be made with shut-off cock and surge snubber.
 - Thermometers shall be a red mercury in glass-type with adjustable angle feature, 7" minimum scale length with range and bulb length suitable for the application and insertion well. These shall be located where they sense a true temperature and where they can be easily read and be installed with heat transfer grease.

- K. Miscellaneous Steel**
- Furnish and install all miscellaneous steel required for supports, hangers, anchors, guides, etc., required for installation of equipment and materials furnished and installed under this division.

- L. Painting**
- This contractor shall perform all painting incidental to this work.

- All insulation shall be painted at the time of installation with one coat of Benjamin Foster "Lignone" water base paint. At the completion of the work, all such insulation shall be given an additional coat of alkyl resin paint of a color to match existing building structure or as selected by the architect.
- All uncovered black iron pipe, fittings, iron portions of valves, hangers, structural steel, exposed fresh grade shall be enclosed in concrete or all other black iron work shall be thoroughly cleaned and given two coats of alkyl resin paint of a color to match existing building structure or as selected by the architect.
- All architectural exposed sheet metal shall be thoroughly cleaned and neutralized and given two (2) coats of alkyl resin paint of a color to match existing building structure or as selected by the architect.
- All painting shall be done with a brush or roller. Spray painting will be prohibited.
- All finishing materials, thinners, etc., shall be the best quality, first line materials as manufactured by:
 - E. I. Dupont De Nemours and Company
 - Pratt and Lambert, Inc.
 - The Glidden Company
 - The Sherwin-Williams Company
 - The Pittsburgh Plate Glass Company
- All paint materials shall be delivered to the job in the manufacturer's original unopened and labeled containers, and they shall be used strictly in accordance with the manufacturer's directions.
- This contractor shall submit a list of materials to the architect. The list shall state the branch names of the materials that the contractor intends to use. This list shall be secured from the paint manufacturer's literature.
- The architect's approval must be secured before any painting work is started.

- M. Clean-Up**
- Insofar as this contract is concerned, at all times keep premises and building in a neat and orderly condition. Follow explicitly any instructions of architect in regard to storage of materials, protective measures, clean-up-of debris, etc.
 - Upon completion of work, this contractor shall thoroughly clean all apparatus furnished by him, pack all valves and thoroughly clean piping, fixtures and equipment removing all dirt, grease and oil.
 - Air systems shall not be operated without filters. Upon completion of work, replace all filters.

- N. Operating and Maintenance**
- This contractor shall furnish competent personal instruction to the owner's operating personnel for a period of two (2) days in the proper operation of the heating and air conditioning equipment. He shall also supply the owner with copies of an operation manual containing the following:
 - Step-by-step procedures for start-up and shut-down for each system and piece of equipment.
 - Performance data, curves, ratings.
 - Wiring diagrams.
 - Manufacturer's descriptive literature.
 - Automatic controls and diagrams and written description of operation.
 - Manufacturer's maintenance and service manuals.
 - Plumbing fixtures.
 - Spare parts and replacement parts list for each piece of equipment.
 - Name of service agency and installer.
 - Final approved shop drawings.

Section 200623 - Piping and Valves

- A. General**
- Furnish all material, labor, equipment, and accessories as required to install complete fire protection, plumbing, and HVAC piping systems as indicated on drawings and in these specifications.
 - Install in full accordance with local code requirements, see other specification section for additional requirements and install in accordance to manufacturer's recommendations and requirements.

- B. Connections to Equipment Furnished by Others**
- Provide valved water and/or gas connection for equipment furnished by other contractors or owner.
 - Include accessories like code, drawings and manufacturer's installation instructions.
 - Fully coordinate with laboratory equipment, pool equipment, kitchen equipment, and laundry equipment suppliers and confirm all rough-in requirements prior to starting work.

- C. Installation**
- All piping shall be installed parallel with, or at right angles to, the building walls. All vertical risers shall be installed plumb and straight.
 - All piping shall be installed with pitch in the direction of flow of not less than 1" in 40', except as otherwise shown. It must be possible to drain every portion of the piping system.
 - Run lines as direct as possible avoiding unnecessary offsets. However, if offsets are required in order to obtain maximum headroom or to avoid conflict with other work, they shall be made as required or as requested by the architect without additional cost to the owner. The architect reserves the right to make minor changes in the location of piping and equipment during the rough-in, without additional cost to the owner. All changes proposed by others shall be approved by the architect.
 - Lines shall be cut accurately to measurement at the site and worked into place without springing or forcing. Sufficient supports, pipe loops, or expansion joints between anchor points shall be provided as needed, whether or not shown, to limit stresses and control movement of lines subject to the thermal expansion.
 - Before any piping is installed, it shall be up-ended and pounded to remove any foreign matter present, and shall be swabbed. If necessary, for thorough cleaning. After installation and before final connections made, all piping system shall be flushed with a material that is not injurious to either pipe or equipment (See also "Tests and Adjustments.")
 - Pipe to be threaded shall be cut square and full threaded with clean-out tapering threads and shall be reamed after threading. Also threaded connections shall be made with pipe thread compound applied to the wall threads only.
 - The edges of pipe to be welded shall be machine beveled wherever possible. Before welding, the surfaces shall be thoroughly cleaned. The piping shall be carefully aligned. No metal shall project within the pipe. Milled joints are prohibited. Only factory formed fittings shall be used. Elbows shall be long radius type. Flanges shall be welding neck type. Millering of the pipe to form elbows of the notching of straight runs to form the tee connection will not be permitted.
 - Unions or companion flanges shall be installed in all connections to equipment. Automatic valves, etc., as necessary to permit removal of equipment and specialties for servicing, repairing, or cleaning. It shall be possible to remove any piece of equipment by removing only one (1) or two (2) sections of piping.
 - Valves shall be provided in suitable locations at each time of equipment, branch circuit, riser, or section of piping as indicated or required for proper and safe operation of the system and to facilitate maintenance and/or removal of all equipment and apparatus. On horizontal pipe runs, install all valve stems vertically up where possible and in no case shall the stems be urned more than 90 degrees from the vertically up position.

- Drain valves shall be provided at all low points, trapped section, and on the equipment side of all branch valves to permit draining of all parts of all liquid piping systems. These shall have hose ends. Drain piping shall be provided from pump glands, relief valves, etc., to spill at the floor over floor drains or other acceptable discharge points. The drain line shall terminate with plain, unthreaded end.
- Taps (half couplings or tees) shall be provided as necessary to permit the installation of temperature control instruments, thermometers, pressure gauges, air vents, etc.
- Connections between copper piping and screwed ferrous equipment connections or screwed ferrous piping systems shall be made as follows:
 - For stationary non-rotating, non-vibrating equipment connections- dielectric unions.
 - For rotating or vibrating equipment connection- cast brass adapter and bronze flanges with dielectric separation of flanges and bolts.
 - Connections between copper piping and ferrous equipment flanges or flanged ferrous piping systems shall be made using bronze companion flange with dielectric separation of flanges and bolts.
 - Brass or bronze valves in ferrous piping will not require dielectric separation.
- All pressure piping systems shall be installed to conform to the requirements of the state's pressure piping code.
- All excavations for installation of pipe shall be open trench work and shall be kept open until piping has been inspected, tested, and accepted.
- All piping passing thru cast-in place concrete construction shall be sleeved to provide a minimum of 1/2" annular space around entire pipe to be sleeves. Space between sleeve and pipes in

- foundation walls shall be tightly caulked with lead and oakum or mechanical seal to give a waterproof penetration.
- Any piping resting on or coming in contact with building structure shall be insulated at that point to prevent telegraphing of sound.
- Any metal piping laid in corrosive fill shall be encased in concrete or in split tile. All sewers 14"-0" through fresh grade shall be encased in concrete.
- Threaded joints shall conform to American Taper Pipe Thread ASA-B2 1-1960. All burrs shall be removed, pipe ends shall be reamed or filed to size of bore, and all chips removed. Pipe cement shall be used only on male threads.
- Unions shall have metal seats for drainage systems and metal to metal ground seats on water system.
- Furnish and install gate valve and drive valve at the base of all new domestic, chilled and heating water lines, in branches to sill valves, toilet rooms, and other fixture groups. Plumbing fixtures shall have wheel or screwdriver stops as specified.
- All water piping shall be properly supported and shall not be loose or shaky. Water hammer arrester shall be installed in vertical upright position.
- Allow 1-1/4" per 100' of length for expansion in domestic hot water lines.
- Nipples between copper and fixtures fittings shall be brass, not galvanized steel.
- Mechanical joints for heating and chilled water piping can be Victaulic Style 7T standard or Gustin-Bacon No. L00 standard series.

- Mechanical joints for copper piping can be pressure-seal-joint fittings.
- D. Sanitary and Storm Sewers**
- Install sanitary and storm sewers, stacks, vents, drains, etc., as indicated on the drawings.
 - All drainage and vent piping shall be constructed and run as directed as possible; shall be protected from contact with slag or cinders and, wherever practicable, shall be located so as to be accessible for inspection. The actual runs and locations of drains, soil waste, and leader piping shall be installed in accordance with the various conditions at the building and any work necessary to conceal pipes or clear pipes of other trades shall be done as directed by the architect.
 - Sewers to be pitched a minimum of 1/4" per foot for 3" sizes and under and 1/8" per foot for 4" sizes and larger or to grades indicated on drawings.
 - All pipe lines shall be correctly aligned before joints are made. All changes in direction of drainage and vent piping shall be made by means of "Y" branches and 1/8, 1/8, or 1/16, bends. No lines shall be run with unnecessary bends or offsets and where changes in direction are unavoidable, they shall be made by use of proper fittings. Single and double sanitary tees, 1/4 bends and 1/8 bends may be used in vertical sections when direction of flow is from horizontal to vertical. Changes in direction and branch connections shall be made with approved drainage foundation cleanouts at base of each vertical waste and rainwater stack, each change in a direction of piping greater than 45 degrees or as shown on drawings, and within 5' of main sewer after exiting the building. Cleanouts on underground lines shall extend up flush with finished floor or grade. Provide cleanouts not less than 50'-0" center along straight runs. Cleanouts shall be size of pipe to which it is installed up to 6" in diameter. Pipe over 6" in diameter shall have a 6" cleanout.
 - Vent terminals shall be terminated at least 12" above roof. Each vent terminal shall be made water tight with the roof by using sheet copper (8 ounces PSF with base not less than 16" diameter and collar full height) pipe or rubber boot pipe flashing. Where vents are 4" or larger, flashing may be turned over into top of pipe without gap. Furnish flashing to general contractor for building into rooming 23. Interior openings through walls, floors, and ceilings shall be sealed vermin proof.
 - All fixtures and storm drains shall be vented as indicated on drawings and in accordance with code. Vent pipes, where not vertical, shall have continuous slope.
 - Openings in drainage and vent pipes shall be properly plugged when work is not in progress.
 - Roof drains shall be provided with a flashing ring and a 30" X 30" X 4 lb. lead flashing properly fastened to the flashing ring.
 - Storm and sanitary sewers shall be laid with full length of each section resting on a solid bed. Where necessary to obtain a firm support, the pipe shall be bedded on select material and thoroughly tamped. Pipe shall be laid starting at the grade and spigot end of ball and spigot pipe pointing in the direction of flow. As pipe is laid, care shall be exercised to keep interior of pipe clear of foreign matter. Where trenching for pipe is excessively wide, the contractor shall, at his own expense, embed the pipe in concrete to support the added load of backfilling.
 - PVC piping shall not be installed unless permitted by code and shall not be installed in return air plenums.

- Sanitary/storm sewer and vent material shall be as follows:
 - Below grade sanitary and storm inside building
 - Service weight - cast iron pipe ASTM A-7482 with ASTM C-564-80 neoprene compression joints or no-hub with clamps.
 - PVC-DWV plastic ASTM D-1785 with ASTM D-2665 DWV solvent weld socket fittings.
 - Above grade sanitary/storm sewer and vent material shall be as follows:
 - No-hub cast iron pipe CISPI 1-301-78.
 - PVC-DWV plastic ASTM D-1785 with ASTM D-2665 DWV solvent weld socket fittings.
 - 1-1/4" and smaller, SCH 40 galvanized steel pipe ASTM A-120-83 with cast iron screwed fittings ANSI B-16.22 1983.
- Site sanitary and storm sewer and vent material shall be as follows:
 - No-hub cast iron pipe CISPI 1-301-78.
 - PVC-DWV plastic ASTM D-1785 with ASTM D-2665 DWV solvent weld socket fittings.
 - 1/2" to 15" - PVC plastic ASTM D-3034 SDR 35 with ASTM D3212 gasket joints.
 - 18" and over - reinforced concrete pipe (RCP) ASTM C 76-83 with ASTM C 443-79 rubber gasket joints.

- E. Domestic Water Piping**
- Install domestic water piping as indicated on drawings. Include all fittings, valves, hangers, and other accessories including water meter and backflow preventer. Extend domestic water piping to all fixtures and equipment required for complete installation.
 - Include unions, or other disconnect metal, stops or valves for isolation of fixtures and equipment. Valves to be fully compatible with piping for service intended as manufactured by Nicco, Crane or Milwaukee. Include hose or drain valves at low points where fixtures cannot be used for drainage.
 - Install shock absorbers at each quick closing fixture and where required to prevent water hammer as manufactured by J.R. Smith, Sioux Chief or Zurn.
 - Hangers on insulated pipe to be outside of insulation, and secured with a sufficient saddle to protect insulation as manufactured by Grinnell or Michigan.
 - Domestic water piping shall be as follows:
 - 4" and smaller above grade - type "L" hard copper ASTM B 88-83Z with wrought copper fittings ASTM B 18.22 1983 and non-lead or antimony solder joints.
 - 2" and smaller above or below grade - PEX tube and fittings with stainless steel crimp rings. No joints for below grade installation.
 - 2" and smaller above ground - CPVC, Schedule 40; socket fittings and solvent cement joints.
 - Domestic water (within buildings) is 5" above, galvanized steel pipe, galvanized C.I. or M.I. fittings or stainless steel pipe and fittings, and screwed or mechanical joint.
 - Below grade - type "K" soft copper without joints.
 - Domestic water (outside building) is 3" and above, AWWA H3-C1.2 ductile iron cement lined iron cement lined pipe, AWWA H3-C1.2 ductile fittings, and compression or mechanical joint.
 - Flush, vent and sanitize all water piping with chlorine as required per AWWA, local building department and health department codes.
 - Domestic hot and cold water piping under concrete floor to be covered with sand so that piping will not become embedded in the floor slab.
 - All piping under concrete floor shall be type "K" soft copper, continuous. No splices or fittings will be allowed.
 - Extreme caution must be taken so that no copper piping and insulation under concrete floors becomes crushed, cut, split, or deformed during the pouring of the floor slab.
 - Joints between copper pipe to screwed pipe joints shall be made by use of brass or copper converter fittings.

- F. Gas Piping**
- Install gas piping in accordance to National Gas Code, utility companies' requirements and local codes.
 - Include meter and regulator and connect to all gas using equipment.
 - Equipment connections at each unit shall include gas valve, union, dirt leg, and reducer to unit connection size.
 - Construct concrete base below frost line for meter installation.
 - All gas piping shall conform to recommended practice and regulation of the NFPA, Gas Company, the state code, and local codes.

CONSULTANTS



SEAL

CONSULTANTS
TB
 ThorsonOver Associates
 CONSULTING ARCHITECTS
 3000 West Greenbush Road | 300.656.6666 Ph.
 Phoenix, AZ 85029

REV SCHEDULE

#	COMMENT	DATE
1	Permit Resubmission	08.20.18
3	DETAILS & HVAC REDESIGN REV.3	01/10/19

PROJECT NAME / LOCATION

STEAK 44

CAMELBACK VILLAGE CENTER,
 5101 NORTH 44TH STREET,
 PHOENIX, ARIZONA 85018

PROJECT INFORMATION


DATE: 2018-06-15
 PROJECT NO.: 2771-18
 DRAWN BY: TBA

ISSUE FOR
 CONSTRUCTION


MP-100

MECHANICAL
 DEMOLITION PLAN

- HVAC DEMOLITION NOTES**
1. IN EVERY INSTANCE OF DEMOLITION AND/OR REMODELING, THE M.C. SHALL FIGURE A COMPLETE JOB AS NONE OTHER SHALL BE ACCEPTED.
 2. THE DRAWINGS ARE TO BE USED ONLY AS A GUIDELINE FOR DEMOLITION. THE M.C. MUST VISIT THE SITE PRIOR TO BIDDING TO VERIFY ALL WORK REQUIRED FOR A COMPLETE JOB AND INCLUDE THE COST OF SUCH WORK IN HIS BID.
 3. EXISTING MATERIALS SHALL BE TURNED OVER TO THE OWNER, IF NOT REQUIRED BY OWNER, THE MECHANICAL CONTRACTOR SHALL REMOVE THESE MATERIALS FROM THE PREMISES.
 4. THE CONTRACTOR SHALL VISIT THE SITE & BECOME FAMILIAR WITH ALL EXISTING SYSTEMS & MATERIALS WHICH MUST BE REMOVED TO ACCOMMODATE NEW CONSTRUCTION. REMOVE ALL AIR TERMINALS, EXHAUST FANS, DUCTWORK, CONTROLS, HANGERS, INSERTS, GRILLES, ETC., UNLESS INDICATED TO REMAIN. PATCH ALL EXISTING WALLS OR FLOORS WHERE DUCT OR PENETRATIONS HAVE BEEN REMOVED TO MATCH EXISTING, UNLESS SPECIFICALLY NOTED TO BE PATCHED BY OTHERS. LEGALLY DISPOSE OF ALL EQUIPMENT, DUCTWORK, PIPING, ETC. PIPING IS TO BE REMOVED EXCEPT ANY ITEMS SPECIFICALLY DESIGNATED BY OWNER TO BE SALVAGED. REMOVE & PLACE DESIGNATED SALVAGED EQUIPMENT IN A LOCATION DIRECTED BY THE OWNER.
 5. REMOVE ALL MECHANICAL EQUIPMENT NOT OTHERWISE INDICATED TO REMAIN, INCLUDING ALL PIPING, CONTROLS & MOUNTING BRACKETS. CAP CONCEALED PIPING BEYOND EXISTING FINISHED SURFACES. PATCH & SEAL ALL PENETRATIONS TO MATCH EXISTING.
 6. EXISTING EQUIPMENT, PIPING OR OTHER PLUMBING RELATED EQUIPMENT THAT CONTAIN POBS, MERCURY, OR OTHER HAZARDOUS WASTE SHALL BE DISPOSED OF PROPERLY PER ALL EPA AND OTHER APPLICABLE GUIDELINES. CONTRACTOR SHALL NOTIFY ARCHITECT IF ASBESTOS IS FOUND.
 7. LOTS AND STREETS SHALL BE MAINTAINED FREE OF DIRT AND DEBRIS DURING CONSTRUCTION.
 8. MECHANICAL CONTRACTOR TO CONFIRM ALL EXISTING CONDITIONS PRIOR TO COMMENCEMENT OF DEMOLITION - REPORT ANY DISCREPANCIES TO THE ARCHITECT IMMEDIATELY.
- PLUMBING DEMOLITION NOTES**
1. IN EVERY INSTANCE OF DEMOLITION AND/OR REMODELING, THE P.C. SHALL FIGURE A COMPLETE JOB AS NONE OTHER SHALL BE ACCEPTED.
 2. THE DRAWINGS ARE TO BE USED ONLY AS A GUIDELINE FOR DEMOLITION. THE P.C. MUST VISIT THE SITE PRIOR TO BIDDING TO VERIFY ALL WORK REQUIRED FOR A COMPLETE JOB AND INCLUDE THE COST OF SUCH WORK IN HIS BID.
 3. THE P.C. SHALL BE RESPONSIBLE TO REMOVE ALL EXISTING EQUIPMENT AND RELATED PIPING, INSULATION AND HANGERS, ETC. ALL PIPING FROM DEMOLISHED EQUIPMENT AND/OR FIXTURES SHALL BE REMOVED. ALL EXPOSED UNUSED PIPING SHALL BE REMOVED. PIPING THAT PASSES THROUGH THE SLAB OR WALL SHALL BE CUT BELOW OR FLUSH WITH THE FINISHED FLOOR OR WALL. PATCHING SHALL BE BY G.C.
 4. THE P.C. SHALL MAINTAIN SERVICES TO ALL EXISTING EQUIPMENT TO REMAIN, OR ANY OTHER EQUIPMENT UNAFFECTED BY DEMOLITION, BASED ON THE PHASING PLAN. THIS REQUIREMENT INCLUDES BUT IS NOT LIMITED TO THE FOLLOWING: WATER SERVICE, GAS SERVICE, SANITARY SEWERS AND STORM SEWERS.
 5. ANY EXISTING PIPING AND OR MECHANICAL DEVICES BEING DISTURBED BY THE WORK SHALL BE REWORKED BY THIS CONTRACTOR AS REQUIRED TO RETURN IT TO ITS FORMER EXISTING OPERATING CONDITION.
 6. ANY PIPING FEEDING THROUGH EQUIPMENT BEING RELOCATED, REWORKED, OR ABANDONED AND SERVING OTHER AREAS SHALL BE MAINTAINED AS REQUIRED.
 7. THE P.C. SHALL DISCONNECT AND REMOVE WATER SERVICE AND GAS SERVICE TO ALL MECHANICAL AND STORE EQUIPMENT BEING REMOVED AS A RESULT OF THE REMODELING.
 8. EXISTING MATERIALS SHALL BE TURNED OVER TO THE OWNER, IF NOT REQUIRED BY OWNER, THE PLUMBING CONTRACTOR SHALL REMOVE THESE MATERIALS FROM THE PREMISES.
 9. EXISTING EQUIPMENT, PIPING OR OTHER PLUMBING RELATED EQUIPMENT THAT CONTAIN POBS, MERCURY, OR OTHER HAZARDOUS WASTE SHALL BE DISPOSED OF PROPERLY PER ALL EPA AND OTHER APPLICABLE GUIDELINES.
 10. LOTS AND STREETS SHALL BE MAINTAINED FREE OF DIRT AND DEBRIS DURING CONSTRUCTION.
 11. PLUMBING CONTRACTOR TO CONFIRM ALL EXISTING CONDITIONS PRIOR TO COMMENCEMENT OF DEMOLITION - REPORT ANY DISCREPANCIES TO THE ARCHITECT IMMEDIATELY.
 12. PLUMBING CONTRACTOR TO COORDINATE ALL DEMOLITION WITH ALL OTHER TRADES PRIOR TO COMMENCEMENT OF DEMOLITION.
 13. REMOVE ALL EXISTING MECHANICAL AND PLUMBING UNLESS OTHERWISE NOTED. ITEMS TO INCLUDE BUT NOT LIMITED TO: CONDENSATE PIPING, DUCTWORK, CONTROLS FOR MECHANICAL EQUIPMENT, MISCELLANEOUS MECHANICAL EQUIPMENT, EXHAUST FANS, UNIT HEATERS, PLUMBING FIXTURES, ETC. REMOVE PIPING BACK TO MANS AND CAP AS REQUIRED OR AS NOTED ON PLANS. REPAIR ROOF AND WALLS WHERE REQUIRED. ALL EXISTING STORM DRAINS, ROOF DRAINS, AND PIPING TO REMAIN UNLESS OTHERWISE NOTED.

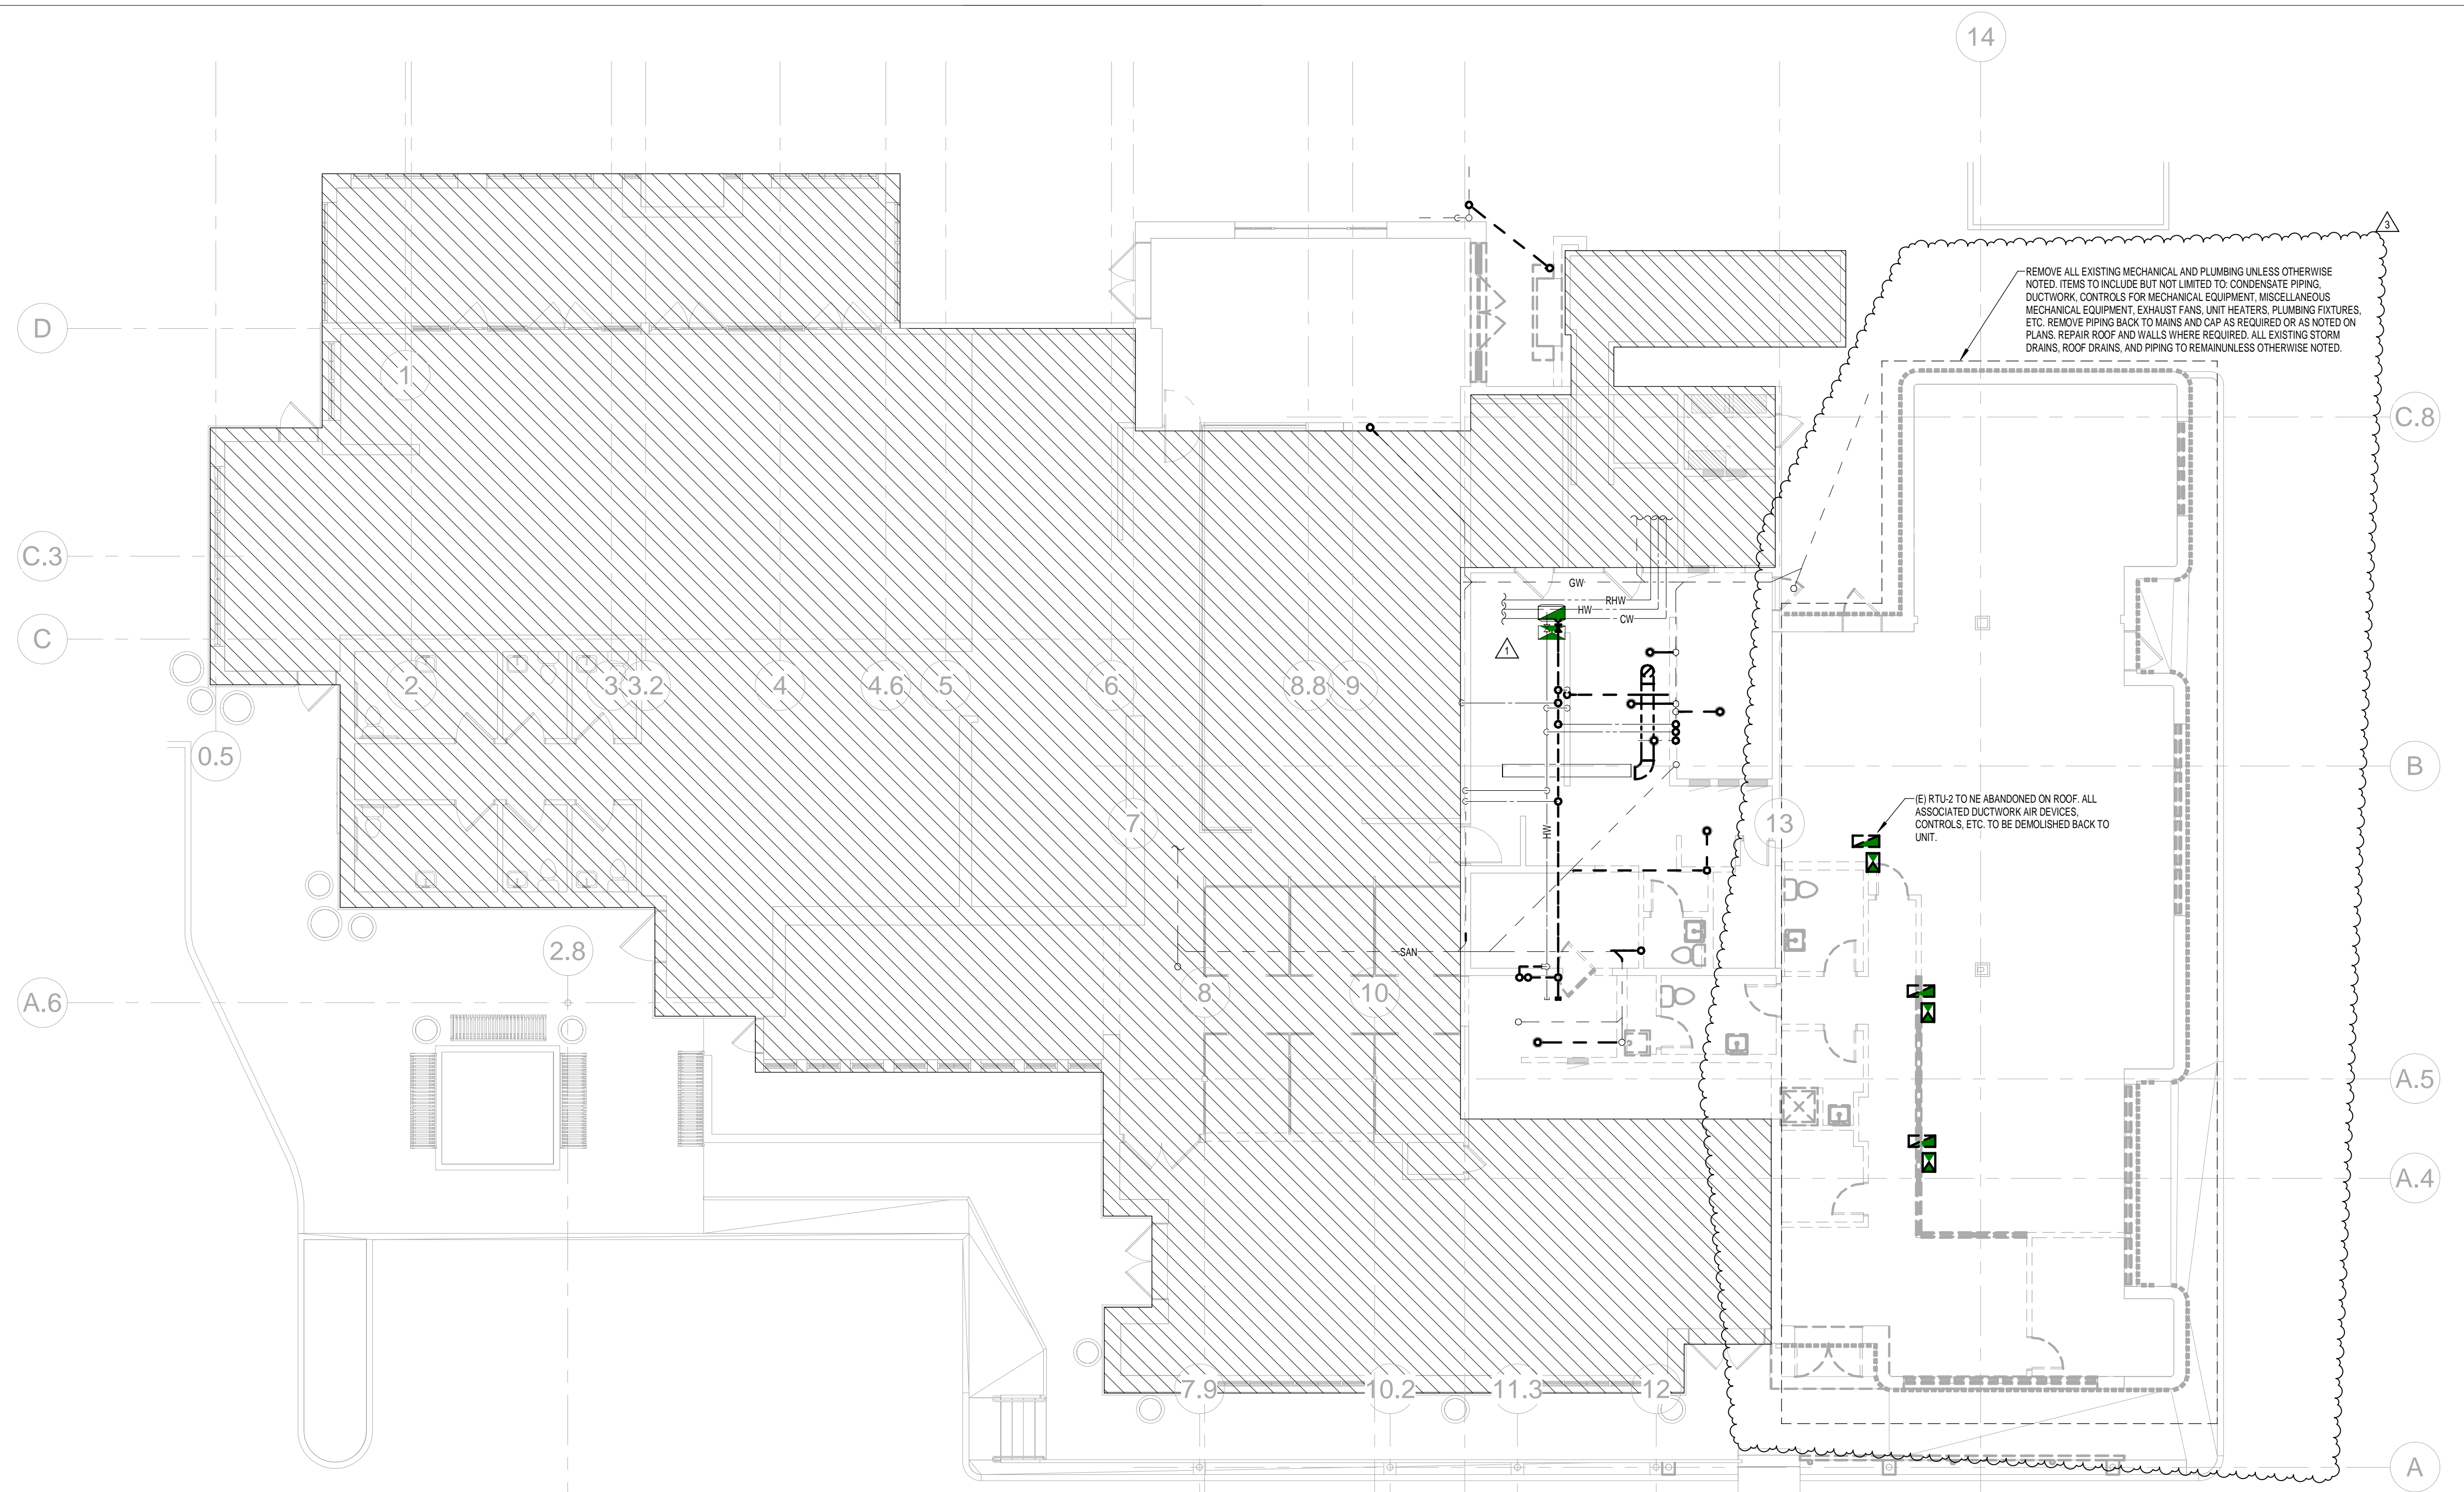

MECHANICAL DEMOLITION PLAN
 1/8" = 1'-0"

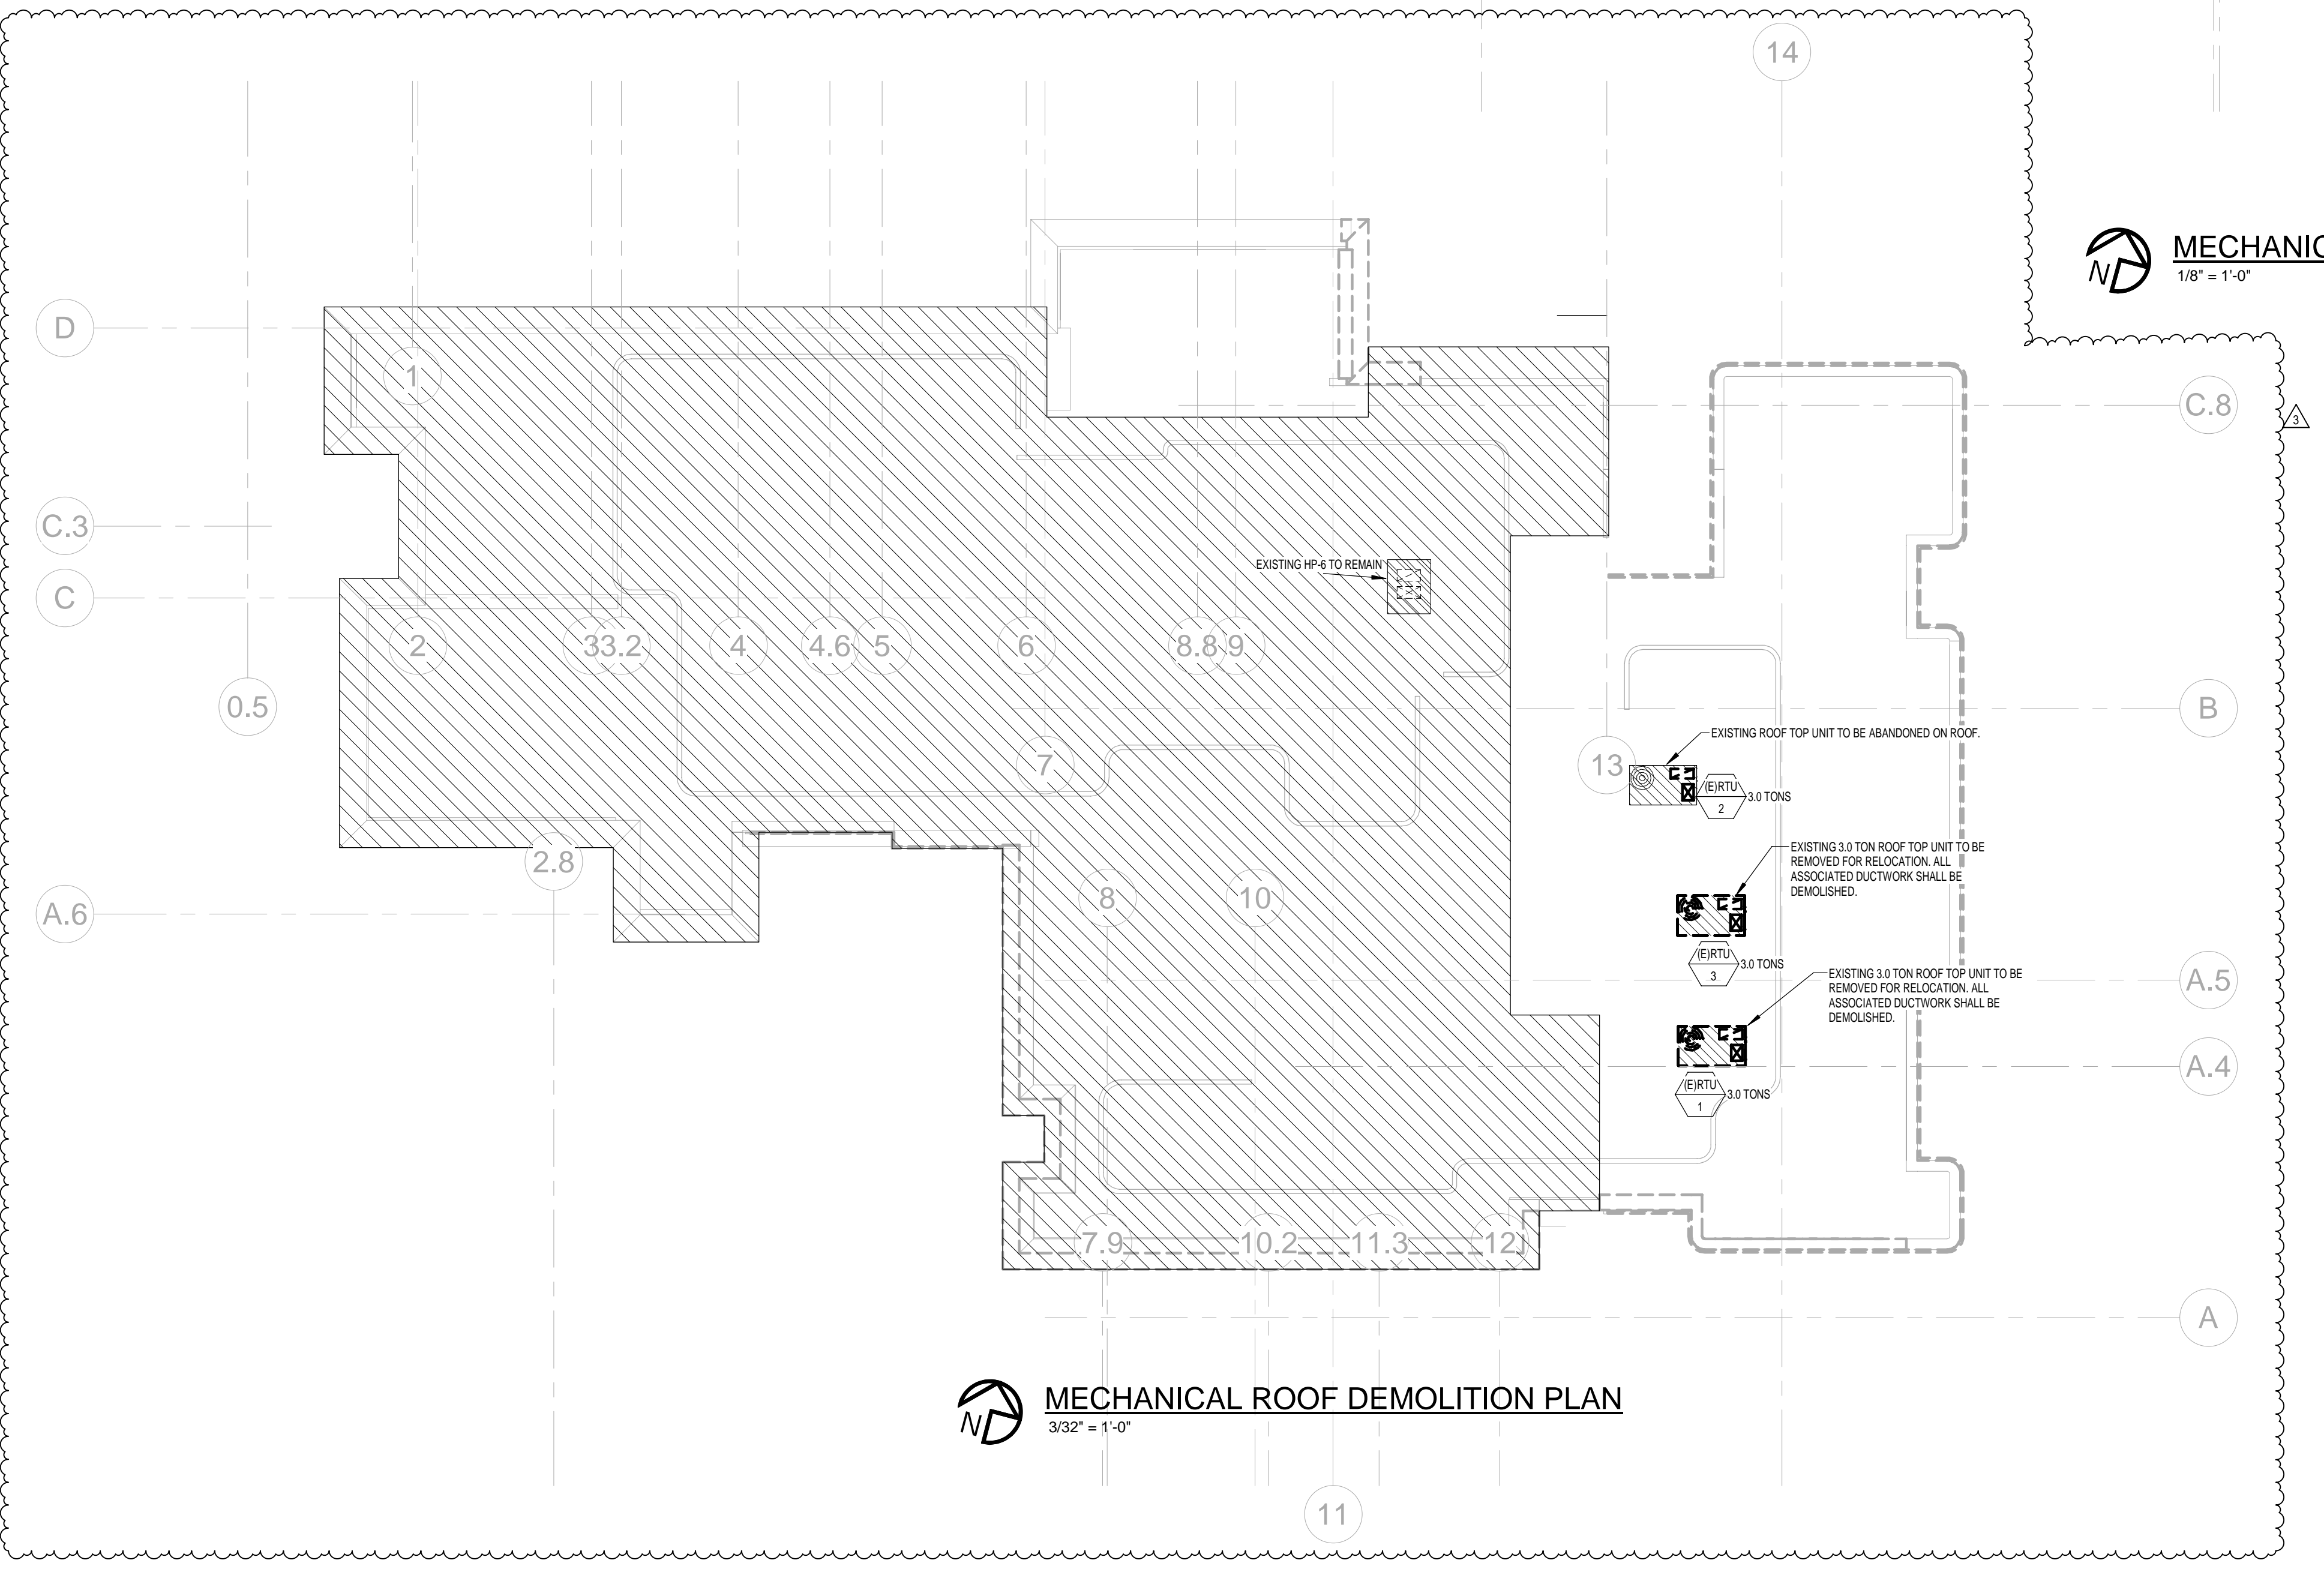

MECHANICAL ROOF DEMOLITION PLAN
 3/32" = 1'-0"