






10/17/03	ADDENDUM NO. 1
3/22/04	MODIFICATION NO. 1
5/21/04	MODIFICATION NO. 3
6/30/04	MODIFICATION NO. 4

R.H. George and Associates, Inc.  
 Consulting Engineering  
 10000 Katy Road, Suite 100  
 Houston, Texas 77024 (713) 860-8300

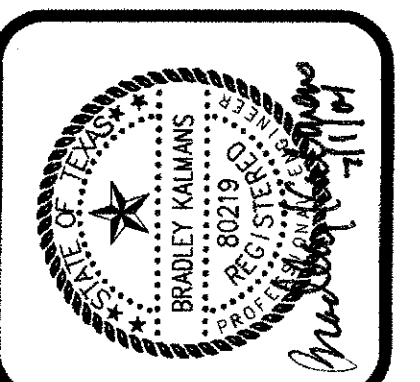


**CDA Architects**  
 A.L.A. Member  
 American Institute of Architects  
 3103 S. Loop West, Suite 1000  
 Houston, Texas 77027  
 Tel: 713/440-3301 Fax: 713/440-3755

**KROGER**  
*Signature*

MECHANICAL FLOOR PLAN  
**KROGER SW-546**  
 LEGACY RANCH SHOPPING CENTER  
 FRISCO, TEXAS

SCALE: AS SHOWN  
 PROJECT: 03048  
 DATE: OCT. 24, 2003  
 SHEET NO. **M11**

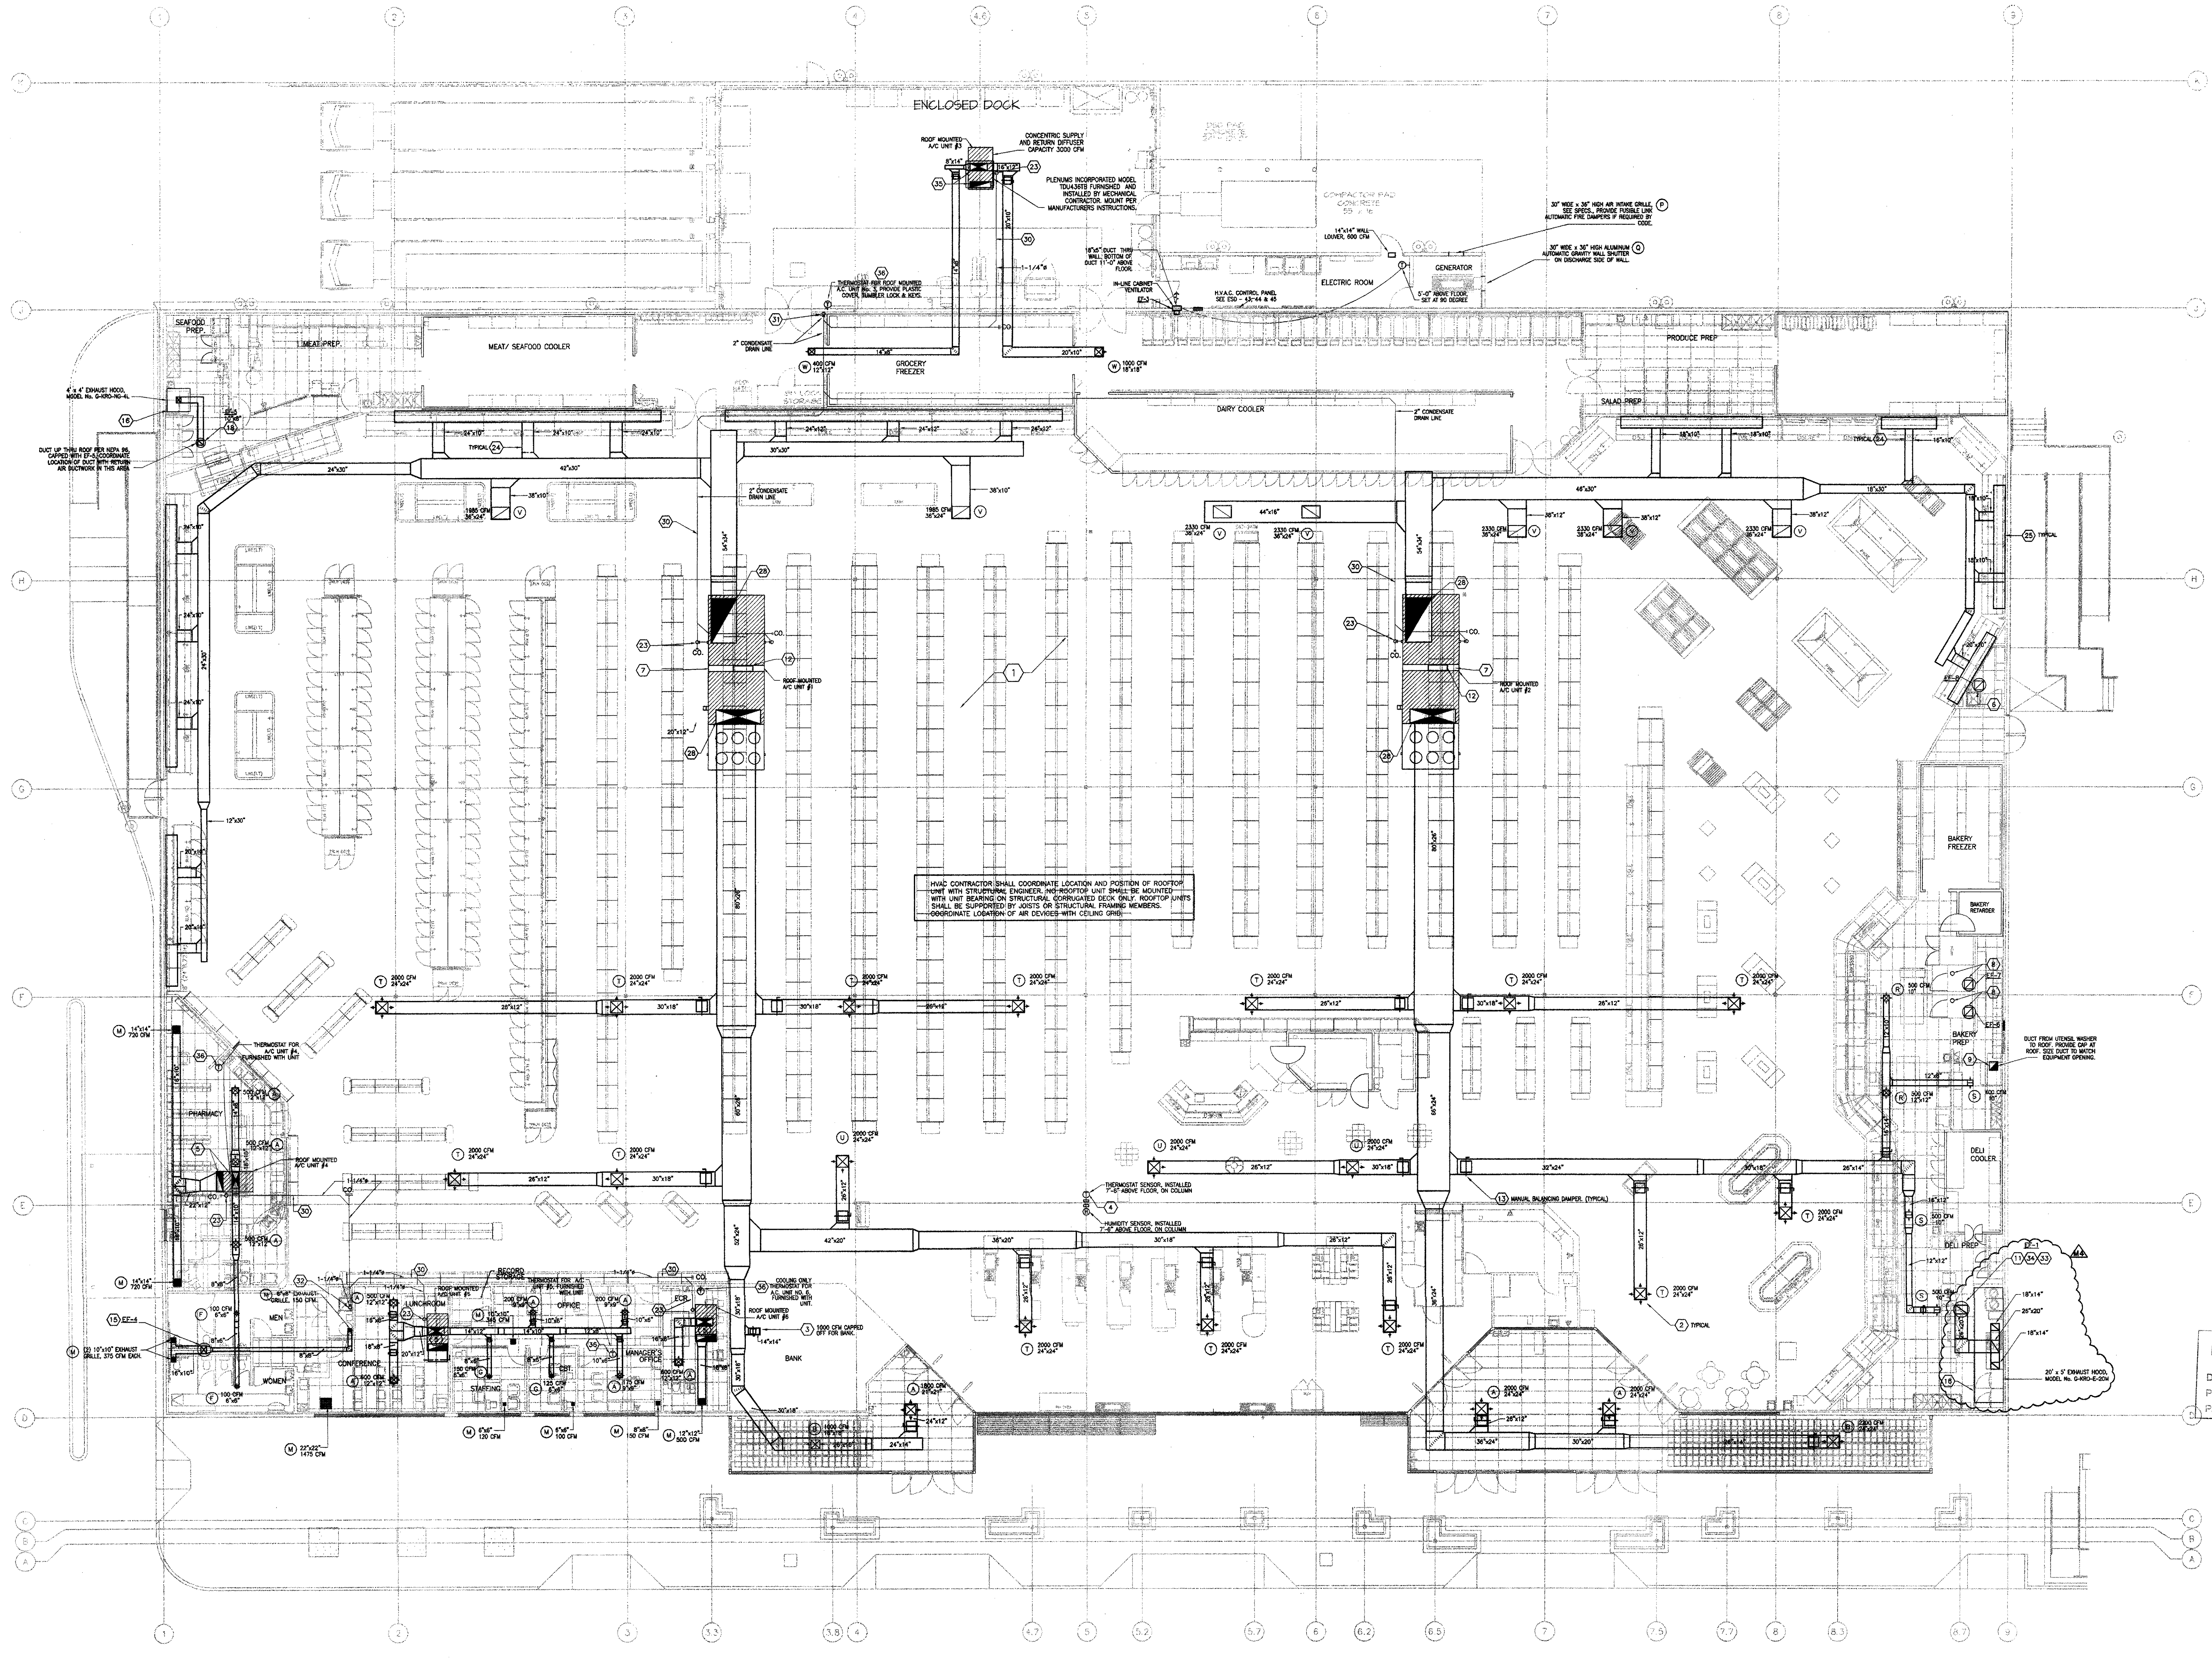

WHEN CONSTRUCTION SHALL COORDINATE LOCATION AND POSITION OF ROOFTOP UNIT WITH STRUCTURAL ENGINEER. THE ROOF TOP UNIT SHALL BE MOUNTED WITH UNIT BEARING ON STRUCTURAL CONCRETE SLAB ONLY. ROOF TOP UNITS SHALL BE SUPPORTED BY JOISTS OR STRUCTURAL FRAMING MEMBERS. COORDINATE LOCATION OF AIR DEVICES WITH CEILING GRID.

Spring Valley Casters/Steel Company  
**AS-BUILT**  
 Date: 11/26/05  
 Project Name: Kroger Legacy Ranch  
 Project Number: 03048

**1 MECHANICAL FLOOR PLAN**  
 SCALE: 3/32" = 1'-0"

H.V.A.C. SYMBOL LEGEND:

90° ELBOW WITH TURNING VANES	STANDARD BRANCH CONNECTION WITH AIR VOLUME CHANGER	90° SPLITTER DAMPER WITH TURNING VANES

NOTES:  
 1. ALL SALES AREA DUCTWORK IN EXPOSED CEILINGS TO BE SHEETMETAL ONLY (NO DUCT BOARD PERMITTED). DUCTWORK IN EXPOSED CEILINGS TO BE UNINSULATED EXCEPT FOR LINING IN FIRST 15'-0" OF DUCTWORK.  
 2. ALL DUCTWORK IN EXPOSED CEILINGS TO BE PAINTED.