


1 MECHANICAL FLOOR PLAN  
SCALE: 1/4" = 1'-0"

- GENERAL NOTES:**
- A. EXISTING CONDITIONS ARE BASED ON RECORD DRAWINGS PROVIDED BY THE OWNER. CONTRACTOR SHALL ADJUST TO ACTUAL FIELD CONDITIONS AT NO ADDITIONAL EXPENSE TO THE PROJECT.
  - B. CONTRACTOR SHALL BE RESPONSIBLE FOR FIELD VERIFICATION OF ALL EXISTING CONDITIONS PRIOR TO SUBMITTING THE BID. NO ADDITIONAL COMPENSATION WILL BE PROVIDED FOR ANY EXTRAS DUE TO THE CONTRACTOR'S FAILURE TO VISIT THE PROJECT SITE PRIOR TO SUBMITTING THE BID. ANY DISCREPANCIES SHALL BE IMMEDIATELY REPORTED TO THE ENGINEER FOR RESOLUTION.
  - C. ALL CONTRACTORS SHALL REVIEW A COMPLETE SET OF CONSTRUCTION DOCUMENTS, CONTRACTORS SHALL FAMILIARIZE THEMSELVES WITH DEMOLITION WORK PRIOR TO BIDDING AND START OF WORK. CONTRACTOR IS RESPONSIBLE TO DEMOLISH ALL EXISTING AS REQUIRED FOR INSTALLATION/CONSTRUCTION OF NEW WORK.
  - D. ALL WORK SHALL BE COMPLETED IN ACCORDANCE WITH ALL APPLICABLE GOVERNMENT AND LOCAL CODES.
  - E. MECHANICAL CONTRACTOR SHALL FIELD COORDINATE WITH ELECTRICAL CONTRACTOR FOR ALL POWER REQUIREMENTS.
  - F. ALL CONTRACTORS SHALL REVIEW A COMPLETE SET OF CONSTRUCTION DOCUMENTS AND COOPERATE WITH THE OTHER TRADES SO THAT THE INSTALLATION OF ALL EQUIPMENT MAY BE PROPERLY COORDINATED.
  - G. ALL EQUIPMENT FURNISHED SHALL FIT THE SPACE AVAILABLE WITH CONNECTIONS IN THE REQUIRED LOCATIONS AND WITH ADEQUATE SPACE FOR OPERATING AND SERVICING. THE DRAWINGS ARE GENERALLY DIAGRAMMATIC AND INDICATE THE INTENT OF THE INSTALLATION WHILE THE SPECIFICATIONS AND EQUIPMENT LIST DENOTE THE TYPE AND QUALITY OF MATERIAL AND WORKMANSHIP TO BE USED. THE DRAWINGS SHALL NOT BE SCALED FOR EXACT MEASUREMENTS. WHERE A CONFLICT EXISTS BETWEEN THE DRAWINGS AND THE SPECIFICATIONS, THE HIGHER AND/OR MORE COSTLY STANDARD WILL APPLY. THE CONTRACTOR SHALL PROMPTLY NOTIFY THE ENGINEER WHOSE DECISION SHALL BE FINAL. NO ALLOWANCE WILL BE MADE SUBSEQUENTLY IN THIS REGARD ON BEHALF OF THE CONTRACTOR AFTER AWARD OF THE CONTRACT.
  - H. COORDINATE DUCT ROUTING AND HEIGHTS WITH GENERAL CONTRACTOR. VERIFY ALL CLEARANCES BEFORE STARTING WORK.
  - I. THE CONTRACTOR SHALL INSTALL ALL PIPING, DUCTWORK AND EQUIPMENT AS REQUIRED IN THE REQUIRED LOCATIONS AND WITH ADEQUATE SPACE FOR OPERATING, MAINTENANCE OR REPAIR ACCESSIBLE.
  - J. ALL DUCT CONNECTIONS TO HVAC EQUIPMENT MUST BE MADE WITH FLEXIBLE CONNECTORS.
  - K. DO NOT ATTACH ANYTHING TO DECK ABOVE. ATTACH TO STRUCTURE (I.E., BEAMS, JOISTS) ONLY. DUCT HANGERS SHALL BE INSTALLED IN ACCORDANCE WITH LOCAL CODE. ALL CONNECTIONS TO JOISTS SHALL BE MADE AT THE TOP CORNER.
  - L. ALL DUCT DIMENSIONS INDICATED ARE CLEAR INSIDE DIMENSIONS. ALL SUPPLY AND UNTEMPERED OUTDOOR AIR DUCTWORK SHALL BE LINED WITH 1" ACOUSTICAL DUCT LINER OR WRAPPED WITH 1-1/2" THICK FIRE RETARDANT FIBERGLASS WITH A REINFORCED ALUMINUM FOIL JACKET AND SHALL BE APPROVED FOR USE BY SMACNA AND NATIONAL RETURN AIR TRANSFER DUCTS AND RETURN DUCTWORK WITHIN 10 FEET OF THE UNIT. RETURN AIR DUCTWORK SHALL BE LINED WITH 1" ACOUSTICAL DUCT LINER OR WRAPPED WITH 1-1/2" THICK FIRE RETARDANT FIBERGLASS WITH A REINFORCED ALUMINUM FOIL JACKET AND SHALL BE APPROVED FOR USE BY SMACNA AND NATIONAL RETURN AIR TRANSFER DUCTS AND RETURN DUCTWORK WITHIN 10 FEET OF THE UNIT. RETURN AIR DUCTWORK SHALL BE LINED WITH 1" ACOUSTICAL DUCT LINER OR WRAPPED WITH 1-1/2" THICK FIRE RETARDANT FIBERGLASS WITH A REINFORCED ALUMINUM FOIL JACKET AND SHALL BE APPROVED FOR USE BY SMACNA AND NATIONAL RETURN AIR TRANSFER DUCTS AND RETURN DUCTWORK WITHIN 10 FEET OF THE UNIT.
  - M. EXPOSED SPIRAL DUCT TO BE GALVANIZED FINISH, FREE FROM SCRATCHES, DENTS OR BLEMISHES AND PAINTED TO MATCH THE SURROUNDING AREA. DUCT SHALL BE INTERNALLY LINED AND SEALED WITH DUCT SEALER COMPLETELY CONCEALED WITHIN THE DUCT JOINT. NO EXPOSED SEALER OR TAPE WILL BE ACCEPTED.
  - N. ALL EXPOSED DUCTWORK SHALL BE INSTALLED TIGHT TO THE BOTTOM OF THE STRUCTURE.
  - O. PROVIDE REMOTE VOLUME DAMPER CONTROL MANUFACTURED BY YOUNG REGULATOR OR UNITED ENERTECH FOR DAMPERS LOCATED ABOVE INACCESSIBLE CEILING. LOCATE CONTROLLER ABOVE ACCESSIBLE CEILING LOCATION.
  - P. REFRIGERANT PIPING SHALL BE SIZED PER MANUFACTURER'S RECOMMENDATIONS. PROVIDE ALL ACCESSORIES AS REQUIRED BY MANUFACTURER FOR COMPLETE WORKING SYSTEM, INCLUDING ANY ACCESSORIES ASSOCIATED WITH LONG LENGTH APPLICATIONS WHERE APPLICABLE.
  - Q. TENANT'S CONTRACTOR SHALL BE RESPONSIBLE FOR THE FIELD VERIFICATION OF ALL UTILITY RUNS AND/OR OTHER IMPROVEMENTS LOCATED ON THE PREMISES PRIOR TO BIDDING. TENANT'S CONTRACTOR SHALL ALSO BE RESPONSIBLE FOR ALL COSTS RELATING TO THE RELOCATION OF, DAMAGE TO, REPAIR OF ANY EXISTING UTILITY RUNS AND/OR IMPROVEMENTS WHICH ARE DAMAGED AS A RESULT OF TENANT'S WORK ON OR AROUND THE PREMISES.
  - R. ALL ROOFING WORK SHALL BE PERFORMED BY LANDLORD'S APPROVED ROOFING CONTRACTOR AT TENANT'S EXPENSE, IF REQUIRED IN LEASE OR TENANT CRITERIA MANUAL.
  - S. ALL GREASE EXHAUST DUCTWORK SHALL BE PROVIDED WITH 3" FOIL FACED THERMAL-CERAMIC INSULATION FOR GREASE DUCTS. INSULATION SHALL MEET NFPA 96 AND ASTM 2335 REQUIREMENTS.
  - T. GREASE DUCT LEAKAGE TESTING MUST BE PERFORMED PRIOR TO CONCEALMENT OF THE DUCTWORK.
  - U. MECHANICAL CONTRACTOR SHALL PROVIDE TENANT WITH A WRITTEN ONE (1) YEAR WARRANTY ON ALL HVAC EQUIPMENT PROVIDED AND / OR INSTALLED. THE WARRANTY SHALL INCLUDE ALL LABOR, MATERIALS AND THREE (3) ROUTINE SERVICES INCLUDING FILTER CHANGES DURING A ONE (1) YEAR PERIOD.
  - V. AT THE COMPLETION OF CONSTRUCTION AN NEBB, AABC OR TABB CERTIFIED AIR BALANCE REPORT SHALL BE SUBMITTED TO THE ENGINEER AND LANDLORD. PRIOR TO SCHEDULING BALANCE CONTRACTOR SHALL COORDINATE WITH LANDLORD'S FIELD REPRESENTATIVE FOR THE VENDOR LISTED BELOW. IF APPROVED, THE BALANCING SHALL BE COMPLETED BY NATION TAB. CONTACT WILL TURNBOURNE AT WILL@NATIONTAB.COM OR 314-954-6244.
- HVAC NOTES:**
1. NEW CAPTIVEAIRE GREASE EXHAUST HOOD TO BE FURNISHED BY OWNER FOR INSTALLATION BY THE MECHANICAL CONTRACTOR. SEE CAPTIVEAIRE SHEETS M701 THROUGH M708 FOR ADDITIONAL INFORMATION. BALANCE HOOD MAKE-UP AIR SUPPLY AIR, AND EXHAUST COLLAR AS NOTED ON THE HOOD SCHEDULE. PROVIDE FULL SIZE TRANSITION MAKE-UP AIR DUCT FROM COLLAR TO MAKE-UP AIR DUCT AND CONDITIONED AIR DUCT AS INDICATED ON PLANS. PROVIDE EACH DROP WITH VOLUME DAMPERS.
  2. TRANSITION FROM HOOD EXHAUST COLLAR AS INDICATED ON PLANS AND EXTEND 14/14 KITCHEN HOOD GREASE EXHAUST DUCTWORK UP TO GREASE EXHAUST FAN ON ROOF. SEE SHEET M150 FOR CONTINUATION. GREASE DUCT SHALL BE WRAPPED WITH TWO (2) LAYERS OF THERMAL CERAMIC FAST WRAP OF 1 1/2" THICK WITH 3" PERIMETER AND LONGITUDINAL OVERLAPS OR EQUIVALENT U.L. LISTED GREASE DUCT WRAP FOR ZERO CLEARANCE TO COMBUSTIBLES. REFER TO DETAIL ON SHEET M501 FOR ADDITIONAL INFORMATION.
  3. AIR CURTAIN FOR SERVICE THRU WINDOW IS INTEGRAL TO THE WINDOW. REFER TO ARCHITECTURAL SHEETS FOR ADDITIONAL INFORMATION.
  4. PROVIDE 8/8 EXHAUST AIR DUCT UP TO EF-1 ON ROOF.
  5. CONTRACTOR SHALL UNDERCUT DOOR 3/4".
  6. PROVIDE REFRIGERANT LINES FROM ASHP-1 ON ROOF TO FC-1 IN ROOM 112. LINES SHALL BE SIZED ACCORDING TO MANUFACTURER'S SPECIFICATIONS. PROVIDE ALL ACCESSORIES AS REQUIRED BY MANUFACTURER FOR COMPLETE WORKING SYSTEM, INCLUDING ANY ACCESSORIES ASSOCIATED WITH LONG LENGTH APPLICATIONS WHERE APPLICABLE.
  7. PROVIDE REFRIGERANT LINES FROM ASHP-2 ON ROOF TO FC-2 IN ROOM 115. LINES SHALL BE SIZED ACCORDING TO MANUFACTURER'S SPECIFICATIONS. PROVIDE ALL ACCESSORIES AS REQUIRED BY MANUFACTURER FOR COMPLETE WORKING SYSTEM, INCLUDING ANY ACCESSORIES ASSOCIATED WITH LONG LENGTH APPLICATIONS WHERE APPLICABLE.
  8. PROVIDE NEW FULLY DIGITAL 7 DAY PROGRAMMABLE TYPE THERMOSTAT WITH REMOTE SENSING CAPABILITIES, AUTO CHANGE OVER AND AUTO SET BACK. MOUNT THERMOSTAT AT 48" ABOVE FINISHED FLOOR. THERMOSTATS SERVING THE SAME TEMPERATURE ZONE SHALL BE INTERLOCKED TO PREVENT SIMULTANEOUS HEATING AND COOLING. PROVIDE REMOTE TEMPERATURE SENSORS AS INDICATED ON PLAN. COORDINATE LOCATION WITH WALL GRAPHICS LAYOUT.
  9. PROVIDE NEW FC UNIT AS NOTED ON PLANS AND AS SCHEDULED ON SHEET M501. PROVIDE REMOTE VOLUME DAMPER AS INDICATED ON PLANS. REFERENCE SHEET M502, DETAIL 5, FOR ADDITIONAL INFORMATION.
  10. PROVIDE CLEANOUTS ON GREASE DUCTWORK AS REQUIRED BY CODE. REFERENCE SHEET M501, DETAIL 5 FOR ADDITIONAL INFORMATION. TYPICAL OF GREASE EXHAUST DUCTWORK.
  11. PROVIDE NEW GAS HEATER AS NOTED ON PLANS AND SCHEDULED ON SHEET M501. INSTALL PER MANUFACTURER'S INSTRUCTIONS AND MAINTAIN ALL REQUIRED CLEARANCES. COORDINATE INSTALLATION LOCATION AND HEIGHTS WITH ARCHITECT.
  12. TOP OPEN RETURN AIR DUCT. PROVIDE OPENING WITH 1/4" MESH GALVANIZED SCREEN.
  13. ROUTE AND TRANSITION DUCTWORK AS REQUIRED TO AVOID STRUCTURAL OR CEILING CONFLICTS.
  14. DOOR MANUFACTURER TO PROVIDE A "KIT" TO FASTEN THE BOTTOM FLANGE OF THE HOOD TO THE WALL, WITH ONE FASTENER PER STUD WALL. SIL-BOND RTV 4500 ALUMINUM SILICONE SEALANT OR APPROVED SIMILAR, TO BE APPLIED BY GENERAL CONTRACTOR / HOOD INSTALLER / HOOD CONTRACTOR FOR ANY REMAINDER. HOOD FASTENING "KIT" DETAIL TO BE INCLUDED IN MANUFACTURER DRAWINGS. REFERENCE SHEET M502, DETAIL 14, FOR ADDITIONAL INFORMATION.
  15. ROUTE AND TRANSITION DUCTWORK AS REQUIRED TO AVOID STRUCTURAL OR CEILING CONFLICTS. DUCTWORK TO BE RUN BETWEEN THE TRUSSES OR WITHIN THE WEBBING. COORDINATE WITH THE ELECTRICAL CONTRACTOR AND NOTIFY THE ARCHITECT WITH ANY CONFLICTS.

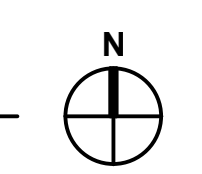

**SHAKE SHACK**  
 NV - 1443 - CRAIG ROAD  
 1830 W Craig Rd  
 NLV NV 89031

**Gensler**  
 500 South Figueroa Street  
 Los Angeles, California 90071  
 United States  
 TEL 213.327.3600  
 FAX 213.327.3601

3883 Howard Hughes Parkway  
 Suite 650  
 Las Vegas, NV 89169  
 United States  
 TEL 702.893.2800  
 FAX 702.893.2805


**kpff**  
 ST ENGINEER  
 700 S FLOWER ST  
 SUITE 2100  
 LOS ANGELES, CA 90017  
 TEL 213.418.0201

**Schnackel**  
 MEPP ENGINEER  
 3035 SOUTH 72ND STREET  
 OMAHA, NE 68124  
 TEL 402.391.7990

**TriMark**  
 FOODSERVICE CONSULTANT  
 505 COLLINS ST  
 PO BOX 3505  
 SOUTHATLORO MA  
 02703  
 TEL 508.399.6000  
 FAX 508.761.3620

**Kimley Horn**  
 CIVIL CONSULTANT  
 401 B ST.  
 STE 600  
 SAN DIEGO, CA 92101  
 TEL 619.744.0181

Date	Description
1 07/07/2022	ADDENDUM 1
2 09/22/2022	ADDENDUM 2
3 10/27/2022	ADDENDUM 3
4 02/07/2023	ISSUE FOR CONSTRUCTION
5 02/21/2023	FIELD NOTICE 1
A 04/05/2023	FIELD NOTICE 1

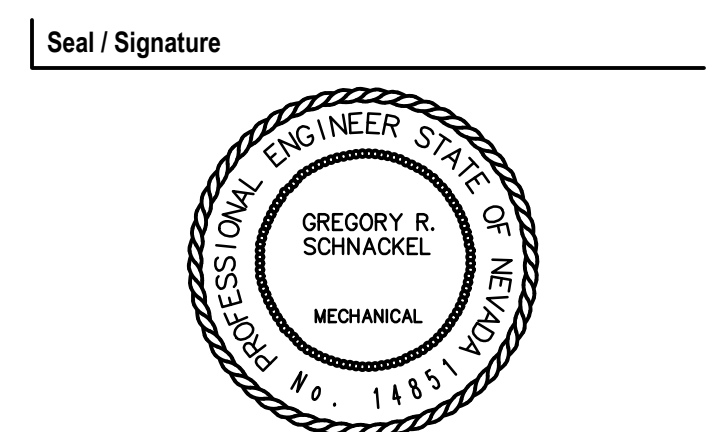

Project Name  
**CRAIG ROAD**

Project Number  
**005.3901.000**

Description  
**MECHANICAL FLOOR PLAN**

Scale  
 1/4" = 1'-0"

**M101**

Date	Description
1 07/07/2022	ADDENDUM 1
2 09/22/2022	ADDENDUM 2
3 10/27/2022	ADDENDUM 3
4 02/07/2023	ISSUE FOR CONSTRUCTION
5 02/21/2023	FIELD NOTICE 1
A 04/05/2023	FIELD NOTICE 1

Seal / Signature




Project Name  
**CRAIG ROAD**

Project Number  
**005.3901.000**


Description  
**MECHANICAL DETAILS**

Scale  
 1/4" = 1'-0"


**M502**

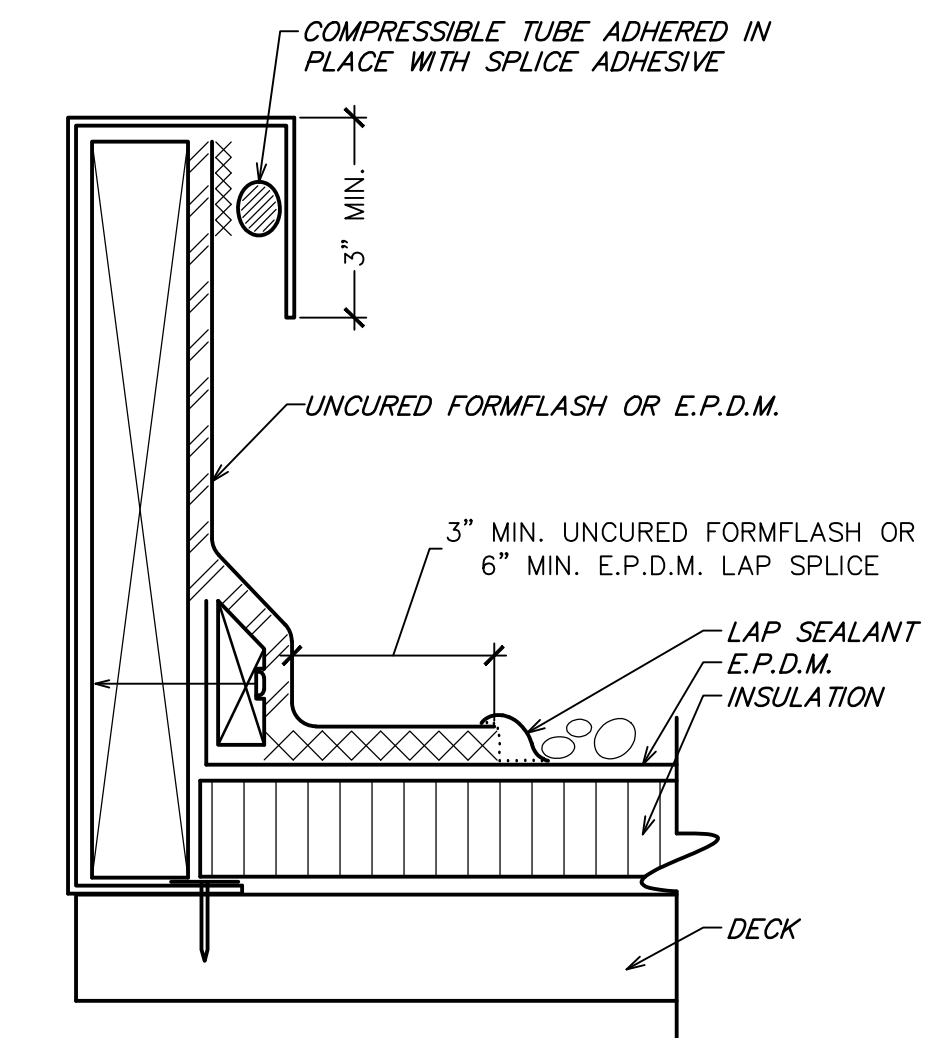


**12 CURB FLASHING DETAIL**  
 NOT TO SCALE

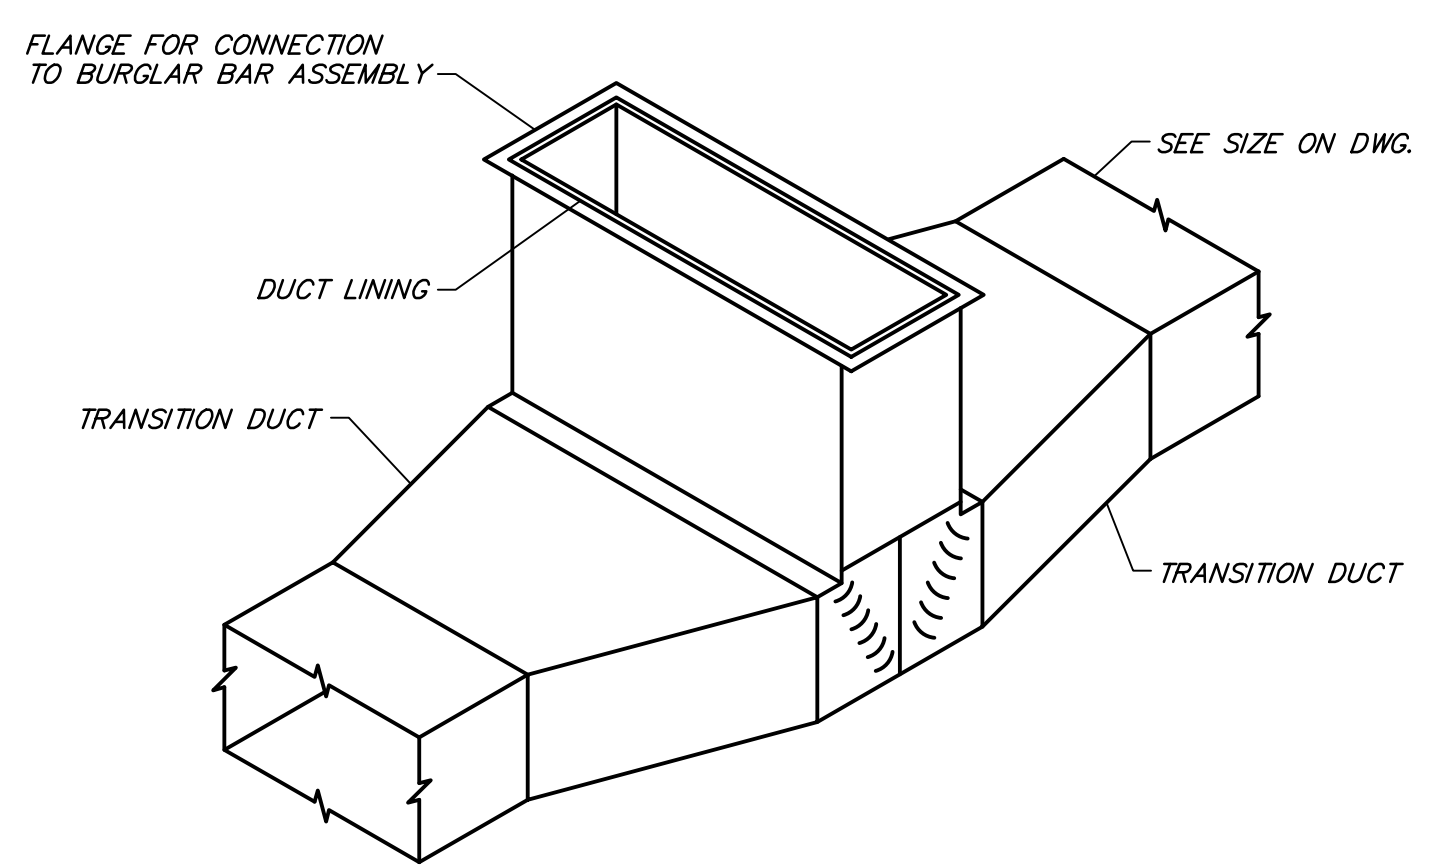


**9 TYPICAL ROOF TOP UNIT TEE CONNECTION**  
 NOT TO SCALE

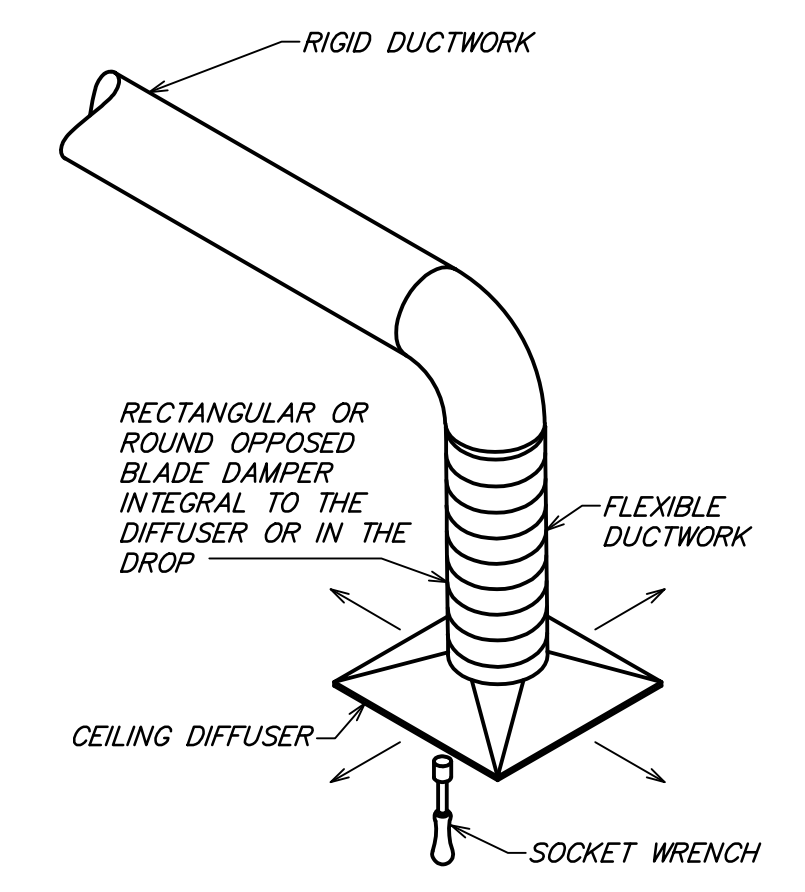


**5 REMOTE VOLUME DAMPER CONTROLLER**  
 NOT TO SCALE

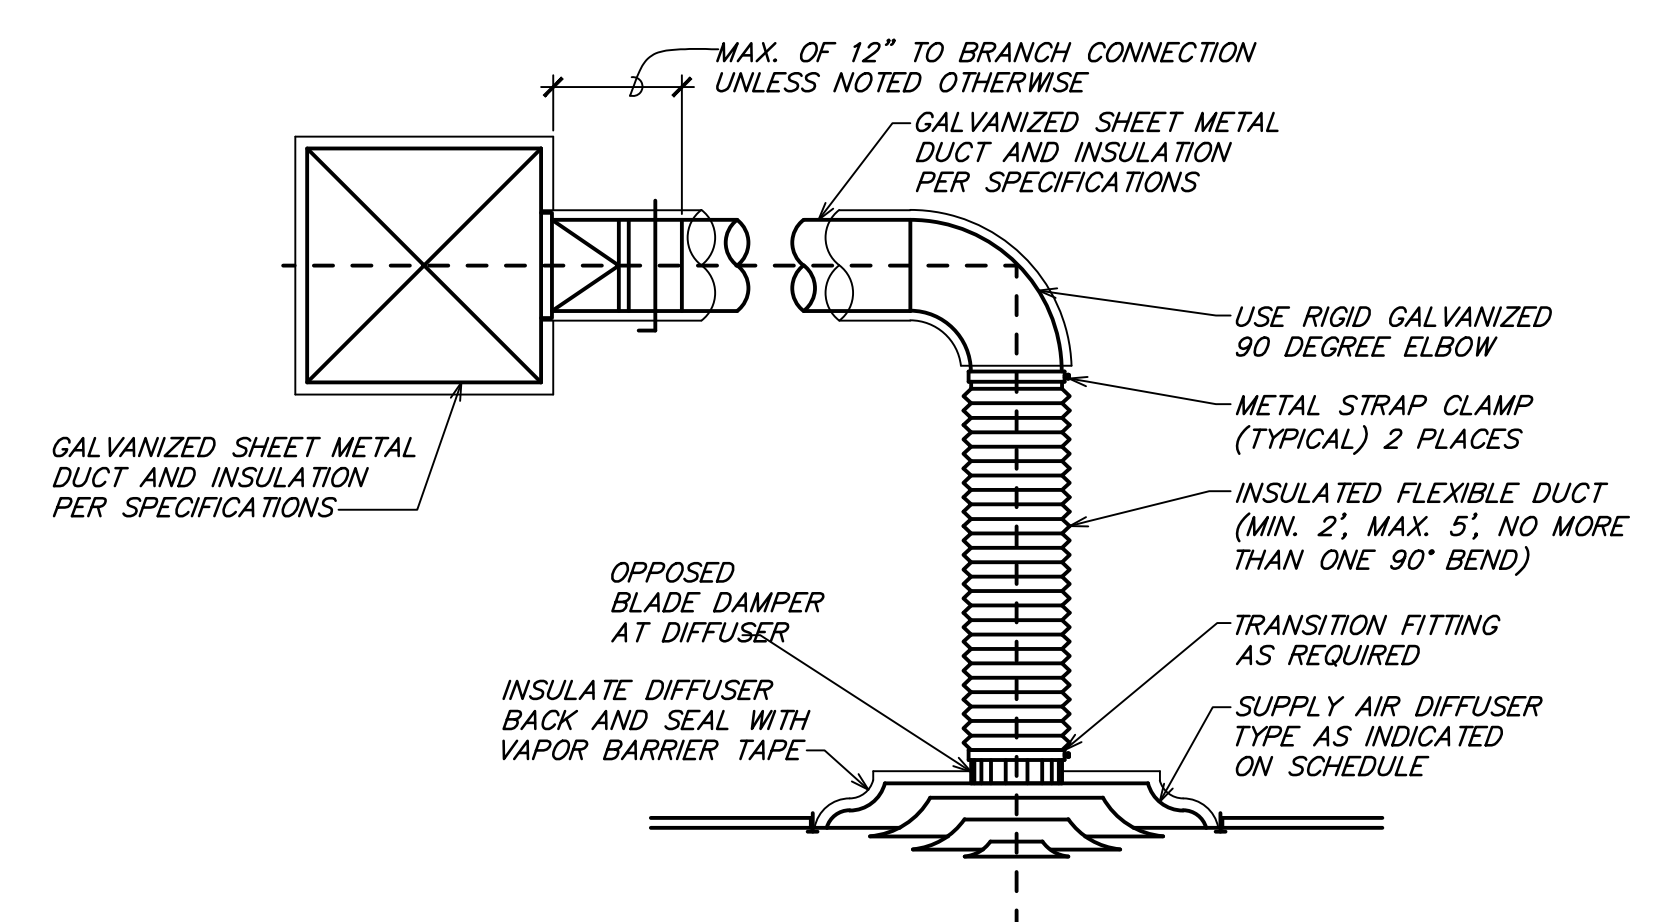


**1 TYPICAL DIFFUSER CONNECTION**  
 NOT TO SCALE

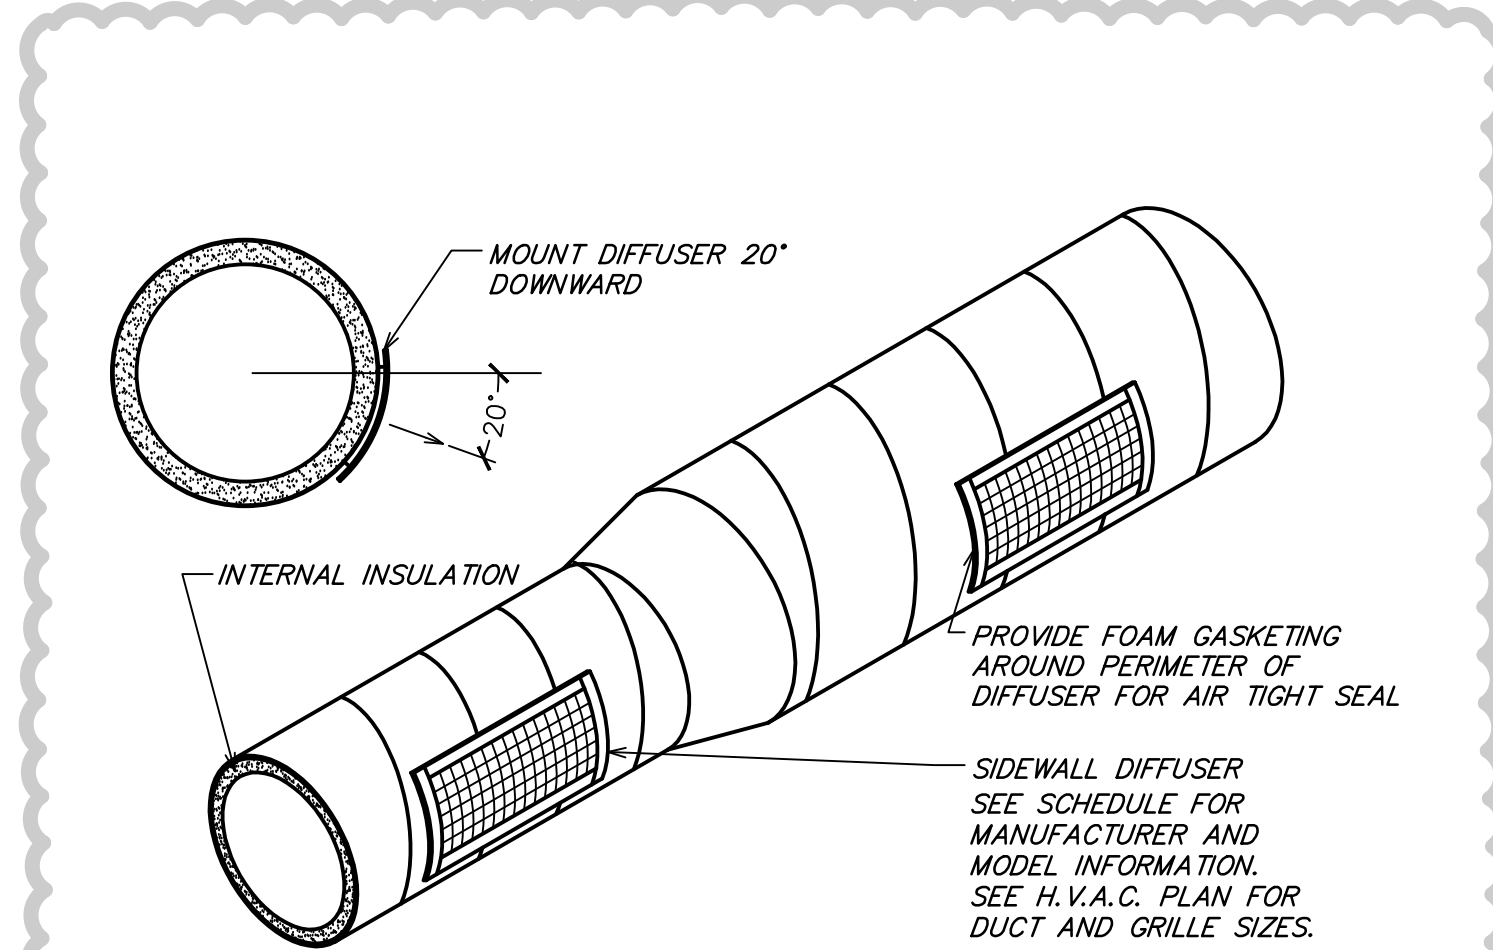


**13 SPIRAL DUCT DIFFUSER DETAIL**  
 NOT TO SCALE

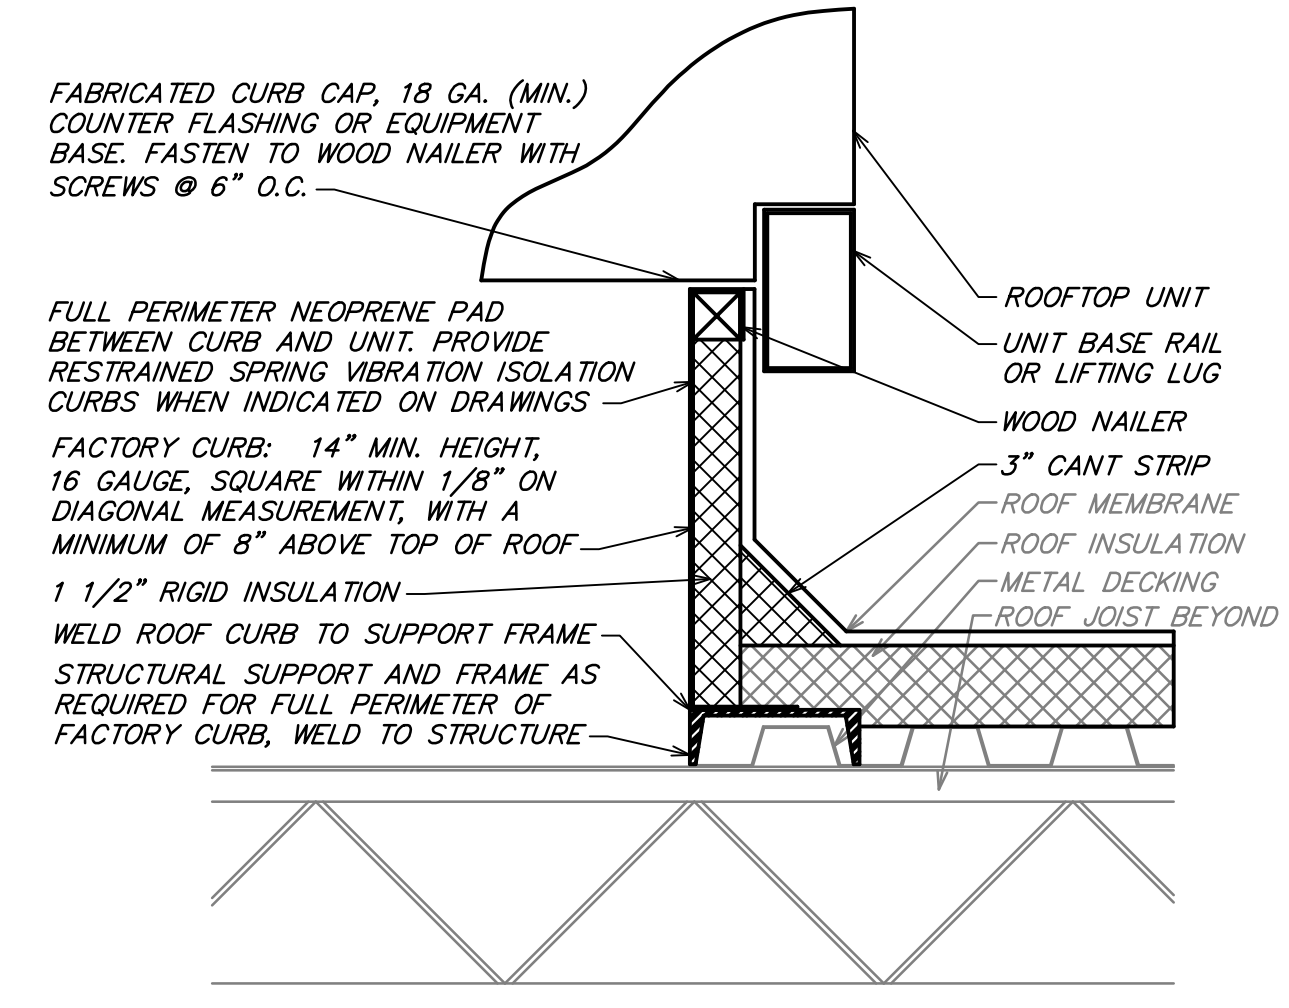


**10 ROOF CURB DETAIL**  
 NOT TO SCALE

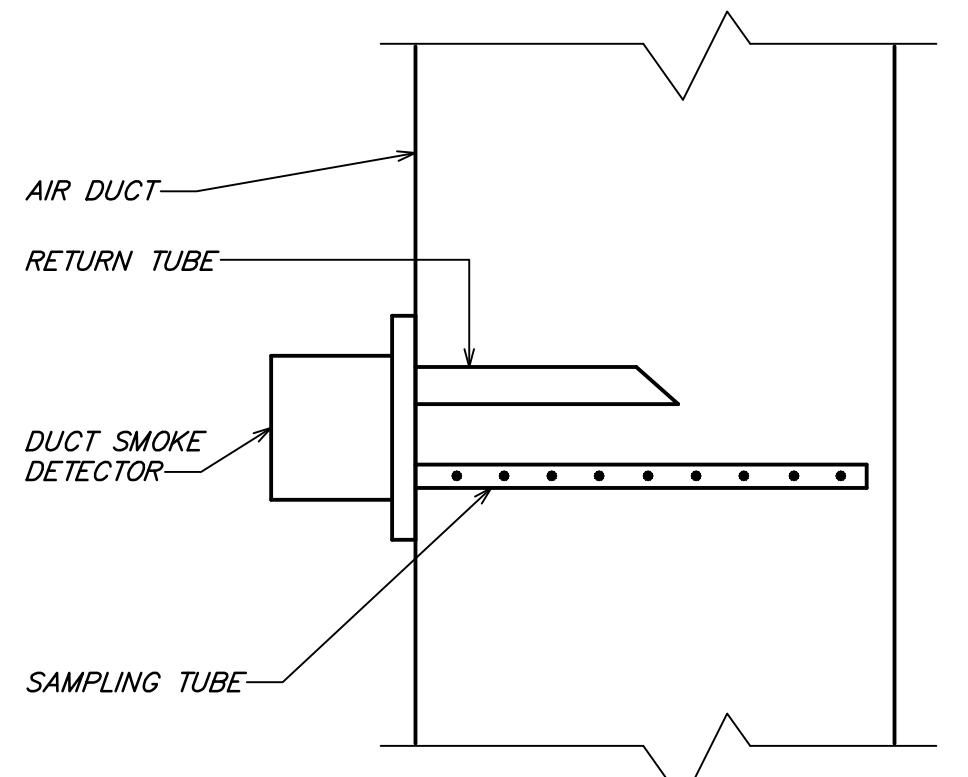

**6 DUCT SMOKE DETECTOR DETAIL**  
 NOT TO SCALE

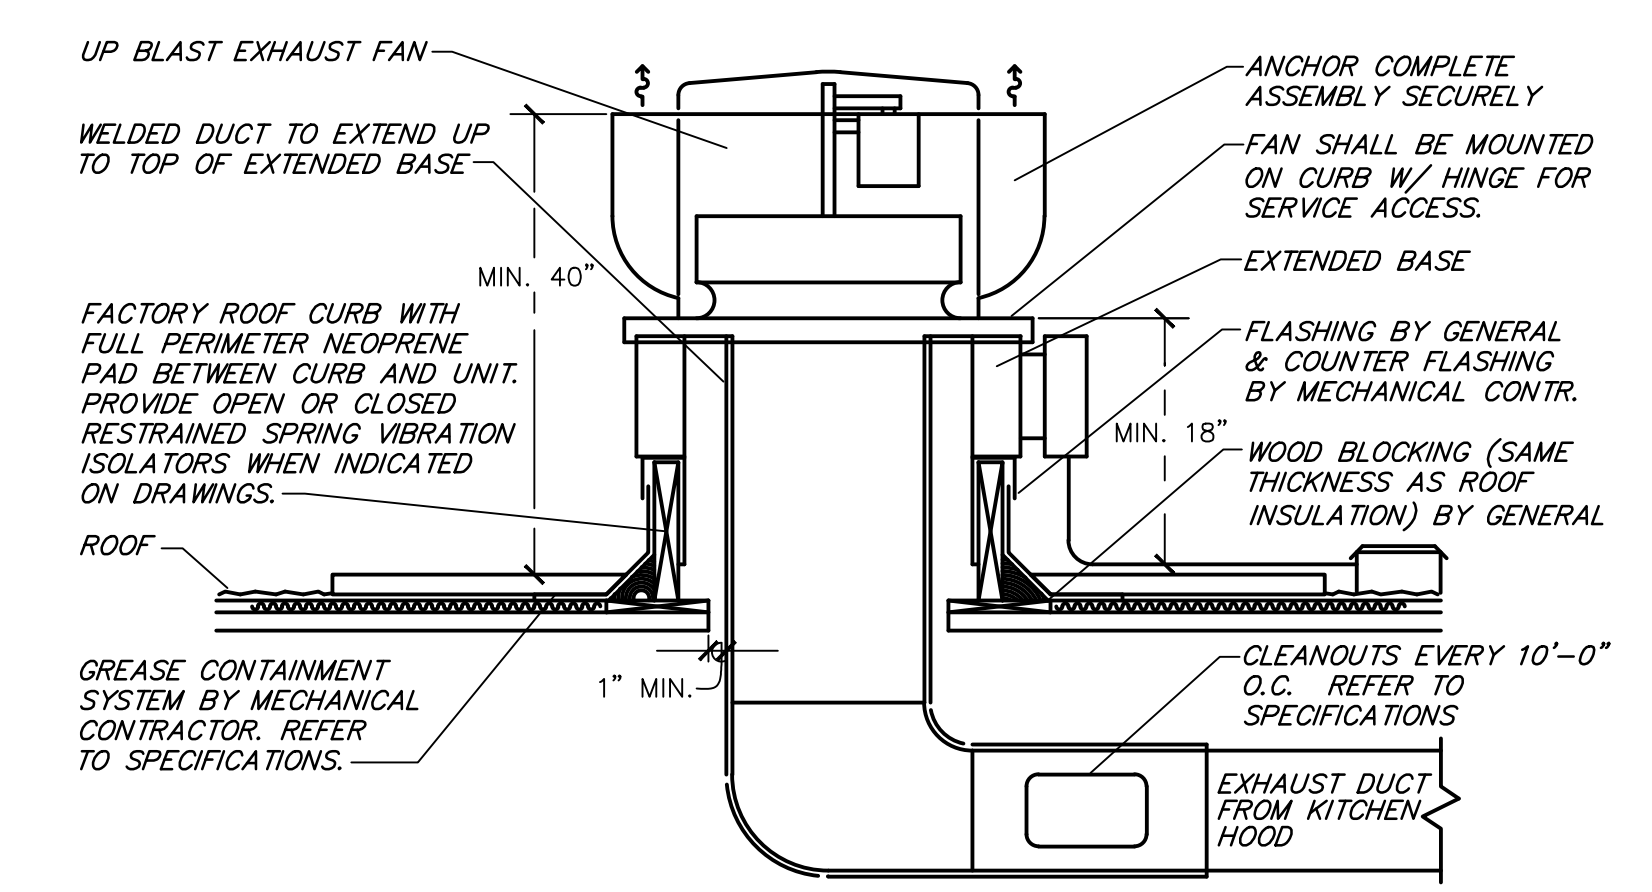


**2 KITCHEN HOOD EXHAUST FAN**  
 NOT TO SCALE

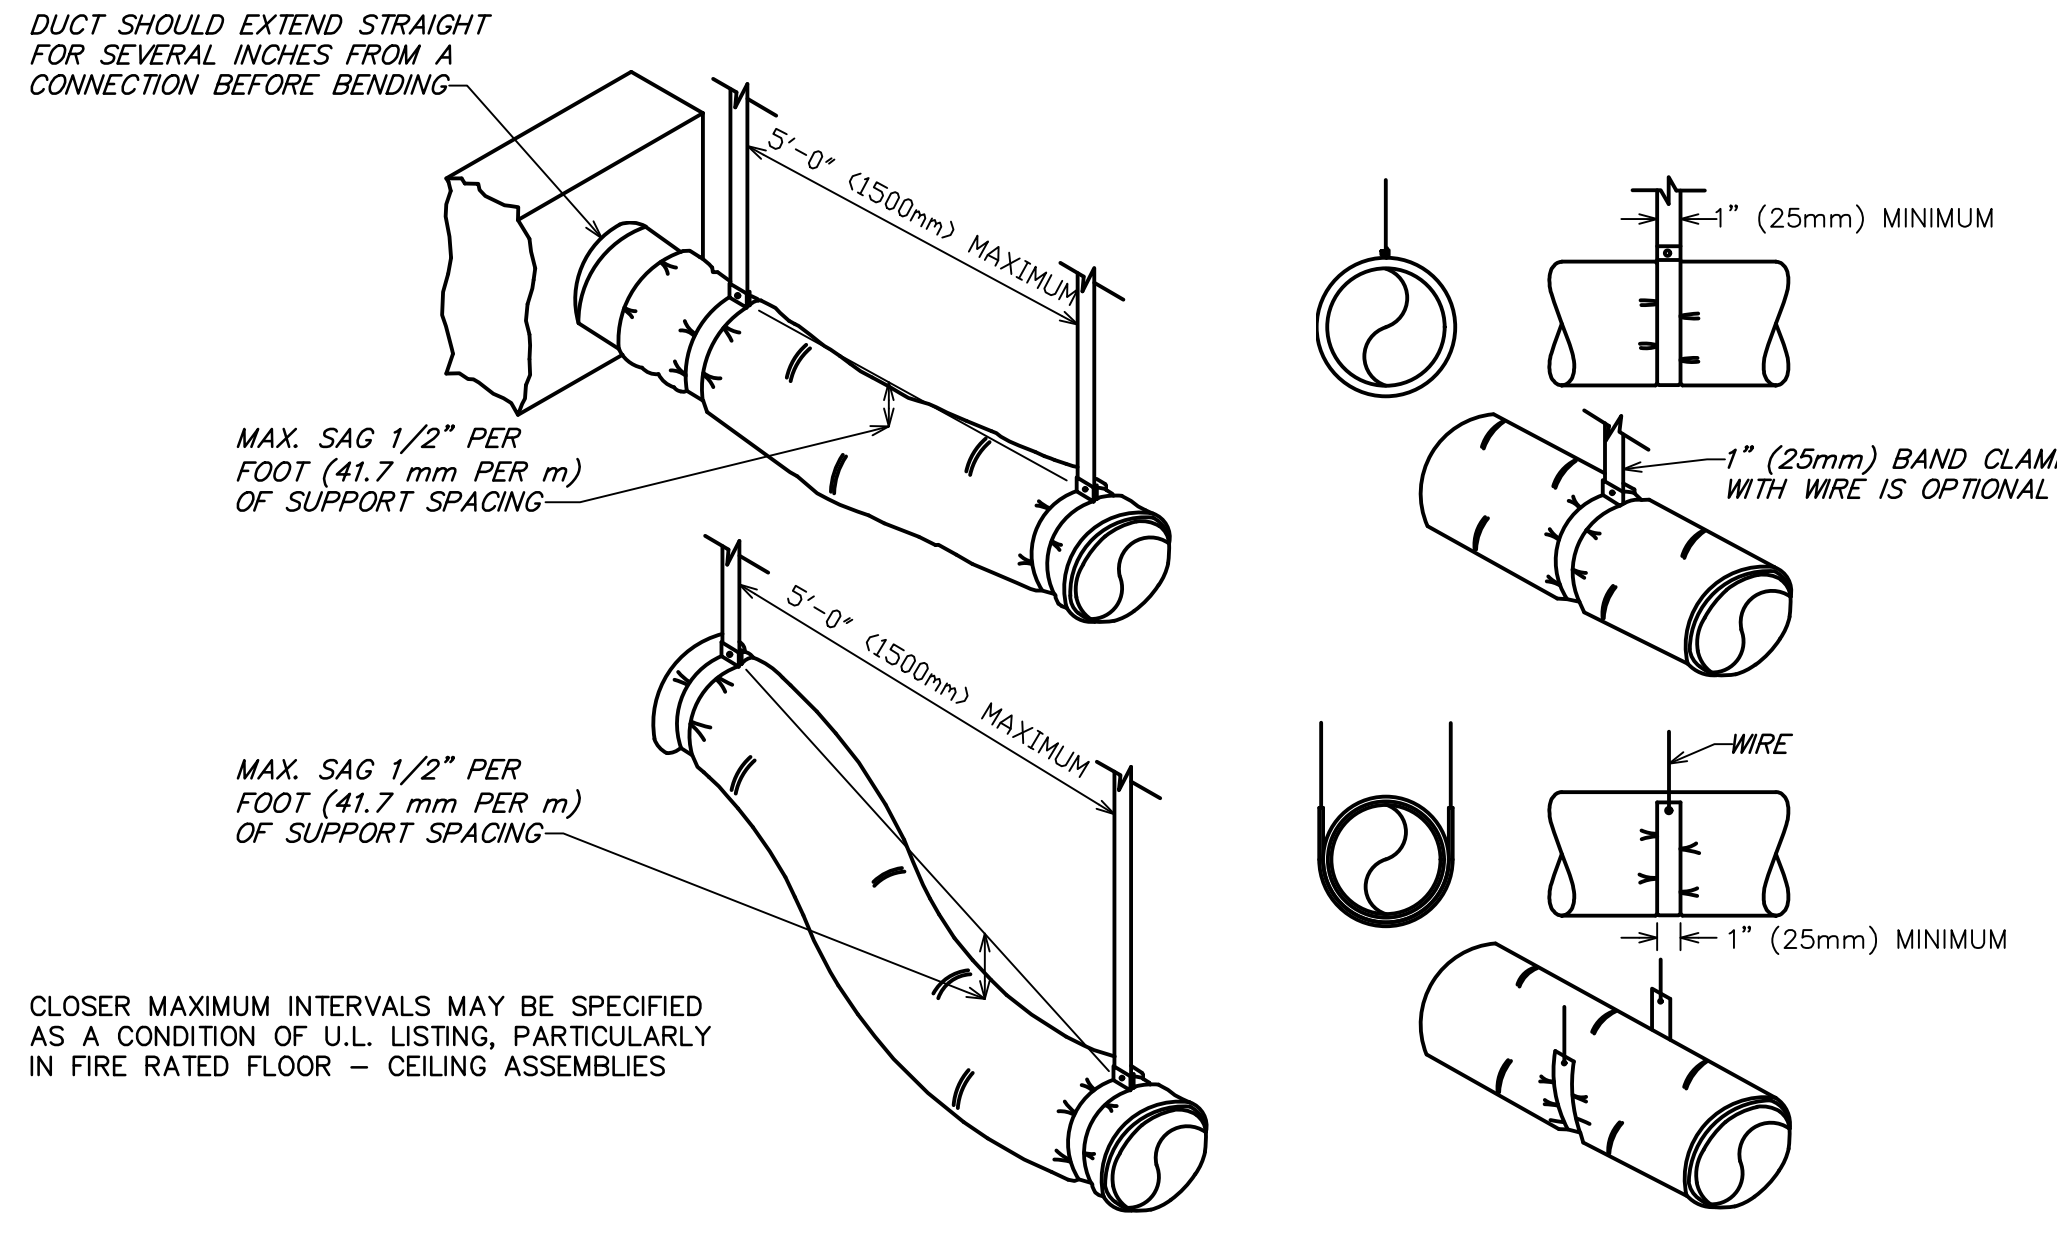


**7 FLEXIBLE DUCT SUPPORTS**  
 NOT TO SCALE

DIA.	WIRE DIA.	ROD	STRAP
10\"/>			


NOTES:  
 1. STRAPS ARE GALVANIZED STEEL; RODS ARE UNCOATED OR GALVANIZED STEEL. WIRE IS BLACK ANNEALED, BRIGHT BASIC OR GALVANIZED STEEL. ALL ARE ALTERNATIVES.  
 2. TABLE ALLOWS FOR CONVENTIONAL WALL THICKNESS, AND JOINT SYSTEMS PLUS ONE LB/SF OF INSULATION WEIGHT. IF HEAVIER DUCTS ARE TO BE INSTALLED, ADJUST HANGER SIZES TO BE WITHIN THEIR LOAD LIMITS.

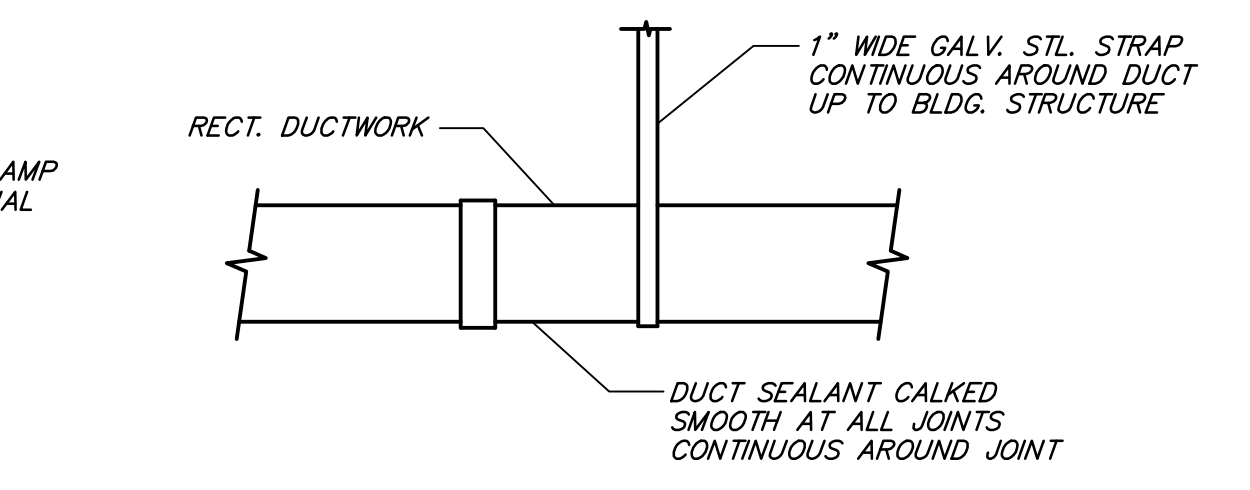

**3 EXPOSED RECTANGULAR DUCT SUPPORT DETAIL**  
 NOT TO SCALE

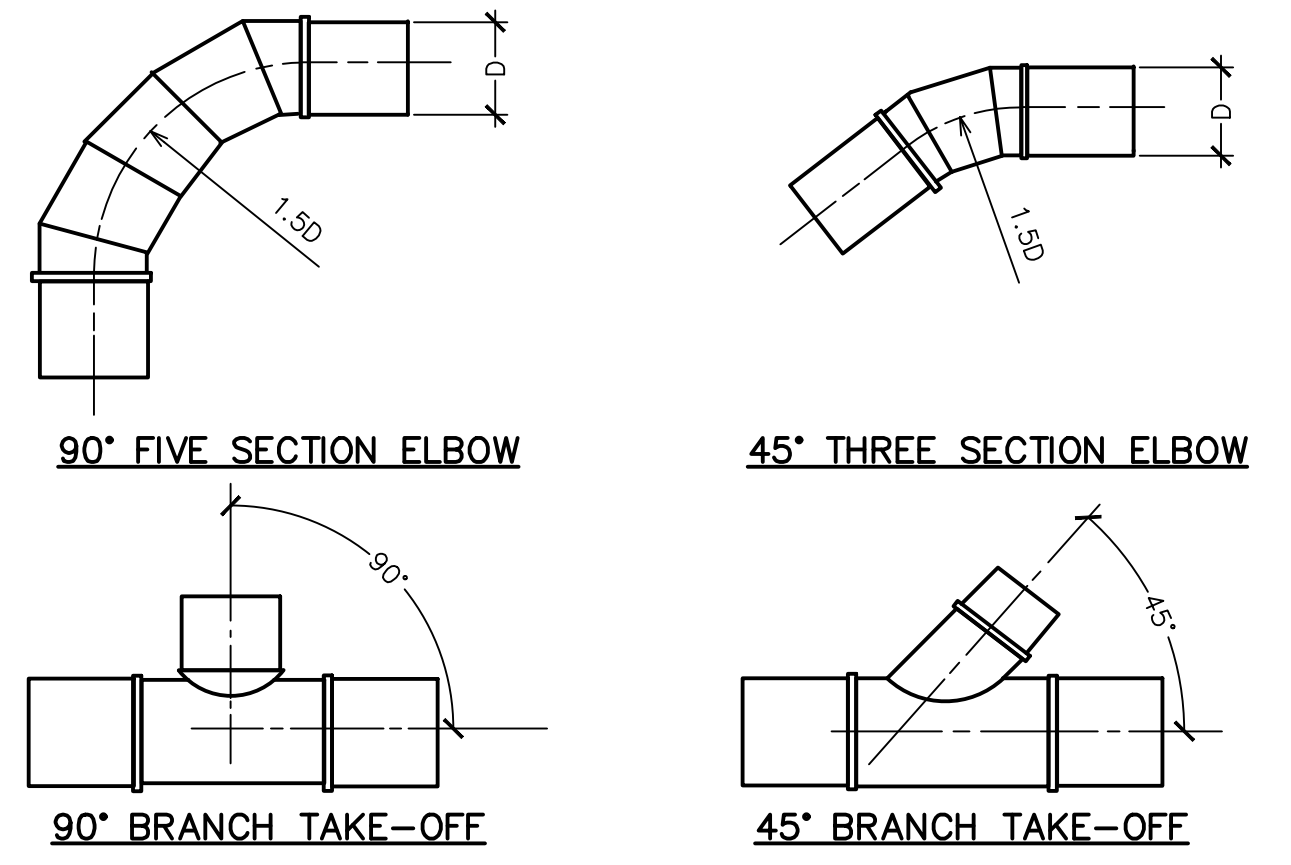


**4 TYPICAL ROUND DUCT FITTINGS**  
 NOT TO SCALE

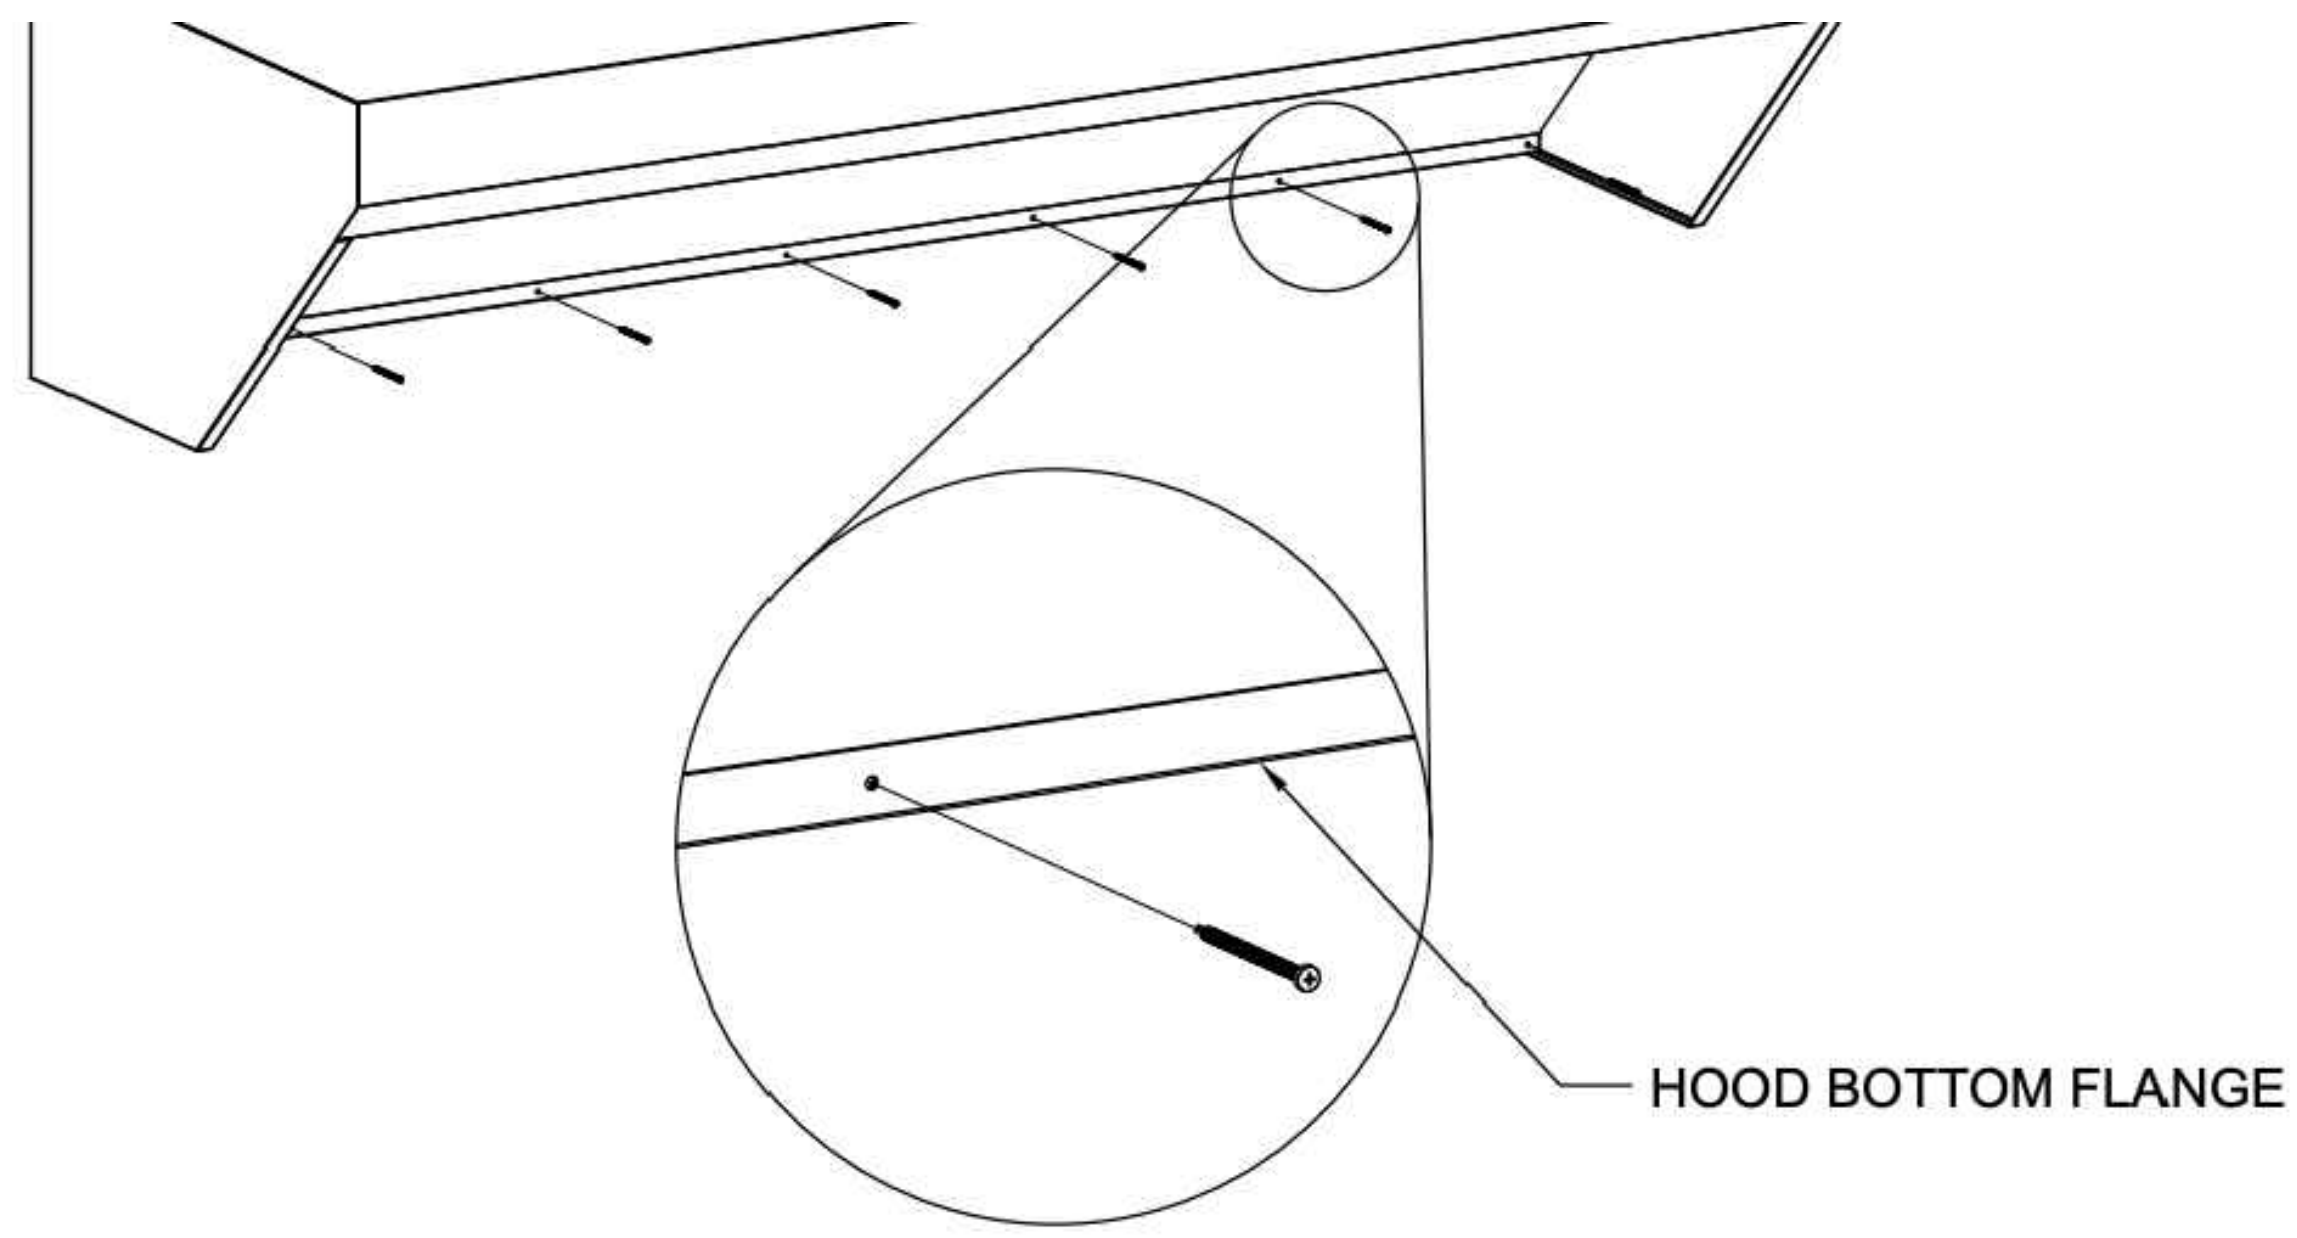

**14 HOOD FASTENING DETAIL**  
 NOT TO SCALE

Table with 2 columns: Date, Description. Rows include 07/07/2022 ADDENDUM 1, 09/22/2022 ADDENDUM 2, 10/27/2022 ADDENDUM 3, 02/07/2023 ISSUE FOR CONSTRUCTION, 02/21/2023 FIELD NOTICE 1, 04/05/2023 FIELD NOTICE 1.

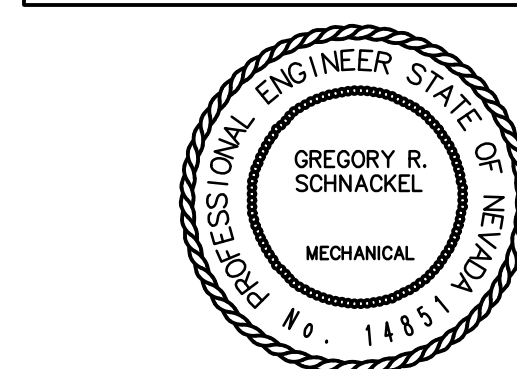

3. Use line size on leaving side of liquid sealend valves.
4. Refrigerant Charging (Control Air) Valve: Use in liquid line between receiver shut-off valve and expansion valve.
5. Filter:
1. Use a filter-drier immediately ahead of liquid-line controls, such as thermostatic expansion valves, solenoid valves, and moisture indicators.
2. Use a filter-drier on suction line just ahead of compressor.
1.03 REGULATORY REQUIREMENTS
1. Conform to ASME B31.9 for installation of piping system.
2. Welding Materials and Procedures: Conform to ASME (BPV IX) and applicable state or local regulations.
3. Welders Certification: In accordance with ASME (BPV IX).

2.03 MOISTURE AND LIQUID INDICATORS
A. Manufacturers:
1. Henry Technologies; Parker Hannifin/Refrigeration and Air Conditioning; Sporlan Valve Company.
B. Indicators: Single port type, UL listed, with copper or brass body, fused or solder ends, sight glass, color coded paper moisture indicator with removable element cartridge and plastic cap; for maximum temperature of 200 degrees F and maximum working pressure of 500 psi.
2.04 FILTER-DRIERS
A. Manufacturers:
1. Flow Controls Division of Emerson Electric; Parker Hannifin/Refrigeration and Air Conditioning; Sporlan Valve Company.
B. Performance:
1. Flow Capacity = Liquid Line: As required by capacities indicated on the Drawings, minimum, rated in accordance with ARI 710.
2. Flow Capacity = Suction Line: As required by capacities indicated on the Drawings, minimum, rated in accordance with ARI 710.
3. Pressure Drop: 2 psi, maximum, when operating at full connected evaporator capacity.
4. Design Working Pressure: 350 psi, minimum.
C. Core: Matched or stainless steel, and/or compatible with refrigerant, activated alumina, activated charcoal, and filtration to 40 microns, with secondary filtration to 20 microns; of construction that will not pass into refrigerant lines.
D. Construction: UL listed.
1. Replaceable Core Type: Steel shell with removable cap.
2. Solder Type: Copper shell.
3. Connections: As specified for applicable pipe type.
2.05 EXPANSION VALVES
A. Manufacturers:
1. Flow Controls Division of Emerson Electric; Parker Hannifin/Refrigeration and Air Conditioning; Sporlan Valve Company.
B. Angle or Straight Through Type: ARI 750; design suitable for refrigerant, brass body, internal or external equalizer, bleed hole, adjustable superheating setting, replaceable inlet strainer, with non-replaceable capillary tube and remote sensing bulb.
C. Selection: Evaluate refrigerant pressure drop through system to determine suitable pressure drop across valve for maximum load at design operating pressure and minimum 10 degrees F superheat. Select to avoid being undrained of full load and excessively oversized of part load.
D. Construction: UL listed.
E. Fused or Soldered: 15 procedures for charging and purging of systems and for disposal of refrigerant.
2. Fully charge completed system with refrigerant after testing.
3.02 FIELD QUALITY CONTROL
A. Test refrigeration system in accordance with ASME B31.5.

END OF SECTION SECTION 233100 - HVAC DUCTS AND CASINGS

1.01 SECTION INCLUDES
A. Nonmetal ductwork.
B. Round spiral ductwork.
C. Kitchen hood ductwork, Type 1 grease hoods.
1.02 PERFORMANCE REQUIREMENTS
A. No variation of duct configuration or sizes permitted except by written permission.
B. Size round ducts installed in place of rectangular ducts in accordance with ASHRAE table of equivalent rectangular duct dimensions.
C. Report all conflicts with structure or other obstructions, prior to fabrication of any ductwork. Suitable adjustments in the sizes of ducts shall be accommodated without any additional expense to the Owner.
1.03 SUBMITTALS
A. Shop Drawings: Indicate duct fittings, particulars such as gages, sizes, welds, and configuration prior to start of work for all systems. No ductwork shall be fabricated until engineer has approved drawings.
B. Test Reports: Indicate pressure tests performed, include date, section tested, test pressure, and leakage rate, following ASMA (LEAK) - HVAC Air Duct Leakage Test Manual.
1.04 REGULATORY REQUIREMENTS
A. Construction of ductwork: NFPA 90A, NFPA 90B, and NFPA 96 standards.
B. Code or utility company requirements shall supersede any conflicting requirements of this Section.
1.05 FIELD CONDITIONS
A. Do not install duct sections when temperatures are less than those recommended by sediment manufacturers.
B. Maintain temperatures within acceptable range during and after installation of duct sections.
2.01 MATERIALS
A. Galvanized Steel Ducts: Hot-dipped galvanized steel sheet, ASTM A 653/A 653M FS Type B, with 0.0272728.
B. Steel Ducts: ASTM A 1008/A 1008M, Designation CS, cold-rolled commercial steel.
C. Aluminum Ducts: ASTM B 209 (ASTM B 209M); aluminum sheet, alloy 3003-H14; Aluminum Connectors and Bar Stock: Alloy 6061-T6S1 or of equivalent strength.
D. Insulated Flexible Ducts:
1. The Contractor may use any of the following ductwork materials, at his option, provided the selected material meets with the approval of all State, local authorities and utility company requirements. Verification of compliance of the selected ductwork material is the sole responsibility of the installing Contractor.
2. Two ply vinyl film supported by helically wound spring steel wire, fiberglass insulation; aluminum vapor barrier film.
a. Pressure Rating: 10 inches WC positive and 1.0 inches WC negative.
b. Maximum Velocity: 4000 fpm.
c. Temperature Range: -10 degrees F to 180 degrees F.
d. Minimum R-Value: 4.2 or greater as required by the applicable energy codes.
3. Block polymer film supported by helically wound spring steel wire; fiberglass insulation; aluminum vapor barrier film.
a. Pressure Rating: 4 inches WC positive and 0.5 inches WC negative.
b. Maximum Velocity: 4000 fpm.
c. Temperature Range: -20 degrees F to 175 degrees F.
d. Minimum R-Value: 4.2 or greater as required by the applicable energy codes.
4. Multiple layers of aluminum laminate supported by helically wound spring steel wire; fiberglass insulation; aluminum vapor barrier film.
a. Pressure Rating: 10 inches WC positive and 1.0 inches WC negative.
b. Maximum Velocity: 4000 fpm.
c. Temperature Range: -20 degrees F to 210 degrees F.
d. Minimum R-Value: 4.2 or greater as required by the applicable energy codes.
e. Minimum R-Value: 4.2 or greater as required by the applicable energy codes.
5. UL 181, class I, aluminum laminate and polyester film with latex adhesive supported by helically wound spring steel wire; fiberglass insulation; aluminum vapor barrier film.
a. Pressure Rating: 10 inches WC positive and 1.0 inches WC negative.
b. Maximum Velocity: 4000 fpm.
c. Temperature Range: -20 degrees F to 210 degrees F.
d. Minimum R-Value: 4.2 or greater as required by the applicable energy codes.
6. UL 181, class Q, interlocking spiral of aluminum foil, fiberglass insulation; aluminum vapor barrier film.
a. Pressure Rating: 8 inches WC positive or negative.
b. Maximum Velocity: 5000 fpm.
c. Temperature Range: -20 degrees F to 230 degrees F.
d. Minimum R-Value: 4.2 or greater as required by the applicable energy codes.
E. Joint Sealers and Sealants: Non-hardening, water resistant, mildew and mold resistant.
1. Type: Heavy mastic or liquid used alone or with tape, suitable for joint configuration and compatible with substrates, and recommended by manufacturer for pressure class of duct.
2. VOC Content: Not more than 250 g/L, excluding water.
3. Surface Burning Characteristics: Flame spreaded of zero, smoke developed of zero, when tested in accordance with ASTM E 84.
4. For Use With Flexible Ducts: UL labeled.
Ductwork Exposed to Weather: Hard coat VersaGrip 102, (VG-102), UL 181-AM compliant duct joint sealer, as manufactured by Carlisle, with fiberglass scrim tape reinforcement on all seams and joints to interior and exterior.

2.02 DUCTWORK FABRICATION
A. Fabricate, support and seal in accordance with SMACNA HVAC Duct Construction Standards - Metal and Flexible.
B. Construct T's, bends, and elbows with radius of not less than 1-1/2 times width of duct on centerline, where possible, and where rectangles elbows must be used, provide turning vanes. Where octagonal lining is indicated, provide turning vanes of perforated metal with glass fiber insulation.
C. Increase duct sizes gradually, not exceeding 10 degrees divergence where possible, maximum 30 degrees divergence between 45 degrees convergence downstream.
D. Fabricate continuously welded round and oval duct fittings two gages heavier than duct gages indicated in SMACNA Standard. Joints shall be minimum 4 inch centered slip joint, brazed or electric. The pit call & UV light replacement 18,000 hour replacements are provided standard 45 degree lateral eye takeoffs unless otherwise indicated where 90 degree central eye connections may be used.
E. Where ducts are connected to exterior wall louvers and duct outlet is smaller than louver frame, provide blank-out panels sealing louver area around duct. Use same material as duct, painted black on exterior side, and unpainted on interior side.
2.03 DUCT MANUFACTURERS
Metal-Fab, Inc.; SEMCO Incorporated; United MCGI Corporation.
2.04 MANUFACTURED METAL DUCTWORK AND FITTINGS
A. Manufacturers: Metal-Fab, Inc.; SEMCO Incorporated; United MCGI Corporation.
B. Round Spiral Ducts: Machine made from round spiral lockseam duct with light reinforcing corrugations; fittings manufactured of all two gages heavier metal than duct.
C. Double Insulated Round Ducts: Round spiral lockseam duct with galvanized steel outer wall, 1 inch thick fiberglass insulation, perforated galvanized inner wall; fitting with solid inner wall.
D. Transverse Duct Connection System: SMACNA "T" rated rigid, cast connection, interlocking angle and duct edge connection system with sealant, gasket, duct, and corner.
2.05 KITCHEN HOOD EXHAUST DUCTWORK, TYPE 1
A. Fabricate in accordance with SMACNA HVAC Duct Construction Standards - Metal and

SECTION 233300 - AIR DUCT ACCESSORIES

1.01 SECTION INCLUDES
A. Clean duct system and force air at high velocity through duct to remove accumulated dust or clean with high power vacuum machines. To obtain sufficient air, clean half the system with vacuum machines.
B. Ductwork Pressure Class:
1. Low Velocity Supply (Heating Systems): Scheduled System ESP+0.25", round up to next higher pressure class.
2. Low Velocity Supply (Systems with Cooling): Scheduled System ESP +0.5".
3. Return and Relief: 1 inch.
4. General Exhaust: Scheduled System ESP +1.0", round up to next higher pressure class.
5. Outside Air Intake: 1 inch.
1.02 SUBMITTALS
A. Product Data: Provide data for equipment required for this project. Review outlets and inlets as to size, finish, and type of mounting prior to submission. Submit schedule of outlets and inlets showing type, size, location, application, accessories, and noise level.
1.03 QUALITY ASSURANCE
A. Test and rate air outlet and inlet performance in accordance with ASHRAE Std 70.
B. Test and rate lower performance in accordance with ASMA 500-L.
C. Code requirements shall supersede any conflicting requirements of this Section.
1.04 QUALIFICATIONS
A. Manufacturer Qualifications: Company specializing in manufacturing the type of products specified in this Section, with minimum five years of documented experience.
2.01 AIR TURNING DEVICES/EXTRACTORS
A. Title: Krueger; Price Industries; Nalor Industries Inc.; Hart & Cooley; Ruskin, Greenleaf.
B. Multi-blade device with blades aligned in short dimension; steel or aluminum construction, with individually adjustable blades, mounting flange, and damper.
2.02 VOLUME CONTROL DAMPERS
A. Title: Krueger; Price Industries; Nalor Industries Inc.; Ruskin Company; Prefco Inc.
B. Fabricate in accordance with SMACNA HVAC Duct Construction Standards - Metal and Flexible, and as indicated.
C. Multi-Blade Damper: Fabricate of opposed blade pattern with maximum blade sizes 8 x 72 inch. Assemble carrier and edge crimped blades in prime coated or galvanized adjustable frame with diffuser face.
D. End Bearings: Except in round ducts 12 inches and smaller, provide end bearings. On multiple blade dampers, provide oil-impregnated nylon or sintered bronze bearings.
E. The contractor shall provide either a mechanical or electrical cable operated system wherever dampers are located in non-accessible areas.
1. Mechanical cable operated system shall be similar and equal to Young Regulator Company, "Bowden Cable Control" system including damper, flexible cable with coating and concealed control regulator control.
2. Electrically operated damper control system shall be similar and equal to United Erector Corporation, "Power Balance" system including motor operated damper, RJ-11 premium rated control and flush calling and wall mounted RJ-11 plug in remote plate. Include one hand held battery pack operator pack to be delivered to the Owner upon completion of the balancing.
2.03 FLEXIBLE DUCT CONNECTIONS
A. Fabricate in accordance with SMACNA HVAC Duct Construction Standards - Metal and Flexible, and as indicated.
B. Fabricate in accordance with SMACNA HVAC Duct Construction Standards - Metal and Flexible, and as indicated.
C. Fabrication: Rigid and close-fitting of galvanized steel with sealing gaskets and fiberglass locking devices. For insulated ducts, install minimum 1 inch thick insulation with sheet metal carrier.
D. Up to 18 inches Square: Provide two hinges and two sash locks.
E. Ducts longer than 12 inches Square: Provide two hinges and two sash locks.
2.04 DUCT ACCESS DOORS
A. Manufacturers: Aador Products Inc.; Nalor Industries Inc.; Ruskin Company; SEMCO Incorporated.
B. Fabricate in accordance with SMACNA HVAC Duct Construction Standards - Metal and Flexible, and as indicated.
C. Fabrication: Rigid and close-fitting of galvanized steel with sealing gaskets and fiberglass locking devices. For insulated ducts, install minimum 1 inch thick insulation with sheet metal carrier.
D. Up to 18 inches Square: Provide two hinges and two sash locks.
E. Ducts longer than 12 inches Square: Provide two hinges and two sash locks.
2.05 AIR PURIFICATION DEVICES
Model: PHG-PK14-24V Specifications
LISTING: UL 1598-2008 (3rd Edition)
INSTALLATION: RUT PACKAGED UNIT / BLOWER CABINET

1.1 SUMMARY
A. This section includes hydro-peroxide, Super-Oxide ions, & Hydroxide Ion's delivered via the technology through podaged heating and cooling units capable of supplying 3,000 to 8,000 CFM of supply air to the indoor space.
1.2 QUALITY ASSURANCE
A. All models shall be UL listed and comply with safety standards UL 1598-2008 (3rd Edition) and CSA Standard C22.2 No. 250.0:2008.
1.3 WARRANTY
A. All units shall be provided with the following standard warranties:
1. 2-year or 18,000 hours from initial startup. National TAB provided service after 2-year warranty period. The pit call & UV light replacement 18,000 hour replacements are provided/installed at no cost if National TAB is providing Ren-Cx Service after initial installation.
B. This warranty shall not apply if:
1. The equipment is not installed by a qualified installer per the manufacturer's installation instructions shipping with the product.
2. The equipment is misused or neglected, or not maintained per the manufacturer's instructions.
3. The equipment is not operated within its published capacity.
4. The equipment is not installed within the terms of its sales agreement.
2.01 MANUFACTURERS
General: Round mounted units having gas burner and electric refrigeration.
B. Description: Self-contained, packaged, factory assembled and prewired, consisting of cabinet and frame, supply fan, heat exchanger and burner, controls, or filters, refrigerant cooling coil and compressor, dry bulb economizer and power exhaust fan with indicators, indoor air filter, heat exchanger and burner, controls, or filters.
C. Electrical Characteristics: As scheduled on the Drawings.
D. Disconnection Switch: Factory mounted disconnect switch on equipment.
2.03 FABRICATION
A. Cabinet: Steel with baked enamel finish, including access panels with screwdriver operated flush cut type fasteners or doors with piano hinges with locking handles. Structural members shall be minimum 18 gage, with access doors or panels of minimum 20 gage.
B. Insulation: One inch thick neoprene coated glass fiber with edges protected from erosion.
C. Heat Exchangers: Aluminum steel or stainless steel where indicated on the Drawings, of welded construction.
D. Supply Fan: Forward curved centrifugal type, realistically mounted with V-belt drive, and/or with mechanical cooling capacity greater than or equal to 1.65,000 Btu/h shall have not fewer than two stages of fan control.
E. Air Filters: 2 inch thick disposable media in metal frames.
F. Round Mounting Curbs: Galvanized steel, channel frame, insulated with gaskets, noller struts. Provide roof curb of adequate height to provide a unit mounting height of 12" or greater above the top of the roof surface with the curb mounted to the building structure. Roof curb height must compensate for the roof insulation thickness to meet this requirement.
G. Vibration Isolation Curb: Only when indicated on the Drawings.
2.04 BURNER
A. Gas Burner: Induced draft or forced draft type burner with adjustable combustion control, flame sensing device, and automatic 100 percent shut-off pilot flame.
B. Burner Safety Controls: Energize ignition, limit time for establishment of flame, prevent opening of gas valve until pilot flame is proven, stop gas flow on ignition failure, energize blower motor, and after air flow proven or slight delay, allow gas valve to open.
C. High Limit Control: Temperature sensor with fixed spot at maximum permissible setting, de-energize burner on excessive burner temperature and alarm burner when temperature drops to low safe value.

3.01 EXAMINATION
A. Examine drawings for the Architectural, Structural, Electrical and all other trades prior to preparation of ductwork shop drawings and prior to the fabrication of any ductwork.
B. Resolve any conflicts encountered with the Engineer prior to fabrication. Identify on ductwork shop drawings any deviations in sizes or shapes necessary by the obstructions of other trades.
3.02 INSTALLATION
A. Install in accordance with manufacturer's instructions.
B. Duct sizes indicated are inside clear dimension. For lined ducts, maintain sizes inside lining.
C. Roof exhausts:
1. Provide metal and flexible ducts in accordance with SMACNA HVAC Duct Construction Standards - Metal and Flexible.
2. Provide openings in ductwork where required to accommodate thermostats and control devices.
D. Provide piping in ductwork with spring valve or screw to ensure against air leakage. Where openings are provided in insulated ductwork, install insulation material inside a metal ring.
E. Provide sufficient space around equipment to allow normal operating and maintenance activities.
F. Sound crimp joints with or without lead for joining round duct sizes 8 inch and smaller with crimp in direction of air flow.
G. Use double metal lock washers on threaded rod supports.
H. Connect flexible ducts to metal ducts with rod bands.
I. Support flexible duct runs every five feet in the horizontal direction to avoid sags and sags.
J. Connect terminal units to supply ducts with one foot maximum length of flexible duct. Do not use flexible duct to change direction.
K. Connect diffusers to low pressure ducts directly or with 5 feet maximum length of flexible duct held in place with stop or clamp. Longer duct lengths are acceptable if depicted on the design drawings and allowed per local code. A maximum of one 90 degree bend, or equivalent, will be allowed in flexible duct runs.
L. Ductwork construction provide temporary closures of metal or taped polyethylene on open ductwork to prevent construction dust from entering ductwork system.
M. Backdraft Damper: Motor actuated (or gravity damper if depicted on design drawings), aluminum multiple blade construction, fall edged with offset hinge pin, nylon bearings, blades lined, and line voltage motor drive, power open, spring return.
N. Kitchen hood exhaust, Type 1: Use stainless steel for ductwork exposed to view and stainless steel or carbon steel for ducts where concealed.
O. For all hood systems, perform all required regulatory duct leakage and weld tests to the presence of the code official, including but not limited to duct leak and smoke tests, to demonstrate the integrity of the duct construction prior to the curb and hinged curb installation. Provide visual inspection of the ductwork on all sides.
P. Provide residue traps in kitchen hood exhaust ducts at base of vertical risers with provisions for clean out.
Q. All roof penetrations shall be flashed and weather sealed by the roofing manufacturer's authorized roofing contractor at this Contractor's expense. This Contractor shall contract with the factory authorized roofing contractor for the specific roofing system applicable to this project. The use of an unauthorized roofing contractor may result in removal and replacement of the penetration systems at this Contractor's expense.
3.03 CLEANING
A. Clean duct system and force air at high velocity through duct to remove accumulated dust or clean with high power vacuum machines. To obtain sufficient air, clean half the system with vacuum machines.
3.04 SCHEDULES
A. Ductwork Material:
B. The Contractor may use any of the following ductwork materials, at his option, provided the selected material meets with the approval of all State, local authorities and utility company requirements. Verification of compliance of the selected piping material is the sole responsibility of the installing Contractor.
1. Low Velocity Supply (Heating Systems): Galvanized Steel, Aluminum.
2. Low Velocity Supply (Systems with Cooling): Galvanized Steel, Aluminum.
3. Return and Relief: Galvanized Steel, Aluminum.
4. General Exhaust: Galvanized Steel, Aluminum.
5. Outside Air Intake: Galvanized Steel.
6. Kitchen Hood Exhaust, Type 1: Carbon Steel, Stainless Steel, Constructed per NFPA 96.
C. Ductwork Pressure Class:
1. Low Velocity Supply (Heating Systems): Scheduled System ESP+0.25", round up to next higher pressure class.
2. Low Velocity Supply (Systems with Cooling): Scheduled System ESP +0.5".
3. Return and Relief: 1 inch.
4. General Exhaust: Scheduled System ESP +1.0", round up to next higher pressure class.
5. Outside Air Intake: 1 inch.

3.05 INSTALLATION
A. Install in accordance with manufacturer's instructions.
B. Provide shaves required for final air balance at no additional expense to the project.
C. Secure roof and wall exhausts with cadmium plated steel lag screws to roof curb or structure.
D. Extend ducts to roof and wall exhausts into roof curb or wall structure.
E. Install backdraft dampers (gravity or motorized as depicted on design drawings) on inlet to roof and wall exhausts.
F. All roofing penetrations shall be flashed and weather sealed by the roofing manufacturer's authorized roofing contractor at this Contractor's expense. This Contractor shall contract with the factory authorized roofing contractor for the specific roofing system applicable to this project. The use of an unauthorized roofing contractor may result in removal and replacement of the penetration systems at this Contractor's expense.
3.06 CLEANING
A. Clean duct system and force air at high velocity through duct to remove accumulated dust or clean with high power vacuum machines. To obtain sufficient air, clean half the system with vacuum machines.
3.07 SCHEDULES
A. Ductwork Material:
B. The Contractor may use any of the following ductwork materials, at his option, provided the selected material meets with the approval of all State, local authorities and utility company requirements. Verification of compliance of the selected piping material is the sole responsibility of the installing Contractor.
1. Low Velocity Supply (Heating Systems): Galvanized Steel, Aluminum.
2. Low Velocity Supply (Systems with Cooling): Galvanized Steel, Aluminum.
3. Return and Relief: Galvanized Steel, Aluminum.
4. General Exhaust: Galvanized Steel, Aluminum.
5. Outside Air Intake: Galvanized Steel.
6. Kitchen Hood Exhaust, Type 1: Carbon Steel, Stainless Steel, Constructed per NFPA 96.
C. Ductwork Pressure Class:
1. Low Velocity Supply (Heating Systems): Scheduled System ESP+0.25", round up to next higher pressure class.
2. Low Velocity Supply (Systems with Cooling): Scheduled System ESP +0.5".
3. Return and Relief: 1 inch.
4. General Exhaust: Scheduled System ESP +1.0", round up to next higher pressure class.
5. Outside Air Intake: 1 inch.

END OF SECTION SECTION 233700 - AIR OUTLETS AND INLETS

1.01 SECTION INCLUDES
A. Rectangular ceiling diffusers.
B. Perforated face ceiling diffusers.
C. Round grille diffusers.
D. Grid core exhaust and return grilles.
E. Wall registers and grilles.
1.02 SUBMITTALS
A. Product Data: Provide data for equipment required for this project. Review outlets and inlets as to size, finish, and type of mounting prior to submission. Submit schedule of outlets and inlets showing type, size, location, application, accessories, and noise level.
1.03 QUALITY ASSURANCE
A. Test and rate air outlet and inlet performance in accordance with ASHRAE Std 70.
B. Test and rate lower performance in accordance with ASMA 500-L.
C. Code requirements shall supersede any conflicting requirements of this Section.
1.04 QUALIFICATIONS
A. Manufacturer Qualifications: Company specializing in manufacturing the type of products specified in this Section, with minimum five years of documented experience.
2.01 AIR TURNING DEVICES/EXTRACTORS
A. Title: Krueger; Price Industries; Nalor Industries Inc.; Hart & Cooley; Ruskin, Greenleaf.
B. Multi-blade device with blades aligned in short dimension; steel or aluminum construction, with individually adjustable blades, mounting flange, and damper.
2.02 VOLUME CONTROL DAMPERS
A. Title: Krueger; Price Industries; Nalor Industries Inc.; Ruskin Company; Prefco Inc.
B. Fabricate in accordance with SMACNA HVAC Duct Construction Standards - Metal and Flexible, and as indicated.
C. Multi-Blade Damper: Fabricate of opposed blade pattern with maximum blade sizes 8 x 72 inch. Assemble carrier and edge crimped blades in prime coated or galvanized adjustable frame with diffuser face.
D. End Bearings: Except in round ducts 12 inches and smaller, provide end bearings. On multiple blade dampers, provide oil-impregnated nylon or sintered bronze bearings.
E. The contractor shall provide either a mechanical or electrical cable operated system wherever dampers are located in non-accessible areas.
1. Mechanical cable operated system shall be similar and equal to Young Regulator Company, "Bowden Cable Control" system including damper, flexible cable with coating and concealed control regulator control.
2. Electrically operated damper control system shall be similar and equal to United Erector Corporation, "Power Balance" system including motor operated damper, RJ-11 premium rated control and flush calling and wall mounted RJ-11 plug in remote plate. Include one hand held battery pack operator pack to be delivered to the Owner upon completion of the balancing.
2.03 FLEXIBLE DUCT CONNECTIONS
A. Fabricate in accordance with SMACNA HVAC Duct Construction Standards - Metal and Flexible, and as indicated.
B. Fabricate in accordance with SMACNA HVAC Duct Construction Standards - Metal and Flexible, and as indicated.
C. Fabrication: Rigid and close-fitting of galvanized steel with sealing gaskets and fiberglass locking devices. For insulated ducts, install minimum 1 inch thick insulation with sheet metal carrier.
D. Up to 18 inches Square: Provide two hinges and two sash locks.
E. Ducts longer than 12 inches Square: Provide two hinges and two sash locks.
2.04 DUCT ACCESS DOORS
A. Manufacturers: Aador Products Inc.; Nalor Industries Inc.; Ruskin Company; SEMCO Incorporated.
B. Fabricate in accordance with SMACNA HVAC Duct Construction Standards - Metal and Flexible, and as indicated.
C. Fabrication: Rigid and close-fitting of galvanized steel with sealing gaskets and fiberglass locking devices. For insulated ducts, install minimum 1 inch thick insulation with sheet metal carrier.
D. Up to 18 inches Square: Provide two hinges and two sash locks.
E. Ducts longer than 12 inches Square: Provide two hinges and two sash locks.
2.05 AIR PURIFICATION DEVICES
Model: PHG-PK14-24V Specifications
LISTING: UL 1598-2008 (3rd Edition)
INSTALLATION: RUT PACKAGED UNIT / BLOWER CABINET

SECTION 233700 - AIR OUTLETS AND INLETS

1.01 SECTION INCLUDES
A. Rectangular ceiling diffusers.
B. Perforated face ceiling diffusers.
C. Round grille diffusers.
D. Grid core exhaust and return grilles.
E. Wall registers and grilles.
1.02 SUBMITTALS
A. Product Data: Provide data for equipment required for this project. Review outlets and inlets as to size, finish, and type of mounting prior to submission. Submit schedule of outlets and inlets showing type, size, location, application, accessories, and noise level.
1.03 QUALITY ASSURANCE
A. Test and rate air outlet and inlet performance in accordance with ASHRAE Std 70.
B. Test and rate lower performance in accordance with ASMA 500-L.
C. Code requirements shall supersede any conflicting requirements of this Section.
1.04 QUALIFICATIONS
A. Manufacturer Qualifications: Company specializing in manufacturing the type of products specified in this Section, with minimum five years of documented experience.
2.01 AIR TURNING DEVICES/EXTRACTORS
A. Title: Krueger; Price Industries; Nalor Industries Inc.; Hart & Cooley; Ruskin, Greenleaf.
B. Multi-blade device with blades aligned in short dimension; steel or aluminum construction, with individually adjustable blades, mounting flange, and damper.
2.02 VOLUME CONTROL DAMPERS
A. Title: Krueger; Price Industries; Nalor Industries Inc.; Ruskin Company; Prefco Inc.
B. Fabricate in accordance with SMACNA HVAC Duct Construction Standards - Metal and Flexible, and as indicated.
C. Multi-Blade Damper: Fabricate of opposed blade pattern with maximum blade sizes 8 x 72 inch. Assemble carrier and edge crimped blades in prime coated or galvanized adjustable frame with diffuser face.
D. End Bearings: Except in round ducts 12 inches and smaller, provide end bearings. On multiple blade dampers, provide oil-impregnated nylon or sintered bronze bearings.
E. The contractor shall provide either a mechanical or electrical cable operated system wherever dampers are located in non-accessible areas.
1. Mechanical cable operated system shall be similar and equal to Young Regulator Company, "Bowden Cable Control" system including damper, flexible cable with coating and concealed control regulator control.
2. Electrically operated damper control system shall be similar and equal to United Erector Corporation, "Power Balance" system including motor operated damper, RJ-11 premium rated control and flush calling and wall mounted RJ-11 plug in remote plate. Include one hand held battery pack operator pack to be delivered to the Owner upon completion of the balancing.
2.03 FLEXIBLE DUCT CONNECTIONS
A. Fabricate in accordance with SMACNA HVAC Duct Construction Standards - Metal and Flexible, and as indicated.
B. Fabricate in accordance with SMACNA HVAC Duct Construction Standards - Metal and Flexible, and as indicated.
C. Fabrication: Rigid and close-fitting of galvanized steel with sealing gaskets and fiberglass locking devices. For insulated ducts, install minimum 1 inch thick insulation with sheet metal carrier.
D. Up to 18 inches Square: Provide two hinges and two sash locks.
E. Ducts longer than 12 inches Square: Provide two hinges and two sash locks.
2.04 DUCT ACCESS DOORS
A. Manufacturers: Aador Products Inc.; Nalor Industries Inc.; Ruskin Company; SEMCO Incorporated.
B. Fabricate in accordance with SMACNA HVAC Duct Construction Standards - Metal and Flexible, and as indicated.
C. Fabrication: Rigid and close-fitting of galvanized steel with sealing gaskets and fiberglass locking devices. For insulated ducts, install minimum 1 inch thick insulation with sheet metal carrier.
D. Up to 18 inches Square: Provide two hinges and two sash locks.
E. Ducts longer than 12 inches Square: Provide two hinges and two sash locks.
2.05 AIR PURIFICATION DEVICES
Model: PHG-PK14-24V Specifications
LISTING: UL 1598-2008 (3rd Edition)
INSTALLATION: RUT PACKAGED UNIT / BLOWER CABINET

1.01 SECTION INCLUDES
A. Rectangular ceiling diffusers.
B. Perforated face ceiling diffusers.
C. Round grille diffusers.
D. Grid core exhaust and return grilles.
E. Wall registers and grilles.
1.02 SUBMITTALS
A. Product Data: Provide data for equipment required for this project. Review outlets and inlets as to size, finish, and type of mounting prior to submission. Submit schedule of outlets and inlets showing type, size, location, application, accessories, and noise level.
1.03 QUALITY ASSURANCE
A. Test and rate air outlet and inlet performance in accordance with ASHRAE Std 70.
B. Test and rate lower performance in accordance with ASMA 500-L.
C. Code requirements shall supersede any conflicting requirements of this Section.
1.04 QUALIFICATIONS
A. Manufacturer Qualifications: Company specializing in manufacturing the type of products specified in this Section, with minimum five years of documented experience.
2.01 AIR TURNING DEVICES/EXTRACTORS
A. Title: Krueger; Price Industries; Nalor Industries Inc.; Hart & Cooley; Ruskin, Greenleaf.
B. Multi-blade device with blades aligned in short dimension; steel or aluminum construction, with individually adjustable blades, mounting flange, and damper.
2.02 VOLUME CONTROL DAMPERS
A. Title: Krueger; Price Industries; Nalor Industries Inc.; Ruskin Company; Prefco Inc.
B. Fabricate in accordance with SMACNA HVAC Duct Construction Standards - Metal and Flexible, and as indicated.
C. Multi-Blade Damper: Fabricate of opposed blade pattern with maximum blade sizes 8 x 72 inch. Assemble carrier and edge crimped blades in prime coated or galvanized adjustable frame with diffuser face.
D. End Bearings: Except in round ducts 12 inches and smaller, provide end bearings. On multiple blade dampers, provide oil-impregnated nylon or sintered bronze bearings.
E. The contractor shall provide either a mechanical or electrical cable operated system wherever dampers are located in non-accessible areas.
1. Mechanical cable operated system shall be similar and equal to Young Regulator Company, "Bowden Cable Control" system including damper, flexible cable with coating and concealed control regulator control.
2. Electrically operated damper control system shall be similar and equal to United Erector Corporation, "Power Balance" system including motor operated damper, RJ-11 premium rated control and flush calling and wall mounted RJ-11 plug in remote plate. Include one hand held battery pack operator pack to be delivered to the Owner upon completion of the balancing.
2.03 FLEXIBLE DUCT CONNECTIONS
A. Fabricate in accordance with SMACNA HVAC Duct Construction Standards - Metal and Flexible, and as indicated.
B. Fabricate in accordance with SM

