


<p>5 - SCALE: N/A</p>	<p>4 - SCALE: N/A</p>	<p>3 GENERAL NOTES SCALE: N/A</p> <p>NOTE: EXISTING CONDITIONS WERE TAKEN FROM SITE VISITS AND MAY NOT REFLECT EXACT "AS-BUILT" CONDITIONS. FIELD VERIFY ALL EXISTING CONDITIONS PRIOR TO SUBMITTING FINAL BIDS. CONTRACTOR SHALL CAREFULLY COORDINATE NEW WORK AND DEMOLITION WITH ALL OTHER DISCIPLINES AND EXISTING CONDITIONS.</p> <p>ALL HVAC EQUIPMENT AND CONTROLS MUST BE LOCATED FOR PROPER ACCESS FOR MAINTENANCE AND REPAIR. WHETHER INSTALLATION IS EXISTING OR NEW, EXISTING EQUIPMENT AND CONTROLS SHALL BE RELOCATED BY THIS CONTRACTOR IF REQUIRED.</p> <p>NOTE: MECHANICAL SCOPE INCLUDES INTERIOR ALTERATION OF EXISTING TENANT SPACE BY INSTALLATION OF NEW DUCTWORK AND DIFFUSERS AS SHOWN ON PLANS.</p> <p>NOTE: ALL DUCT SIZES INDICATED ARE INSIDE CLEAR DIMENSIONS. SEE SPECIFICATIONS FOR INSULATION REQUIREMENTS.</p>	<p>2 MECHANICAL KEYNOTES SCALE: N/A</p> <p>KEYNOTE SYMBOLS: (1), (2), (3)</p> <ol style="list-style-type: none"> 1. REUSE EXISTING 18" TO 24" ROOFTOP UNIT. FIELD VERIFY EXACT LOCATION OF DUCT DROPS UNDER THE UNIT AND COORDINATE AS NECESSARY. BALANCE DIFFUSERS ARE TO BE CLEANED AND MINIMUM OUTDOOR AIR IS 17.5 CFM. CLEAN AND REFINISH UNIT TO THE NEW CONDITION. PROVIDE EXISTING IDENTIFICATION PLACARDS PER CIB STANDARD. 2. REPLACE EXISTING ROOFTOP UNIT WITH NEW PER RTU SCHEDULE. FIELD VERIFY EXACT LOCATION OF DUCT DROPS INTO THE SPACE AND COORDINATE AS NECESSARY. 3. CONNECT NEW DUCT TO EXISTING. CLEAN AND REFINISH EXISTING TO USE NEW CONDITION. 4. REPLACE EXISTING EXHAUST FAN WITH NEW PER SCHEDULE. ROUTE EXHAUST DUCT THRU ROOF AND PENETRATE WITH ROOF VENT CAP. 5. RELOCATE EXISTING THERMOSTAT TO LOCATION SHOWN. INSTALL AT ADA MOUNTING HEIGHT. 6. PROVIDE TEMPERATURE SENSOR MOUNTED ON COLUMN AS HIGH AS POSSIBLE FOR EXISTING ROOFTOP UNIT AND CONNECTED TO RELOCATED THERMOSTAT IN MANAGER'S OFFICE. 7. PROVIDE TEMPERATURE SENSOR MOUNTED NEAR TRANSFER GRILLE FOR RTU-1 AND CONNECTED TO THERMOSTAT IN MANAGER'S OFFICE. 8. PROVIDE NEW PROGRAMMABLE THERMOSTAT FOR RTU-1 IN LOCATION SHOWN. 9. MOUNT TRANSFER GRILLE ON WALL AS HIGH AS POSSIBLE. INSTALL GRILLES WITH LOUVERS IN OPPOSED DIRECTIONS TO SHIELD FROM LIGHT TRANSFER. 10. DUCTWORK TO BE INSTALLED TIGHT TO DECK/STRUCTURE ABOVE. WHERE POSSIBLE DUCTWORK SHALL BE ROUTED THROUGH JOIST SPACES. CONTRACTOR TO VERIFY DUCT SIZING AND ROUTING PRIOR TO FABRICATION. 11. ACTIVATION OF SMOKE DETECTOR SHALL ACTIVATE A VISBLE AND AUDIBLE SIGNAL IN AN APPROVED LOCATION. DUCT SMOKE DETECTOR TROUBLE CONDITIONS SHALL ACTIVATE A VISBLE OR AUDIBLE SIGNAL IN AN APPROVED LOCATION AND SHALL BE IDENTIFIED AS AIR DUCT DETECTOR TROUBLE PER SECTION 0564.1 EXCEPT 2 OF THE OHIO MECHANICAL CODE. CONTRACTOR TO COORDINATE APPROVED LOCATION WITH LANDLORD.
---------------------------	---------------------------	---	--

5 - SCALE: N/A	4 - SCALE: N/A	3 GENERAL NOTES SCALE: N/A	2 MECHANICAL KEYNOTES SCALE: N/A
-------------------	-------------------	--------------------------------------	--

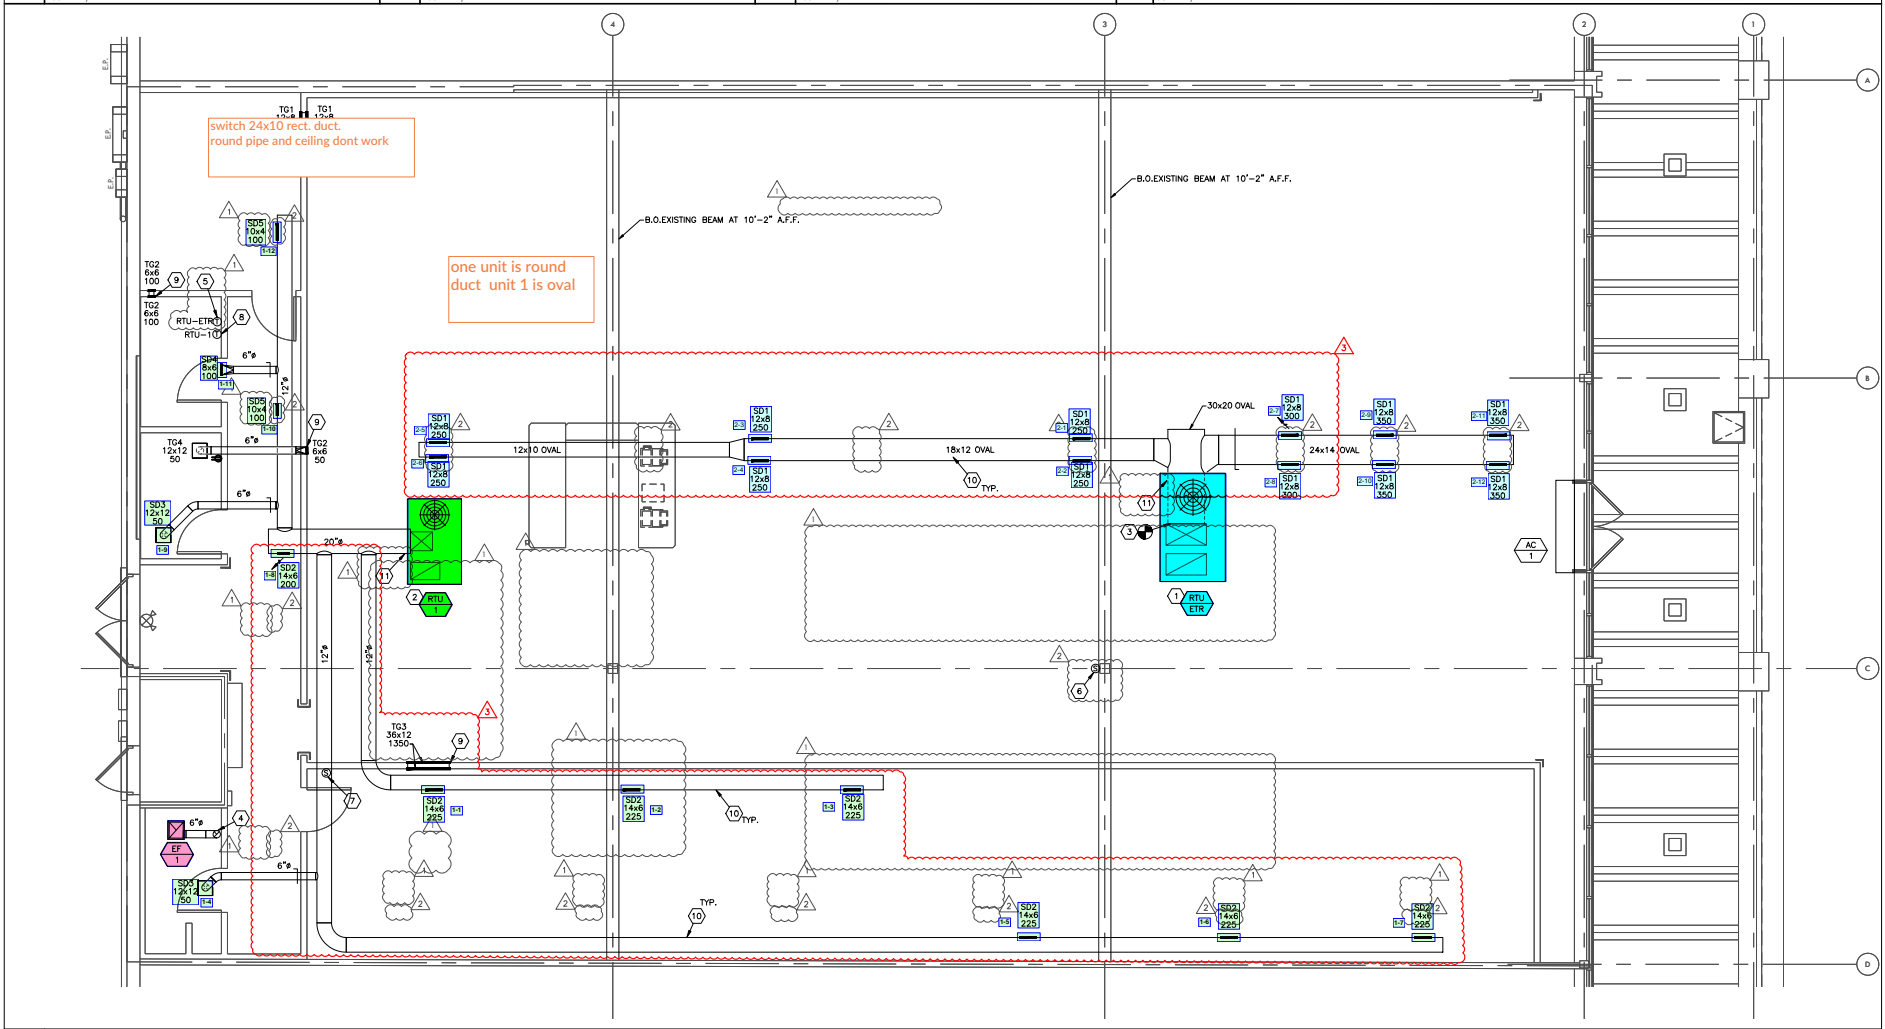

20 **MECHANICAL PLAN**
SCALE: 1/4" = 1'-0"

snipes

ADDRESS:
COLERAIN HILLS
8415 COLERAIN AVE.
CINCINNATI, OH 45239

CLIENT

SNIPES USA
2309 STREET RD.
BENSALEM, PA 19020

DESIGN PROFESSIONALS

BRETT DEBEEZ, ARCHITECT
2750 WATLAND AVE.
UNIT 50275
EL LOUIS, MO 63105

BRIAN J. TIMMONS, P.E.
1180 COLLEGE BLVD., SUITE 475
OVERLAND PARK, KS 66210

ACERTUS
CONSTRUCTION SOFTWARE

PROFESSIONAL SEAL

DATE	ISSUE	APP.
11/16/23	ISSUE NO. 01 OF 01	
12/06/23	ISSUE NO. 02 OF 01	
01/24/24	ISSUE NO. 03 OF 01	
03/11/24	ISSUE NO. 04 OF 01	

PROJECT NUMBER: 23128
MECHANICAL PLAN
M1.0