



SHOP DRAWING REVIEW

PROJECT NO.: 22.7119

PROJECT NAME: Kiewit Westlake KIE Water

RE: 230900-03.0 - HVAC Controls PD

- Reviewed
- Recommend Rejected
- Recommend Furnish As Corrected
- Recommend Revise and Resubmit
- Recommend Submit Specified Item

This review is only for general conformance with the design concept and the information given in the Construction Documents prepared by others. Corrections or comments made on shop drawings during this review do not relieve the contractor from compliance with the requirements of the plans and specifications and applicable laws, codes and regulations or comments on shop drawings reviewed by Engineer of Record. Approval of a specific item shall not include approval of an assembly of which the item is a component. The contractor is responsible for: dimensions to be confirmed and correlated at the jobsite; information that pertains solely to the fabrication processes or to the means, methods, techniques, sequences and procedures of construction; coordination of the Work with that of all other trades and performing all Work in a safe and satisfactory manner.

Lankford | Fendler + associates

Date: 3/24/23
By: Carly

The following items were observed and recorded not to be in compliance with the bid plans and specifications:

VERIFY ALL VAV AND FAN POWERED BOXES IN AREAS A & B HAVE BEEN COORDINATED TO RECEIVE NEW TEMPERATURE CONTROLS.



PACIFIC BUILDERS

Pacific Builders, Inc.
7950 Legacy Dr, Suite 150
Plano, Texas 75024
P: (972) 866-8080

Project: 33021 Kiewit Westlake - Phase II
2050 Roanoke Rd
Westlake, Texas 76262

Submittal #230000-3.0 - HVAC Controls Submittal

Table with submittal details including Revision (0), Status (Open), Issue Date (Feb 15, 2023), Responsible Contractor (Metro Mechanical), Received Date, Final Due Date (Mar 22, 2023), Location, Type (Product Information), Approvers, Ball in Court, Distribution, and Description.

Submittal Workflow

Table with columns: Name, Sent Date, Due Date, Returned Date, Response, Attachments. Shows workflow steps for John Spradling, Bryce Green, Sarah Godfrey, Katie Lopez, Stacey Price, and Melissa Weber.





PACIFIC BUILDERS

Job Name: Kiewit Westlake - Phase II
Job #: 33021R
Submittal #: 230000-3 - HVAC Controls Submittal



PACIFIC BUILDERS

- NO EXCEPTIONS TAKEN
- EXCEPTION AS NOTED
- REVISE & RESUBMIT
- REJECTED
- ARCHITECT/ENGINEER VERIFY
- _____

Review is only for general conformance with the Design Concept of the project and the general compliance with the information given in the contract documents. Subcontractor is responsible for conformance with all requirements of the plans and specifications including, but not limited to, dimensions which shall be confirmed and correlated at the job site, fabrication processes and techniques of construction, coordination of work with that of all others, and satisfactory performance of all work.

BY Bryce Green

DATE 3/15/23

7950 Legacy Dr,
Suite 150
Plano, TX 75024

T: 972.866.8080
F: 972.866.9090

pbidfw.com

ARCHITECT COMMENTS:

Hellmuth, Obata & Kassabaum, Inc.
ARCHITECTURE, ENGINEERING, PLANNING, INTERIORS, GRAPHICS, CONSULTING

| | |
|--|--|
| A - Approved | Proceed with the work covered by this Submittal provided it complies with the Contract Documents. Comments and corrections do not authorize changes to the Contract Documents. |
| B - Approved as Noted | |
| C - Revise as Noted and Resubmit | Do not proceed with the work covered by this Submittal. Limit corrections in resubmissions to items noted in this Submittal. |
| D - Rejected | |
| E - Reviewed for Information | This Submittal is for information only. Resubmit only if noted in this Submittal. |
| F - Reviewed for Information as Noted | |

B Approved as Noted

Review of this Submittal is for the limited purpose of checking for conformance with information given and the design concept expressed in the Contract Documents. The review is not for determining the accuracy or completeness of other details such as dimensions and quantities, or for substantiating instructions for installation or performance of equipment or systems, which remains the Contractor's responsibility. Review shall not constitute approval of safety precautions, or of construction means, methods, and techniques, sequences or procedures.

Approval of a specific item shall not indicate approval of an assembly of which the item is a component. Approval of this Submittal does not relieve the Contractor of its responsibility to comply with the Contract Documents.


Reviewed By:

sarah.godfrey

3/27/2023

Submittal File:

230000-3.0 - HVAC Controls PD_LFA_HOK.pdf

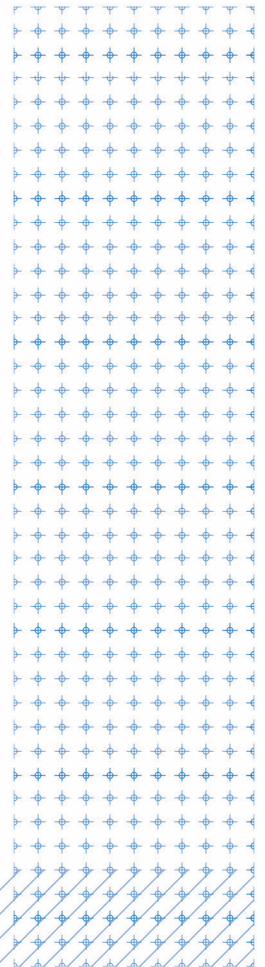

Kiewit Westlake Office TI

2050 Roanoke Road

WESTLAKE, TX 76262

Customer Contact

METRO MECHANICAL INC
430 S BRYAN BELTLINE
MESQUITE TX 75149 USA

TRANE PROJECT TEAM

SALESPERSON:
Zach Rutledge

PROJECT MANAGER:
Michael Drury

DESIGNED BY:
Ben Nyamaah



TRANE®

DRAWINGS ARE BASED ON CONSTRUCTION DOCUMENTS
DATED 12-2-2021 ADDENDUM 1

THIS DRAWING SET IS THE PROPERTY OF TRANE. DESIGN INFORMATION, DRAWINGS, DETAILS OR SPECIFICATION DATA MAY NOT BE REPRODUCED OR DUPLICATED NOR MAY ANY WORK BE EXECUTED HERE FROM WITHOUT THE WRITTEN AUTHORIZATION OF TRANE.

| TITLE PAGE | | | | |
|---|--|------------------|-----------|-------------|
| CID: 00097395 | NUM. | REVISION | DATE: | BY: |
| PID: 00105161 | | | | |
| PROJECT: K901283 | | | | |
| SALESPERSON: Z Rutledge | | | | |
| DESIGNED BY: B Nyamaah | 2 | -RECORD DRAWINGS | 7/21/2022 | BEN |
| CHECKED BY: | 1 | -SUBMITTALS | 3/1/2022 | BEN |
| Fort Worth 4200 N. Sylvania Avenue FORT WORTH, TX 76137 817-838-1300 FILE: Kiewitt Westlake Office_rev1.vsd | PROJECT: Kiewit Westlake Office TI 2050 Roanoke Road WESTLAKE TX 76262 | | | |
| | | | | DWG 1 OF 41 |


| INDEX OF CONTROL SYSTEM DRAWINGS | | | | |
|----------------------------------|--|----------------|---------------|--------------------------|
| DWG # | DRAWING TITLE | REVISION LEVEL | REVISION DATE | COMMENTS |
| 1 | TITLE PAGE | 2 | 7/21/2022 | INCLUDES LRT 2050 AND TI |
| 2 | DRAWING INDEX | 1 | 3/1/2022 | |
| 3 | LEGEND | 1 | 3/1/2022 | |
| 4 | WIRING NOTES | 1 | 3/1/2022 | |
| 5 | RISER | 2 | 7/28/2022 | INCLUDES LRT 2050 AND TI |
| 6 | HVAC LEVEL 1 - AREA A | 1 | 3/1/2022 | |
| 7 | HVAC LEVEL 1 - AREA B | 1 | 3/1/2022 | |
| 8 | HVAC LEVEL 1 - AREA C | 1 | 3/1/2022 | |
| 9 | HVAC LEVEL 2 - AREA A | 1 | 3/1/2022 | |
| 10 | HVAC LEVEL 2 - AREA B | 1 | 3/1/2022 | |
| 11 | HVAC LEVEL 2 - AREA C | 1 | 3/1/2022 | |
| 12 | ADDRESS SCHEDULE (1) | 1 | 3/1/2022 | |
| 13 | ADDRESS SCHEDULE (2) | | | |
| 14 | ADDRESS SCHEDULE (3) | | | |
| 15 | ADDRESS SCHEDULE (4) | | | |
| 16 | ADDRESS SCHEDULE (5) | | | |
| 17 | ENCLOSURE SCHEDULE | 1 | 3/1/2022 | |
| 18 | ENCLOSURE GRAPHICS | 1 | 3/1/2022 | |
| 19 | FIRST FLOOR (SC-1) - CONTROLLER | 1 | 3/1/2022 | |
| 20 | SECOND FLOOR (SC-2) - CONTROLLER | 1 | 3/1/2022 | |
| 21 | CARRIER INTERGRATION PC - 1 SEQUENCE | 1 | 3/1/2022 | |
| 22 | CARRIER INTERGRATION PC - 1 CONTROLLER | 1 | 3/1/2022 | |
| 23 | ELEC SC 2ND FL B SC - 3 CONTROLLER | | | |
| 24 | FAN POWERED BOXES - FLOW | 1 | 3/1/2022 | |
| 25 | FAN POWERED BOXES - SEQUENCE | 1 | 3/1/2022 | |
| 26 | FAN POWERED BOXES - S210 CONTROLLER | 1 | 3/1/2022 | |
| 27 | VAV BOXES - FLOW | 1 | 3/1/2022 | |
| 28 | VAV BOXES - SEQUENCE | 1 | 3/1/2022 | |
| 29 | VAV BOXES - S210 CONTROLLER | 1 | 3/1/2022 | |
| 30 | FPB 1 ~ 22 S210 - 18 FLOW | | | |
| 31 | FPB 1 ~ 22 S210 - 18 SEQUENCE | | | |
| 32 | FPB 1 ~ 22 S210 - 18 CONTROLLER | | | |
| 33 | VAVRH S210 - 19 FLOW | | | |
| 34 | VAVRH S210 - 19 SEQUENCE | | | |
| 35 | VAVRH S210 - 19 CONTROLLER | | | |
| 36 | VAV 1 ~ 33 S210 - 20 FLOW | | | |
| 37 | VAV 1 ~ 33 S210 - 20 SEQUENCE | | | |
| 38 | VAV 1 ~ 33 S210 - 20 CONTROLLER | | | |
| 41 | MINI SPLIT BRG - 1 CONTROLLER | | | |
| 42 | DETAIL SHEET | | | |
| 43 | BILL OF MATERIALS | 1 | 3/1/2022 | |

DRAWING INDEX

| CID: | NUM. | REVISION | DATE: | BY: |
|---|--|-------------|----------|-----|
| 00097395 | | | | |
| PID: 00105161 | | | | |
| PROJECT: K901283 | | | | |
| SALESPERSON: Z Rutledge | | | | |
| DESIGNED BY: B Nyamaah | | | | |
| CHECKED BY: | 1 | -SUBMITTALS | 3/1/2022 | BEN |
| Fort Worth 4200 N. Sylvania Avenue FORT WORTH, TX 76137 817-838-1300 | PROJECT: Kiewit Westlake Office TI 2050 Roanoke Road WESTLAKE TX 76262 | | | |
| FILE: Kiewitt Westlake Office_rev1.vsd | DWG 2 OF 41 | | | |



TYPICAL FLOW SHAPE SYMBOLS

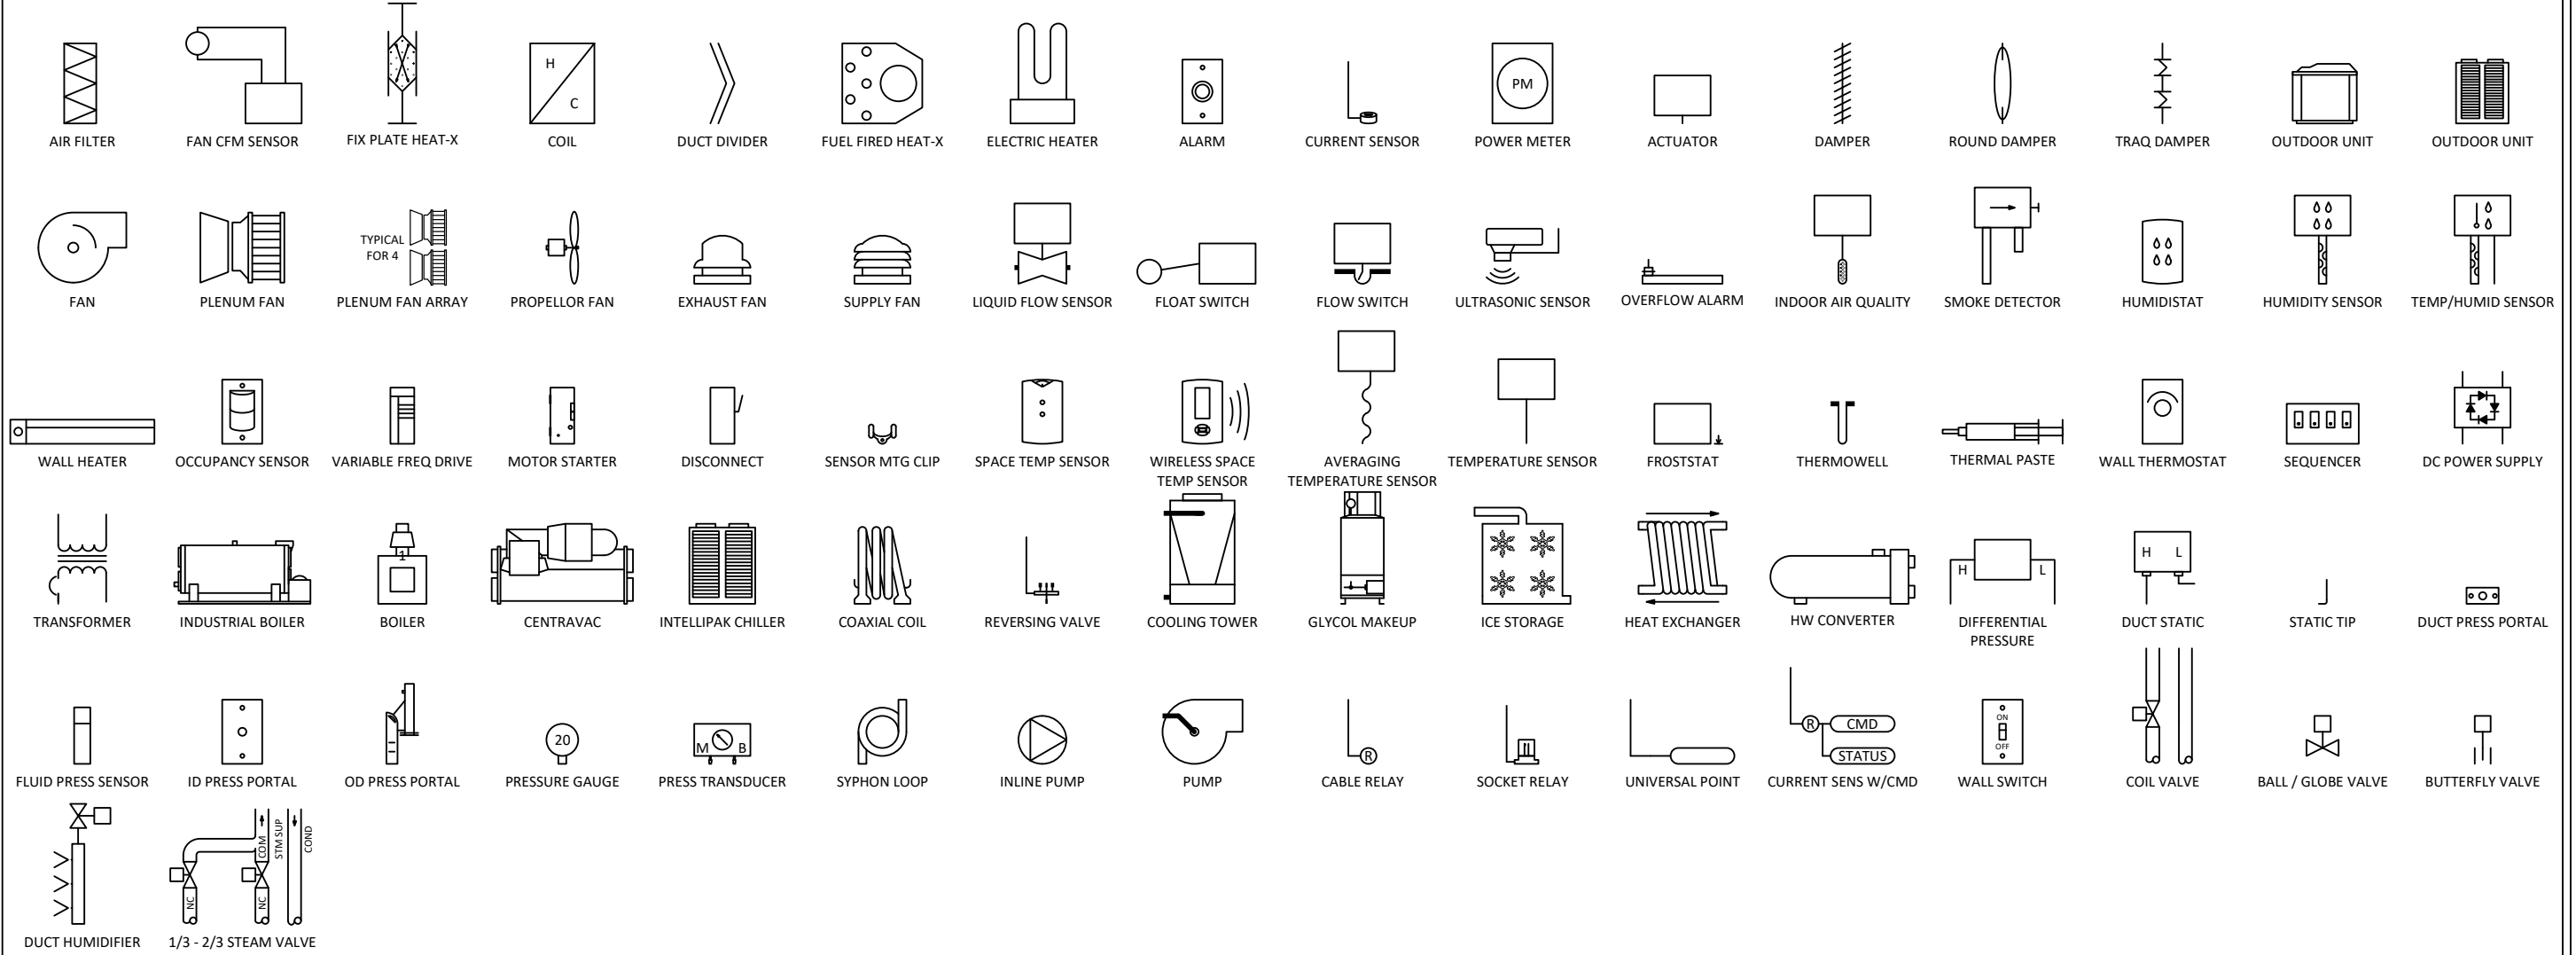

| LEGEND | | | | |
|---|---|-------------|----------|-------------|
| CID: | NUM. | REVISION | DATE: | BY: |
| 00097395 | | | | |
| PID: 00105161 | | | | |
| PROJECT: K901283 | | | | |
| SALESPERSON: Z Rutledge | | | | |
| DESIGNED BY: B Nyamaah | | | | |
| CHECKED BY: | 1 | -SUBMITTALS | 3/1/2022 | BEN |
| Fort Worth 4200 N. Sylvania Avenue FORT WORTH, TX 76137 817-838-1300 FILE: Kiewitt Westlake Office_rev1.vsd | PROJECT: Kiewitt Westlake Office TI 2050 Roanoke Road WESTLAKE TX 76262 | | | |
| | | | | DWG 3 OF 41 |



WIRING NOTES

ELECTRICAL CONTRACTOR FOR TRANE:

- REFER TO DEVICE INSTALLATION MANUALS FOR SPECIFIC WIRING REQUIREMENTS.
- FIELD WIRING MUST BE IN ACCORDANCE WITH NATIONAL ELECTRICAL CODE, STATE AND LOCAL BUILDING CODES, AND APPLICABLE SECTIONS OF PROJECT SPECIFICATION.
- TAG ALL CONTROL WIRING AT EACH END OF THE CABLE OR WIRE PER TAGS SHOWN IN ATTACHED DRAWINGS.
- AVOID OVER TIGHTENING CABLE TIES AND OTHER FORMS OF CABLE WRAPS. THIS CAN DAMAGE THE WIRES INSIDE THE CABLES.
- DO NOT CABLE TIE TO INSULATED WATER, STEAM OR OTHER LINES.
- IN OPEN PLENUMS, DO NOT RUN NEAR LIGHTING BALLASTS.
- ALL PANELS AND FIELD DEVICES LISTED IN THIS DOCUMENT ARE TO BE INSTALLED BY CONTROL ELECTRICAL SUBCONTRACTOR UNLESS OTHERWISE NOTED ON DRAWINGS.
- MOUNT ALL ROOM SENSORS AND SWITCHES AS SHOWN ON THE CONSTRUCTION DOCUMENTS, UNLESS OTHERWISE DIRECTED IN WRITING BY THE OWNER AND/OR ENGINEER. IF NO DIRECTION IS PROVIDED IN THE CONSTRUCTION DOCUMENTS, THEN MOUNT AT 4FT (1.2M) ABOVE FINISHED FLOOR.
- FLEXIBLE CONDUIT IS NOT TO EXCEED 24" IN LENGTH.
- CONTROL PANELS ARE NOT TO BE USED AS JUNCTION BOXES OR RACEWAYS. WIRING THAT DOES NOT TERMINATE IN A CONTROL PANEL IS NOT TO BE RUN WITHIN THE PANEL.
- BINARY INPUT LIMITS: 1000 FT (300 M).
- 0~10 VDC ANALOG INPUT LIMITS: 300 FT (100 M).
- 0~20 MA ANALOG INPUT LIMITS: 1000 FT (300 M).
- VARIABLE RESISTANCE ANALOG INPUT LIMITS: 300 FT (100 M).
- ANALOG OUTPUT LIMITS: 1000 FT (300 M).
- BINARY OUTPUT LIMITS: 1000 FT (300 M).
- WIRING POWER FROM THE AC OUT TERMINALS TO POWER ANALOG INPUT DEVICES WILL CAUSE IMMEDIATE CONTROLLER FAILURE IF INPUT DEVICE USES HALF-WAVE RECTIFICATION. WHEN UNSURE, USE A SEPARATE SUPPLY FOR DEVICE.

GENERAL COMMUNICATION GUIDE:

- DO NOT RUN COMMUNICATION LINK WIRING IN THE SAME CONDUIT OR WIRE BUNDLE WITH AC-POWER WIRES (INCLUDING CONDUCTORS RUNNING FROM TRIAC-TYPE OUTPUTS). KEEP POLARITY CONSISTENT THROUGHOUT THE SITE. MAKE SURE THAT THE 24 VAC POWER SUPPLIES ARE CONSISTENT IN HOW THEY ARE GROUNDED.
AVOID SHARING 24 VAC BETWEEN CONTROLLERS. USE ONLY ONE TYPE OF COMMUNICATION CABLE; DO NOT MIX CABLE. IF AN EXISTING JOB USED ALTERNATE CABLE, CONTINUE USING THE SAME CABLE AFTER APPROVAL FROM THE PROJECT MANAGER.
- BACNET MS/TP COMMUNICATION CABLE MUST BE SHIELDED TWISTED PAIR, 18 AWG MINIMUM, STRANDED, TINNED COPPER CONDUCTORS. SHIELD MUST BE CONTINUOUS THROUGHOUT, ISOLATED FROM OTHER CONDUCTORS OR GROUND, AND GROUNDED AT THE SYSTEM CONTROLLER ONLY. MAXIMUM CAPACITANCE BETWEEN CONDUCTORS IS 24 PICO FARADS PER FOOT. MAXIMUM DISTANCE IS 4000 FT (1372 M).
MAXIMUM OF 60 TRANE DEVICES PER LINK BUT LESS WHEN COMBINED WITH NON-TRANE DEVICES. A TRACER BACNET TERMINATOR IS REQUIRED AT EACH END OF THE COMMUNICATION LINK. EACH TERMINATOR REQUIRES 24 VDC POWER. EXPANSION MODULE LINK LIMIT IS 656 FT (200 M). TOPOLOGY MUST BE DAISY CHAINED.
- LONTALK (COMM 5) COMMUNICATION CABLE MUST BE LEVEL 4 UNSHIELDED, 22 AWG WITH MAXIMUM CAPACITANCE BETWEEN CONDUCTORS OF 17 PICO FARADS PER FOOT. MAXIMUM DISTANCE IS 4500 FT (1400 M). MAXIMUM DEVICES IS 60 DEVICES WITHOUT REPEATER AND 120 WITH REPEATER. ONE REPEATER PER LINK CAN BE USED FOR AN ADDITIONAL 4500 FT (1400 M), 60 DEVICES.
CCP III LINK LIMIT IS 3500 FT (1090 M). 105 OHMS, 1%, 1/4 WATT TERMINATION RESISTORS ARE REQUIRED AT EACH END FOR LEVEL 4 WIRE AND 82 OHMS, 1%, 1/4 WATT AT EACH END FOR 18 AWG SHIELDED (PURPLE) WIRE. EX2 LINK LIMIT IS 1000 FT (300 M). TOPOLOGY MUST BE DAISY CHAINED.
- COMM 3 AND COMM 4 COMMUNICATION CABLE MUST BE SHIELDED TWISTED PAIR, 18 AWG MINIMUM, STRANDED, TINNED COPPER CONDUCTORS. SHIELD MUST BE CONTINUOUS THROUGHOUT, ISOLATED FROM OTHER CONDUCTORS OR GROUND, AND GROUNDED AT BCU ONLY.
MAXIMUM CAPACITANCE BETWEEN CONDUCTORS IS 24 PICO FARADS PER FOOT. MAXIMUM DISTANCE IS 5000 FT (1715 M). UNDER CERTAIN CONDITIONS, TERMINATION RESISTORS ARE REQUIRED ON A COMM 3 COMMUNICATION LINK.
- ETHERNET LAN COMMUNICATION CABLE MAXIMUM DISTANCE IS 295 FT (90 M) PLUS 33 FT (10 M) FOR PATCH CABLES.
- TRANE WIRELESS COMMUNICATION TYPICAL WCI TO WCI DISTANCE IS UP TO 200 FT (60 M) WITH COMMON BUILDING OBSTRUCTIONS. WCI IS POWERED BY 24 VDC OR 24 VAC. EACH NETWORK REQUIRES 1 WCI AS A NETWORK COORDINATOR AND SUPPORTS UP TO 30 TRANE BACNET CONTROLLERS EQUIPPED WITH WCI. TRACER SC SUPPORTS UP TO 8 NETWORK COORDINATORS AND UP TO 120 TRANE BACNET CONTROLLERS. TRACER SC NETWORK COORDINATORS MAY HAVE A COMBINED IMC WIRING LENGTH OF 656 FT (200 M). REFER TO IOM FOR DETAILS.

- MODBUS. REFER TO MANUFACTURER DOCUMENTATION FOR SPECIFIC WIRING REQUIREMENTS, TERMINATION RESISTORS, AND THE MAXIMUM NUMBER OF DEVICES SUPPORTED PER LINK. IF THIRD-PARTY PRODUCT LITERATURE IS NOT AVAILABLE, GENERAL LOW-DATA RATE GUIDELINES ARE AS FOLLOWS:
COMMUNICATION CABLE MUST BE 2-WIRE EIA/TIA-485 BRAID OR FOIL SHIELD TWISTED PAIR WIRE, 18 AWG, AND MAXIMUM CAPACITANCE BETWEEN CONDUCTIONS OF 24 PF/FT. MAXIMUM DISTANCE IS 4000FT (1200M). MAXIMUM DEVICES IS 30 DEVICES PER LINK. WIRING MUST BE ASSEMBLED IN A DAISY-CHAIN CONFIGURATION AND 1/2 WATT 120 OHM TERMINATION RESISTOR OR TRACER BACNET TERMINATOR MAY BE USED AT EACH END OF THE COMMUNICATION LINK.
- M-NET COMMUNICATION CABLE MUST BE PLENUM RATED, SHIELDED TWISTED PAIR, 16 AWG MINIMUM, STRANDED, TINNED COPPER CONDUCTORS. SHIELD MUST BE CONTINUOUS THROUGHOUT, ISOLATED FROM OTHER CONDUCTORS OR GROUND AND 2 IN. OR MORE FROM ANY POWER SOURCE WIRING. MAXIMUM CAPACITANCE BETWEEN CONDUCTORS IS 59 PICO FARADS PER FOOT. MAXIMUM DISTANCE FOR OUTDOOR UNITS IS 1640 FT (500 M). MAXIMUM DISTANCE FOR INDOOR UNITS IS 656 FT (200 M). MAXIMUM DISTANCE FOR REMOTE CONTROLLERS IS 32 FT (10 M). TOPOLOGY MUST BE DAISY CHANGED.

CABLE MATRIX

| KEY | PART NO* | DESCRIPTION | WIRE COLORS |
|-----|----------|--|--|
| A | 052003-S | 18/2 TWIST SHLD VIOLET PLENUM CABLE | WHT, BLK |
| B | N/A | FACTORY PROVIDED CABLE | |
| C | 105500 | 22/2 TWIST NON-SHLD BLUE COMM PLENUM CABLE | WHT, BLU/BLU |
| D | 002320-S | 18/2 TWIST SHLD WHITE PLENUM CABLE | WHT, BLK |
| E | 002330-S | 18/3 TWIST SHLD WHITE PLENUM CABLE | WHT, BLK, RED |
| F | 002340-S | 18/4 TWIST SHLD WHITE PLENUM CABLE | WHT, BLK, RED, GRN |
| G | 002351 | 18/6 TWIST SHLD WHITE PLENUM CABLE | WHT, BLK, RED, GRN, BLU, BRN |
| H | 6200FH | BELDEN 16/2 TWIST SHLD PLENUM CABLE | RED, BLK |
| J | N/A | 1 PAIR #14 THHN STRANDED IN CONDUIT | |
| L | N/A | ETHERNET RG58 THHNNET PLENUM CABLE | |
| M | 555619-S | ETHERNET CAT-5 PLENUM CABLE | WHT, BLK, RED, GRN, BLU, YEL, ORN, BRN |
| O | 002352-S | 18/8 TWIST SHLD WHITE PLENUM CABLE | WHT, BLK, RED, GRN, BLU, YEL, ORN, BRN |
| P | 106502-S | 22/2 TWIST SHLD ORANGE COMM PLENUM CABLE | BLK, RED |
| Q | 761360-S | 16/2 SOLID RED SMOKE DETECTOR PLENUM CABLE | WHT, RED |
| 2C | N/A | 18/2 SOLID THERMOSTAT PLENUM CABLE | WHT, RED |
| 3C | N/A | 18/3 SOLID THERMOSTAT PLENUM CABLE | WHT, RED, GRN |
| 5C | 510005-S | 18/5 SOLID THERMOSTAT PLENUM CABLE | WHT, RED, GRN, YEL, BLU |
| 8C | 510007-S | 18/8 SOLID THERMOSTAT PLENUM CABLE | WHT, RED, GRN, YEL, BLU, ORN, BLK, BRN |
| 10C | N/A | 18/10 SOLID THERMOSTAT PLENUM CABLE | WHT, RED, GRN, YEL, BLU, ORN, BLK, BRN, PNK, GRY |
| 12C | N/A | 18/12 SOLID THERMOSTAT PLENUM CABLE | WHT, RED, GRN, YEL, BLU, ORN, BLK, BRN, PNK, GRY, PUR, TAN |


* TRANE APPROVED WINDY CITY PART NUMBERS. WHEN ORDERING CABLE SPECIFY JACKET COLOR. PART NUMBERS ARE SUBJECT TO CHANGE WITHOUT NOTICE.

CABLE MATRIX NOTES

ALL CABLE WIRING METHODS MUST BE TRANE RECOMMENDED. CONTACT TRANE FOR RECOMMENDED CABLES AND SPECIFICATIONS

CABLE INFORMATION SHAPE (CIS)


EACH CABLE CONNECTION HAS A CIS WHICH PROVIDES SOME OR ALL OF THE INFORMATION INDICATED BELOW

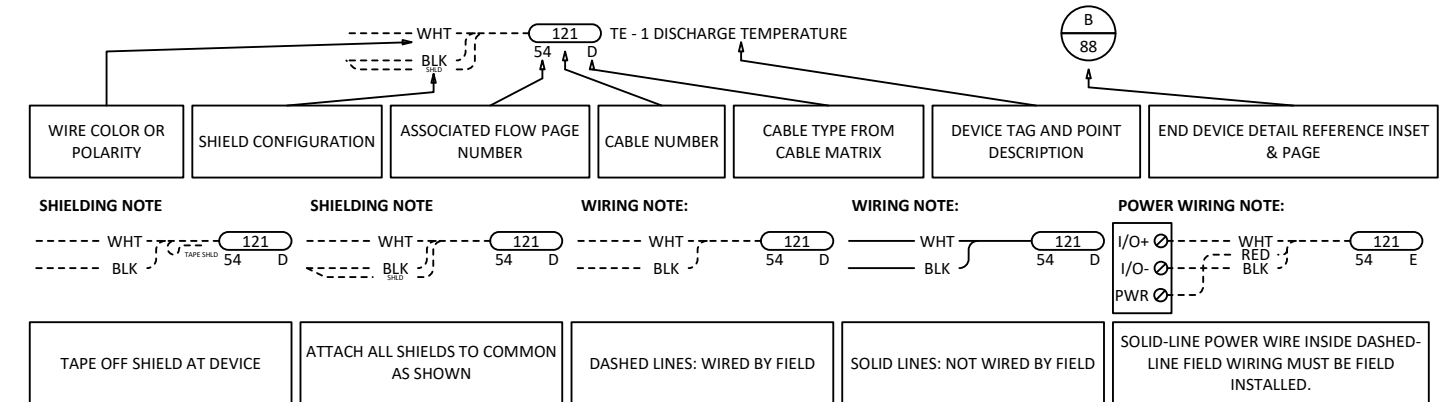

FACTORY MOUNTED DEVICE WITH FIELD MOUNTED CONTROLLER:

FIELD, FACTORY AND EXISTING DEVICE NOTES:


FLOW SHAPE NOTES:

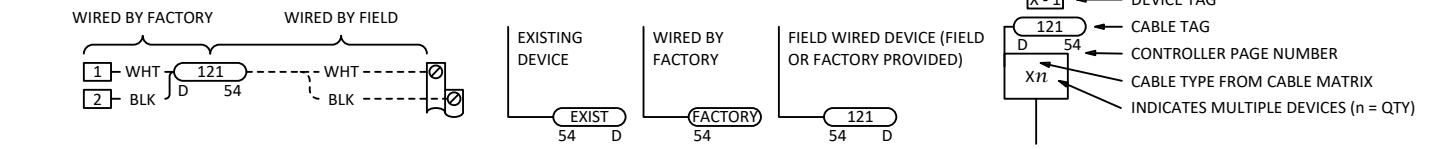


RISER 'WIRING BY' NOTE:

| | | |
|--------------------------------|---------------|---------|
| EC - ELECTRICAL CONTRACTOR | 480 VAC BY EC | ENC - 1 |
| ESC - ELECTRICAL SUBCONTRACTOR | | |
| OTHER | | |
| TRANE | | |
| EXIST - EXISTING | | |

WIRELESS COMMUNICATION NOTES:

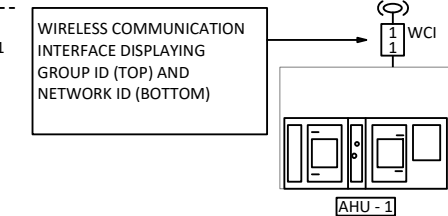

ENCLOSURE TAG:

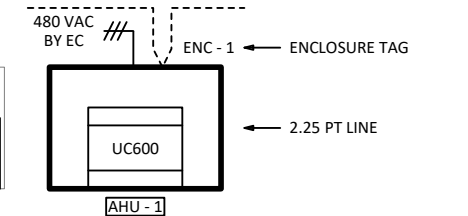

INTERCONNECT WIRING DETAIL REFERENCE:

| | |
|----|---|
| A | INTERCONNECT WIRING DETAIL REFERENCE INSET LETTER (TOP), PAGE NUMBER (BOTTOM) |
| 12 | |


RISER TERMINATION DEVICES

| | |
|----|----------------------|
| BT | BACNET TERMINATOR |
| R | TERMINATION RESISTOR |

WIRING NOTES

| CID: | NUM. | REVISION | DATE: | BY: |
|---|------|---|----------|-----|
| 00097395 | | | | |
| PID: 00105161 | | | | |
| PROJECT: K901283 | | | | |
| SALESPERSON: Z Rutledge | | | | |
| DESIGNED BY: B Nyamaah | | | | |
| CHECKED BY: | 1 | -SUBMITTALS | 3/1/2022 | BEN |
| Fort Worth 4200 N. Sylvania Avenue FORT WORTH, TX 76137 817-838-1300 FILE: Kiewitt Westlake Office_rev1.vsd | | PROJECT: Kiewitt Westlake Office TI 2050 Roanoke Road WESTLAKE TX 76262 | | |




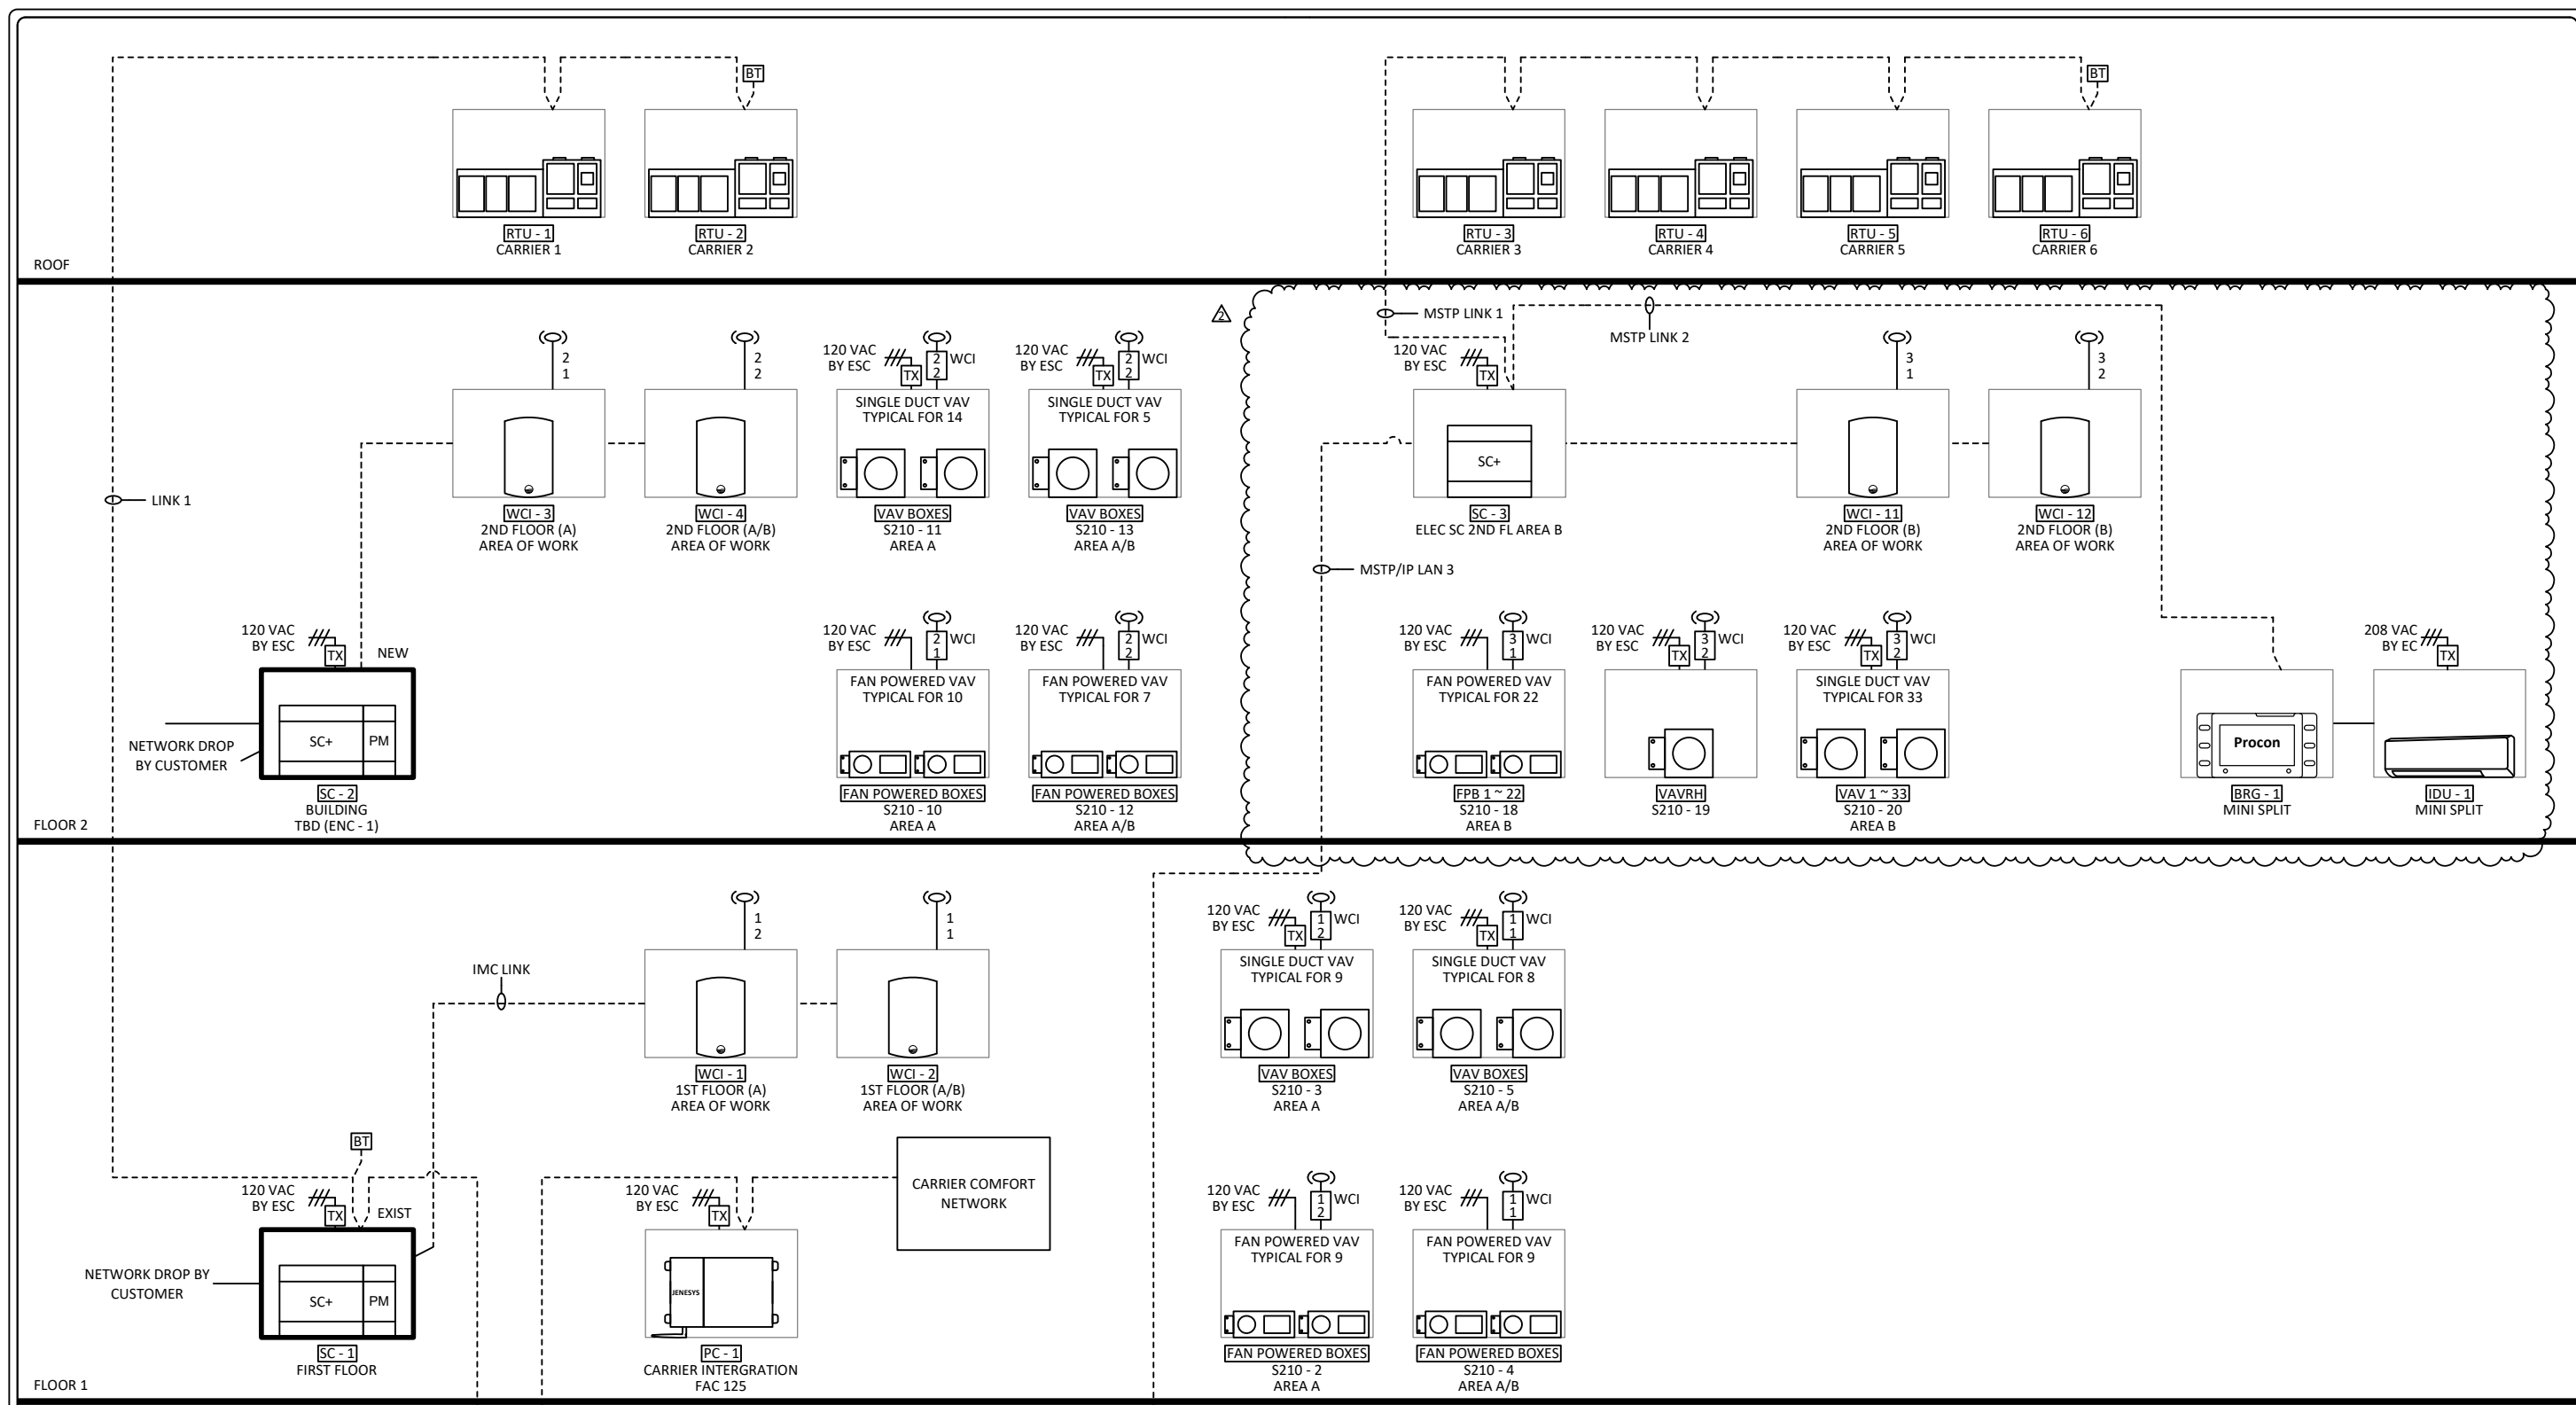


| RISER | | | | |
|---|------|--|-----------|-------------|
| CID: | NUM. | REVISION | DATE: | BY: |
| 00097395 | | | | |
| PID: 00105161 | | | | |
| PROJECT: K901283 | | | | |
| SALESPERSON: Z Rutledge | | | | |
| DESIGNED BY: B Nyamaah | 2 | -RECORD DRAWINGS | 7/28/2022 | BEN |
| CHECKED BY: | 1 | -SUBMITTALS | 3/1/2022 | BEN |
| Fort Worth 4200 N. Sylvania Avenue FORT WORTH, TX 76137 817-838-1300 | | PROJECT: Kiewit Westlake Office TI 2050 Roanoke Road WESTLAKE TX 76262 | | |
| FILE: Kiewitt Westlake Office_rev1.vsd | | | | DWG 5 OF 41 |



(HVAC LEVEL 1 – AREA A)

| BILL OF MATERIAL | | | | |
|------------------|-----|--------|---------|-------------|
| TAG | QTY | VENDOR | PART NO | DESCRIPTION |

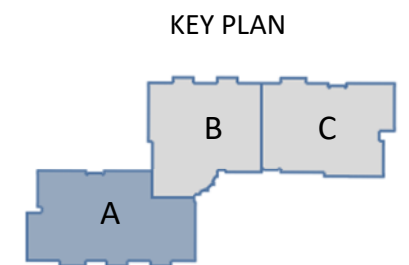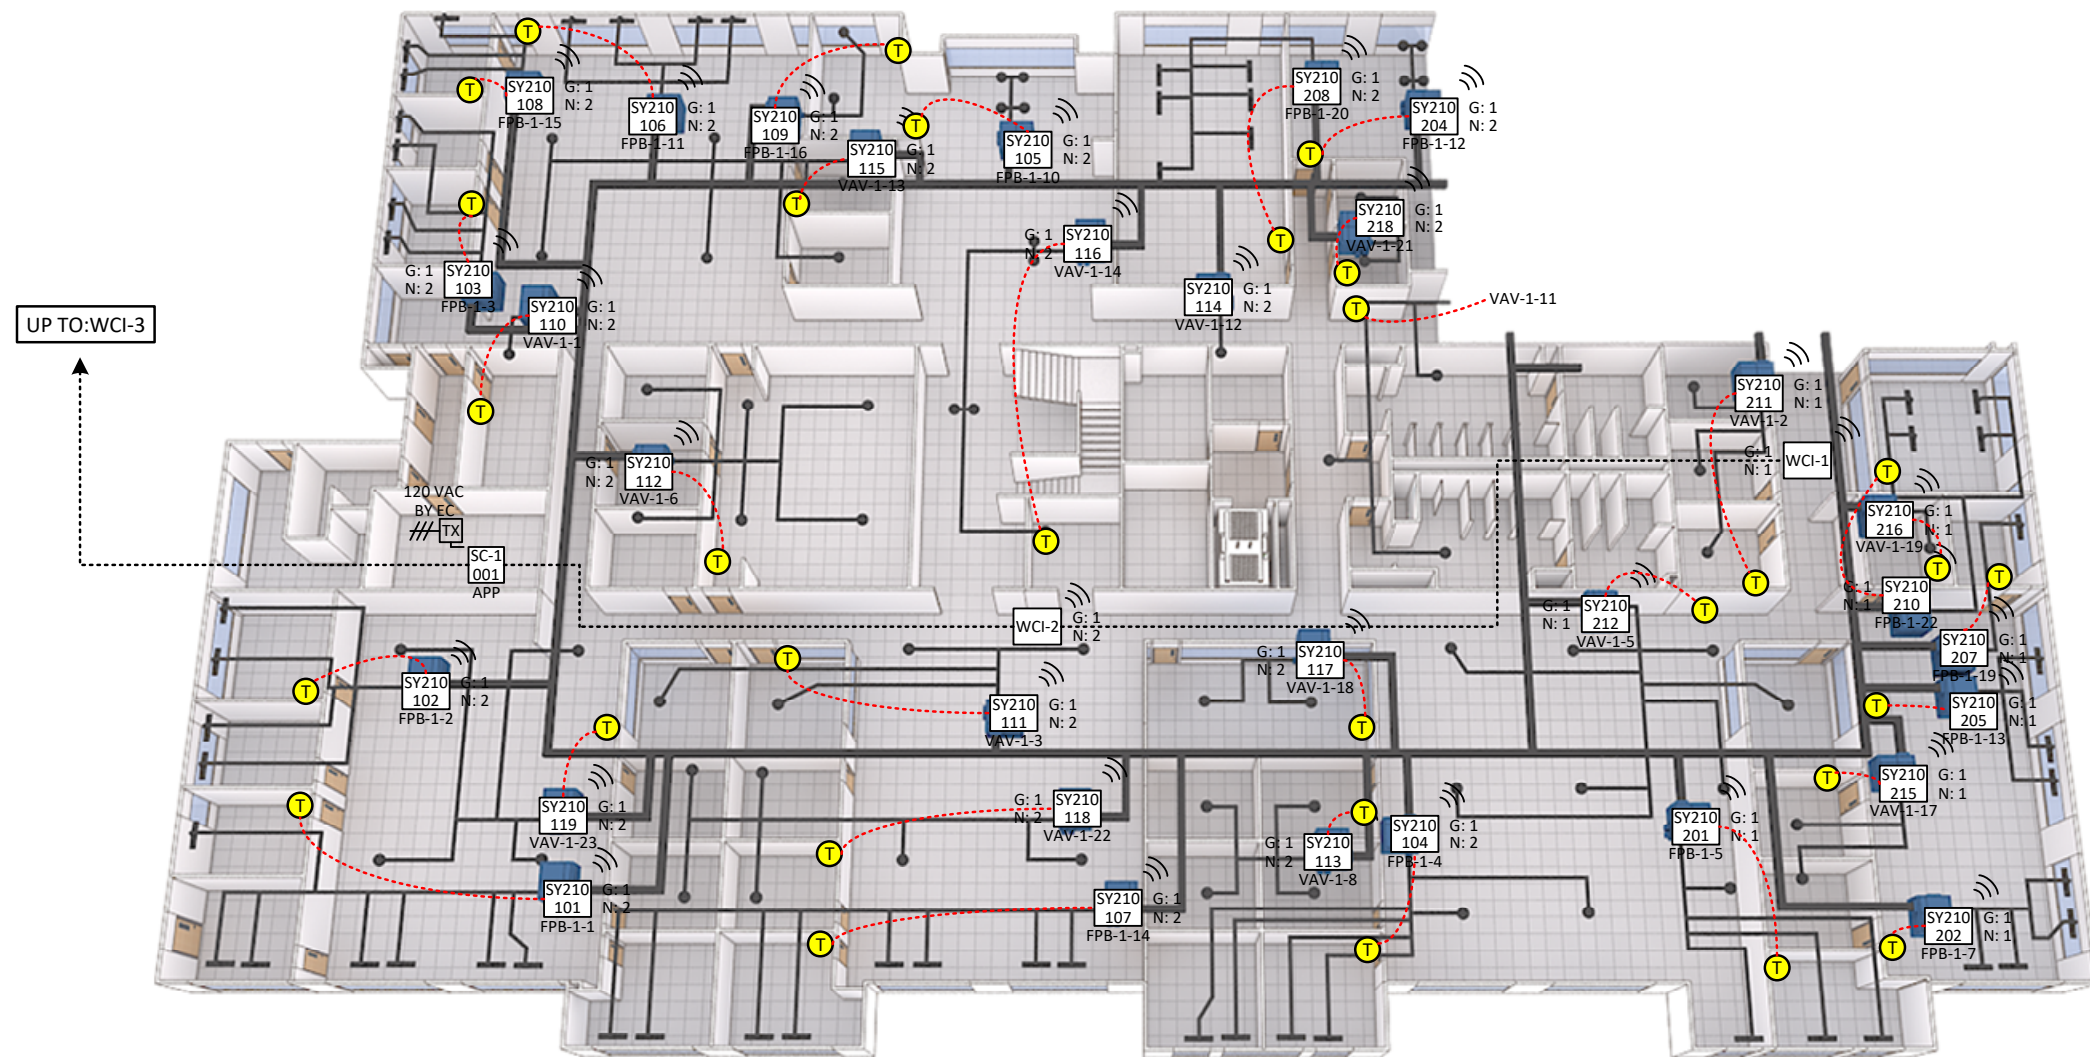

NOTES:


1. COMM. LINK ROUTING SHOWN IS ONLY SUGGESTION, & ORDER OF CONNECTION OF DEVICES IS NOT CRITICAL. HOWEVER, DOCUMENT ALL DEVIATIONS FOR RECORD DRAWINGS. COMM. LINK SHOULD ONLY BE "DAISY CHAINED". "STAR" CONNECTIONS ARE UNACCEPTABLE.
2. ROUTE COMM. LINKS BETWEEN AREAS & FLOORS IN THE MOST LOGICAL & EXPEDITIOUS MANNER.
3. WIRING BETWEEN A WCI AND A CONTROLLER CANNOT EXCEED 656' (200m)
4. EACH TRANE WIRELESS NETWORK CAN HAVE A TOTAL OF 21 WCIS (20 NETWORK MEMBER WCIS PLUS 1 NETWORK COORDINATOR WCI). EACH NETWORK REQUIRES ONE WCI TO FUNCTION AS THE NETWORK COORDINATOR.

LEGEND:

- IMC (A)
- BACNET MSTP LINK 1 (A)
- BACNET MSTP LINK 2 (A)

LEGEND:

- (T) TEMPERATURE
- (H) HUMIDITY

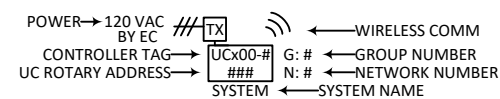



1 FIELD TO REFERENCE MECHANICAL FOR "EXACT LOCATION OF EQUIPMENT AND SENSORS" M101 & M102



| HVAC LEVEL 1 - AREA A | | | | |
|---|--|-------------|----------|-----|
| CID: 00097395 | NUM. | REVISION | DATE: | BY: |
| PID: 00105161 | | | | |
| PROJECT: K901283 | | | | |
| SALESPERSON: Z Rutledge | | | | |
| DESIGNED BY: B Nyamaah | | | | |
| CHECKED BY: | 1 | -SUBMITTALS | 3/1/2022 | BEN |
| Fort Worth 4200 N. Sylvania Avenue FORT WORTH, TX 76137 817-838-1300 | PROJECT: Kiewit Westlake Office TI 2050 Roanoke Road WESTLAKE TX 76262 | | | |
| FILE: Kiewitt Westlake Office_rev1.vsd | DWG 6 OF 41 | | | |

(HVAC LEVEL 1 – AREA B)

| BILL OF MATERIAL | | | | |
|------------------|-----|--------|---------|-------------|
| TAG | QTY | VENDOR | PART NO | DESCRIPTION |

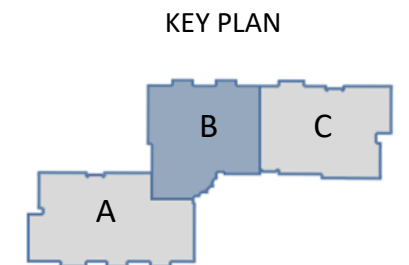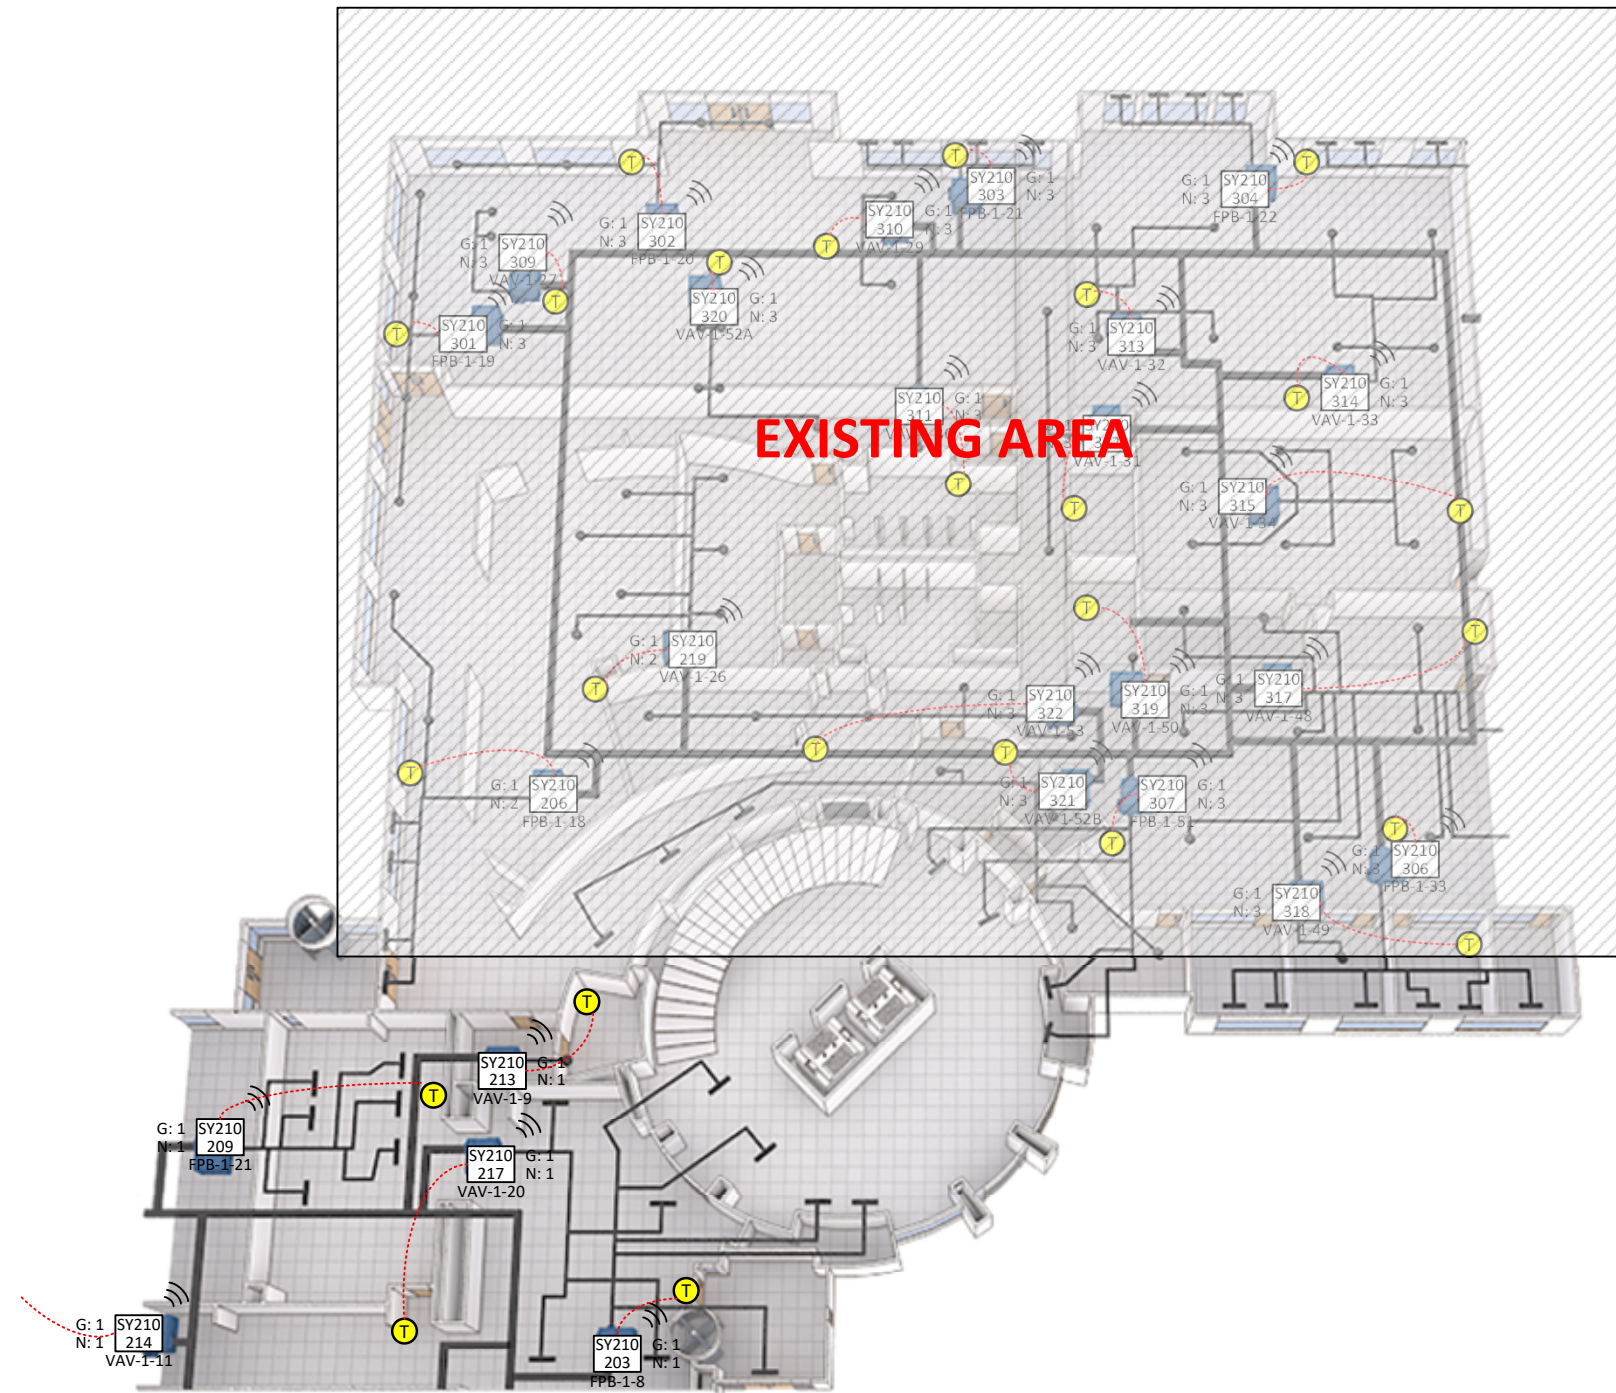

NOTES:


1. COMM. LINK ROUTING SHOWN IS ONLY SUGGESTION, & ORDER OF CONNECTION OF DEVICES IS NOT CRITICAL. HOWEVER, DOCUMENT ALL DEVIATIONS FOR RECORD DRAWINGS. COMM. LINK SHOULD ONLY BE "DAISY CHAINED". "STAR" CONNECTIONS ARE UNACCEPTABLE.
2. ROUTE COMM. LINKS BETWEEN AREAS & FLOORS IN THE MOST LOGICAL & EXPEDITIOUS MANNER.
3. WIRING BETWEEN A WCI AND A CONTROLLER CANNOT EXCEED 656' (200m)
4. EACH TRANE WIRELESS NETWORK CAN HAVE A TOTAL OF 21 WCIS (20 NETWORK MEMBER WCIS PLUS 1 NETWORK COORDINATOR WCI). EACH NETWORK REQUIRES ONE WCI TO FUNCTION AS THE NETWORK COORDINATOR.

LEGEND:

- IMC (A)
- BACNET MSTP LINK 1 (A)
- BACNET MSTP LINK 2 (A)

LEGEND:

- (T) TEMPERATURE
- (H) HUMIDITY

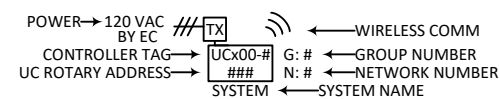


FIELD TO REFERENCE MECHANICAL FOR "EXACT LOCATION OF EQUIPMENT AND SENSORS" M101 & M102

| HVAC LEVEL 1 - AREA B | | | | |
|---|--|-------------|----------|-----|
| CID: | NUM. | REVISION | DATE: | BY: |
| 00097395 | | | | |
| PID: 00105161 | | | | |
| PROJECT: K901283 | | | | |
| SALESPERSON: Z Rutledge | | | | |
| DESIGNED BY: B Nyamaah | | | | |
| CHECKED BY: | 1 | -SUBMITTALS | 3/1/2022 | BEN |
| Fort Worth 4200 N. Sylvania Avenue FORT WORTH, TX 76137 817-838-1300 | PROJECT: Kiewit Westlake Office TI 2050 Roanoke Road WESTLAKE TX 76262 | | | |
| FILE: Kiewitt Westlake Office_rev1.vsd | DWG 7 OF 41 | | | |



(HVAC LEVEL 1 – AREA C)

| BILL OF MATERIAL | | | | |
|------------------|-----|--------|---------|-------------|
| TAG | QTY | VENDOR | PART NO | DESCRIPTION |

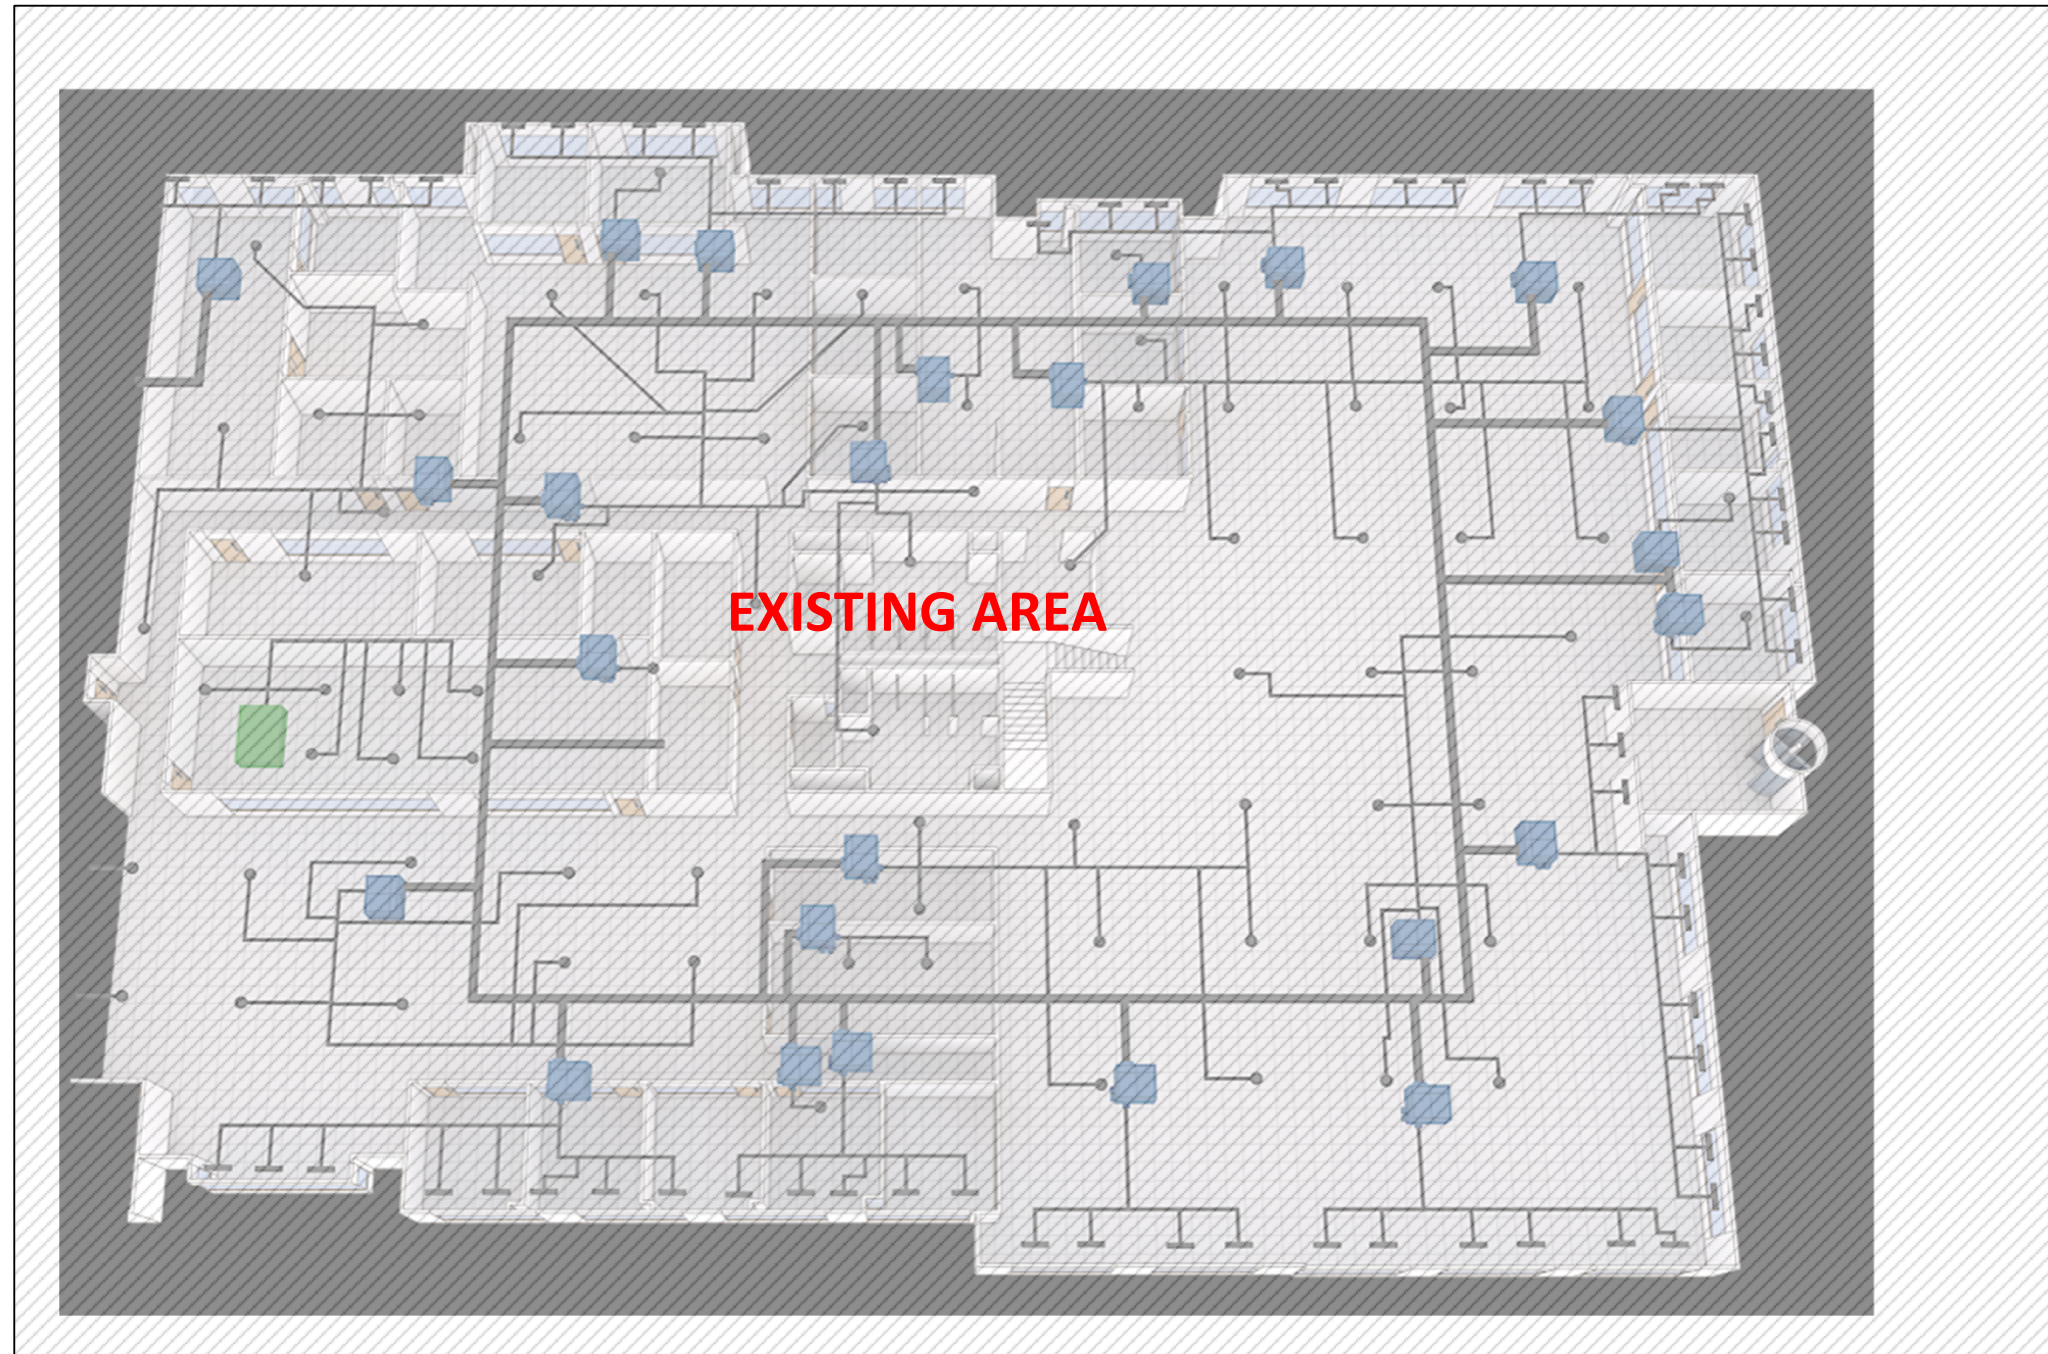

CARRIER COMFORT NETWORK

KEY PLAN



NOTES:


1. COMM. LINK ROUTING SHOWN IS ONLY SUGGESTION, & ORDER OF CONNECTION OF DEVICES IS NOT CRITICAL. HOWEVER, DOCUMENT ALL DEVIATIONS FOR RECORD DRAWINGS. COMM. LINK SHOULD ONLY BE "DAISY CHAINED". "STAR" CONNECTIONS ARE UNACCEPTABLE.
2. ROUTE COMM. LINKS BETWEEN AREAS & FLOORS IN THE MOST LOGICAL & EXPEDITIOUS MANNER.
3. WIRING BETWEEN A WCI AND A CONTROLLER CANNOT EXCEED 656' (200m)
4. EACH TRANE WIRELESS NETWORK CAN HAVE A TOTAL OF 21 WCIS (20 NETWORK MEMBER WCIS PLUS 1 NETWORK COORDINATOR WCI). EACH NETWORK REQUIRES ONE WCI TO FUNCTION AS THE NETWORK COORDINATOR.

LEGEND:

- IMC (A)
- BACNET MSTP LINK 1 (A)
- BACNET MSTP LINK 2 (A)

LEGEND:



- T** TEMPERATURE
- H** HUMIDITY

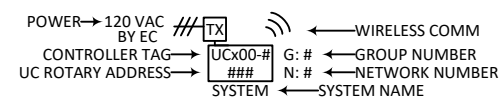

| HVAC LEVEL 1 - AREA C | | | | |
|---|--|-------------|----------|-------------|
| CID: 00097395 | NUM. | REVISION | DATE: | BY: |
| PID: 00105161 | | | | |
| PROJECT: K901283 | | | | |
| SALESPERSON: Z Rutledge | | | | |
| DESIGNED BY: B Nyamaah | | | | |
| CHECKED BY: | 1 | -SUBMITTALS | 3/1/2022 | BEN |
| Fort Worth 4200 N. Sylvania Avenue FORT WORTH, TX 76137 817-838-1300 | PROJECT: Kiewit Westlake Office TI 2050 Roanoke Road WESTLAKE TX 76262 | | | |
| FILE: Kiewitt Westlake Office_rev1.vsd | | | | DWG 8 OF 41 |

(HVAC LEVEL 2 – AREA A)

| BILL OF MATERIAL | | | | |
|------------------|-----|--------|---------|-------------|
| TAG | QTY | VENDOR | PART NO | DESCRIPTION |

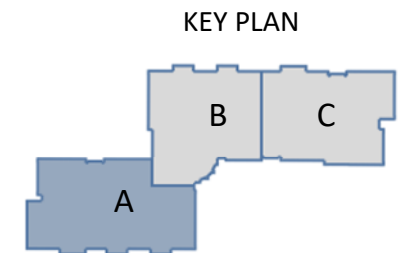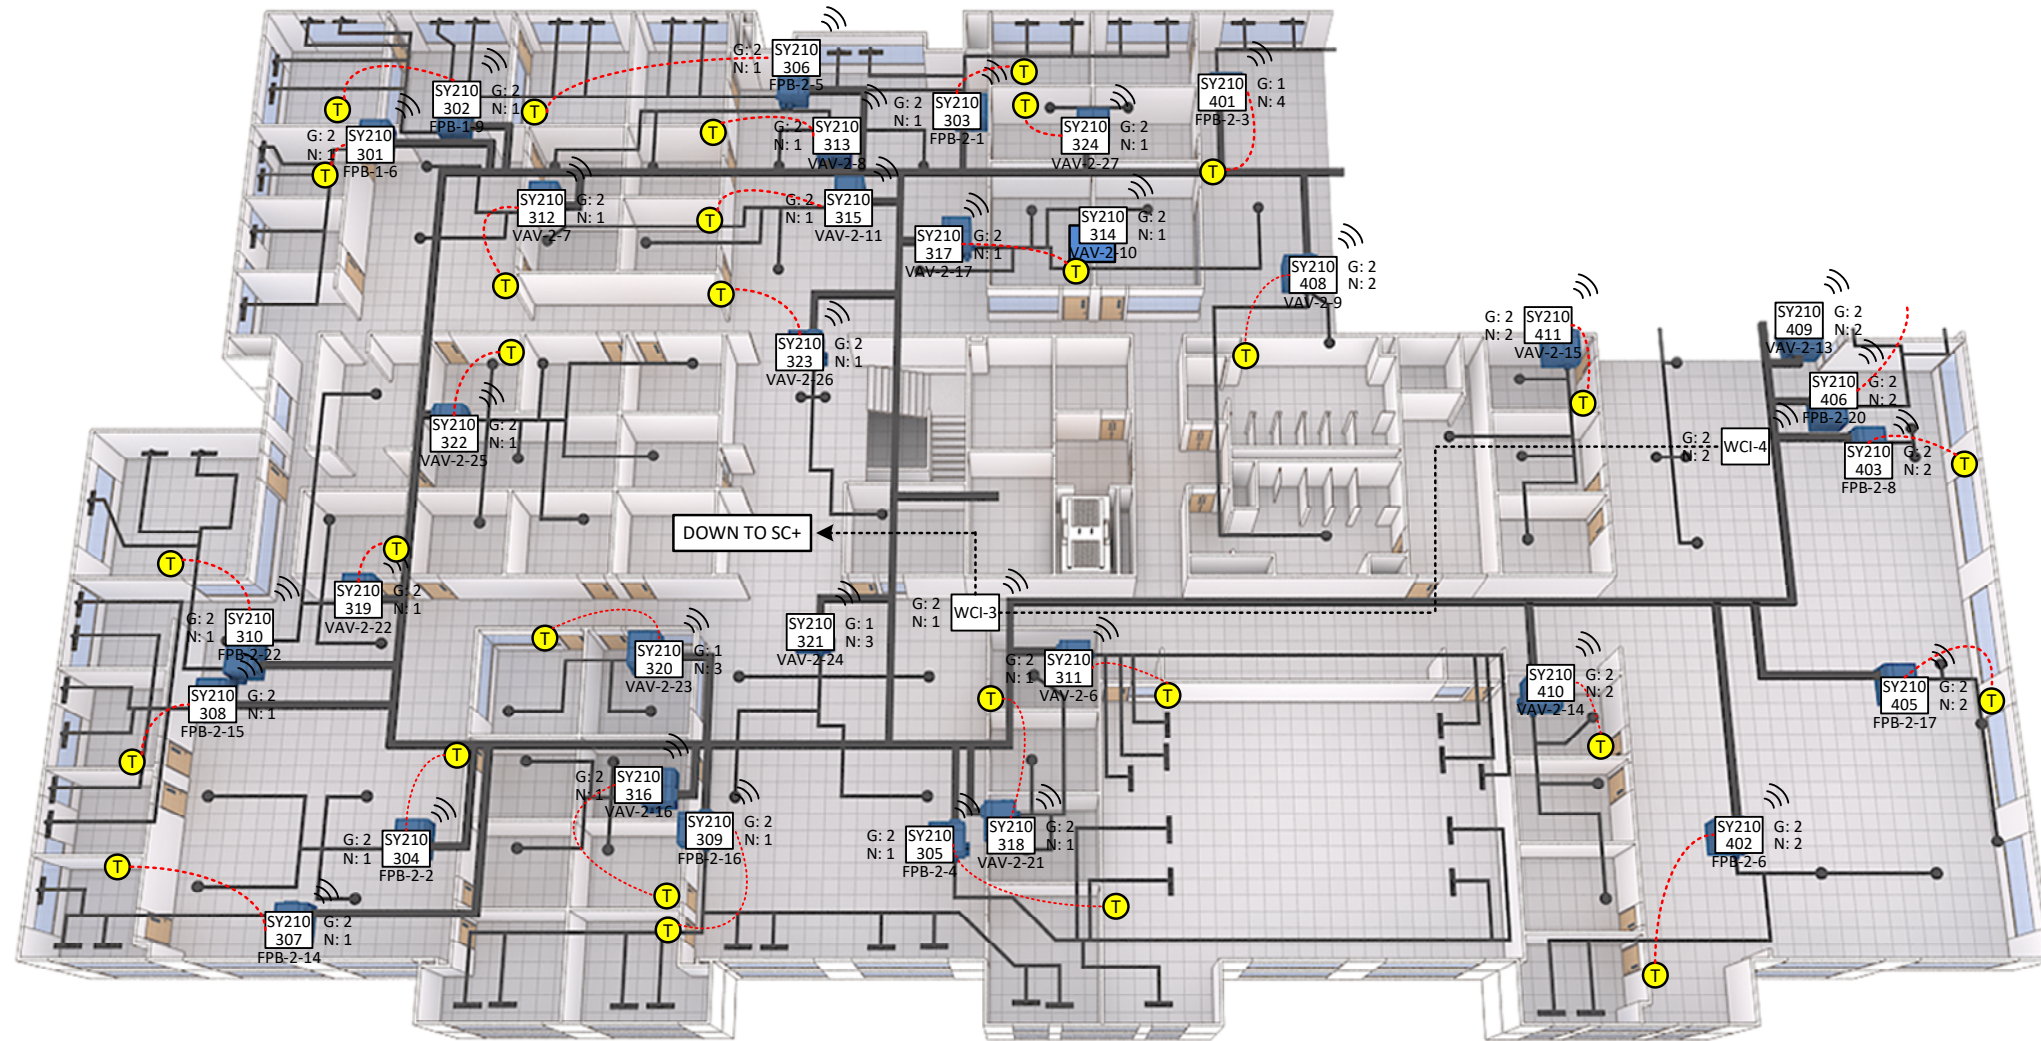

NOTES:


1. COMM. LINK ROUTING SHOWN IS ONLY SUGGESTION, & ORDER OF CONNECTION OF DEVICES IS NOT CRITICAL. HOWEVER, DOCUMENT ALL DEVIATIONS FOR RECORD DRAWINGS. COMM. LINK SHOULD ONLY BE "DAISY CHAINED". "STAR" CONNECTIONS ARE UNACCEPTABLE.
2. ROUTE COMM. LINKS BETWEEN AREAS & FLOORS IN THE MOST LOGICAL & EXPEDITIOUS MANNER.
3. WIRING BETWEEN A WCI AND A CONTROLLER CANNOT EXCEED 656' (200m)
4. EACH TRANE WIRELESS NETWORK CAN HAVE A TOTAL OF 21 WCIS (20 NETWORK MEMBER WCIS PLUS 1 NETWORK COORDINATOR WCI). EACH NETWORK REQUIRES ONE WCI TO FUNCTION AS THE NETWORK COORDINATOR.

LEGEND:

- IMC (A)
- BACNET MSTP LINK 1 (A)
- BACNET MSTP LINK 2 (A)

LEGEND:

- (T) TEMPERATURE
- (H) HUMIDITY

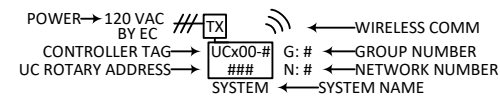


1 FIELD TO REFERENCE MECHANICAL FOR "EXACT LOCATION OF EQUIPMENT AND SENSORS" M101 & M102

| HVAC LEVEL 2 - AREA A | | | | |
|---|--|-------------|----------|-----|
| CID: 00097395 | NUM. | REVISION | DATE: | BY: |
| PID: 00105161 | | | | |
| PROJECT: K901283 | | | | |
| SALESPERSON: Z Rutledge | | | | |
| DESIGNED BY: B Nyamaah | | | | |
| CHECKED BY: | 1 | -SUBMITTALS | 3/1/2022 | BEN |
| Fort Worth 4200 N. Sylvania Avenue FORT WORTH, TX 76137 817-838-1300 | PROJECT: Kiewit Westlake Office TI 2050 Roanoke Road WESTLAKE TX 76262 | | | |
| FILE: Kiewitt Westlake Office_rev1.vsdx | DWG 9 OF 41 | | | |



(HVAC LEVEL 2 – AREA B)

| BILL OF MATERIAL | | | | |
|------------------|-----|--------|---------|-------------|
| TAG | QTY | VENDOR | PART NO | DESCRIPTION |

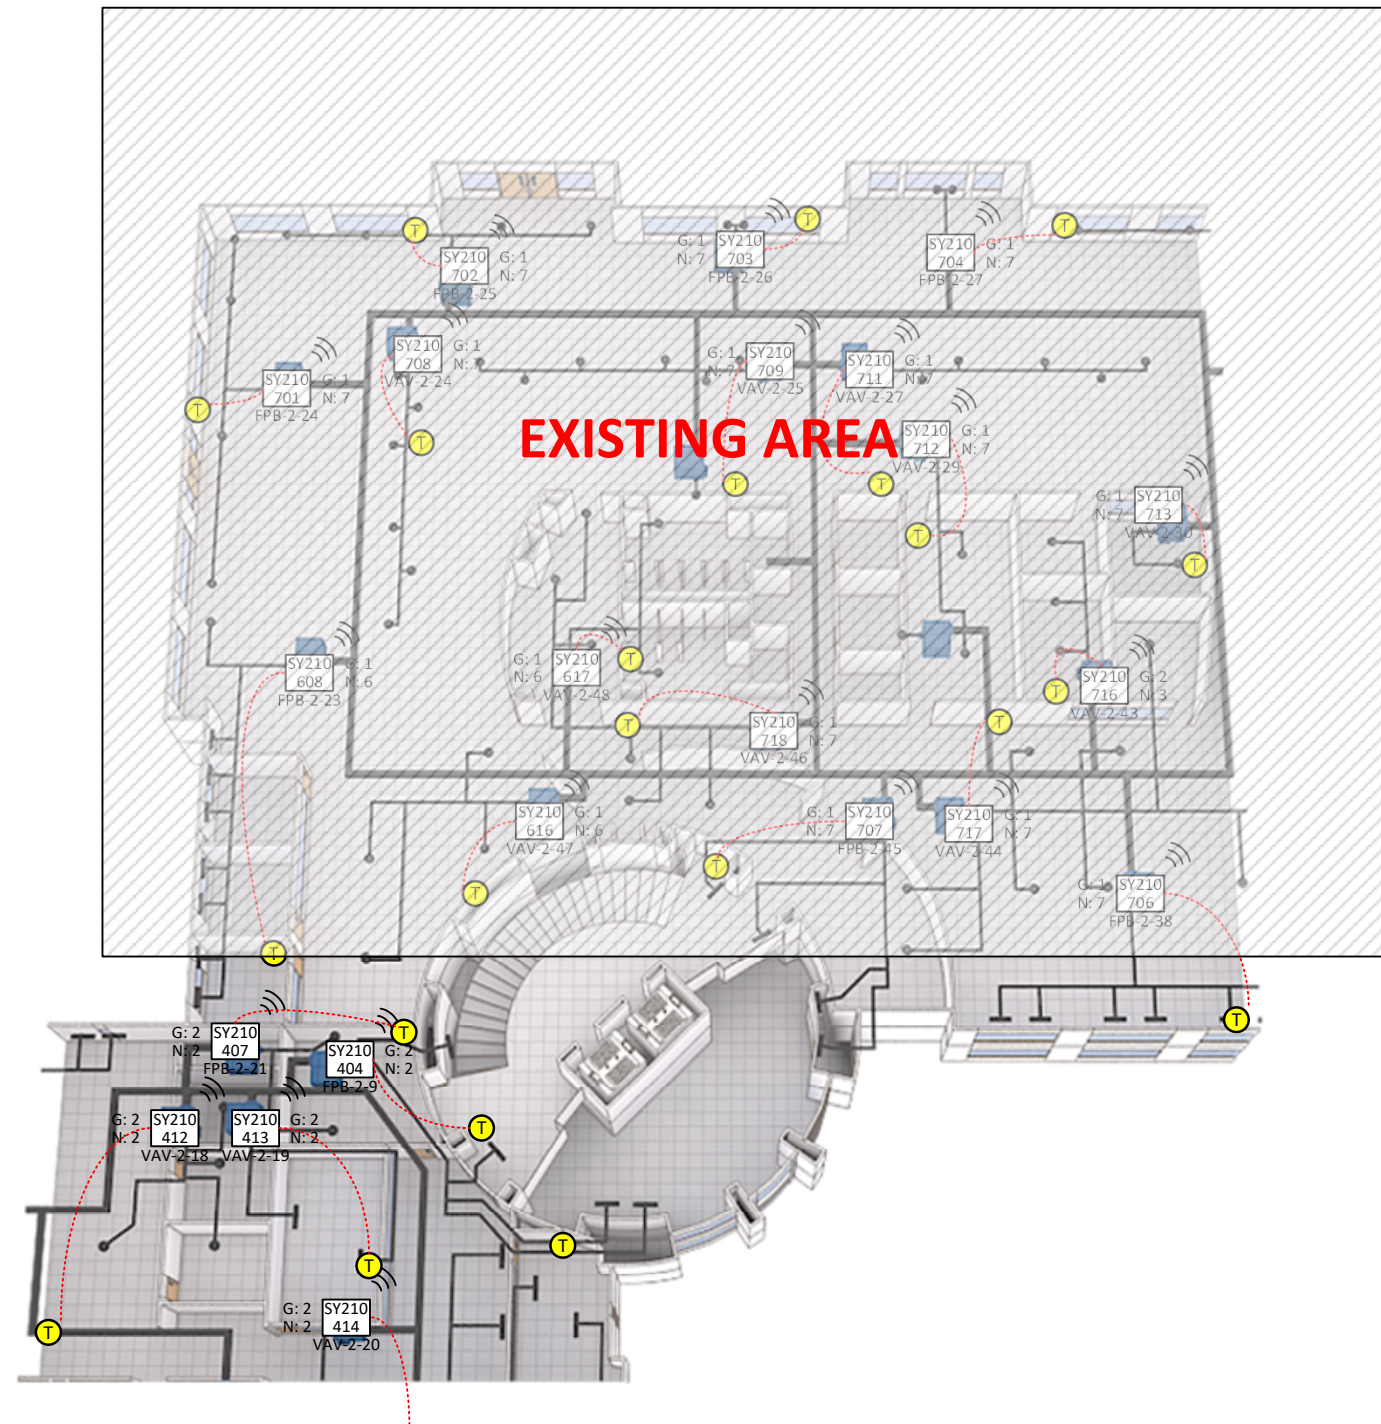

NOTES:


1. COMM. LINK ROUTING SHOWN IS ONLY SUGGESTION, & ORDER OF CONNECTION OF DEVICES IS NOT CRITICAL. HOWEVER, DOCUMENT ALL DEVIATIONS FOR RECORD DRAWINGS. COMM. LINK SHOULD ONLY BE "DAISY CHAINED". "STAR" CONNECTIONS ARE UNACCEPTABLE.
2. ROUTE COMM. LINKS BETWEEN AREAS & FLOORS IN THE MOST LOGICAL & EXPEDITIOUS MANNER.
3. WIRING BETWEEN A WCI AND A CONTROLLER CANNOT EXCEED 656' (200m)
4. EACH TRANE WIRELESS NETWORK CAN HAVE A TOTAL OF 21 WCIS (20 NETWORK MEMBER WCIS PLUS 1 NETWORK COORDINATOR WCI). EACH NETWORK REQUIRES ONE WCI TO FUNCTION AS THE NETWORK COORDINATOR.

LEGEND:


- IMC (A)
- BACNET MSTP LINK 1 (A)
- BACNET MSTP LINK 2 (A)

LEGEND:

- (T) TEMPERATURE
- (H) HUMIDITY

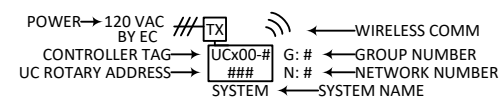

KEY PLAN

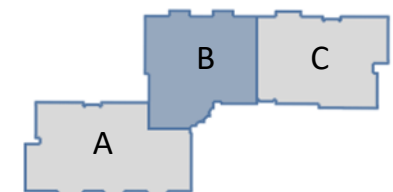


1 FIELD TO REFERENCE MECHANICAL FOR "EXACT LOCATION OF EQUIPMENT AND SENSORS" M101 & M102

| HVAC LEVEL 2 - AREA B | | | | |
|---|--|-------------|----------|--------------|
| CID: 00097395 | NUM. | REVISION | DATE: | BY: |
| PID: 00105161 | | | | |
| PROJECT: K901283 | | | | |
| SALESPERSON: Z Rutledge | | | | |
| DESIGNED BY: B Nyamaah | | | | |
| CHECKED BY: | 1 | -SUBMITTALS | 3/1/2022 | BEN |
| Fort Worth 4200 N. Sylvania Avenue FORT WORTH, TX 76137 817-838-1300 | PROJECT: Kiewit Westlake Office TI | | | |
| FILE: Kiewitt Westlake Office_rev1.vsd | 2050 Roanoke Road WESTLAKE TX 76262 | | | DWG 10 OF 41 |

(HVAC LEVEL 2 – AREA C)

| BILL OF MATERIAL | | | | |
|------------------|-----|--------|---------|-------------|
| TAG | QTY | VENDOR | PART NO | DESCRIPTION |

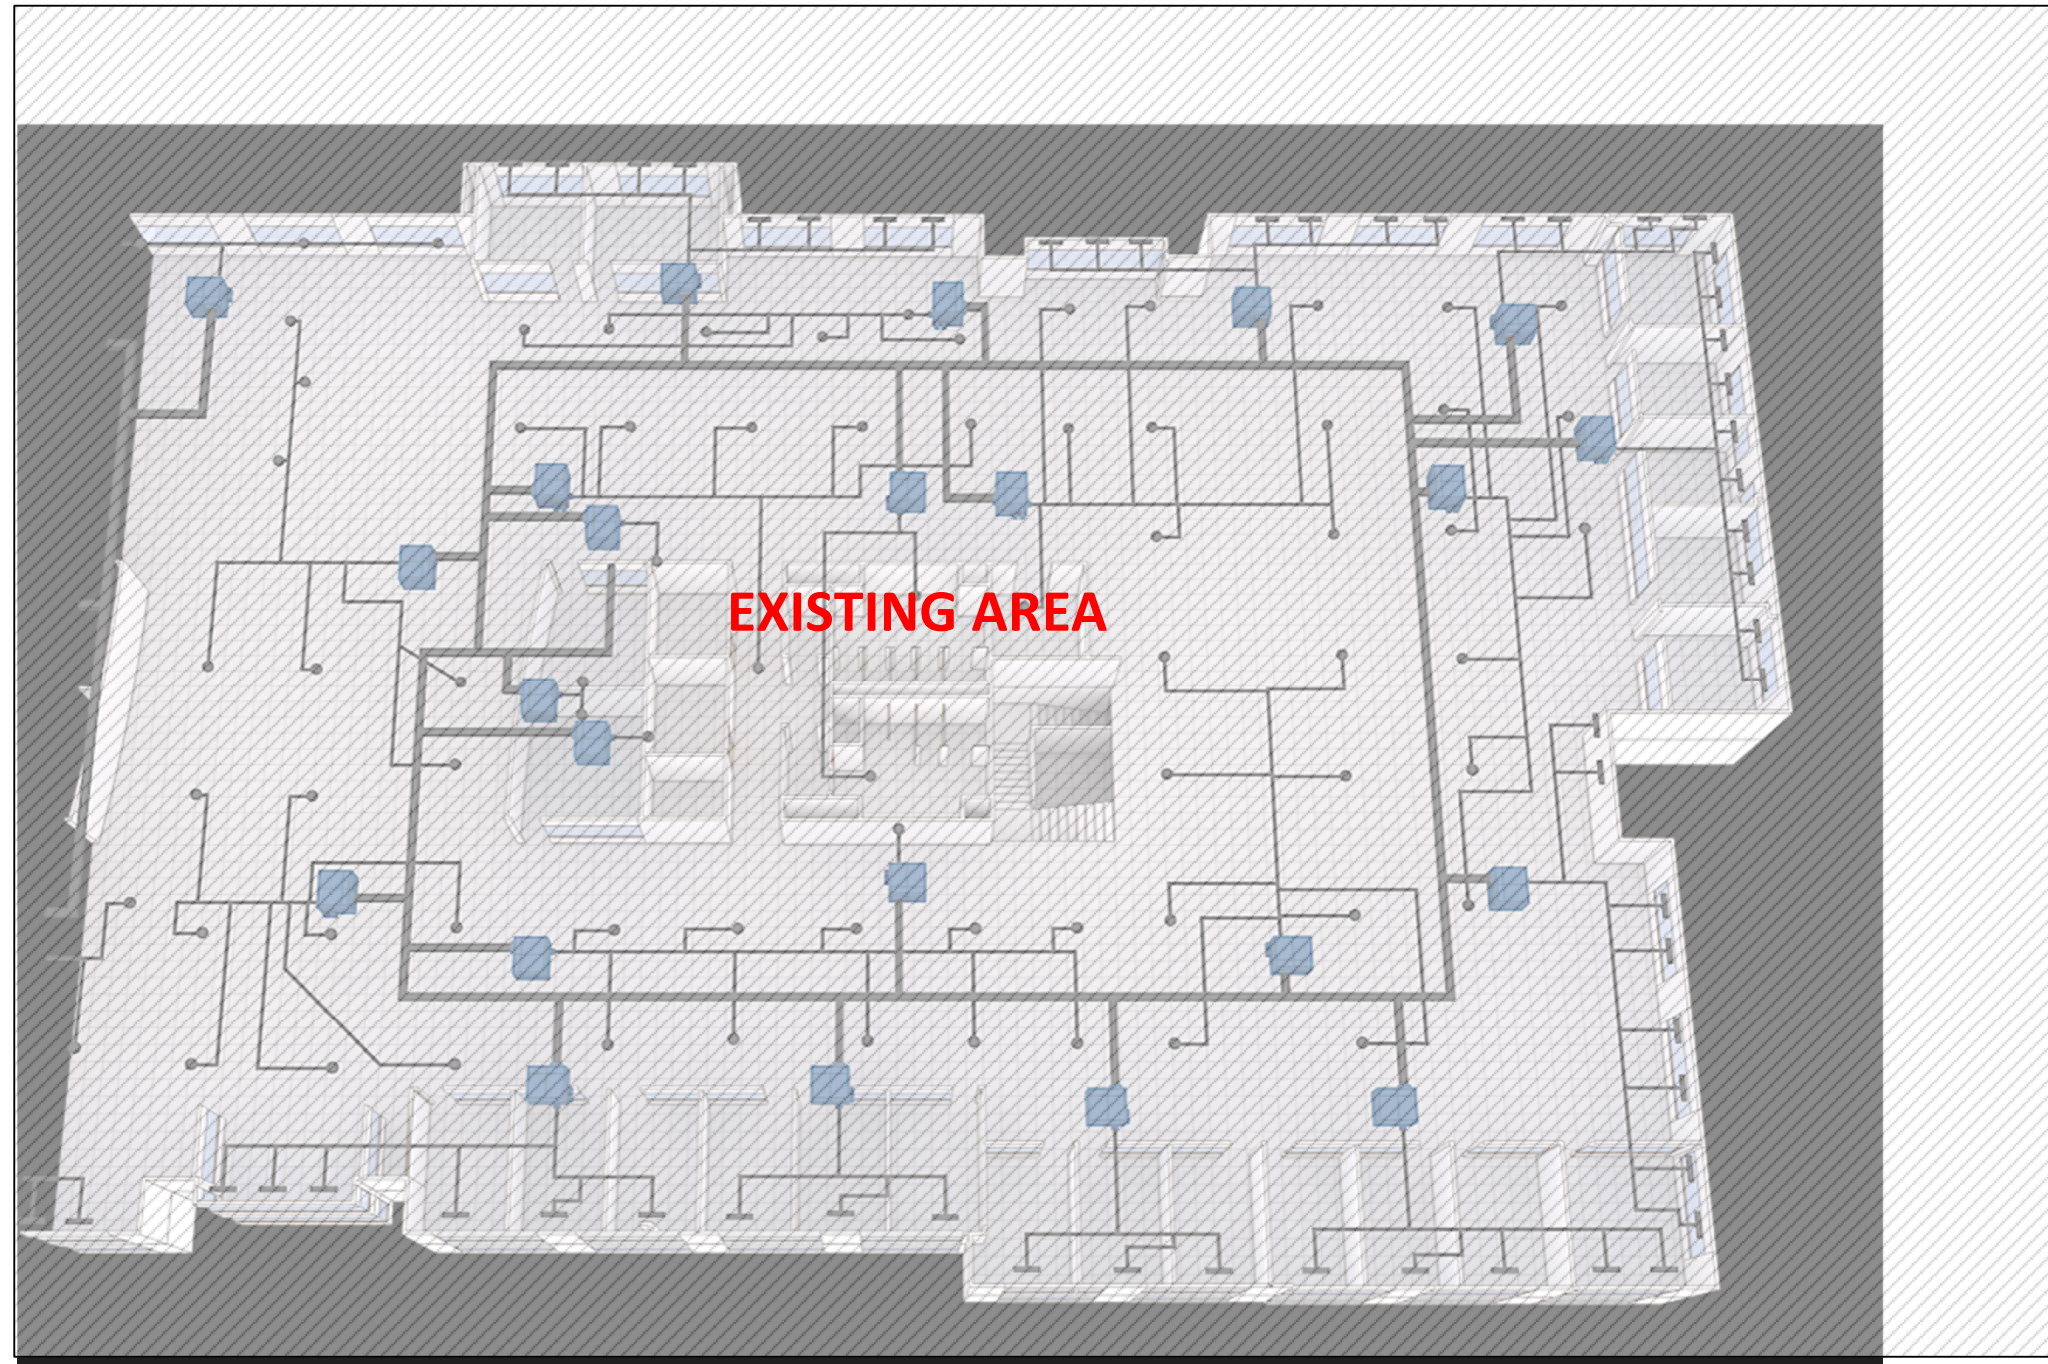

CARRIER COMFORT NETWORK

KEY PLAN



NOTES:


1. COMM. LINK ROUTING SHOWN IS ONLY SUGGESTION, & ORDER OF CONNECTION OF DEVICES IS NOT CRITICAL. HOWEVER, DOCUMENT ALL DEVIATIONS FOR RECORD DRAWINGS. COMM. LINK SHOULD ONLY BE "DAISY CHAINED". "STAR" CONNECTIONS ARE UNACCEPTABLE.
2. ROUTE COMM. LINKS BETWEEN AREAS & FLOORS IN THE MOST LOGICAL & EXPEDITIOUS MANNER.
3. WIRING BETWEEN A WCI AND A CONTROLLER CANNOT EXCEED 656' (200m)
4. EACH TRANE WIRELESS NETWORK CAN HAVE A TOTAL OF 21 WCIS (20 NETWORK MEMBER WCIS PLUS 1 NETWORK COORDINATOR WCI). EACH NETWORK REQUIRES ONE WCI TO FUNCTION AS THE NETWORK COORDINATOR.

LEGEND:

- IMC (A)
- BACNET MSTP LINK 1 (A)
- BACNET MSTP LINK 2 (A)

LEGEND:

- T** TEMPERATURE
- H** HUMIDITY

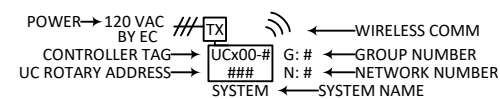

| HVAC LEVEL 2 - AREA C | | | | |
|---|--|-------------|----------|--------------|
| CID: | NUM. | REVISION | DATE: | BY: |
| 00097395 | | | | |
| PID: 00105161 | | | | |
| PROJECT: K901283 | | | | |
| SALESPERSON: Z Rutledge | | | | |
| DESIGNED BY: B Nyamaah | | | | |
| CHECKED BY: | 1 | -SUBMITTALS | 3/1/2022 | BEN |
| Fort Worth 4200 N. Sylvania Avenue FORT WORTH, TX 76137 817-838-1300 | PROJECT: Kiewit Westlake Office TI 2050 Roanoke Road WESTLAKE TX 76262 | | | |
| FILE: Kiewitt Westlake Office_rev1.vsd | | | | DWG 11 OF 41 |

ADDRESS SCHEDULE (1 of 5)

| ITEM | LINK TYPE | LINK | RISER TAG | CONTROLLER/SYSTEM | LOCATION | AREA SERVED | GRP. | NET. | ADD. | WIRELESS SENSOR ADDRESS | IP ADDRESS | SUBNET MASK | GATEWAY | NOTE |
|------|-----------|----------------------|------------|-------------------|--------------|-----------------|------|------|------|-------------------------|------------|-------------|---------|------|
| 1 | BACnet | SC - 3 BACNET LINK 2 | MINI SPLIT | BRG - 1 | | | | | | | | | | |
| 2 | ETHERNET | ETHERNET | PC - 1 | PC - 1 | | | | | | | | | | |
| 3 | ETHERNET | ETHERNET | SC - 1 | SC - 2 | | | | | 001 | | | | | |
| 4 | ETHERNET | ETHERNET | SC - 2 | SC - 1 | | | | | 002 | | | | | |
| 5 | ETHERNET | ETHERNET | SC - 4 | SC - 3 | | | | | | | | | | |
| 6 | WCI IMC | SC - 1 WCI IMC 1 | WCI - 1 | WCI - 1 | AREA OF WORK | 1ST FLOOR (A) | | | | | | | | |
| 7 | WCI IMC | SC - 1 WCI IMC 1 | WCI - 2 | WCI - 2 | AREA OF WORK | 1ST FLOOR (A/B) | | | | | | | | |
| 8 | WCI IMC | SC - 2 WCI IMC 1 | WCI - 3 | WCI - 3 | AREA OF WORK | 2ND FLOOR (A) | | | | | | | | |
| 9 | WCI IMC | SC - 2 WCI IMC 1 | WCI - 4 | WCI - 4 | AREA OF WORK | 2ND FLOOR (A/B) | | | | | | | | |
| 10 | WCI IMC | SC - 3 WCI IMC 1 | WCI - 11 | WCI - 11 | AREA OF WORK | 2ND FLOOR (B) | | | | | | | | |
| 11 | WCI IMC | SC - 3 WCI IMC 1 | WCI - 12 | WCI - 12 | AREA OF WORK | 2ND FLOOR (B) | | | | | | | | |
| 12 | WIRELESS | SC - 1 VIA WCI - 1 | FPB-1 - 1 | FAN POWERED BOXES | 1ST FLOOR | | 1 | 2 | 101 | | | | | |
| 13 | WIRELESS | SC - 1 VIA WCI - 1 | FPB-1 - 2 | FAN POWERED BOXES | 1ST FLOOR | | 1 | 2 | 102 | | | | | |
| 14 | WIRELESS | SC - 1 VIA WCI - 1 | FPB-1 - 3 | FAN POWERED BOXES | 1ST FLOOR | | 1 | 2 | 103 | | | | | |
| 15 | WIRELESS | SC - 1 VIA WCI - 1 | FPB-1 - 4 | FAN POWERED BOXES | 1ST FLOOR | | 1 | 2 | 104 | | | | | |
| 16 | WIRELESS | SC - 1 VIA WCI - 1 | FPB-1 - 10 | FAN POWERED BOXES | 1ST FLOOR | | 1 | 2 | 105 | | | | | |
| 17 | WIRELESS | SC - 1 VIA WCI - 1 | FPB-1 - 11 | FAN POWERED BOXES | 1ST FLOOR | | 1 | 2 | 106 | | | | | |
| 18 | WIRELESS | SC - 1 VIA WCI - 1 | FPB-1 - 14 | FAN POWERED BOXES | 1ST FLOOR | | 1 | 2 | 107 | | | | | |
| 19 | WIRELESS | SC - 1 VIA WCI - 1 | FPB-1 - 15 | FAN POWERED BOXES | 1ST FLOOR | | 1 | 2 | 108 | | | | | |
| 20 | WIRELESS | SC - 1 VIA WCI - 1 | FPB-1 - 16 | FAN POWERED BOXES | 1ST FLOOR | | 1 | 2 | 109 | | | | | |
| 21 | WIRELESS | SC - 1 VIA WCI - 1 | VAV-1 - 1 | VAV BOXES | 1ST FLOOR | | 1 | 2 | 110 | | | | | |
| 22 | WIRELESS | SC - 1 VIA WCI - 1 | VAV-1 - 3 | VAV BOXES | 1ST FLOOR | | 1 | 2 | 111 | | | | | |
| 23 | WIRELESS | SC - 1 VIA WCI - 1 | VAV-1 - 6 | VAV BOXES | 1ST FLOOR | | 1 | 2 | 112 | | | | | |
| 24 | WIRELESS | SC - 1 VIA WCI - 1 | VAV-1 - 8 | VAV BOXES | 1ST FLOOR | | 1 | 2 | 113 | | | | | |
| 25 | WIRELESS | SC - 1 VIA WCI - 1 | VAV-1 - 12 | VAV BOXES | 1ST FLOOR | | 1 | 2 | 114 | | | | | |
| 26 | WIRELESS | SC - 1 VIA WCI - 1 | VAV-1 - 13 | VAV BOXES | 1ST FLOOR | | 1 | 2 | 115 | | | | | |
| 27 | WIRELESS | SC - 1 VIA WCI - 1 | VAV-1 - 14 | VAV BOXES | 1ST FLOOR | | 1 | 2 | 116 | | | | | |
| 28 | WIRELESS | SC - 1 VIA WCI - 1 | VAV-1 - 18 | VAV BOXES | 1ST FLOOR | | 1 | 2 | 129 | | | | | |
| 29 | WIRELESS | SC - 1 VIA WCI - 1 | VAV-1 - 23 | VAV BOXES | 1ST FLOOR | | 1 | 2 | 119 | | | | | |
| 30 | WIRELESS | SC - 1 VIA WCI - 2 | FPB-1 - 5 | FAN POWERED BOXES | 1ST FLOOR | | 1 | 1 | 201 | | | | | |
| 31 | WIRELESS | SC - 1 VIA WCI - 2 | FPB-1 - 7 | FAN POWERED BOXES | 1ST FLOOR | | 1 | 1 | 202 | | | | | |
| 32 | WIRELESS | SC - 1 VIA WCI - 2 | FPB-1 - 8 | FAN POWERED BOXES | 1ST FLOOR | | 1 | 1 | 203 | | | | | |
| 33 | WIRELESS | SC - 1 VIA WCI - 2 | FPB-1 - 12 | FAN POWERED BOXES | 1ST FLOOR | | 1 | 1 | 204 | | | | | |
| 34 | WIRELESS | SC - 1 VIA WCI - 2 | FPB-1 - 13 | FAN POWERED BOXES | 1ST FLOOR | | 1 | 1 | 206 | | | | | |
| 35 | WIRELESS | SC - 1 VIA WCI - 2 | FPB-1 - 19 | FAN POWERED BOXES | 1ST FLOOR | | 1 | 1 | 207 | | | | | |
| 36 | WIRELESS | SC - 1 VIA WCI - 2 | FPB-1 - 20 | FAN POWERED BOXES | 1ST FLOOR | | 1 | 1 | 208 | | | | | |
| 37 | WIRELESS | SC - 1 VIA WCI - 2 | FPB-1 - 21 | FAN POWERED BOXES | 1ST FLOOR | | 1 | 1 | 209 | | | | | |
| 38 | WIRELESS | SC - 1 VIA WCI - 2 | FPB-1 - 22 | FAN POWERED BOXES | 1ST FLOOR | | 1 | 1 | 210 | | | | | |
| 39 | WIRELESS | SC - 1 VIA WCI - 2 | VAV-1 - 2 | VAV BOXES | 1ST FLOOR | | 1 | 1 | 211 | | | | | |
| 40 | WIRELESS | SC - 1 VIA WCI - 2 | VAV-1 - 5 | VAV BOXES | 1ST FLOOR | | 1 | 1 | 212 | | | | | |
| 41 | WIRELESS | SC - 1 VIA WCI - 2 | VAV-1 - 9 | VAV BOXES | 1ST FLOOR | | 1 | 1 | 213 | | | | | |
| 42 | WIRELESS | SC - 1 VIA WCI - 2 | VAV-1 - 11 | VAV BOXES | 1ST FLOOR | | 1 | 1 | 214 | | | | | |
| 43 | WIRELESS | SC - 1 VIA WCI - 2 | VAV-1 - 17 | VAV BOXES | 1ST FLOOR | | 1 | 1 | 205 | | | | | |

| ADDRESS SCHEDULE | | | | |
|---|-------------------------------------|-------------|--|--------------|
| CID: 00097395 | NUM. | REVISION | DATE: | BY: |
| PID: 00105161 | | | | |
| PROJECT: K901283 | | | | |
| SALESPERSON: Z Rutledge | | | | |
| DESIGNED BY: B Nyamaah | | | | |
| CHECKED BY: | 1 | -SUBMITTALS | 3/1/2022 | BEN |
| Fort Worth 4200 N. Sylvania Avenue FORT WORTH, TX 76137 817-838-1300 FILE: Kiewitt Westlake Office_rev1.vsd | PROJECT: Kiewitt Westlake Office TI | | 2050 Roanoke Road WESTLAKE TX 76262 | |
| | | | | DWG 12 OF 41 |



ADDRESS SCHEDULE (2 of 5)

| ITEM | LINK TYPE | LINK | RISER TAG | CONTROLLER/SYSTEM | LOCATION | AREA SERVED | GRP. | NET. | ADD. | WIRELESS SENSOR ADDRESS | IP ADDRESS | SUBNET MASK | GATEWAY | NOTE |
|------|-----------|---------------------|------------------------|-------------------|-----------|-------------|------|------|------|-------------------------|------------|-------------|---------|------|
| 44 | WIRELESS | SC - 1 VIA WCI - 2 | VAV-1 - 19 | VAV BOXES | 1ST FLOOR | | 1 | 1 | 216 | | | | | |
| 45 | WIRELESS | SC - 1 VIA WCI - 2 | VAV-1 - 20 | VAV BOXES | 1ST FLOOR | | 1 | 1 | 217 | | | | | |
| 46 | WIRELESS | SC - 1 VIA WCI - 2 | VAV-1 - 21 | VAV BOXES | 1ST FLOOR | | 1 | 1 | 218 | | | | | |
| 47 | WIRELESS | SC - 2 VIA WCI - 3 | FPB-1 - 6 | FAN POWERED BOXES | 2ND FLOOR | | 2 | 1 | 301 | | | | | |
| 48 | WIRELESS | SC - 2 VIA WCI - 3 | FPB-1 - 9 | FAN POWERED BOXES | 2ND FLOOR | | 2 | 1 | 302 | | | | | |
| 49 | WIRELESS | SC - 2 VIA WCI - 3 | FPB-2 - 1 | FAN POWERED BOXES | 2ND FLOOR | | 2 | 1 | 303 | | | | | |
| 50 | WIRELESS | SC - 2 VIA WCI - 3 | FPB-2 - 2 | FAN POWERED BOXES | 2ND FLOOR | | 2 | 1 | 304 | | | | | |
| 51 | WIRELESS | SC - 2 VIA WCI - 3 | FPB-2 - 4 | FAN POWERED BOXES | 2ND FLOOR | | 2 | 1 | 305 | | | | | |
| 52 | WIRELESS | SC - 2 VIA WCI - 3 | FPB-2 - 5 | FAN POWERED BOXES | 2ND FLOOR | | 2 | 1 | 306 | | | | | |
| 53 | WIRELESS | SC - 2 VIA WCI - 3 | FPB-2 - 14 | FAN POWERED BOXES | 2ND FLOOR | | 2 | 1 | 307 | | | | | |
| 54 | WIRELESS | SC - 2 VIA WCI - 3 | FPB-2 - 15 | FAN POWERED BOXES | 2ND FLOOR | | 2 | 1 | 308 | | | | | |
| 55 | WIRELESS | SC - 2 VIA WCI - 3 | FPB-2 - 16 | FAN POWERED BOXES | 2ND FLOOR | | 2 | 1 | 309 | | | | | |
| 56 | WIRELESS | SC - 2 VIA WCI - 3 | FPB-2 - 22 | FAN POWERED BOXES | 2ND FLOOR | | 2 | 1 | 602 | | | | | |
| 57 | WIRELESS | SC - 2 VIA WCI - 4 | FPB-2 - 3 | FAN POWERED BOXES | 2ND FLOOR | | 2 | 2 | 401 | | | | | |
| 58 | WIRELESS | SC - 2 VIA WCI - 4 | FPB-2 - 6 | FAN POWERED BOXES | 2ND FLOOR | | 2 | 2 | 402 | | | | | |
| 59 | WIRELESS | SC - 2 VIA WCI - 4 | FPB-2 - 8 | FAN POWERED BOXES | 2ND FLOOR | | 2 | 2 | 403 | | | | | |
| 60 | WIRELESS | SC - 2 VIA WCI - 4 | FPB-2 - 9 | FAN POWERED BOXES | 2ND FLOOR | | 2 | 2 | 404 | | | | | |
| 61 | WIRELESS | SC - 2 VIA WCI - 4 | FPB-2 - 17 | FAN POWERED BOXES | 2ND FLOOR | | 2 | 2 | 405 | | | | | |
| 62 | WIRELESS | SC - 2 VIA WCI - 4 | FPB-2 - 20 | FAN POWERED BOXES | 2ND FLOOR | | 2 | 2 | 406 | | | | | |
| 63 | WIRELESS | SC - 2 VIA WCI - 4 | FPB-2 - 21 | FAN POWERED BOXES | 2ND FLOOR | | 2 | 2 | 607 | | | | | |
| 64 | WIRELESS | SC - 2 VIA WCI - 4 | VAV-2 - 6 | VAV BOXES | 2ND FLOOR | | 2 | 2 | 311 | | | | | |
| 65 | WIRELESS | SC - 2 VIA WCI - 4 | VAV-2 - 7 | VAV BOXES | 2ND FLOOR | | 2 | 2 | 312 | | | | | |
| 66 | WIRELESS | SC - 2 VIA WCI - 4 | VAV-2 - 8 | VAV BOXES | 2ND FLOOR | | 2 | 2 | 313 | | | | | |
| 67 | WIRELESS | SC - 2 VIA WCI - 4 | VAV-2 - 9 | VAV BOXES | 2ND FLOOR | | 2 | 2 | 408 | | | | | |
| 68 | WIRELESS | SC - 2 VIA WCI - 4 | VAV-2 - 10 | VAV BOXES | 2ND FLOOR | | 2 | 2 | 314 | | | | | |
| 69 | WIRELESS | SC - 2 VIA WCI - 4 | VAV-2 - 11 | VAV BOXES | 2ND FLOOR | | 2 | 2 | 315 | | | | | |
| 70 | WIRELESS | SC - 2 VIA WCI - 4 | VAV-2 - 13 | VAV BOXES | 2ND FLOOR | | 2 | 2 | 409 | | | | | |
| 71 | WIRELESS | SC - 2 VIA WCI - 4 | VAV-2 - 15 | VAV BOXES | 2ND FLOOR | | 2 | 2 | 441 | | | | | |
| 72 | WIRELESS | SC - 2 VIA WCI - 4 | VAV-2 - 16 | VAV BOXES | 2ND FLOOR | | 2 | 2 | 519 | | | | | |
| 73 | WIRELESS | SC - 2 VIA WCI - 4 | VAV-2 - 17 | VAV BOXES | 2ND FLOOR | | 2 | 2 | 412 | | | | | |
| 74 | WIRELESS | SC - 2 VIA WCI - 4 | VAV-2 - 19 | VAV BOXES | 2ND FLOOR | | 2 | 2 | 414 | | | | | |
| 75 | WIRELESS | SC - 2 VIA WCI - 4 | VAV-2 - 20 | VAV BOXES | 2ND FLOOR | | 2 | 2 | 413 | | | | | |
| 76 | WIRELESS | SC - 2 VIA WCI - 4 | VAV-2 - 21 | VAV BOXES | 2ND FLOOR | | 2 | 2 | 318 | | | | | |
| 77 | WIRELESS | SC - 2 VIA WCI - 4 | VAV-2 - 22 | VAV BOXES | 2ND FLOOR | | 2 | 2 | 319 | | | | | |
| 78 | WIRELESS | SC - 2 VIA WCI - 4 | VAV-2 - 23 | VAV BOXES | 2ND FLOOR | | 2 | 2 | 320 | | | | | |
| 79 | WIRELESS | SC - 2 VIA WCI - 4 | VAV-2 - 24 | VAV BOXES | 2ND FLOOR | | 2 | 2 | 321 | | | | | |
| 80 | WIRELESS | SC - 2 VIA WCI - 4 | VAV-2 - 25 | VAV BOXES | 2ND FLOOR | | 2 | 2 | 322 | | | | | |
| 81 | WIRELESS | SC - 2 VIA WCI - 4 | VAV-2 - 26 | VAV BOXES | 2ND FLOOR | | 2 | 2 | 323 | | | | | |
| 82 | WIRELESS | SC - 2 VIA WCI - 4 | VAV-2 - 27 | VAV BOXES | 2ND FLOOR | | 2 | 2 | 324 | | | | | |
| 83 | WIRELESS | SC - 3 VIA WCI - 11 | FPB - 1 | FPB 1 ~ 22 | | | 3 | 1 | | | | | | |
| 84 | WIRELESS | SC - 3 VIA WCI - 11 | FPB - 1 Sensor WCS - 4 | FPB 1 ~ 22 | | | 3 | 1 | | | | | | |
| 85 | WIRELESS | SC - 3 VIA WCI - 11 | FPB - 2 | FPB 1 ~ 22 | | | 3 | 1 | | | | | | |
| 86 | WIRELESS | SC - 3 VIA WCI - 11 | FPB - 2 Sensor WCS - 4 | FPB 1 ~ 22 | | | 3 | 1 | | | | | | |

| ADDRESS SCHEDULE (2) | | | | |
|---|------|----------|--|--------------|
| CID: | NUM. | REVISION | DATE: | BY: |
| 00097395 | | | | |
| PID: 00105161 | | | | |
| PROJECT: K901283 | | | | |
| SALESPERSON: Z Rutledge | | | | |
| DESIGNED BY: B Nyamaah | | | | |
| CHECKED BY: | | | | |
| Fort Worth 4200 N. Sylvania Avenue FORT WORTH, TX 76137 817-838-1300 FILE: Kiewitt Westlake Office_rev1.vsd | | | | |
| | | | PROJECT: Kiewit Westlake Office TI 2050 Roanoke Road WESTLAKE TX 76262 | |
| | | | | DWG 13 OF 41 |



ADDRESS SCHEDULE (3 of 5)

| ITEM | LINK TYPE | LINK | RISER TAG | CONTROLLER/SYSTEM | LOCATION | AREA SERVED | GRP. | NET. | ADD. | WIRELESS SENSOR ADDRESS | IP ADDRESS | SUBNET MASK | GATEWAY | NOTE |
|------|-----------|---------------------|-------------------------|-------------------|----------|-------------|------|------|------|-------------------------|------------|-------------|---------|------|
| 87 | WIRELESS | SC - 3 VIA WCI - 11 | FPB - 3 | FPB 1 ~ 22 | | | 3 | 1 | | | | | | |
| 88 | WIRELESS | SC - 3 VIA WCI - 11 | FPB - 3 Sensor WCS - 4 | FPB 1 ~ 22 | | | 3 | 1 | | | | | | |
| 89 | WIRELESS | SC - 3 VIA WCI - 11 | FPB - 4 | FPB 1 ~ 22 | | | 3 | 1 | | | | | | |
| 90 | WIRELESS | SC - 3 VIA WCI - 11 | FPB - 4 Sensor WCS - 4 | FPB 1 ~ 22 | | | 3 | 1 | | | | | | |
| 91 | WIRELESS | SC - 3 VIA WCI - 11 | FPB - 5 | FPB 1 ~ 22 | | | 3 | 1 | | | | | | |
| 92 | WIRELESS | SC - 3 VIA WCI - 11 | FPB - 5 Sensor WCS - 4 | FPB 1 ~ 22 | | | 3 | 1 | | | | | | |
| 93 | WIRELESS | SC - 3 VIA WCI - 11 | FPB - 6 | FPB 1 ~ 22 | | | 3 | 1 | | | | | | |
| 94 | WIRELESS | SC - 3 VIA WCI - 11 | FPB - 6 Sensor WCS - 4 | FPB 1 ~ 22 | | | 3 | 1 | | | | | | |
| 95 | WIRELESS | SC - 3 VIA WCI - 11 | FPB - 7 | FPB 1 ~ 22 | | | 3 | 1 | | | | | | |
| 96 | WIRELESS | SC - 3 VIA WCI - 11 | FPB - 7 Sensor WCS - 4 | FPB 1 ~ 22 | | | 3 | 1 | | | | | | |
| 97 | WIRELESS | SC - 3 VIA WCI - 11 | FPB - 8 | FPB 1 ~ 22 | | | 3 | 1 | | | | | | |
| 98 | WIRELESS | SC - 3 VIA WCI - 11 | FPB - 8 Sensor WCS - 4 | FPB 1 ~ 22 | | | 3 | 1 | | | | | | |
| 99 | WIRELESS | SC - 3 VIA WCI - 11 | FPB - 9 | FPB 1 ~ 22 | | | 3 | 1 | | | | | | |
| 100 | WIRELESS | SC - 3 VIA WCI - 11 | FPB - 9 Sensor WCS - 4 | FPB 1 ~ 22 | | | 3 | 1 | | | | | | |
| 101 | WIRELESS | SC - 3 VIA WCI - 11 | FPB - 10 | FPB 1 ~ 22 | | | 3 | 1 | | | | | | |
| 102 | WIRELESS | SC - 3 VIA WCI - 11 | FPB - 10 Sensor WCS - 4 | FPB 1 ~ 22 | | | 3 | 1 | | | | | | |
| 103 | WIRELESS | SC - 3 VIA WCI - 11 | FPB - 11 | FPB 1 ~ 22 | | | 3 | 1 | | | | | | |
| 104 | WIRELESS | SC - 3 VIA WCI - 11 | FPB - 11 Sensor WCS - 4 | FPB 1 ~ 22 | | | 3 | 1 | | | | | | |
| 105 | WIRELESS | SC - 3 VIA WCI - 11 | FPB - 12 | FPB 1 ~ 22 | | | 3 | 1 | | | | | | |
| 106 | WIRELESS | SC - 3 VIA WCI - 11 | FPB - 12 Sensor WCS - 4 | FPB 1 ~ 22 | | | 3 | 1 | | | | | | |
| 107 | WIRELESS | SC - 3 VIA WCI - 11 | FPB - 13 | FPB 1 ~ 22 | | | 3 | 1 | | | | | | |
| 108 | WIRELESS | SC - 3 VIA WCI - 11 | FPB - 13 Sensor WCS - 4 | FPB 1 ~ 22 | | | 3 | 1 | | | | | | |
| 127 | WIRELESS | SC - 3 VIA WCI - 12 | VAV - 1 | VAV 1 ~ 33 | | | 3 | 2 | | | | | | |
| 128 | WIRELESS | SC - 3 VIA WCI - 12 | VAV - 1 Sensor WCS - 6 | VAV 1 ~ 33 | | | 3 | 2 | | | | | | |
| 129 | WIRELESS | SC - 3 VIA WCI - 12 | VAV - 2 | VAV 1 ~ 33 | | | 3 | 2 | | | | | | |

| ADDRESS SCHEDULE (3) | | | | |
|---|------|----------|--|--------------|
| CID: | NUM. | REVISION | DATE: | BY: |
| 00097395 | | | | |
| PID: 00105161 | | | | |
| PROJECT: K901283 | | | | |
| SALESPERSON: Z Rutledge | | | | |
| DESIGNED BY: B Nyamaah | | | | |
| CHECKED BY: | | | | |
| Fort Worth 4200 N. Sylvania Avenue FORT WORTH, TX 76137 817-838-1300 FILE: Kiewitt Westlake Office_rev1.vsd | | | | |
| | | | PROJECT: Kiewit Westlake Office TI 2050 Roanoke Road WESTLAKE TX 76262 | |
| | | | | DWG 14 OF 41 |



ADDRESS SCHEDULE (4 of 5)

| ITEM | LINK TYPE | LINK | RISER TAG | CONTROLLER/SYSTEM | LOCATION | AREA SERVED | GRP. | NET. | ADD. | WIRELESS SENSOR ADDRESS | IP ADDRESS | SUBNET MASK | GATEWAY | NOTE |
|------|-----------|---------------------|-------------------------|-------------------|----------|-------------|------|------|------|-------------------------|------------|-------------|---------|------|
| 130 | WIRELESS | SC - 3 VIA WCI - 12 | VAV - 2 Sensor WCS - 6 | VAV 1 ~ 33 | | | 3 | 2 | | | | | | |
| 131 | WIRELESS | SC - 3 VIA WCI - 12 | VAV - 3 | VAV 1 ~ 33 | | | 3 | 2 | | | | | | |
| 132 | WIRELESS | SC - 3 VIA WCI - 12 | VAV - 3 Sensor WCS - 6 | VAV 1 ~ 33 | | | 3 | 2 | | | | | | |
| 133 | WIRELESS | SC - 3 VIA WCI - 12 | VAV - 4 | VAV 1 ~ 33 | | | 3 | 2 | | | | | | |
| 134 | WIRELESS | SC - 3 VIA WCI - 12 | VAV - 4 Sensor WCS - 6 | VAV 1 ~ 33 | | | 3 | 2 | | | | | | |
| 135 | WIRELESS | SC - 3 VIA WCI - 12 | VAV - 5 | VAV 1 ~ 33 | | | 3 | 2 | | | | | | |
| 136 | WIRELESS | SC - 3 VIA WCI - 12 | VAV - 5 Sensor WCS - 6 | VAV 1 ~ 33 | | | 3 | 2 | | | | | | |
| 137 | WIRELESS | SC - 3 VIA WCI - 12 | VAV - 6 | VAV 1 ~ 33 | | | 3 | 2 | | | | | | |
| 138 | WIRELESS | SC - 3 VIA WCI - 12 | VAV - 6 Sensor WCS - 6 | VAV 1 ~ 33 | | | 3 | 2 | | | | | | |
| 139 | WIRELESS | SC - 3 VIA WCI - 12 | VAV - 7 | VAV 1 ~ 33 | | | 3 | 2 | | | | | | |
| 140 | WIRELESS | SC - 3 VIA WCI - 12 | VAV - 7 Sensor WCS - 6 | VAV 1 ~ 33 | | | 3 | 2 | | | | | | |
| 141 | WIRELESS | SC - 3 VIA WCI - 12 | VAV - 8 | VAV 1 ~ 33 | | | 3 | 2 | | | | | | |
| 142 | WIRELESS | SC - 3 VIA WCI - 12 | VAV - 8 Sensor WCS - 6 | VAV 1 ~ 33 | | | 3 | 2 | | | | | | |
| 143 | WIRELESS | SC - 3 VIA WCI - 12 | VAV - 9 | VAV 1 ~ 33 | | | 3 | 2 | | | | | | |
| 144 | WIRELESS | SC - 3 VIA WCI - 12 | VAV - 9 Sensor WCS - 6 | VAV 1 ~ 33 | | | 3 | 2 | | | | | | |
| 145 | WIRELESS | SC - 3 VIA WCI - 12 | VAV - 10 | VAV 1 ~ 33 | | | 3 | 2 | | | | | | |
| 146 | WIRELESS | SC - 3 VIA WCI - 12 | VAV - 10 Sensor WCS - 6 | VAV 1 ~ 33 | | | 3 | 2 | | | | | | |
| 147 | WIRELESS | SC - 3 VIA WCI - 12 | VAV - 11 | VAV 1 ~ 33 | | | 3 | 2 | | | | | | |
| 148 | WIRELESS | SC - 3 VIA WCI - 12 | VAV - 11 Sensor WCS - 6 | VAV 1 ~ 33 | | | 3 | 2 | | | | | | |
| 149 | WIRELESS | SC - 3 VIA WCI - 12 | VAV - 12 | VAV 1 ~ 33 | | | 3 | 2 | | | | | | |
| 150 | WIRELESS | SC - 3 VIA WCI - 12 | VAV - 12 Sensor WCS - 6 | VAV 1 ~ 33 | | | 3 | 2 | | | | | | |
| 151 | WIRELESS | SC - 3 VIA WCI - 12 | VAV - 13 | VAV 1 ~ 33 | | | 3 | 2 | | | | | | |
| 152 | WIRELESS | SC - 3 VIA WCI - 12 | VAV - 13 Sensor WCS - 6 | VAV 1 ~ 33 | | | 3 | 2 | | | | | | |
| 162 | WIRELESS | SC - 3 VIA WCI - 12 | VAV - 18 Sensor WCS - 6 | VAV 1 ~ 33 | | | 3 | 2 | | | | | | |
| 163 | WIRELESS | SC - 3 VIA WCI - 12 | VAV - 19 | VAV 1 ~ 33 | | | 3 | 2 | | | | | | |
| 164 | WIRELESS | SC - 3 VIA WCI - 12 | VAV - 19 Sensor WCS - 6 | VAV 1 ~ 33 | | | 3 | 2 | | | | | | |
| 165 | WIRELESS | SC - 3 VIA WCI - 12 | VAV - 20 | VAV 1 ~ 33 | | | 3 | 2 | | | | | | |
| 166 | WIRELESS | SC - 3 VIA WCI - 12 | VAV - 20 Sensor WCS - 6 | VAV 1 ~ 33 | | | 3 | 2 | | | | | | |
| 167 | WIRELESS | SC - 3 VIA WCI - 12 | VAV - 21 | VAV 1 ~ 33 | | | 3 | 2 | | | | | | |

| ADDRESS SCHEDULE (4) | | | | |
|---|------|----------|--|--------------|
| CID: | NUM. | REVISION | DATE: | BY: |
| 00097395 | | | | |
| PID: 00105161 | | | | |
| PROJECT: K901283 | | | | |
| SALESPERSON: Z Rutledge | | | | |
| DESIGNED BY: B Nyamaah | | | | |
| CHECKED BY: | | | | |
| Fort Worth 4200 N. Sylvania Avenue FORT WORTH, TX 76137 817-838-1300 FILE: Kiewitt Westlake Office_rev1.vsd | | | | |
| | | | PROJECT: Kiewit Westlake Office TI 2050 Roanoke Road WESTLAKE TX 76262 | |
| | | | | DWG 15 OF 41 |



ADDRESS SCHEDULE (5 of 5)

| ITEM | LINK TYPE | LINK | RISER TAG | CONTROLLER/SYSTEM | LOCATION | AREA SERVED | GRP. | NET. | ADD. | WIRELESS SENSOR ADDRESS | IP ADDRESS | SUBNET MASK | GATEWAY | NOTE |
|------|-----------|---------------------|-------------------------|-------------------|----------|-------------|------|------|------|-------------------------|------------|-------------|---------|------|
| 168 | WIRELESS | SC - 3 VIA WCI - 12 | VAV - 21 Sensor WCS - 6 | VAV 1 ~ 33 | | | 3 | 2 | | | | | | |
| 169 | WIRELESS | SC - 3 VIA WCI - 12 | VAV - 22 | VAV 1 ~ 33 | | | 3 | 2 | | | | | | |
| 170 | WIRELESS | SC - 3 VIA WCI - 12 | VAV - 22 Sensor WCS - 6 | VAV 1 ~ 33 | | | 3 | 2 | | | | | | |
| 171 | WIRELESS | SC - 3 VIA WCI - 12 | VAV - 23 | VAV 1 ~ 33 | | | 3 | 2 | | | | | | |
| 172 | WIRELESS | SC - 3 VIA WCI - 12 | VAV - 23 Sensor WCS - 6 | VAV 1 ~ 33 | | | 3 | 2 | | | | | | |
| 173 | WIRELESS | SC - 3 VIA WCI - 12 | VAV - 24 | VAV 1 ~ 33 | | | 3 | 2 | | | | | | |
| 174 | WIRELESS | SC - 3 VIA WCI - 12 | VAV - 24 Sensor WCS - 6 | VAV 1 ~ 33 | | | 3 | 2 | | | | | | |
| 175 | WIRELESS | SC - 3 VIA WCI - 12 | VAV - 25 | VAV 1 ~ 33 | | | 3 | 2 | | | | | | |
| 176 | WIRELESS | SC - 3 VIA WCI - 12 | VAV - 25 Sensor WCS - 6 | VAV 1 ~ 33 | | | 3 | 2 | | | | | | |
| 177 | WIRELESS | SC - 3 VIA WCI - 12 | VAV - 26 | VAV 1 ~ 33 | | | 3 | 2 | | | | | | |
| 187 | WIRELESS | SC - 3 VIA WCI - 12 | VAV - 31 | VAV 1 ~ 33 | | | 3 | 2 | | | | | | |
| 188 | WIRELESS | SC - 3 VIA WCI - 12 | VAV - 31 Sensor WCS - 6 | VAV 1 ~ 33 | | | 3 | 2 | | | | | | |
| 189 | WIRELESS | SC - 3 VIA WCI - 12 | VAV - 32 | VAV 1 ~ 33 | | | 3 | 2 | | | | | | |
| 190 | WIRELESS | SC - 3 VIA WCI - 12 | VAV - 32 Sensor WCS - 6 | VAV 1 ~ 33 | | | 3 | 2 | | | | | | |
| 191 | WIRELESS | SC - 3 VIA WCI - 12 | VAV - 33 | VAV 1 ~ 33 | | | 3 | 2 | | | | | | |
| 192 | WIRELESS | SC - 3 VIA WCI - 12 | VAV - 33 Sensor WCS - 6 | VAV 1 ~ 33 | | | 3 | 2 | | | | | | |
| 193 | WIRELESS | SC - 3 VIA WCI - 12 | VAVRH | VAVRH | | | 3 | 2 | | | | | | |
| 194 | WIRELESS | SC - 3 VIA WCI - 12 | VAVRH Sensor WCS - 5 | VAVRH | | | 3 | 2 | | | | | | |

| ADDRESS SCHEDULE (5) | | | | |
|---|------|----------|--|--------------|
| CID: 00097395 | NUM. | REVISION | DATE: | BY: |
| PID: 00105161 | | | | |
| PROJECT: K901283 | | | | |
| SALESPERSON: Z Rutledge | | | | |
| DESIGNED BY: B Nyamaah | | | | |
| CHECKED BY: | | | | |
| Fort Worth 4200 N. Sylvania Avenue FORT WORTH, TX 76137 817-838-1300 FILE: Kiewitt Westlake Office_rev1.vsd | | | | |
| | | | PROJECT: Kiewit Westlake Office TI 2050 Roanoke Road WESTLAKE TX 76262 | |
| | | | | DWG 16 OF 41 |




| ENCLOSURE SCHEDULE | | | | | | | |
|-------------------------|----------|--------|-------------|---|----------|------------|-------------------|
| TAG | LOCATION | VENDOR | PART NUMBER | DESCRIPTION | DIN RAIL | CONTROLLER | SYSTEM CONTROLLED |
| ENC - 1 (SC+ ENCLOSURE) | TBD | KELE | HC1612P | 16 X 12 X 6 NEMA 1 HINGED COVER ENCLOSURE W/ PERF PANEL | SINGLE | | |

| ENCLOSURE SCHEDULE | | | | |
|---|--|-------------|----------|-----|
| CID: | NUM. | REVISION | DATE: | BY: |
| 00097395 | | | | |
| PID: 00105161 | | | | |
| PROJECT: K901283 | | | | |
| SALESPERSON: Z Rutledge | | | | |
| DESIGNED BY: B Nyamaah | | | | |
| CHECKED BY: | 1 | -SUBMITTALS | 3/1/2022 | BEN |
| Fort Worth 4200 N. Sylvania Avenue FORT WORTH, TX 76137 817-838-1300 | PROJECT: Kiewit Westlake Office TI 2050 Roanoke Road WESTLAKE TX 76262 | | | |
| FILE: Kiewitt Westlake Office_rev1.vsd | DWG 17 OF 41 | | | |



ENC - 1 (SC+ ENCLOSURE) - TBD

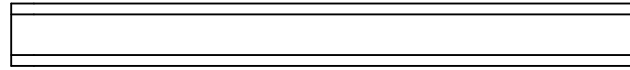


DIN
18

| ENCLOSURE GRAPHICS | | | | |
|---|------------------------------------|-------------|--|--------------|
| CID: | NUM. | REVISION | DATE: | BY: |
| 00097395 | | | | |
| PID: 00105161 | | | | |
| PROJECT: K901283 | | | | |
| SALESPERSON: Z Rutledge | | | | |
| DESIGNED BY: B Nyamaah | | | | |
| CHECKED BY: | 1 | -SUBMITTALS | 3/1/2022 | BEN |
| Fort Worth 4200 N. Sylvania Avenue FORT WORTH, TX 76137 817-838-1300 | PROJECT: Kiewit Westlake Office TI | | 2050 Roanoke Road WESTLAKE TX 76262 | |
| FILE: Kiewitt Westlake Office_rev1.vsd | | | | DWG 18 OF 41 |



(FIRST FLOOR)

| BILL OF MATERIAL | | | | |
|------------------|-----|--------|---------|-------------|
| TAG | QTY | VENDOR | PART NO | DESCRIPTION |

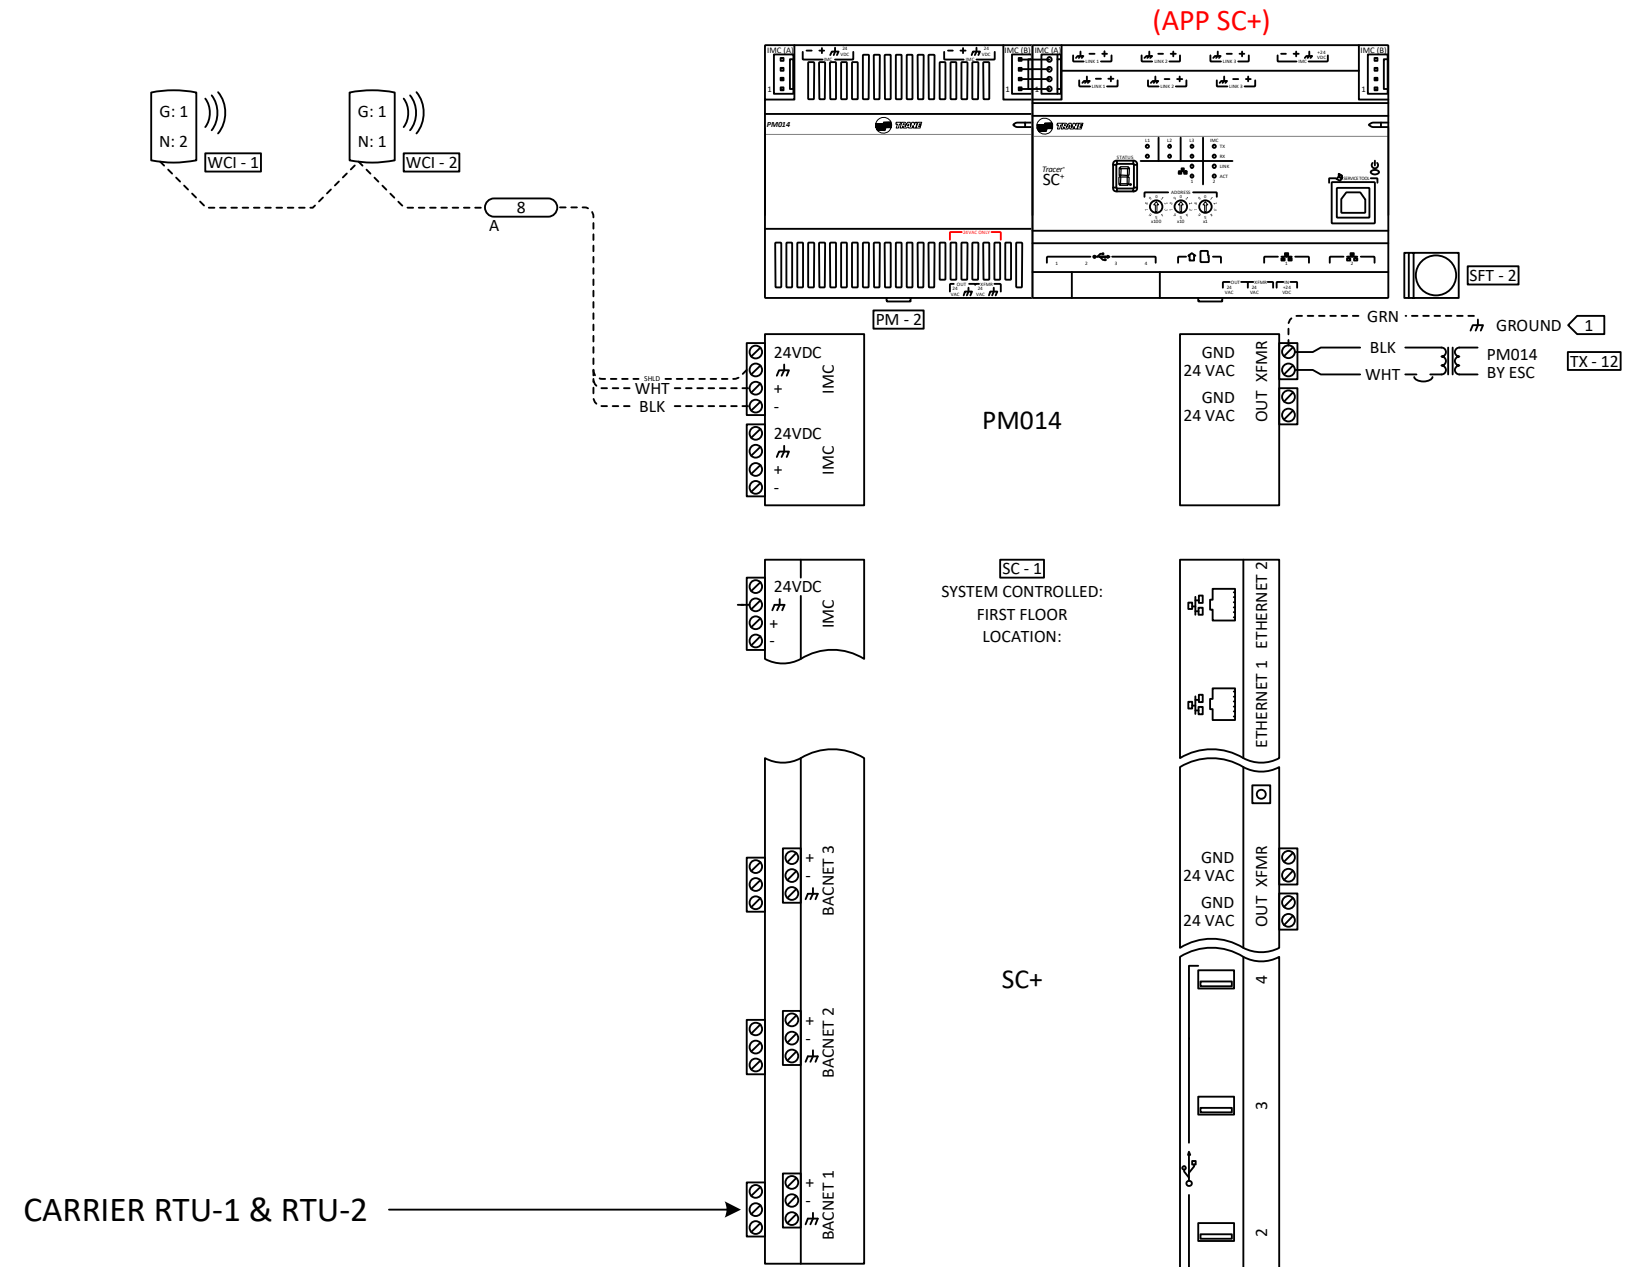

- 5 TO BE COMPLETED DURING INSTALLATION AND INCLUDED IN RECORD DRAWINGS.
- 4 REMOTE ACCESS REQUIRED FOR TIS IN WARRANTY SERVICE AGREEMENT.
- 3 FOR THE CUSTOMER TO REMOTELY CONNECT TO THE SC, A SECURE NETWORK BEHIND A FIREWALL AND VPN ACCESS IS REQUIRED.
- 2 CUSTOMER TO SUPPLY NETWORK COMM ACCESS POINT.
- 1 DEVICE MUST BE GROUNDED WITH FACTORY PROVIDED GROUND WIRE AS DETAILED IN THE DEVICE INSTALLATION LITERATURE.


| FIRST FLOOR (SC-1) - CONTROLLER | | | | |
|---|------|---|----------|-----|
| CID: | NUM. | REVISION | DATE: | BY: |
| 00097395 | | | | |
| PID: 00105161 | | | | |
| PROJECT: K901283 | | | | |
| SALESPERSON: Z Rutledge | | | | |
| DESIGNED BY: B Nyamaah | | | | |
| CHECKED BY: | 1 | -SUBMITTALS | 3/1/2022 | BEN |
| Fort Worth 4200 N. Sylvania Avenue FORT WORTH, TX 76137 817-838-1300 FILE: Kiewitt Westlake Office_rev1.vsd | | PROJECT: Kiewitt Westlake Office TI 2050 Roanoke Road WESTLAKE TX 76262 | | |



(BUILDING)

| BILL OF MATERIAL | | | | |
|------------------|-----|--------|---------|-------------|
| TAG | QTY | VENDOR | PART NO | DESCRIPTION |

(BASE SC+)

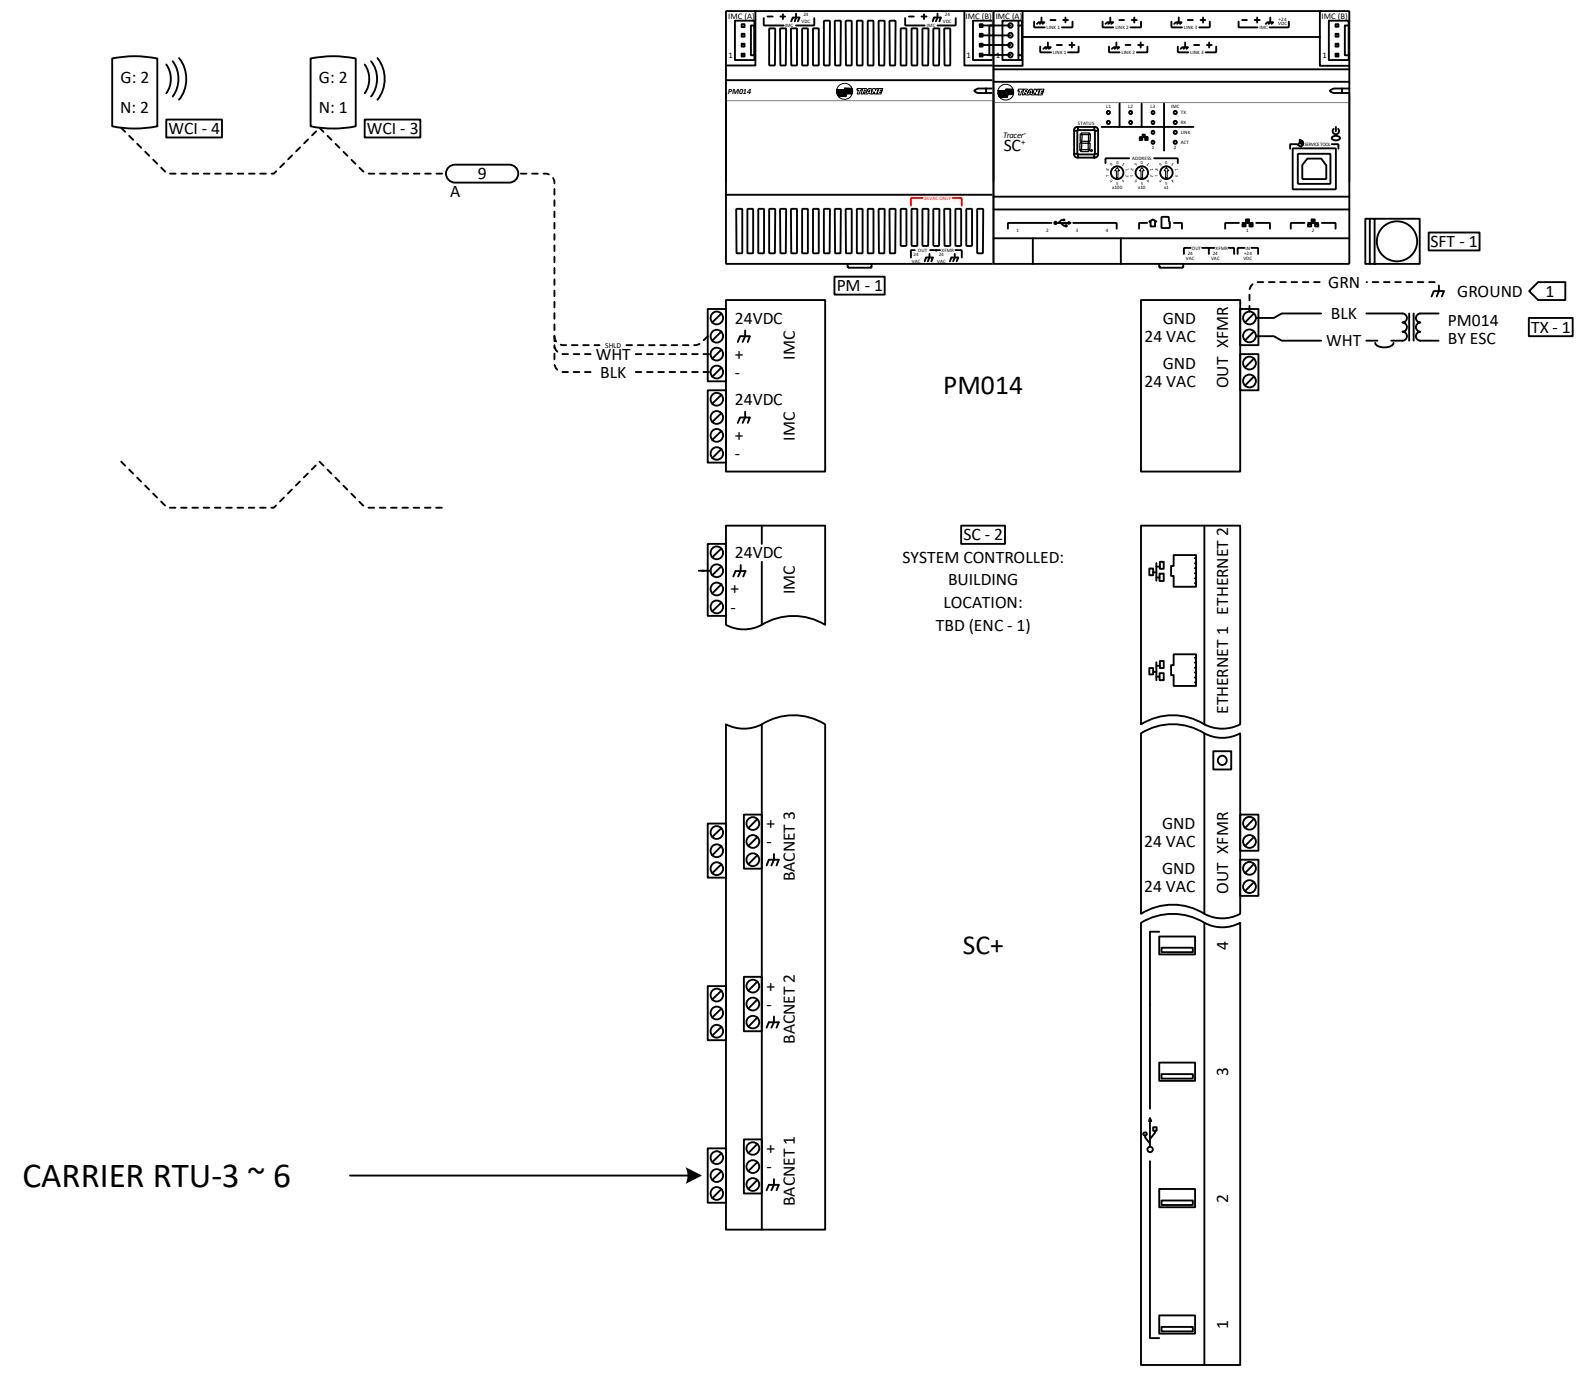

SC-2
SYSTEM CONTROLLED:
BUILDING
LOCATION:
TBD (ENC - 1)

CARRIER RTU-3 ~ 6

- 5 TO BE COMPLETED DURING INSTALLATION AND INCLUDED IN RECORD DRAWINGS.
- 4 REMOTE ACCESS REQUIRED FOR TIS IN WARRANTY SERVICE AGREEMENT.
- 3 FOR THE CUSTOMER TO REMOTELY CONNECT TO THE SC, A SECURE NETWORK BEHIND A FIREWALL AND VPN ACCESS IS REQUIRED.
- 2 CUSTOMER TO SUPPLY NETWORK COMM ACCESS POINT.
- 1 DEVICE MUST BE GROUNDED WITH FACTORY PROVIDED GROUND WIRE AS DETAILED IN THE DEVICE INSTALLATION LITERATURE.

| SECOND FLOOR (SC-2) - CONTROLLER | | | | |
|---|------|--|----------|--------------|
| CID: | NUM. | REVISION | DATE: | BY: |
| 00097395 | | | | |
| PID: 00105161 | | | | |
| PROJECT: K901283 | | | | |
| SALESPERSON: Z Rutledge | | | | |
| DESIGNED BY: B Nyamaah | | | | |
| CHECKED BY: | 1 | -SUBMITTALS | 3/1/2022 | BEN |
| Fort Worth 4200 N. Sylvania Avenue FORT WORTH, TX 76137 817-838-1300 | | PROJECT: Kiewit Westlake Office TI 2050 Roanoke Road WESTLAKE TX 76262 | | |
| FILE: Kiewitt Westlake Office_rev1.vsd | | | | DWG 20 OF 41 |




DRAG A SHAPE FROM THE 'BUILDING CONTROLLER SEQUENCE SHAPES' STENCIL HERE

| CARRIER INTERGRATION PC - 1 SEQUENCE | | | | |
|---|--|-------------|----------|--------------|
| CID: 00097395 | NUM. | REVISION | DATE: | BY: |
| PID: 00105161 | | | | |
| PROJECT: K901283 | | | | |
| SALESPERSON: Z Rutledge | | | | |
| DESIGNED BY: B Nyamaah | | | | |
| CHECKED BY: | 1 | -SUBMITTALS | 3/1/2022 | BEN |
| Fort Worth 4200 N. Sylvania Avenue FORT WORTH, TX 76137 817-838-1300 | PROJECT: Kiewit Westlake Office TI 2050 Roanoke Road WESTLAKE TX 76262 | | | |
| FILE: Kiewitt Westlake Office_rev1.vsd | | | | DWG 21 OF 41 |



(CARRIER INTERGRATION)

| BILL OF MATERIAL | | | | |
|------------------|-----|--------|---------|-------------|
| TAG | QTY | VENDOR | PART NO | DESCRIPTION |

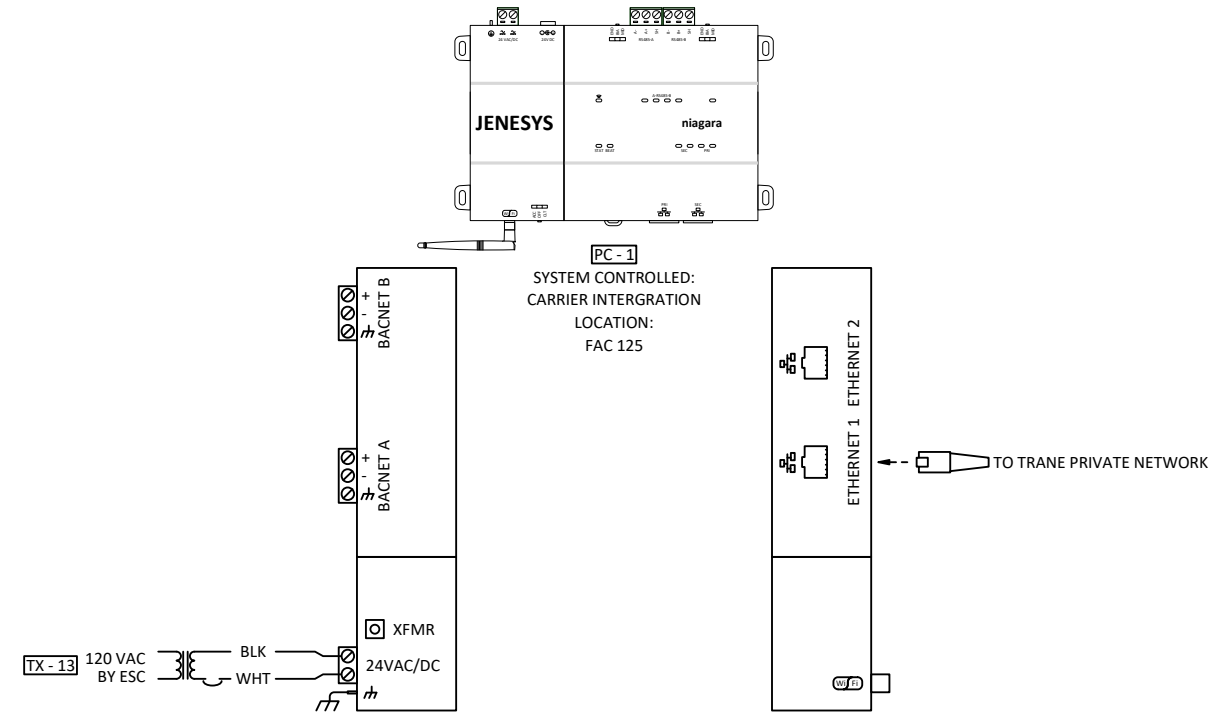


| CARRIER INTERGRATION PC - 1 CONTROLLER | | | | |
|---|--|-------------|----------|--------------|
| CID: 00097395 | NUM. | REVISION | DATE: | BY: |
| PID: 00105161 | | | | |
| PROJECT: K901283 | | | | |
| SALESPERSON: Z Rutledge | | | | |
| DESIGNED BY: B Nyamaah | | | | |
| CHECKED BY: | 1 | -SUBMITTALS | 3/1/2022 | BEN |
| Fort Worth 4200 N. Sylvania Avenue FORT WORTH, TX 76137 817-838-1300 | PROJECT: Kiewit Westlake Office TI 2050 Roanoke Road WESTLAKE TX 76262 | | | |
| FILE: Kiewitt Westlake Office_rev1.vsd | | | | DWG 22 OF 41 |




(ELEC SC 2ND FL AREA B)


| BILL OF MATERIAL | | | | |
|--------------------|-----|--------|--------------|--|
| TAG | QTY | VENDOR | PART NO | DESCRIPTION |
| WCI - 11, WCI - 12 | 2 | TRANE | X13790901030 | AIR-FI WIRELESS COMM INTERFACE, INDOOR MOUNTING, FIELD |

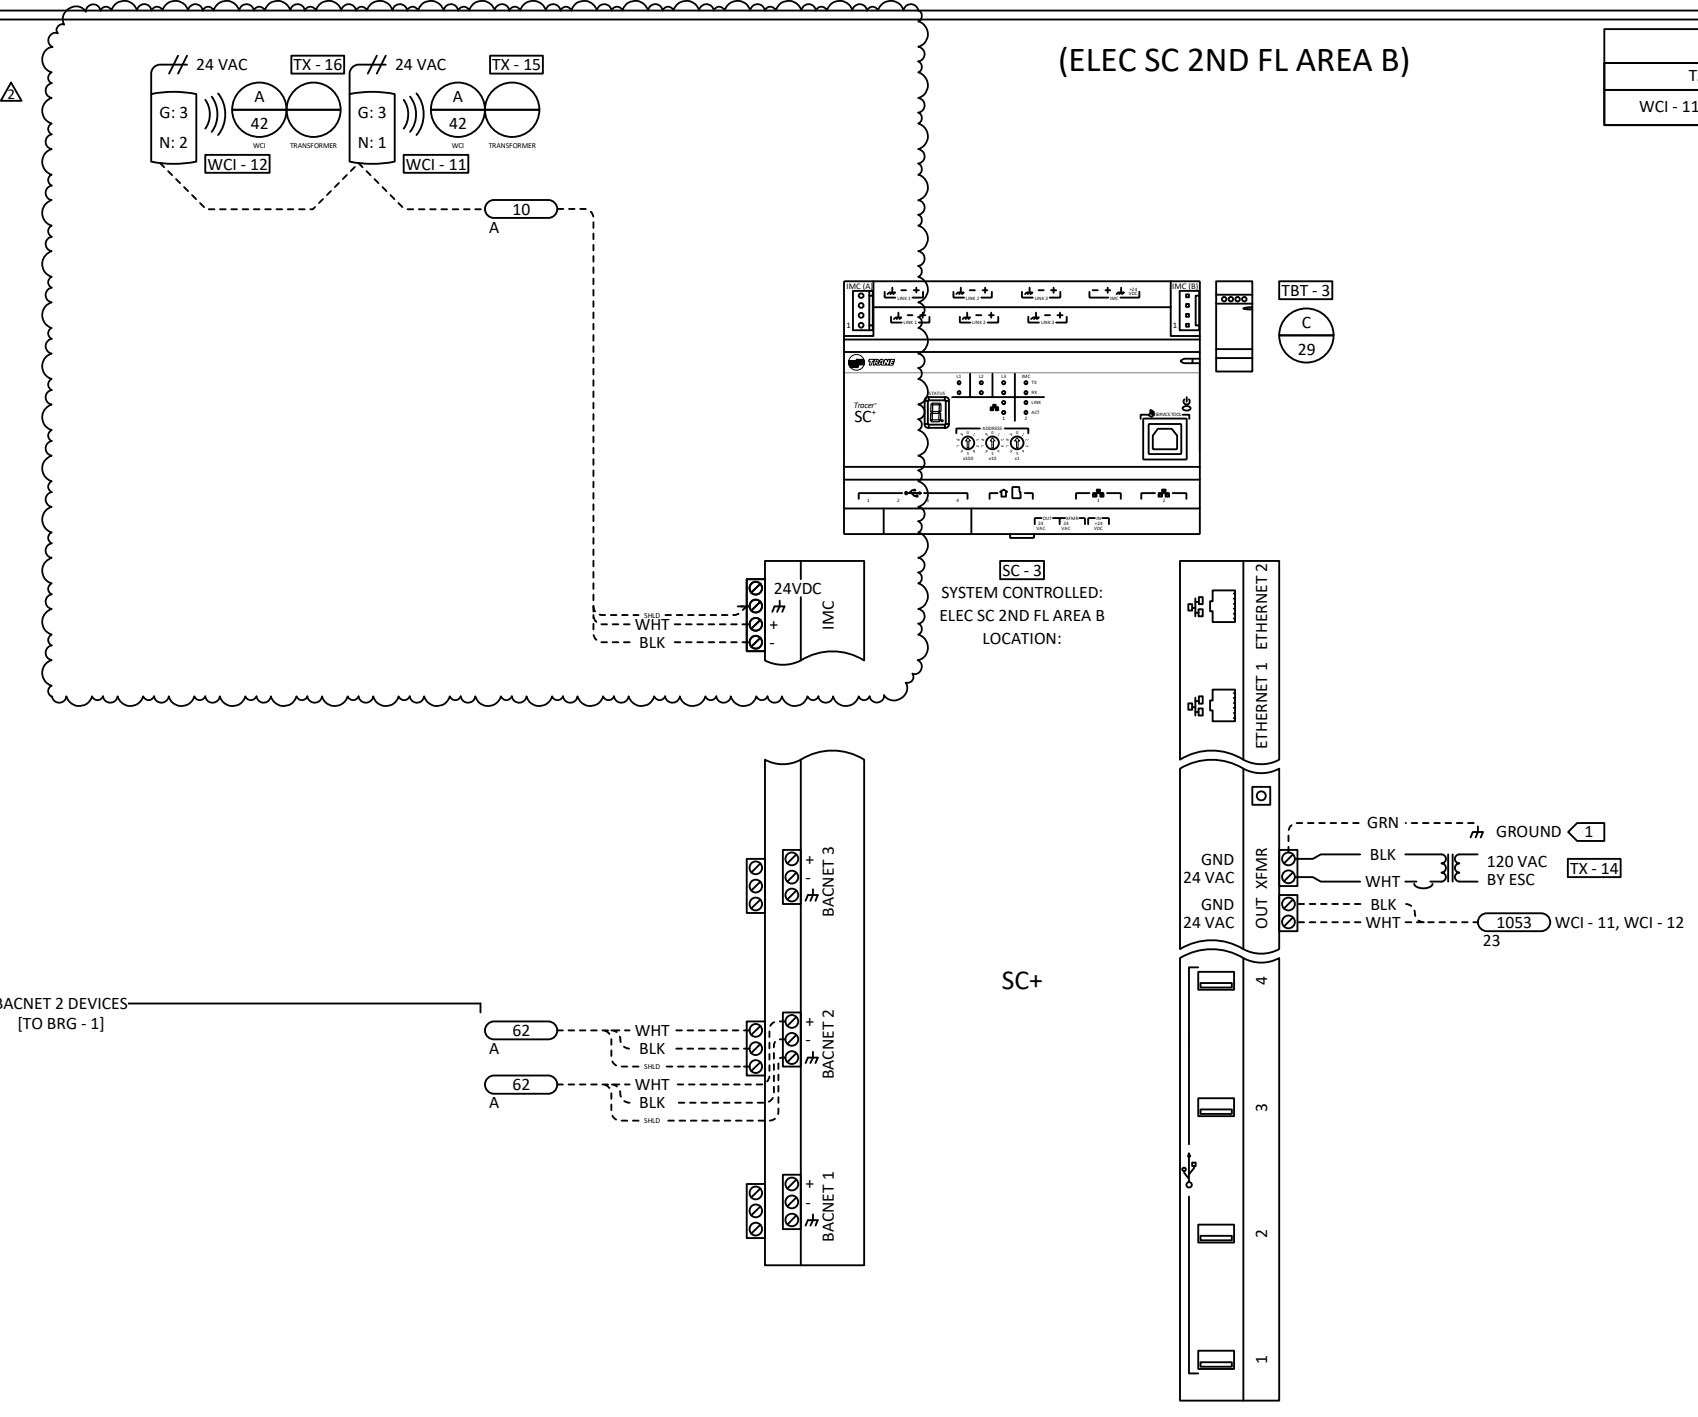

BACNET 2 DEVICES
[TO BRG - 1]

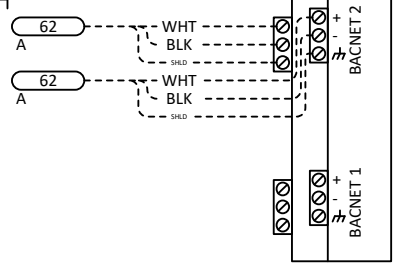

SC+

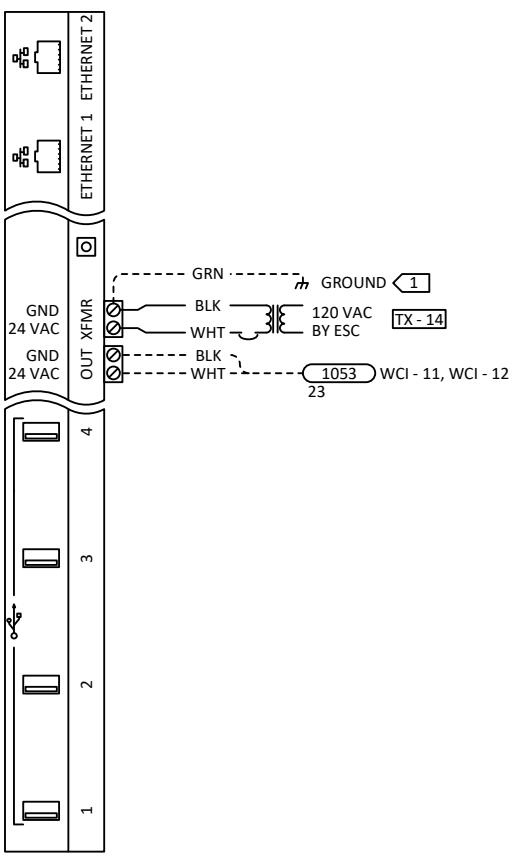


- 5 TO BE COMPLETED DURING INSTALLATION AND INCLUDED IN RECORD DRAWINGS.
- 4 REMOTE ACCESS REQUIRED FOR TIS IN WARRANTY SERVICE AGREEMENT.
- 3 FOR THE CUSTOMER TO REMOTELY CONNECT TO THE SC, A SECURE NETWORK BEHIND A FIREWALL AND VPN ACCESS IS REQUIRED.
- 2 CUSTOMER TO SUPPLY NETWORK COMM ACCESS POINT.
- 1 DEVICE MUST BE GROUNDED WITH FACTORY PROVIDED GROUND WIRE AS DETAILED IN THE DEVICE INSTALLATION LITERATURE.

| ELEC SC 2ND FL B SC - 3 CONTROLLER | | | | |
|---|------|----------|--|--------------|
| CID: | NUM. | REVISION | DATE: | BY: |
| 00097395 | | | | |
| PID: 00105161 | | | | |
| PROJECT: K901283 | | | | |
| SALESPERSON: Z Rutledge | | | | |
| DESIGNED BY: B Nyamaah | | | | |
| CHECKED BY: | | | | |
| Fort Worth 4200 N. Sylvania Avenue FORT WORTH, TX 76137 817-838-1300 | | | | |
| | | | PROJECT: Kiewit Westlake Office TI 2050 Roanoke Road WESTLAKE TX 76262 | |
| FILE: Kiewitt Westlake Office_rev1.vsd | | | | DWG 23 OF 41 |




TYPICAL FOR 35
(FAN POWERED BOXES) ◁1

| BILL OF MATERIAL | | | | |
|------------------|-----|--------|---------|-------------|
| TAG | QTY | VENDOR | PART NO | DESCRIPTION |

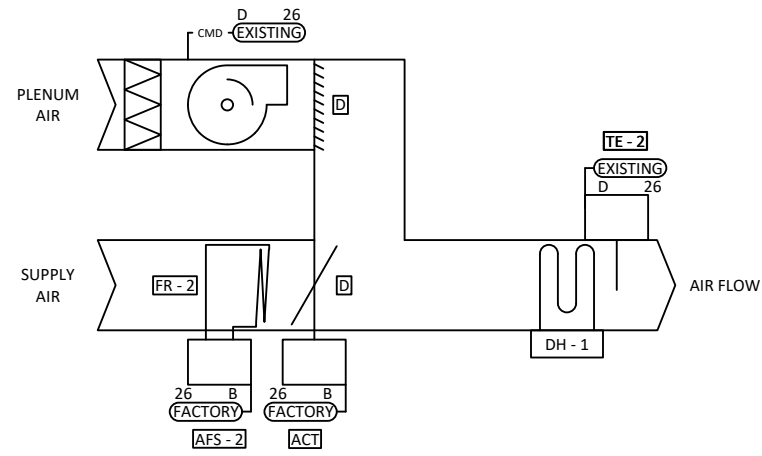

SPACE TEMPERATURE SENSOR

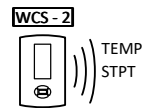

◁1 8 FAN POWERED BOXES WILL BE NEW SUPPLIED BY FACTORY. (27) EXISTING FAN POWERED BOXES WILL REQUIRE NEW CONTROLLER AND WCI. SEE FLOORPLAN FOR REFERENCE.

| FAN POWERED BOXES - FLOW | | | | |
|---|--|-------------|----------|--------------|
| CID: | NUM. | REVISION | DATE: | BY: |
| 00097395 | | | | |
| PID: 00105161 | | | | |
| PROJECT: K901283 | | | | |
| SALESPERSON: Z Rutledge | | | | |
| DESIGNED BY: B Nyamaah | | | | |
| CHECKED BY: | 1 | -SUBMITTALS | 3/1/2022 | BEN |
| Fort Worth 4200 N. Sylvania Avenue FORT WORTH, TX 76137 817-838-1300 FILE: Kiewitt Westlake Office_rev1.vsd | PROJECT: Kiewit Westlake Office TI 2050 Roanoke Road WESTLAKE TX 76262 | | | |
| | | | | DWG 24 OF 41 |



**Kiewit Westlake Office TI, 2050 Roanoke Road, WESTLAKE, TX
FAN POWERED BOXES S210 - 2**

Sequence of Operations
FAN POWERED BOXES Flow

Building Automation System Interface:

The Building Automation System (BAS) will send the controller Occupied and Unoccupied commands. The BAS may also send a Heat/Cool mode, priority shutdown commands, space temperature and/or space temperature setpoint. If communication is lost with the BAS, the VAV controller will operate using its local setpoints.

Occupied Mode:

The occupancy mode will be communicated or hardwired to the controller via a binary input. When the unit is in the occupied mode the VAV will maintain the space temperature at the active occupied heating or cooling setpoint. Applicable ventilation and airflow setpoints will be enforced. The occupied mode will be the default mode of the VAV.

Unoccupied:

Normal operating mode for unoccupied spaces or nighttime operation. When the unit is in unoccupied mode the VAV controller will maintain the space temperature at the stored unoccupied heating or cooling setpoint regardless of the presence of a hardwired or communicated setpoint. When in the Unoccupied Mode, the controller will disable the electric heat, and close the ventilation air damper, unless unoccupied cooling or heating is needed. When the space temperature is between the active unoccupied setpoint the VAV will modulate fully closed, and the fan will turn off.

Heat/Cool Mode:

The Heat/Cool mode will be set by a communicated value or automatically by the VAV controller. In standalone or auto mode the VAV controller will compare the primary air temperature with the configured auto changeover setpoint to determine if the air is "hot" or "cold". Heating mode implies the primary air temperature is hot. Cooling mode implies the primary air temperature is cold.

Heat/Cool Setpoint:

The space temperature setpoint will be determined either by a local (e.g., thumbwheel) setpoint, the VAV default setpoint or a communicated value. The VAV will use the locally stored default setpoints when neither a local setpoint nor communicated setpoint is present. If both a local setpoint and communicated setpoint exist, the VAV will use the communicated value.

Cooling Mode:

When the unit is in cooling mode, the VAV controller will maintain the space temperature at the active cooling setpoint by simultaneously modulating both the VAV damper (between the active cooling minimum and maximum airflow setpoints) and the fan (between the minimum and maximum fan airflow setpoints). Based on the VAV controller occupancy mode, the active cooling setpoint will be one of the following:

| Setpoint | Default Value |
|---------------------------------------|------------------|
| Occupied Cooling Setpoint | 74.0 deg. F |
| Unoccupied Cooling Setpoint | 85.0 deg. F |
| Occupied Standby Cooling Setpoint | 78.0 deg. F |
| Occupied Min Cooling Airflow Setpoint | See VAV Schedule |
| Occupied Max Cooling Airflow Setpoint | See VAV Schedule |
| Min Fan Airflow Setpoint | See VAV Schedule |
| Max Fan Airflow Setpoint | See VAV Schedule |

The VAV controller will use the measured space temperature and the active cooling setpoint to determine the requested cooling capacity of the unit. The outputs will be controlled based on the unit configuration and the requested cooling capacity.

Heating Mode:

When the unit is in heating mode, the VAV controller will maintain the space temperature at the active heating setpoint by simultaneously modulating both the VAV damper (between the active heating minimum and maximum airflow setpoints) and the fan (between the minimum and maximum fan airflow setpoints). Based on the VAV controller occupancy mode, the active heating setpoint will be one of the following:

| Setpoint | Default Value |
|---------------------------------------|------------------|
| Occupied Heating Setpoint | 71.0 deg. F |
| Unoccupied Heating Setpoint | 60.0 deg. F |
| Occupied Standby Heating Setpoint | 67.0 deg. F |
| Occupied Min Heating Airflow Setpoint | See VAV Schedule |
| Occupied Max Heating Airflow Setpoint | See VAV Schedule |
| Min Fan Airflow Setpoint | See VAV Schedule |
| Max Fan Airflow Setpoint | See VAV Schedule |

Intermittent Fan Control:

During all occupied modes, when the unit is in cooling mode, as the space temperature falls below the active cooling setpoint, the VAV damper will modulate to its minimum cooling airflow setpoint. The terminal fan and heat will cycle as needed to maintain a reduced space temperature. If the discharge air temperature reaches the design heating discharge air temperature setpoint of 90.0 deg. F (adj.), the VAV controller will modulate the fan between the minimum and maximum fan airflow setpoints to maintain space temperature at the active heating setpoint and modulate the electric heater to maintain discharge air temperature at the design heating discharge air temperature setpoint. If the fan reaches the maximum fan airflow setpoint, the VAV controller will modulate the electric heater to maintain space temperature at the active heating setpoint while the fan continues to operate at the maximum fan airflow setpoint. During the unoccupied mode, the VAV damper will modulate fully closed.

During reheat the VAV damper, fan, and electric heat will operate as follows:

Silicon Controlled Rectifier (SCR):

The VAV controller will operate the fan at the minimum fan airflow setpoint and modulate the SCR electric heater to maintain space temperature at the active heating setpoint. If the discharge air temperature reaches the design heating discharge air temperature setpoint of 90.0 deg. F (adj.), the VAV controller will modulate the fan between the minimum and maximum fan airflow setpoints to maintain space temperature at the active heating setpoint and modulate the SCR electric heater to maintain discharge air temperature at the design heating discharge air temperature setpoint. If the fan reaches the maximum fan airflow setpoint, the VAV controller will modulate the SCR electric heater to maintain space temperature at the active heating setpoint while the fan continues to operate at the maximum fan airflow setpoint.

When the unit is in occupied mode, the ventilation airflow setpoint will equal the design outdoor airflow (see VAV schedule).

The current ventilation airflow setpoint will be communicated to the BAS for control of the system outdoor-air intake.

Space Sensor Failure:

If there is a fault with the operation of the zone sensor an alarm will be annunciated at the BAS. Space sensor failure will cause the VAV controller to drive the VAV damper to minimum air flow setpoint. If the VAV is in the occupied mode, or drive it closed if the VAV is in the unoccupied mode. The parallel fan will be disabled along with the reheat.




| FAN POWERED BOXES - SEQUENCE | | | | |
|---|--|-------------|----------|-----|
| CID: 00097395 | NUM. | REVISION | DATE: | BY: |
| PID: 00105161 | | | | |
| PROJECT: K901283 | | | | |
| SALESPERSON: Z Rutledge | | | | |
| DESIGNED BY: B Nyamaah | | | | |
| CHECKED BY: | 1 | -SUBMITTALS | 3/1/2022 | BEN |
| Fort Worth 4200 N. Sylvania Avenue FORT WORTH, TX 76137 817-838-1300 | PROJECT: Kiewit Westlake Office TI 2050 Roanoke Road WESTLAKE TX 76262 | | | |
| FILE: Kiewitt Westlake Office_rev1.vsd | DWG 25 OF 41 | | | |

TYPICAL FOR 35
(FAN POWERED BOXES) (2)

| BILL OF MATERIAL | | | | |
|------------------|-----|--------|---------|-------------|
| TAG | QTY | VENDOR | PART NO | DESCRIPTION |

AREA OF WORK WILL ONLY CONSIST 35 BOXES ONLY PER SCOPE

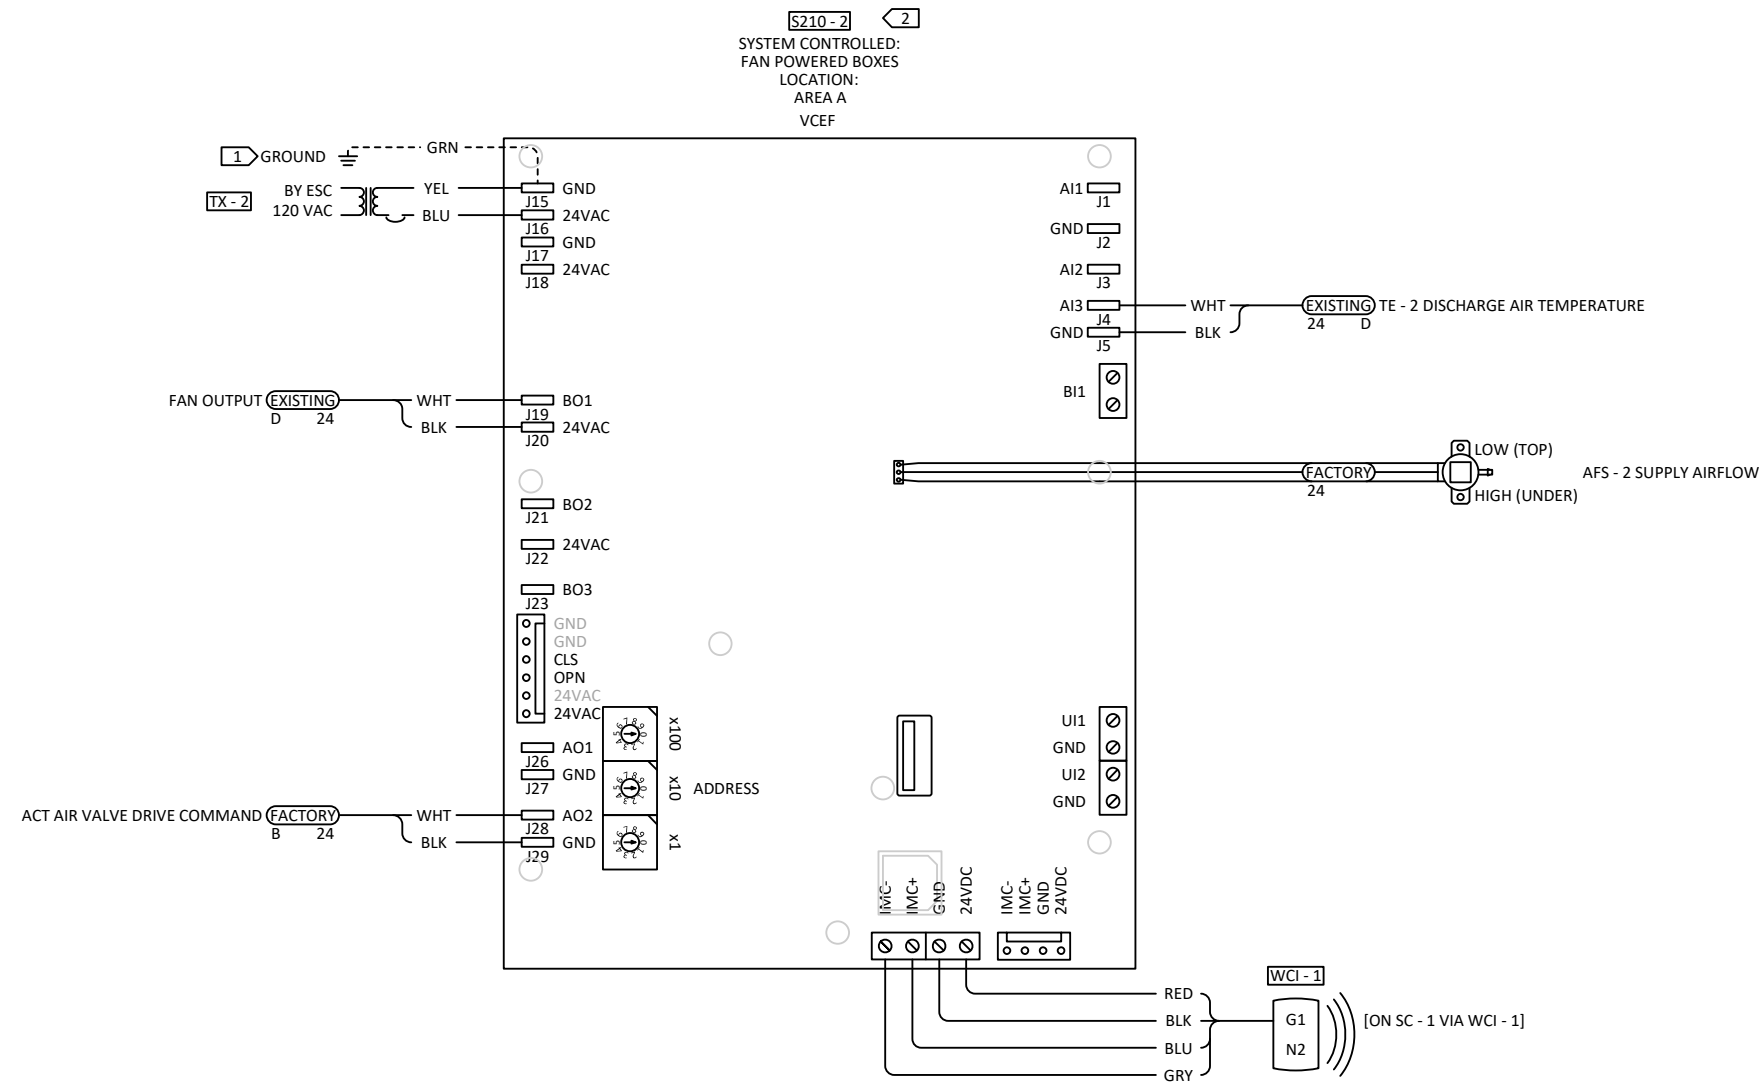

- (2) 8 FAN POWERED BOXES WILL BE NEW SUPPLIED BY FACTORY. (27) EXISTING FAN POWERED BOXES WILL REQUIRE NEW CONTROLLER AND WCI. SEE FLOORPLAN FOR REFERENCE.
- (1) DEVICE MUST BE GROUNDED WITH FACTORY PROVIDED GROUND WIRE AS DETAILED IN THE DEVICE INSTALLATION LITERATURE.


| FAN POWERED BOXES - S210 CONTROLLER | | | | |
|---|------|---|----------|-----|
| CID: | NUM. | REVISION | DATE: | BY: |
| 00097395 | | | | |
| PID: 00105161 | | | | |
| PROJECT: K901283 | | | | |
| SALESPERSON: Z Rutledge | | | | |
| DESIGNED BY: B Nyamaah | | | | |
| CHECKED BY: | 1 | -SUBMITTALS | 3/1/2022 | BEN |
| Fort Worth 4200 N. Sylvania Avenue FORT WORTH, TX 76137 817-838-1300 FILE: Kiewitt Westlake Office_rev1.vsd | | PROJECT: Kiewitt Westlake Office TI 2050 Roanoke Road WESTLAKE TX 76262 | | |




AREA OF WORK WILL ONLY CONSIST 40 BOXES ONLY PER SCOPE

TYPICAL FOR 36
(VAV BOXES) ◁1

| BILL OF MATERIAL | | | | |
|------------------|-----|--------|---------|-------------|
| TAG | QTY | VENDOR | PART NO | DESCRIPTION |

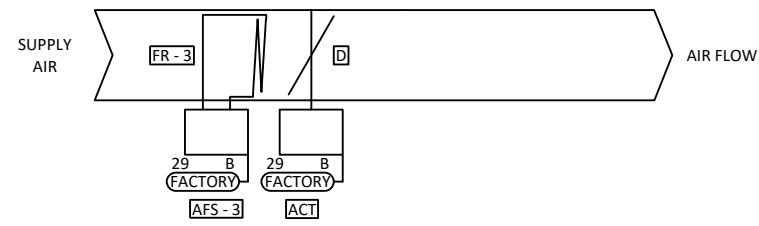

SPACE TEMPERATURE SENSOR

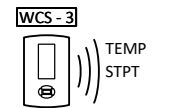

◁1 13 VAV BOXES WILL BE NEW SUPPLIED BY FACTORY. (27) EXISTING VAV BOXES WILL REQUIRE NEW CONTROLLER AND WCI. SEE FLOORPLAN FOR REFERENCE.

| VAV BOXES - FLOW | | | | |
|---|---|-------------|----------|--------------|
| CID: | NUM. | REVISION | DATE: | BY: |
| 00097395 | | | | |
| PID: 00105161 | | | | |
| PROJECT: K901283 | | | | |
| SALESPERSON: Z Rutledge | | | | |
| DESIGNED BY: B Nyamaah | | | | |
| CHECKED BY: | 1 | -SUBMITTALS | 3/1/2022 | BEN |
| Fort Worth 4200 N. Sylvania Avenue FORT WORTH, TX 76137 817-838-1300 FILE: Kiewitt Westlake Office_rev1.vsd | PROJECT: Kiewitt Westlake Office TI 2050 Roanoke Road WESTLAKE TX 76262 | | | |
| | | | | DWG 27 OF 41 |



Kiewit Westlake Office TI, 2050 Roanoke Road, WESTLAKE, TX

VAV BOXES S210 - 3

Sequence of Operations

VAV BOXES Flow

Building Automation System Interface:

The Building Automation System (BAS) will send the controller Occupied and Unoccupied commands. The BAS may also send a Heat/Cool mode, priority shutdown commands, space temperature and/or space temperature setpoint. If communication is lost with the BAS, the VAV controller will operate using its local setpoints.

Occupied Mode:

The occupancy mode will be communicated or hardwired to the controller via a binary input. When the unit is in the occupied mode the VAV will maintain the space temperature at the active occupied heating or cooling setpoint. Applicable ventilation and airflow setpoints will be enforced. The occupied mode will be the default mode of the VAV.

Unoccupied:

Normal operating mode for unoccupied spaces or nighttime operation. **Unoccupied:**

When in the Unoccupied Mode, the controller will close the air damper, unless unoccupied cooling or ventilation is required. When the unit is in unoccupied mode the VAV controller will maintain the space temperature at the stored unoccupied heating or cooling setpoint regardless of the presence of a hardwired or communicated setpoint. If the zone temperature rises above its Unoccupied Cooling Setpoint, the controller will modulate the air damper, until the zone temperature drops back to 2.0 deg. F below the Unoccupied Cooling Setpoint.

Heat/Cool Mode:

The Heat/Cool mode will be set by a communicated value or automatically by the VAV controller. In standalone or auto mode the VAV controller will compare the primary air temperature with the configured auto changeover setpoint to determine if the air is "hot" or "cold". Heating mode implies the primary air temperature is hot. Cooling mode implies the primary air temperature is cold.

Heat/Cool Setpoint:

The space temperature setpoint will be determined either by a local (e.g., thumbwheel) setpoint, the VAV default setpoint or a communicated value. The VAV will use the locally stored default setpoints when neither a local setpoint nor communicated setpoint is present. If both a local setpoint and communicated setpoint exist, the VAV will use the communicated value.

Cooling Mode:

When the unit is in cooling mode, the VAV controller will maintain the space temperature at the active cooling setpoint by modulating the VAV damper (between the active cooling minimum and maximum airflow setpoints). The outputs will be controlled based on the unit configuration and the requested cooling capacity.

Heating Mode:

When the unit is in heating mode, the VAV controller will maintain the space temperature at the active heating setpoint by modulating the VAV damper (between the active heating minimum and maximum airflow setpoints). Based on the VAV controller occupancy mode, the active heating setpoint will be one of the following:

| Setpoint | Default Value |
|---------------------------------------|------------------|
| Occupied Heating Setpoint | 71.0 deg. F |
| Unoccupied Heating Setpoint | 60.0 deg. F |
| Occupied Standby Heating Setpoint | 67.0 deg. F |
| Occupied Min Heating Airflow Setpoint | See VAV Schedule |
| Occupied Max Heating Airflow Setpoint | See VAV Schedule |

When the unit is in occupied mode, the ventilation airflow setpoint will equal the design outdoor airflow (see VAV schedule).

The current ventilation airflow setpoint will be communicated to the BAS for control of the system outdoor-air intake.

Space Sensor Failure:

If there is a fault with the operation of the zone sensor an alarm will be annunciated at the BAS. Space sensor failure will cause the VAV to drive the damper to minimum air flow if the VAV is in the occupied mode, or drive it closed if the VAV is in the unoccupied mode.


| VAV BOXES - SEQUENCE | | | | |
|---|------------------------------------|-------------|--|--------------|
| CID: | NUM. | REVISION | DATE: | BY: |
| 00097395 | | | | |
| PID: 00105161 | | | | |
| PROJECT: K901283 | | | | |
| SALESPERSON: Z Rutledge | | | | |
| DESIGNED BY: B Nyamaah | | | | |
| CHECKED BY: | 1 | -SUBMITTALS | 3/1/2022 | BEN |
| Fort Worth 4200 N. Sylvania Avenue FORT WORTH, TX 76137 817-838-1300 | PROJECT: Kiewit Westlake Office TI | | 2050 Roanoke Road WESTLAKE TX 76262 | |
| FILE: Kiewitt Westlake Office_rev1.vsd | | | | DWG 28 OF 41 |



TYPICAL FOR 36
(VAV BOXES) 2

| BILL OF MATERIAL | | | | |
|------------------|-----|--------|---------|-------------|
| TAG | QTY | VENDOR | PART NO | DESCRIPTION |

AREA OF WORK WILL ONLY CONSIST 40 BOXES ONLY PER SCOPE

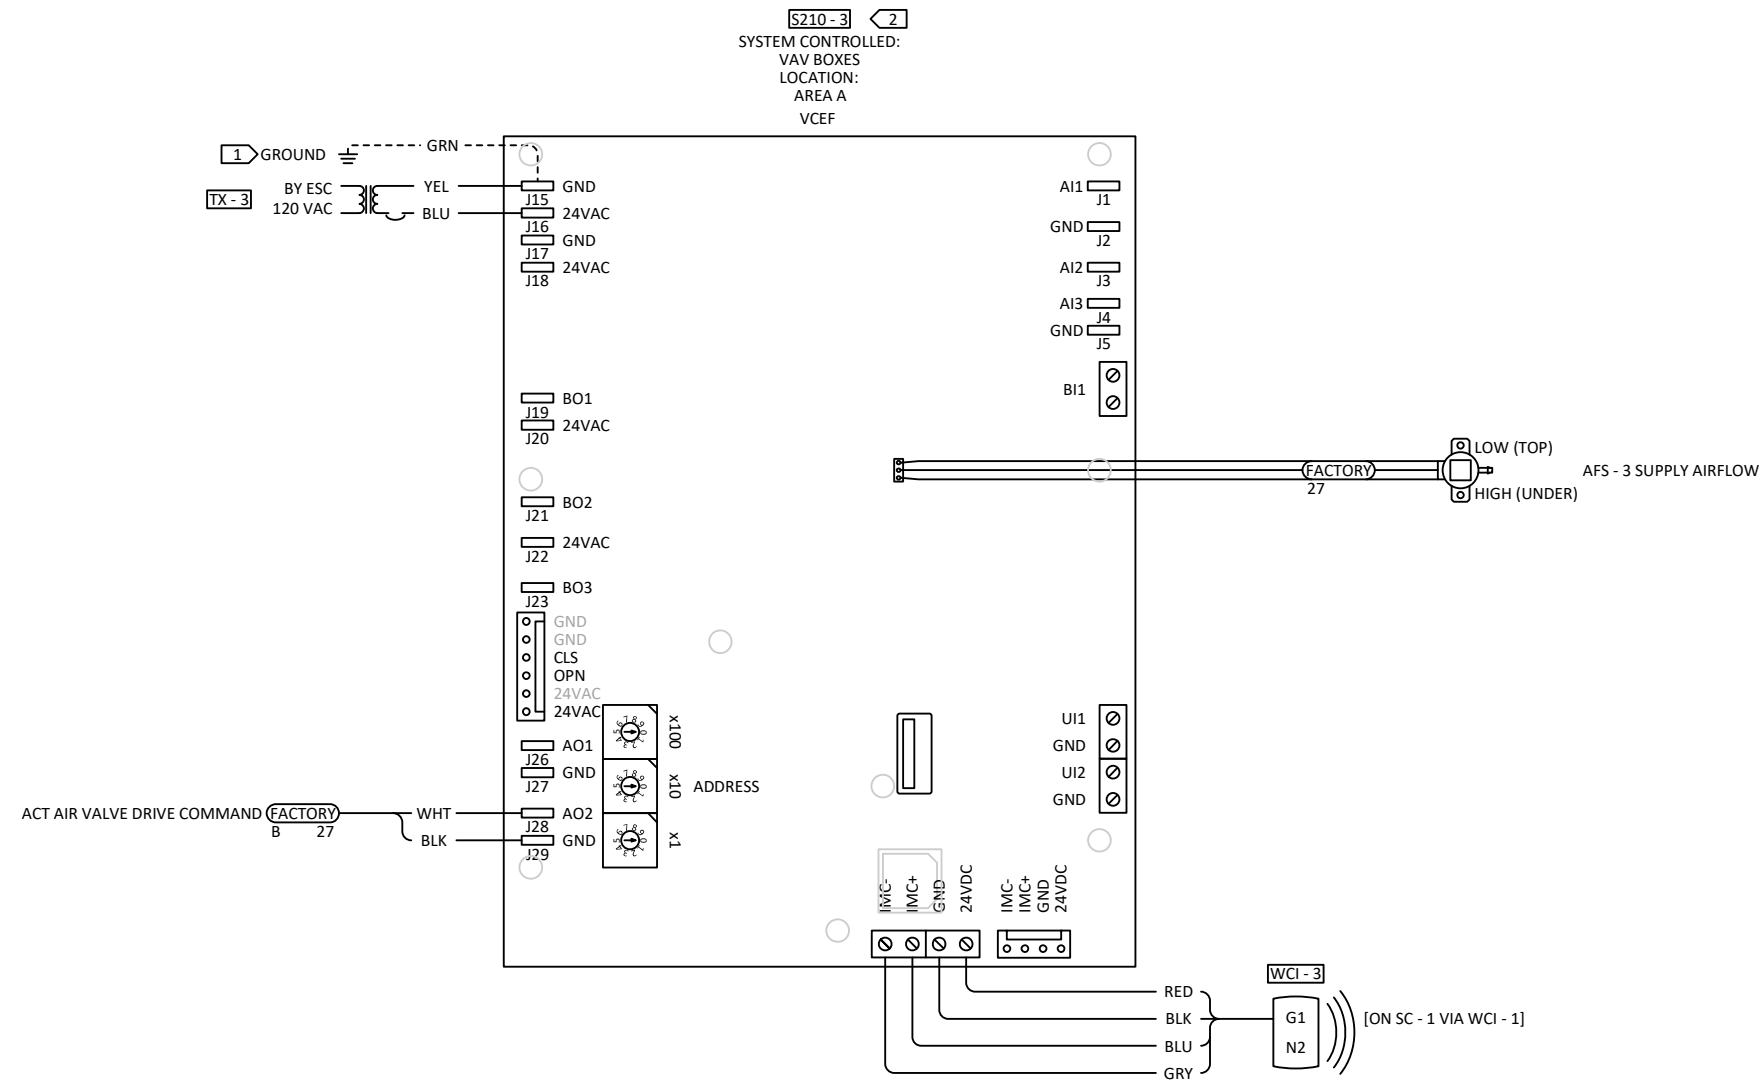

- 2 13 VAV BOXES WILL BE NEW SUPPLIED BY FACTORY. (27) EXISTING VAV BOXES WILL REQUIRE NEW CONTROLLER AND WCI. SEE FLOORPLAN FOR REFERENCE.
- 1 DEVICE MUST BE GROUNDED WITH FACTORY PROVIDED GROUND WIRE AS DETAILED IN THE DEVICE INSTALLATION LITERATURE.

| VAV BOXES - S210 CONTROLLER | | | | |
|---|--|-------------|----------|--------------|
| CID: | NUM. | REVISION | DATE: | BY: |
| 00097395 | | | | |
| PID: 00105161 | | | | |
| PROJECT: K901283 | | | | |
| SALESPERSON: Z Rutledge | | | | |
| DESIGNED BY: B Nyamaah | | | | |
| CHECKED BY: | 1 | -SUBMITTALS | 3/1/2022 | BEN |
| Fort Worth 4200 N. Sylvania Avenue FORT WORTH, TX 76137 817-838-1300 | PROJECT: Kiewit Westlake Office TI 2050 Roanoke Road WESTLAKE TX 76262 | | | |
| FILE: Kiewitt Westlake Office_rev1.vsd | | | | DWG 29 OF 41 |



Kiewit Westlake Office TI, 2050 Roanoke Road, WESTLAKE, TX

FPB 1 ~ 22 S210 - 18

Sequence of Operations

FPB 1 ~ 22 Flow

Building Automation System Interface:

The Building Automation System (BAS) will send the controller Occupied and Unoccupied commands. The BAS may also send a Heat/Cool mode, priority shutdown commands, space temperature and/or space temperature setpoint. If communication is lost with the BAS, the VAV controller will operate using its local setpoints.

Occupancy:

The occupancy mode will be communicated or hardwired to the controller via a binary input. When the unit is in the occupied mode the VAV will maintain the space temperature at the active occupied heating or cooling setpoint. Applicable ventilation and airflow setpoints will be enforced. The occupied mode will be the default mode of the VAV.

Unoccupied:

Normal operating mode for unoccupied spaces or nighttime operation. When the unit is in unoccupied mode the VAV controller will maintain the space temperature at the stored unoccupied heating or cooling setpoint regardless of the presence of a hardwired or communicated setpoint. When in the Unoccupied Mode, the controller will disable the electric heat, and close the ventilation air damper, unless unoccupied cooling or heating is needed. When the space temperature is between the active unoccupied setpoint the VAV will modulate fully closed, and the fan will turn off.

Heat/Cool Mode:

The Heat/Cool mode will be set by a communicated value or automatically by the VAV controller. In standalone or auto mode the VAV controller will compare the primary air temperature with the configured auto changeover setpoint to determine if the air is "hot" or "cold". Heating mode implies the primary air temperature is hot. Cooling mode implies the primary air temperature is cold.

Heat/Cool Setpoint:

The space temperature setpoint will be determined either by a local (e.g., thumbwheel) setpoint, the VAV default setpoint or a communicated value. The VAV will use the locally stored default setpoints when neither a local setpoint nor communicated setpoint is present. If both a local setpoint and communicated setpoint exist, the VAV will use the communicated value.

Cooling Mode:

When the unit is in cooling mode, the VAV controller will maintain the space temperature at the active cooling setpoint by simultaneously modulating both the VAV damper (between the active cooling minimum and maximum airflow setpoints) and the fan (between the minimum and maximum fan airflow setpoints). Based on the VAV controller occupancy mode, the active cooling setpoint will be one of the following:

| Setpoint | Default Value |
|---------------------------------------|------------------|
| Occupied Cooling Setpoint | 74.0 deg. F |
| Unoccupied Cooling Setpoint | 85.0 deg. F |
| Occupied Standby Cooling Setpoint | 78.0 deg. F |
| Occupied Min Cooling Airflow Setpoint | See VAV Schedule |
| Occupied Max Cooling Airflow Setpoint | See VAV Schedule |
| Min Fan Airflow Setpoint | See VAV Schedule |
| Max Fan Airflow Setpoint | See VAV Schedule |

The VAV controller will use the measured space temperature and the active cooling setpoint to determine the requested cooling capacity of the unit. The outputs will be controlled based on the unit configuration and the requested cooling capacity.

Heating Mode:

When the unit is in heating mode, the VAV controller will maintain the space temperature at the active heating setpoint by simultaneously modulating both the VAV damper (between the active heating minimum and maximum airflow setpoints) and the fan (between the minimum and maximum fan airflow setpoints). Based on the VAV controller occupancy mode, the active heating setpoint will be one of the following:

| Setpoint | Default Value |
|---------------------------------------|------------------|
| Occupied Heating Setpoint | 71.0 deg. F |
| Unoccupied Heating Setpoint | 60.0 deg. F |
| Occupied Standby Heating Setpoint | 67.0 deg. F |
| Occupied Min Heating Airflow Setpoint | See VAV Schedule |
| Occupied Max Heating Airflow Setpoint | See VAV Schedule |
| Min Fan Airflow Setpoint | See VAV Schedule |
| Max Fan Airflow Setpoint | See VAV Schedule |

Intermittent Fan Control:

During all occupied modes, when the unit is in cooling mode, as the space temperature falls below the active cooling setpoint, the VAV damper will modulate to its minimum cooling airflow setpoint. The terminal fan and heat will cycle as needed to maintain a reduced space temperature. If the discharge air temperature reaches the design heating discharge air temperature setpoint of 90.0 deg. F (adj.), the VAV controller will modulate the fan between the minimum and maximum fan airflow setpoints to maintain space temperature at the active heating setpoint and modulate the electric heater to maintain discharge air temperature at the design heating discharge air temperature setpoint. During the unoccupied mode, the VAV damper will modulate fully closed.

The reheat will be enabled when the space temperature drops below the active heating setpoint and the minimum airflow requirements are met. During reheat the VAV damper, fan, and electric heat will operate as described above.

Electric Staged:

Stage 1 energizes when the space temperature falls below the active heating setpoint and minimum airflow requirements are met. When the zone temperature rises above the active heating setpoint by 0.5 deg. F, stage 1 is de-energized.

Stage 2 energizes when the space temperature is 1.0 deg. F or more below the active heating setpoint, and is de-energized when the space temperature is 0.5 deg. F below the active heating setpoint.

Ventilation Control (Fixed):

When the unit is in unoccupied mode, the ventilation airflow setpoint will be zero. When the unit is in occupied mode, the ventilation airflow setpoint will equal the design outdoor airflow (see VAV schedule).

The current ventilation airflow setpoint will be communicated to the BAS for control of the system outdoor-air intake.

Space Sensor Failure:

If there is a fault with the operation of the zone sensor an alarm will be annunciated at the BAS. Space sensor failure will cause the VAV controller to drive the VAV damper to minimum air flow setpoint. If the VAV is in the occupied mode, or drive it closed if the VAV is in the unoccupied mode. The parallel fan will be disabled along with the reheat.




| FPB 1 ~ 22 S210 - 18 SEQUENCE | | | | |
|---|------|--|-------|--------------|
| CID: | NUM. | REVISION | DATE: | BY: |
| 00097395 | | | | |
| PID: 00105161 | | | | |
| PROJECT: K901283 | | | | |
| SALESPERSON: Z Rutledge | | | | |
| DESIGNED BY: B Nyamaah | | | | |
| CHECKED BY: | | | | |
| Fort Worth 4200 N. Sylvania Avenue FORT WORTH, TX 76137 817-838-1300 | | PROJECT: Kiewit Westlake Office TI 2050 Roanoke Road WESTLAKE TX 76262 | | |
| FILE: Kiewitt Westlake Office_rev1.vsd | | | | DWG 31 OF 41 |

TYPICAL FOR 22
(FPB 1 ~ 22)

| BILL OF MATERIAL | | | | |
|------------------|-----|--------|---------|-------------|
| TAG | QTY | VENDOR | PART NO | DESCRIPTION |

5210 - 18
SYSTEM CONTROLLED:
FPB 1 ~ 22
LOCATION:
AREA B
VCEF

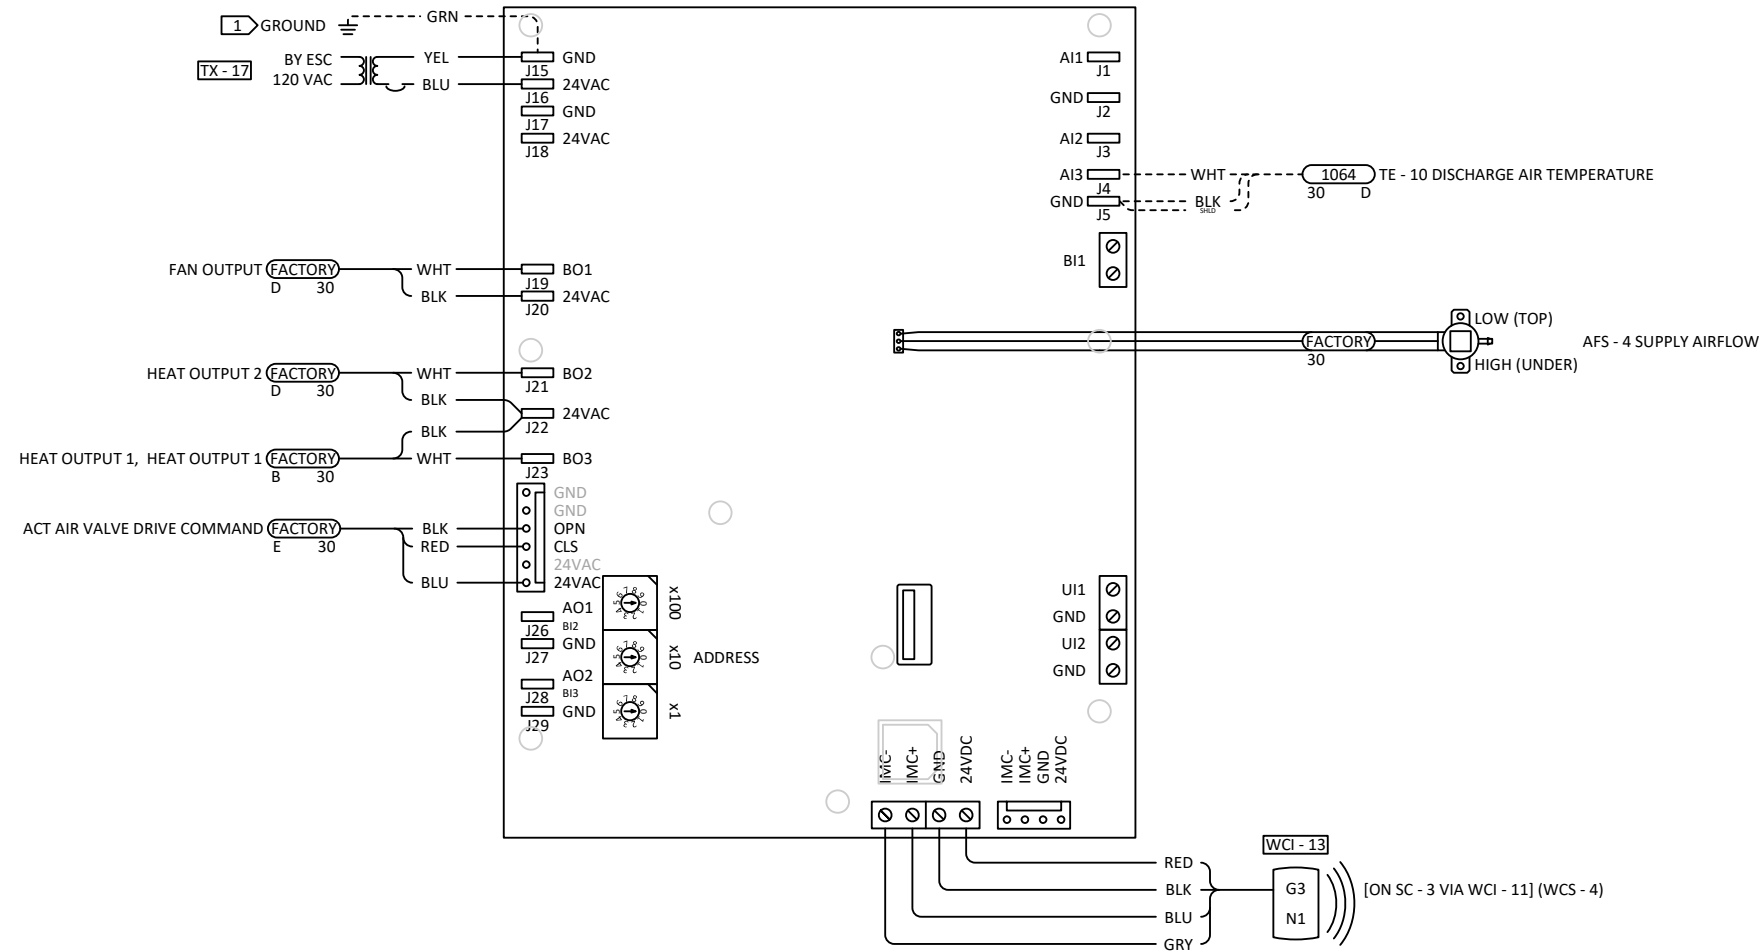

B
42


1 DEVICE MUST BE GROUNDED WITH FACTORY PROVIDED GROUND WIRE AS DETAILED IN THE DEVICE INSTALLATION LITERATURE.

| FPB 1 ~ 22 S210 - 18 CONTROLLER | | | | |
|---|------|----------|--|--------------|
| CID: 00097395 | NUM. | REVISION | DATE: | BY: |
| PID: 00105161 | | | | |
| PROJECT: K901283 | | | | |
| SALESPERSON: Z Rutledge | | | | |
| DESIGNED BY: B Nyamaah | | | | |
| CHECKED BY: | | | | |
| Fort Worth 4200 N. Sylvania Avenue FORT WORTH, TX 76137 817-838-1300 FILE: Kiewitt Westlake Office_rev1.vsd | | | | |
| | | | PROJECT: Kiewit Westlake Office TI 2050 Roanoke Road WESTLAKE TX 76262 | |
| | | | | DWG 32 OF 41 |




(VAVRH)

| BILL OF MATERIAL | | | | |
|------------------|-----|--------|--------------|---|
| TAG | QTY | VENDOR | PART NO | DESCRIPTION |
| WCS - 5 | 1 | TRANE | X13790955010 | TEMP SENS, AIR-FI WIRELESS COMM, DISPLAY, UNIVERSAL |

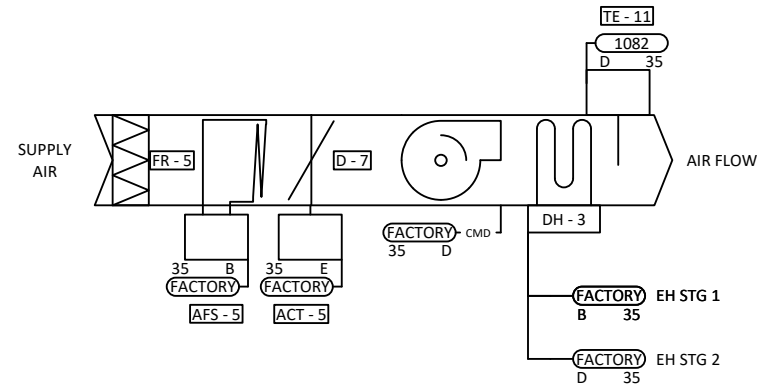

SPACE TEMPERATURE SENSOR

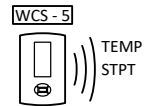

| VAVRH S210 - 19 FLOW | | | | |
|---|------|----------|---|--------------|
| CID: | NUM. | REVISION | DATE: | BY: |
| 00097395 | | | | |
| PID: 00105161 | | | | |
| PROJECT: K901283 | | | | |
| SALESPERSON: Z Rutledge | | | | |
| DESIGNED BY: B Nyamaah | | | | |
| CHECKED BY: | | | | |
| Fort Worth 4200 N. Sylvania Avenue FORT WORTH, TX 76137 817-838-1300 FILE: Kiewitt Westlake Office_rev1.vsd | | | | |
| | | | PROJECT: Kiewitt Westlake Office TI 2050 Roanoke Road WESTLAKE TX 76262 | |
| | | | | DWG 33 OF 41 |



Kiewit Westlake Office TI, 2050 Roanoke Road, WESTLAKE, TX

VAVRH S210 - 19

Sequence of Operations

VAVRH Flow

Building Automation System Interface:

The Building Automation System (BAS) will send the controller Occupied and Unoccupied commands. The BAS may also send a Heat/Cool mode, priority shutdown commands, space temperature and/or space temperature setpoint. If communication is lost with the BAS, the VAV controller will operate using its local setpoints.

Occupancy:

The occupancy mode will be communicated or hardwired to the controller via a binary input. When the unit is in the occupied mode the VAV will maintain the space temperature at the active occupied heating or cooling setpoint. Applicable ventilation and airflow setpoints will be enforced. The occupied mode will be the default mode of the VAV.

Unoccupied:

Normal operating mode for unoccupied spaces or nighttime operation. When the unit is in unoccupied mode the VAV controller will maintain the space temperature at the stored unoccupied heating or cooling setpoint regardless of the presence of a hardwired or communicated setpoint. When in the Unoccupied Mode, the controller will disable the electric heat, and close the ventilation air damper, unless unoccupied cooling or heating is needed. When the space temperature is between the active unoccupied setpoint the VAV will modulate fully closed, and the fan will turn off.

Heat/Cool Mode:

The Heat/Cool mode will be set by a communicated value or automatically by the VAV controller. In standalone or auto mode the VAV controller will compare the primary air temperature with the configured auto changeover setpoint to determine if the air is "hot" or "cold". Heating mode implies the primary air temperature is hot. Cooling mode implies the primary air temperature is cold.

Heat/Cool Setpoint:

The space temperature setpoint will be determined either by a local (e.g., thumbwheel) setpoint, the VAV default setpoint or a communicated value. The VAV will use the locally stored default setpoints when neither a local setpoint nor communicated setpoint is present. If both a local setpoint and communicated setpoint exist, the VAV will use the communicated value.

Cooling Mode:

When the unit is in cooling mode, the VAV controller will maintain the space temperature at the active cooling setpoint by simultaneously modulating both the VAV damper (between the active cooling minimum and maximum airflow setpoints) and the fan (between the minimum and maximum fan airflow setpoints). Based on the VAV controller occupancy mode, the active cooling setpoint will be one of the following:

| Setpoint | Default Value |
|---------------------------------------|------------------|
| Occupied Cooling Setpoint | 74.0 deg. F |
| Unoccupied Cooling Setpoint | 85.0 deg. F |
| Occupied Standby Cooling Setpoint | 78.0 deg. F |
| Occupied Min Cooling Airflow Setpoint | See VAV Schedule |
| Occupied Max Cooling Airflow Setpoint | See VAV Schedule |
| Min Fan Airflow Setpoint | See VAV Schedule |
| Max Fan Airflow Setpoint | See VAV Schedule |

The VAV controller will use the measured space temperature and the active cooling setpoint to determine the requested cooling capacity of the unit. The outputs will be controlled based on the unit configuration and the requested cooling capacity.

Heating Mode:

When the unit is in heating mode, the VAV controller will maintain the space temperature at the active heating setpoint by simultaneously modulating both the VAV damper (between the active heating minimum and maximum airflow setpoints) and the fan (between the minimum and maximum fan airflow setpoints). Based on the VAV controller occupancy mode, the active heating setpoint will be one of the following:

| Setpoint | Default Value |
|---------------------------------------|------------------|
| Occupied Heating Setpoint | 71.0 deg. F |
| Unoccupied Heating Setpoint | 60.0 deg. F |
| Occupied Standby Heating Setpoint | 67.0 deg. F |
| Occupied Min Heating Airflow Setpoint | See VAV Schedule |
| Occupied Max Heating Airflow Setpoint | See VAV Schedule |
| Min Fan Airflow Setpoint | See VAV Schedule |
| Max Fan Airflow Setpoint | See VAV Schedule |

Continuous Fan Control:

The VAV fan will operate continuously in all occupied modes. The terminal fan and heat will cycle as needed to maintain a reduced space temperature.

The reheat will be enabled when the space temperature drops below the active heating setpoint and the minimum airflow requirements are met. During reheat the VAV damper, fan, and electric heat will operate as described above.

Electric Staged:

Stage 1 energizes when the space temperature falls below the active heating setpoint and minimum airflow requirements are met. When the zone temperature rises above the active heating setpoint by 0.5 deg. F, stage 1 is de-energized.

Stage 2 energizes when the space temperature is 1.0 deg. F or more below the active heating setpoint, and is de-energized when the space temperature is 0.5 deg. F below the active heating setpoint.

Ventilation Control (Fixed):

When the unit is in unoccupied mode, the ventilation airflow setpoint will be zero. When the unit is in occupied mode, the ventilation airflow setpoint will equal the design outdoor airflow (see VAV schedule).

The current ventilation airflow setpoint will be communicated to the BAS for control of the system outdoor-air intake.

Space Sensor Failure:


If there is a fault with the operation of the zone sensor an alarm will be annunciated at the BAS. Space sensor failure will cause the VAV to drive the damper to minimum air flow if the VAV is in the occupied mode, or drive it closed if the VAV is in the unoccupied mode. The series fan will be enabled and the reheat will be disabled.




| VAVRH S210 - 19 SEQUENCE | | | | |
|---|------|--|-------|--------------|
| CID: | NUM. | REVISION | DATE: | BY: |
| 00097395 | | | | |
| PID: 00105161 | | | | |
| PROJECT: K901283 | | | | |
| SALESPERSON: Z Rutledge | | | | |
| DESIGNED BY: B Nyamaah | | | | |
| CHECKED BY: | | | | |
| Fort Worth 4200 N. Sylvania Avenue FORT WORTH, TX 76137 817-838-1300 | | PROJECT: Kiewit Westlake Office TI 2050 Roanoke Road WESTLAKE TX 76262 | | |
| FILE: Kiewitt Westlake Office_rev1.vsd | | | | DWG 34 OF 41 |

TYPICAL FOR 33
(VAV 1 ~ 33)

| BILL OF MATERIAL | | | | |
|------------------|-----|--------|--------------|---|
| TAG | QTY | VENDOR | PART NO | DESCRIPTION |
| WCS - 6 | 33 | TRANE | X13790955010 | TEMP SENS, AIR-FI WIRELESS COMM, DISPLAY, UNIVERSAL |

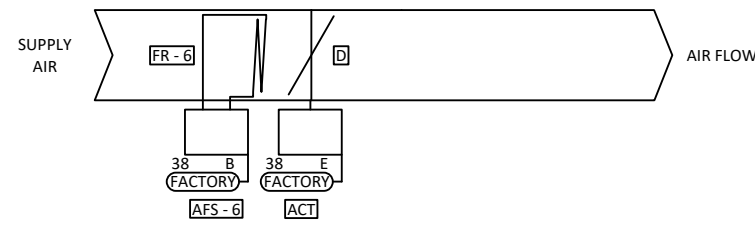

SPACE TEMPERATURE SENSOR

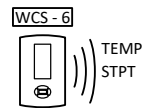

| VAV 1 ~ 33 S210 - 20 FLOW | | | | |
|---|------|--|-------|-----|
| CID: | NUM. | REVISION | DATE: | BY: |
| 00097395 | | | | |
| PID: 00105161 | | | | |
| PROJECT: K901283 | | | | |
| SALESPERSON: Z Rutledge | | | | |
| DESIGNED BY: B Nyamaah | | | | |
| CHECKED BY: | | | | |
| Fort Worth 4200 N. Sylvania Avenue FORT WORTH, TX 76137 817-838-1300 FILE: Kiewitt Westlake Office_rev1.vsd | | PROJECT: Kiewit Westlake Office TI 2050 Roanoke Road WESTLAKE TX 76262 | | |



Kiewit Westlake Office TI, 2050 Roanoke Road, WESTLAKE, TX

VAV 1 ~ 33 S210 - 20

Sequence of Operations

VAV 1 ~ 33 Flow

Building Automation System Interface:

The Building Automation System (BAS) will send the controller Occupied and Unoccupied commands. The BAS may also send a Heat/Cool mode, priority shutdown commands, space temperature and/or space temperature setpoint. If communication is lost with the BAS, the VAV controller will operate using its local setpoints.

Occupancy:

The occupancy mode will be communicated or hardwired to the controller via a binary input. When the unit is in the occupied mode the VAV will maintain the space temperature at the active occupied heating or cooling setpoint. Applicable ventilation and airflow setpoints will be enforced. The occupied mode will be the default mode of the VAV.

Unoccupied:

Normal operating mode for unoccupied spaces or nighttime operation. **Unoccupied:**

When in the Unoccupied Mode, the controller will close the air damper, unless unoccupied cooling or ventilation is required. When the unit is in unoccupied mode the VAV controller will maintain the space temperature at the stored unoccupied heating or cooling setpoint regardless of the presence of a hardwired or communicated setpoint. If the zone temperature rises above its Unoccupied Cooling Setpoint, the controller will modulate the air damper, until the zone temperature drops back to 2.0 deg. F below the Unoccupied Cooling Setpoint.

Heat/Cool Mode:

The Heat/Cool mode will be set by a communicated value or automatically by the VAV controller. In standalone or auto mode the VAV controller will compare the primary air temperature with the configured auto changeover setpoint to determine if the air is "hot" or "cold". Heating mode implies the primary air temperature is hot. Cooling mode implies the primary air temperature is cold.

Heat/Cool Setpoint:

The space temperature setpoint will be determined either by a local (e.g., thumbwheel) setpoint, the VAV default setpoint or a communicated value. The VAV will use the locally stored default setpoints when neither a local setpoint nor communicated setpoint is present. If both a local setpoint and communicated setpoint exist, the VAV will use the communicated value.

Cooling Mode:

When the unit is in cooling mode, the VAV controller will maintain the space temperature at the active cooling setpoint by modulating the VAV damper (between the active cooling minimum and maximum airflow setpoints). The outputs will be controlled based on the unit configuration and the requested cooling capacity.

Heating Mode:

When the unit is in heating mode, the VAV controller will maintain the space temperature at the active heating setpoint by modulating the VAV damper (between the active heating minimum and maximum airflow setpoints). Based on the VAV controller occupancy mode, the active heating setpoint will be one of the following:

| Setpoint | Default Value |
|---------------------------------------|------------------|
| Occupied Heating Setpoint | 71.0 deg. F |
| Unoccupied Heating Setpoint | 60.0 deg. F |
| Occupied Standby Heating Setpoint | 67.0 deg. F |
| Occupied Min Heating Airflow Setpoint | See VAV Schedule |
| Occupied Max Heating Airflow Setpoint | See VAV Schedule |

Ventilation Control (Fixed):

When the unit is in unoccupied mode, the ventilation airflow setpoint will be zero. When the unit is in occupied mode, the ventilation airflow setpoint will equal the design outdoor airflow (see VAV schedule).

The current ventilation airflow setpoint will be communicated to the BAS for control of the system outdoor-air intake.

Space Sensor Failure:


If there is a fault with the operation of the zone sensor an alarm will be annunciated at the BAS. Space sensor failure will cause the VAV to drive the damper to minimum air flow if the VAV is in the occupied mode, or drive it closed if the VAV is in the unoccupied mode.



| VAV 1 ~ 33 S210 - 20 SEQUENCE | | | | |
|---|------|----------|--|--------------|
| CID: | NUM. | REVISION | DATE: | BY: |
| 00097395 | | | | |
| PID: 00105161 | | | | |
| PROJECT: K901283 | | | | |
| SALESPERSON: Z Rutledge | | | | |
| DESIGNED BY: B Nyamaah | | | | |
| CHECKED BY: | | | | |
| Fort Worth 4200 N. Sylvania Avenue FORT WORTH, TX 76137 817-838-1300 | | | | |
| | | | PROJECT: Kiewit Westlake Office TI 2050 Roanoke Road WESTLAKE TX 76262 | |
| FILE: Kiewitt Westlake Office_rev1.vsd | | | | DWG 37 OF 41 |

TYPICAL FOR 33
(VAV 1 ~ 33)

| BILL OF MATERIAL | | | | |
|------------------|-----|--------|---------|-------------|
| TAG | QTY | VENDOR | PART NO | DESCRIPTION |

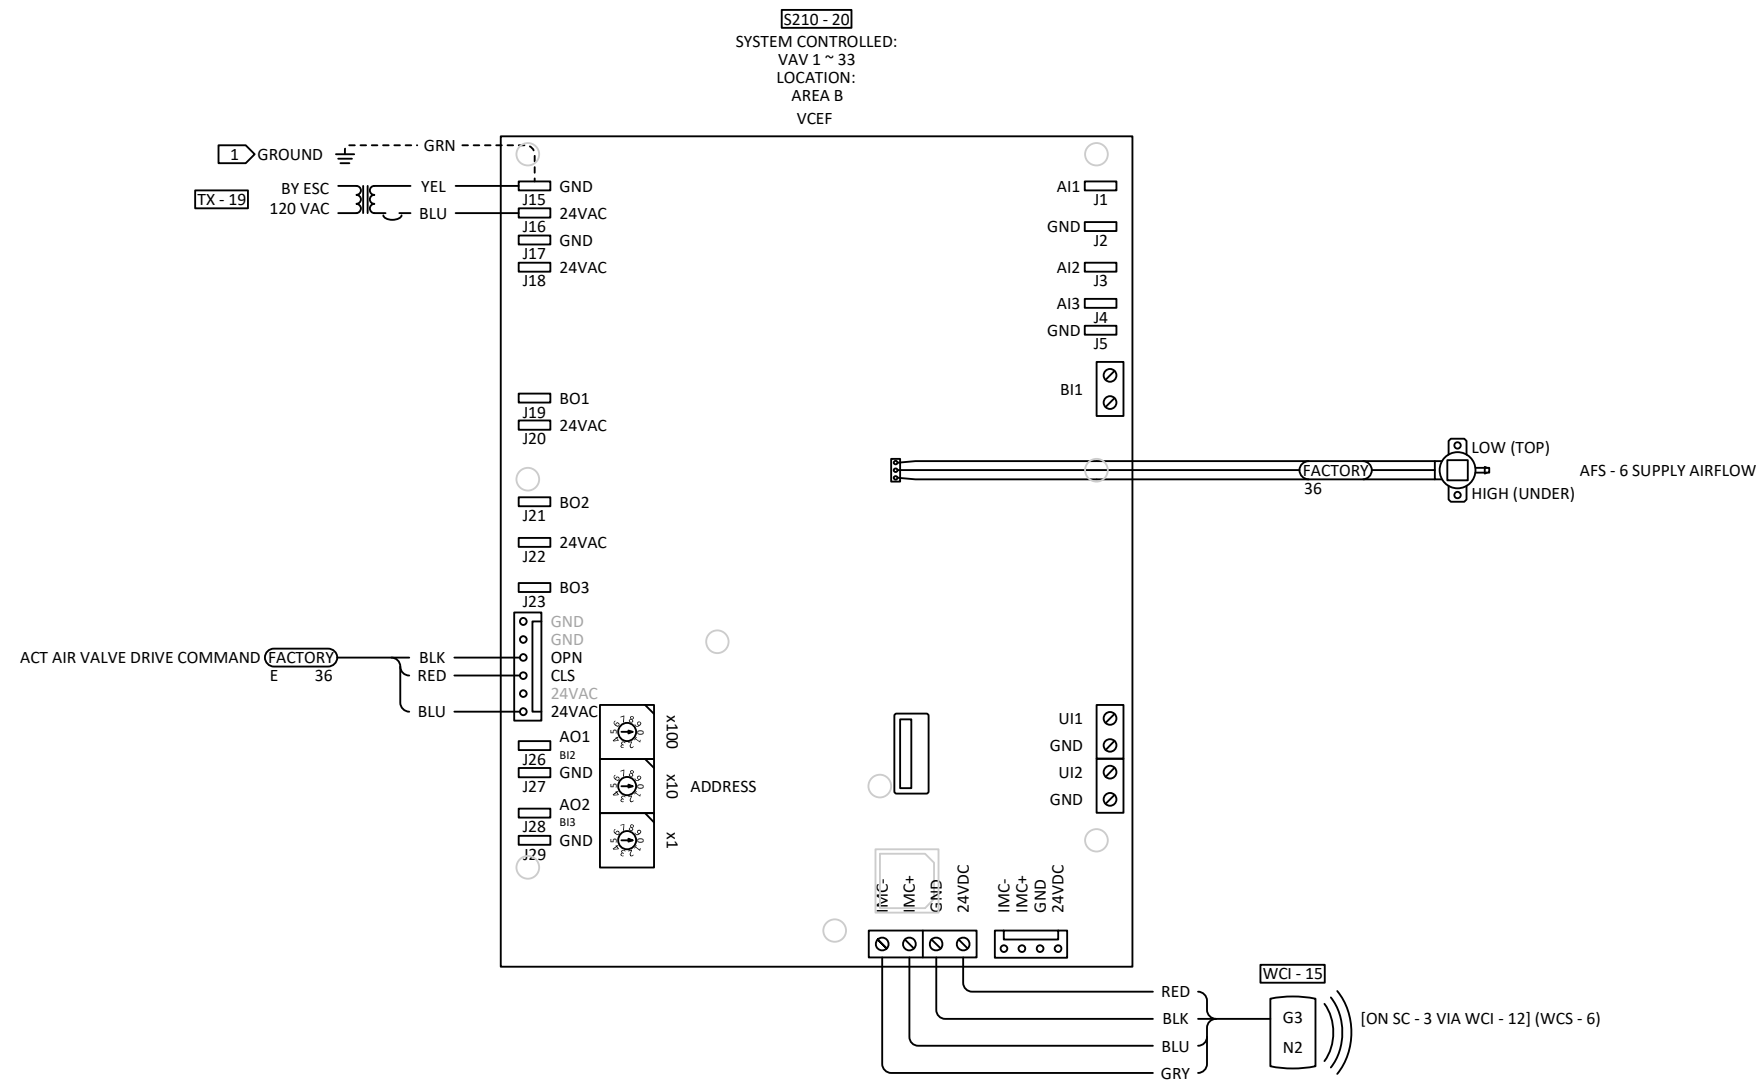


1 DEVICE MUST BE GROUNDED WITH FACTORY PROVIDED GROUND WIRE AS DETAILED IN THE DEVICE INSTALLATION LITERATURE.


| VAV 1 ~ 33 S210 - 20 CONTROLLER | | | | |
|---|------|---|-------|-----|
| CID: 00097395 | NUM. | REVISION | DATE: | BY: |
| PID: 00105161 | | | | |
| PROJECT: K901283 | | | | |
| SALESPERSON: Z Rutledge | | | | |
| DESIGNED BY: B Nyamaah | | | | |
| CHECKED BY: | | | | |
| Fort Worth 4200 N. Sylvania Avenue FORT WORTH, TX 76137 817-838-1300 FILE: Kiewitt Westlake Office_rev1.vsd | | PROJECT: Kiewitt Westlake Office TI 2050 Roanoke Road WESTLAKE TX 76262 | | |



AIR-FI WIRELESS COMM INTERFACE, INDOOR MOUNTING,
FIELD
TRANE
X13790901030

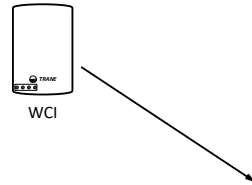

SENSOR TEMP 4" DUCT THERM
TRANE
41901129

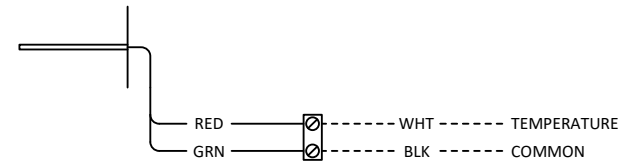

A

B

| DETAIL SHEET | | | | |
|---|--|----------|-------|--------------|
| CID: | NUM. | REVISION | DATE: | BY: |
| 00097395 | | | | |
| PID: 00105161 | | | | |
| PROJECT: K901283 | | | | |
| SALESPERSON: Z Rutledge | | | | |
| DESIGNED BY: B Nyamaah | | | | |
| CHECKED BY: | | | | |
| Fort Worth 4200 N. Sylvania Avenue FORT WORTH, TX 76137 817-838-1300 | PROJECT: Kiewit Westlake Office TI 2050 Roanoke Road WESTLAKE TX 76262 | | | |
| FILE: Kiewitt Westlake Office_rev1.vsd | | | | DWG 40 OF 41 |



| BILL OF MATERIAL | | | | |
|------------------|-----|--------|--------------|--|
| TAG PREFIX | QTY | VENDOR | PART NO | DESCRIPTION |
| WCI | 2 | TRANE | X13790901030 | AIR-FI WIRELESS COMM INTERFACE, INDOOR MOUNTING, FIELD |
| WCS | 56 | TRANE | X13790955010 | TEMP SENS, AIR-FI WIRELESS COMM, DISPLAY, UNIVERSAL |

2 ONLY 54 WCI FOR BOXES, AND 4 WCI FOR IMC LINK

1 ONLY 54 CONTROLLERS WILL BE PROVIDED FOR EXISTING BOXES. 21 CONTROLLERS WILL BE SUPPLIED WITH NEW FACTORY CONTROLLERS.

| BILL OF MATERIALS | | | | |
|---|--|-------------|----------|-----|
| CID: | NUM. | REVISION | DATE: | BY: |
| 00097395 | | | | |
| PID: 00105161 | | | | |
| PROJECT: K901283 | | | | |
| SALESPERSON: Z Rutledge | | | | |
| DESIGNED BY: B Nyamaah | | | | |
| CHECKED BY: | 1 | -SUBMITTALS | 3/1/2022 | BEN |
| Fort Worth 4200 N. Sylvania Avenue FORT WORTH, TX 76137 817-838-1300 | PROJECT: Kiewit Westlake Office TI 2050 Roanoke Road WESTLAKE TX 76262 | | | |
| FILE: Kiewitt Westlake Office_rev1.vsd | DWG 41 OF 41 | | | |

