


01 MECHANICAL CELLAR PLAN
1/4" = 1'-0"

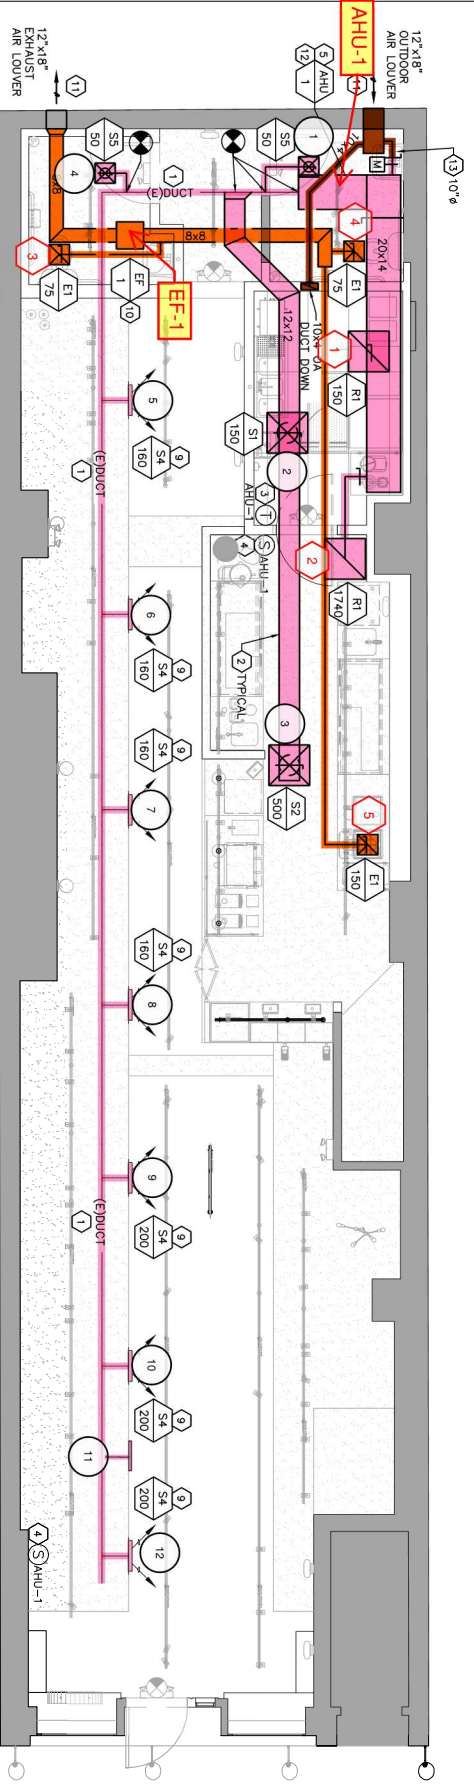

01 MECHANICAL FIRST FLOOR PLAN
1/4" = 1'-0"