


HVAC SPECIFICATIONS

1. GENERAL PROVISIONS
 - A. THE PROVISIONS OF THE INSTRUCTIONS TO BIDDERS, GENERAL CONDITIONS, SUPPLEMENTARY CONDITIONS, ALTERNATES, ADDENDAS, AND DIVISION 1 ARE A PART OF THIS SPECIFICATION. CONTRACTORS AND SUBCONTRACTORS SHALL EXAMINE SAME AS WELL AS OTHER DIVISIONS OF THE SPECIFICATIONS WHICH AFFECT WORK UNDER THIS DIVISION.
 - B. THIS CONTRACTOR SHALL PROVIDE ALL LABOR, EQUIPMENT, SUPPLIES, SERVICES, AND SHALL PERFORM ALL WORK COMPLETE AND IN STRICT ACCORDANCE WITH THIS SPECIFICATION AND APPLICABLE DRAWINGS. ANY DEVIATIONS SHALL BE CLEARLY DEFINED AND ITEMIZED IN ACCORDANCE WITH SECTION 101 OF THIS SPECIFICATION.
 - C. THIS CONTRACTOR IS INSTRUCTED TO READ CAREFULLY THE SPECIFICATIONS FOR ALL PARTS OF THE WORK, WHICH INCLUDE THE ARCHITECTURAL, ELECTRICAL, MECHANICAL, PLUMBING, FIRE PROTECTION, CIVIL, STRUCTURAL AND ALL OTHER DRAWINGS AS WELL AS THE SPECIFICATIONS FOR ALL THE DIVISIONS THAT ARE PART OF THE CONTRACT DOCUMENTS.
 - D. ALL ITEMS OF LABOR, MATERIAL, AND EQUIPMENT NOT SPECIFICALLY MENTIONED HEREIN OR SHOWN ON PLAN, BUT INCIDENTAL TO, OR REQUIRED FOR THE COMPLETE INSTALLATION AND PROPER OPERATION OF THE WORK, SHALL BE FURNISHED AS IF CALLED FOR IN DETAIL BY THE SPECIFICATIONS OR DRAWINGS.
 - E. AS USED IN THIS SPECIFICATION, "PROVIDE" MEANS "FURNISH AND INSTALL." "FURNISH" MEANS "TO PURCHASE AND DELIVER TO THE PROJECT SITE COMPLETE WITH EVERY NECESSARY APPURTENANCE AND SUPPORT;" AND "INSTALL" MEANS "TO UNLOAD AT THE DELIVERY POINT AT THE SITE AND PERFORM EVERY OPERATION NECESSARY FOR PROPER INSTALLATION PER CODES AND MANUFACTURERS' REQUIREMENTS, TO ESTABLISH SECURE MOUNTING AND CORRECT OPERATION AT THE PROPER LOCATION IN THE PROJECT."
2. PERMITS, CODES, INSPECTIONS AND TESTS
 - A. THE HVAC CONTRACTOR SHALL SECURE AND PAY FOR ALL PERMITS AND INSPECTIONS REQUIRED FOR THE PROSECUTION OF HVAC WORK. ALL PERMITS AND CERTIFICATES OF INSPECTION AND APPROVAL SIGNED BY THE CONTROLLING BUILDING DEPARTMENT SHALL BECOME PROPERTY OF THE OWNER.
 - B. DRAWINGS INDICATE THE MINIMUM DESIGN REQUIREMENTS. NATIONAL, STATE, AND LOCAL CODES SHALL BE FOLLOWED, COMPLY WITH THE LATEST EDITIONS OF THE STATE MECHANICAL CODE, NFPA, SMACNA, AND ASHRAE STANDARDS. THE CONTRACTOR SHALL INCLUDE THE COST OF SATISFYING SUCH CODES AND STANDARDS IN THE BID.
 - C. FOLLOWING COMPLETION OF THE HVAC WORK, FURNISH TO THE OWNER, IN DUPLICATE, CERTIFICATES OF INSPECTION AND APPROVAL BY REGULATORY AGENCIES HAVING JURISDICTION
 1. DEMONSTRATE TO THE OWNER'S SATISFACTION THE PROPER OPERATION OF EACH OF THE SYSTEMS COMPRISING THIS CONTRACT BEFORE FINAL PAYMENT.
 2. IMMEDIATELY CORRECT ANY WORK FOUND AT VARIANCE WITH THESE SPECIFICATIONS, THE NATIONAL, STATE, AND LOCAL CODES, AND REQUIREMENTS OF GOVERNING REGULATORY AGENCIES.
 3. TEST PIPING FOR LEAKS; REPAIR LEAKS IN COPPER TUBING BY SWEATING OUT JOINT; THOROUGHLY CLEANING BOTH TUBE AND FITTING, AND REORDERING, CORRECT LEAKS IN SCREWED JOINT BY REPLACING THREAD OR FITTING OR BOTH.
 4. PROVIDE SERVICES OF A ACCEPTED A.B.C. OR N.E.B. TEST AGENCY. CONDUCT ALL TESTS IN ACCORDANCE WITH ASSOCIATED AIR BALANCE COUNCIL STANDARDS. TEST AND ADJUST AIR HANDLING SYSTEM TO WITHIN 5% OF DESIGN REQUIREMENTS.
3. PROTECTION
 - A. THE HVAC CONTRACTOR SHALL PROVIDE ALL NECESSARY PROTECTION FROM DIRT AND WATER DURING CONSTRUCTION NECESSITATED BY HVAC WORK.
4. EQUIPMENT AND MATERIALS
 - A. ALL EQUIPMENT AND MATERIALS SHALL BE NEW AND SHALL CONFORM TO UNDERWRITERS' LABORATORIES STANDARDS, WHERE APPLICABLE. WHERE SPECIFICATIONS DESCRIBE OR PLANS SHOW MATERIALS OR EQUIPMENT OF HIGHER QUALITY THAN REQUIRED BY CODE AND LOCAL RULING, THE DRAWINGS AND SPECIFICATIONS SHALL GOVERN THE QUALITY OF THE MATERIAL OR EQUIPMENT. USED EQUIPMENT OR MATERIALS ARE PROHIBITED UNLESS NOTED OTHERWISE.
 - B. NEW EQUIPMENT SHALL NOT BE OPERATED DURING CONSTRUCTION. HVAC CONTRACTOR SHALL COORDINATE WITH OTHER TRADES AND PROVIDE TEMPORARY SPACE CONDITIONING IN ORDER TO MAINTAIN TEMPERATURES AND HUMIDITY LEVELS AS REQUIRED FOR GENERAL CONSTRUCTION.
 - C. THE CONTRACTOR SHALL SUBMIT PROOF, IF REQUESTED BY THE ARCHITECT/ENGINEER OR OWNER, THAT THE MATERIALS, APPLIANCES, EQUIPMENT OR DEVICES FURNISHED AND INSTALLED UNDER THIS CONTRACT MEET THE REQUIREMENTS OF THE UNDERWRITERS' LABORATORIES, INC. IN REGARDS TO FIRE AND CASUALTY HAZARDS, THE LABEL OF OR LISTING BY THE UNDERWRITERS' LABORATORIES, INC. WILL BE ACCEPTED AS CONFORMING TO THIS REQUIREMENT. IN LIEU OF THE LABEL OR LISTING, THE CONTRACTOR MAY SUBMIT INDEPENDENT PROOF SATISFACTORY TO THE ARCHITECT/ENGINEER THAT THE MATERIAL, APPLIANCES OR DEVICES CONFORM TO THE PUBLISHED STANDARDS, INCLUDING METHODS OF TEST FOR THE UNDERWRITERS' LABORATORIES INCORPORATED UNDERWRITERS LABORATORIES, INC. AND ITS PUBLICATIONS WILL BE REFERRED TO HEREINAFTER BY THE ABBREVIATION UL WITH OR WITHOUT ADDITIONAL IDENTIFYING SYMBOLS.
5. GUARANTEE
 - A. THE HVAC CONTRACTOR SHALL GUARANTEE FOR A PERIOD OF ONE YEAR THAT ALL WORK AND EQUIPMENT WILL REMAIN FREE FROM ALL DEFECTS IN WORKMANSHIP AND MATERIALS, AND THAT IT WILL COMPLY WITH ALL THE SPECIFIC REQUIREMENTS OF THE SPECIFICATIONS AND OTHER CONTRACT DOCUMENTS GOVERNING THE WORK.
 - B. ALL WORK FOUND BY THE ENGINEER TO BE DEFECTIVE WILL BE REPLACED WITH NEW WORK MEETING ALL THE REQUIREMENTS OF THE CONTRACT. THE HVAC CONTRACTOR WILL BEAR ALL COSTS OF SUPPLYING SUCH NEW, AND INSTALLING AND FINISHING SAME, AND WILL ASSUME ALL COSTS FOR REPLACING OTHER WORK DAMAGED BY THE REMOVAL AND REPLACEMENT OF ANY OF THE WORK. THE HVAC CONTRACTOR WILL BEAR ALL COSTS FOR FREIGHT, DRYAGE AND DEMURRAGE, AND ALL LABOR IN CONNECTION THEREWITH.
6. CUTTING, PATCHING, FIRESTOPPING AND PAINTING
 - A. THIS CONTRACTOR SHALL BE RESPONSIBLE FOR CUTTING ALL HOLES REQUIRED FOR INSTALLATION OF HVAC WORK. HOLES SHALL BE CUT IN A NEAT AND WORKMANLIKE MANNER.
 - B. CONTRACTOR SHALL EMPLOY AN BUILDING OWNER APPROVED ROOFING CONTRACTOR FOR ALL ROOF PENETRATIONS. ROOF SHALL BE REPAIRED SO AS NOT TO VOID ROOF WARRANTY.
 - C. UNLESS NOTED OTHERWISE, ALL HOLES OR DAMAGE CAUSED BY THE REMOVAL OF EXISTING WORK OR THE INSTALLATION OF NEW WORK SHALL BE PROPERLY PATCHED BY THIS CONTRACTOR. HOLES SHALL BE NEATLY PATCHED AND PAINTED WITH SUITABLE MATERIAL TO MATCH EXISTING SURFACES. HOLES THROUGH FLOORS OR FIRE WALLS SHALL BE SEALED WITH THE APPROPRIATE CALK, PUTTY, STRIP OR SHEET FIRE BARRIER PRODUCT.
 - D. FIRESTOP SYSTEM (REQUIRED FIRESTOPPING MATERIALS) SHALL BE DETERMINED BY THE WALL OR FLOOR/CILING ASSEMBLY AND PENETRATION TYPE AND SHALL BE UL LISTED AND TESTED IN ACCORDANCE WITH ASTM E814. FIRE RATING OF THE FIRESTOP SYSTEM SHALL BE EQUIVALENT TO THE ASSEMBLY WHICH IS PENETRATED.
 - E. ACCEPTABLE FIRE BARRIER PRODUCTS: HILTI 'FS-ONE' NELSON FLAMESEAL' OR APPROVED EQUAL AS MANUFACTURED BY 3M.
7. CLEANING AND PAINTING
 - A. CLEAN NEW PIPING AFTER WORK IS COMPLETE TO REMOVE PIPE DOPE. LOOSE MILL SCALE AND OTHER EXTRANEOUS MATERIALS.
 - B. TOUCH UP AND REPAIR ANY DAMAGED FACTORY FINISHES ON EQUIPMENT AND MATERIALS FURNISHED. OTHER PAINTING WILL BE DONE UNDER THE PAINTING DIVISION OF THE SPECIFICATIONS.
8. COORDINATION AND CONDUCT OF WORK
 - A. HVAC DRAWINGS ARE DIAGRAMMATIC, INDICATING GENERAL ARRANGEMENT, APPROXIMATE SIZES, GENERAL LOCATIONS OF EQUIPMENT AND PIPING. VERIFY DIMENSIONS IN FIELD ADJUST TO MANUFACTURERS SHOP DRAWINGS. DO NOT SCALE DRAWINGS.
 - B. ALL REQUESTS FOR INFORMATION SUPPLEMENTAL TO THE CONSTRUCTION DOCUMENTS SHALL BE SUBMITTED IN WRITING TO THE ARCHITECT FOR DISTRIBUTION TO THE APPROPRIATE PARTY(S).
 - C. DRAWINGS AND SPECIFICATIONS ARE TO BE CONSIDERED AS SUPPLEMENTING EACH OTHER. WORK SPECIFIED BUT NOT SHOWN, OR SHOWN BUT NOT SPECIFIED, SHALL BE PERFORMED OR FURNISHED AS THOUGH MENTIONED IN BOTH SPECIFICATIONS AND DRAWINGS.
 - D. ANY DISCREPANCIES BETWEEN THE DRAWINGS AND SPECIFICATIONS SHALL BE BROUGHT TO THE ATTENTION OF THE ARCHITECT AND ENGINEER.
 - E. ARCHITECTURAL AND STRUCTURAL DRAWINGS SUPERSEDE HVAC DRAWINGS. DETERMINE THAT WORK OF THIS DIVISION CAN BE ACCOMMODATED WITHIN SPACES PROVIDED. NOTIFY ARCHITECT OF ANY INTERFERENCE BEFORE STARTING INSTALLATION.
 - F. DETERMINE SIZES, LOCATIONS FOR CHASES AND OPENINGS NECESSARY FOR INSTALLATION OF HVAC WORK. COOPERATE WITH OTHER TRADES IN PROVIDING SLEEVES, INSERTS AND HANGERS.
 - G. COORDINATE THIS WORK WITH ALL TRADES. ARRANGE OPERATIONS SO AS NOT TO DELAY COMPLETION OF INSTALLATION OF ANY PARTS OF INTERRELATED WORK SO THAT CONSTRUCTION MAY PROCEED ON SCHEDULE.
 - H. COOPERATE WITH ALL TRADES IN PREPARING INTERFERENCE DRAWINGS FOR AREAS WHERE THERE IS POSSIBLE CONFLICT BETWEEN TRADES. EXACT LOCATION OF PIPES, DUCTS AND EQUIPMENT SHALL BE BASED ON FIELD MEASUREMENT WITH FINAL ARRANGEMENT DETERMINED BY INTRA-TRADE AGREEMENTS SUBJECT TO ARCHITECT'S APPROVAL.
 - I. ARCHITECT RESERVES THE RIGHT TO MAKE REASONABLE CHANGES IN INDICATED LOCATIONS WITHOUT EXTRA COST TO THE OWNER.
 - J. ALL WORK SHALL BE INSTALLED IN NEAT AND WORKMANLIKE MANNER BY FIRST-CLASS MECHANICS. THE CONTRACTOR SHALL PROVIDE ADEQUATE AND COMPETENT SUPERVISION OF THE JOB AS REQUIRED.
 - K. DUCTWORK, PIPING AND EQUIPMENT SHALL BE ARRANGED SUBSTANTIALLY AS INDICATED. ANY CHANGE RESULTING IN A SAVINGS IN LABOR OR MATERIAL SHALL BE MADE ONLY IN ACCORDANCE WITH A CONTRACT CHANGE ORDER. DEVIATIONS SHALL BE MADE ONLY WHERE NECESSARY TO AVOID INTERFERENCES AND ONLY AFTER DRAWINGS SHOWING THE PROPOSED DEVIATIONS HAVE BEEN SUBMITTED TO AND APPROVED BY THE ARCHITECT.
 - L. COORDINATE ALL SHUTDOWNS OF ANY HVAC SYSTEM IN ADVANCE WITH THE OWNER.
9. SUBMITTALS
 - A. SHOP DRAWINGS/SUBMITTALS FOR ALL SCHEDULED AND/OR SPECIFIED EQUIPMENT SHALL BE SUBMITTED ELECTRONICALLY FOR APPROVAL BY THE ARCHITECT AND ENGINEER. INFORMATION SHALL INCLUDE, BUT IS NOT LIMITED TO: CFM, HP, GPM, MBH, EER, COP, % EFF, VOLTAGE/PHASE, MCA, CONNECTION SIZES, WEIGHT, DIMENSIONS, SCHEDULED EQUIPMENT, DIFFUSERS, DAMPERS, LISTED ACCESSORIES, ETC. AND OTHER COMPONENTS REQUIRED FOR A COMPLETE INSTALLATION.
 - B. WHERE ONLY ONE MAKE OF EQUIPMENT IS NAMED, IT SHALL BE PROVIDED AS SPECIFIED.
 - C. VERBAL REQUESTS OF APPROVALS FOR ANY SUBSTITUTION WILL NOT BE BINDING ON THE ARCHITECT, ENGINEER AND OWNER.
 - D. THIS CONTRACTOR ASSUMES ALL RESPONSIBILITY FOR ALL COSTS FOR REDESIGN AND CHANGES NECESSARY BY ALL TRADES TO ACCOMMODATE THE USE OF EQUIPMENT NOT SPECIFIED ON PROJECT DOCUMENTS.
 - E. BIDS SHALL BE BASED UPON THE SPECIFIED PRODUCTS OR LISTED ALTERNATIVES. DRAWINGS AND SPECIFICATIONS ARE BASED ON THE PRODUCTS SPECIFIED BY TYPE, MODEL, AND SIZE, AND THUS ESTABLISH MINIMUM QUALITIES, WHICH SUBSTITUTES MUST MEET TO QUALIFY FOR REVIEW.
 - F. SHOULD THE CONTRACTOR PROPOSE TO FURNISH MATERIALS, EQUIPMENT, AND DEVICES, OTHER THAN THOSE SPECIFIED AND LISTED, THE CONTRACTOR SHALL SUBMIT A WRITTEN REQUEST FOR SUBSTITUTIONS TO THE ENGINEER AT LEAST FOURTEEN (14) CALENDAR DAYS PRIOR TO BID OPENING. THE REQUEST SHALL BE AN ALTERNATE TO THE ORIGINAL BID AND SHALL INCLUDE AND BE ACCOMPANIED WITH COMPLETE SPECIFICATION CUT SHEET SUBMITTALS AS OUTLINED IN SECTION 10A OF THIS SPECIFICATION SECTION, COMPLETE WITH DESCRIPTIVE (MANUFACTURER, BRAND NAME, CATALOG NUMBER, ETC) AND TECHNICAL DATA FOR ALL ITEMS. INDICATE ANY ADDITIONS OR DEDUCTIONS TO THE CONTRACT PRICE ON BOTH THE SUBSTITUTION SUBMITTAL AND THE BID FORM. FAILURE TO PERFORM THESE ACTIONS EQUATES TO ACKNOWLEDGEMENT THAT THE PROJECT HAS BEEN BID WITH STRICT ACCORDANCE TO THIS SPECIFICATION AND APPLICABLE DRAWINGS.
 - G. ACCEPTANCE OR REJECTION OF THE PROPOSED SUBSTITUTIONS SHALL BE SUBJECT TO APPROVAL OF THE ARCHITECT AND ENGINEER. IF REQUESTED, THE CONTRACTOR SHALL SUBMIT INSPECTION SAMPLES OF BOTH THE SPECIFIED AND THE PROPOSED SUBSTITUTE ITEMS.
 - H. IF ANY SUBSTITUTIONS ARE APPROVED, AN ADDENDUM LISTING THE APPROVED ITEM(S) WILL BE ISSUED TO ALL BIDDING CONTRACTORS PRIOR TO THE BID DATE.
 - I. IN ALL CASES WHERE SUBSTITUTIONS ARE PERMITTED, THE CONTRACTOR SHALL BEAR ANY EXTRA COST OF EVALUATING THE EQUALITY OF THE MATERIAL AND EQUIPMENT TO BE INSTALLED.
10. EQUIPMENT IDENTIFICATION
 - A. THE CONTRACTOR SHALL FURNISH AND INSTALL A SYSTEM OF NAMEPLATES DESIGNED TO IDENTIFY EACH PIECE OF EQUIPMENT.
 1. NAMEPLATE LETTERS AND NUMBERS SHALL MATCH EQUIPMENT DESIGNATION AS INDICATED ON THE DRAWINGS.
 2. NAMEPLATES SHALL BE LAMINATED PHENOLIC WITH BLACK SURFACE AND WHITE CORE. USE 1/16" THICK MATERIAL FOR PLATES UP TO 2" BY 4". FOR LARGER SIZES USE 1/8" THICK. LETTERS AND NUMBERS SHALL BE A MINIMUM OF 3/16" HIGH.
 3. FASTEN NAMEPLATES TO ALL EQUIPMENT BY THE USE OF STAINLESS STEEL SHEET METAL SCREWS.

1. PROVIDE SERVICES OF A ACCEPTED A.B.C. OR N.E.B. TEST AGENCY. CONDUCT ALL TESTS IN ACCORDANCE WITH ASSOCIATED AIR BALANCE COUNCIL STANDARDS. TEST AND ADJUST AIR HANDLING SYSTEM TO WITHIN 5% OF DESIGN REQUIREMENTS.

12. AS-BUILT DRAWINGS
 - A. AS WORK PROGRESSES, RECORD ON A SET OF 'AS-BUILT' PRINTS ANY DEVIATIONS FROM DESIGN DRAWINGS. DELIVER THIS SET TO THE OWNER BEFORE SUBMITTING REQUEST FOR FINAL PAYMENT. THE 'AS-BUILT' PRINTS SHALL BE AN ACCURATE DEPICTION OF THE PROJECT AS COMPLETED.
13. OPERATING AND MAINTENANCE MANUALS
 - A. PROVIDE TO OWNER AT PROJECT TURNOVER, THREE (3) HARDBOUND COPIES OF OPERATING AND MAINTENANCE MANUALS FOR ALL EQUIPMENT AND SYSTEMS INSTALLED.
 - B. MANUALS SHALL INCLUDE ALL RELEVANT INFORMATION NEEDED FOR DAY-TO-DAY OPERATION AND MANAGEMENT OF EACH SYSTEM AND EQUIPMENT MAINTENANCE INFORMATION REQUIRED TO SUPPORT THE MAINTENANCE PROGRAM.
 - C. MANUALS SHALL INCLUDE THE SEQUENCE OF OPERATION FOR EACH SYSTEM WHICH DESCRIBES THE CONTROL COMPONENTS AND HOW THE SYSTEM WILL START, STOP AND OPERATE.
14. INSULATION
 - A. PROVIDE ALL INSULATION MATERIALS (INSULATION, JACKETS, FITTING COVERS, ADHESIVES, CEMENTS, MASTICS, SEALERS AND FINISHES) WITH A FLAME-SPREAD INDEX OF 25 OR LESS AND SMOKE DEVELOPED INDEX OF 50 OR LESS, AS TESTED UNDER PROCEDURE ASTM E-84 (NFPA 255)
 - B. ALL INSULATION SHALL BE INSTALLED OVER CLEAN, DRY SURFACES. INSULATION MUST BE DRY AND IN GOOD CONDITION. ~~WET OR DAMAGED INSULATION IS NOT ACCEPTABLE.~~ NO INSULATION SHALL BE APPLIED PRIOR TO PRESSURE TEST COMPLETION OF THE RESPECTIVE SYSTEM.
 - C. ALL INSULATION SHALL BE CONTINUOUS (INCLUDING VAPOR BARRIER) THROUGH WALL AND CEILING OPENINGS AND SLEEVES. OVERLAP AT SEAMS PER MANUFACTURER'S RECOMMENDATIONS.
 - D. ALL INSULATION PRODUCTS SHALL BE APPLIED IN ACCORDANCE WITH MANUFACTURER'S WRITTEN RECOMMENDATION. THE WORKMANSHIP SHALL BE FIRST CLASS AND ALL JOINTS SHALL BE MADE TIGHT.
 - E. INSULATION MUST MEET ADOPTED ASHRAE 90.1 STANDARDS.
 - F. INSULATE CONCEALED SUPPLY AIR DUCTWORK WITH 2" THICK OWENS-CORNING FIBERGLASS DUCTWRAP WITH FOIL FACED ALL-SERVICE JACKET.
 - G. INSULATE SUPPLY AIR DUCTWORK LOCATED IN PLENUM SPACES WITH 1-1/2" THICK OWENS-CORNING FIBERGLASS DUCTWRAP WITH FOIL FACED ALL-SERVICE JACKET.
 - H. INSULATE OUTDOOR AIR DUCTWORK WITH 1-1/2" THICK OWENS-CORNING FIBERGLASS DUCTWRAP WITH FOIL FACED ALL-SERVICE JACKET.
 - I. INSULATE DUCT INSULATION SHALL BE USED ON EXPOSED DUCTWORK.
 - J. INSULATE SUPPLY AIR DUCTWORK DOWNSTREAM OF DUCT TERMINAL UNITS WITH 1-1/2" THICK OWENS-CORNING FIBERGLASS DUCTWRAP WITH FOIL FACED ALL-SERVICE JACKET.
 - K. REPAIR EXISTING INSULATION WHERE REMOVED FOR NEW CONNECTIONS OR INSULATION DAMAGED DURING CONSTRUCTION. INSULATION SHALL BE THE SAME AS SPECIFIED FOR NEW SERVICE.
 - L. ALL INSULATION USED AS PLENUM WRAP COVERING FOR COMBUSTIBLE MATERIALS IN A PLENUM SPACE SHALL BE 3M PLENUM PROTECTION SYSTEM (P-100-9), ONE LAYER OF 3M FIRE BARRIER DUCT WRAP-SA, IN ACCORDANCE WITH UL910 & UL1887.
 - M. ACOUSTICAL DUCT LINING:
 1. INTERNALLY LINE FIRST TEN FEET OF DUCTWORK FROM AIR HANDLERS AND TERMINAL UNITS AND WHERE INDICATED ON PLANS.
 2. FIBROUS GLASS, COMPLYING WITH THERMAL INSULATION MANUFACTURERS ASSOCIATION (TIMA) AHC-101.
 3. ASTM C 1071, TYPE II, WITH COATED SURFACE EXPOSED TO AIRSTREAM TO PREVENT EROSION OF GLASS FIBERS 1" THICK, 1- 1/2 LB. DENSITY. COATING MATERIAL SHALL BE ANTI-MICROBIAL AND COMPLY WITH NFPA 90A AND 90B.
 4. FACTORY EQUAL TO OR BETTER, AT MEAN TEMPERATURE OF 75 DEG. F.
 5. FLAME SPREAD INDEX SHALL BE 25 OR LESS AND SMOKE DEVELOPED INDEX SHALL BE 50 OR LESS, AS TESTED IN ACCORDANCE WITH ASTM C 411.
 6. DUCT LINING ADHESIVE SHALL COMPLY WITH ASTM C 916 SPECIFICATIONS FOR ADHESIVES FOR "DUCT THERMAL INSULATION." DUCT LINING FASTENERS ALL COMPLY WITH SMACNA DUCT CONSTRUCTION STANDARDS, ARTICLE S2.11
 - N. ALTERNATE: DUCT LINING MATERIAL - ARMACELL AP ARMAFLEX SA BLACK DUCT LINER, 3/4" THICK, MICROBAN ANTI-MICROBIAL PROTECTION.
15. METAL DUCTWORK
 - A. HVAC CONTRACTOR SHALL VERIFY ALL EXISTING CONDITIONS PRIOR TO FABRICATION OF DUCTWORK. ANY CONFLICTS OR INTERFERENCES SHALL BE BROUGHT TO THE ATTENTION OF THE ENGINEER.
 - B. GALVANIZED DUCTWORK SHALL BE FABRICATED OF NO 1 PRIME GALVANIZED SHEET METAL OF LOCK FORMING QUALITY.
 - C. SEALING MATERIALS SHALL BE SUITABLE FOR USE WITH AIR DISTRIBUTION DUCTWORK. ACCEPTABLE MANUFACTURERS ARE MONOCO INDUSTRIES, 3M, OR UNITED SHEET METAL.
 - D. PROVIDE ALL DUCTWORK AS INDICATED ON THE DRAWINGS, MAKING ALL NECESSARY OFFSETS (WHETHER OR NOT SPECIFICALLY INDICATED) AS REQUIRED TO MEET THE VARIOUS BUILDING CONDITIONS. DUCTWORK INSTALLATION SHALL NOT CONFLICT WITH EQUIPMENT OR PIPING.
 - E. EXPOSED DUCTWORK SHALL BE PRIMED AND PAINTED. COORDINATE WITH ARCHITECTURAL PLANS FOR COLOR SELECTION.
 - F. ALL CHANGES IN CROSS SECTION SHALL BE MADE WITHOUT REDUCING THE DESIGN AREA OF THE DUCT OR RAISING THE PRESSURE DROP PER 100 FEET OF DUCT SHOWN ON DOCUMENTS.
 - G. NO PIPE OR OTHER OBSTRUCTIONS SHALL PASS THROUGH AIR DUCTS, UNLESS SPECIFICALLY SHOWN ON PLANS.
 - H. CAP ALL OPEN ENDS TO DUCTWORK DURING CONSTRUCTION TO PREVENT ENTRANCE OF DUST, DEBRIS, MOISTURE ETC.
 - I. INSTALL DUCTWORK RUN ABOVE CEILING AS HIGH AS POSSIBLE SO AS TO MAINTAIN DESIGN CEILING HEIGHTS. EXPOSED DUCTWORK SHALL BE INSTALLED TO PROVIDE MAXIMUM HEADROOM OR AT HEIGHT SPECIFIED ON PLANS.
 - J. DUCTWORK SHALL NOT BE HUNG FROM EQUIPMENT, PIPING, CONDUIT, ROOF DECKING OR OTHER DUCTWORK.
 - K. ALL DUCTWORK JOINTS AND SEAMS SHALL BE AIR-TIGHT PER SMACNA TABLE 1.1. POORLY MADE JOINTS, SPLITS, VISIBLE HOLES AT CORNERS, ETC SHALL BE REWORKED AND REPAIRED. WHERE EXCESSIVE PULSATING OF DUCTWORK IS FOUND, ADDITIONAL STIFFENERS SHALL BE ADDED. ANY CRACKING IN THE SEALANT THAT IS APPARENT UPON INSPECTION SHALL BE SUFFICIENT TO WARRANT REJECTION.
 - L. IF THE INTERIOR OF SHEET METAL IS EXPOSED TO VIEW THROUGH AIR DISTRIBUTION DEVICES IN FINISHED AREAS OF THE BUILDING, IT SHALL BE COATED WITH PRIMER AND A FLAT BLACK FINISH COAT.
 - M. ALL DUCTWORK SHALL BE SUPPORTED PER SMACNA REQUIREMENTS.
 - N. RECTANGULAR DUCTWORK FITTINGS:
 1. BRANCH CONNECTIONS SHALL BE 45 DEGREE ENTRY. STRAIGHT TAPS ARE NOT PERMITTED.
 2. CHANGES IN DIRECTION SHALL BE MADE WITH FULL RADIUS ELBOWS WITH RADIUS EQUAL TO 1-1/2 TIMES THE HORIZONTAL WIDTH OF THE DUCT OR WITH SQUARE ELBOWS WITH TURNING VANES. TURNING VANES SHALL BE DOUBLE THICKNESS TYPE. CONSTRUCTED OF THE SAME MATERIAL AS THE SURROUNDING DUCTWORK, PER SMACNA REQUIREMENTS.
 - O. ROUND DUCTWORK FITTINGS:
 1. BRANCH CONNECTIONS SHALL BE MADE WITH 45 DEGREE ENTRY TEES.
 2. CHANGE IN DIRECTION SHALL BE MADE WITH FULL RADIUS ELBOWS WITH RADIUS EQUAL TO 1-1/2 TIMES THE DIAMETER OF THE DUCT.
 - P. LOW PRESSURE DUCTWORK SHALL BE CONSTRUCTED PER SMACNA "HVAC DUCT CONSTRUCTION STANDARDS" FOR 2 INCH STATIC PRESSURE, SEAL CLASS "B"
 - Q. HANGERS AND SUPPORTS
 1. PROVIDE GALVANIZED STEEL STRAPS, ALL-THREAD ROD AND HORIZONTAL ANGLE SUPPORTS SIZED PER SMACNA REQUIREMENTS.
 2. DUCT ATTACHMENTS SHALL BE MADE USING SHEET METAL SCREWS COMPATIBLE WITH DUCT MATERIALS.
 3. BUILDING ATTACHMENTS SHALL BE CONCRETE INSERTS OR STRUCTURAL STEEL FASTENERS APPROPRIATE FOR THE BUILDING MATERIALS. DO NOT USE POWER ACTIVATE CONCRETE FASTENERS. "C" TYPE MALLEABLE IRON BEAM CLAMPS ARE ACCEPTABLE ONLY IF USED WITH CARBON STEEL RETAINER STRAP.
16. FLEXIBLE DUCTWORK
 - A. TESTED AND CLASSIFIED BY UNDERWRITERS LABORATORIES, INC. AS CLASS 1 AIR DUCT AND LABELED IN ACCORDANCE WITH UL 181, STANDARD FOR AIR DUCTS. THE FLAME SPREAD RATING SHALL BE 25 OR LESS AND THE SMOKE DEVELOPED RATING SHALL BE 50 OR LESS.
 - B. LINER SHALL BE CONSTRUCTED OF ALUMINUM FOIL, FIBERGLASS AND ALUMINIZED POLYESTER, MECHANICALLY LOCKED WITHOUT ADHESIVES. HELIX SHALL BE GALVANIZED STEEL, FORMED AND MECHANICALLY LOCKED TO FABRIC.
 - C. WHERE DUCTWORK IS TO BE INSULATED, FLEXIBLE DUCTWORK LINER SHALL BE COVERED BY A FACTORY WRAPPED, 1-1/2" THICK, 3/4 POUND DENSITY FIBERGLASS INSULATION BLANKET WITH A FIRE RETARDANT REINFORCED ALUMINUM OUTER JACKET.
 - D. INSTALL FLEXIBLE DUCTWORK FULLY EXTENDED, FREE OF SAGS AND KINKS. MAXIMUM LENGTH OF FLEXIBLE DUCTWORK SHALL BE 50' FASTEN FLEXIBLE DUCTWORK TO RIGID DUCTWORK AND DEVICES WITH SELF-LOCKING 100 PERCENT NYLON, ADJUSTABLE DIAMETER CLAMPS.
 - E. ACCEPTABLE MANUFACTURERS ARE THERMAFLEX, FLEXMASTER U.S.A. INC. AND CLEVAFLX.
17. BALANCING DAMPERS
 - A. PROVIDE BALANCING DAMPERS FOR ALL AIR TERMINAL DEVICES (SUCH AS BUT NOT LIMITED TO, DIFFUSERS, REGISTERS, GRILLES, ETC.) AND BRANCH DUCTWORK REQUIRED FOR PROPER BALANCING OF SYSTEM.
 - B. ROUND DAMPERS SHALL BE SINGLE BLADE TYPE CONSTRUCTION, MINIMUM 18 GAUGE GALVANIZED STEEL. PIVOT ROD SHAFT SHALL BE CONTINUOUS.
 - C. RECTANGULAR DAMPERS SHALL BE SINGLE BLADE OR MULTIPLE (OPPOSED BLADE) TYPE CONSTRUCTION. MAXIMUM BLADE WIDTH IS 8 INCHES.
 - D. ALL BALANCING DAMPERS SHALL BE CONSTRUCTED IN ACCORDANCE WITH SMACNA "HVAC DUCT CONSTRUCTION STANDARDS"
 - E. FURNISH ALL BALANCING DAMPERS WITH YOUNG REGULATOR COMPANY VALCALOX REGULATORS WITH HANDLE PERMANENTLY ATTACHED. DAMPER HANDLE POSITION SHALL BE SECURELY LOCKED IN PLACE BY TIGHTENING OF A LOCK NUT. WHERE DUCTWORK IS EXTERNALLY INSULATED, REGULATOR BASE HEIGHT SHALL ACCOMMODATE INSULATION THICKNESS.
 - F. PROVIDE ALL MANUAL BALANCING DAMPERS WHERE INDICATED ON THE DRAWINGS AND WHERE NECESSARY TO PROPERLY DISTRIBUTE AND BALANCE THE AIR.
18. REGISTERS, GRILLES AND DIFFUSERS
 - A. PROVIDE REGISTERS, GRILLES AND DIFFUSERS WHERE SHOWN ON THE DRAWINGS, OF SIZE, TYPE, AND MATERIAL AS INDICATED AND AS REQUIRED FOR A COMPLETE INSTALLATION.
 - B. BORDER TYPES SHALL BE COMPATIBLE WITH THE CEILINGS WHERE THE GRILLES AND DIFFUSERS ARE TO BE INSTALLED.
 - C. ALL GRILLES AND DIFFUSERS SHALL BE FINISHED WITH A FACTORY APPLIED OFF-WHITE FINISH UNLESS NOTED OTHERWISE.
 - D. REFER TO ARCHITECTURAL REFLECTED CEILING PLANS FOR EXACT LOCATION OF GRILLES AND DIFFUSERS.
19. VIBRATION ISOLATION
 - A. PROVIDE ADEQUATE VIBRATION ISOLATION FOR EACH PIECE OF EQUIPMENT.
 - B. PROVIDE FLEXIBLE CONNECTIONS WITH 1" SLACK BETWEEN DUCTS AND FANS AS MANUFACTURED BY DURO-DYNE, OR EQUIVALENT.
 - C. PROVIDE FLEXIBLE FITTING ON PIPING CONNECTIONS TO EQUIPMENT.
20. REFRIGERATION AND AIR CONDITIONING CONDENSATE PIPING SYSTEMS
 - A. USE TYPE DNY COPPER PIPING WITH BRAZED DRAINAGE FITTINGS FOR CONDENSATE PIPING.
 - B. USE TYPE ACR COPPER PIPING WITH BRAZED WROUGHT COPPER FITTINGS FOR ALL REFRIGERATION PIPING.
 - C. PITCH PUMPED AND GRAVITY CONDENSATE PIPING AT 1/8 INCH PER FOOT IN DIRECTION OF FLOW.
 - D. INSULATE ALL INTERIOR CONDENSATE PIPING AND REFRIGERATION SUCTION PIPING WITH 3/4 INCH ARMACELL CLOSED CELL SELF SEALING ARMAFLEX INSULATION.
21. EXHAUST FANS
 - A. CEILING MOUNTED DIRECT DRIVE CENTRIFUGAL EXHAUST VENTILATOR. FANS SHALL BE UL LISTED AND BEAR THE AMCA CERTIFIED RATING SEAL FOR SOUND AND AIR PERFORMANCE.
 - B. ALL FASTENERS SHALL BE CORROSION RESISTANT. ALUMINUM BASE SHALL HAVE CONTINUOUSLY WELDED CURB CAP CORNERS. MOTOR, BEARINGS AND DRIVE SHALL BE MOUNTED ON A STEEL ASSEMBLY, ISOLATED FROM THE FAN STRUCTURE WITH RUBBER VIBRATION ISOLATORS.
 - C. WHEEL SHALL BE CENTRIFUGAL BACKWARD INCLINED TYPE, CONSTRUCTED OF ALUMINUM, WITH A MACHINED CAST ALUMINUM HUB.
 - D. MOTOR SHALL BE HEAVY DUTY TYPE WITH PERMANENTLY LUBRICATED SEALED BALL BEARINGS.
 - E. FAN BEARINGS SHALL BE HEAVY DUTY REGREASABLE BALL TYPE WITH A CAST IRON HOUSING, RATED IN EXCESS OF 200,000 HOURS AT MAXIMUM CATALOGED OPERATING SPEED.
 - F. BELTS SHALL BE OIL AND HEAT RESISTANT, NON-STATIC TYPE. DRIVES SHALL BE MACHINED CAST IRON, KEYS AND SECURELY ATTACHED TO WHEEL AND MOTOR SHAFTS AND SIZED FOR 150 PERCENT OF THE INSTALLED MOTOR HORSEPOWER.
 - G. ACCEPTABLE MANUFACTURERS: BROAN, PENN VENTILATOR, COOK GREENHECK AND ACME.

22. EXTERIOR LOUVERS
 - A. EXTRUDED ALUMINUM ALLOY FRAME AND DRAINABLE BLADES. ALUMINUM BIRD SCREEN. MILL FINISH.
 - B. ACCEPTABLE MANUFACTURERS: RUSKIN, GREENHECK.
23. MOTOR OPERATED DAMPERS
 - A. GALVANIZED STEEL, LOW LEAKAGE CONTROL, DAMPERS WITH 1/4 GAUGE REINFORCED GALVANIZED STEEL HAT CHANNEL FRAME. BLADES SHALL BE 1/4 GAUGE REINFORCED SINGLE SKIN GALVANIZED STEEL.
 - B. EDGE SEALS SHALL BE PVC COATED POLYESTER FABRIC MECHANICALLY LOCKED INTO THE BLADE EDGE. ADHESIVE OR CLIP-ON STYLES ARE NOT ACCEPTABLE.
 - C. JAMB SEALS SHALL BE FLEXIBLE METAL, COMPRESSION TYPE TO PREVENT LEAKAGE BETWEEN BLADE END AND DAMPER FRAME. BLADE END OVERLAPPING FRAME IS UNACCEPTABLE.
 - D. BEARINGS SHALL BE CORROSION RESISTANT. AXLES SHALL BE SQUARE OR HEXAGONAL POSITIVELY LOCKED INTO THE DAMPER BLADE. LINKAGE SHALL BE OUT OF THE AIRSTREAM.
 - E. DAMPER ACTUATORS SHALL BE FURNISHED AND INSTALLED BY THE TEMPERATURE CONTROL CONTRACTOR.
 - F. ACCEPTABLE MANUFACTURERS: RUSKIN, GREENHECK.
24. TEMPERATURE CONTROLS
 - A. ALL TEMPERATURE CONTROL COMPONENTS, WIRING AND CONDUIT SHALL BE THE RESPONSIBILITY OF THE HVAC CONTRACTOR.
 - B. WIRING AND CONDUIT
 1. ALL 24 VOLT WIRING SHALL BE INSTALLED IN CONDUIT, IN ACCORDANCE WITH THE LATEST EDITION OF THE NATIONAL ELECTRIC CODE.
 2. ALL OUTDOOR 24 VOLT WIRING SHALL BE INSTALLED IN CONDUIT, IN ACCORDANCE WITH THE LATEST EDITION OF THE NATIONAL ELECTRIC CODE.
 - C. HVAC CONTRACTOR SHALL USE BUILDING APPROVED TEMPERATURE CONTROL CONTRACTOR AND MANUFACTURER.
25. PROJECT COMPLETION:
 - A. UPON COMPLETION OF PROJECT THIS CONTRACTOR SHALL PROVIDE NEW FILTERS WITHIN ALL FAN POWERED EQUIPMENT.
 - B. ALL FAN POWERED EQUIPMENT SHALL HAVE THEIR EXTERIOR CLEANED WITH A MILD SOAP AND WATER SOLUTION AND THOROUGHLY DRIED.
 - C. PROVIDE 3 COPIES OF FINAL TEST AND BALANCE REPORT TO OWNER/ARCHITECT.

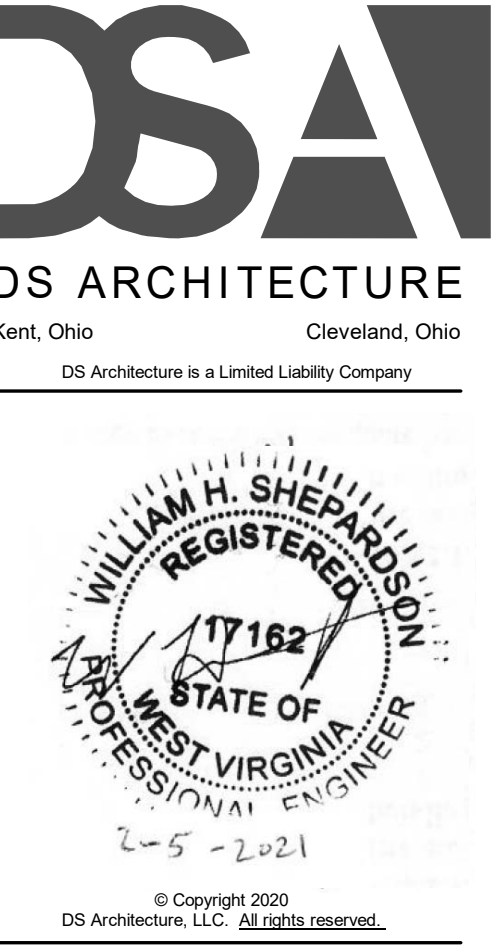

© Copyright 2021 DS Architecture, LLC. All rights reserved.

NVA Paw Prints Vet Clinic
 Lot 7E of the Gateway Development
 Westover, West Virginia 26501




Issue Description:
BIDDING & PERMITTING


Revision Schedule	#	DATE	DESCRIPTION
1	2/22/2021	Addendum 1	

Project #: 20053
 Issue Date: 2/5/2021


M0.00

HVAC SPECIFICATIONS

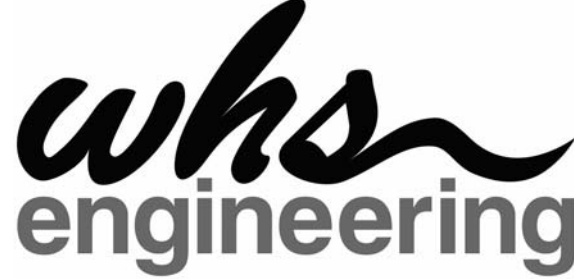


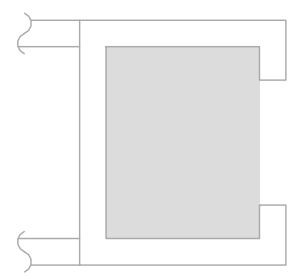


FOR ROOMS OR AREAS SHOWN SHADDED WITH THE SHADE TYPE UNDER NO CIRCUMSTANCES, SHALL PIPING, DUCTWORK, OR EQUIPMENT BE INSTALLED IN OR ROUTED THROUGH THESE ROOMS OR AREAS EXCEPT FOR BRANCH PIPING OR DUCTWORK SPECIFICALLY SERVING THE ROOM OR AREA. DEDICATED SPACE SHALL EXTEND VERTICALLY FROM FLOOR TO STRUCTURAL CEILING.

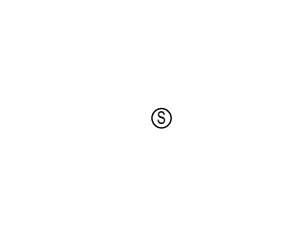


DUCT-TYPE SMOKE DETECTOR WITH REMOTE TEST STATION AND AUXILIARY RELAY FURNISHED AND WIRED BY ELECTRICAL CONTRACTOR. INSTALLED IN DUCTWORK BY MECHANICAL CONTRACTOR PER CODE. COORDINATE EXACT LOCATION WITH MECHANICAL CONTRACTOR AND MANUFACTURER. PROVIDE CONDUIT AND WIRING NECESSARY TO SHUT DOWN HVAC UNIT UPON ACTIVATION OF SMOKE DETECTOR.

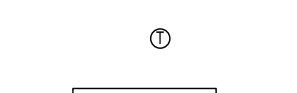


THERMOSTAT

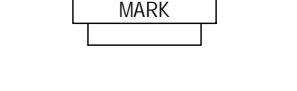

EQUIPMENT TAG

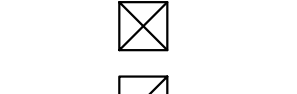

SUPPLY OR OUTDOOR AIR DUCT

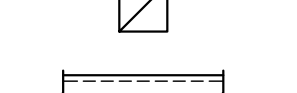


RETURN OR EXHAUST AIR DUCT



DUCT LINING



DUCT UP

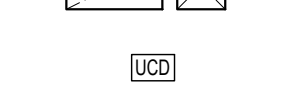

DUCT DOWN




3/4" DOOR UNDERCUT



AIRFLOW DIRECTION


HVAC LEGEND

NO SCALE

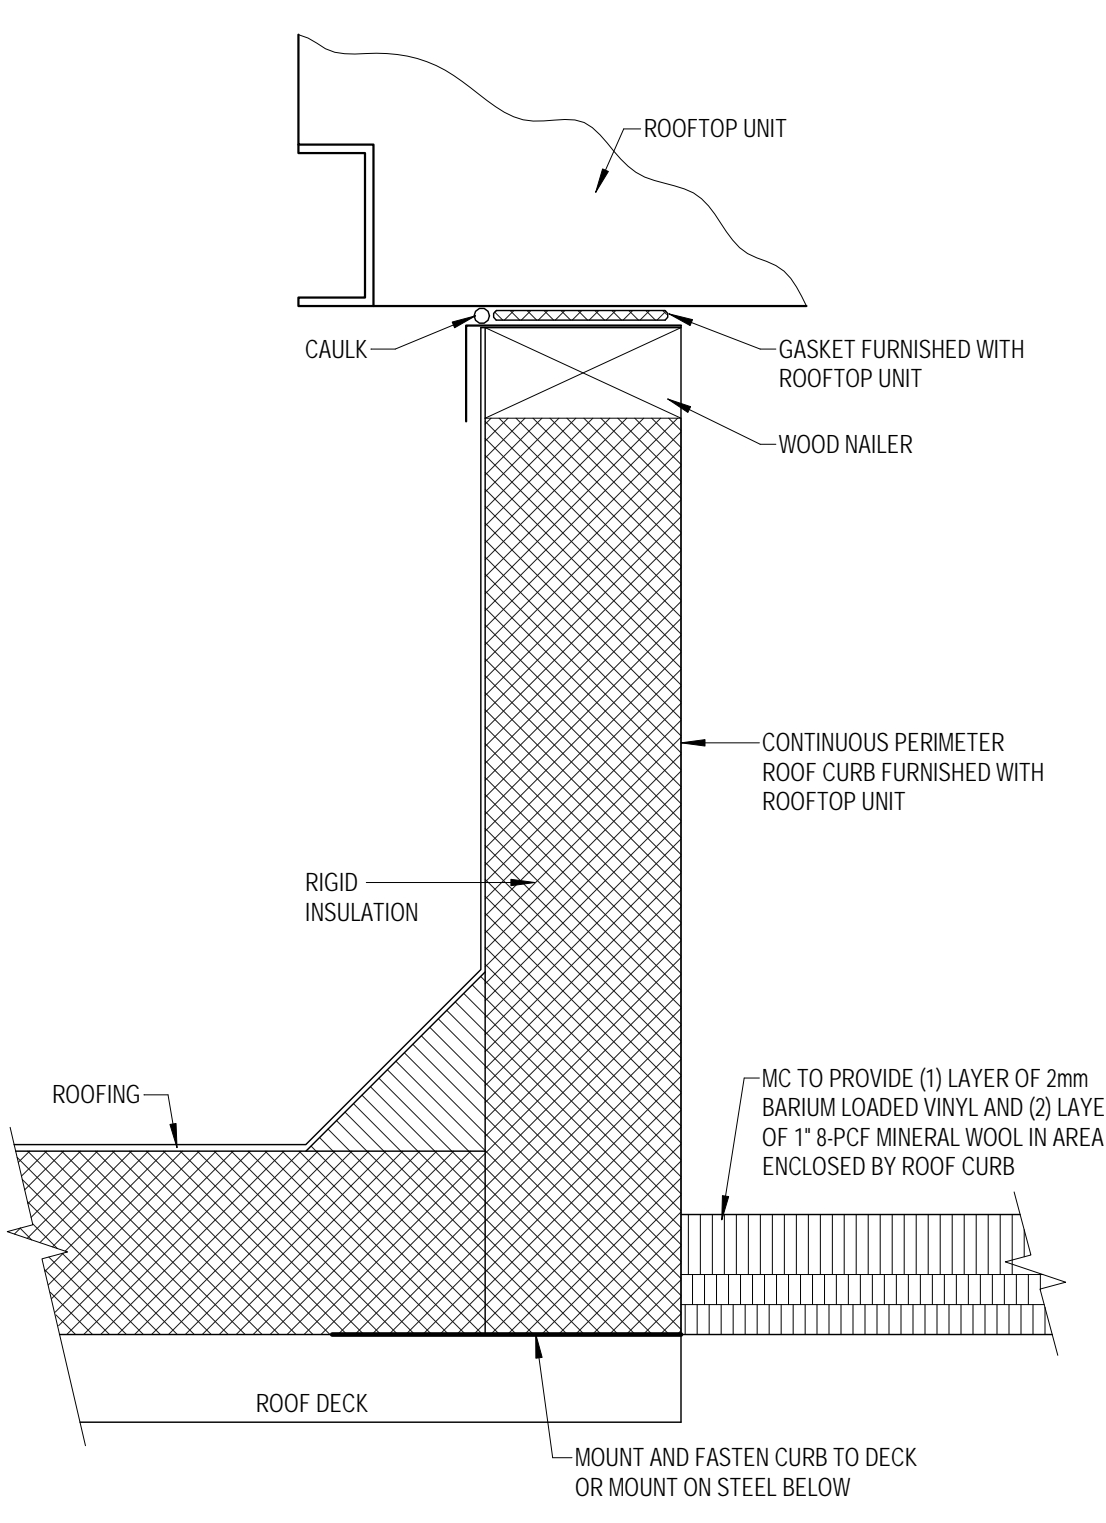


ROOFTOP UNIT MOUNTING DETAIL

NO SCALE

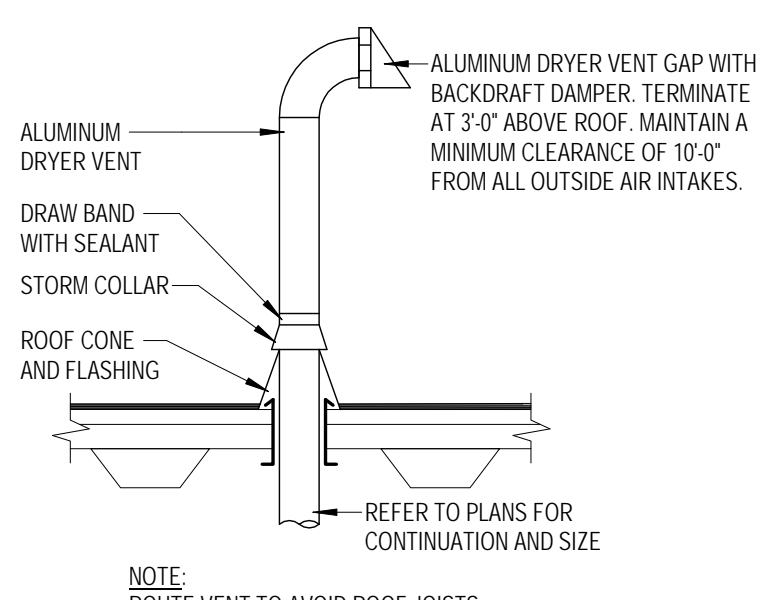


DRYER VENT THROUGH ROOF DETAIL

NO SCALE

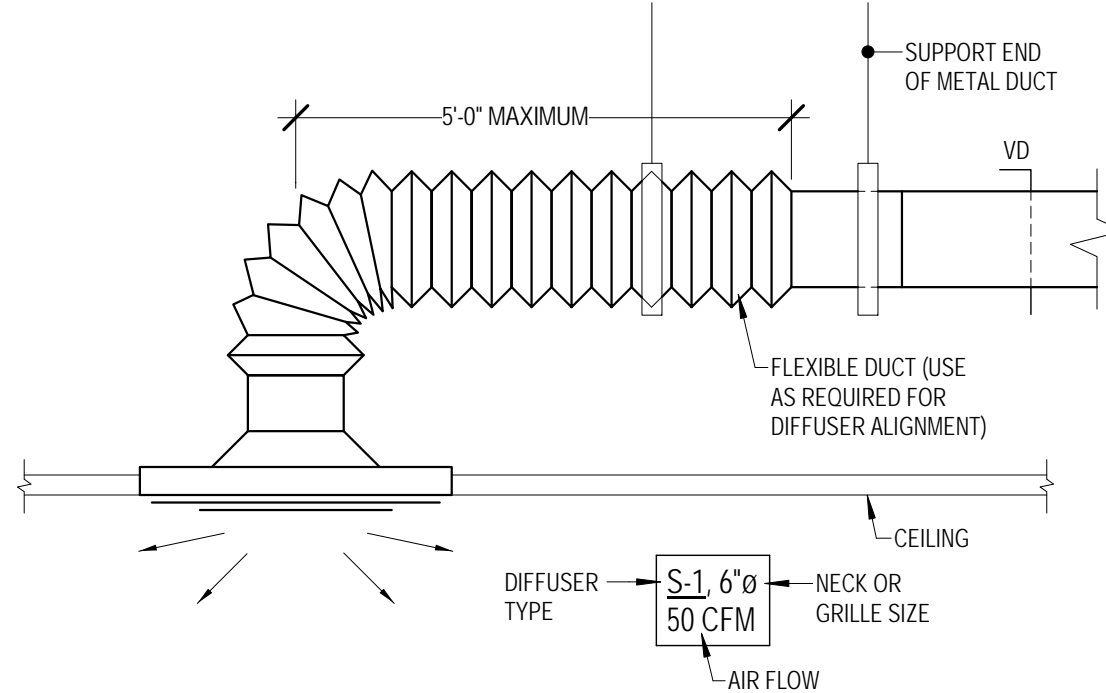


CEILING DIFFUSER WITH FLEX CONNECTION DETAIL

NO SCALE

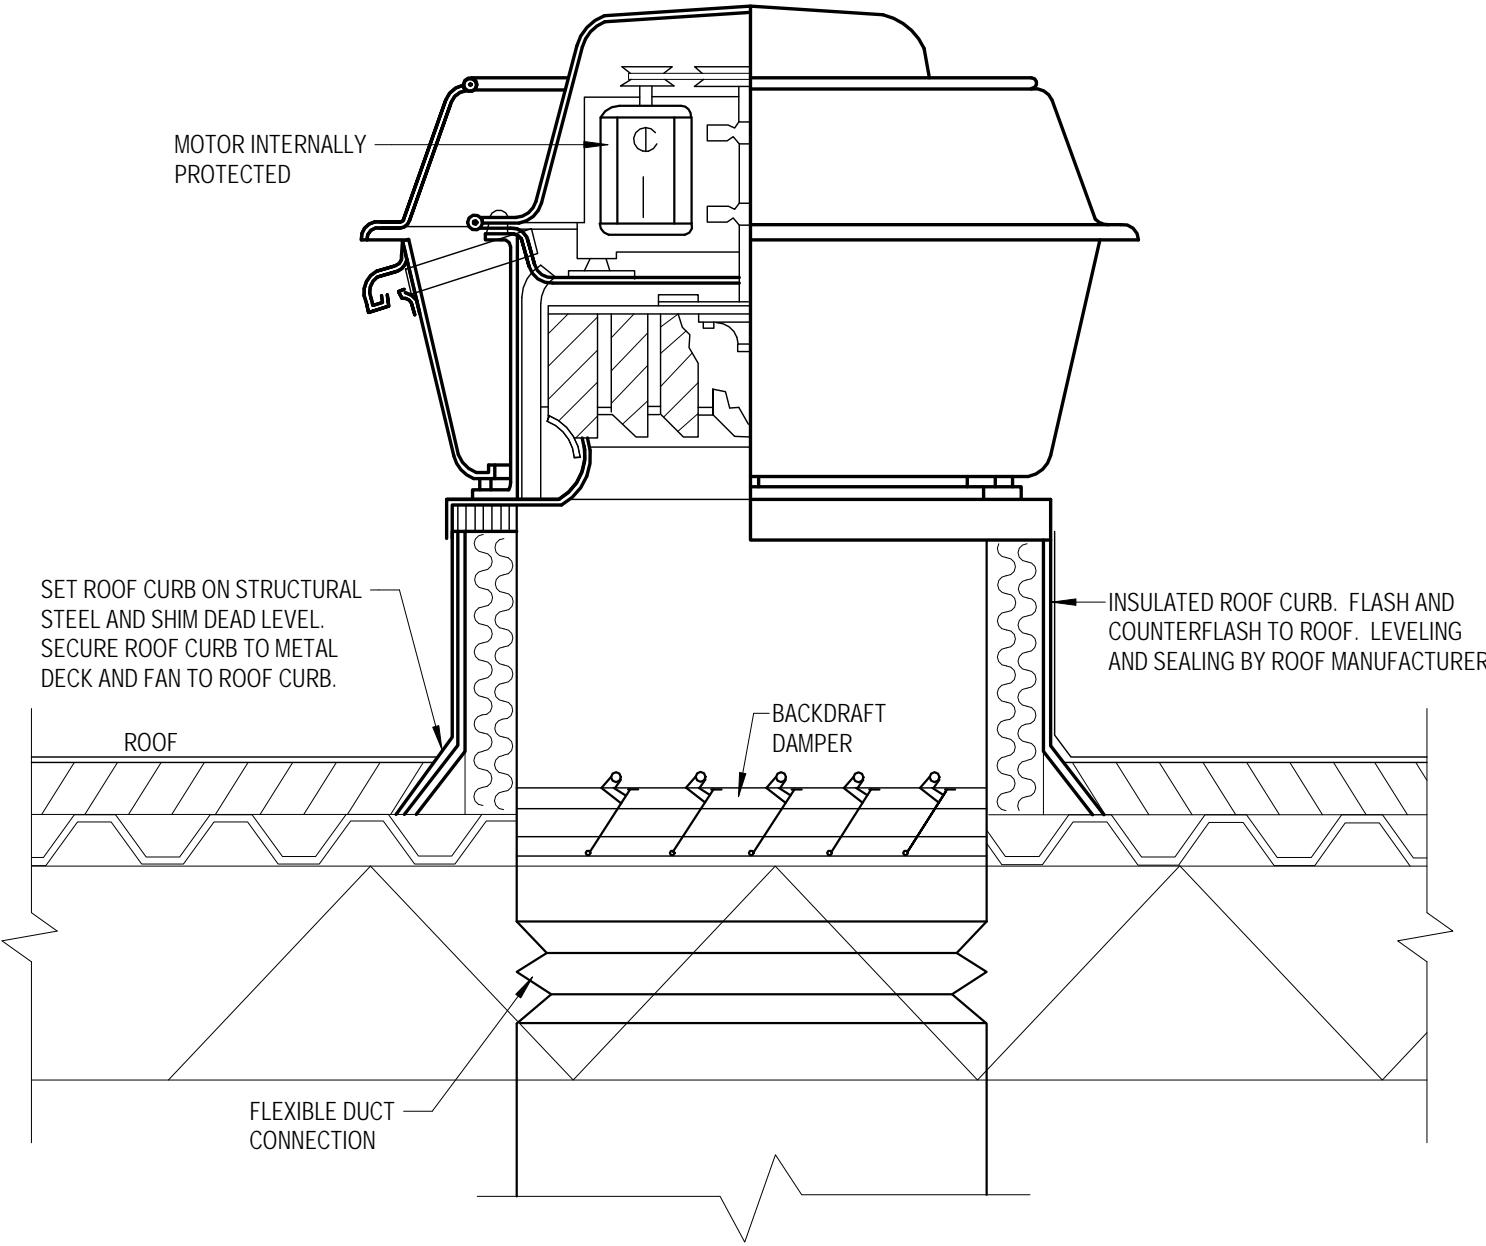

ROOF EXHAUST FAN DETAIL

NO SCALE

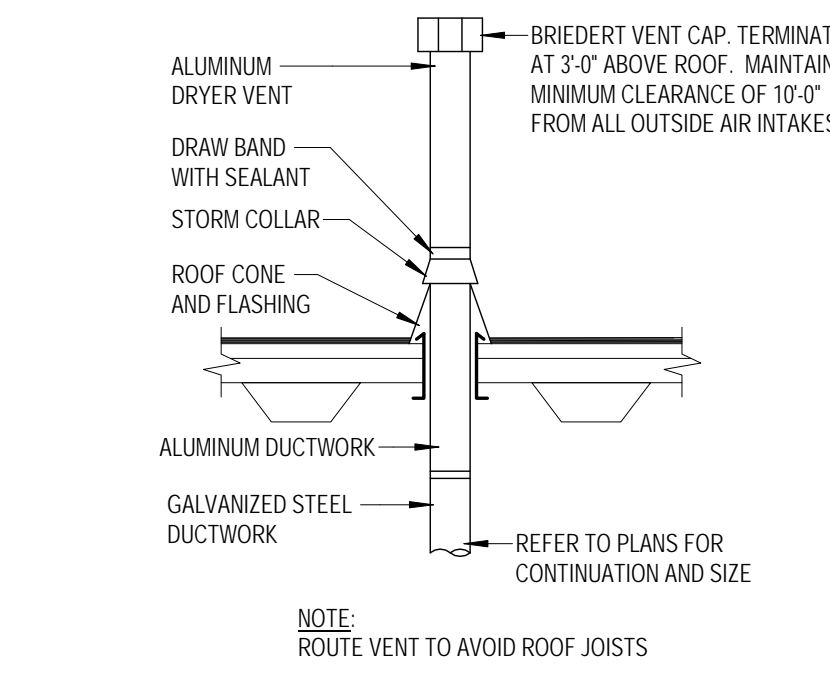

EXHAUST VENT THROUGH ROOF DETAIL

NO SCALE

HVAC GENERAL NOTES:

- GENERAL NOTES SHALL APPLY TO ALL HVAC DRAWINGS.
- ALL KEY NOTES INDICATED ON THE DRAWINGS AS "TYPICAL" ARE TO BE CONSIDERED AS SHOWN AT ALL OTHER SIMILAR CONDITIONS WHETHER NOTED OR NOT.
- ALL HVAC WORK SHALL BE COMPLETE AND READY FOR SATISFACTORY SERVICE.
- THE CONTRACT DRAWINGS ARE DIAGRAMMATIC AND ARE INTENDED TO CONVEY THE GENERAL ARRANGEMENT OF THE WORK.
- THE CONTRACTOR IS RESPONSIBLE FOR THE MEANS, METHODS, AND WORK SCHEDULING ASSOCIATED WITH THE INSTALLATION OF THE HVAC SYSTEMS.
- EXAMINE THE SITE AND OBSERVE THE CONDITIONS UNDER WHICH THE WORK WILL BE INSTALLED. NO ALLOWANCES WILL BE MADE FOR ERRORS OR OMISSIONS RESULTING FROM THE FAILURE TO COMPLETELY EXAMINE THE SITE.
- VERIFY SIZE AND LOCATIONS OF ALL EXISTING SERVICES. NOTIFY THE ENGINEER OF ALL DISCREPANCIES THAT EXIST BETWEEN THE CONTRACT DOCUMENTS AND THE EXISTING SERVICES BEFORE MAKING ANY CONNECTIONS TO THE EXISTING SERVICES.
- COORDINATE THE SIZE AND LOCATION OF ROOF PENETRATIONS AND FLASHING REQUIREMENTS WITH THE WORK OF OTHER TRADES.
- ROUTE PIPING AND DUCT SYSTEMS PARALLEL AND PERPENDICULAR TO THE BUILDING LINES. MOUNT AS CLOSE AS POSSIBLE TO THE UNDERSIDE OF THE BUILDING STRUCTURE.
- COORDINATE THE INSTALLATION OF HVAC SYSTEMS WITH THE WORK OF OTHER TRADES. PROVIDE OFFSETS IN PIPING AND DUCTWORK AS REQUIRED AT NO ADDITIONAL COST TO AVOID OBSTRUCTIONS.
- MOUNT ROOM SENSORS AND SWITCHES AT 4'-0" ABOVE FINISHED FLOOR UNLESS NOTED OTHERWISE.
- SUPPORT ALL EQUIPMENT FROM THE BUILDING STRUCTURE TO PROVIDE A VIBRATION-FREE INSTALLATION.
- DUCTWORK DIMENSIONS SHOWN ON THE DRAWINGS ARE INTERNAL AIRFLOW DIMENSIONS. INCREASE THE SHEET METAL DUCTWORK DIMENSIONS BY 2 IN. TO ACCOMMODATE 1-IN. DUCT LINER WHERE REQUIRED.
- PROVIDE FLEXIBLE DUCT CONNECTORS ON ALL DUCTWORK CONNECTIONS TO FANS OR AIR HANDLING UNITS.
- PROVIDE 1/2-IN. MESH ALUMINUM SCREEN OVER THE OPENING OF ALL OPEN-ENDED DUCTWORK. ENSURE THAT ADEQUATE CLEARANCE EXISTS FOR THE INSTALLATION AND MAINTENANCE OF ALL WORK SHOWN ON THE DRAWINGS AND DESCRIBED IN THE SPECIFICATIONS.
- PROVIDE ACCESS PANELS (INSTALLED IN WALLS OR CEILINGS) AND/OR ACCESS DOORS (INSTALLED IN DUCTWORK) THAT ARE INDICATED OR REQUIRED FOR ACCESS TO CONCEALED HVAC DEVICES THAT MAY REQUIRE FUTURE INSPECTION, REPAIR, OR ADJUSTMENT.
- IDENTIFY ALL HVAC EQUIPMENT WITH ENGRAVED, COLOR-CODED LAMINATED PLASTIC MARKERS WITH CONTACT-TYPE, PERMANENT ADHESIVE. MATCH EQUIPMENT SCHEDULES ON THE DRAWINGS AS CLOSELY AS POSSIBLE FOR EQUIPMENT DESIGNATIONS.
- PROVIDE SLEEVES AND CAULK ALL PIPING PENETRATIONS THROUGH WALLS AND FLOORS AND PATCH TO MATCH THE ADJACENT CONSTRUCTION. PROVIDE CHROME-PLATED ESCUTCHEONS ON ALL PIPING PENETRATIONS IN EXPOSED LOCATIONS.
- PROVIDE SLEEVES AND PATCH ALL DUCT PENETRATIONS THROUGH WALLS AND FLOORS TO MATCH THE EXISTING CONSTRUCTION. SLEEVE DIMENSIONS SHALL BE 1 IN. LARGER THAN INSULATED DUCT DIMENSIONS. THE SPACE BETWEEN THE DUCT AND THE SLEEVE SHALL BE PACKED WITH MINERAL FIBER AND CAULKED.
- FIRESTOP ALL PENETRATIONS THROUGH FIRE-RESISTANCE-RATED WALLS, FLOORS, OR ASSEMBLIES IN ACCORDANCE WITH THE APPLICABLE CODES AND STANDARDS.
- SEAL ALL PENETRATIONS THROUGH WATERPROOF CONSTRUCTION IN ACCORDANCE WITH THE WATERPROOFING MANUFACTURER'S INSTRUCTIONS. ALL WORK SHALL BE PERFORMED BY APPROVED CONTRACTORS IF REQUIRED BY THE MANUFACTURER TO MAINTAIN THE WARRANTY ON THE MATERIAL.
- PROVIDE ALL LOW PRESSURE DUCTWORK SIZED EQUAL TO OR LESS THAN 0.1" W.G./100' (TYP.) UNLESS SCHEDULED OTHERWISE. INDICATE ALL DUCT SIZES ON SHOP DRAWINGS.
- PROVIDE MINIMUM DUCT RADIUS ON ELBOWS AT 1-1/2 TIMES DUCT SIZE.
- ALL DUCTS SHALL BE FREE FROM CONTACT WITH ALL PIPING, WALLS, ELECTRICAL CONDUITS, CEILING SUSPENSION SYSTEMS, ETC.
- PROVIDE THROAT WITH PROPORTIONAL SPLIT AND TURNING VANES ON TEE TRANSITIONS. (BULLHEAD TEE'S WILL NOT BE PERMITTED.)
- ALL PIPING AND DUCTWORK SHALL FREELY PASS THROUGH ALL WALLS AND FLOORS WITHOUT RIGID CONNECTIONS. PENETRATION POINTS SHALL BE SLEEVED TO ALLOW PASSAGE OF PIPING OR DUCTWORK AND MAINTAIN 3/4" TO 1-1/4" CLEARANCE AROUND THE OUTSIDE SURFACES. THIS CLEARANCE SHALL BE TIGHTLY PACKED WITH ONE POUND DENSITY GLASS FIBER, AND CAULKED AIR TIGHT WITH NON-HARDENING SEALANT AFTER INSTALLATION OF PIPING OR DUCTWORK.
- PROVIDE FIRE DAMPERS WITH ACCESS IN ALL RATED WALLS IN ACCORDANCE WITH LOCAL CODES.
- FABRICATE, INSTALL, SEAL, AND INSULATE ALL DUCTWORK IN STRICT CONFORMANCE WITH THE REQUIREMENTS OF THE STATE MECHANICAL CODE AND ASME STANDARDS.
- ALL EQUIPMENT, MATERIALS AND WORK SHALL CONFORM TO THE APPLICABLE CODES OF THE STATE BUILDING, FIRE, MECHANICAL, AND NATIONAL ELECTRICAL CODES AS ADOPTED BY THE CITY AND ALL OTHER CODES. SAFETY ORDERS AND REGULATIONS AS ENFORCED BY THE STATE AND CITY FIRE MARSHALLS PERTAINING TO THIS PROJECT.
- PROTECTIVE BARRIERS SHALL BE INSTALLED IN FRONT OF EQUIPMENT WHERE EQUIPMENT IS SUBJECT TO MECHANICAL DAMAGE.
- SUITABLE OPENINGS WITH TIGHTLY FITTED COVERS SHALL BE PROVIDED TO MAKE FIRE DAMPERS ACCESSIBLE FOR INSPECTION.
- ACCESSIBILITY: ALL EQUIPMENT SHOWN IN WALLS OR ABOVE NON-ACCESSIBLE CEILINGS SHALL BE INSTALLED WITHIN 24" OF, AND BEHIND, AN ACCESS PANEL.
- SPECIFICATION: THESE DRAWINGS SHALL BE READ IN CONJUNCTION WITH, AND BE CONSIDERED TO BE A PART OF THE SPECIFICATIONS.
- PATCHING THE CONTRACT SHALL BE RESPONSIBLE FOR PATCHING AND REPAIRING ALL AREAS WHICH ARE EXCAVATED AND/OR DAMAGED BY HIS OPERATIONS.

ROOFTOP UNIT SCHEDULE (GAS HEAT)

MARK	NOMINAL TONS	CFM	MIN. OUTSIDE AIR CFM	EXTERNAL STATIC PRESSURE (W/C)	SUPPLY FAN (BHP)	ELECTRICAL VOLT. PH. MCA. MOCP	COOLING CAPACITY TOTAL (MBH) SENSIBLE (MBH) INPUT (MBH) OUTPUT (MBH)	HEATING CAPACITY (MBH)	MANUFACTURER	MODEL	EER	SEER	WEIGHT (LBS)	REMARKS
RTU 1	6	2100	675	1.0	1.0	208 3 32.00 45	73.2 56.4 150 120	LENNOX	LGH074HHE	12.0	-	979	1-14	
RTU 2	6	2100	675	1.0	1.0	208 3 32.00 45	73.2 56.4 150 120	LENNOX	LGH074HHE	12.0	-	979	1-14	
RTU 3	5	2000	500	1.0	1.0	208 3 33.00 45	60.1 46.3 150 120	LENNOX	LGH069HHE	12.7	17.1	932	1-13	

GRILLE AND DIFFUSER SCHEDULE

MARK	QTY.	MANUFACTURER	MODEL	DAMPER	FRAME/BORDER	MODULE SIZE	PATTERN	FINISH	REMARKS
SUPPLY									
S-1	36	TITUS	OMNI	OBD	LAY-IN	24"x24"	4-WAY THROW	WHITE	-
S-2	7	TITUS	OMNI	OBD	SURFACE	24"x24"	4-WAY THROW	WHITE	-
S-3	1	TITUS	FL-10	OBD	SURFACE	1-SLOT	LINEAR	WHITE	1
RETURN									
R-1	20	TITUS	300RL	-	LAY-IN	AS NOTED	35° DEFLECTION	WHITE	-
R-2	2	TITUS	300RL	-	SURFACE	AS NOTED	35° DEFLECTION	WHITE	-
EXHAUST									
E-1	3	TITUS	300RL	-	LAY-IN	AS NOTED	35° DEFLECTION	WHITE	-

FAN SCHEDULE


MARK	QTY.	SERVICE	CFM	STATIC PRESSURE (W/C)	RPM	SONES	HP or WATTS	VOLT.	PH.	MANUFACTURER	MODEL	WEIGHT (LBS)	REMARKS
EF 1	1	112- PUBLIC RESTROOM	100	0.3	1075	2.0	39.2	120	1	COOK	GC-148	12	1,2,5,6
EF 2	1	115- STAFF RESTROOM	100	0.3	1075	2.0	39.2	120	1	COOK	GC-148	12	1,2,5,6
EF 3	1	135- STAFF RESTROOM	100	0.3	1075	2.0	39.2	120	1	COOK	GC-148	12	1,2,5,6
EF 4	1	DOG WARD, ISO, CAT WARD	650	0.5	1725	7.0	116	120		GREENHECK	G-095-VG	50	1-4,6
EF 5	1	135- STAFF RESTROOM	100	0.3	1075	2.0	39.2	120	1	COOK	GC-148	12	1,2,5,6
EF 6	1	133- CUSTODIAL	50	0.3	1075	2.0	39.2	120	1	COOK	GC-148	12	1,2,5,6
EF 7	1	111- CUSTODIAL	50	0.3	1075	2.0	39.2	120	1	COOK	GC-148	12	1,2,5,6

ELECTRIC CABINET UNIT HEATER SCHEDULE

MARK	QTY.	SERVICE	CFM	MBH	ELECTRICAL KW VOLT. PH. MCA. MOCP	MANUFACTURER	MODEL	WEIGHT (LBS)	REMARKS
CUH A	1	DOG WARD	250	27.3	8.0 208 3 29.00 30	QMARK	CU935	120	1-4
CUH B	1	VESTIBULE	500	34.1	10.0 208 3 29.00 30	QMARK	CU945	160	1-4


SPLIT SYSTEM HEAT PUMP SCHEDULE

MARK	NOMINAL TONS	RATED COOLING CAPACITY (MBH)	RATED HEATING CAPACITY (MBH)	CFM RANGE	ELECTRICAL VOLT. PH. MCA. MOCP	SEER	MANUFACTURER	MODEL	REMARKS
AH 1	0.75	-	-	194-459	208 1 0.00 0	23.5	LG	LSN09HVS5	3
HP 1	0.75	9.0	10.9	-	208 1 10.00 15	23.5	LG	LSU09HVS5	1,2,4,5

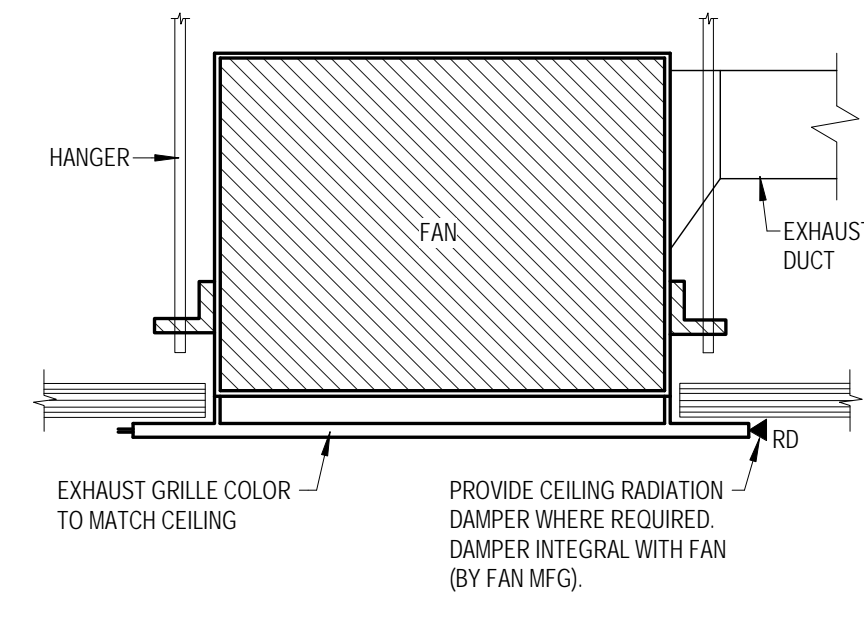


CEILING/SUSPENDED FAN DETAIL

NO SCALE

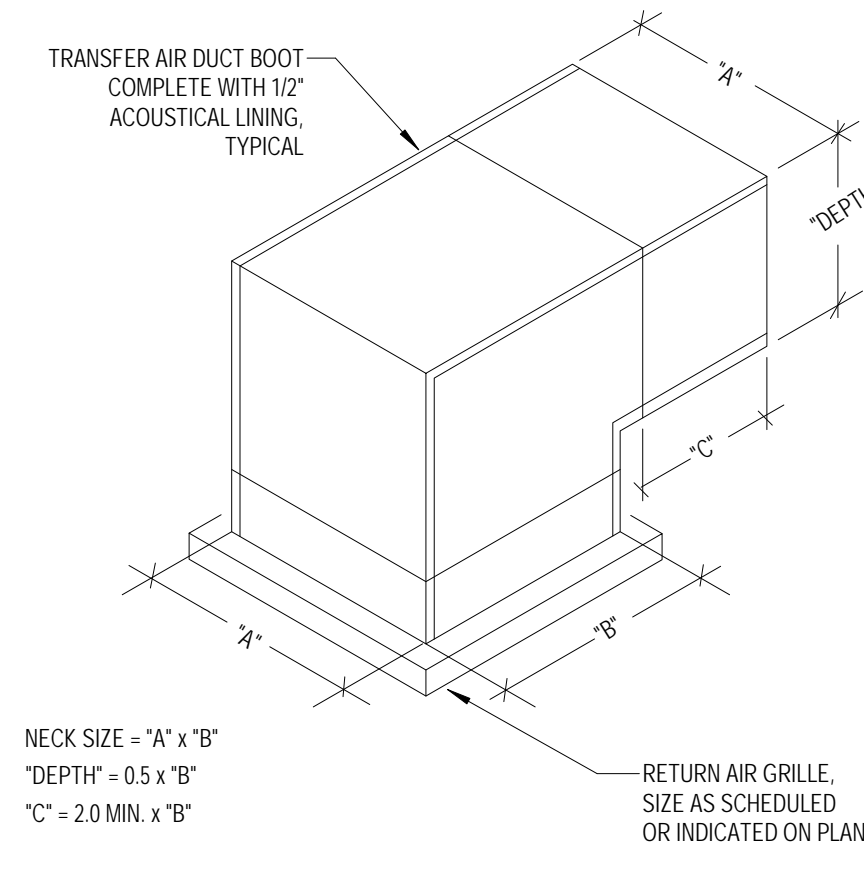

TRANSFER AIR DUCT BOOT DETAIL

NO SCALE

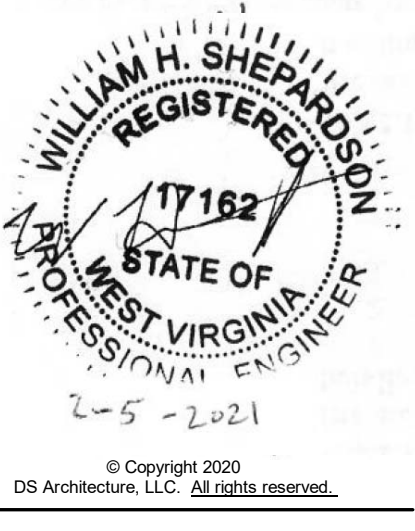



Issue Description:
BIDDING & PERMITTING
Revision Schedule
DATE DESCRIPTION
1 2/22/2021 Addendum 1

Project #: 20053
Issue Date: 2/5/2021


M0.01

HVAC SCHEDULES AND DETAILS

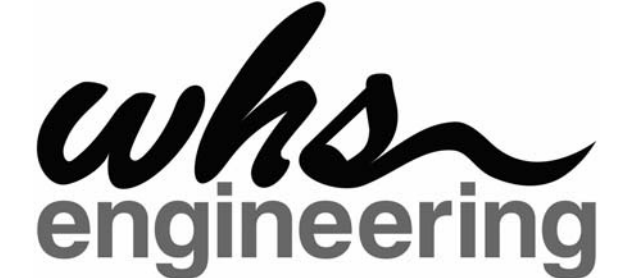

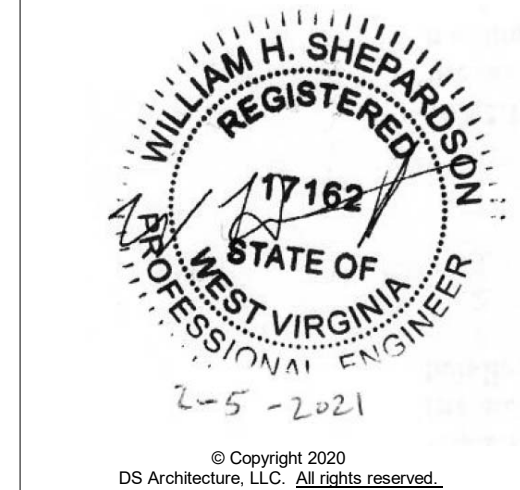

- CODED NOTES:**
1. PROVIDE AND INSTALL GAS FIRED ROOFTOP UNIT MOUNTED ON 14" CURB. COORDINATE EXACT UNIT LOCATION WITH OWNER AND STRUCTURAL ENGINEER PRIOR TO BID. PROVIDE SHET METAL OFFSETS TO MATCH FINAL UNIT LOCATION. PROVIDE FLEXIBLE CONNECTIONS AT UNIT SUPPLY AND RETURN DUCT CONNECTIONS. OFFSET DUCTWORK AS REQUIRED TO AVOID STRUCTURE. PROVIDE CPVC CONDENSATE TRAP WITH CLEANOUT PLUG. DRAIN ON ROOF WITH 4" TRAP AND VENT. SEE DETAIL ON SHEET M0.01 FOR MORE INFORMATION.
 2. MECHANICAL CONTRACTOR TO MOUNT SMOKE DETECTOR REMOTE KEY STATUS AND TEST STATIONS (WITH AUDIO AND VISUAL ALARM). MECHANICAL CONTRACTOR TO INDICATE DETECTOR SERVING ROOFTOP UNIT. COORDINATE EXACT LOCATION WITH FIRE MARSHAL PRIOR TO ROUGH-IN. ALL WIRING SHALL BE BY ELECTRICAL CONTRACTOR IN CONDUIT PER N.E.C. REMOTE STATION SHALL BE A SYSTEM SENSOR MODEL SSK451 OR EQUAL.
 3. SMOKE DETECTOR SHALL BE FURNISHED/INSTALLED BY MECHANICAL CONTRACTOR AND WIRED BY ELECTRICAL CONTRACTOR TO SHUT DOWN CORRESPONDING AIR CONDITIONING UNIT UNDER ALARM CONDITIONS. ALL WIRING SHALL BE IN CONDUIT PER N.E.C. SMOKE DETECTOR SHALL BE SYSTEM SENSOR MODEL DH100ACDCLP OR EQUAL.
 4. PROVIDE AND INSTALL PROGRAMMABLE THERMOSTAT. COORDINATE EXACT LOCATION WITH OWNER PRIOR TO ROUGH-IN.
 5. PROVIDE ROOF MOUNTED EXHAUST FAN AND CURB. MAINTAIN MINIMUM 10'-0" CLEARANCE FROM ALL FRESH AIR INTAKES.
 6. EXTEND 6" EXHAUST DUCT UP THROUGH ROOF. TERMINATE WITH ROOF VENT. MAINTAIN MINIMUM 10'-0" CLEARANCE FROM ALL FRESH AIR INTAKES.
 7. PROVIDE MINI-SPLIT HEAT PUMP UNIT ON ROOF. INSTALL ON 18" ELEVATED STAND. INSTALL PER MANUFACTURER'S INSTRUCTIONS.
 8. ROUTE 6" WATER HEATER VENT UP THROUGH ROOF AND TERMINATE WITH ROOF VENT. ROUTE 6" COMBUSTION AIR INTAKE TO EXTERIOR AND TERMINATE WITH SIDEWALL VENT CAP. PROVIDE CONNECTIONS FOR (3) WATER HEATERS TO BE INSTALLED PLUS (1) FUTURE HEATER.
 9. TERMINATE RETURN DUCT UP 45° WITH WIREMESH SCREEN.
 10. PROVIDE AND INSTALL RECESSED DRYER BOX. EXTEND 4" EXHAUST DUCT UP THROUGH ROOF AND TERMINATE WITH ROOF VENT.
 11. STAINLESS STEEL VENT HOOD. ROUTE 6" EXHAUST DUCT UP THROUGH ROOF. TERMINATE WITH ROOF VENT. MAINTAIN MINIMUM 10'-0" CLEARANCE FROM ALL FRESH AIR INTAKES.
 12. G.C. PROVIDED DOOR LOUVERS, HIGH AND LOW.

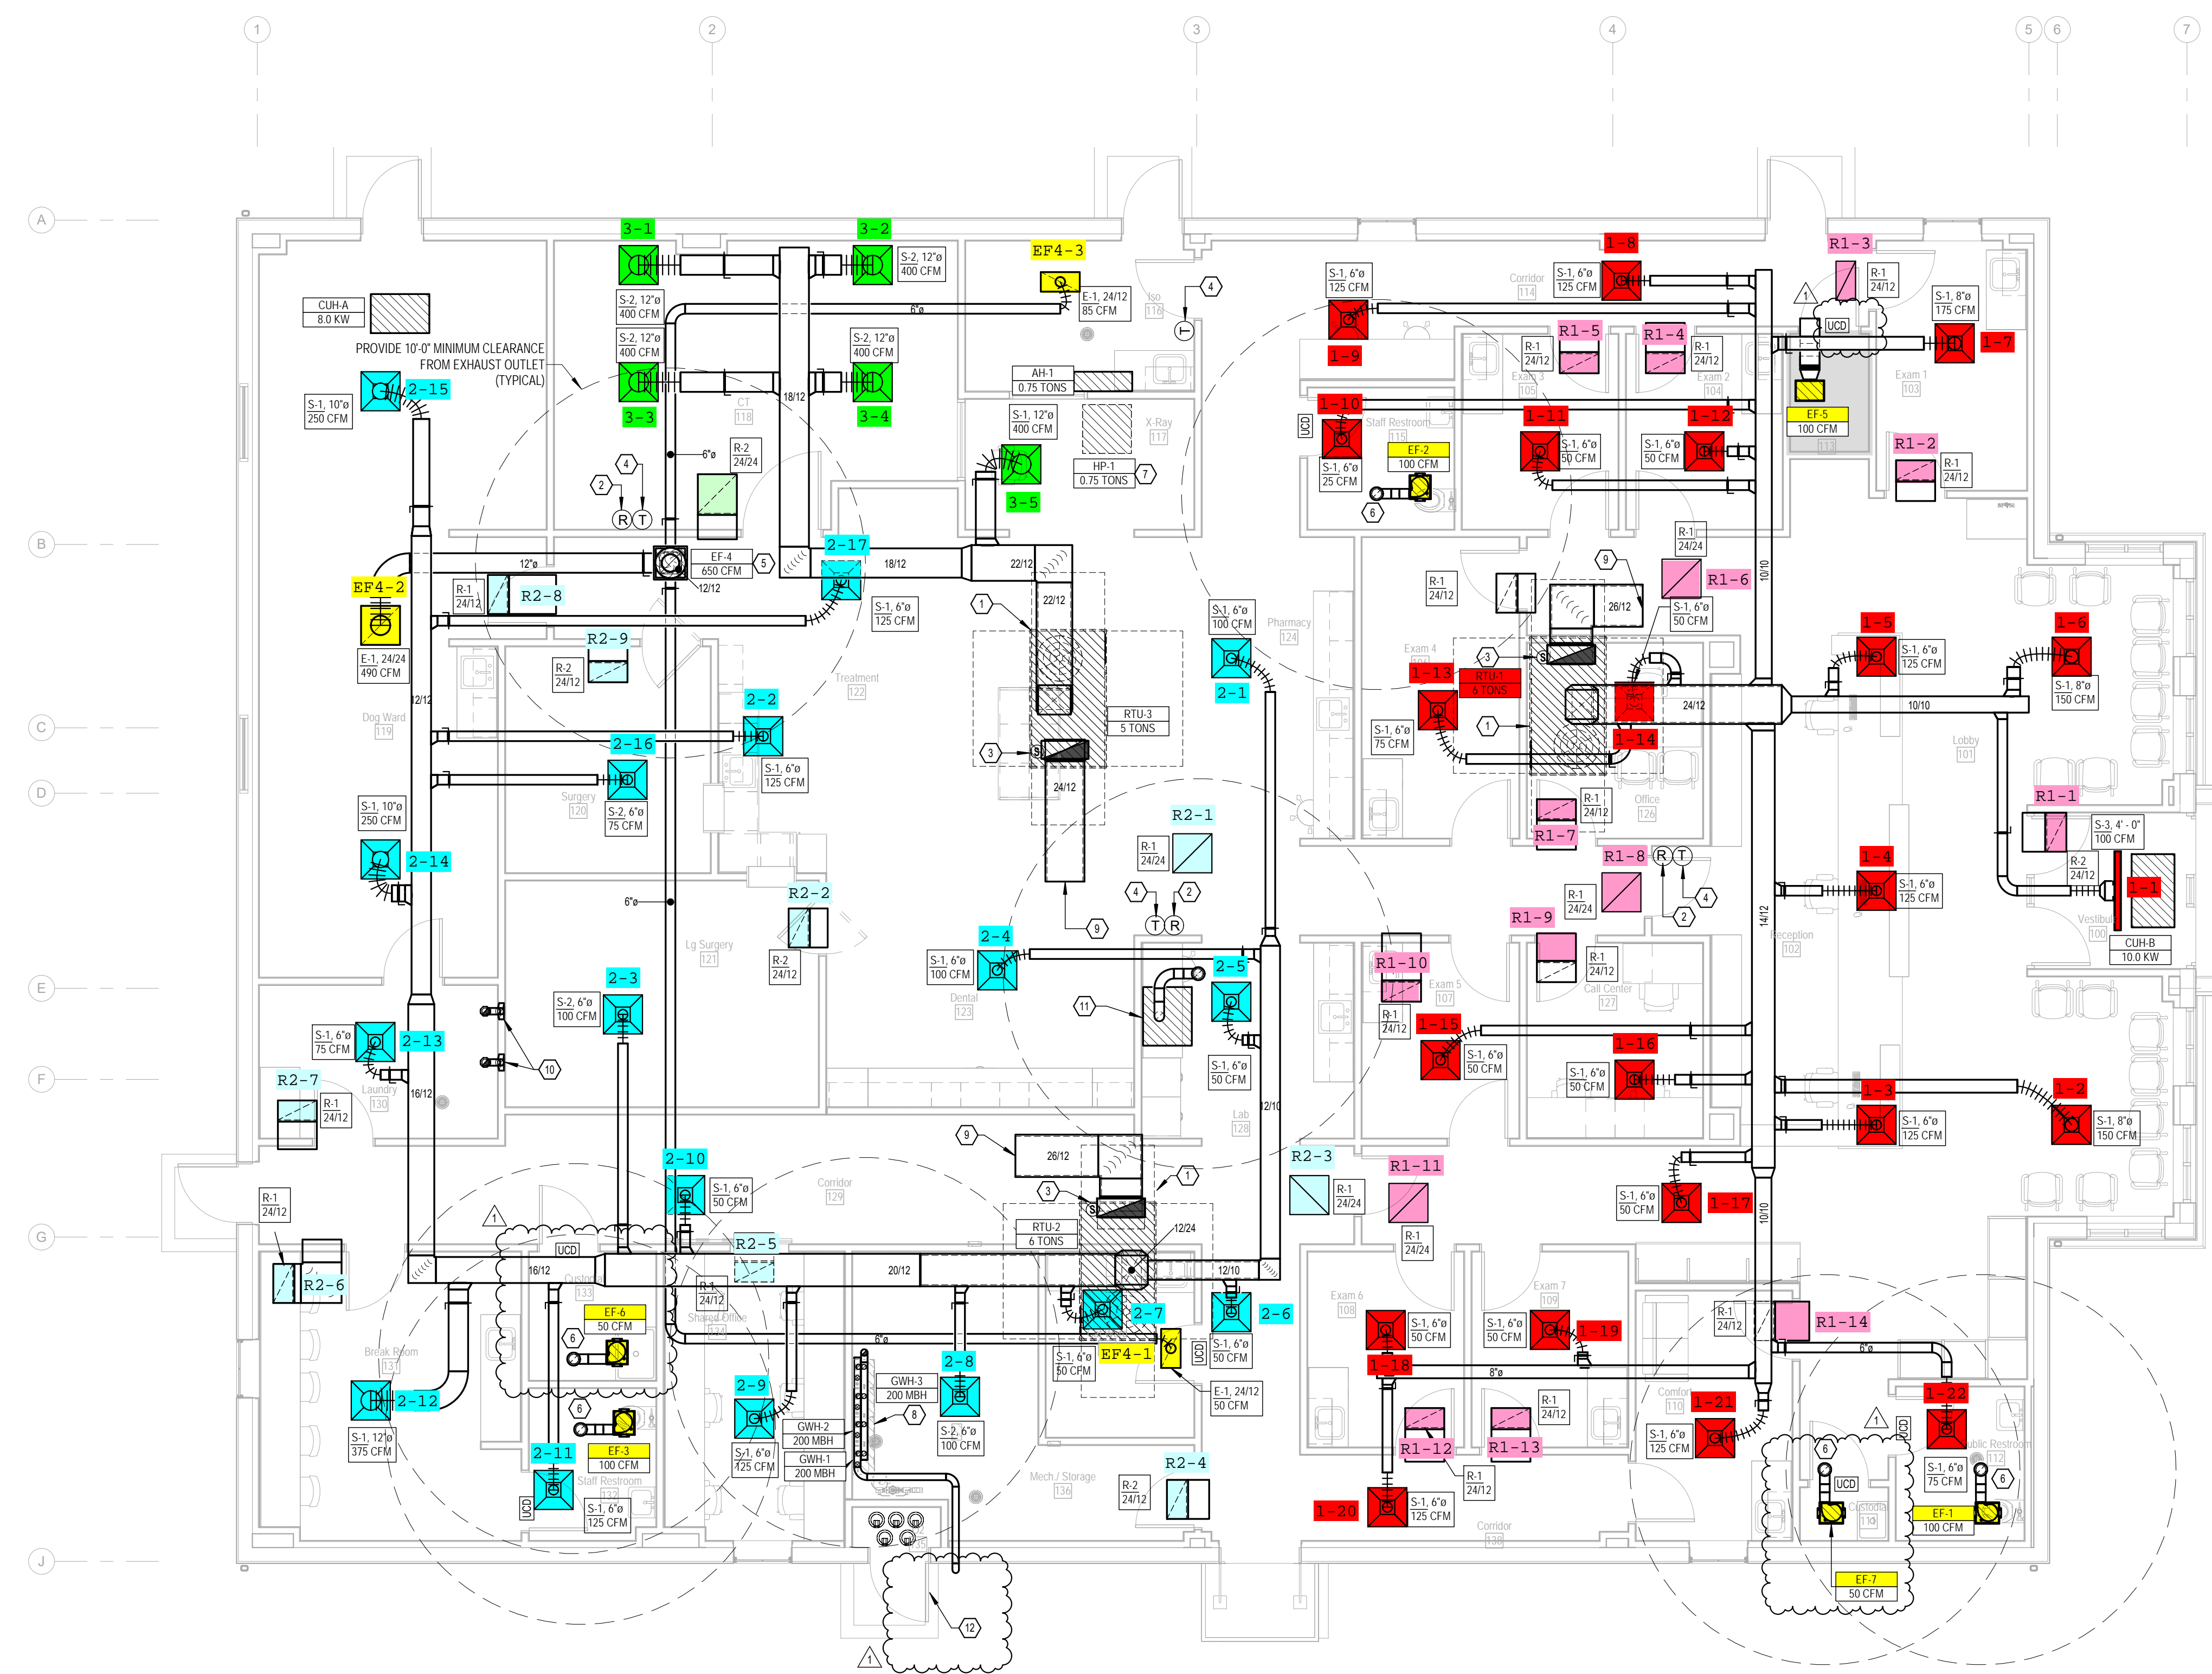

HVAC PLAN
 3/16" = 1'-0"

NVA
Paw Prints Vet Clinic
 Lot 7E of the Gateway Development
 Westover, West Virginia 26501



Issue Description:
BIDDING & PERMITTING

Revision Schedule

#	DATE	DESCRIPTION
1	2/22/2021	Addendum 1

Project #: 20053
 Issue Date: 2/5/2021

M1.01
 HVAC PLANS

