

SECTION 26 00 00 - ELECTRICAL GENERAL REQUIREMENTS

- PART 1 - GENERAL**
1. THE TERM "TENANT," "TENANT'S CONSTRUCTION MANAGER," "OWNER," OR "OWNER'S CONSTRUCTION MANAGER" SHALL REFER TO SWEETGREEN.
 2. THE GENERAL CONTRACTOR SHALL PROVIDE ALL MATERIALS AND LABOR AS REQUIRED TO PROVIDE A COMPLETE WORKING SYSTEM AND AS DESCRIBED IN THESE DRAWINGS.
 3. THE GENERAL CONTRACTOR SHALL REVIEW A COMPLETE SET OF THE CONSTRUCTION DOCUMENTS. EACH SUB-CONTRACTOR SHALL MAINTAIN A COMPLETE SET OF DRAWINGS ON SITE DURING THE CONSTRUCTION PROCESS.
 4. COORDINATE WORK AS REQUIRED WITH THE LANDLORD. THE GENERAL CONTRACTOR SHALL UTILIZE LANDLORD-REQUIRED CONTRACTORS AT THE GENERAL CONTRACTOR'S EXPENSE.
- PART 2 - PRODUCTS**
1. PRODUCTS SHALL BE AS DESCRIBED IN THE DRAWINGS AND AS REQUIRED FOR A COMPLETE AND FUNCTIONING SYSTEM.
- PART 3 - EXECUTION**
1. UNLESS DIMENSIONS HAVE BEEN PROVIDED, THE DRAWINGS ARE DIAGRAMMATIC IN NATURE, SHOWING THE GENERAL LOCATION, TYPE, LAYOUT AND REQUIRED EQUIPMENT. THEY SHALL NOT BE SCALED. COORDINATE WITH THE ARCHITECTURAL DRAWINGS, TENANT VENDORS AND MANUFACTURER'S INSTALLATION INSTRUCTIONS AND CUTSHEETS AS REQUIRED.
 2. COMPLETE ALL WORK IN COMPLIANCE WITH THE CODES LISTED ON SHEET G-001 INCLUDING ALL LOCAL AMENDMENTS, ALL RELEVANT NFPA CODES AND STANDARDS AND SMACNA STANDARDS.
 - A. VERIFY ALL CODE REQUIREMENTS AND LOCAL AMENDMENTS WITH THE AUTHORITY HAVING JURISDICTION PRIOR TO BID.
 - B. WHEN THERE IS A DISCREPANCY BETWEEN THE ADOPTED CODES AND THESE DRAWINGS, THE MORE STRINGENT REQUIREMENT SHALL APPLY.
 3. COORDINATE WITH THE LOCAL AUTHORITY HAVING JURISDICTION AND ARRANGE ALL INSPECTIONS AS REQUIRED.
 - A. MAINTAIN A CLEAN CONSTRUCTION SITE DURING CONSTRUCTION. CLEAN SCRAP MATERIAL AND REMOVE FROM SITE DAILY AND MAINTAIN WORKING AREA IN AN ORDERLY FASHION.
 - B. PROVIDE SUBMITTALS AS NOTED IN THESE SPECIFICATIONS AND AS REQUESTED BY THE TENANT'S CONSTRUCTION MANAGER.
 - C. ALL SHOP DRAWINGS SHALL BE REVIEWED AND STAMPED BY THE GENERAL CONTRACTOR PRIOR TO SUBMITTING TO THE TENANT'S CONSTRUCTION MANAGER.
 - D. SHOP DRAWINGS SHALL BE SUBMITTED TO ALLOW FOR FIVE BUSINESS DAYS OF REVIEW TIME.
 6. PROVIDE REQUESTS FOR INFORMATION TO THE TENANT'S CONSTRUCTION MANAGER.
 - A. REQUESTS FOR INFORMATION SHALL PROVIDE A DETAILED DESCRIPTION OF THE SITE CONDITION OR DISCREPANCY AND THE CONTRACTORS PROPOSED REMEDY.
 - B. REQUESTS FOR INFORMATION SHALL BE SUBMITTED TO ALLOW FOR FIVE BUSINESS DAYS OF REVIEW TIME.
 7. UPON COMPLETION OF WORK, THE GENERAL CONTRACTOR SHALL PROVIDE THE TENANT'S CONSTRUCTION MANAGER WITH A BOUND RECORD OF ALL ELECTRICAL EQUIPMENT UTILIZED IN THE JOB. THE GENERAL CONTRACTOR SHALL PROVIDE THE SAME INFORMATION ON A COMPACT DISC. THE DISKETT SHALL CONTAIN:
 - A. COVER SHEET INDICATING THE PROJECT NAME, ADDRESS AND TURN-OVER DATE.
 - B. COMPANY NAME AND CONTACT INFORMATION OF THE CONTRACTORS UTILIZED FOR THE ELECTRICAL SCOPE OF WORK.
 - C. CUTSHEETS, INSTALLATION MANUALS AND MAINTENANCE REQUIREMENTS FOR ALL ELECTRICAL EQUIPMENT.
 8. UPON COMPLETION OF WORK, THE GENERAL CONTRACTOR SHALL PROVIDE THE TENANT'S CONSTRUCTION MANAGER A FULL SET OF DRAWINGS WITH ANY DEVIATIONS FROM THE DRAWINGS INDICATED IN RED INK.

(END OF SECTION 26 00 00)

SECTION 26 05 19 - LOW-VOLTAGE ELECTRICAL POWER CONDUCTORS AND CABLES

- PART 1 - GENERAL**
1. SECTION REQUIREMENTS
 - A. ALL CONDUCTORS SHALL BE COPPER. ALUMINUM CONDUCTORS ARE NOT PERMITTED UNLESS NOTED OTHERWISE.
 - B. SUBMITTALS: NONE REQUIRED.
- PART 2 - PRODUCTS**
1. COPPER BUILDING WIRE SHALL BE FLEXIBLE, INSULATED, DRAWN COPPER CURRENT-CARRYING CONDUCTOR WITH AN OVERALL INSULATION LAYER OR JACKET, OR BOTH, RATED 600V OR LESS, LISTED AND LABELED AS DEFINED IN NFPA 70.
 2. METAL-CLAD CABLE, TYPE MC SHALL BE A FACTORY ASSEMBLY OF ONE OR MORE CURRENT-CARRYING INSULATED CONDUCTORS IN A METALLIC SHEATH, LISTED AND LABELED AS DEFINED IN NFPA 70.
- PART 3 - EXECUTION**
1. REFER TO THE MAIN DISTRIBUTION DIAGRAM FOR FEEDER CONDUCTOR AND INSULATION REQUIREMENTS.
 2. REFER TO THE MATERIAL SCHEDULE FOR BRANCH CIRCUIT CONDUCTOR AND INSULATION REQUIREMENTS.
 3. INSTALLATION OF CONDUCTORS AND CABLES
 - A. CONCEAL CABLES IN FINISHED WALLS AND CEILINGS WHERE PRACTICAL. IN AREAS WITH EXPOSED CEILINGS, CONDUCTORS SHALL BE ROUTED PARALLEL AND PERPENDICULAR TO WALLS AND BUILDING STRUCTURE.
 - B. USE MANUFACTURER-APPROVED PULLING COMPOUND OR LUBRICANT WHERE NECESSARY. COMPOUND USED MUST NOT DETERIORATE CONDUCTOR OR INSULATION.
 - C. USE PULLING MEANS THAT WILL NOT DAMAGE THE CABLES OR RACEWAY.
 4. CONNECTIONS
 - A. TIGHTEN ELECTRICAL CONNECTORS AND TERMINALS ACCORDING TO MANUFACTURER'S PUBLISHED TORQUE-TIGHTENING VALUES.
 - B. MAKE SPLICES, TERMINATIONS AND TAPS THAT ARE COMPATIBLE WITH CONDUCTOR MATERIAL. USE OXIDE INHIBITOR IN EACH SPLICE, TERMINATION AND TAP BETWEEN ALUMINUM AND COPPER.
 - C. INSTALL CONDUCTOR AT EACH OUTLET AND SWITCH WITH AT LEAST 6 INCHES OF SLACK.
 5. THE FOLLOWING COLOR CODE SHALL BE USED FOR ALL SECONDARY SERVICE, FEEDER AND BRANCH CIRCUIT CONDUCTORS:

A. PHASE A	RED	BROWN
B. PHASE B	BLACK	YELLOW
C. PHASE C	BLUE	PURPLE
D. NEUTRAL	WHITE	GRAY
E. GROUND	GREEN	GREEN

(END OF SECTION 26 05 19)

SECTION 26 05 26 - GROUNDING AND BONDING FOR ELECTRICAL SYSTEMS

- PART 1 - GENERAL**
1. SUMMARY
 - A. SECTION INCLUDES GROUNDING AND BONDING SYSTEMS AND EQUIPMENT. REQUIREMENTS OF THIS SECTION MAY BE SUPPLEMENTED IN SPECIAL CASES AS DESCRIBED IN OTHER SECTIONS.
 2. QUALITY ASSURANCE
 - A. TESTING AGENCY QUALIFICATIONS: CERTIFIED BY NETA
- PART 2 - PRODUCTS**
1. ELECTRICAL COMPONENTS, DEVICES AND ACCESSORIES SHALL BE LISTED AND LABELED AS DEFINED IN NFPA 70 AND MARKED FOR INTENDED LOCATION AND APPLICATION.
 2. COMPLY WITH UL 467 FOR GROUNDING AND BONDING MATERIALS AND EQUIPMENT.
 3. CONDUCTORS
 - A. INSULATED CONDUCTORS: COPPER WIRE OR CABLE INSULATED FOR 600V UNLESS OTHERWISE REQUIRED BY APPLICABLE CODE OR AUTHORITIES HAVING JURISDICTION.
 - B. BARE STEEL CONDUCTORS: SOLID CONDUCTORS SHALL COMPLY WITH ASTM B 3. STRANDED CONDUCTORS SHALL COMPLY WITH ASTM B 8.
 4. CONNECTORS
 - A. CONNECTORS SHALL BE LISTED AND LABELED BY A NATIONALLY RECOGNIZED TESTING AGENCY ACCEPTABLE TO THE AUTHORITIES HAVING JURISDICTION.
 - B. MECHANICAL TYPE BUS-BAR CONNECTORS SHALL BE CAST SILICON BRONZE, SOLDERLESS COMPRESSION TYPE WIRE TERMINALS.
 - C. CABLE-TO-CABLE CONNECTORS SHALL BE COMPRESSION TYPE, COPPER OR COPPER ALLOY.
 - D. CONDUIT HUBS SHALL BE MECHANICAL TYPE, TERMINAL WITH THREADED HUB.
 5. GROUNDING ELECTRODES
 - A. GROUND RODS SHALL BE COPPER-CLAD STEEL, 3/4 INCH BY 10 FEET.
- PART 3 - EXECUTION**
1. APPLICATIONS
 - A. INSTALL SOLID CONDUCTOR FOR NO. #10 AWG AND SMALLER, AND STRANDED CONDUCTORS FOR NO. #6 AWG AND LARGER UNLESS NOTED OTHERWISE.
 - B. ISOLATED GROUNDING CONDUCTORS SHALL BE GREEN-COLORED INSULATION WITH CONTINUOUS YELLOW STRIPE.
 - C. PIPE AND EQUIPMENT GROUNDING CONNECTOR TERMINATIONS SHALL BE WITH BOLTED CONNECTORS.
 - D. CONNECTIONS TO GROUND RODS AT TEST WELLS SHALL BE WITH BOLTED CONNECTORS.
 - E. CONNECTIONS TO STRUCTURAL STEEL SHALL BE WITH WELDED CONNECTORS.
 2. SERVICE GROUNDING
 - A. EQUIPMENT GROUNDING CONDUCTORS AND GROUNDING ELECTRODE CONDUCTORS SHALL BE CONNECTED TO THE GROUND BUS. INSTALL A MAIN BONDING JUMPER BETWEEN THE NEUTRAL AND GROUND BUSES.
 3. EQUIPMENT GROUNDING
 - A. INSTALL INSULATED EQUIPMENT GROUNDING CONDUCTORS WITH ALL FEEDERS AND BRANCH CIRCUITS IN ACCORDANCE WITH NFPA 70.
 4. INSTALLATION
 - A. ROUTE GROUNDING CONDUCTORS ALONG SHORTEST AND STRAIGHTEST PATHS POSSIBLE UNLESS OTHERWISE INDICATED OR REQUIRED BY CODE. AVOID OBSTRUCTING ACCESS OR PLACING CONDUCTORS WHERE THEY MAY BE SUBJECTED TO STRAIN, IMPACT OR DAMAGE.
 - B. INSTALL GROUND RODS IN ACCORDANCE WITH NFPA 70 AND THE AUTHORITY HAVING JURISDICTION.
 - C. INSTALL BONDING STRAPS AND JUMPERS IN LOCATIONS ACCESSIBLE FOR INSPECTION AND MAINTENANCE.
 - D. METAL WATER SERVICE PIPE (WHEN APPLICABLE): INSTALL INSULATED COPPER GROUNDING CONDUCTORS IN CONDUIT FROM BUILDING'S MAIN WATER SERVICE EQUIPMENT TO MAIN WATER SERVICE ENTRANCE TO THE BUILDING AND CONNECT TO MAIN METAL WATER SERVICE PIPES.
 - E. WATER METER PIPING (WHEN APPLICABLE): USE BRANDED-TYPE BONDING JUMPERS TO ELECTRICALLY BYPASS WATER METER.
 - F. BOND EACH ABOVE GROUND PORTION OF GAS PIPING SYSTEMS DOWNSTREAM FROM EQUIPMENT SHUTOFF VALVE.
 5. CONNECTIONS
 - A. MAKE CONNECTIONS SO POSSIBILITY OF GALVANIC ACTION OR ELECTROLYSIS IS MINIMIZED. SELECT CONNECTORS, CONNECTION HARDWARE, CONDUCTORS AND CONNECTION METHODS SO METALS IN DIRECT CONTACT ARE GALVANICALLY COMPATIBLE.
 - B. COAT AND SEAL CONNECTIONS HAVING DISSIMILAR METALS WITH INERT MATERIAL TO PREVENT FUTURE PENETRATION OF MOISTURE TO CONTACT SURFACES.

(END OF SECTION 26 05 26)

SECTION 26 05 33 - RACEWAYS AND BOXES FOR ELECTRICAL SYSTEMS

- PART 1 - GENERAL**
1. SECTION REQUIREMENTS
 - A. SUBMITTALS: NONE REQUIRED.
- PART 2 - PRODUCTS**
1. METAL CONDUIT
 - A. ALL METAL CONDUIT SHALL BE LISTED, LABELED AND MARKED AS DEFINED IN NFPA 70 FOR THE INTENDED LOCATION AND APPLICATION.
 - B. INTERMEDIATE METAL CONDUIT, ELECTRICAL METALLIC TUBING, METAL-CLAD CABLE, FLEXIBLE METAL CONDUIT AND LIQUID TIGHT FLEXIBLE METAL CONDUIT SHALL BE PERMITTED. REFER TO THE ELECTRICAL MATERIAL SCHEDULE FOR APPLICATIONS.
 2. METAL FITTINGS
 - A. ALL METAL FITTINGS SHALL BE LISTED, LABELED AND MARKED AS DEFINED IN NFPA 70 FOR THE INTENDED LOCATION AND APPLICATION.
 - B. ALL METAL FITTINGS SHALL BE LISTED AND LABELED FOR THE TYPE OF CONDUIT.
 - C. FITTINGS FOR EMT SHALL BE STEEL WITH A SETSCREW.
 - D. EXPANSION FITTINGS SHALL COMPLY WITH UL 651, RATED FOR ENVIRONMENTAL CONDITIONS WHERE INSTALLED, AND INCLUDING FLEXIBLE EXTERNAL BONDING JUMPER.
 3. METAL RACEWAYS AND AUXILIARY CUTTERS
 - A. CONSTRUCTED OF SHEET METAL, COMPLYING WITH UL 870 AND NEMA 250, SIZED PER NFPA 70.
 - B. INCLUDE COVERS, COUPLINGS, OFFSETS, ELBOWS, EXPANSION JOINTS, ADAPTERS, HOLD-DOWN STRAPS, END CAPS AND OTHER FITTINGS TO MATCH AND MATE WITH WIREWAYS FOR A COMPLETE SYSTEM.
 - C. PROVIDED WITH MANUFACTURER'S STANDARD ENAMEL FINISH.
 4. BOXES, ENCLOSURES AND CABINETS
 - A. BOXES, ENCLOSURES AND CABINETS INSTALLED IN WET LOCATIONS SHALL BE LISTED FOR USE IN WET LOCATIONS.
 - B. OUTLETS, DEVICE BOXES, PULL BOXES AND JUNCTION BOXES; CAST METAL BOXES SHALL BE UTILIZED AT EXTERIOR, INTERIOR EXPOSED AND INTERIOR DAMP LOCATIONS. ALL OTHER LOCATIONS SHALL USE SHEET METAL BOXES.
 - C. METAL FLOOR BOXES SHALL BE AS SPECIFIED ON THE PLANS.
 5. CABINETS
 - A. NEMA 250, TYPE 1 GALVANIZED STEEL BOX FINISHED INSIDE AND OUT WITH MANUFACTURER'S STANDARD ENAMEL.
 - B. PROVIDE WITH HINGED DOOR WITH FLUSH LATCH AND CONCEALED HINGE.
 - C. PROVIDE METAL BARRIERS TO SEPARATE WIRING OF DIFFERENT SYSTEMS AND VOLTAGES.

- PART 3 - EXECUTION**
1. COMPLY WITH NFPA 70 LIMITATIONS FOR TYPES OF RACEWAYS ALLOWED IN SPECIFIC APPLICATIONS.
 2. REFER TO THE MATERIAL SCHEDULE FOR RACEWAY APPLICATIONS.
 3. MINIMUM RACEWAY SIZE SHALL BE 3/4-INCH TRADE SIZE.
 4. INSTALLATION
 - A. DO NOT FASTEN CONDUITS ONTO THE BOTTOM SIDE OF METAL ROOF DECK, ATTACHED TO PIPING, DUCTWORK OR OTHER CONDUIT.
 - B. KEEP RACEWAYS AT LEAST 6 INCHES AWAY FROM PARALLEL RUNS OF FLUES AND STEAM OR HOT WATER PIPING.
 - C. COORDINATE INSTALLATION WITH WORK OF ALL OTHER TRADES. ACCOMMODATE HANGERS, INSULATION AND OTHER REQUIREMENTS AS REQUIRED.
 - D. ARRANGE STUB UPS TO CURVED PORTIONS OF BENDS ARE NOT VISIBLE ABOVE FINISHED SLAB.
 - E. INSTALL NO MORE THAN THE EQUIVALENT OF THREE 90-DEGREE BENDS IN ANY CONDUIT RUN. WHERE MORE BENDS ARE REQUIRED IN A SINGLE RUN, A PULL BOX SHALL BE INSTALLED.
 - F. CONDUIT CONDUIT WITHIN FINISHED WALLS, CEILINGS AND FLOORS UNLESS NOTED OTHERWISE. INSTALL EXPOSED CONDUITS PARALLEL OR PERPENDICULAR TO BUILDING LINES.
 - G. APPLY LISTED COMPOUND TO THREADS OF RACEWAYS AND FITTINGS ON ALL JOINTS EXPOSED TO WET, DAMP OR OUTDOOR CONDITIONS. FOLLOW COMPOUND MANUFACTURER'S WRITTEN INSTRUCTIONS.
 - H. USE INSULATING BUSINGS TO PROTECT CONDUCTORS AT ALL RACEWAY TERMINATIONS SUBJECT TO MOISTURE OR VIBRATION.
 - I. INSTALL PULL WIRES WHERE NOTED ON PLANS. USE POLYPROPYLENE OR MONOFLAMENT PLASTIC LINE WITH NOT LESS THAN 200 POUND TENSILE STRENGTH.
 - J. INSTALL DEVICES TO SEAL RACEWAY INTERIORS AT ACCESSIBLE LOCATIONS. LOCATE SEALS SO NO FITTINGS OR BOXES ARE BETWEEN THE SEAL AND CHANGES OF ENVIRONMENT WHERE CONDUIT PASSES FROM WARM TO COLD CONDITIONS, SUCH AS THE BOUNDARIES OF REFRIGERATED SPACES, WHERE CONDUIT PASSES FROM THE INTERIOR TO EXTERIOR OF THE BUILDING AND WHERE REQUIRED BY NFPA 70.
 - K. INSTALL EXPANSION FITTINGS AT ALL LOCATIONS WHERE CONDUITS CROSS BUILDING OR STRUCTURE EXPANSION JOINTS PER THE MANUFACTURER'S WRITTEN INSTRUCTIONS.
 - L. FASTEN JUNCTION AND PULL BOXES TO BUILDING STRUCTURE.

(END OF SECTION 26 05 33)

SECTION 26 22 13 - LOW-VOLTAGE DISTRIBUTION TRANSFORMERS

- PART 1 - GENERAL**
1. SUMMARY
 - A. SECTION INCLUDES DISTRIBUTION, DRY-TYPE TRANSFORMERS WITH A NOMINAL PRIMARY AND SECONDARY RATING OF 600V AND LESS.
 2. SECTION REQUIREMENTS
 - A. SUBMITTALS: PROVIDE SHOP DRAWINGS INCLUDING RATED NAMEPLATE DATA, CAPACITIES, WEIGHTS, DIMENSIONS, MINIMUM CLEARANCES, INSTALLED DEVICES AND FEATURES AND THE PERFORMANCE FOR EACH TRANSFORMER.
- PART 2 - PRODUCTS**
1. DISTRIBUTION TRANSFORMERS
 - A. PROVIDE A FACTORY-ASSEMBLED AND TESTED, AIR-COOLED TRANSFORMER FOR A 60-HZ SERVICE.
 - B. COMPLY WITH NFPA 70.
 - C. TRANSFORMERS SHALL COMPLY WITH DOE 2016 EFFICIENCY LEVELS AND SHALL BE MARKED AS SUCH.
 - D. CORES SHALL BE ELECTRICAL GRADE, CONSTRUCTED OF NON-AGING SILICONE WITH HIGH PERMEABILITY AND LOW HYSTERESIS LOSS. ONE LEG PER PHASE. CORE VOLUME SHALL ALLOW EFFICIENT TRANSFORMER OPERATION AT 10 PERCENT ABOVE THE NOMINAL TAP VOLTAGE. CORE SHALL BE GROUNDED TO THE ENCLOSURE.
 - E. COILS SHALL BE CONSTRUCTED WITH CONTINUOUS ALUMINUM WINDINGS WITHOUT SPLICES, EXCEPT FOR TAPS.
 - F. PROVIDE A VENTILATED ENCLOSURE.
 - G. TAPS: TWO 2.5 PERCENT TAPS ABOVE AND FOUR 2.5 PERCENT TAPS BELOW NORMAL FULL CAPACITY.
 - H. INSULATION CLASS: 220 DEGREE C. C. UL COMPONENTS RATED INSULATION SYSTEM WITH A MAXIMUM OF 150 DEGREE C. RISE ABOVE A 40 DEGREE AMBIENT TEMPERATURE.
 - I. GROUNDINGS: PROVIDE A GROUND-BAR KIT OR A GROUND BAR INSTALLED ON THE INSIDE OF THE TRANSFORMER ENCLOSURE.
 - J. SOUND LEVELS: WHEN FACTORY TESTED ACCORDING TO IEEE STANDARDS, MAXIMUM SOUND LEVELS FOR TRANSFORMERS UP TO 50 KVA SHALL NOT EXCEED 45 DB. MAXIMUM SOUND LEVELS FOR TRANSFORMERS FROM 51 KVA TO 150 KVA SHALL NOT EXCEED 50 DB.

- PART 3 - EXECUTION**
1. EXAMINATION
 - A. VERIFY THAT FIELD MEASUREMENTS ARE AS NOTED TO MAINTAIN WORKING CLEARANCES AS REQUIRED BY NFPA 70 AND MANUFACTURER'S RECOMMENDATIONS.
 2. INSTALLATION
 - A. INSTALL TRANSFORMERS LEVEL AND PLUMB AS SHOWN ON THE DRAWINGS AND PER THE MANUFACTURER'S RECOMMENDATIONS.
 3. CONNECTIONS
 - A. GROUND AND CONNECT WIRING PER THE SPECIFICATIONS.
 - B. PROVIDE FLEXIBLE CONNECTIONS AT ALL CONDUIT AND CONDUCTOR TERMINATIONS AND SUPPORTS TO ELIMINATE SOUND AND VIBRATION TRANSMISSION TO THE BUILDING STRUCTURE.

(END OF SECTION 26 22 13)

SECTION 26 24 16 - PANELBOARDS

- PART 1 - GENERAL**
1. GENERAL REQUIREMENTS
 - A. COMPLY WITH NEMA PB1 AND NFPA 70.
 2. SECTION REQUIREMENTS
 - A. SUBMITTALS: PROVIDE SHOP DRAWINGS INDICATING ENCLOSURE TYPE, MOUNTING, BUS CONFIGURATION, VOLTAGE RATING, CURRENT RATING, SHORT CIRCUIT CURRENT RATING AND BREAKER CONFIGURATION.
- PART 2 - PRODUCTS**
1. LIGHTING AND APPLIANCE BRANCH-CIRCUIT PANELBOARDS
 - A. PROVIDE WITH FLUSH-MOUNTED OR SURFACE-MOUNTED (REFER TO PANELBOARD SCHEDULE), DEAD-FRONT CABINET.
 - B. PROVIDE WITH HINGED FRONT COVER AND CONCEALED HINGES, SECURED WITH FLUSH LATCH WITH TUMBLER LOCK; KEYPED ALIKE.
 - C. PHASE, NEUTRAL AND GROUND BUSES SHALL BE ALUMINUM (3).
 - D. CONDUCTOR CONNECTORS SHALL BE SUITABLE FOR USE WITH CONDUCTOR MATERIAL AND SIZES.
 - E. PANELBOARD SHORT-CIRCUIT CURRENT RATING SHALL BE AS NOTED ON THE MAIN DISTRIBUTION DIAGRAM.
 - F. BRANCH OVERCURRENT PROTECTIVE DEVICES SHALL BE BOLTED TO CIRCUIT BREAKERS, REPLACEMENTS WITHOUT DISTURBING ADJACENT UNITS.
 - G. CONTACTORS IN MAIN BUS SHALL BE NEMA ICS 2, CLASS A COMBINATION CONTACTORS.
 - H. PANEL SHALL BE SQUARE-D TYPE NO AND NF. EQUALS BY GENERAL ELECTRIC OR Eaton.
 2. MOLDED-CASE CIRCUIT BREAKERS
 - A. COMPLY WITH UL 489 WITH INTERRUPTING CAPACITY AS REQUIRED TO SATISFY THE SHORT-CIRCUIT CURRENT AS NOTED ON THE MAIN DISTRIBUTION DIAGRAM.
 - B. LINE-SIDE TERMINALS SHALL BE BOLTED TO THE BUSBAR.
 - C. PROVIDE CIRCUIT BREAKER, APPROPRIATE FOR THE APPLICATION.
 - D. SINGLE HANDLE FOR MULTIPLE CIRCUIT BREAKERS.
 - E. PROVIDE TYPE SWD FOR REPEITIVE SWITCHING LIGHTING LOADS.
 - F. PROVIDE TYPE HACR CIRCUIT BREAKERS FOR HEATING, AIR-CONDITIONING AND REFRIGERATING EQUIPMENT.
 - G. BREAKERS SHALL BE BY THE SAME MANUFACTURER AS THE PANELBOARD.
 3. IDENTIFICATION
 - A. ALL PANELBOARDS SHALL INCLUDE THE MANUFACTURER'S LABELING, INCLUDING MANUFACTURER'S NAME, VOLTAGE, AMPERAGE, NUMBER OF PHASES AND NUMBER OF POLES.
 - B. PROVIDE A TYPED CIRCUIT DIRECTORY INSIDE THE PANELBOARD DOOR MOUNTED IN A TRANSPARENT CARD HOLDER.

(END OF SECTION 26 24 16)

SECTION 26 27 26 - WIRING DEVICES

- PART 1 - GENERAL**
1. SECTION INCLUDES: STRAIGHT BLADE RECEPTACLES, ISOLATED GROUND RECEPTACLES, GFCI RECEPTACLES, SPECIAL RECEPTACLES AND SWITCHES.
 2. SECTION REQUIREMENTS
 - A. SUBMITTALS: NONE REQUIRED.
- PART 2 - PRODUCTS**
1. GENERAL
 - A. WIRING DEVICES, COMPONENTS AND ACCESSORIES SHALL BE LISTED AND LABELED AS DEFINED IN NFPA 70 AND MARKED FOR INTENDED LOCATION AND APPLICATION.
 - B. COMPLY WITH NFPA 70.
 - C. MATCH PLUG CONFIGURATIONS WITH ALL OWNER (OR OWNER'S VENDOR) FURNISHED EQUIPMENT.
 2. STRAIGHT BLADE RECEPTACLES
 - A. 5-20R, 125V, 20A DECORA STYLE RECEPTACLE.
 - B. PROVIDE TAMPER-RESISTANT RECEPTACLES IN ALL CUSTOMER-ACCESSIBLE AREAS.
 - C. MANUFACTURED BY HUBBELL, LEVITON OR PASS & SEYMOUR/LEGRAND.
 3. ISOLATED GROUND RECEPTACLES
 - A. 5-20R, 125V, 20A DECORA STYLE RECEPTACLE.
 - B. EQUIPMENT GROUNDING CONTACTS SHALL BE CONNECTED ONLY TO THE GREEN GROUNDING SCREW TERMINAL OF THE DEVICE AND WITH INHERENT ELECTRICAL ISOLATION FROM MOUNTING STRAP. ISOLATION SHALL BE INTEGRAL TO RECEPTACLE CONSTRUCTION AND NOT DEPENDENT ON REMOVABLE PARTS.
 - C. MANUFACTURED BY HUBBELL, LEVITON OR PASS & SEYMOUR/LEGRAND.
 4. GFCI RECEPTACLES
 - A. 5-20R, 125V, 20A DECORA STYLE GFCI RECEPTACLE.
 - B. PROVIDE TAMPER-RESISTANT RECEPTACLES IN ALL CUSTOMER-ACCESSIBLE AREAS.
 - C. MANUFACTURED BY HUBBELL, LEVITON OR PASS & SEYMOUR/LEGRAND.
 5. SPECIAL RECEPTACLES
 - A. RECEPTACLES NOT INDICATED ABOVE SHALL BE AS NOTED ON THE PLANS.
 - B. WHERE NO MANUFACTURER IS SPECIFIED, PROVIDE HUBBELL, LEVITON OR PASS & SEYMOUR/LEGRAND.
 6. SWITCHES
 - A. 125V, 20A RATED UNLESS NOTED OTHERWISE.
 - B. WHERE NO MANUFACTURER IS SPECIFIED, PROVIDE HUBBELL, LEVITON OR PASS & SEYMOUR/LEGRAND.

- PART 3 - EXECUTION**
1. INSTALLATION
 - A. REFER TO THE MATERIAL SCHEDULE FOR DEVICE TYPE AND COLOR REQUIREMENTS.
 - B. COMPLY WITH NEMA 1, INCLUDING MOUNTING HEIGHTS UNLESS NOTED OTHERWISE.
 - C. COORDINATE THE INSTALLATION OF WIRING DEVICES WITH OTHER TRADES. PROTECT INSTALLED DEVICES AND BOXES AS NECESSARY. DO NOT PLACE WALL FINISH MATERIALS OVER DEVICE BOXES.
 - D. INSTALL WIRING DEVICES AFTER WALL PREPARATION, INCLUDING PAINTING IS COMPLETE.
 - E. INSTALL DEVICES AND ASSEMBLES PLUMB AND SECURE.
 - F. UNLESS NOTED OTHERWISE MOUNT DEVICES FLUSH WITH LONG DIMENSION VERTICAL AND WITH GROUNDING TERMINAL OF RECEPTACLES ON TOP.
 - G. GROUP ADJACENT SWITCHES UNDER SINGLE, MULTIGANG WALL PLATES.

(END OF SECTION 26 27 26)

SECTION 26 28 16 - ENCLOSED SWITCHES

- PART 1 - GENERAL**
1. GENERAL REQUIREMENTS
 - A. COMPLY WITH NFPA 70.
 2. SECTION REQUIREMENTS
 - A. SUBMITTALS: NONE REQUIRED.
- PART 2 - PRODUCTS**
1. GENERAL REQUIREMENTS
 - A. THIS CONTRACTOR SHALL VERIFY ALL DIMENSIONS PRIOR TO ROUGH-IN AND PURCHASING OF ALL ENCLOSED SWITCHES AND CIRCUIT BREAKERS. FIELD-VERIFY CLEARANCES AS REQUIRED IN NFPA 70.
 2. FUSIBLE SWITCHES
 - A. FUSIBLE SWITCHES SHALL BE HEAVY DUTY TYPE.
 - B. SINGLE THROW, THREE POLE WITH VOLTAGES AND AMPACITY AS NOTED ON THE PLANS AND AS REQUIRED.
 - C. UL 98 AND NEMA KS 1, HORSEPOWER RATED, WITH CLIPS OR BOLT PADS TO ACCOMMODATE INDICATED FUSES.
 - D. PROVIDE WITH A LOCKABLE HANDLE, INTEGRAL TO THE BOX WITH CAPABILITY TO ACCEPT THREE PADLOCKS, AND INTERLOCKED WITH COVER IN CLOSED POSITION.
 - E. PROVIDE A DUAL COVER INTERLOCK TO PREVENT UNAUTHORIZED OPENING OF THE SWITCH DOOR WHEN THE HANDLES ARE IN THE "ON POSITION."
 - F. PROVIDE NEMA 1, GENERAL PURPOSE ENCLOSURE AT INDOOR LOCATIONS. PROVIDE NEMA 3R WEATHERPROOF ENCLOSURE FOR SWITCHES LOCATED AT OUTDOOR LOCATIONS.
 - G. ENCLOSURES SHALL BE GRAY BAKED ENAMEL PAINT, ELECTRODEPOSITED OR CLEANED, PHOSPHATIZED STEEL.
 - H. PROVIDE WITH EQUIPMENT GROUND KIT (WHERE REQUIRED), NEUTRAL KIT AND ISOLATED GROUND KIT (WHERE REQUIRED).
 - I. PROVIDE CLASS R FUSES, SIZED AS NOTED ON THE PLANS. PROVIDE CLASS R FUSE KIT TO REFLECT FUSES OTHER THAN TYPE R. THE SHORT CIRCUIT RATING OF THE SWITCHES SHALL BE 200,000 RMS SYMMETRICAL AMPS.
 - J. LUGS SHALL BE MECHANICAL TYPE, SUITABLE FOR THE NUMBER, SIZE AND CONDUCTOR MATERIAL. LUGS SHALL BE UL LISTED FOR 75 DEGREES C.
 - K. PROVIDE SERVICE-RATED SWITCHES ON ALL SERVICE ENTRANCE EQUIPMENT.
 3. NONFUSIBLE SWITCHES
 - A. NON-FUSIBLE SWITCHES SHALL BE HEAVY DUTY TYPE.
 - B. SINGLE THROW, THREE POLE WITH VOLTAGES AND AMPACITY AS NOTED ON THE PLANS AND AS REQUIRED.
 - C. UL 98 AND NEMA KS 1, HORSEPOWER RATED.
 - D. PROVIDE WITH A LOCKABLE HANDLE, INTEGRAL TO THE BOX WITH CAPABILITY TO ACCEPT THREE PADLOCKS, AND INTERLOCKED WITH COVER IN CLOSED POSITION.
 - E. PROVIDE A DUAL COVER INTERLOCK TO PREVENT UNAUTHORIZED OPENING OF THE SWITCH DOOR WHEN THE HANDLES ARE IN THE "ON POSITION."
 - F. PROVIDE NEMA 1, GENERAL PURPOSE ENCLOSURE AT INDOOR LOCATIONS. PROVIDE NEMA 3R WEATHERPROOF ENCLOSURE FOR SWITCHES LOCATED AT OUTDOOR LOCATIONS.
 - G. ENCLOSURES SHALL BE GRAY BAKED ENAMEL PAINT, ELECTRODEPOSITED OR CLEANED, PHOSPHATIZED STEEL.
 - H. PROVIDE WITH EQUIPMENT GROUND KIT (WHERE REQUIRED), NEUTRAL KIT AND ISOLATED GROUND KIT (WHERE REQUIRED). ALL ACCESSORIES SHALL BE INTERNALLY MOUNTED, AND LABELED FOR THE INTENDED USE.
 - I. LUGS SHALL BE MECHANICAL TYPE, SUITABLE FOR THE NUMBER, SIZE AND CONDUCTOR MATERIAL. LUGS SHALL BE UL LISTED FOR 75 DEGREES C.
 - J. PROVIDE SERVICE-RATED SWITCHES ON ALL SERVICE ENTRANCE EQUIPMENT.

- PART 3 - EXECUTION**
1. INSTALLATION
 - A. COORDINATE LAYOUT AND INSTALLATION OF SWITCHES AND COMPONENTS WITH EQUIPMENT SERVED AND ADJACENT SURFACES. MAINTAIN REQUIRED WORKSPACE CLEARANCES AND REQUIRED CLEARANCES TO MAINTAIN ACCESS TO AND FUNCTIONING OF EQUIPMENT.
 - B. COMPLY WITH NFPA 70 AND NEMA 1.
 - C. LABEL EACH ENCLOSURE WITH ENGRAVED METAL OR LAMINATED PLASTIC NAMEPLATE.
 - D. ADJUST ALL MOVING PARTS AND OPERABLE COMPONENTS TO FUNCTION SMOOTHLY AND LUBRICATE AS RECOMMENDED BY THE MANUFACTURER.

(END OF SECTION 26 28 16)

SECTION 26 51 19 - LIGHTING

- PART 1 - GENERAL**
1. GENERAL REQUIREMENTS
 - A. ALL LIGHTING FIXTURES SHALL BE LISTED AND LABELED AS DEFINED IN NFPA 70, BY A QUALIFIED TESTING AGENCY AND MARKED FOR INTENDED LOCATION AND APPLICATION.
 - B. LIGHTING SHALL COMPLY WITH ENERGY CODE OF THE AUTHORITY HAVING JURISDICTION.
 2. SECTION REQUIREMENTS
 - A. SUBMITTALS: NONE REQUIRED.
- PART 2 - PRODUCTS**
1. GENERAL
 - A. REFER TO THE LIGHTING FIXTURE SCHEDULE FOR FIXTURE TYPES, DESCRIPTIONS AND LAMP/BALLAST REQUIREMENTS.
 2. MATERIALS
 - A. ALL METAL PARTS SHALL BE FREE OF BURRS AND SHARP CORNERS AND EDGES.
 - B. SHEET METAL SHALL BE STEEL UNLESS NOTED OTHERWISE.
 - C. FORM AND SUPPORT TO PREVENT WARPING AND SAGGING.
 - D. PROVIDE WITH EQUIPMENT GROUND KIT (WHERE REQUIRED), NEUTRAL KIT AND ISOLATED GROUND KIT (WHERE REQUIRED). ALL ACCESSORIES SHALL BE INTERNALLY MOUNTED, AND LABELED FOR THE INTENDED USE.
 - E. PROVIDE SUPPORT FOR ALL LUMINAIRES IN ACCORDANCE WITH THE MANUFACTURER'S INSTALLATION INSTRUCTIONS, NFPA 70 AND AS REQUIRED BY THE AUTHORITY HAVING JURISDICTION.
 3. LUMINAIRE SUPPORT
 - A. PROVIDE SUPPORT FOR ALL LUMINAIRES IN ACCORDANCE WITH THE MANUFACTURER'S INSTALLATION INSTRUCTIONS, NFPA 70 AND AS REQUIRED BY THE AUTHORITY HAVING JURISDICTION.

(END OF SECTION 26 51 19)

ELECTRICAL GENERAL NOTES

- A. GENERAL NOTES APPLY TO ALL ELECTRICAL SHEETS.
- B. ELECTRICAL WORK SHALL BE DONE IN ACCORDANCE WITH THE ELECTRICAL CODE AND IN ACCORDANCE WITH THE AUTHORITY HAVING JURISDICTION. SEE SHEET G-001 FOR THE PREVAILING CODES.
- C. WIRING SHALL BE (2#12, #12 G, IN 3/4" C UNLESS NOTED OTHERWISE.
- D. INDIVIDUAL CONDUIT HOME RUNS SHOWN SHALL NOT BE CONSOLIDATED.
- E. EMERGENCY EGRESS LIGHTS AND ILLUMINATED EXIT SIGNS SHALL BE CONNECTED TO LOCAL LIGHTING CIRCUIT AHEAD OF ALL LOCAL SWITCHING.
- F. REFER TO THE EMERGENCY CIRCUIT WIRING DIAGRAM ON SHEET E-401 FOR INFORMATION REGARDING THE CIRCUITING OF FIXTURES LABELED "EM."
- G. INSTALL WALL SWITCHES AT 48" AFF TO CENTER OF SWITCH AND RECEPTACLES AT 18" AFF TO CENTER OF RECEPTACLE UNLESS NOTED OTHERWISE.
- H. INSTALL CONDUIT CONCEALED ABOVE THE CEILING, IN WALLS, OR IN RACEWAYS.
- I. LIGHTING CONTROL SYSTEM IS BASED ON LUTRON VIVE HUB, POWER PAK RELAYS, PICO SWITCHES, AND MAESTRO SWITCHES. REFER TO SHEET E-300 FOR MORE INFORMATION. COORDINATE WITH SWEETGREEN'S LUTRON REPRESENTATIVE AS REQUIRED.
- J. THE TERM "FURNISH" OR "SUPPLY" MEANS SUPPLY AND DELIVER TO THE PROJECT SITE, READY FOR UNLOADING, UNPACKING, ASSEMBLY, INSTALLATION AND SIMILAR OPERATIONS. THE TERM "INSTALL" DESCRIBES THE OPERATIONS AT THE PROJECT SITE INCLUDING THE ACTUAL UNLOADING, UNPACKING, ASSEMBLY, ERECTING, PLACING, ANCHORING, APPLYING, WORKING TO DIMENSION, FINISHING, CURING, PROTECTING, CLEANING, AND SIMILAR OPERATIONS. THE TERM "PROVIDE" MEANS TO FURNISH AND INSTALL, COMPLETE AND READY FOR INTENDED USE.
- K. PROVIDE ALL REQUIRED FIRESTOPPING AND SLEEVES AS REQUIRED TO MAINTAIN THE FIRE RATING OF ALL LINESET PIPING, CONTROL AND POWER WIRING AND ALL OTHER SYSTEMS PENETRATING THE FIRE RATED SHAFT.
- L. PROVIDE HILTI FIRESTOP BOX INSERTS ON ALL ELECTRICAL BOXES LOCATED IN FIRE-RATED WALLS.



sweetgreen

3101 W. EXPOSITION BLVD.
LOS ANGELES, CALIFORNIA 90018

THESE DRAWINGS & SPECIFICATIONS ARE CONFIDENTIAL AND SHALL REMAIN THE SOLE PROPERTY OF SWEETGREEN CORPORATION. THEY SHALL NOT BE REPRODUCED IN WHOLE OR IN PART, SHARED WITH THIRD PARTIES OR USED IN ANY MANNER ON OTHER PROJECTS OR EXTENSIONS TO THIS PROJECT WITHOUT THE PRIOR WRITTEN CONSENT OF SWEETGREEN CORPORATION. THESE DRAWINGS & SPECIFICATIONS ARE INTENDED TO EXPRESS DESIGN INTENT FOR A PROTOTYPICAL SWEETGREEN STORE WHICH IS SUBJECT TO CHANGE AT ANY TIME AND MAY NOT REFLECT ACTUAL SITE CONDITIONS. NEITHER PARTY SHALL HAVE ANY OBLIGATION OR LIABILITY TO THE OTHER EXCEPT AS STATED ABOVE UNTIL A WRITTEN AGREEMENT IS FULLY EXECUTED.

ENGINEER OF RECORD:



EVERJ ENGINEERING, INC.
1509 BUCK TRAIL LANE
WORTHINGTON, OH 43085
240-319-0822
www.everjengineering.com
TX ENGINEERING FIRM F-22980

STAMP:

CONSTRUCTION
ISSUE SET

07/24/2022

PROJECT INFORMATION:
MUELLER
PROJECT INFORMATION:
1900 ALDRICH ST.
SUITE 140
AUSTIN, TX 78723

DRAWN BY: JAE
CHECKED BY: MK
PROJECT MANAGER: JAE
SG DESIGN MANAGER: LG
SG CONSTR. MANAGER: KZ
PROJECT NO: 210005
TEMPLATE VERSION: 12/21/2021

REVISIONS
REV. DATE DESCRIPTION
2 05/20/22 PLAN REVIEW COMMENTS
3 06/29/22 CLIENT CHANGES

ELECTRICAL
SPECIFICATIONS

E-010




sweetgreen

3101 W. EXPOSITION BLVD.
LOS ANGELES, CALIFORNIA 90018

THESE DRAWINGS & SPECIFICATIONS ARE CONFIDENTIAL AND SHALL REMAIN THE SOLE PROPERTY OF SWEETGREEN CORPORATION. THEY SHALL NOT BE REPRODUCED (IN WHOLE OR IN PART), SHARED WITH THIRD PARTIES OR USED IN ANY MANNER ON OTHER PROJECTS OR EXTENSIONS TO THIS PROJECT WITHOUT THE PRIOR WRITTEN CONSENT OF SWEETGREEN CORPORATION. THESE DRAWINGS & SPECIFICATIONS ARE INTENDED TO EXPRESS DESIGN INTENT FOR A PROTOTYPICAL SWEETGREEN STORE WHICH IS SUBJECT TO CHANGE AT ANY TIME AND MAY NOT REFLECT ACTUAL SITE CONDITIONS. NEITHER PARTY SHALL HAVE ANY OBLIGATION OR LIABILITY TO THE OTHER EXCEPT AS STATED ABOVE UNTIL A WRITTEN AGREEMENT IS FULLY EXECUTED.

ENGINEER OF RECORD:

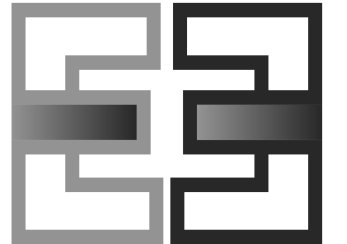

EVERJ ENGINEERING, INC.
1509 BUCK TRAIL LANE
WORTHINGTON, OH 43085
240-319-0822
www.everjengineering.com
TX ENGINEERING FIRM F-22980

STAMP:

CONSTRUCTION
ISSUE SET

07/24/2022

PROJECT INFORMATION:
MUELLER
PROJECT INFORMATION:
**1900 ALDRICH ST.
SUITE 140
AUSTIN, TX 78723**

DRAWN BY: JAE
CHECKED BY: MK
PROJECT MANAGER: JAE
SG DESIGN MANAGER: LG
SG CONSTR. MANAGER: KZ
PROJECT NO: 210005
TEMPLATE VERSION: 12/21/2021

REVISIONS
REV. DATE DESCRIPTION
1 05/05/22 LANDLORD COMMENTS
2 05/20/22 PLAN REVIEW COMMENTS

ELECTRICAL
LIGHTING PLAN

E-100

CODED NOTES

- 1 WALL MOUNT THE EMERGENCY LIGHT FIXTURE AT 6" BELOW THE CEILING UNLESS NOTED OTHERWISE. EMERGENCY LIGHTS SHALL BE CONNECTED THROUGH THE UNSWITCHED LEG OF THE LOCAL GENERAL LIGHTING CIRCUIT SERVING THE AREA TO PROVIDE CONTINUOUS EMERGENCY ILLUMINATION PER THE NEC.
- 2 EXIT SIGNS SHALL BE CONNECTED THROUGH THE UNSWITCHED LEG OF THE LOCAL GENERAL LIGHTING CIRCUIT SERVING THE AREA TO PROVIDE CONTINUOUS EMERGENCY ILLUMINATION PER THE NEC. VERIFY MOUNTING HEIGHT OF EXIT SIGN PRIOR TO ROUGH-IN. EXIT SIGN MUST BE VISIBLE FROM AREA SERVED AFTER BUILDING SYSTEMS HAVE BEEN INSTALLED.
- 3 INSTALL LIGHT FIXTURES FURNISHED WITH THE WALK-IN COOLER. PROVIDE POWER THROUGH THE POWPAK INDICATED. PROVIDE WIRING TO THE WALK-IN COOLER LIGHTING J-BOX AND FROM J-BOX TO LIGHT FIXTURES. SEAL INTERIOR OF CONDUITS WHERE THEY PASS THROUGH THE WALK-IN COOLER ENVELOPE.
- 4 PROVIDE SWITCHES IN LOCATION SHOWN. SEE LIGHTING CONTROL SCHEDULE FOR MANUFACTURER AND MODEL INFORMATION.
- 5 PROVIDE WIRELESS HUB RECESSED IN LAY-IN CEILING IN LOCATION SHOWN AND PER THE MANUFACTURER'S INSTALLATION INSTRUCTIONS. REFER TO LIGHTING CONTROL SCHEDULE FOR MANUFACTURER AND MODEL INFORMATION.
- 6 PROVIDE POWPAK MODULES MOUNTED TO WALL ABOVE CEILING IN LOCATION SHOWN PER DETAIL 2/SHEET E-401. REFER TO POWPAK SCHEDULE FOR MODEL NUMBER.
- 7 PROVIDE LIGHTALARMS LMIU-250 EMERGENCY LIGHTING INVERTERS, EM1 AND EM2 ON WALL ABOVE CEILING IN LOCATION SHOWN. CONNECT TO CIRCUIT SHOWN. PROVIDE WIRING TO LIGHTS LABELED "EM" PER DETAIL 4/SHEET E-401. EACH INVERTER SHALL BE CAPABLE OF PROVIDING UP TO 125W OF LED LIGHT TO FIXTURES AT 100% LIGHT OUTPUT FOR 90 MINUTES.
- 8 REFER TO LUTRON SHOP DRAWINGS FOR WIRING DIAGRAMS AND SCHEMATICS.
- 9 COORDINATE COMMISSIONING WITH LUTRON NOT LESS THAN TWO WEEKS PRIOR TO FINAL INSTALLATION OF LIGHTING CONTROL SYSTEM. THE ELECTRICAL CONTRACTOR SHALL BE ON SITE FOR THE DURATION OF THE LUTRON COMMISSIONING PROCESS.
- 10 COORDINATE THE ROUTING OF ALL EXPOSED CONDUIT WITH SWEETGREEN'S CONSTRUCTION MANAGER PRIOR TO ROUGH-IN.
- 11 COORDINATE INSTALLATION REQUIREMENTS OF THE COOLER WINDOW LIGHTING WITH THE EQUIPMENT PROVIDER PRIOR TO ROUGH-IN. REFER TO DETAIL 3/SHEET E-401.
- 12 PROVIDE WALL-MOUNTED OCCUPANCY SENSOR SWITCH (LUTRON MS-OPS2-WH) FOR CONTROL OF ROOM LIGHTING AS SHOWN. CIRCUIT AS INDICATED AND SET SWITCH TO TURN LIGHTING ON AUTOMATICALLY UPON OCCUPANTS ENTERING THE ROOM. DEVICE SHALL TURN ROOM LIGHTING OFF AFTER 15 MINUTES OF VACANCY.
- 13 EXTEND WIRING TO CIRCUIT SHOWN THROUGH THE POWPAK INDICATED.
- 14 PROVIDE A RECEPTACLE FOR THE OLO SIGNAGE. COORDINATE MOUNTING LOCATION AND ALL OTHER REQUIREMENTS WITH SWEETGREEN'S VENDOR PRIOR TO ROUGH-IN.
- 15 PROVIDE WALL-MOUNTED VACANCY SENSOR SWITCH (LUTRON MS-OPS2-WH) FOR CONTROL OF ROOM LIGHTING AS SHOWN. CIRCUIT AS INDICATED AND SET SWITCH TO MANUAL ON / AUTOMATIC OFF OPERATION. DEVICE SHALL TURN ROOM LIGHTING OFF AFTER 15 MINUTES OF VACANCY.
- 16 PROVIDE POWER TO A JUNCTION BOX FOR WINDOW SIGNAGE. COORDINATE ALL REQUIREMENTS WITH SWEETGREEN'S VENDOR PRIOR TO ROUGH-IN.


SYMBOLS & ABBREVIATIONS

LIGHTING SYMBOLS

- CONDUIT CONCEALED ABOVE THE CEILING, IN A WALL, OR IN A RACEWAY
- CONDUIT CONCEALED BELOW THE SLAB
- A-6 HOME-RUN TO PANELBOARD AND CIRCUIT NUMBER SHOWN
- (X) PLAN NOTE: SEE PLAN NOTES LISTED ON THE SAME SHEET FOR NOTE MEANING
- ⊙ JUNCTION BOX
- ELECTRIC PANELBOARD
- § LIGHT SWITCH. SEE SCHEDULES FOR MAKE/MODEL
- OUTDOOR PHOTOCELL
- ⊞ WALL-MOUNTED OCCUPANCY SENSOR
- ⊞ WALL-MOUNTED VACANCY SENSOR

LIGHTING ABBREVIATIONS

- (E) EXISTING
- (R) RELOCATED
- AFF ABOVE FINISHED FLOOR
- AFG ABOVE FINISHED GRADE
- C CONDUIT
- EM EMERGENCY
- G GROUND
- GC GENERAL CONTRACTOR
- GFCI GROUND FAULT CIRCUIT INTERRUPT
- IG ISOLATED GROUND
- JB JUNCTION BOX
- KES TENANT'S KITCHEN EQUIPMENT SUPPLIER
- NL NIGHT LIGHT
- S SURFACE MOUNTED
- TLS TENANT'S LIGHTING SUPPLIER
- UNO UNLESS NOTED OTHERWISE
- WP WEATHERPROOF

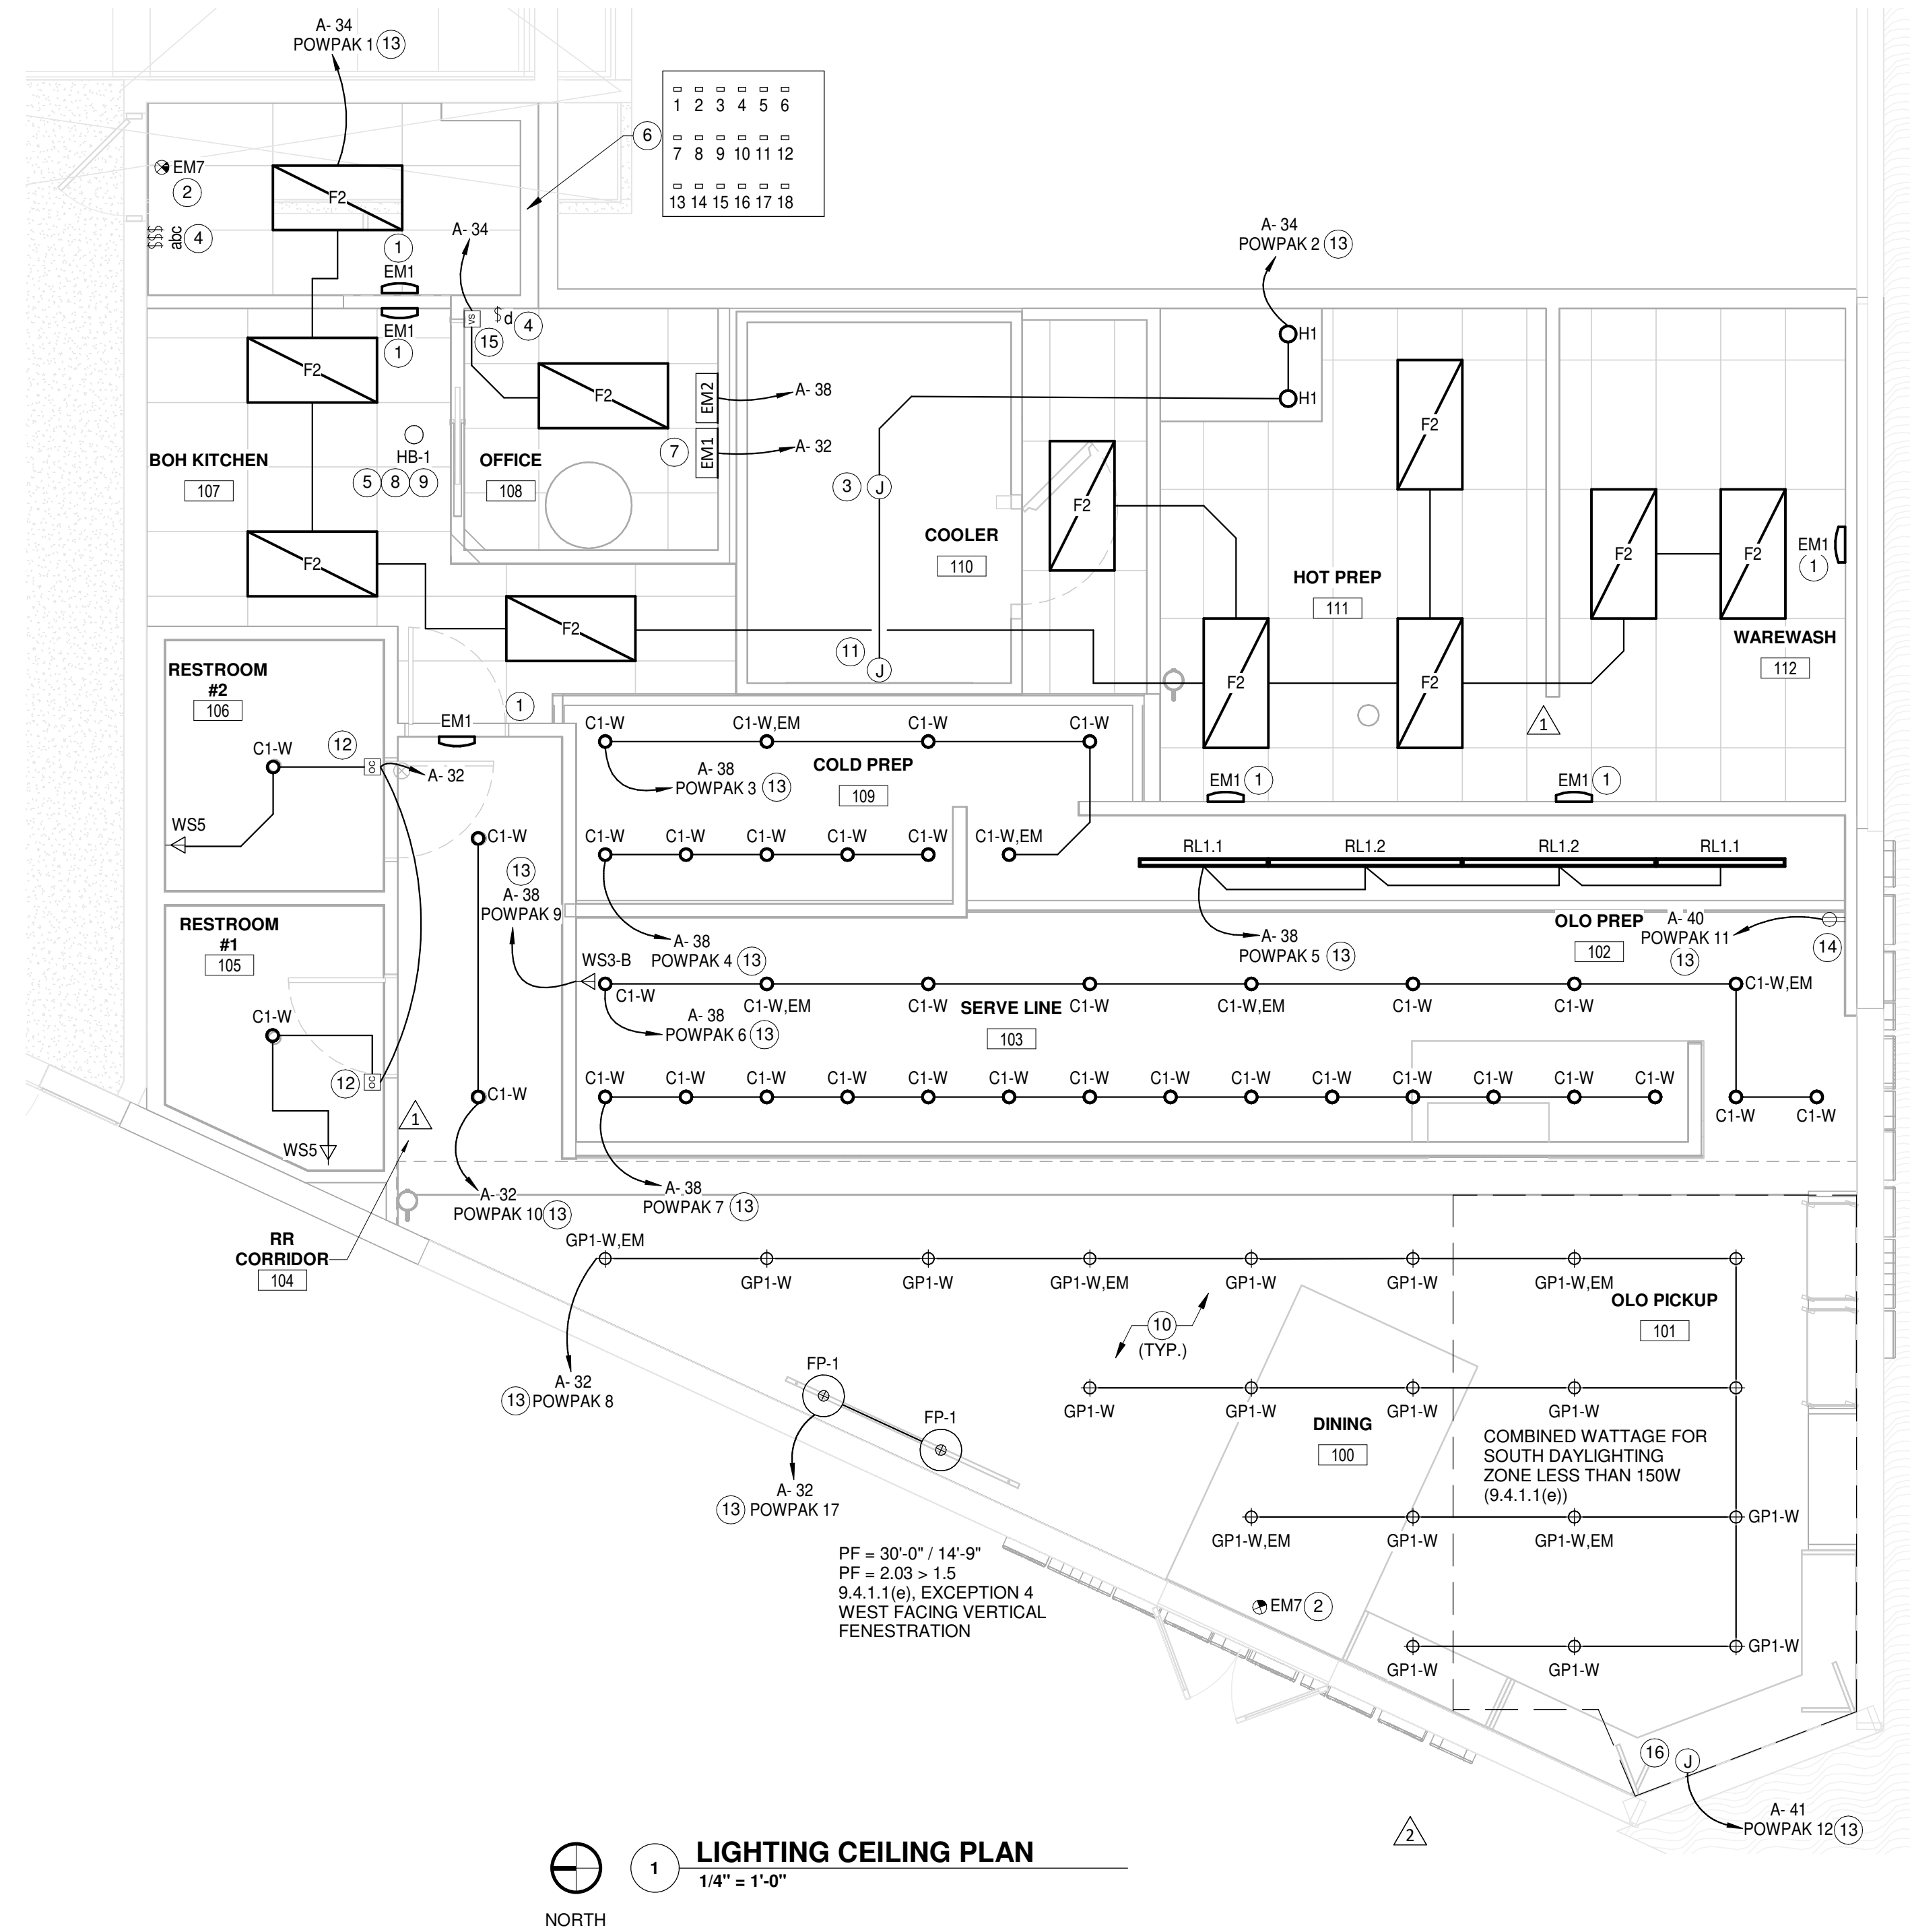




sweetgreen

3101 W. EXPOSITION BLVD.
LOS ANGELES, CALIFORNIA 90018

THESE DRAWINGS & SPECIFICATIONS ARE CONFIDENTIAL AND SHALL REMAIN THE SOLE PROPERTY OF SWEETGREEN CORPORATION. THEY SHALL NOT BE REPRODUCED IN WHOLE OR IN PART, SHARED WITH THIRD PARTIES OR USED IN ANY MANNER ON OTHER PROJECTS OR EXTENSIONS TO THIS PROJECT WITHOUT THE PRIOR WRITTEN CONSENT OF SWEETGREEN CORPORATION. THESE DRAWINGS & SPECIFICATIONS ARE INTENDED TO EXPRESS DESIGN INTENT FOR A PROTOTYPICAL SWEETGREEN STORE WHICH IS SUBJECT TO CHANGE AT ANY TIME AND MAY NOT REFLECT ACTUAL SITE CONDITIONS. NEITHER PARTY SHALL HAVE ANY OBLIGATION OR LIABILITY TO THE OTHER EXCEPT AS STATED ABOVE UNTIL A WRITTEN AGREEMENT IS FULLY EXECUTED.

ENGINEER OF RECORD:

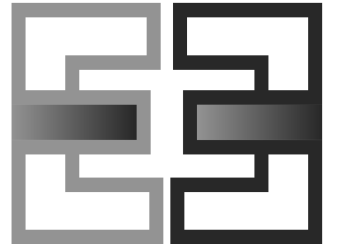

EVERJ ENGINEERING, INC.
1509 BUCK TRAIL LANE
WORTHINGTON, OH 43085
240-319-0822
www.everjengineering.com
TX ENGINEERING FIRM F-22980

STAMP:

CONSTRUCTION
ISSUE SET

07/24/2022

PROJECT INFORMATION:
MUELLER
PROJECT INFORMATION:
**1900 ALDRICH ST.
SUITE 140
AUSTIN, TX 78723**

DRAWN BY: JAE
CHECKED BY: MK
PROJECT MANAGER: JAE
SG DESIGN MANAGER: LG
SG CONSTR. MANAGER: KZ
PROJECT NO: 210005
TEMPLATE VERSION: 12/21/2021

REVISIONS
REV. DATE DESCRIPTION
2 05/20/22 PLAN REVIEW COMMENTS
3 06/29/22 CLIENT CHANGES

ELECTRICAL POWER
FLOOR PLAN

E-200

CODED NOTES

- PROVIDE POWER FOR WALK-IN COOLER EVAPORATOR FAN. COORDINATE REQUIREMENTS WITH THE KITCHEN EQUIPMENT SUPPLIER PRIOR TO ROUGH-IN.
- SHOW ROOM WINDOW RECEPTACLE. COORDINATE EXACT RECEPTACLE MOUNTING HEIGHT IN THE FIELD. LOCATION SHALL BE IN THE DRYWALL NO GREATER THAN 18" ABOVE THE MAIN STORE-FRONT WINDOW. RECEPTACLES SHALL BE ALIGNED WITH MULLIONS OR CENTERED ON PANES.
- JUNCTION BOX FOR EXTERIOR SIGN LIGHTING. COORDINATE EXACT LOCATION WITH ARCHITECT, OWNER'S REPRESENTATIVE, AND THE SIGN INSTALLER (IF APPLICABLE) PRIOR TO ROUGH-IN. CONNECT TO POWPAK AND CIRCUIT SHOWN. REFER TO THE POWPAK SCHEDULE ON SHEET E-300.
- REFER TO EVI SHOP DRAWINGS FOR HORIZONTAL AND VERTICAL DIMENSIONS OF ALL SERVE LINE RECEPTACLES.
- REFER TO ELEVATION ON SHEET E-400 FOR RECEPTACLE CIRCUIT DESIGNATIONS.
- NOT USED.
- PROVIDE 5' LONG CORD, AND NEMA L14-20P RECEPTACLE FOR THE HOT FOOD WELLS PER MANUFACTURER'S INSTALLATION INSTRUCTIONS. COORDINATE HEIGHT AND LOCATION OF THE CONVENIENCE RECEPTACLE WITH MILLWORK PRIOR TO ROUGH-IN. REFER TO ARCHITECTURAL ELEVATIONS FOR MORE INFORMATION.
- PROVIDE POWER TO WIRELESS HUB POWER SUPPLY THROUGH CIRCUIT SHOWN. EXTEND 24V WIRING FROM POWER SUPPLY TO WIRELESS HUB PER THE MANUFACTURER'S INSTALLATION INSTRUCTIONS.
- PROVIDE POWER CONNECTION FOR AIR-DOOR, WINDOW WARMER, AND ALL COOLER ACCESSORIES. COORDINATE ALL REQUIREMENTS WITH THE KITCHEN EQUIPMENT SUPPLIER PRIOR TO BID.
- PROVIDE TWO DUPLEX RECEPTACLES IN A COMMON JUNCTION BOX FOR THE IT RACK POWER. PROVIDE INDIVIDUAL CIRCUITS AS SHOWN IN THE ELEVATIONS ON SHEET E-400.
- PROVIDE RECEPTACLE FOR LAVATORY CONTROL MODULE RECEPTACLE PER DETAIL 6/SHEET P-400.
- PROVIDE TAYMAC MMS100 SINGLE-GANG VERTICAL WEATHERPROOF WHILE IN USE OUTLET COVER ON DISH MACHINE RECEPTACLE. NO SUBSTITUTES SHALL BE ACCEPTED.
- POWER FOR THE DIGITAL MENU BOARDS SHALL BE CONCEALED BEHIND THE MENU BOARD. COORDINATE THE LOCATION AND MOUNTING HEIGHT WITH THE DISPLAY VENDOR PRIOR TO ROUGH-IN.
- INTERLOCK PUMP, P-2 WITH DISHWASHER OPERATION SO THAT THE PUMP OPERATES WHEN THE DISHWASHER IS RUNNING AND THE WATER VALVE IS OPEN.
- THE GENERAL CONTRACTOR SHALL PROVIDE 5' LONG CORD, AND AN ANGLED NEMA L6-15P PLUG FOR BLAST CHILLER PER THE MANUFACTURER'S INSTALLATION INSTRUCTIONS.
- THE GENERAL CONTRACTOR SHALL INSTALL THE LAPC UNIT, FURNISHED BY SWEETGREEN ON THE OFFICE WALL IN LOCATION SHOWN. THE BOTTOM OF THE UNIT SHALL BE MOUNTED AT 6'-6" AFF. PROVIDE A NORMALLY CLOSED SWITCH FOR REMOTE POWER OFF ON WALL AT 48" AFF AS SHOWN. INSTALL PER DETAIL 5/SHEET E-401 AND PER THE MANUFACTURER'S INSTALLATION INSTRUCTIONS.
- PROVIDE POWER TO THE RECEPTACLES SERVING THE POS STATIONS AND THE OLO MONITORS THROUGH THE LAPC. REFER TO DETAIL 5/SHEET E-401 AND THE PANELBOARD SCHEDULES FOR MORE INFORMATION.
- PROVIDE JUNCTION BOX 0'-6" BELOW THE FINISHED CEILING IN THE LOCATION SHOWN FOR THE SECURITY PANEL POWER SUPPLY. ONCE THE PANEL HAS BEEN PROVIDED BY THE SECURITY VENDOR, PROVIDE POWER CABLING AS REQUIRED AND MAKE CONNECTION. COORDINATE INSTALLATION LOCATION AND ALL OTHER REQUIREMENTS WITH THE SECURITY VENDOR PRIOR TO ROUGH-IN.
- NOT USED.
- NOT USED.
- PROVIDE UNDER-SLAB WIRING FOR THE DEVICES AS SHOWN. COORDINATE PENETRATION LOCATIONS WITH THE MILLWORK VENDOR AND SITE CONDITIONS PRIOR TO ROUGH-IN.
- PROVIDE RECEPTACLE MOUNTED TO THE STOREFRONT SEATING MILLWORK. COORDINATE MOUNTING LOCATION WITH THE MILLWORK VENDOR PRIOR TO ROUGH-IN.
- COORDINATE THE WATER HEATER RECEPTACLE WITH THE PLUMBING ROUGH-IN'S PRIOR TO ROUGH-IN. RECEPTACLE SHALL BE MOUNTED SUCH THAT THE WATER HEATER CAN BE PLUGGED IN AND UNPLUGGED WITHOUT SHARP TURNS IN THE CORD.
- PROVIDE RECEPTACLES LOCATED ABOVE THE COLD PREP SINK IN A HORIZONTAL ORIENTATION AT THE ELEVATION NOTED.
- THE GENERAL CONTRACTOR SHALL PROVIDE A 5' LONG CORD AND NEMA 15-50P PLUG FOR THE COMBINATION OVEN PER THE MANUFACTURER'S INSTALLATION INSTRUCTIONS.
- RECEPTACLES ON CIRCUIT A-28 SHALL BE AUTOMATICALLY CONTROLLED PER LIGHTING SEQUENCE OF OPERATIONS ON SHEET E-300.
- TRANSFORMER T1 SHALL BE MOUNTED TO THE WALL AND FURNISHED WITH THE MANUFACTURER'S WALL BRACKETS AND OTHER ACCESSORIES REQUIRED TO SUPPORT THE TRANSFORMER.


SYMBOLS & ABBREVIATIONS

ELECTRICAL POWER SYMBOLS

- CONDUIT CONCEALED ABOVE THE CEILING, IN A WALL, OR IN A RACEWAY
- CONDUIT CONCEALED BELOW THE SLAB
- A-6 HOME-RUN TO PANELBOARD AND CIRCUIT NUMBER SHOWN
- (X) PLAN NOTE: SEE PLAN NOTES LISTED ON THE SAME SHEET FOR NOTE MEANING
- DISCONNECT SWITCH:
X = SWITCH RATING
Y = FUSE SIZE (NF = NON-FUSED)
Z = NUMBER OF POLES
- JUNCTION BOX
- ELECTRIC PANELBOARD
- § GENERAL PURPOSE 1-POLE SWITCH
- §WP WEATHER-PROOF SWITCH
- NEMA 5-20R 1-PLEX RECEPTACLE
- ⊕ NEMA 5-20R DUPLEX RECEPTACLE
- ⊕ NEMA 5-20R DUPLEX RECEPTACLE WITH USB
- ⊕ NEMA 5-20R DOUBLE-DUPLEX RECEPTACLES
- IG/GFI NEMA 5-20R DUPLEX COMBINATION ISOLATED GROUND/GFI RECEPTACLE PASS & SEYMOUR MODEL#2095IGTRO
- OTHER RECEPTACLE - SEE PLAN FOR RATING AND TYPE

POWER ABBREVIATIONS

- (E) EXISTING
- (R) RELOCATED
- AFG ABOVE FINISHED FLOOR
- AFG ABOVE FINISHED GRADE
- C CONDUIT
- G GROUND
- GC GENERAL CONTRACTOR
- GFCI GROUND FAULT CURRENT INTERRUPT
- IG ISOLATED GROUND
- JB JUNCTION BOX
- KES TENANT'S KITCHEN EQUIPMENT SUPPLIER
- S SURFACE MOUNTED
- UNO UNLESS NOTED OTHERWISE
- WP WEATHERPROOF

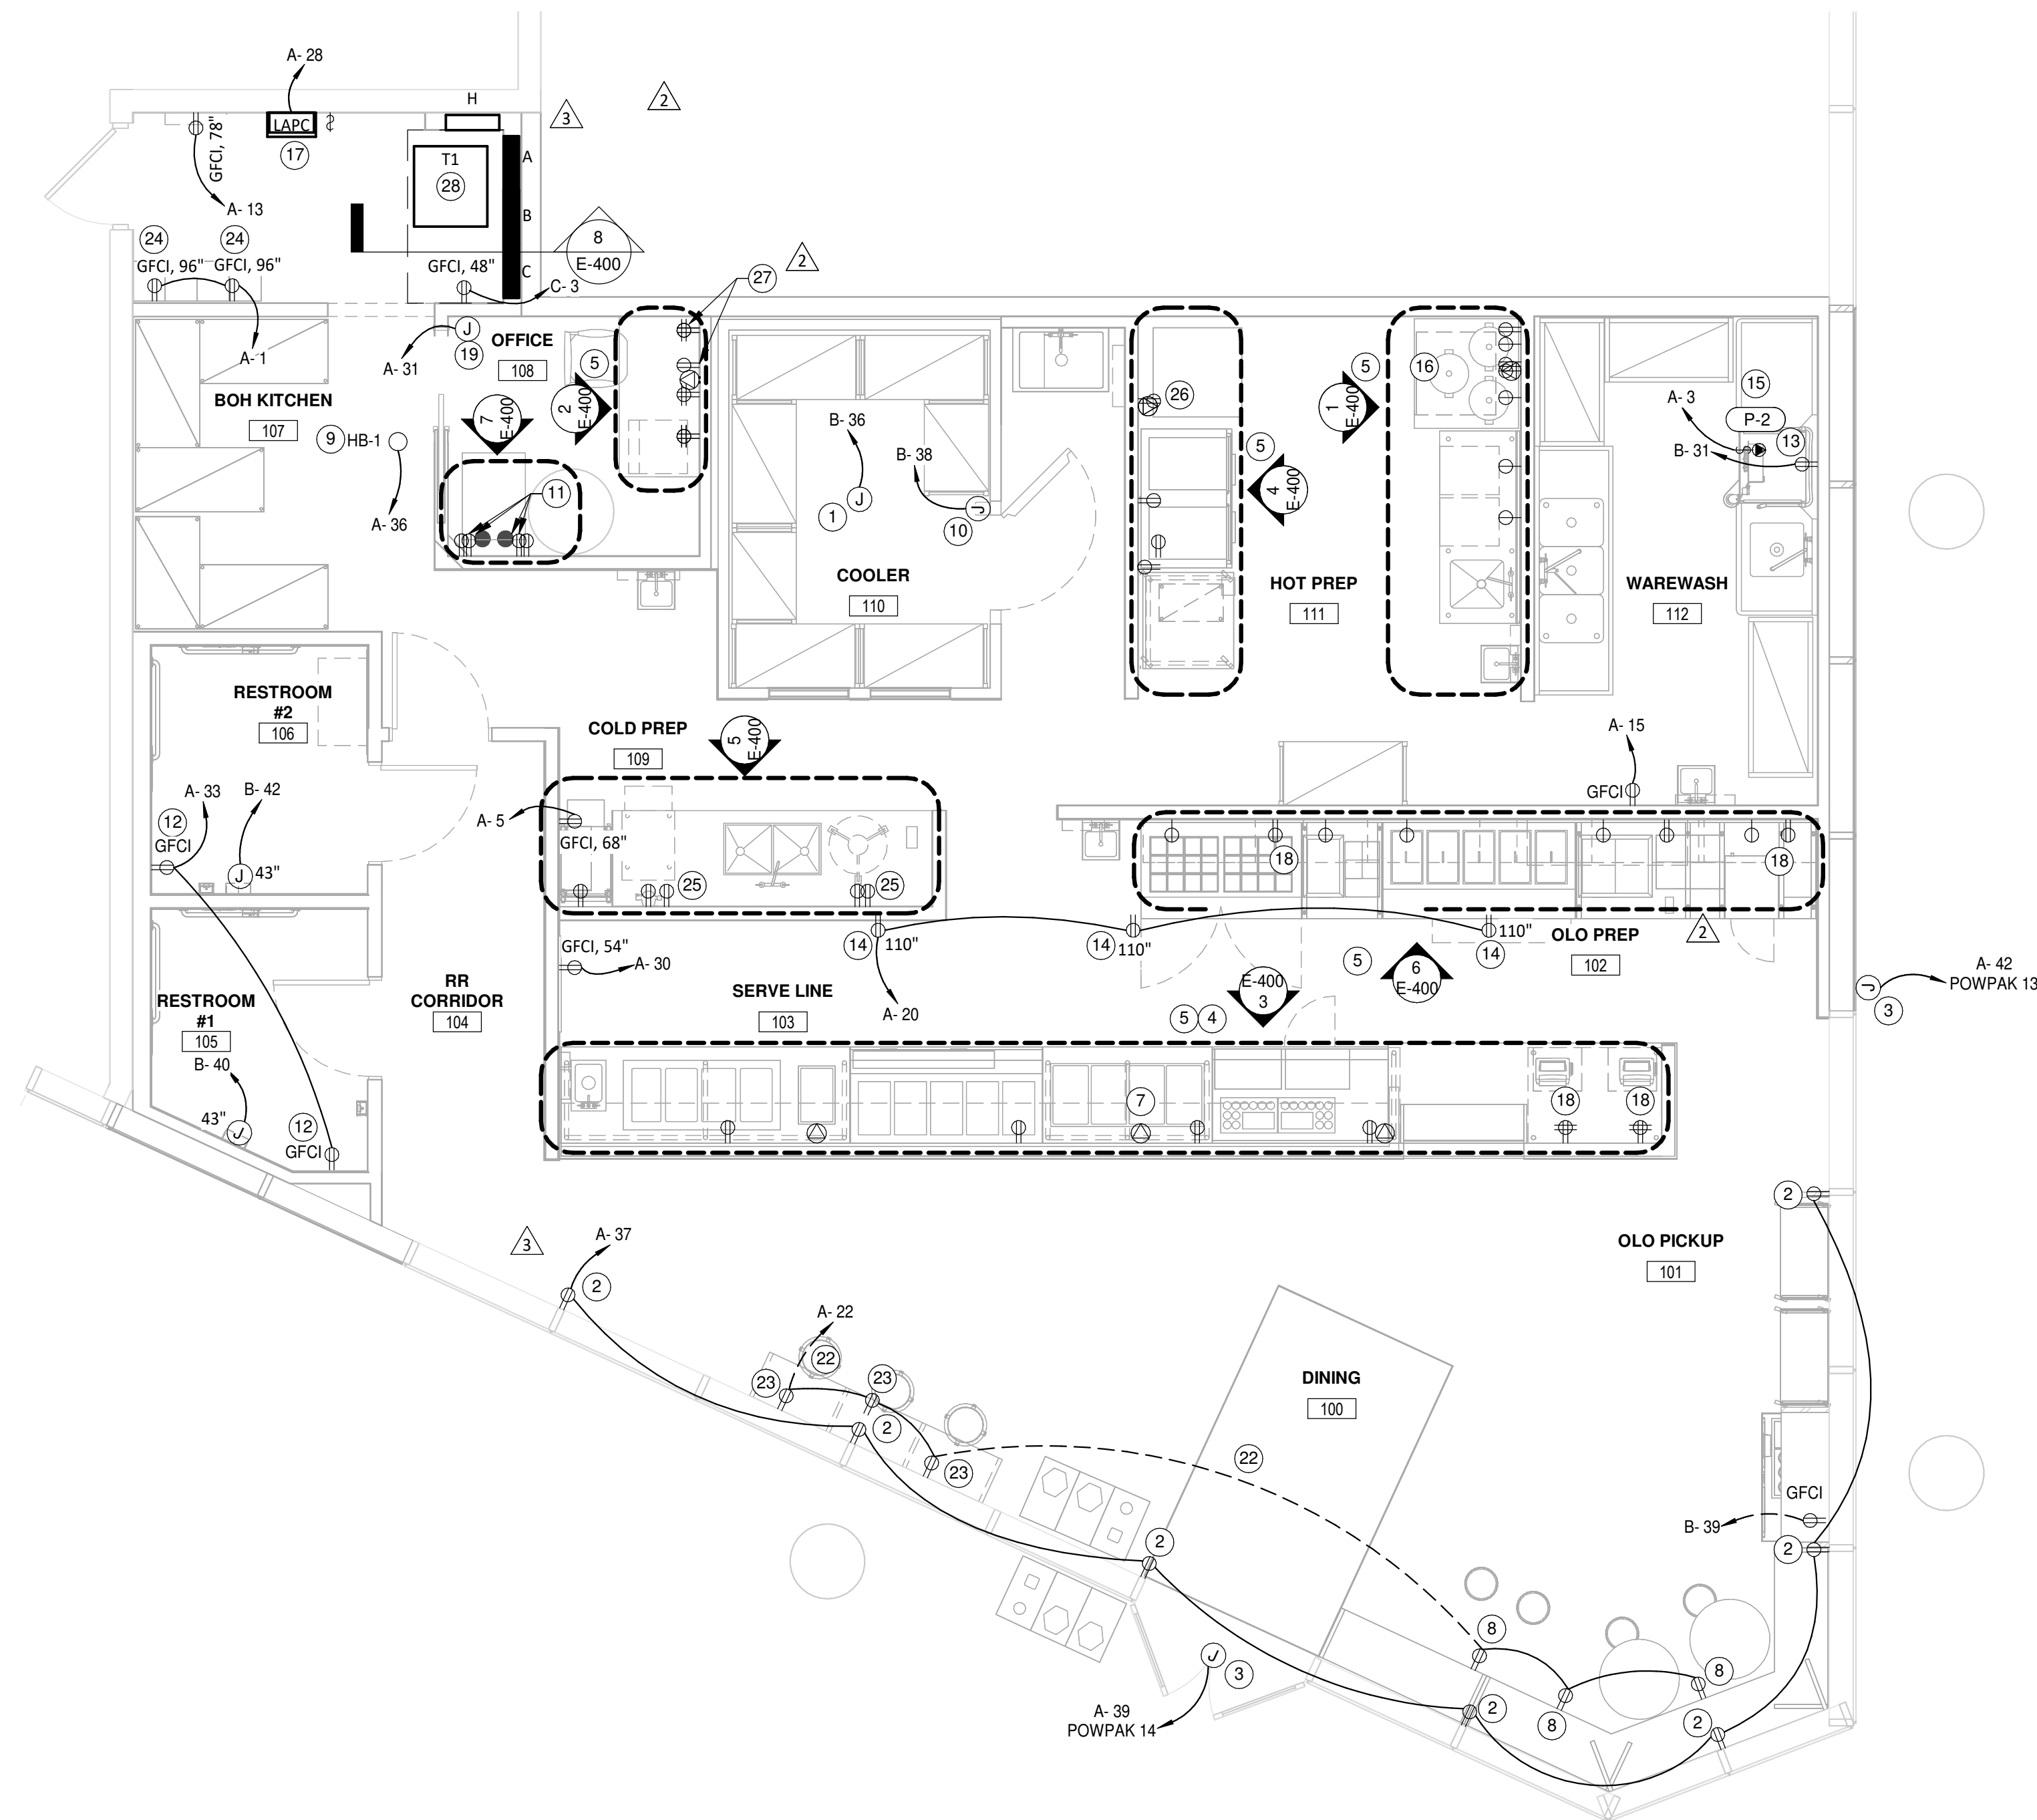

1 POWER FLOOR PLAN
1/4" = 1'-0"
NORTH




sweetgreen

3101 W. EXPOSITION BLVD.
LOS ANGELES, CALIFORNIA 90018

THESE DRAWINGS & SPECIFICATIONS ARE CONFIDENTIAL AND SHALL REMAIN THE SOLE PROPERTY OF SWEETGREEN CORPORATION. THEY SHALL NOT BE REPRODUCED (IN WHOLE OR IN PART), SHARED WITH THIRD PARTIES OR USED IN ANY MANNER ON OTHER PROJECTS OR EXTENSIONS TO THIS PROJECT WITHOUT THE PRIOR WRITTEN CONSENT OF SWEETGREEN CORPORATION. THESE DRAWINGS & SPECIFICATIONS ARE INTENDED TO EXPRESS DESIGN INTENT FOR A PROTOTYPICAL SWEETGREEN STORE WHICH IS SUBJECT TO CHANGE AT ANY TIME AND MAY NOT REFLECT ACTUAL SITE CONDITIONS. NEITHER PARTY SHALL HAVE ANY OBLIGATION OR LIABILITY TO THE OTHER EXCEPT AS STATED ABOVE UNTIL A WRITTEN AGREEMENT IS FULLY EXECUTED.

ENGINEER OF RECORD:

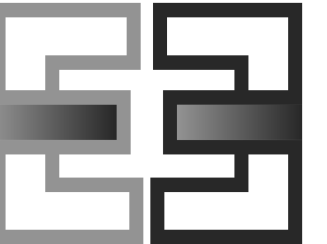

EVERJ ENGINEERING, INC.
1509 BUCK TRAIL LANE
WORTHINGTON, OH 43085
240-319-0822
www.everjengineering.com
TX ENGINEERING FIRM F-22980

STAMP:

CONSTRUCTION
ISSUE SET

07/24/2022

PROJECT INFORMATION:
MUELLER

PROJECT INFORMATION:
1900 ALDRICH ST.
SUITE 140
AUSTIN, TX 78723

DRAWN BY: JAE
CHECKED BY: MK
PROJECT MANAGER: JAE
SG DESIGN MANAGER: LG
SG CONSTR. MANAGER: KZ
PROJECT NO: 210005
TEMPLATE VERSION: 12/21/2021


REVISIONS
2 05/20/22 PLAN REVIEW COMMENTS
3 06/29/22 CLIENT CHANGES

ELECTRICAL POWER
MECHANICAL PLANS


E-201

CODED NOTES

- CONNECT EQUIPMENT TO POWPAK AND CIRCUIT AS SHOWN. REFER TO THE POWPAK SCHEDULE ON SHEET E-300.
- POWER FOR MOTORIZED DAMPERS SHALL BE OBTAINED FROM THEIR ASSOCIATED AIR HANDLING UNIT. COORDINATE ALL REQUIREMENTS WITH THE MECHANICAL CONTRACTOR AS REQUIRED.
- THE GENERAL CONTRACTOR SHALL FURNISH A REME HALO AIR PURIFICATION SYSTEM AND REQUIRED TRANSFORMER PURCHASED THROUGH SWEETGREEN'S VENDOR (NATIONAL TAB). THE GENERAL CONTRACTOR SHALL PROVIDE POWER TO, AND INSTALL, THE TRANSFORMER. THE GENERAL CONTRACTOR SHALL EXTEND CONDUIT AND CONDUCTORS FROM THE TRANSFORMER AND MAKE FINAL CONNECTION TO THE HALO UNIT. INTERLOCK UNIT OPERATION WITH SUPPLY-AIR FAN OPERATION OF THE ASSOCIATED MECHANICAL UNIT. REFER TO THE MECHANICAL PLANS FOR MORE INFORMATION. INSTALL PER THE MANUFACTURER'S INSTALLATION INSTRUCTIONS.
- CONDENSATE PUMP SHALL BE POWERED FROM THE ASSOCIATED EXISTING AIR HANDLING UNIT (PROVIDED BY THE LANDLORD). PROVIDE WIRING AND CONDUIT AS REQUIRED TO ACCOMMODATE THE FINAL INSTALLED LOCATION PER THE MANUFACTURER'S INSTALLATION INSTRUCTIONS.
- NOT USED.
- THE GENERAL CONTRACTOR SHALL FURNISH AND INSTALL A GFCI RECEPTACLE IN A WEATHERPROOF ENCLOSURE MOUNTED TO THE CONDENSING UNIT. COORDINATE EXACT LOCATION AT TIME OF INSTALLATION SUCH THAT THE CONDENSING COIL IS NOT BLOCKED.

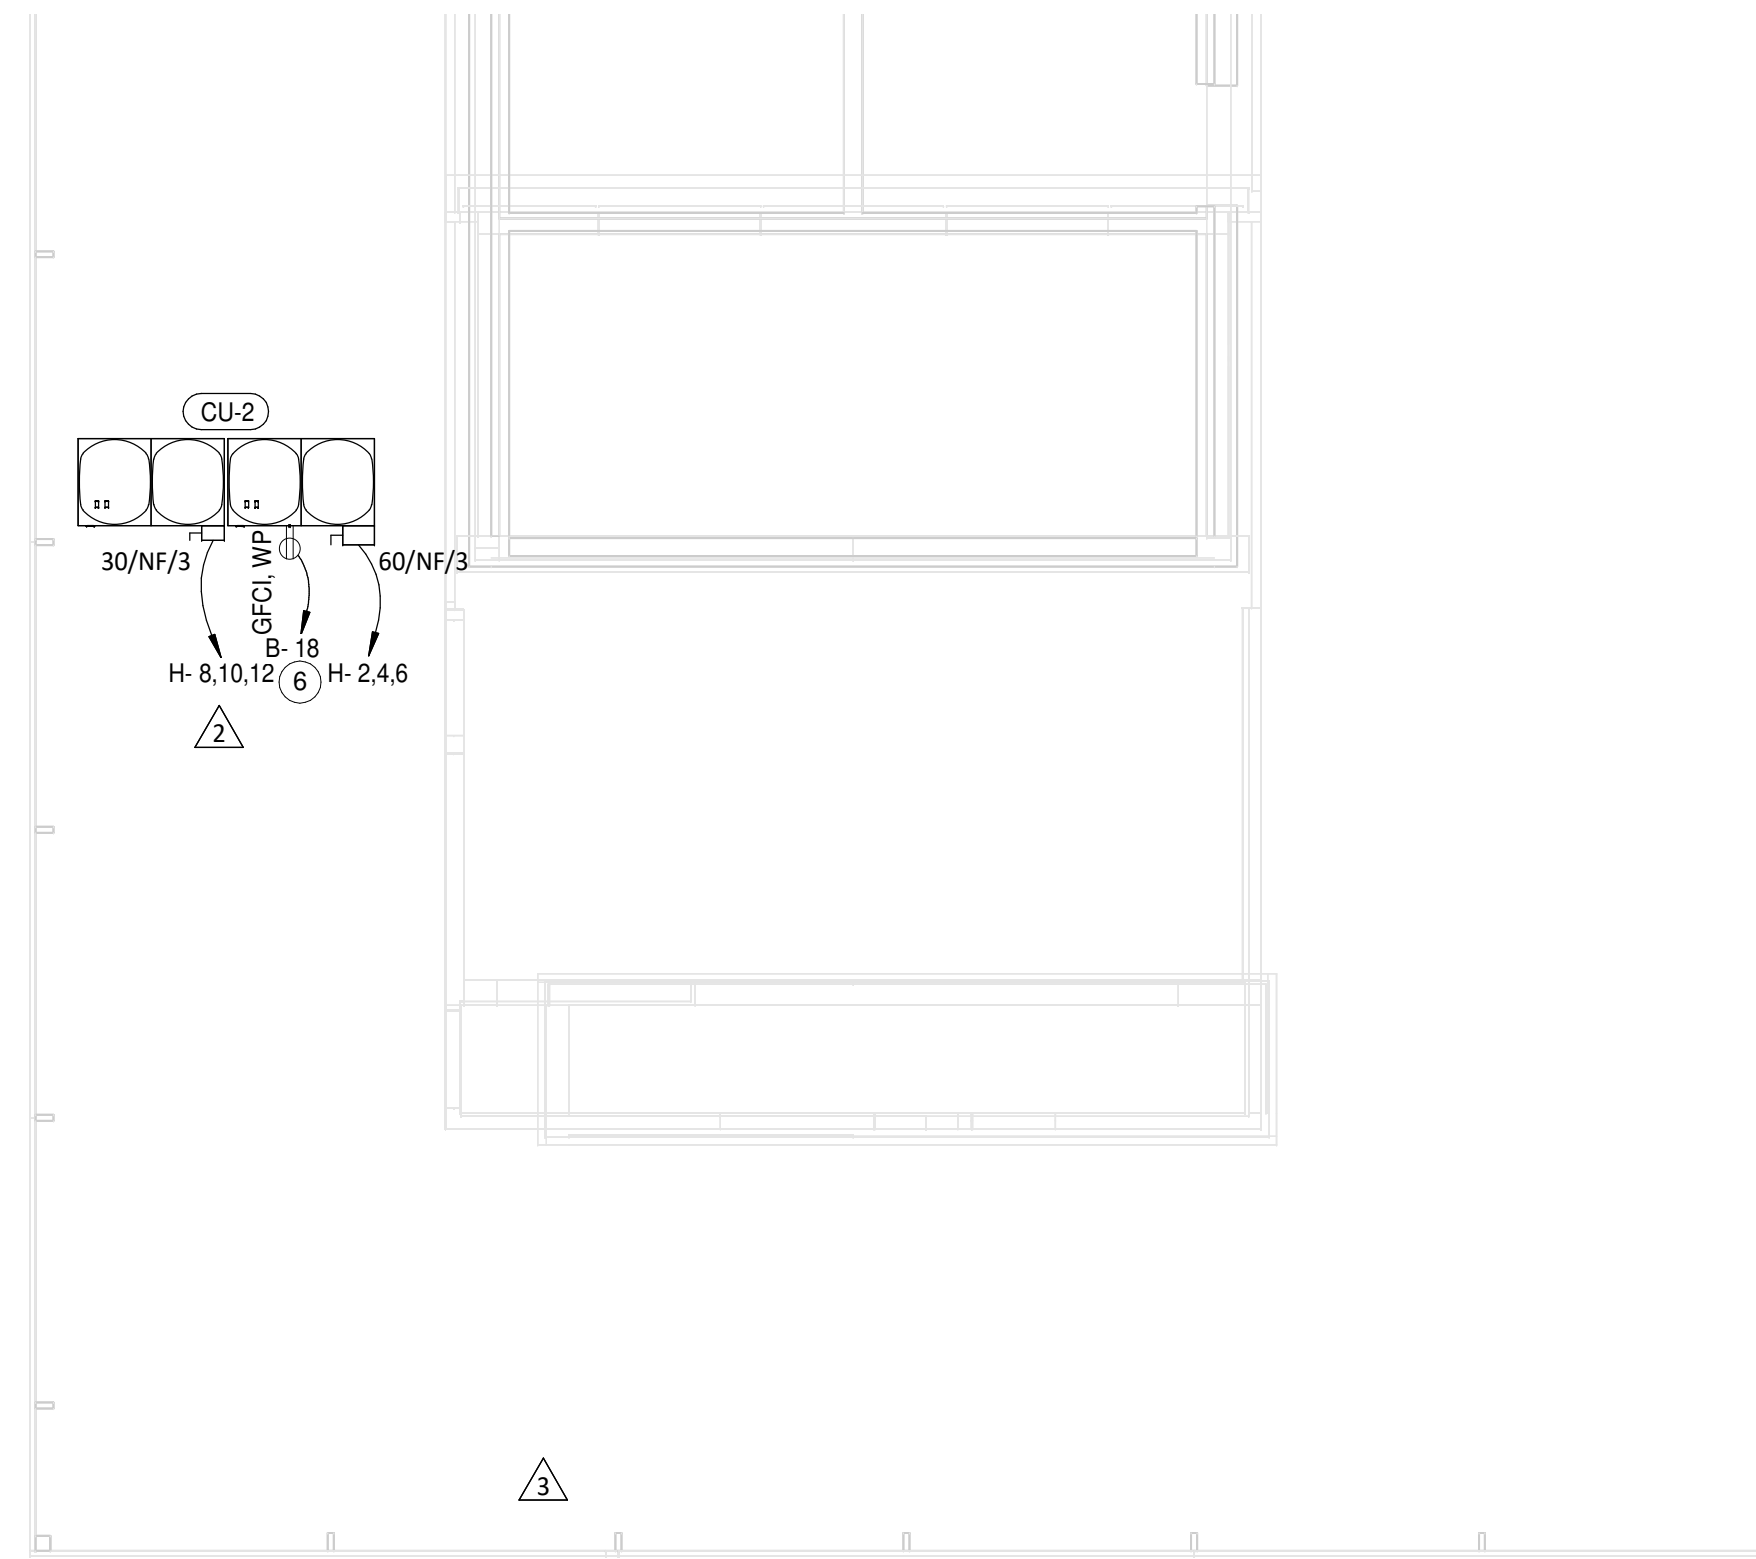

POWER ROOF PLAN
3/16" = 1'-0"
NORTH

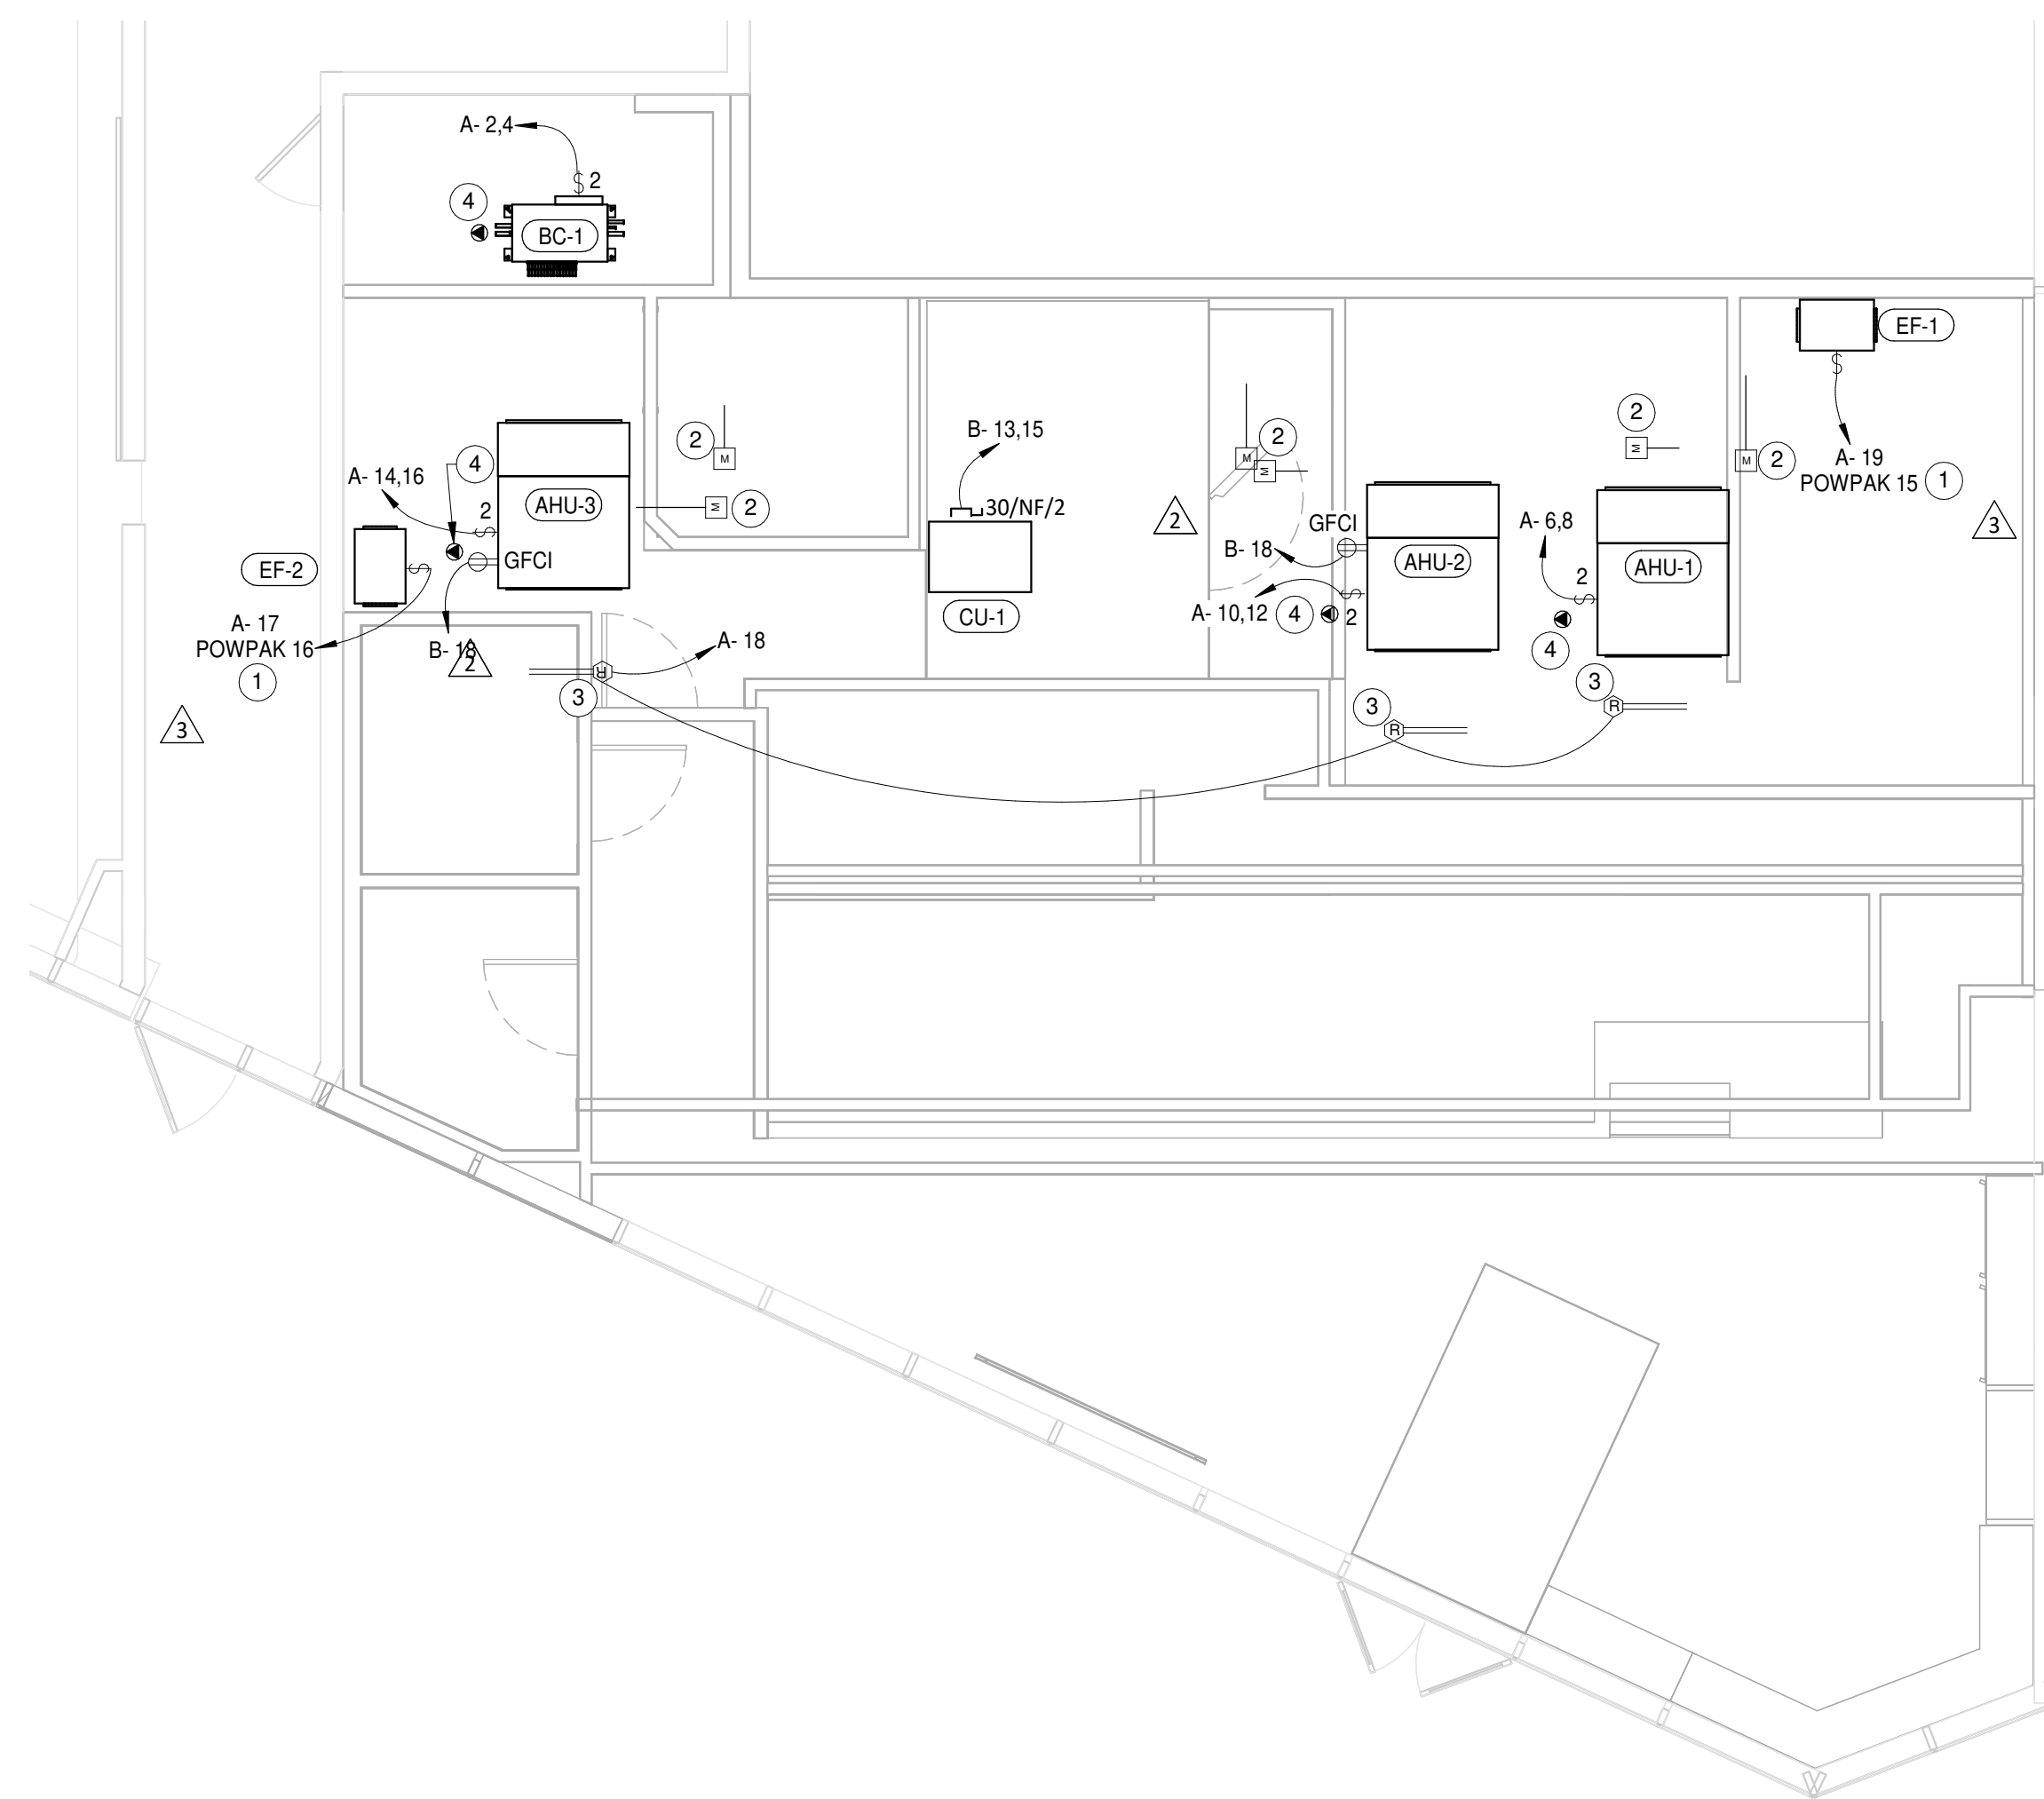

MECHANICAL POWER PLAN
3/16" = 1'-0"
NORTH

SYMBOLS & ABBREVIATIONS

ELECTRICAL POWER SYMBOLS

- CONDUIT CONCEALED ABOVE THE CEILING, IN A WALL, OR IN A RACEWAY
- CONDUIT CONCEALED BELOW THE SLAB
- A-6 HOME-RUN TO PANELBOARD AND CIRCUIT NUMBER SHOWN
- PLAN NOTE: SEE PLAN NOTES LISTED ON THE SAME SHEET FOR NOTE MEANING
- DISCONNECT SWITCH:
X = SWITCH RATING
Y = FUSE SIZE (NF = NON-FUSED)
Z = NUMBER OF POLES
- JUNCTION BOX
- ELECTRIC PANELBOARD
- GENERAL PURPOSE 1-POLE SWITCH
- WEATHER-PROOF SWITCH
- NEMA 5-20R 1-POLE RECEPTACLE
- NEMA 5-20R DUPLEX RECEPTACLE
- NEMA 5-20R DUPLEX RECEPTACLE WITH USB
- NEMA 5-20R DOUBLE-DUPLEX RECEPTACLES
- NEMA 5-20R DUPLEX COMBINATION ISOLATED GROUND/GFI RECEPTACLE PASS & SEYMOUR MODEL#2095IGTR0
- OTHER RECEPTACLE - SEE PLAN FOR RATING AND TYPE

POWER ABBREVIATIONS

- (E) EXISTING
- (R) RELOCATED
- AFF ABOVE FINISHED FLOOR
- AFG ABOVE FINISHED GRADE
- C CONDUIT
- G GROUND
- GC GENERAL CONTRACTOR
- GFCI GROUND FAULT CURRENT INTERRUPT
- IG ISOLATED GROUND
- JB JUNCTION BOX
- KES TENANT'S KITCHEN EQUIPMENT SUPPLIER
- S SURFACE MOUNTED
- UNO UNLESS NOTED OTHERWISE
- WP WEATHERPROOF




sweetgreen

3101 W. EXPOSITION BLVD.
LOS ANGELES, CALIFORNIA 90018

THESE DRAWINGS & SPECIFICATIONS ARE CONFIDENTIAL AND SHALL REMAIN THE SOLE PROPERTY OF SWEETGREEN CORPORATION. THEY SHALL NOT BE REPRODUCED (IN WHOLE OR IN PART), SHARED WITH THIRD PARTIES OR USED IN ANY MANNER ON OTHER PROJECTS OR EXTENSIONS TO THIS PROJECT WITHOUT THE PRIOR WRITTEN CONSENT OF SWEETGREEN CORPORATION. THESE DRAWINGS & SPECIFICATIONS ARE INTENDED TO EXPRESS DESIGN INTENT FOR A PROTOTYPICAL SWEETGREEN STORE WHICH IS SUBJECT TO CHANGE AT ANY TIME AND MAY NOT REFLECT ACTUAL SITE CONDITIONS. NEITHER PARTY SHALL HAVE ANY OBLIGATION OR LIABILITY TO THE OTHER EXCEPT AS STATED ABOVE UNTIL A WRITTEN AGREEMENT IS FULLY EXECUTED.

ENGINEER OF RECORD:

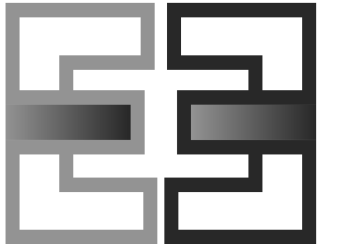

EVERJ ENGINEERING, INC.
1509 BUCK TRAIL LANE
WORTHINGTON, OH 43085
240-319-0822
www.everjengineering.com
TX ENGINEERING FIRM F-22980

STAMP:

CONSTRUCTION
ISSUE SET

07/24/2022

PROJECT INFORMATION:
MUELLER
PROJECT INFORMATION:
**1900 ALDRICH ST.
SUITE 140
AUSTIN, TX 78723**

DRAWN BY: JAE
CHECKED BY: MK
PROJECT MANAGER: JAE
SG DESIGN MANAGER: LG
SG CONSTR. MANAGER: KZ
PROJECT NO: 210005
TEMPLATE VERSION: 12/21/2021

REVISIONS
REV. DATE DESCRIPTION
1 05/05/22 LANDLORD COMMENTS
2 05/20/22 PLAN REVIEW COMMENTS

ELECTRICAL
LIGHTING
SCHEDULES

E-300

LUTRON LIGHTING CONTROL SYSTEM INFORMATION

CONTACT SWEETGREEN'S LUTRON REPRESENTATIVE FOR SYSTEM INFORMATION AT:
YAN WUJAYA
484505-0973
YWUJAYA@LUTRON.COM

- THE LIGHTING CONTROLS SHALL BE FURNISHED BY SWEETGREEN'S LIGHTING VENDOR. CONTACT LUTRON PRIOR TO BID TO OBTAIN LIGHTING CONTROL DIAGRAMS AND DETAILS AS REQUIRED.

- ANY CHANGES OR VARIATION TO THE EQUIPMENT PACKAGE THAT WOULD AFFECT THE LIGHTING CONTROL EQUIPMENT PACKAGE SHOULD BE BROUGHT TO THE ATTENTION OF THE LUTRON TEAM AND THE ARCHITECT/ENGINEER.

LIGHTING SEQUENCE OF OPERATIONS

LIGHT SWITCHES a, b, c - THESE LIGHT SWITCHES SHALL PROVIDE A TWO-HOUR OVERRIDE FOR THE SWITCHED AREA TO THE CURRENT SCENES AS DESCRIBED BELOW.

LIGHT SWITCH d - SHALL BE A FOUR-BUTTON PICO SWITCH TO PROVIDE A TWO-HOUR OVERRIDE WITH THE FOLLOWING PROGRAMMED SCENES: CLOSED, PREP, OPEN AND EVENING.

INTERIOR AND EXTERIOR SIGNAGE SHALL BE CONTROLLED BY A TIMECLOCK AND SHALL BE PROVIDED WITH A 2-HOUR OVERRIDE WHEN THEIR SWITCH IS UTILIZED.

12:00 AM - 6:30AM - "CLOSED"
DURING THIS TIME, A TWO HOUR OVERRIDE INITIATED BY OCCUPANCY SENSOR DETECTION SHALL ACTIVATE THE "PREP" SCENE.

KITCHEN (POWPAK 1-7) -	50%
DINING ROOM (POWPAK 8-10, 17) -	50%
EXTERIOR SIGNAGE (POWPAK 13, 14) -	ON
NEON (POWPAK 11, 12) -	ON
EXHAUST FAN (POWPAK 15, 16) -	OFF
OFFICE RECEPTACLES (POWPAK 18) -	OFF

6:30 AM - 10:00 AM - "PREP" KITCHEN (POWPAK 1-7) -	50%
DINING ROOM (POWPAK 8-10, 17) -	50%
EXTERIOR SIGNAGE (POWPAK 13, 14) -	ON
NEON (POWPAK 11, 12) -	ON
EXHAUST FAN (POWPAK 15, 16) -	ON
OFFICE RECEPTACLES (POWPAK 18) -	ON

10:00 AM - 0:15 PRIOR TO SUNSET - "OPEN" HALLWAY LIGHTING (POWPAK 10) -	75%
KITCHEN (POWPAK 1-7) -	50%
DINING ROOM (POWPAK 8, 9, 17) -	50%
EXTERIOR SIGNAGE (POWPAK 13, 14) -	OFF
NEON (POWPAK 11, 12) -	ON
EXHAUST FAN (POWPAK 15, 16) -	ON
OFFICE RECEPTACLES (POWPAK 18) -	ON

0:15 PRIOR TO SUNSET - 10:00 PM - "EVENING" BACK OF HOUSE LIGHTING (POWPAK 1, 2) -	50%
PREP LIGHTING (POWPAK 3-7) -	50%
DECORATIVE LIGHTING (POWPAK 9, 17) -	90%
DINING ROOM (POWPAK 8) -	65%
HALLWAY LIGHTING (POWPAK 10) -	50%
EXTERIOR SIGNAGE (POWPAK 13, 14) -	ON
NEON (POWPAK 11, 12) -	ON
EXHAUST FAN (POWPAK 15, 16) -	ON
OFFICE RECEPTACLES (POWPAK 18) -	ON

10:00 PM - 12:00 AM "PREP" KITCHEN (POWPAK 1-7) -	50%
DINING ROOM (POWPAK 8-10, 17) -	50%
EXTERIOR SIGNAGE (POWPAK 13, 14) -	ON
NEON (POWPAK 11, 12) -	ON
EXHAUST FAN (POWPAK 15, 16) -	ON
OFFICE RECEPTACLES (POWPAK 18) -	OFF

LIGHTING CONTROL SCHEDULE

TAG	SUPPLIER	INSTALLER	MANUFACTURER	MODEL
a	OWNER	GC	LUTRON	PJ2-3BRL-GWH-L01
b	OWNER	GC	LUTRON	PJ2-3BRL-GWH-L01
c	OWNER	GC	LUTRON	PJ2-3BRL-GWH-L01
d	OWNER	GC	LUTRON	PJ2-4B-GWH-EL2
HB-1	OWNER	GC	LUTRON	HJS-0-FM

EM1 CONNECTED LOAD

TAG	COUNT	WATTS
GP1-W	5	60
TOTAL CONNECTED WATTAGE		60

EM2 CONNECTED LOAD

TAG	COUNT	WATTS
C1-W	5	65
TOTAL CONNECTED WATTAGE		65

POWPAK SCHEDULE

TAG	SUPPLIER	INSTALLER	PANEL	CIRCUIT NUMBER	AREA SERVED	CONTROL	MANUFACTURER	MODEL	CONTROL TYPE	CONTROL SWITCH
1	OWNER	GC	A	34	BOH GENERAL LIGHTING	MANUAL/TIMECLOCK	LUTRON	RMJS-8T-DV-B	0-10V	a/d
2	OWNER	GC	A	34	WIC / HD2 LIGHTING	MANUAL/TIMECLOCK	LUTRON	RMJS-16R-DV-B	SWITCHED	d
3	OWNER	GC	A	38	COLD PREP GENERAL LIGHTING	MANUAL/TIMECLOCK	LUTRON	RMJS-8T-DV-B-EM	0-10V	b/d
4	OWNER	GC	A	38	COLD PREP WORKING LIGHTING	MANUAL/TIMECLOCK	LUTRON	RMJS-8T-DV-B	0-10V	b/d
5	OWNER	GC	A	38	OLO WORKINGS LIGHTING	MANUAL/TIMECLOCK	LUTRON	RMJS-8T-DV-B	0-10V	b/d
6	OWNER	GC	A	38	OLO/SERVE LINE GENERAL LIGHTING	MANUAL/TIMECLOCK	LUTRON	RMJS-8T-DV-B-EM	0-10V	b/d
7	OWNER	GC	A	38	SERVE LINE WORKING LIGHTING	MANUAL/TIMECLOCK	LUTRON	RMJS-8T-DV-B	0-10V	b/d
8	OWNER	GC	A	32	DINING ROOM GENERAL LIGHTING	MANUAL/TIMECLOCK	LUTRON	RMJS-8T-DV-B-EM	0-10V	c/d
9	OWNER	GC	A	38	LOCAL LIST LIGHTING	MANUAL/TIMECLOCK	LUTRON	RMJS-PNE-DV	PHASE	c/d
10	OWNER	GC	A	32	HALLWAY GENERAL LIGHTING	MANUAL/TIMECLOCK	LUTRON	RMJS-8T-DV-B-EM	0-10V	c/d
11	OWNER	GC	A	40	OLO SIGNAGE	MANUAL/TIMECLOCK	LUTRON	RMJS-16R-DV-B	SWITCHED	d
12	OWNER	GC	A	41	WINDOW NEON	MANUAL/TIMECLOCK	LUTRON	RMJS-PNE-DV	PHASE	d
13	OWNER	GC	A	42	STOREFRONT SIGNAGE	MANUAL/TIMECLOCK	LUTRON	RMJS-PNE-DV	PHASE	d
14	OWNER	GC	A	39	STOREFRONT SIGNAGE	MANUAL/TIMECLOCK	LUTRON	RMJS-PNE-DV	PHASE	d
15	OWNER	GC	A	19	EF-1	TIMECLOCK	LUTRON	RMJS-16R-DV-B	SWITCHED	d
16	OWNER	GC	A	17	EF-2	TIMECLOCK	LUTRON	RMJS-16R-DV-B	SWITCHED	d
17	OWNER	GC	A	32	DECORATIVE PENDANT LIGHTING	MANUAL/TIMECLOCK	LUTRON	RMJS-8T-DV-B	0-10V	c/d
18	OWNER	GC	A	26	OFFICE RECEPTACLES	TIMECLOCK	LUTRON	RMJS-16R-DV-B	SWITCHED	d

LIGHTING FIXTURE SCHEDULE

TAG	SUPPLIER	INSTALLER	MANUFACTURER	MODEL	LAMP(S)	MOUNTING	VOLTS	WATTS	DIMMING STYLE	DESCRIPTION	REMARKS
C1-W	OWNER	GC	HALO LIGHTING	H457TATE010 FRAME - EL406930 LIGHT ENGINE - TL410WH TRIM L10 SAND BLASTED LENS	INTEGRAL 3000K LED	GYPSUM BOARD	120	13.0	0-10V	4" LED RECESSED CAN LIGHT. NON IC RATED.	
EM1	OWNER	GC	LIGHTALARMS	LCAB-2SQLED	(2) LED HEADS WITH 200 LUMEN OUTPUT	SURFACE	120	7.2	NONE	THERMOPLASTIC EMERGENCY LIGHTING UNIT WITH 90 MINUTE NICAD BATTERY BACKUP. UL 924 COMPLIANT	
EM7	OWNER	GC	CONTECH	REXA-SF-G-EM-P	INTEGRAL LED	UNIVERSAL	120	3.0	NONE	EDGE LIT EXIT SIGN WITH STEEL HOUSING AND TRIM PLATE. GREEN LETTERS, CLEAR SINGLE FACE, UNIVERSAL MOUNTING, UNIVERSAL ARROWS 6" LETTERS AND 90 MINUTE BATTERY BACKUP. UL 924 COMPLIANT.	
F2	OWNER	GC	ABB LIGHTING	FLP-24-D-53W-30	INTEGRAL 3000K LED	LAY-IN	120	53.0	0-10V		
FP-1	OWNER	GC	SPECTRUM	GPRF1200LEDGV-15L-30K-DS10X-CM96-MW	INTEGRAL 3000K LED	PENDANT	120	10.0	0-10V	FEATURE PENDANT LIGHT	
GP1-W	OWNER	GC	DMF LIGHTING	DCC-CC-S-M-4-D-10-G-0-00-0-30-WH-O-00	INTEGRAL 3000K LED	PENDANT	120	12.0	0-10V	4" DIAMETER, 8" HIGH CYLINDER MEDIUM, 8" ADJUSTABLE CORD MOUNT, 0-10V DIMMING, WHITE FINISH	ADJUST CORD LENGTH FOR MOUNTING HEIGHT CALLED FOR IN THE ARCHITECTURAL DRAWINGS.
H1	KES	GC	ALLANSON LIGHTING TECHNOLOGIES	(ALF16-120V-WW-R)-(54-262-02-ALT)	PROVIDED BY THE KES	INTEGRAL TO HOOD	120	17.0	N/A		MAKE ALL CONNECTIONS AND INSTALL LAMPS AS REQUIRED.
RL1.1	OWNER	GC	CORONET LIGHTING	LSR2LED-4FT-LTG1-3000K-UNV-DB-W-NT	INTEGRAL 3000K LED	GYPSUM BOARD	120	29.0	0-10V	RECESSED LINEAR LED LIGHT. 48" LENGTH	
RL1.2	OWNER	GC	CORONET LIGHTING	LSR2LED-6FT-LTG1-3000K-UNV-DV-W-NT	INTEGRAL 3000K LED	GYPSUM BOARD	120	43.5	0-10V	RECESSED LINEAR LED LIGHT. 96" LENGTH	
WS3-B	OWNER	GC	BRENDAN RAVENHILL	ADA SCNCE 25	INTEGRAL 2700K LED	WALL	120	27.0	ELV	WALL MOUNTED SCNCE 5.75" X 3.5" X 25" BLACK FINISH, 2700K, 90 CRI, ELV DIMMING	
WS5	OWNER	GC	RICH BRILLIANT WILLING	DP-AA01-S4-27-120-TR-IP20	INTEGRAL 2700K LED	WALL	120	8.5	TRIAC	WALL MOUNTED SCNCE 5.25" X 3.2" DEPTH, DIMPLE, NATURAL BACKPLATE AND FROSTED GLASS	

ALL LIGHT FIXTURES IN THE FOOD PREPARATION AND SERVING AREAS MUST BE EQUIPPED WITH SHIELDS

MATERIAL SCHEDULE		
CATEGORY	APPLICATION	ALLOWABLE MATERIAL
CONDUCTORS	#10 AWG AND SMALLER	SOLID CU, TYPE THHN/THWN OR XHHW
	#8 AWG AND LARGER	STRANDED CU, TYPE THHN/THWN OR XHHW
CONDUITS	OUTDOOR, EXPOSED OR CONCEALED	INTERMEDIATE METAL CONDUIT
	OUTDOOR OR INDOOR, DAMP LOCATIONS, CONNECTION TO VIBRATING EQUIPMENT	LIQUIDTIGHT FLEXIBLE METAL CONDUIT
	INDOOR, EXPOSED	ELECTRICAL METALIC TUBING U.N.O.
	INDOOR, WITHIN 1-1/2" OF ROOF DECK	INTERMEDIATE METAL CONDUIT
	INDOOR, CONCEALED	ELECTRICAL METALLIC CONDUIT OR METAL CLAD CABLE
	INDOOR DRY LOCATIONS, CONNECTION TO VIBRATING EQUIPMENT	FLEXIBLE METAL CONDUIT
	LOW VOLTAGE, INDOOR, ABOVE GRADE	ELECTRICAL METALLIC TUBING
	LOW VOLTAGE, BELOW GRADE	RIGID NONMETALLIC CONDUIT (SCHEDULE 40 PVC)
	IN KITCHEN (NON-TILE SURFACES), OFFICE OR NON-PUBLIC SPACE	GRAY DECORA DEVICE WITH STAINLESS STEEL COVER PLATE
	IN KITCHEN (TILE SURFACES)	WHITE DECORA DEVICE WITH WHITE COVER PLATE
WIRING DEVICES	IG OR IG/GFI RECEPTACLES	GRAY DECORA DEVICE WITH STAINLESS STEEL COVER PLATE
	ON DRYWALL IN DINING ROOM	WHITE DECORA DEVICE WITH WHITE COVER PLATE
	IN RESTROOMS	WHITE TAMPER RESISTANT DECORA DEVICE WITH WHITE COVER PLATE
	IN MILLWORK	WHITE TAMPER RESISTANT DECORA DEVICE WITH TWO USB PORTS WITH BRUSHED NICKEL COVER PLATE

VOLTS: 480/277V WYE PHASES: 3 WIRES: 4 MOUNTING: RECESSED ENCLOSURE: TYPE 1												PANEL: H MAINS: MCB AMPERAGE: 225 A MCB RATING: 200 A											
CKT	CIRCUIT DESCRIPTION	RATING	POLES	TYPE	NOTES	CKT AMPS	LOAD TYPE	A	B	C	LOAD TYPE	CKT AMPS	TYPE	NOTES	POLES	RATING	CIRCUIT DESCRIPTION	CKT					
1								27.54	6.10									2					
3	T1	125 A	3			98.7			26.87	6.10	C	22.0	HACR	3	35 A		CU-2, SECTION ONE (3-#8, #10G, IN 3/4" C.)	4					
5										27.64	6.10							6					
7	SPACE						0.00	5.27										8					
9	SPACE							0.00	5.27			C	19.0	HACR	3	30 A	CU-2, SECTION TWO (3-#10, #10G, IN 3/4" C.)	10					
11	SPACE									0.00	5.27							12					
13	SPACE						0.00	0.00									SPACE	14					
15	SPACE							0.00	0.00								SPACE	16					
17	SPACE								0.00	0.00							SPACE	18					
19	SPACE						0.00	0.00									SPACE	20					
21	SPACE							0.00	0.00								SPACE	22					
23	SPACE									0.00	0.00						SPACE	24					
25	SPACE						0.00	0.00									SPACE	26					
27	SPACE							0.00	0.00								SPACE	28					
29	SPACE									0.00	0.00						SPACE	30					
								KVA	38.90 KVA	38.23 KVA	39.00 KVA												
								AMPS	141 A	138 A	141 A												
TYPE DESCRIPTION												CONNECTED LOAD		DEMAND FACTOR		ESTIMATED DEMAND		PANEL TOTALS					
A INTERIOR LIGHTING												3.06 KVA		125.00%		3.82 KVA		TOTAL CONNECTED KVA: 116.13 KVA					
B EXTERIOR LIGHTING												2.40 KVA		125.00%		3.00 KVA		TOTAL CONNECTED AMPS: 140 A					
C COMFORT COOLING												39.67 KVA		100.00% +25% LARGEST MOTOR		39.67 KVA		TOTAL ESTIMATED KVA: 98.87 KVA					
D COMFORT HEATING												0.00 KVA		0.00%		0.00 KVA		TOTAL ESTIMATED AMPS: 119 A					
E MISC. MOTOR												9.69 KVA		100.00%		9.69 KVA							
F KITCHEN EQUIPMENT												52.16 KVA		65.00%		33.91 KVA							
G RECEPTACLES												8.78 KVA		100.00%		8.78 KVA							

PANEL NAME: LAPC					VOLTS: 120				
MOUNTING: SURFACE					PHASES: 1				
ENCLOSURE: TYPE 1					MAINS: MCB				
					AMPERAGE: 20 A				
					WIRES: 3				
CKT	CIRCUIT DESCRIPTION	TRIP	POLES	LOAD (KVA)					
1	RECEPTACLE - POS	20 A	1	0.72					
2	SPARE	20 A	1	0.00					
3	RECEPTACLE - OLO	20 A	1	0.36					
4	SPARE	20 A	1	0.00					
				TOTAL LOAD:	1.08 KVA				
				TOTAL AMPS:	9 A				

VOLTS: 208/120V WYE PHASES: 3 WIRES: 4 MOUNTING: RECESSED ENCLOSURE: TYPE 1												PANEL: A MAINS: MCB AMPERAGE: 225 A MCB RATING: 225 A											
CKT	CIRCUIT DESCRIPTION	RATING	POLES	TYPE	NOTES	CKT AMPS	LOAD TYPE	A	B	C	LOAD TYPE	CKT AMPS	TYPE	NOTES	POLES	RATING	CIRCUIT DESCRIPTION	CKT					
1	DWH-1	20 A	1			3.3	F	0.40	0.07								BC-1 (2-#10, #10G, IN 3/4" C.)	2					
3	P-2	20 A	1			0.5	F		0.06	0.07								4					
5	DATE OODE GENIE	20 A	1			3.0	F			0.36	0.80						AHU-1 (2-#10, #10G, IN 3/4" C.)	6					
7	K420 - VEGETABLE DRYER	20 A	1			2.7	F	0.32	0.80									8					
9	P-1	20 A	1			0.0	F		0.00	0.80							AHU-2 (2-#10, #10G, IN 3/4" C.)	10					
11	K560 - CONDENSATE HOOD	20 A	1			1.4	F			0.17	0.80							12					
13	FLY LIGHT	20 A	1			1.5	F	0.18	0.85								AHU-3 (2-#10, #10G, IN 3/4" C.)	14					
15	WATER BLOWER	20 A	1			1.5	F		0.18	0.85								16					
17	EF-2	15 A	1			7.9	E			0.95	0.54						REME AIR PURIFICATION SYSTEM	18					
19	EF-1	15 A	1			7.9	E	0.95	0.54								DIGITAL MENU DISPLAY	20					
21	RECEPTACLE - A/V RACK	20 A	1			1.5	G		0.18	1.08							RECEPTACLE - DINING CONVENIENCE	22					
23	RECEPTACLE - A/V RACK	20 A	1			1.5	G			0.18	1.08						RECEPTACLES - OFFICE	24					
25	RECEPTACLE - A/V RACK	20 A	1			1.5	G	0.18	0.90								RECEPTACLE - OFFICE	26					
27	RECEPTACLE - A/V RACK	20 A	1			1.5	G		0.18	1.08							LAPC	28					
29	RECEPTACLE - SERVE LINE CONVENIENCE	20 A	1			1.5	G			0.18	0.18						RECEPTACLE - LOCAL LIST	30					
31	ALARM PANEL	20 A	1			1.2	G	0.14	0.52								LIGHTING - DINING ROOM	32					
33	RECEPTACLES - RESTROOM	20 A	1			3.0	G		0.36	0.66							LIGHTING - BACK KITCHEN	34					
35	RECEPTACLES - PREP LINE	20 A	1			1.5	G			0.18	0.07						LIGHTING - WIRELESS HUB	36					
37	RECEPTACLE - STOREFRONT	20 A	1			10.5	G	1.26	0.80								LIGHTING - FRONT KITCHEN	38					
39	EXTERIOR SIGNAGE	20 A	1			10.0	B		1.20	0.18							LIGHTING - PICKUP	40					
41	LIGHTING - NEON SIGNAGE	20 A	1			10.0	A			1.20	1.20						EXTERIOR SIGNAGE	42					
								KVA	27.54 KVA	26.87 KVA	27.64 KVA												
								AMPS	230 A	224 A	231 A												
TYPE DESCRIPTION												CONNECTED LOAD		DEMAND FACTOR		ESTIMATED DEMAND		PANEL TOTALS					
A INTERIOR LIGHTING												3.06 KVA		125.00%		3.82 KVA		TOTAL CONNECTED KVA: 82.05 KVA					
B EXTERIOR LIGHTING												2.40 KVA		125.00%		3.00 KVA		TOTAL CONNECTED AMPS: 228 A					
C COMFORT COOLING												5.59 KVA		100.00% +25% LARGEST MOTOR		5.59 KVA		TOTAL ESTIMATED KVA: 64.78 KVA					
D COMFORT HEATING												0.00 KVA		0.00%		0.00 KVA		TOTAL ESTIMATED AMPS: 180 A					
E MISC. MOTOR												9.69 KVA		100.00%		9.69 KVA							
F KITCHEN EQUIPMENT												52.16 KVA		65.00%		33.91 KVA							
G RECEPTACLES												8.78 KVA		100.00%		8.78 KVA							




sweetgreen

3101 W. EXPOSITION BLVD.
LOS ANGELES, CALIFORNIA 90018

THESE DRAWINGS & SPECIFICATIONS ARE CONFIDENTIAL AND SHALL REMAIN THE SOLE PROPERTY OF SWEETGREEN CORPORATION. THEY SHALL NOT BE REPRODUCED IN WHOLE OR IN PART, SHARED WITH THIRD PARTIES OR USED IN ANY MANNER ON OTHER PROJECTS OR EXTENSIONS TO THIS PROJECT WITHOUT THE PRIOR WRITTEN CONSENT OF SWEETGREEN CORPORATION. THESE DRAWINGS & SPECIFICATIONS ARE INTENDED TO EXPRESS DESIGN INTENT FOR A PROTOTYPICAL SWEETGREEN STORE WHICH IS SUBJECT TO CHANGE AT ANY TIME AND MAY NOT REFLECT ACTUAL SITE CONDITIONS. NEITHER PARTY SHALL HAVE ANY OBLIGATION OR LIABILITY TO THE OTHER EXCEPT AS STATED ABOVE UNTIL A WRITTEN AGREEMENT IS FULLY EXECUTED.

ENGINEER OF RECORD:

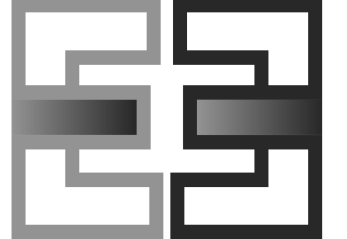

EVERJ ENGINEERING, INC.
1509 BUCK TRAIL LANE
WORTHINGTON, OH 43085
240-319-0822
www.everjengineering.com
TX ENGINEERING FIRM F-22980

STAMP:

CONSTRUCTION
ISSUE SET

07/24/2022

PROJECT INFORMATION:
MUELLER

PROJECT INFORMATION:
1900 ALDRICH ST.
SUITE 140
AUSTIN, TX 78723

DRAWN BY: JAE
CHECKED BY: MK
PROJECT MANAGER: JAE
SG DESIGN MANAGER: LG
SG CONSTR. MANAGER: KZ
PROJECT NO: 210005
TEMPLATE VERSION: 12/21/2021

REVISIONS
REV. DATE DESCRIPTION
2 05/20/22 PLAN REVIEW COMMENTS
3 06/29/22 CLIENT CHANGES

ELECTRICAL
SCHEDULES

E-310




sweetgreen

3101 W. EXPOSITION BLVD.
LOS ANGELES, CALIFORNIA 90018

THESE DRAWINGS & SPECIFICATIONS ARE CONFIDENTIAL AND SHALL REMAIN THE SOLE PROPERTY OF SWEETGREEN CORPORATION. THEY SHALL NOT BE REPRODUCED (IN WHOLE OR IN PART), SHARED WITH THIRD PARTIES OR USED IN ANY MANNER ON OTHER PROJECTS OR EXTENSIONS TO THIS PROJECT WITHOUT THE PRIOR WRITTEN CONSENT OF SWEETGREEN CORPORATION. THESE DRAWINGS & SPECIFICATIONS ARE INTENDED TO EXPRESS DESIGN INTENT FOR A PROTOTYPICAL SWEETGREEN STORE WHICH IS SUBJECT TO CHANGE AT ANY TIME AND MAY NOT REFLECT ACTUAL SITE CONDITIONS. NEITHER PARTY SHALL HAVE ANY OBLIGATION OR LIABILITY TO THE OTHER (EXCEPT AS STATED ABOVE) UNTIL A WRITTEN AGREEMENT IS FULLY EXECUTED.

ENGINEER OF RECORD:

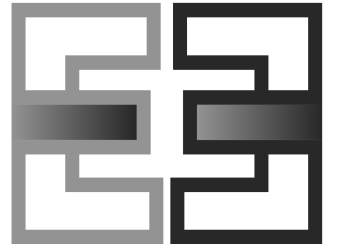

EVERJ ENGINEERING, INC.
1509 BUCK TRAIL LANE
WORTHINGTON, OH 43085
240-319-0822
www.everjengineering.com
TX ENGINEERING FIRM F-22980

STAMP:

CONSTRUCTION
ISSUE SET

07/24/2022

PROJECT INFORMATION:
MUELLER

PROJECT INFORMATION:
**1900 ALDRICH ST.
SUITE 140
AUSTIN, TX 78723**

DRAWN BY: JAE
CHECKED BY: MK
PROJECT MANAGER: JAE
SG DESIGN MANAGER: LG
SG CONSTR. MANAGER: KZ
PROJECT NO: 210005
TEMPLATE VERSION: 12/21/2021

REVISIONS
REV. DATE DESCRIPTION
2 05/20/22 PLAN REVIEW COMMENTS
3 06/29/22 CLIENT CHANGES

ELECTRICAL
SCHEDULES


E-311

VOLTS: 208/120V WYE PHASES: 3 WIRES: 4 MOUNTING: RECESSED ENCLOSURE: TYPE 1													PANEL: C MAINS: MLO AMPERAGE 225 A												
CKT	CIRCUIT DESCRIPTION	RATING	POLES	TYPE NOTES	CKT AMPS	LOAD TYPE	A	B	C	LOAD TYPE	CKT AMPS	TYPE NOTES	POLES	RATING	CIRCUIT DESCRIPTION	CKT									
1	K111 - MIXING TABLE	20 A	1		4.7	F	0.56	0.00							SPARE	2									
3	RECEPTACLE - EMPLOYEE	20 A	1		1.5	G		0.18	0.00						SPARE	4									
5									0.00						SPARE	6									
7	SPARE	20 A	1				0.00	0.00							SPARE	8									
9	SPARE	20 A	1					0.00	0.00						SPARE	10									
11	SPARE	20 A	1						0.00	0.00					SPARE	12									
13	SPARE	20 A	1				0.00	0.00							SPARE	14									
15	SPARE	20 A	1					0.00	0.00						SPARE	16									
17	SPARE	20 A	1						0.00	0.00					SPARE	18									
19	SPARE	20 A	1				0.00	0.00							SPARE	20									
21	SPACE							0.00	0.00						SPACE	22									
23	SPACE								0.00	0.00					SPACE	24									
25	SPACE						0.00	0.00							SPACE	26									
27	SPACE							0.00	0.00						SPACE	28									
29	SPACE								0.00	0.00					SPACE	30									
31	SPACE						0.00	0.00							SPACE	32									
33	SPACE							0.00	0.00						SPACE	34									
35	SPACE								0.00	0.00					SPACE	36									
37	SPACE						0.00	0.00							SPACE	38									
39	SPACE							0.00	0.00						SPACE	40									
41	SPACE								0.00	0.00					SPACE	42									
							KVA	0.56 kVA	0.18 kVA	0.00 kVA															
							AMPS	5 A	2 A	0 A															

VOLTS: 208/120V WYE PHASES: 3 WIRES: 4 MOUNTING: RECESSED ENCLOSURE: TYPE 1													PANEL: B MAINS: MLO AMPERAGE 225 A												
CKT	CIRCUIT DESCRIPTION	RATING	POLES	TYPE NOTES	CKT AMPS	LOAD TYPE	A	B	C	LOAD TYPE	CKT AMPS	TYPE NOTES	POLES	RATING	CIRCUIT DESCRIPTION	CKT									
1							3.60	1.65								2									
3	K540 - COMBI OVEN (365, 1#10G. IN 3/4" C.)	35 A	3	GFCI	30.0	F		3.60	1.65						K126 - SERVE HOT FOOD WELLS (3#10, #10G. IN 3/4" C.)	4									
5									3.60	1.65						6									
7							3.60	0.62							K145 - HOT FOOD WELLS (2#10, #10G. IN 3/4" C.)	8									
9	K540 - COMBI OVEN (365, 1#10G. IN 3/4" C.)	35 A	3	GFCI	30.0	F		3.60	0.62							10									
11									3.60	0.66					K561 - BLAST CHILLER (2#10, #10G. IN 3/4" C.)	12									
13							1.70	0.66								14									
15	CJ-1 (2-#10, #10G. IN 3/4" C.)	25 A	2	HACR	16.3	E		1.70	0.72						K301 - MEGA TOP REFRIGERATOR	16									
17	K223-1 ICE MAKER WITH BIN	15 A	1	HACR GFCI	10.0	F			1.20	0.54						18									
19	K308 - COUNTER-TOP PREP UNIT	20 A	1		2.8	F	0.34	1.20							K306 - WATERLESS HOT FOOD WELL	20									
21	SPARE	20 A	1					0.00	1.03						K304 - 5 PAN OLO W/ REFRIGERATED BASE	22									
23	K520 - RICE COOKER	20 A	1	GFCI	18.0	F			2.16	0.60					K303 - HOT FOOD WELL UNIT	24									
25	SPARE	20 A	1				0.00	1.44							K107 - SELF SERVE CASE	26									
27	K520 - RICE COOKER	20 A	1	GFCI	18.0	F		2.16	0.64						K525 - UNDERCOUNTER WARMING DRAWER	28									
29	K520 - RICE COOKER	20 A	1	GFCI	18.0	F			2.16	0.64					K525 - UNDERCOUNTER WARMING DRAWER	30									
31	K633 - DISH MACHINE	20 A	1	GFCI	15.0	F	1.80	0.24							K307 - UNDERCOUNTER REFRIGERATOR	32									
33	K881 - REACH IN REFRIGERATOR	20 A	1		6.9	F		0.83	1.80						K431 - FOOD PROCESSOR	34									
35	K155 - COLD FOOD WELLS	20 A	1		3.2	F			0.38	1.20					COOLER EVAPORATOR	36									
37	K130 - REFRIGERATED SANDWICH UNIT	20 A	1		8.6	F	1.03	1.20							COOLER AIR DOOR	38									
39	K231 - WATER CHILLER AND DISPENSER	20 A	1		3.8	F		0.45	1.00						HAND DRYER - NORTH RR	40									
41	IMMERSION BLENDER	20 A	1		3.0	G			0.36	1.00					HAND DRYER - SOUTH RR	42									
							KVA	19.63 kVA	19.98 kVA	19.75 kVA															
							AMPS	164 A	167 A	165 A															

THESE DRAWINGS & SPECIFICATIONS ARE CONFIDENTIAL AND SHALL REMAIN THE SOLE PROPERTY OF SWEETGREEN CORPORATION. THEY SHALL NOT BE REPRODUCED (IN WHOLE OR IN PART), SHARED WITH THIRD PARTIES OR USED IN ANY MANNER ON OTHER PROJECTS OR EXTENSIONS TO THIS PROJECT WITHOUT THE PRIOR WRITTEN CONSENT OF SWEETGREEN CORPORATION. THESE DRAWINGS & SPECIFICATIONS ARE INTENDED TO EXPRESS DESIGN INTENT FOR A PROTOTYPICAL SWEETGREEN STORE WHICH IS SUBJECT TO CHANGE AT ANY TIME AND MAY NOT REFLECT ACTUAL SITE CONDITIONS. NEITHER PARTY SHALL HAVE ANY OBLIGATION OR LIABILITY TO THE OTHER EXCEPT AS STATED ABOVE UNTIL A WRITTEN AGREEMENT IS FULLY EXECUTED.

ENGINEER OF RECORD:

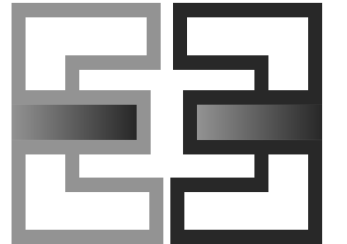

EVERJ ENGINEERING, INC.
1509 BUCK TRAIL LANE
WORTHINGTON, OH 43085
240-319-0822
www.everjengineering.com
TX ENGINEERING FIRM F-22980

STAMP:

CONSTRUCTION
ISSUE SET

07/24/2022

PROJECT INFORMATION:
MUELLER


PROJECT INFORMATION:
**1900 ALDRICH ST.
SUITE 140
AUSTIN, TX 78723**

DRAWN BY: JAE
CHECKED BY: MK
PROJECT MANAGER: JAE
SG DESIGN MANAGER: LG
SG CONSTR. MANAGER: KZ
PROJECT NO: 210005
TEMPLATE VERSION: 12/21/2021


REVISIONS
REV. DATE DESCRIPTION
2 05/20/22 PLAN REVIEW COMMENTS
3 06/29/22 CLIENT CHANGES

ELECTRICAL
ELEVATIONS


E-400

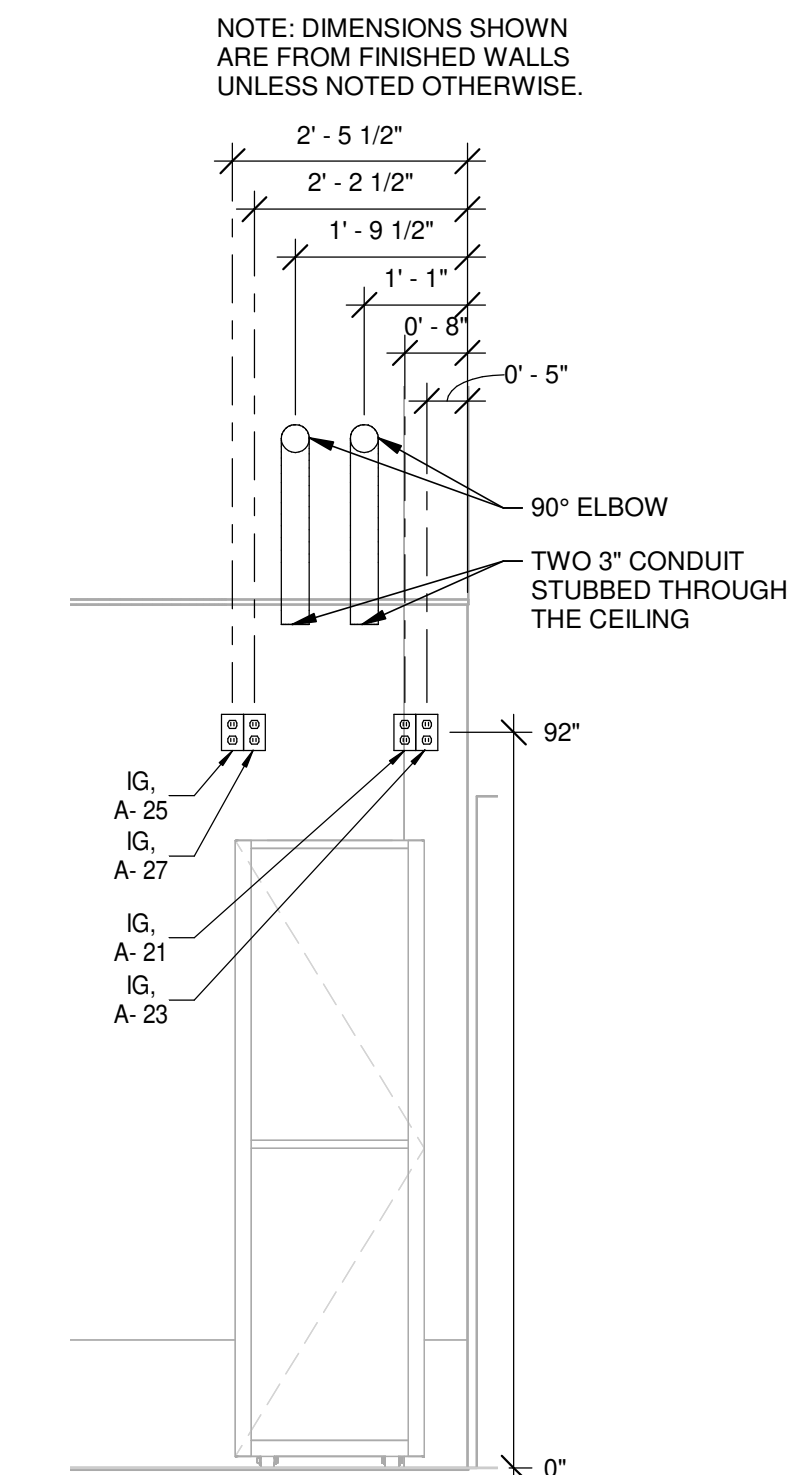


7 IT RACK ELEVATION
N.T.S.

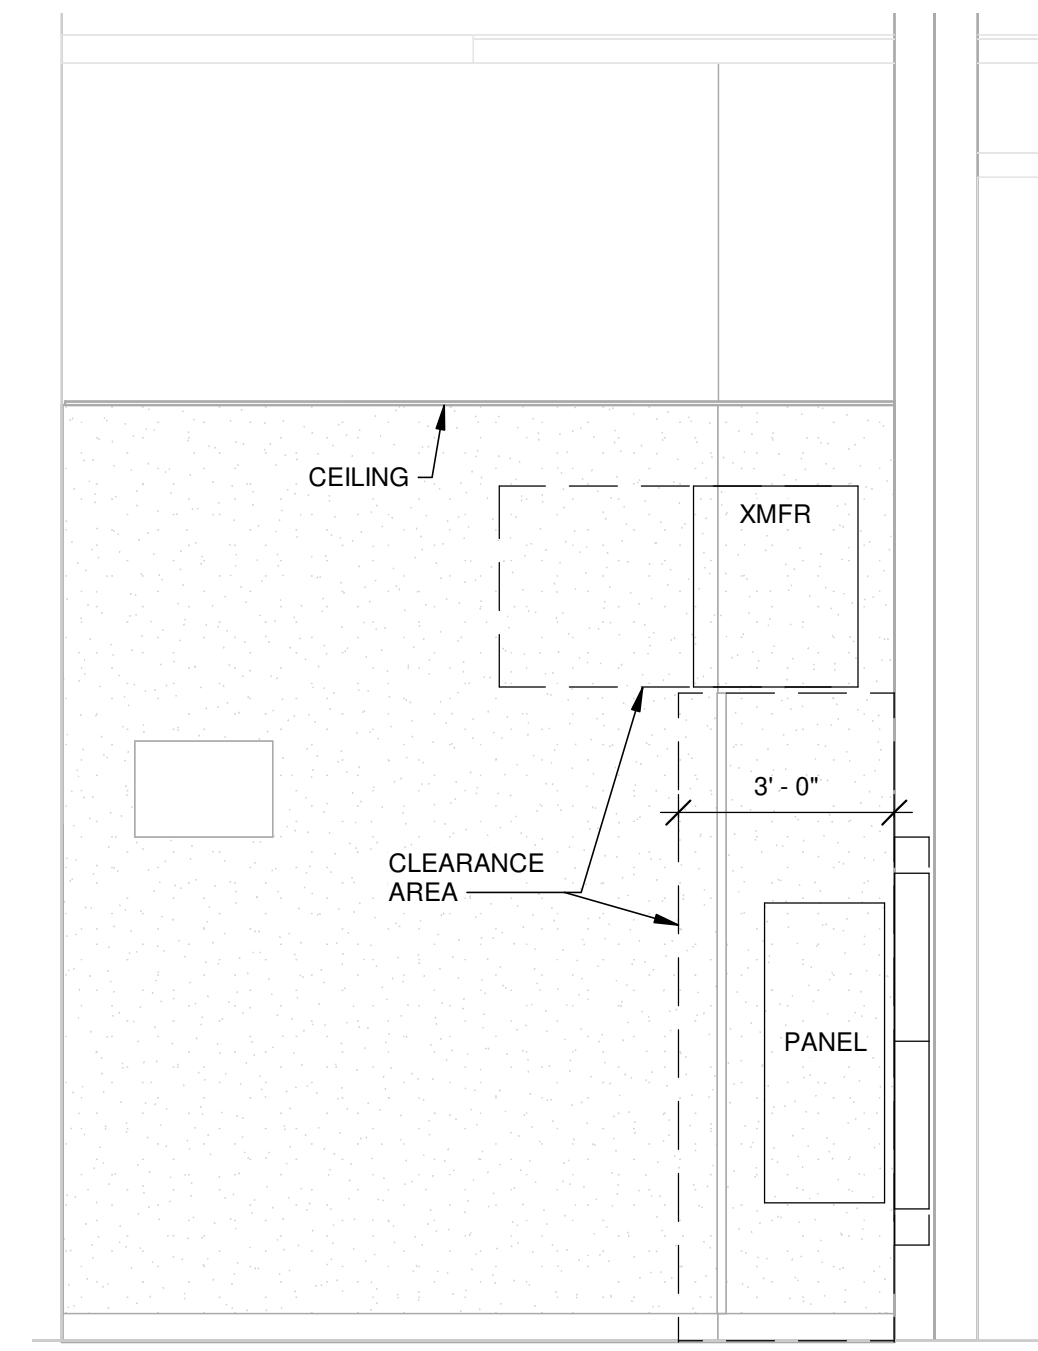


8 ELECTRICAL EQUIPMENT CLEARANCES
N.T.S.

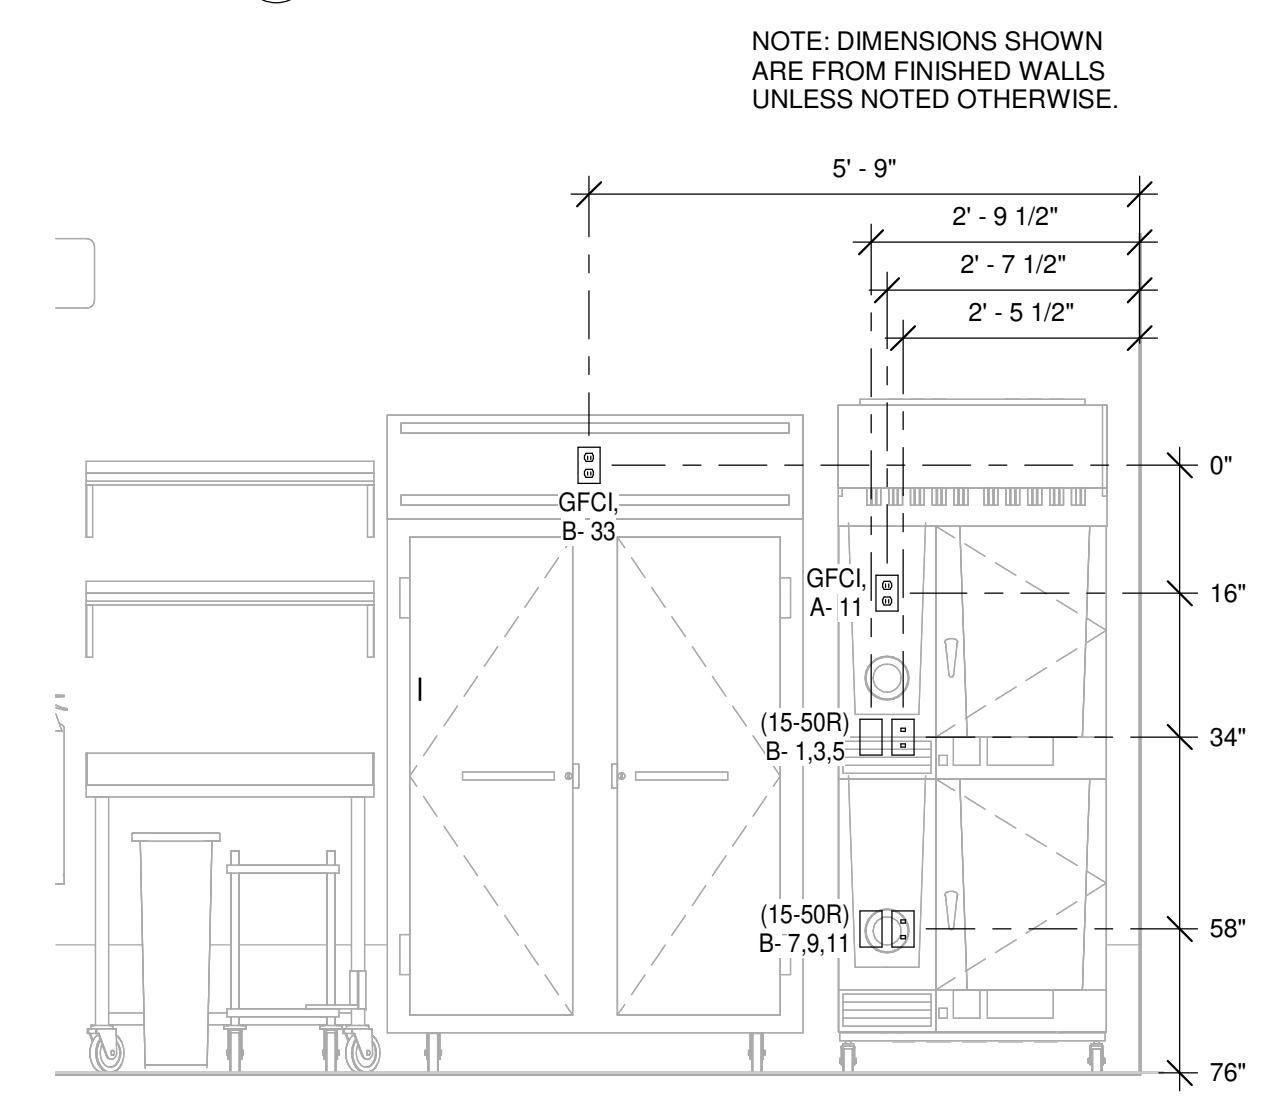


4 COMBINATION OVEN OLO ELEVATION
N.T.S.

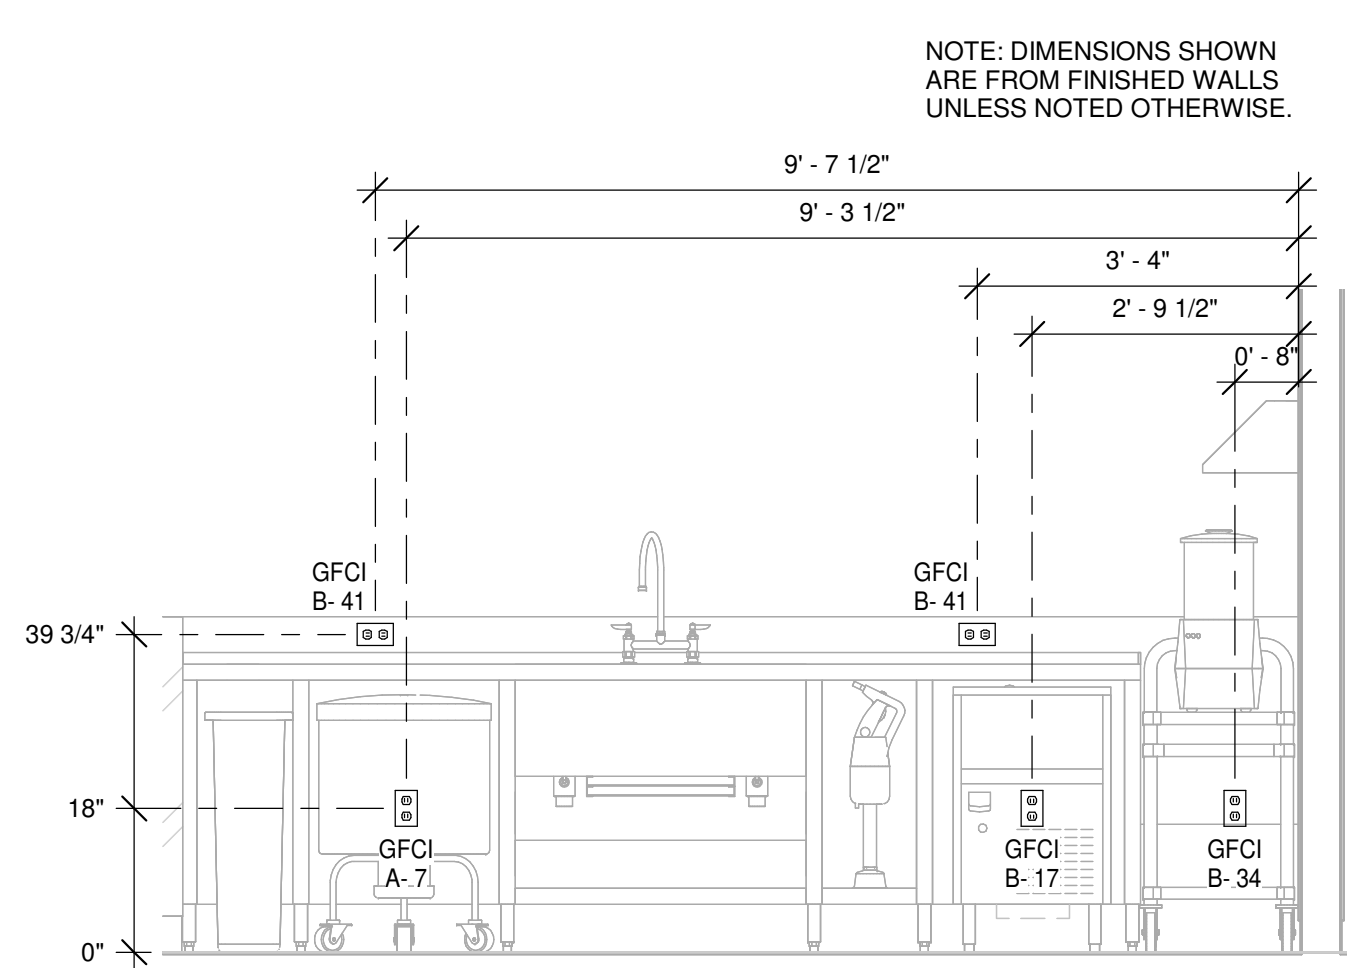


5 COLD PREP ELEVATION
N.T.S.

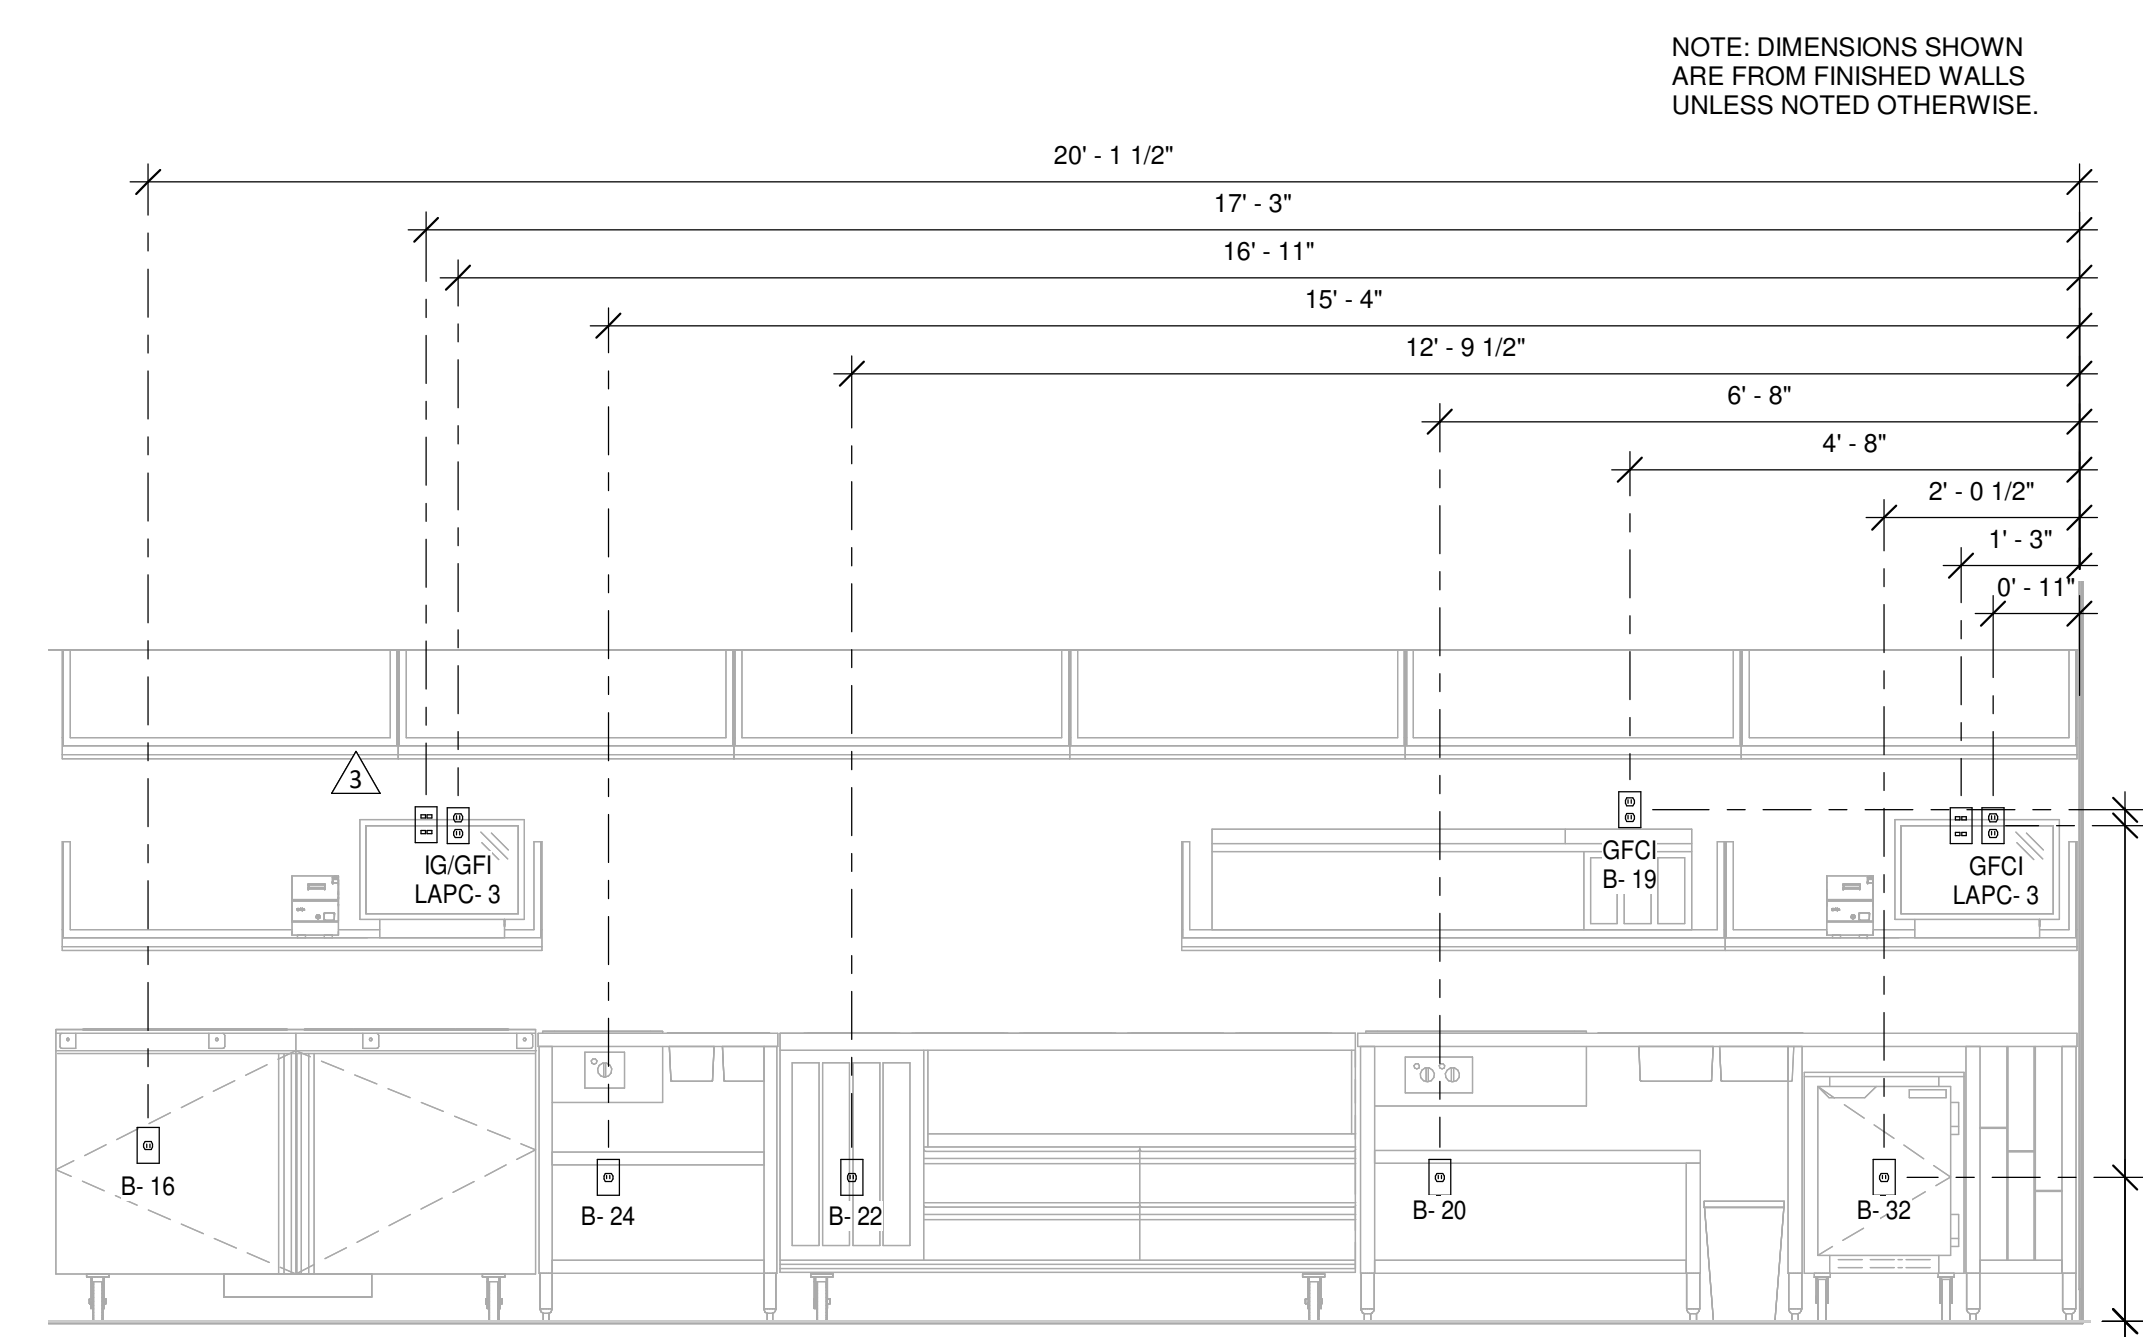


6 OLO ELEVATION
N.T.S.

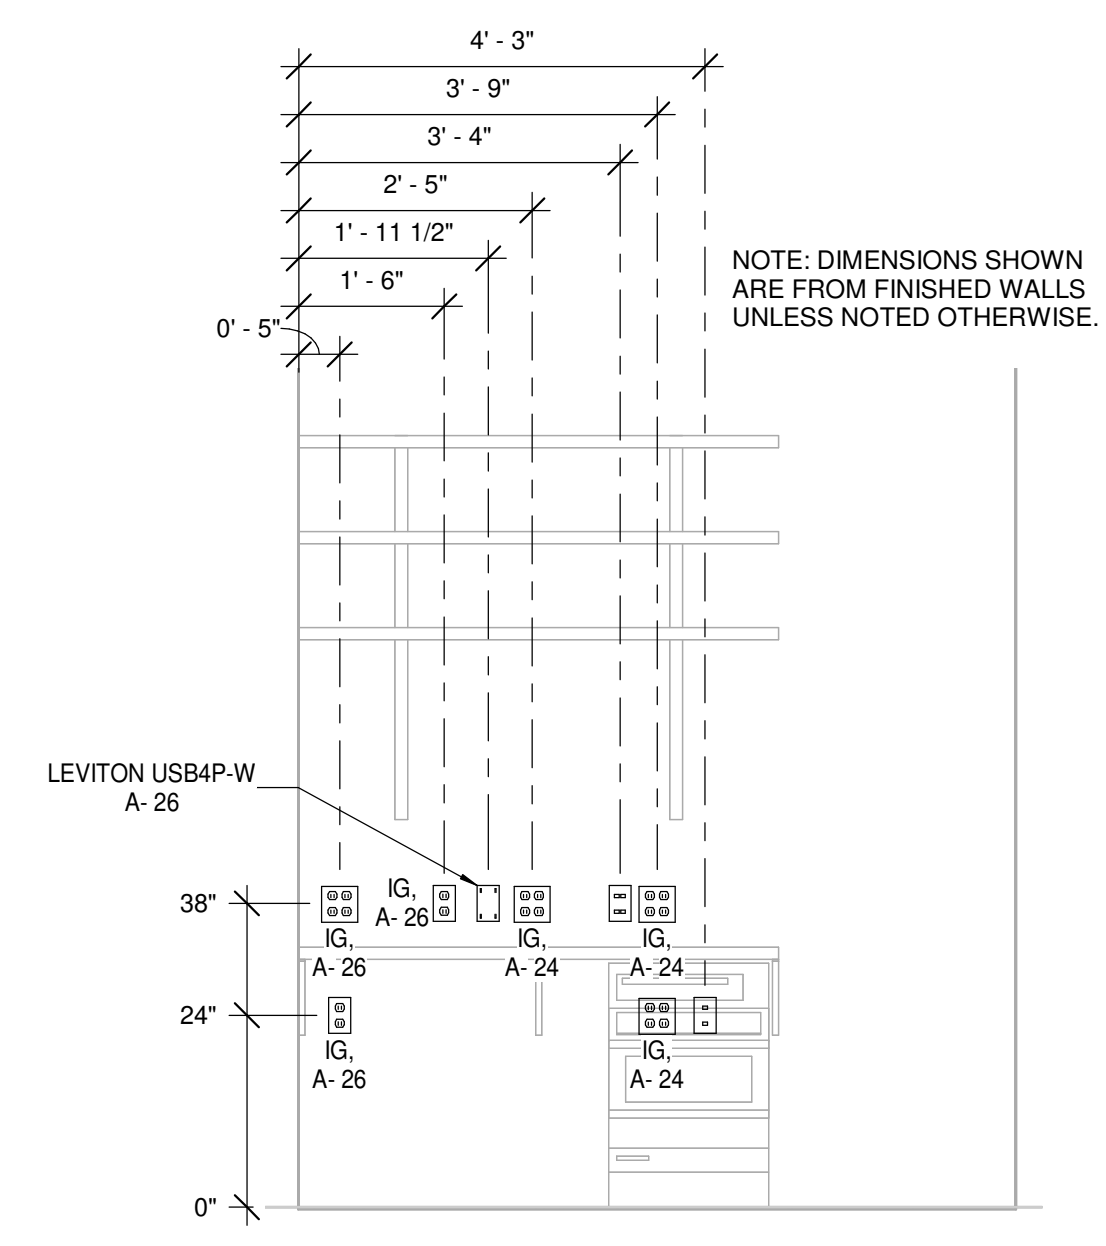

2 OPERATIONS ROOM ELEVATION
N.T.S.

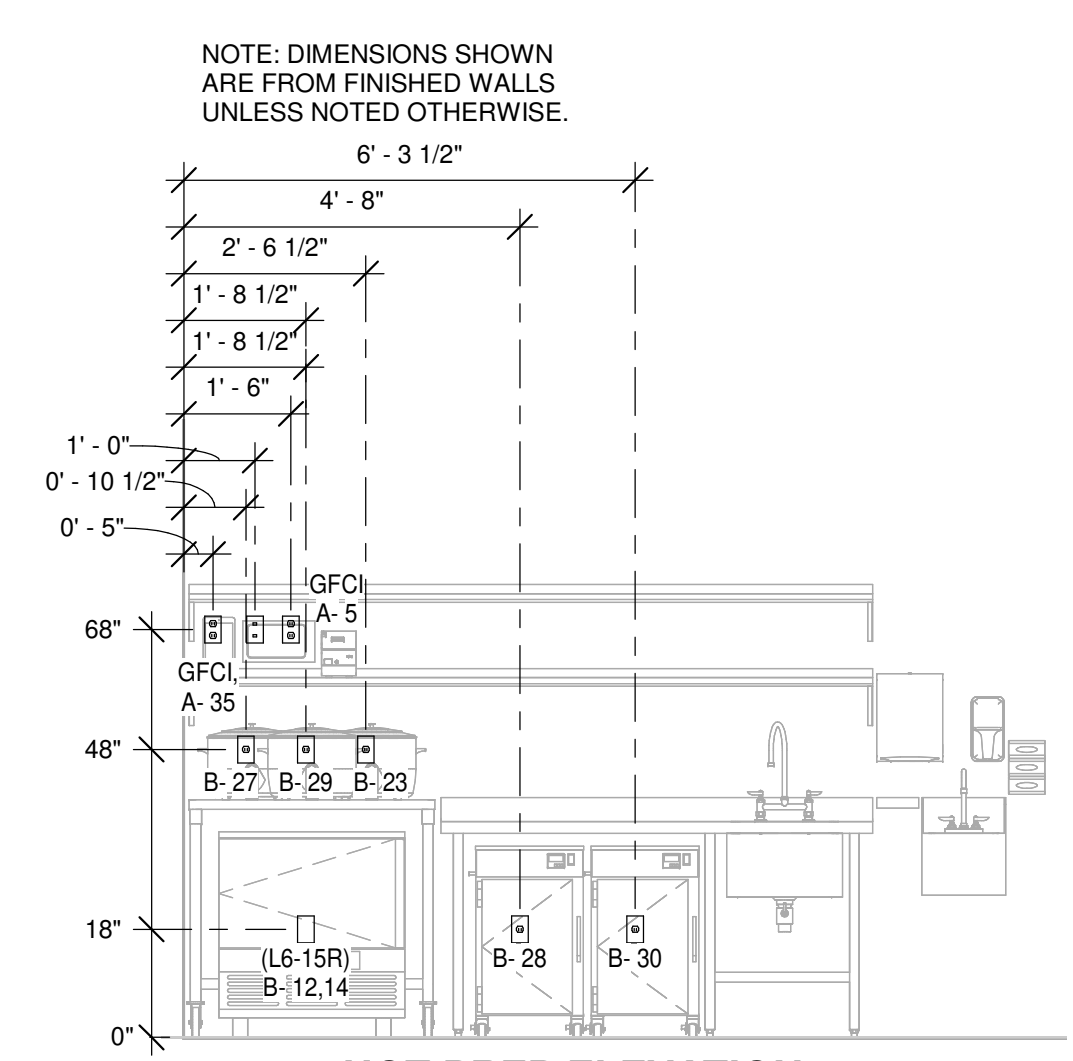


1 HOT PREP ELEVATION
N.T.S.

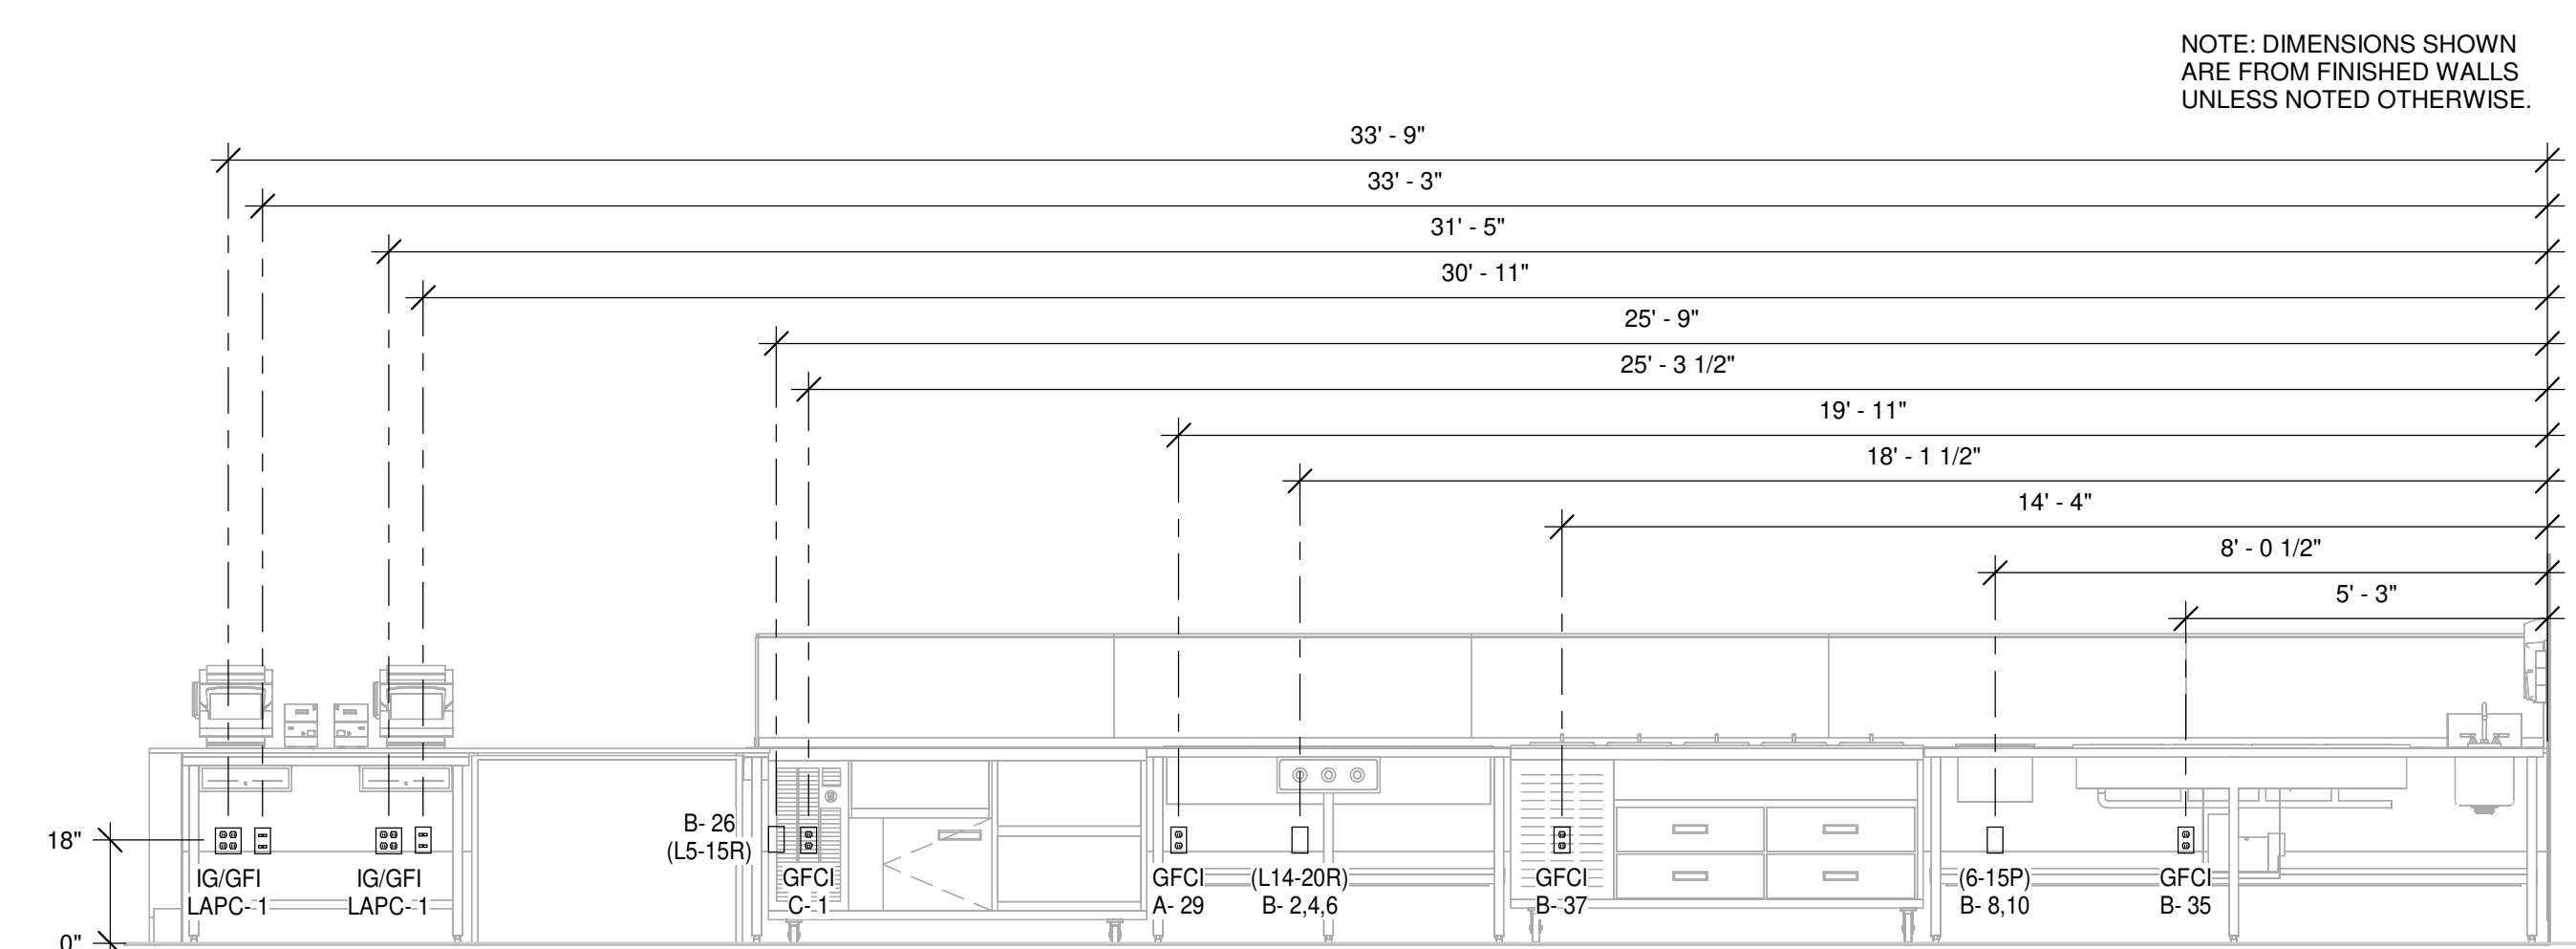

3 SERVE LINE ELEVATION
N.T.S.

THESE DRAWINGS & SPECIFICATIONS ARE CONFIDENTIAL AND SHALL REMAIN THE SOLE PROPERTY OF SWEETGREEN CORPORATION. THEY SHALL NOT BE REPRODUCED (IN WHOLE OR IN PART), SHARED WITH THIRD PARTIES OR USED IN ANY MANNER ON OTHER PROJECTS OR EXTENSIONS TO THIS PROJECT WITHOUT THE PRIOR WRITTEN CONSENT OF SWEETGREEN CORPORATION. THESE DRAWINGS & SPECIFICATIONS ARE INTENDED TO EXPRESS DESIGN INTENT FOR A PROTOTYPICAL SWEETGREEN STORE WHICH IS SUBJECT TO CHANGE AT ANY TIME AND MAY NOT REFLECT ACTUAL SITE CONDITIONS. NEITHER PARTY SHALL HAVE ANY OBLIGATION OR LIABILITY TO THE OTHER EXCEPT AS STATED ABOVE UNTIL A WRITTEN AGREEMENT IS FULLY EXECUTED.

ENGINEER OF RECORD:

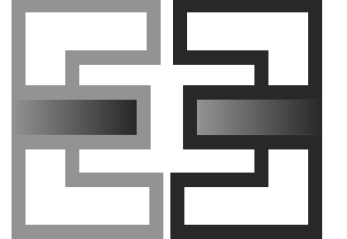

EVERJ ENGINEERING, INC.
1509 BUCK TRAIL LANE
WORTHINGTON, OH 43085
240-319-0822
www.everjengineering.com
TX ENGINEERING FIRM F-22980

STAMP:

**CONSTRUCTION
ISSUE SET**

07/24/2022


PROJECT INFORMATION:
MUELLER
PROJECT INFORMATION:
**1900 ALDRICH ST.
SUITE 140
AUSTIN, TX 78723**

DRAWN BY: JAE
CHECKED BY: MK
PROJECT MANAGER: JAE
SG DESIGN MANAGER: LG
SG CONSTR. MANAGER: KZ
PROJECT NO: 210005
TEMPLATE VERSION: 12/21/2021

REVISIONS
REV. DATE DESCRIPTION
2 05/20/22 PLAN REVIEW COMMENTS
3 06/29/22 CLIENT CHANGES


ELECTRICAL DETAILS

E-401

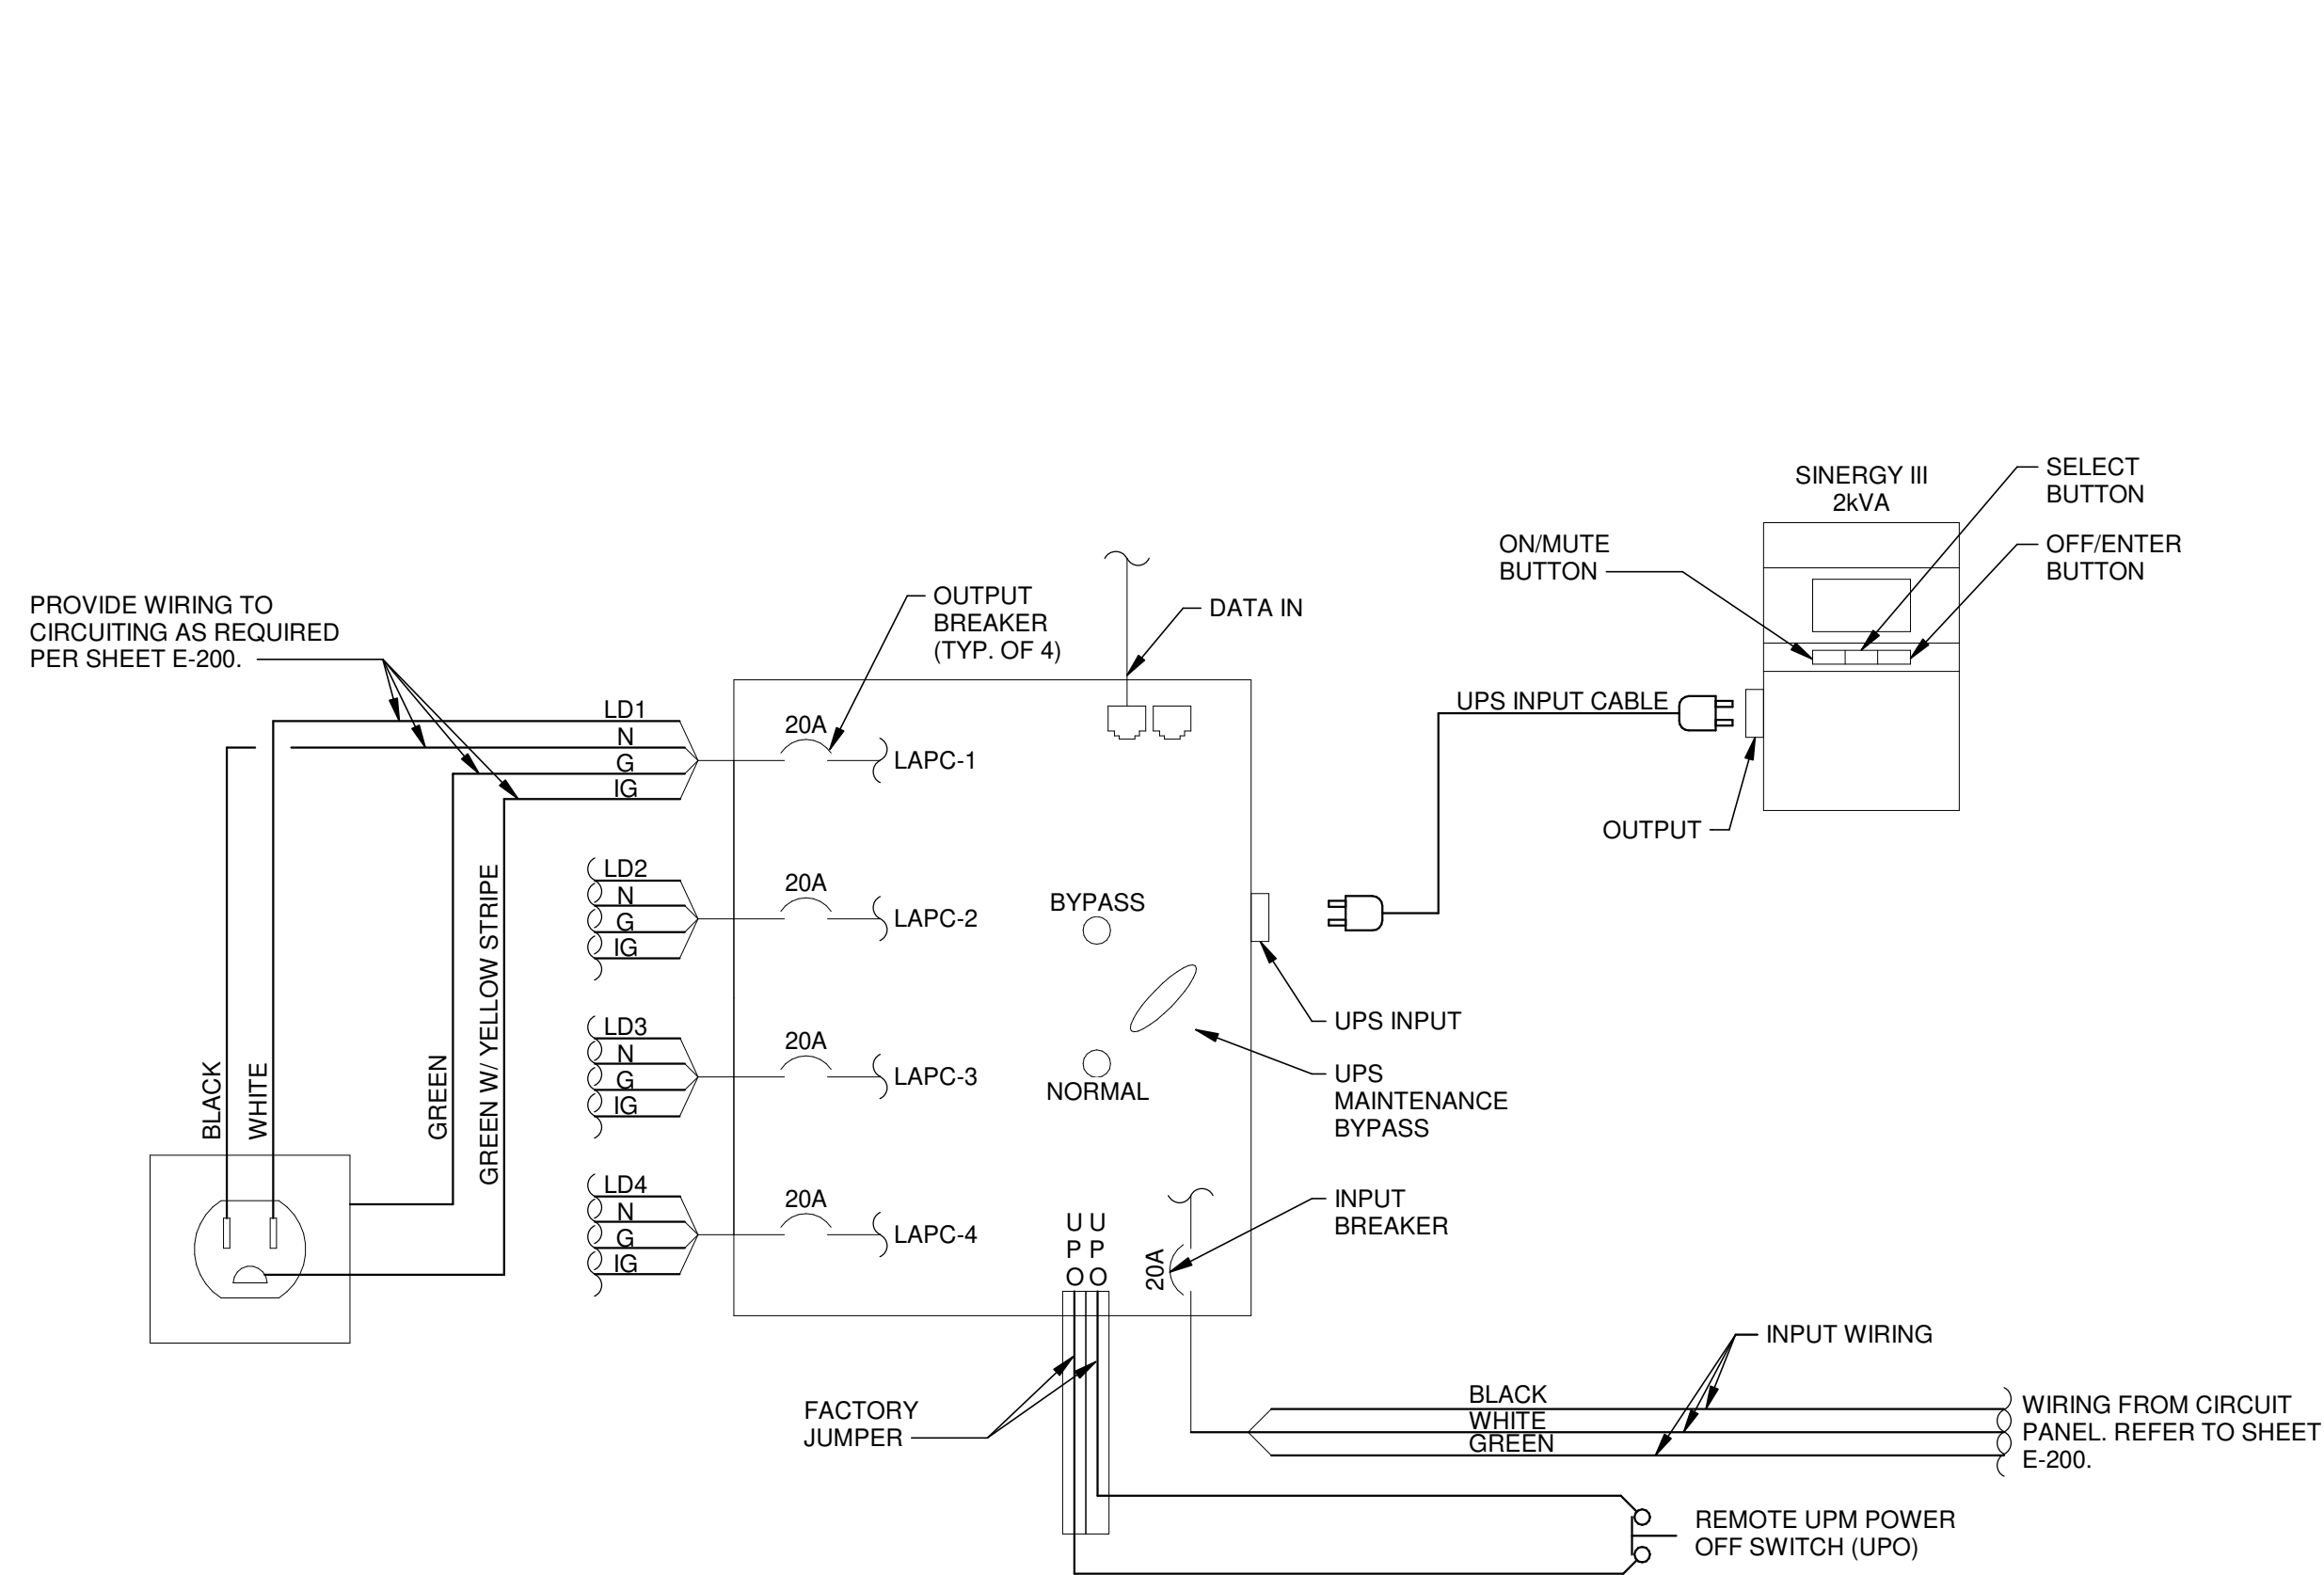


- NOTES:
1. INPUT WIRING FROM CIRCUIT BREAKER MUST BE RUN IN A SEPARATE CONDUIT FROM ALL OUTPUT WIRING. DO NOT USE A GFCI TYPE CIRCUIT BREAKER.
 2. ALL OUTPUT WIRING SHALL BE RUN IN DEDICATED CONDUITS, AND SHALL NOT BE ROUTED WITH ANY OTHER WRING.
 3. CONDUIT ENTRY SHALL NOT BE PERMITTED ON THE RIGHT-HAND-SIDE OF THE ENCLOSURE.
 4. CONNECT THE UPM NIG BOND TO THE GROUNDING ELECTRODE SYSTEM VIA ONE OF THE BONDED RECEPTACLE SCREWS ON THE PACK OF THE UPM.
 5. WHEN INSTALLING A REMOTE UPM POWER OFF SWITCH, REMOVE THE FACTORY JUMPER BETWEEN TERMINALS "UPO" AND "UPO" AND CONNECT TO THE NORMALLY CLOSED CONTACTS OF A 20A RATED REMOTE SWITCH.

5 LAPC WIRING DIAGRAM
N.T.S.

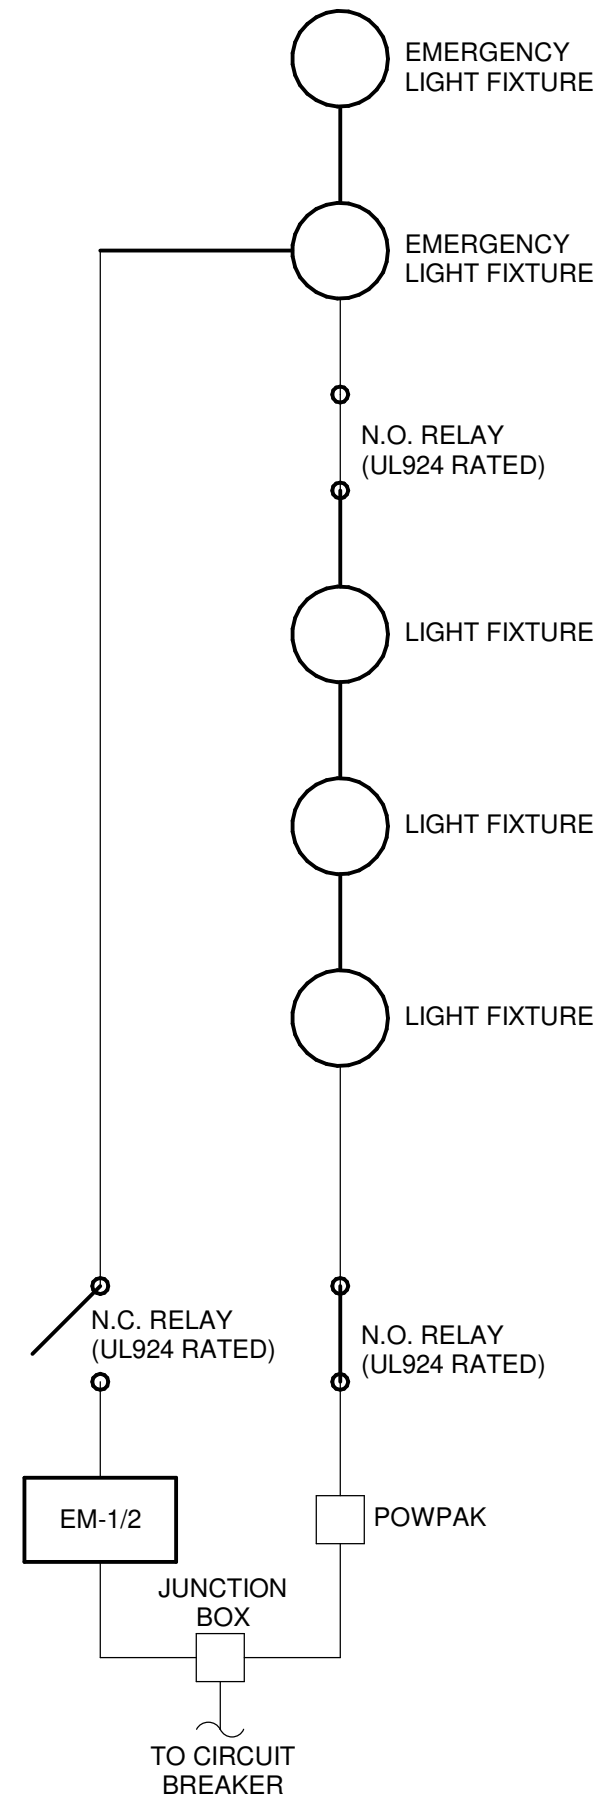


NOTE: DIAGRAM REPRESENTS SYSTEM DURING NON-EMERGENCY OPERATION.

4 EMERGENCY CIRCUIT WIRING DIAGRAM
N.T.S.

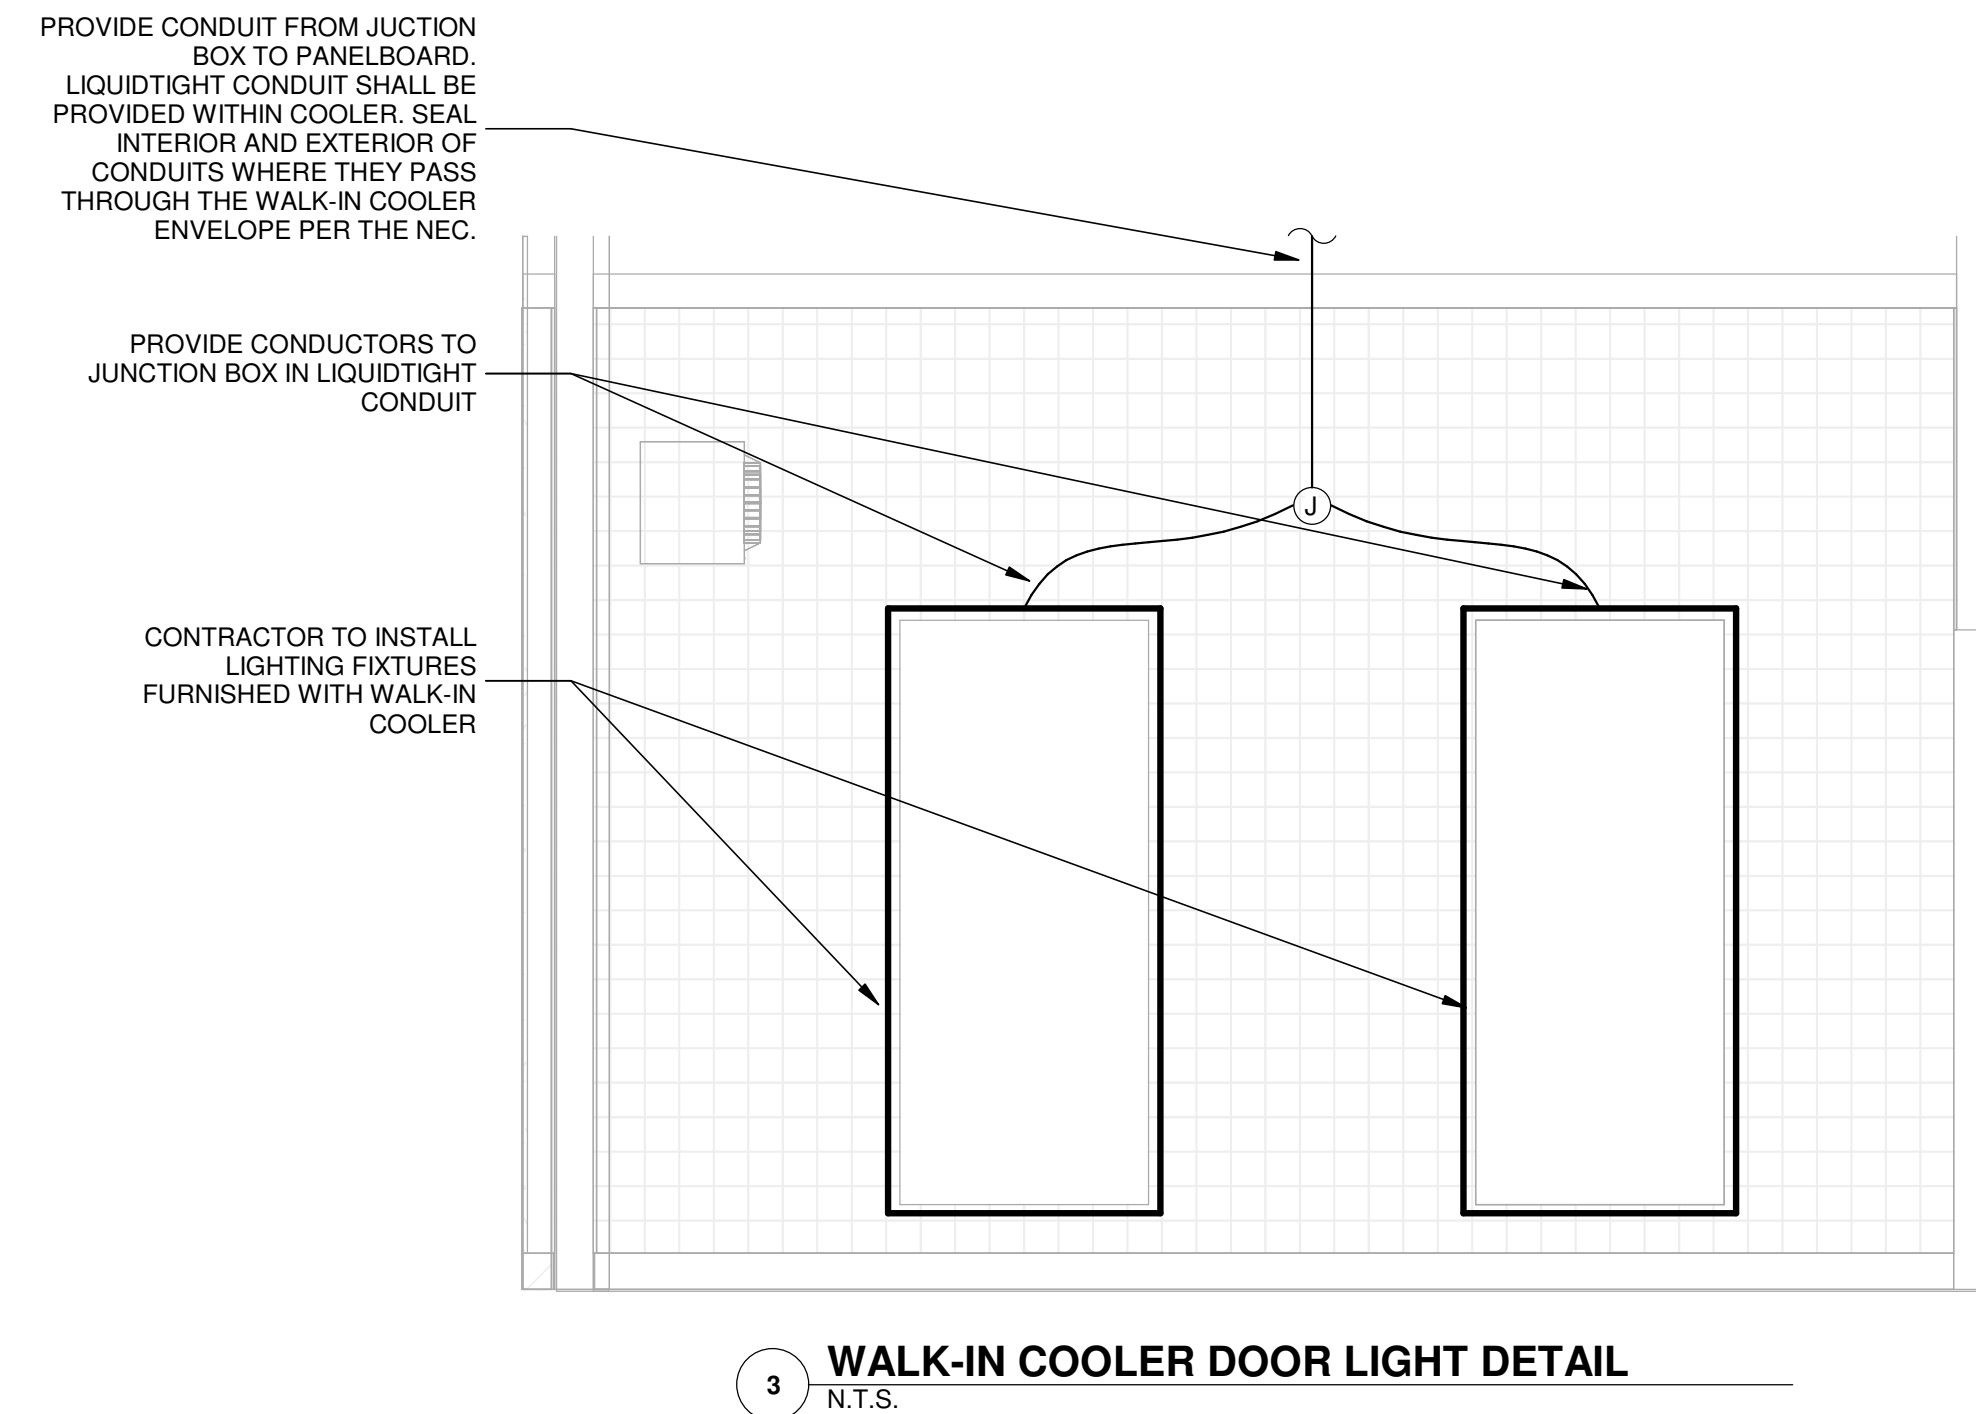


3 WALK-IN COOLER DOOR LIGHT DETAIL
N.T.S.

POINT	VOLTS	PHASES	CONDUCTOR PROPERTIES				I VALUE	M VALUE	AVAILABLE FAULT CURRENT (A)	
			LENGTH (FT)	# OF SETS	SIZE	CONDUIT				
A									65000	
B	480	3	265	1	#250	STEEL	12122	5.127	0.163	10608
C	480	3	10	1	#210	STEEL	7187	0.053	0.949	10072
D								4.421	0.184	4287
75 kVA TRANSFORMER: Z=4.4%, %Z TOLERANCE=-10%										
E	208	3	10	1	#350	STEEL	15484	0.023	0.977	4191

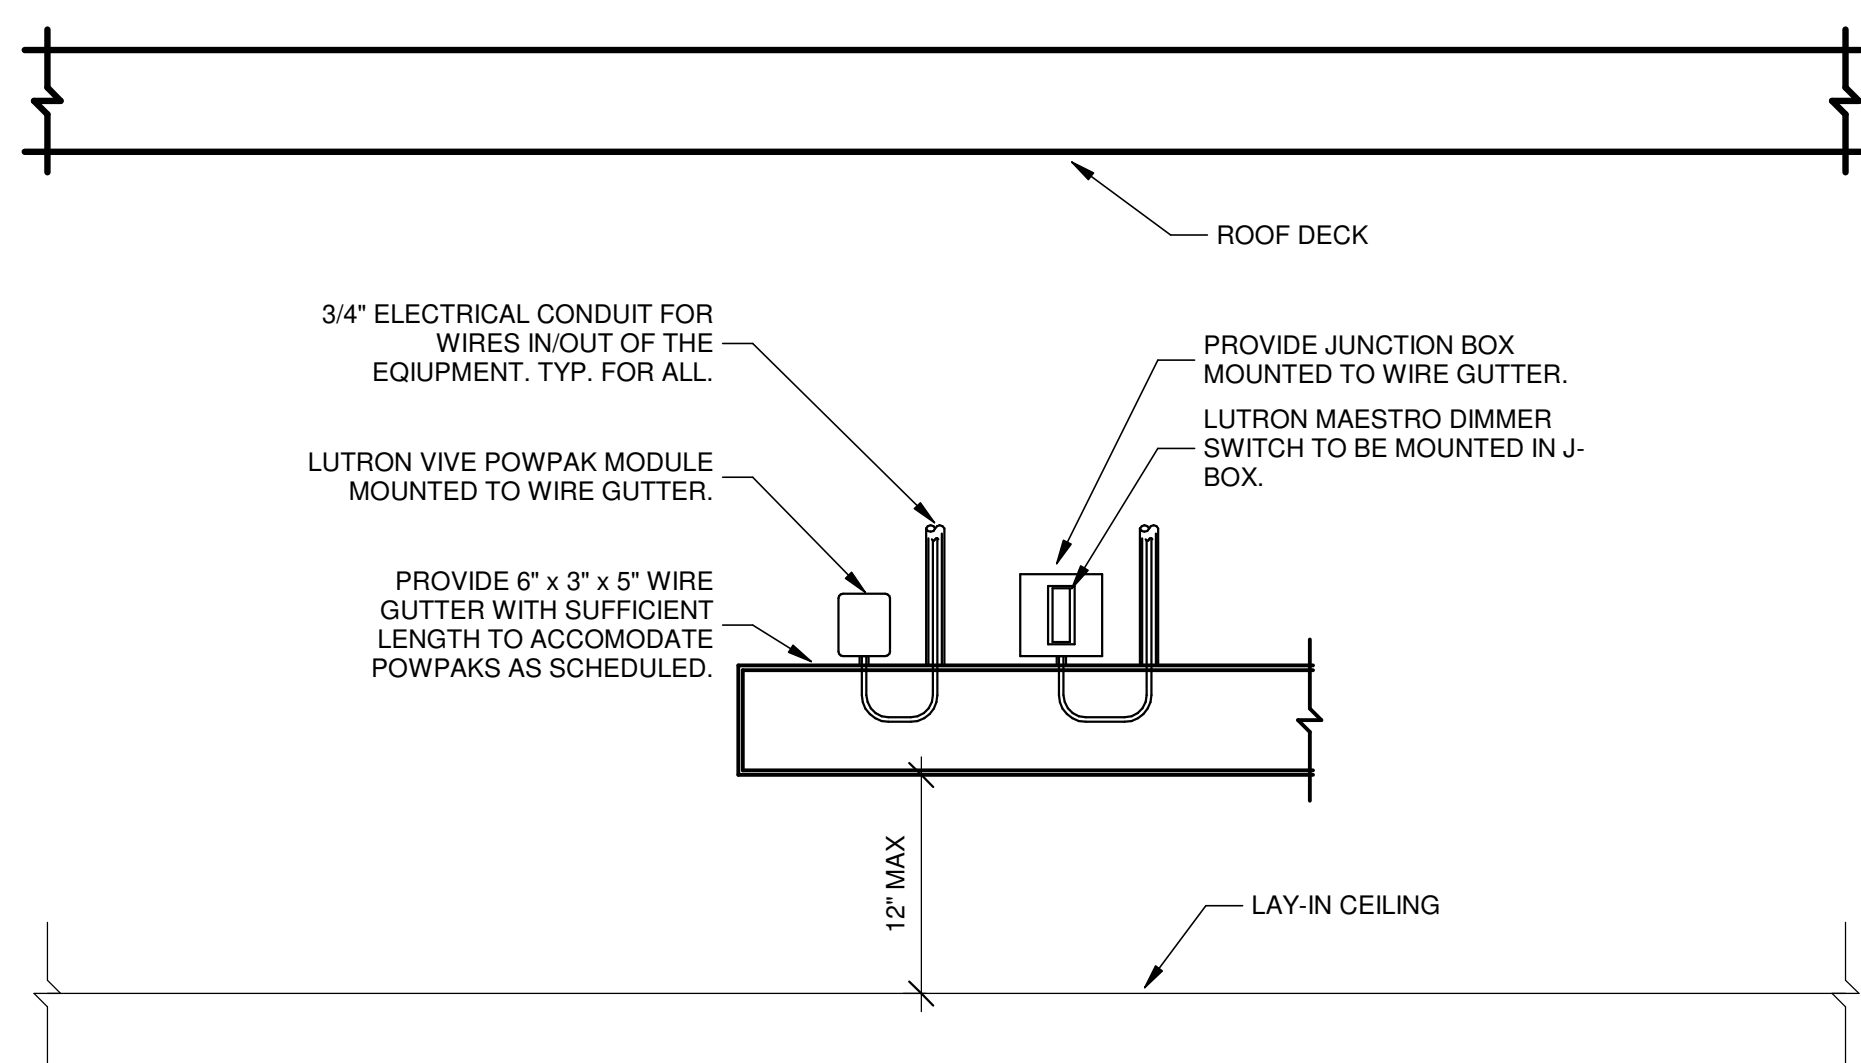

2 LIGHTING CONTROL INSTALLATION
N.T.S.

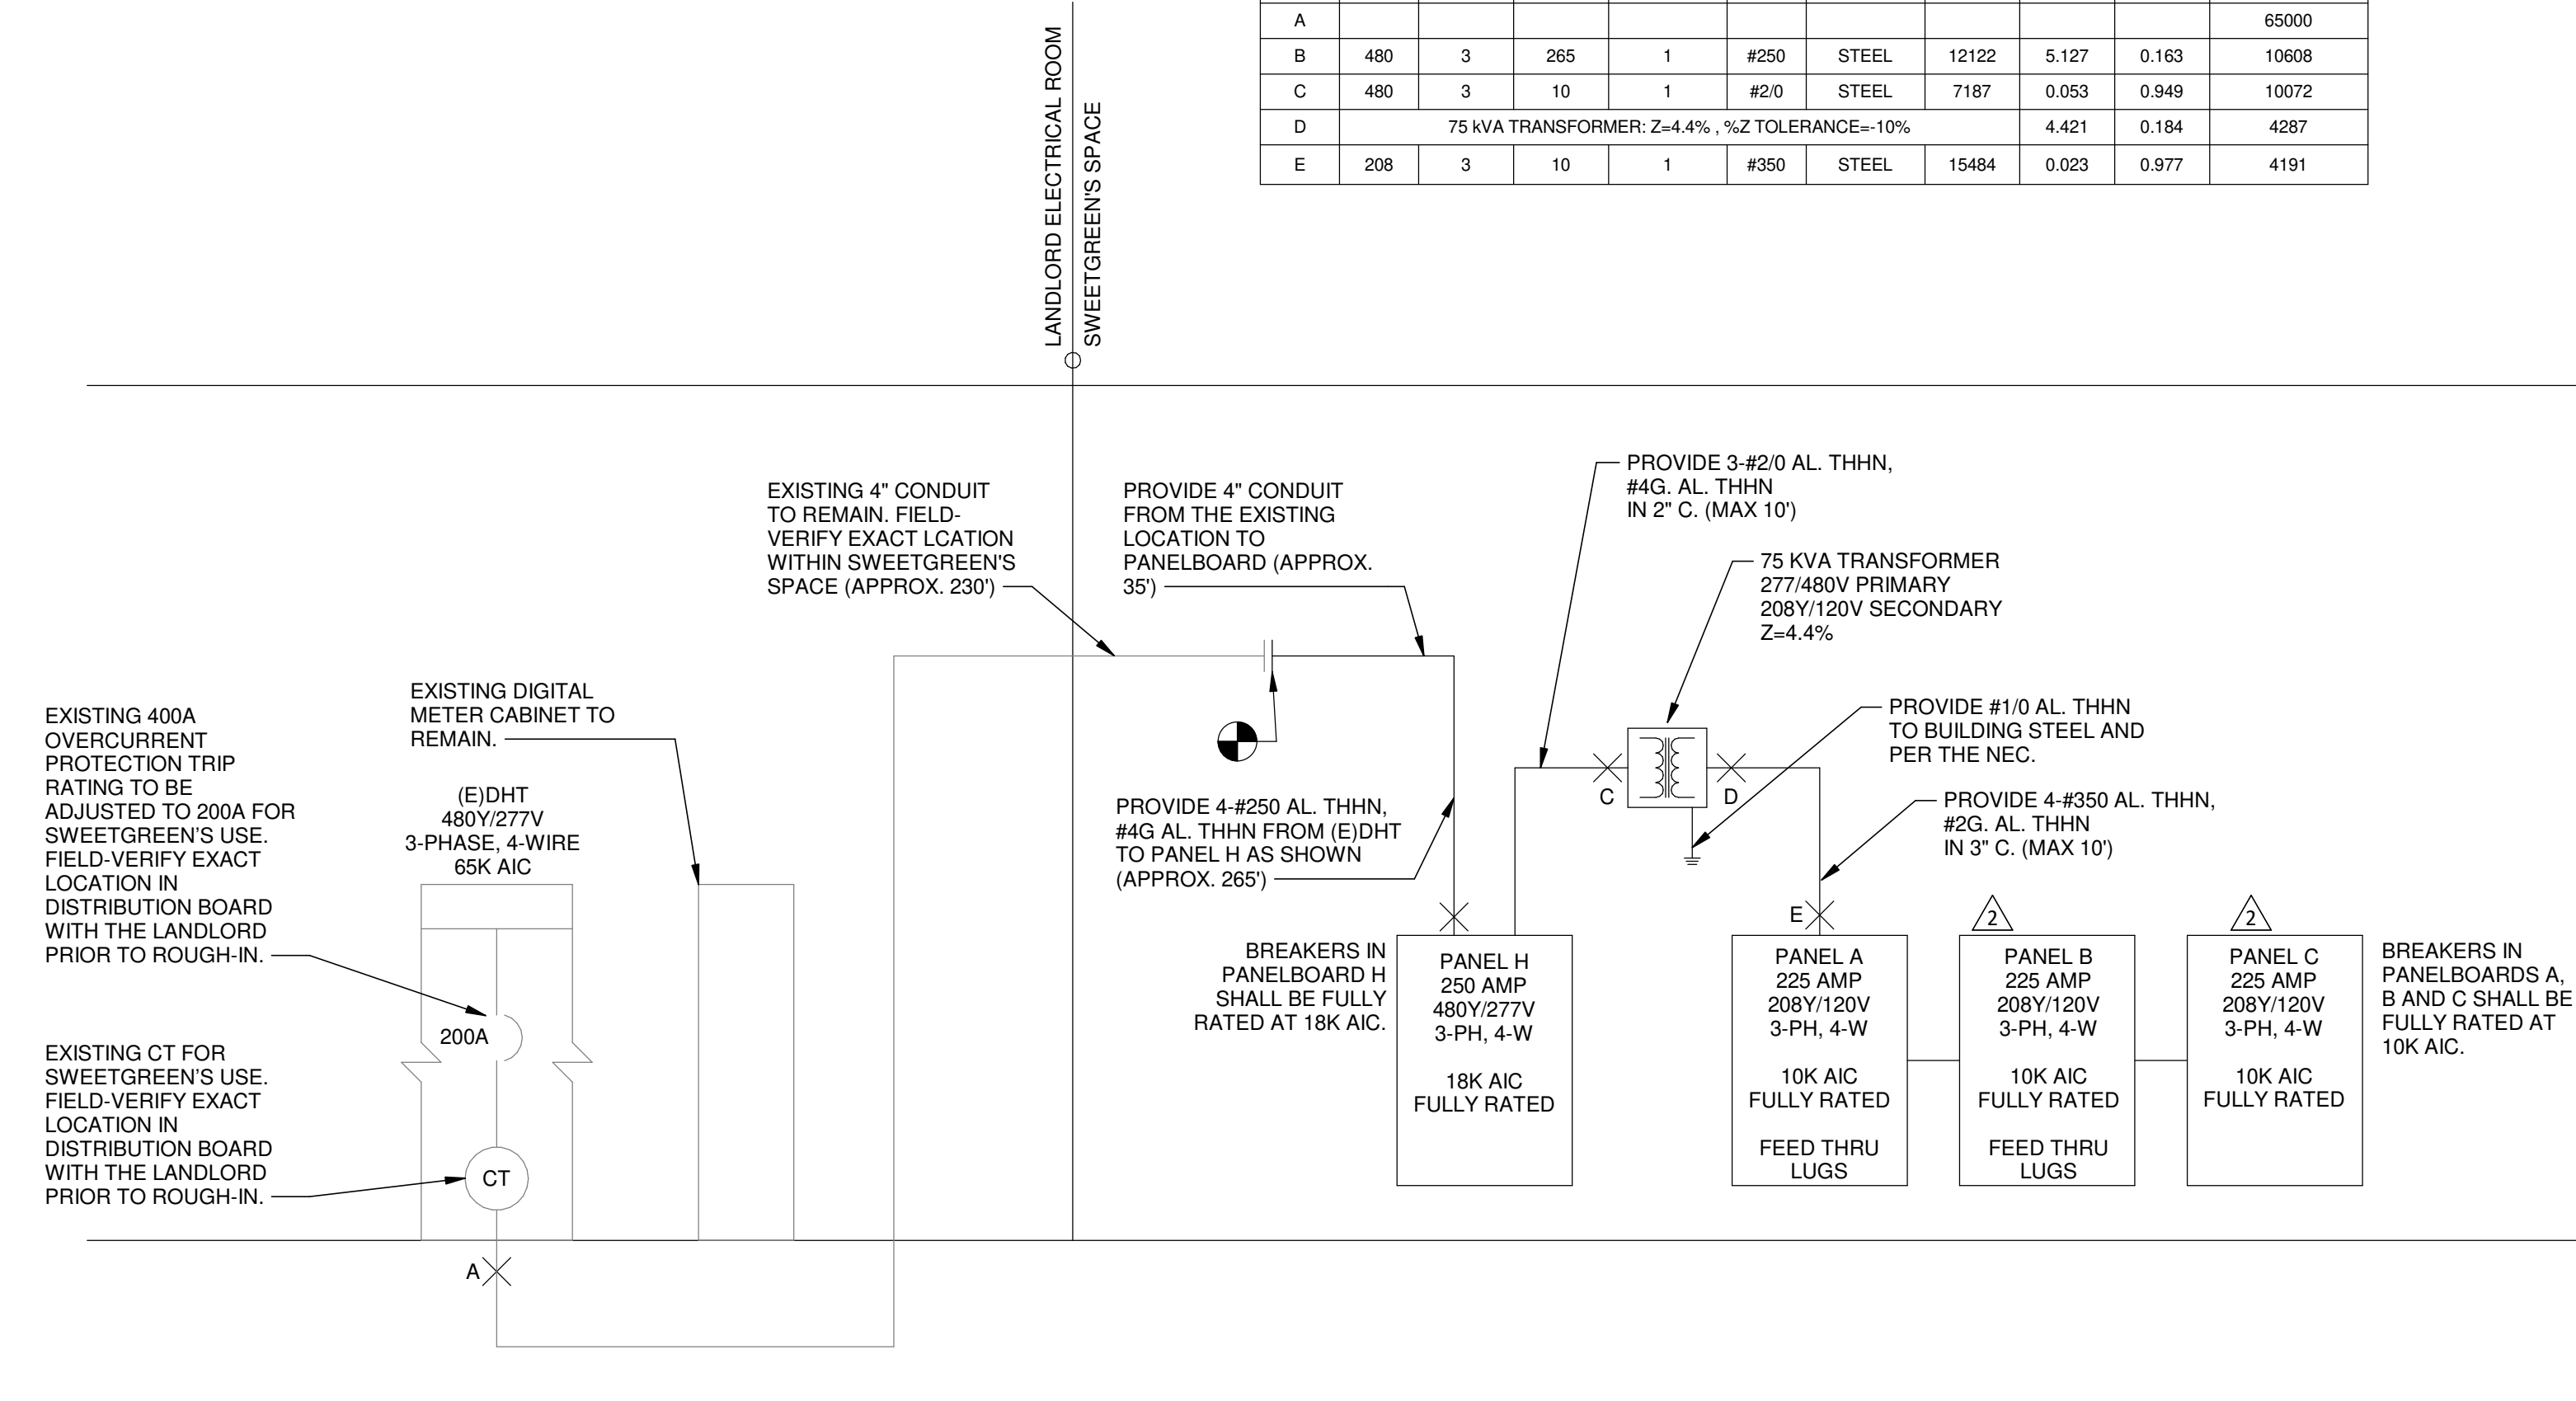

1 MAIN DISTRIBUTION DIAGRAM
N.T.S.




sweetgreen

3101 W. EXPOSITION BLVD.
LOS ANGELES, CALIFORNIA 90018

THESE DRAWINGS & SPECIFICATIONS ARE CONFIDENTIAL AND SHALL REMAIN THE SOLE PROPERTY OF SWEETGREEN CORPORATION. THEY SHALL NOT BE REPRODUCED IN WHOLE OR IN PART, SHARED WITH THIRD PARTIES OR USED IN ANY MANNER ON OTHER PROJECTS OR EXTENSIONS TO THIS PROJECT WITHOUT THE PRIOR WRITTEN CONSENT OF SWEETGREEN CORPORATION. THESE DRAWINGS & SPECIFICATIONS ARE INTENDED TO EXPRESS DESIGN INTENT FOR A PROTOTYPICAL SWEETGREEN STORE WHICH IS SUBJECT TO CHANGE AT ANY TIME AND MAY NOT REFLECT ACTUAL SITE CONDITIONS. NEITHER PARTY SHALL HAVE ANY OBLIGATION OR LIABILITY TO THE OTHER EXCEPT AS STATED ABOVE UNTIL A WRITTEN AGREEMENT IS FULLY EXECUTED.

ENGINEER OF RECORD:

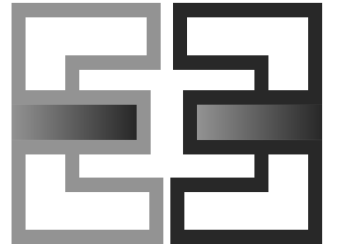

EVERJ ENGINEERING, INC.
1509 BUCK TRAIL LANE
WORTHINGTON, OH 43085
240-319-0822
www.everjengineering.com
TX ENGINEERING FIRM F-22980

STAMP:

CONSTRUCTION
ISSUE SET

07/24/2022

PROJECT INFORMATION:
MUELLER
PROJECT INFORMATION:
**1900 ALDRICH ST.
SUITE 140
AUSTIN, TX 78723**

DRAWN BY: JAE
CHECKED BY: MK
PROJECT MANAGER: JAE
SG DESIGN MANAGER: LG
SG CONSTR. MANAGER: KZ
PROJECT NO: 210005
TEMPLATE VERSION: 12/21/2021

REVISIONS
REV. DATE DESCRIPTION
2 05/20/22 PLAN REVIEW COMMENTS
3 06/29/22 CLIENT CHANGES

ELECTRICAL
LOW-VOLTAGE PLAN

E-500

CODED NOTES

- PROVIDE 1" CONDUIT FROM THE AREA ABOVE THE CEILING AT THE IT RACK TO THE WIRELESS ACCESS POINT. REFER TO THE ARCHITECTURAL RCP FOR EXACT LOCATION. PROVIDE BUSHINGS AS REQUIRED. INSTALL OWNER-FURNISHED CABLING. LEAVE 2' OF SLACK AT THE WAP END, AND 15' OF SLACK AT THE IT RACK. SWEETGREEN'S VENDOR SHALL PROVIDE DEVICE AND MAKE FINAL CONNECTION.
- PROVIDE 1" CONDUIT FROM THE AREA ABOVE THE CEILING AT THE IT RACK TO THE DATA JACK. PROVIDE BUSHINGS AS REQUIRED. INSTALL OWNER-FURNISHED CABLING. LEAVE 2' OF SLACK AT THE DEVICE END, AND 15' OF SLACK AT THE IT RACK. SWEETGREEN'S VENDOR SHALL PROVIDE DEVICE AND MAKE FINAL CONNECTION. REFER TO NOTATION ON PLAN AND THE ELEVATIONS FOR JACK QUANTITY.
- PROVIDE 1" CONDUIT FROM THE AREA ABOVE THE CEILING AT THE IT RACK TO THE SECURITY CAMERA. REFER TO THE ARCHITECTURAL RCP FOR EXACT LOCATION. PROVIDE BUSHINGS AS REQUIRED. INSTALL OWNER-FURNISHED CABLING. LEAVE 2' OF SLACK AT THE DEVICE END, AND 15' OF SLACK AT THE IT RACK. GO TO TAPE AND HUB WIRE PENETRATION LOCATIONS IN GYPSUM BOARD CEILINGS. SEE ARCHITECTURAL RCP FOR EXACT CAMERA LOCATIONS. SWEETGREEN'S VENDOR SHALL PROVIDE DEVICE AND MAKE FINAL CONNECTION.
- DATA FOR DIGITAL MENU BOARDS IS TO BE MOUNTED BEHIND THE MENU BOARDS. COORDINATE THE LOCATION AND MOUNTING HEIGHT WITH THE MOUNTING BRACKETS AND THE DISPLAY VENDOR PRIOR TO ROUGH-IN.
- PROVIDE 1" CONDUIT TO THE SERVE LINE VOLUME CONTROL IN LOCATION SHOWN. PROVIDE BUSHINGS AS REQUIRED. INSTALL OWNER-FURNISHED CABLING. LEAVE 2' OF SLACK AT THE DEVICE END, AND 15' OF SLACK AT THE IT RACK. SWEETGREEN'S VENDOR SHALL PROVIDE DEVICE AND MAKE FINAL CONNECTION.
- PROVIDE 1" CONDUIT FROM THE AREA ABOVE THE CEILING AT THE IT RACK TO THE IPOD JACK IN LOCATION SHOWN. PROVIDE BUSHING AT BOTH ENDS OF THE CONDUIT. INSTALL OWNER-FURNISHED CABLING. LEAVE 2' OF SLACK AT THE AUDIO JACK END, AND 15' OF SLACK AT THE IT RACK. REFER TO SWEETGREEN'S VENDOR DRAWINGS FOR MORE INFORMATION. SWEETGREEN'S VENDOR SHALL PROVIDE DEVICE AND MAKE FINAL CONNECTION.
- FIELD VERIFY LOCATION AND EXISTENCE OF AN EMT TENANT TELECO/DATA SERVICE CONDUIT TERMINATED IN LEASE SPACE. IF SUCH A CONDUIT DOES NOT EXIST THEN PROVIDE AND INSTALL A 1" EMT TELEPHONE/DATA SERVICE CONDUIT WITH PULLSTRING ROUTED FROM THE BUILDING TELEPHONE DEMARK TO AN ACCESSIBLE LOCATION ABOVE THE NEW TENANT COMMUNICATIONS SHELF. COORDINATE ALL TELEPHONE SERVICE ENTRANCE ISSUES WITH THE SERVICE PROVIDER.
- COORDINATE REQUIREMENTS OF DATA JACK AND CABLING WITH SECURITY SYSTEM INSTALLER.
- PROVIDE 1" CONDUIT FROM THE AREA ABOVE THE CEILING AT THE IT RACK TO THE WIRELESS HUB. PROVIDE BUSHINGS AS REQUIRED. INSTALL OWNER-FURNISHED CABLING. MAKE FINAL CONNECTION TO THE WIRELESS HUB AND 15' OF SLACK AT THE IT RACK. SWEETGREEN'S VENDOR SHALL MAKE FINAL CONNECTION TO PATCH PANEL.
- PROVIDE 3/4" CONDUIT FROM THE ALARM PANEL LOCATION IN THE OFFICE TO A JUNCTION BOX FOR THE SECURITY KEYPAD. COORDINATE EXACT LOCATION AND ALL OTHER REQUIREMENTS WITH THE SECURITY VENDOR AS REQUIRED. SWEETGREEN'S SECURITY VENDOR SHALL FURNISH AND INSTALL THE KEYPAD AND ASSOCIATED CABLING.
- DATA CONNECTION FOR LOCAL LIST. PROVIDE DATA DEVICE CONCEALED BEHIND THE LOCAL LIST BOARD. REFER TO THE ARCHITECTURAL PLANS FOR EXACT LOCATION.
- TWO 3" CONDUITS STUBBED UP THROUGH THE OPERATIONS ROOM CEILING FOR PASS-THROUGH OF LOW-VOLTAGE CABLING. PROVIDE BUSHINGS ON EITHER END. CONDUIT SHALL BE HELD TIGHT TO WALL, CENTERED BEHIND THE IT RACK. TERMINATE CONDUIT 18" ABOVE THE TOP OF THE IT RACK. REFER TO THE ELEVATION ON SHEET E-400 FOR MORE INFORMATION.
- TERMINATE ALL LOW-VOLTAGE CONDUITS REQUIRED FOR THIS PLAN WITHIN 3'-0" OF THE TWO 3" CONDUITS NOTED IN CODED NOTE 12.
- NOT USED.
- NOT USED.
- PROVIDE 1" CONDUIT FROM THE AREA ABOVE THE CEILING AT THE IT RACK TO THE VOLUME CONTROL IN LOCATION SHOWN. PROVIDE BUSHING. INSTALL OWNER-FURNISHED CABLING. LEAVE 2' OF SLACK AT THE MASTER VOLUME CONTROL END, AND 15' OF SLACK AT THE IT RACK. REFER TO SWEETGREEN'S VENDOR DRAWINGS FOR MORE INFORMATION. SWEETGREEN'S VENDOR SHALL PROVIDE DEVICE AND MAKE FINAL CONNECTION.
- PROVIDE 1" CONDUIT FROM THE AREA ABOVE THE CEILING AT THE IT RACK TO THE WIRELESS ACCESS POINT IN THE DINING ROOM. COORDINATE EXACT CONDUIT ROUTING WITH SWEETGREEN'S CONSTRUCTION MANAGER AS REQUIRED. REFER TO THE ARCHITECTURAL RCP FOR EXACT LOCATION. PROVIDE BUSHINGS AS REQUIRED. INSTALL OWNER-FURNISHED CABLING. LEAVE 2' OF SLACK AT THE WIRELESS ACCESS POINT END, AND 15' OF SLACK AT THE IT RACK. SWEETGREEN'S VENDOR SHALL PROVIDE DEVICE AND MAKE FINAL CONNECTION.
- INSTALL TWO 50' COILS OF CAT6 CABLING ABOVE THE CEILING ABOVE THE IT RACK AND EXTEND THROUGH THE 3" CONDUIT. CABLING SHALL BE OWNER-FURNISHED AND TERMINATED BY SWEETGREEN'S VENDOR.
- DATA CONNECTION FOR THE LAPC. PROVIDE DATA DEVICE LOCATED ABOVE THE UNIT AT THE ELEVATION SHOWN. COORDINATE ALL REQUIREMENTS WITH SWEETGREEN'S VENDOR PRIOR TO ROUGH-IN.
- UPON INSTALLATION OF THE SECURITY CAMERA CABLING, SEAL THE INTERIOR OF THE CONDUITS WHERE THEY PASS THROUGH THE COOLER ENVELOPE.
- PROVIDE 1" CONDUIT FOR THE SPEAKER AND PROVIDE BUSHINGS AS REQUIRED. SPEAKER SHOWN FOR ILLUSTRATIVE PURPOSES ONLY. REFER TO THE SPEAKER VENDOR'S SHOP DRAWINGS FOR EXACT ROUTING AND MORE INFORMATION. TYPICAL.
- PROVIDE 1" CONDUIT FROM THE SPEAKER TO THE AREA ABOVE THE CEILING AT THE IT RACK. PROVIDE BUSHINGS AS REQUIRED. REFER TO THE SPEAKER VENDOR'S SHOP DRAWINGS FOR EXACT CABLING PATH. INSTALL OWNER-FURNISHED CABLING. LEAVE 2' OF SLACK AT THE SPEAKER AND 15' OF SLACK AT THE IT RACK. SWEETGREEN'S VENDOR SHALL PROVIDE DEVICE AND MAKE FINAL CONNECTION. REFER TO THE SPEAKER VENDOR DRAWINGS FOR EXACT ROUTING.


SYMBOLS & ABBREVIATIONS

LOW-VOLTAGE SYMBOLS

- CONDUIT CONCEALED ABOVE THE CEILING, IN A WALL, OR IN A RACEWAY
- SPEAKER WIRING. REFER TO NOTE FOR NUMBER AND TYPE
- HOME-RUN TO PANELBOARD AND CIRCUIT NUMBER SHOWN
- PLAN NOTE: SEE PLAN NOTES LISTED ON THE SAME SHEET FOR NOTE MEANING
- JUNCTION BOX
- ELECTRIC PANELBOARD
- JUNCTION BOX FOR RJ-45 OUTLET. REFER TO PLAN FOR JACK QUANTITY
- SECURITY CAMERA
- WIRELESS ACCESS POINT
- VOLUME CONTROL
- IPOD JACK

LOW-VOLTAGE ABBREVIATIONS

- (E) EXISTING
- (R) RELOCATED
- AFF ABOVE FINISHED FLOOR
- AFG ABOVE FINISHED GRADE
- C CONDUIT
- JB JUNCTION BOX
- KES TENANT'S KITCHEN EQUIPMENT SUPPLIER
- S SURFACE MOUNTED
- UNO UNLESS NOTED OTHERWISE
- WP WEATHERPROOF

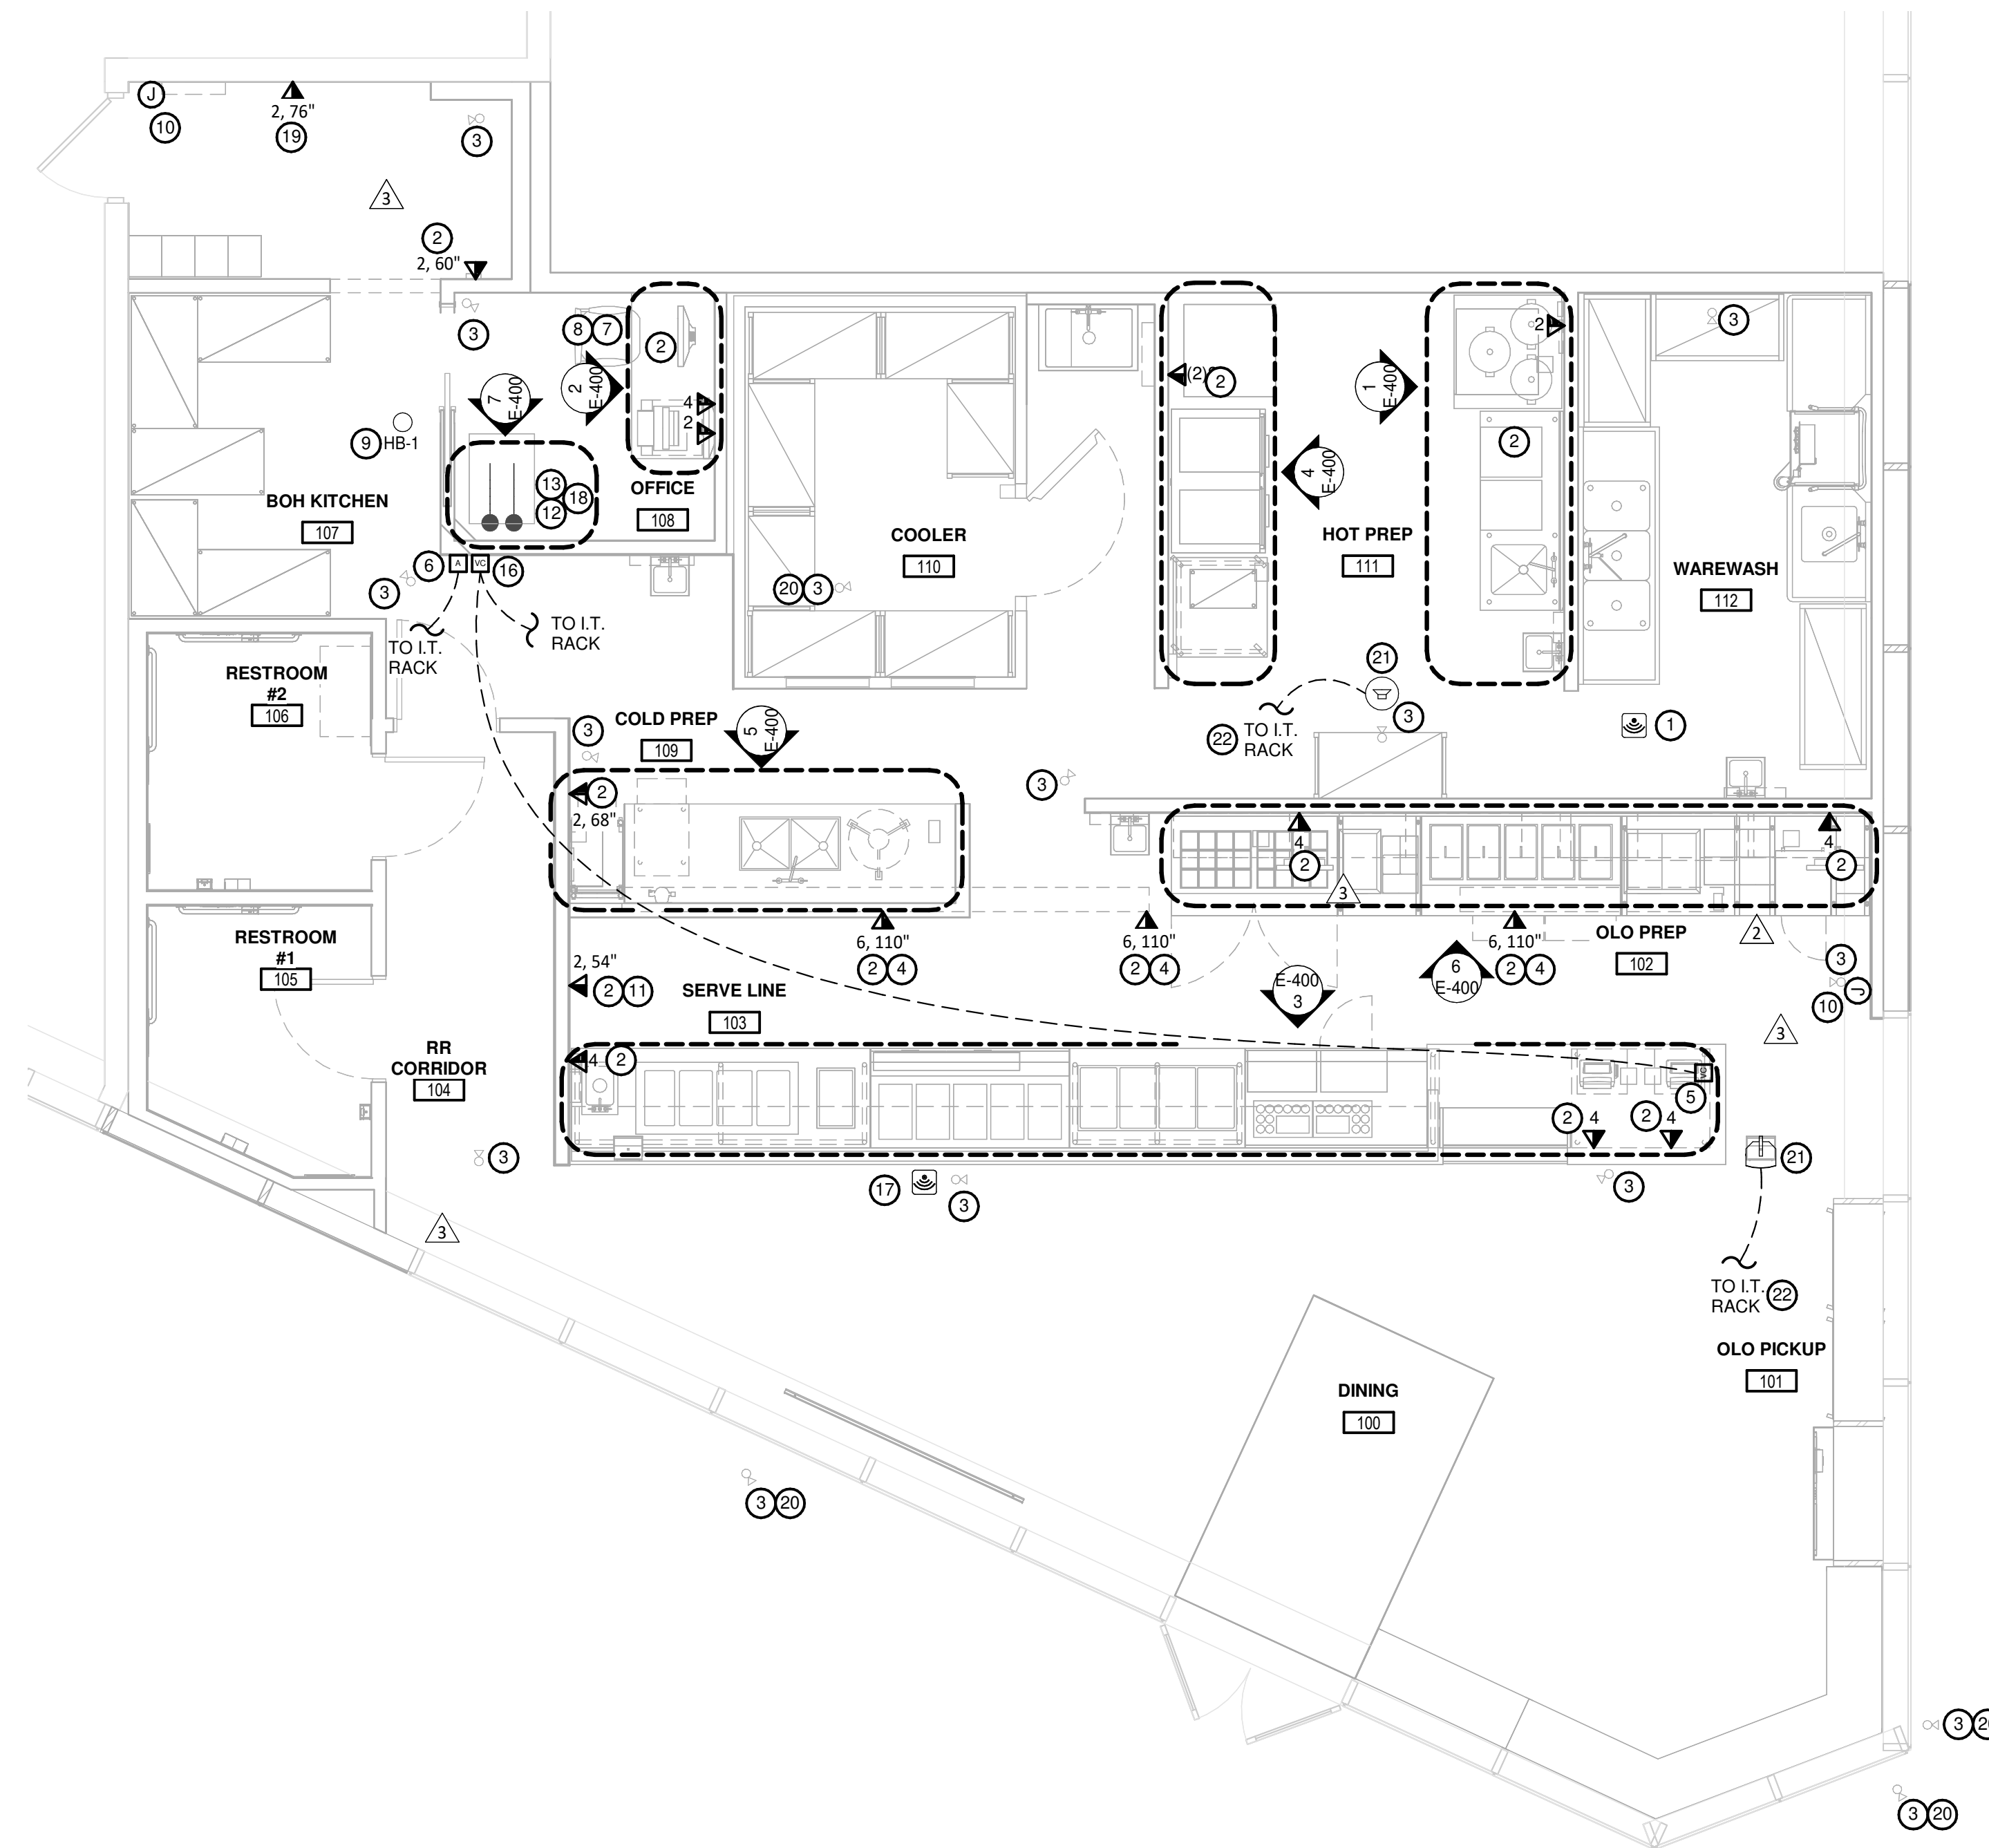

1 LOW-VOLTAGE FLOOR PLAN
1/4" = 1'-0"
NORTH