

## SECTION 23 00 00 - MECHANICAL GENERAL REQUIREMENTS

### PART 1 - GENERAL

1. THE TERM "TENANT," "TENANT'S CONSTRUCTION MANAGER," "OWNER," OR "OWNER'S CONSTRUCTION MANAGER" SHALL REFER TO SWEETGREEN.
2. THE GENERAL CONTRACTOR SHALL PROVIDE ALL MATERIALS AND LABOR AS REQUIRED TO PROVIDE A COMPLETE WORKING SYSTEM AND AS DESCRIBED IN THESE DRAWINGS.
3. THE GENERAL CONTRACTOR SHALL REVIEW A COMPLETE SET OF THE CONSTRUCTION DOCUMENTS. EACH SUB-CONTRACTOR SHALL MAINTAIN A COMPLETE SET OF DRAWINGS ON SITE DURING THE CONSTRUCTION PROCESS.
4. COORDINATE WORK AS REQUIRED WITH THE LANDLORD. THE GENERAL CONTRACTOR SHALL NOTIFY LANDLORD-REQUIRED CONTRACTORS AT THE GENERAL CONTRACTOR'S EXPENSE.

### PART 2 - PRODUCTS

1. PRODUCTS SHALL BE AS DESCRIBED IN THE DRAWINGS AND AS REQUIRED FOR A COMPLETE AND FUNCTIONING SYSTEM.

### PART 3 - EXECUTION

1. UNLESS DIMENSIONS HAVE BEEN PROVIDED, THE DRAWINGS ARE DIAGRAMMATIC IN NATURE, SHOWING THE GENERAL LOCATION, TYPE, LAYOUT AND REQUIRED EQUIPMENT. THEY SHALL NOT BE SCALED. COORDINATE WITH THE ARCHITECTURAL DRAWINGS, TENANT VENDORS AND MANUFACTURER'S INSTALLATION INSTRUCTIONS AND CUTSHEETS AS REQUIRED.
2. COMPLETE ALL WORK IN COMPLIANCE WITH THE CODES LISTED ON SHEET G-001 INCLUDING ALL LOCAL AMENDMENTS, ALL RELEVANT NFPA CODES AND STANDARDS AND SMACNA STANDARDS.
3. VERIFY ALL CODE REQUIREMENTS AND LOCAL AMENDMENTS WITH THE AUTHORITY HAVING JURISDICTION PRIOR TO BID.
4. WHEN THERE IS A DISCREPANCY BETWEEN THE ADOPTED CODES AND THESE DRAWINGS, THE MORE STRINGENT REQUIREMENT SHALL APPLY.
5. COORDINATE WITH THE LOCAL AUTHORITY HAVING JURISDICTION AND ARRANGE ALL INSPECTIONS AS REQUIRED.
6. MAINTAIN A CLEAN CONSTRUCTION SITE DURING CONSTRUCTION. CLEAN SCRAP MATERIAL AND REMOVE FROM SITE DAILY AND MAINTAIN WORKING AREA IN AN ORDERLY FASHION.
7. PROVIDE SUBMITTALS AS NOTED IN THESE SPECIFICATIONS AND AS REQUESTED BY THE TENANT'S CONSTRUCTION MANAGER.
8. ALL SHOP DRAWINGS SHALL BE REVIEWED AND STAMPED BY THE GENERAL CONTRACTOR PRIOR TO SUBMITTING TO THE TENANT'S CONSTRUCTION MANAGER.
9. SHOP DRAWINGS SHALL BE SUBMITTED TO ALLOW FOR FIVE BUSINESS DAYS OF REVIEW TIME.
10. PROVIDE REQUESTS FOR INFORMATION TO THE TENANT'S CONSTRUCTION MANAGER.
11. REQUESTS FOR INFORMATION SHALL PROVIDE A DETAILED DESCRIPTION OF THE SITE CONDITION OR DISCREPANCY AND THE CONTRACTORS PROPOSED REMEDY.
12. REQUESTS FOR INFORMATION SHALL BE SUBMITTED TO ALLOW FOR FIVE BUSINESS DAYS OF REVIEW TIME.
13. UPON COMPLETION OF WORK, THE GENERAL CONTRACTOR SHALL PROVIDE THE TENANT'S CONSTRUCTION MANAGER WITH A BOUND RECORD OF ALL MECHANICAL EQUIPMENT UTILIZED IN THE JOB. THE GENERAL CONTRACTOR SHALL PROVIDE THE SAME INFORMATION ON A COMPACT DISC. THE BINDER SHALL CONTAIN:
  - A. COVER SHEET INDICATING THE PROJECT NAME, ADDRESS AND TURNOVER DATE.
  - B. COMPANY NAME AND CONTACT INFORMATION OF THE CONTRACTORS UTILIZED FOR THE MECHANICAL SCOPE OF WORK.
  - C. CUTSHEETS, INSTALLATION MANUALS AND MAINTENANCE REQUIREMENTS FOR ALL MECHANICAL EQUIPMENT.
14. UPON COMPLETION OF WORK, THE GENERAL CONTRACTOR SHALL PROVIDE THE TENANT'S CONSTRUCTION MANAGER A FULL SET OF DRAWINGS WITH ANY DEVIATIONS FROM THE DRAWINGS INDICATED IN RED INK.

(END OF SECTION 23 00 00)

## SECTION 23 05 93 - TESTING, ADJUSTING AND BALANCING FOR HVAC

### PART 1 - GENERAL

1. QUALITY ASSURANCE: ALL TESTING AND BALANCING WORK SHALL BE COMPLETED BY AN INDEPENDENT CONTRACTOR, CERTIFIED BY NEBB OR TABB AS A TAB TECHNICIAN. BALANCE THE SYSTEM IN ACCORDANCE WITH GENERALLY ACCEPTED ENGINEERING STANDARDS.

### PART 2 - PRODUCTS: NA

### PART 3 - EXECUTION

1. AIR SYSTEMS
  - A. PROVIDE ALL LABOR AND MATERIALS REQUIRED TO BALANCE THE SYSTEM AS NOTED ON THE PLANS.
  - B. FAN SYSTEMS SHALL BE ADJUSTED SUCH THAT THE LOWEST FAN SPEED IS UTILIZED TO DELIVER THE REQUIRED CFM TO THE AIR TERMINALS.
  - C. ADJUST DAMPERS AS REQUIRED TO BALANCE THE SUPPLY, RETURN AND EXHAUST DEVICES TO 10% OF THE DESIGN RATES. ADJUST THE OUTSIDE AIR DAMPER AS REQUIRED TO OBTAIN THE MINIMUM OUTSIDE AIR REQUIREMENTS AS NOTED IN THE SCHEDULES.
  - D. RECORD THE OPERATING VOLTAGE, AMPACITY, SUPPLY/RETURN SYSTEM STATIC PRESSURES, SUPPLY/RETURN AIR TEMPERATURES (BOTH HEATING AND COOLING) AND FINAL FAN RPM.
  - E. VERIFY SYSTEM CONTROLS ARE FUNCTIONING AS INTENDED.
2. WATER SYSTEMS
  - A. PROVIDE ALL LABOR AND MATERIALS REQUIRED TO BALANCE THE SYSTEM AS NOTED ON THE PLANS.
  - B. ADJUST BALANCING VALVES AS REQUIRED TO ACHIEVE A WATER FLOW WITHIN 5% OF THE DESIGN VALUE.
  - C. RECORD THE OPERATING FLOW RATE, WATER SUPPLY/RETURN TEMPERATURE CONDITIONS AND PRESSURE DROP ACROSS THE COIL.
  - D. VERIFY SYSTEM CONTROLS ARE FUNCTIONING AS INTENDED.
3. REPORTING
  - A. THE TEST AND BALANCE AGENT SHALL PREPARE A REPORT INCLUDING THE FINAL VALUES OF THE AIR AND WATER SYSTEM BALANCING, SYSTEM DIAGRAMS, AND SYSTEM NOTES.
  - B. THE GENERAL CONTRACTOR SHALL REVIEW THE FINAL BALANCE REPORT PRIOR TO SENDING TO THE TENANT'S CONSTRUCTION MANAGER.
  - C. PROVIDE TAB REPORT TO THE LANDLORD AND THE AUTHORITY HAVING JURISDICTION AS REQUIRED.

(END OF SECTION 23 05 93)

## SECTION 23 07 13 - DUCT INSULATION

### PART 1 - GENERAL

1. INSULATION SHALL BE PROVIDED ON THE FOLLOWING DUCT SERVICES:
  - A. INDOOR, CONCEALED SUPPLY AND OUTDOOR AIR.
  - B. INDOOR, CONCEALED RETURN.
  - C. INDOOR, CONCEALED OVEN AND WAREWASH EXHAUST FROM AIR TERMINAL TO PENETRATION OF BUILDING EXTERIOR.
  - D. INDOOR, CONCEALED GENERAL EXHAUST FROM AIR TERMINAL TO PENETRATION OF BUILDING EXTERIOR.
  - E. OUTDOOR, SUPPLY AND RETURN.
2. QUALITY ASSURANCE
  - A. INSULATION INSTALLED INDOORS SHALL HAVE A FLAME-SPREAD INDEX OF 25 OR LESS, AND SMOKE DEVELOPED INDEX OF 50 OR LESS.
  - B. INSULATION INSTALLED OUTDOORS SHALL HAVE A FLAME-SPREAD INDEX OF 75 OR LESS, AND SMOKE DEVELOPED INDEX OF 150 OR LESS.
  - C. INSULATION, ADHESIVES, MASTICS AND OTHER MATERIALS REQUIRED SHALL BE FREE OF FORMALDEHYDE.

### PART 2 - PRODUCTS

1. INTERIOR DUCTWORK SHALL HAVE FLEXIBLE FIBERGLASS DUCT WRAP LAMINATED TO FOIL REINFORCED KRAFT VAPOR BARRIER FACING WITH 2" STAPLING FLANGE AND AN INSTALLED THICKNESS OF 1-1/2" WITH AN R-VALUE OF 6.0.
2. EXTERIOR DUCTWORK SHALL BE INSULATED WITH 2" THICK RIGID INSULATION WITH A MINIMUM R-VALUE OF 12.0, PROTECTED WITH ROOFING MEMBRANE.

### PART 3 - EXECUTION

1. PREPARATION: CLEAN AND DRY SURFACES. REMOVE MATERIALS THAT WILL ADVERSELY AFFECT INSULATION APPLICATION.
2. GENERAL INSTALLATION REQUIREMENTS:
  - A. INSTALL INSULATION ACCORDING TO MANUFACTURER'S INSTALLATION INSTRUCTIONS.
  - B. INSTALL INSULATION AND ACCESSORIES AND FINISHES WITH SMOOTH, STRAIGHT AND EVEN SURFACES. FREE OF VOIDS THROUGHOUT THE LENGTH OF DUCT AND FITTINGS.
  - C. INSTALL ACCESSORIES COMPATIBLE WITH INSULATION MATERIALS AND SUITABLE FOR THE SERVICE. ACCESSORIES SHALL NOT CORRODE, SOFTEN OR OTHERWISE ATTACK INSULATION OR JACKET IN EITHER WET OR DRY STATE.
  - D. INSTALL INSULATION WITH LONGITUDINAL SEAMS AT TOP OF HORIZONTAL RUNS. LONGITUDINAL SEAMS AND END JOINTS SHALL BE TIGHT. BOND SEAMS AND JOINTS WITH ADHESIVE RECOMMENDED BY INSULATION MANUFACTURER TO MAINTAIN VAPOR BARRIER INTEGRITY.
  - E. APPLY ADHESIVES, MASTICS AND SEALANTS AT MANUFACTURER'S RECOMMENDED COVERAGE RATE.
  - F. CUT INSULATION IN A MANNER TO AVOID COMPRESSING INSULATION MORE THAN 75 PERCENT ITS NOMINAL THICKNESS.
3. PENETRATIONS
  - A. ROOF PENETRATIONS: INSTALL INSULATION CONTINUOUSLY THROUGH ROOF PENETRATIONS. FOR APPLICATIONS REQUIRING ONLY INDOOR INSULATION, TERMINATE INSULATION ABOVE ROOF SURFACE AND SEAL WITH JOINT SEALANT. FOR APPLICATIONS REQUIRING INDOOR AND OUTDOOR INSULATION, INSTALL INSULATION FOR OUTDOOR APPLICATIONS TIGHTLY JOINED TO INDOOR INSULATION ENDS, SEAL JOINT WITH JOINT SEALANT.
  - B. WALL PENETRATIONS: INSTALL INSULATION CONTINUOUSLY THROUGH WALL PENETRATIONS. FOR APPLICATIONS REQUIRING ONLY INDOOR INSULATION, TERMINATE INSULATION ABOVE ROOF SURFACE AND SEAL WITH JOINT SEALANT. FOR APPLICATIONS REQUIRING INDOOR AND OUTDOOR INSULATION, INSTALL INSULATION FOR OUTDOOR APPLICATIONS TIGHTLY JOINED TO INDOOR INSULATION ENDS, SEAL JOINT WITH JOINT SEALANT.
  - C. INTERIOR WALLS: INSTALL INSULATION CONTINUOUSLY THROUGH WALLS AND PARTITIONS THAT ARE NOT FIRE RATED. TERMINATE INSULATION AT FIRE DAMPER SLEEVES FOR FIRE RATED WALL AND PARTITION PENETRATIONS. EXTERNALLY INSTALL THE DAMPER SLEEVES TO MATCH ADJACENT INSULATION AND OVERLAP DUCT INSULATION AT LEAST 2 INCHES.

(END OF SECTION 23 07 13)

## SECTION 23 31 13 - METAL DUCTS

### PART 1 - GENERAL

1. SECTION INCLUDES
  - A. RECTANGULAR DUCTS AND FITTINGS
  - B. ROUND DUCTS AND FITTINGS
  - C. DOUBLE WALL DUCTWORK AND FITTINGS
  - D. FLAT OVAL DUCTS AND FITTINGS
  - E. SHEET METAL MATERIALS
  - F. SEALANTS AND GASKETS
  - G. HANGERS AND SUPPORTS
2. PERFORMANCE REQUIREMENTS
  - A. DUCT CONSTRUCTION, INCLUDING SHEET METAL THICKNESS, SEAM AND JOINT CONSTRUCTION, REINFORCEMENTS AND HANGERS/SUPPORTS SHALL COMPLY WITH THE LATEST VERSION OF SMACNA'S "HVAC DUCT CONSTRUCTION STANDARDS - METAL AND FLEXIBLE."
  - B. DUCT HANGERS AND SUPPORTS SHALL WITHSTAND THE EFFECTS OF GRAVITY LOADS AND STRESSES WITHIN LIMITS UNDER CONDITIONS DESCRIBED IN SMACNA'S "HVAC DUCT CONSTRUCTION STANDARDS - METAL AND FLEXIBLE."
  - C. SURFACES IN CONTACT WITH THE AIRSTREAM SHALL COMPLY WITH REQUIREMENTS IN ANSI/ASHRAE 62.1.
3. SECTION REQUIREMENTS
  - A. SUBMITTALS: NONE REQUIRED.

### PART 2 - PRODUCTS

1. RECTANGULAR DUCTS AND FITTINGS:
  - A. COMPLY WITH SMACNA'S "HVAC DUCT CONSTRUCTION STANDARDS - METAL AND FLEXIBLE" BASED ON INDICATED STATIC-PRESSURE CLASS UNLESS NOTED OTHERWISE.
  - B. TRAVERSE JOINTS: SELECT JOINT TYPES AND FABRICATE ACCORDING TO SMACNA'S "HVAC DUCT CONSTRUCTION STANDARDS - METAL AND FLEXIBLE," FIGURE 2-1 FOR STATIC PRESSURE CLASS, APPLICABLE SEALING REQUIREMENTS, MATERIALS INVOLVED, DUCT SUPPORT INTERVALS AND OTHER PROVISIONS AS REQUIRED.
  - C. LONGITUDINAL SEAMS: SELECT SEAM TYPES AND FABRICATE ACCORDING TO SMACNA'S "HVAC DUCT CONSTRUCTION STANDARDS - METAL AND FLEXIBLE," FIGURE 2-2 FOR STATIC PRESSURE CLASS, APPLICABLE SEALING REQUIREMENTS, MATERIALS INVOLVED, DUCT SUPPORT INTERVALS AND OTHER PROVISIONS AS REQUIRED.
  - D. ELBOWS, TRANSITIONS, BRANCH CONNECTIONS AND OTHER DUCT CONSTRUCTION: SELECT TYPES AND FABRICATE ACCORDING TO SMACNA'S "HVAC DUCT CONSTRUCTION STANDARDS - METAL AND FLEXIBLE," CHAPTER 4 FOR STATIC-PRESSURE CLASS, APPLICABLE SEALING REQUIREMENTS, MATERIALS INVOLVED, DUCT SUPPORT INTERVALS AND OTHER PROVISIONS AS REQUIRED.
2. ROUND DUCTS AND FITTINGS:
  - A. SPIRAL LOCK SEAM, WITHOUT INSULATION.
  - B. BASIS OF DESIGN: LINDAB SAFE SINGLE WALL DUCTS AND FITTINGS. ALTERNATES BY MCGILL AIRFLOW. ALL DUCTWORK SHALL BE PREPPED AND READY TO RECEIVE PAINT.
3. FLAT OVAL DUCTS AND FITTINGS:
  - A. SPIRAL LOCK SEAM, WITHOUT INSULATION.
  - B. BASIS OF DESIGN: LINDAB FOSH FLAT OVAL SPIRAL DUCTS AND FITTINGS. ALTERNATES BY MCGILL AIRFLOW. ALL DUCTWORK SHALL BE PREPPED AND READY TO RECEIVE PAINT.
4. DOUBLE WALL DUCTWORK AND FITTINGS:
  - A. SPIRAL LOCK SEAM, WITH 1" INSULATION THICKNESS.
  - B. BASIS OF DESIGN: LINDAB SAFE DOUBLE WALL DUCTS AND FITTINGS. ALTERNATES BY MCGILL AIRFLOW.
5. MATERIALS: GALVANIZED SHEET STEEL, COMPLY WITH ASTM A 653A 653M G90 COATING DESIGNATION.
6. SEALANTS AND GASKETS:
  - A. MAXIMUM FLAME-SPREAD INDEX: 25 (WHEN TESTED ACCORDING TO UL 723).
  - B. MAXIMUM SMOKE DEVELOPED INDEX: 50 (WHEN TESTED ACCORDING TO UL 723).
  - C. TWO-PART TAPE SEALING SYSTEM: PROVIDE 3" TAPE CONSTRUCTED OF WOVEN COTTON FIBER IMPREGNATED WITH MINERAL GYPSUM AND MODIFIED ACRYLIC/SILICONE TO FORM A HARD, DURABLE AIR/TIGHT SEAL. SEALANT SHALL BE A MODIFIED STYRENE ACRYLIC, COMPATIBLE WITH GALVANIZED SHEET STEEL, WATER, MOLD AND MILDEW RESISTANT. VOC CONTENT OF 25% OR LESS.
  - D. WATER BASED JOINT AND SEAM SEALANT: BRUSH ON WITH MINIMUM OF 65% SOLIDS CONTENT. MINIMUM SHORE A HARDNESS OF 20. COMPATIBLE WITH GALVANIZED SHEET STEEL, WATER, MOLD AND MILDEW RESISTANT. VOC CONTENT OF 75% (LESS WATER).
6. HANGERS AND SUPPORT:
  - A. RECTANGULAR DUCTWORK: HANGER RODS SHALL BE CADMIUM-PLATED STEEL RODS AND NUTS. STRAP AND ROD SIZE SHALL COMPLY WITH SMACNA'S "HVAC DUCT CONSTRUCTION STANDARDS - METAL AND FLEXIBLE," TABLE 5-1. SECURE TO DUCT WITH SHEET METAL SCREWS COMPATIBLE WITH DUCT MATERIALS.
  - B. ROUND DUCTWORK: SUPPORT WITH AIRCRAFT CABLE COMPLYING WITH ASTM A 603. CONNECT ENDS WITH CADMIUM-PLATED STEEL ASSEMBLIES WITH BRACKETS, SWIVEL AND BOLTS DESIGNED FOR DUCT HANGER SERVICE.
  - C. ROUND DUCTWORK SHALL BE PROVIDED WITH DUCT SUPPORTS, SPACED PER THE MANUFACTURER'S RECOMMENDATIONS.

### PART 3 - EXECUTION

1. INSTALLATION
  - A. DRAWING PLANS, SCHEMATICS AND DIAGRAMS INDICATE GENERAL LOCATION AND ARRANGEMENT OF DUCTWORK ROUTING. COORDINATE INSTALLATION WITH WORK OF ALL OTHER TRADES AND EXISTING CONDITIONS. ACCOMMODATE DUCT HANGER, RODS, INSULATION AND OTHER REQUIREMENTS AS REQUIRED.
  - B. INSTALL DUCTS ACCORDING TO SMACNA'S "HVAC DUCT CONSTRUCTION STANDARDS - METAL AND FLEXIBLE" IN MAXIMUM PRACTICAL LENGTHS WITH FEWEST POSSIBLE JOINTS.
  - C. UNLESS NOTED OTHERWISE, EXPOSED HEAD DO NOT USE TWO-PART TAPING SYSTEM. MAINTAIN CONSISTENCY, SYMMETRY AND UNIFORMITY IN THE INSTALLATION.
  - D. INSTALL DUCTS WITH CLEARANCES AS REQUIRED TO ACCOMMODATE THE INSTALLATION OF INSULATION.
  - E. INSTALLATION OF EXPOSED DUCTWORK: PROTECT DUCTWORK FROM DAMAGE. REPAIR/REPLACE ALL DAMAGED SECTIONS AND FINISHED WORK. TRIM SEALANTS FLUSH WITH METAL. CREATE A SMOOTH AND UNIFORM EXPOSED HEAD. DO NOT USE TWO-PART TAPING SYSTEM. MAINTAIN CONSISTENCY, SYMMETRY AND UNIFORMITY IN THE INSTALLATION.
2. DUCT SEALING: CONSTRUCT DUCTS WITH 2-INCH POSITIVE AND NEGATIVE DUCT PRESSURE CLASSIFICATIONS.
3. HANGER AND SUPPORT INSTALLATION: COMPLY WITH SMACNA'S "HVAC DUCT CONSTRUCTION STANDARDS - METAL AND FLEXIBLE," CHAPTER 5 AND HANGERS EXPOSED TO VIEW SHALL BE AS NOTED IN THE MECHANICAL DETAILS.
4. CONNECTIONS: MAKE CONNECTIONS TO EQUIPMENT WITH FLEXIBLE CONNECTORS COMPLYING WITH SECTION 23 33 00 "AIR DUCT ACCESSORIES." COMPLY WITH SMACNA'S "HVAC DUCT CONSTRUCTION STANDARDS - METAL AND FLEXIBLE" FOR BRANCH, OUTLET AND INLET, AND TERMINAL UNIT CONNECTIONS.
5. CLEANING: CLEAN ALL EXISTING DUCTWORK PRIOR TO REBAM PRIOR TO TESTING, ADJUSTING AND BALANCING. REMOVE ALL SURFACE CONTAMINANTS AND DEPOSITS ON AIR OUTLETS AND INLETS PRIOR TO PUNCH.
6. PROVIDE AIR BALANCE IN ACCORDANCE WITH SECTION 23 05 93 "TESTING, ADJUSTING, AND BALANCING FOR HVAC."
7. DUCT ELBOWS
  - A. RECTANGULAR: PROVIDE HOLLOW-FORMED, DOUBLE-THICKNESS TURNING VANES OR RADUSED ELBOWS WITH INSIDE RADIUS NO SMALLER THAN 1/2 OF THE DUCT WALL THICKNESS.
  - B. ROUND DUCT ELBOWS: PROVIDE RADUSED ELBOWS WITH AN INSIDE RADIUS NO SMALLER THAN 1/2 OF THE DUCT WIDTH.
8. BRANCH CONNECTION
  - A. RECTANGULAR: COMPLY WITH SMACNA'S "HVAC DUCT CONSTRUCTION STANDARDS - METAL AND FLEXIBLE," FIGURE 4.6. RECTANGULAR MAIN TO RECTANGULAR BRANCH SHALL BE 45-DEGREE ENTRY. RECTANGULAR MAIN TO ROUND BRANCH SHALL BE A SPIN-IN FITTING.
  - B. ROUND: COMPLY WITH SMACNA'S "HVAC DUCT CONSTRUCTION STANDARDS - METAL AND FLEXIBLE," FIGURE 3.5 AND FIGURE 3.6. PROVIDE 90 DEGREE TAP.

(END OF SECTION 23 31 13)

## SECTION 23 33 00 - AIR DUCT ACCESSORIES

### PART 1 - GENERAL

1. SECTION INCLUDES
    - A. BACKDRAFT AND PRESSURE RELIEF DAMPERS
    - B. MANUAL VOLUME DAMPERS
    - C. CONTROL DAMPERS
    - D. FIRE DAMPERS
    - E. TURNING VANES
    - F. FLEXIBLE CONNECTORS
    - G. DUCT ACCESSORY HARDWARE
  2. SECTION REQUIREMENTS
    - A. SUBMITTALS: NONE REQUIRED.
  3. PRODUCTS
    1. COMPLY WITH NFPA 90A AND WITH NFPA 90B.
    2. COMPLY WITH SMACNA'S "HVAC DUCT CONSTRUCTION STANDARDS - METAL AND FLEXIBLE" FOR ACCEPTABLE MATERIALS, THICKNESS AND DUCT CONSTRUCTION METHODS UNLESS NOTED OTHERWISE. SHEET METAL MATERIALS SHALL BE FREE FROM PITTING, SEAM MARKS, ROLLER MARKS, STAINS, DISCOLORATIONS AND OTHER IMPERFECTIONS.
    3. GALVANIZED SHEET STEEL: COMPLY WITH ASTM A 653A 653M G90 COATING DESIGNATION.
    4. BACKDRAFT AND PRESSURE RELIEF DAMPERS: GRAVITY BALANCED, AS SPECIFIED ON THE PLANS.
    5. MANUAL VOLUME DAMPERS: STANDARD LEAKAGE RATING WITH LINKAGE OUTSIDE OF AIRFRAME. SUITABLE FOR HORIZONTAL OR VERTICAL APPLICATIONS
    6. FRAME: HAT SHAPED WITH MITERED AND WELDED CORNERS. FLANGELESS FRAMES FOR INSTALLING IN DUCTS.
    7. BLADES: RECTANGULAR DAMPERS SHALL BE MULTIPLE BLADES WITH OPPOSED-BLADE DESIGN. ROUND DAMPERS SHALL BE SINGLE BLADE.
    8. BLADE AXLES: GALVANIZED STEEL.
    9. BEARINGS: MOLDED SYNTHETIC.
    10. THE BARS AND BRACKETS: GALVANIZED STEEL.
    11. JACKSHAFT: 1/2" DIAMETER CONSTRUCTED OF GALVANIZED STEEL WITHIN PIPE-BEARING ASSEMBLY WITH SUPPORTS. LENGTH AND NUMBER OF MOUNTINGS AS REQUIRED.
    12. HARDWARE: ZINC-PLATED, DIE CAST CORE WITH DIAL HANDLE AND A LOCKING NUT.
  6. CONTROL DAMPERS
    - A. FRAME: HAT SHAPED WITH MITERED AND WELDED CORNERS. FLANGELESS FRAMES FOR INSTALLING IN DUCTS.
    - B. BLADES: RECTANGULAR DAMPERS SHALL BE MULTIPLE BLADES WITH OPPOSED-BLADE DESIGN. ROUND DAMPERS SHALL BE SINGLE BLADE. BLADE EDGING SHALL BE REPLACEABLE RUBBER SEALS.
    - C. BLADE AXLES: 1/2" DIAMETER. BLADE LINKAGE HARDWARE OF ZINC-PLATED STEEL AND BRASS; ENDS SEALED AGAINST BLADE BEARING.
    - D. BEARINGS: MOLDED SYNTHETIC.
  7. FIRE DAMPERS
    - A. TYPE: STATIC, RATED AND LABELED ACCORDING TO UL 555.
    - B. CLOSING RATINGS IN DUCTS UP TO 4" STATIC PRESSURE CLASS AND MAXIMUM 2,000 FPM VELOCITY.
    - C. FIRE RATINGS: 1-1/2 HOURS, OR AS NOTED IN THE SCHEDULES.
    - D. FRAME: CURTAIN TYPE WITH BLADES INSIDE AIRSTREAM. CONSTRUCTED OF GALVANIZED STEEL.
    - E. MOUNTING SLEEVE: FACTORY FURNISHED.
    - F. MOUNTING ORIENTATION: AS NOTED ON PLANS.
    - G. BLADES: INTERLOCKING, CONSTRUCTED OF GALVANIZED STEEL.
    - H. HEAT RESPONSIVE DEVICE: 160 DEGREE F RATED FUSIBLE LINK OR AS NOTED IN THE SCHEDULES.
    8. TURNING VANES: CURVED BLADES OF GALVANIZED SHEET STEEL. PROVIDED WITH SUPPORT BARS PERPENDICULAR TO BLADE SET. SUITABLE FOR DUCT MOUNTING. COMPLY WITH SMACNA'S "HVAC DUCT CONSTRUCTION STANDARDS - METAL AND FLEXIBLE," SINGLE WALL CONSTRUCTION.
    9. FLEXIBLE CONNECTORS: CONSTRUCTED OF FLAME-RETARDANT OR NONCOMBUSTIBLE FABRIC. FABRIC SHALL BE A GLASS FABRIC, DOUBLE COATED WITH NEOPRENE. COMPLY WITH UL 181 CLASS 1. FACTORY-FABRICATED WITH A FABRIC STRIP 3-1/2 INCHES WIDE ATTACHED TO TWO STRIPS OF 2-3/4 INCH THICK GALVANIZED SHEET STEEL.
3. EXECUTION
  1. INSTALLATION
    - A. INSTALL DUCT ACCESSORIES ACCORDING TO APPLICABLE DETAILS IN SMACNA'S "HVAC DUCT CONSTRUCTION STANDARDS - METAL AND FLEXIBLE."
    - B. INSTALL VOLUME DAMPERS AND FLEXIBLE CONNECTORS NOTED ON PLANS AND AS REQUIRED FOR SYSTEM BALANCING. WHERE DAMPERS ARE INSTALLED IN DUCTS WITH DUCT LINER, INSTALL DAMPERS WITH HAT CHANNELS OF SAME DEPTH AS LINER AND TERMINATE LINER WITH NOSING AT HAT CHANNEL.
    - C. SET DAMPERS TO FULLY OPEN POSITION BEFORE TESTING, ADJUSTING AND BALANCING.
    - D. INSTALL TEST HOLES AT FAN INLETS AND OUTLETS AND WHERE REQUIRED FOR TESTING AND BALANCING PURPOSES.
    - E. INSTALL FIRE DAMPERS ACCORDING TO UL LISTING.
    - F. INSTALL FLEXIBLE CONNECTORS TO CONNECT DUCTS TO EQUIPMENT.
  2. TESTS AND INSPECTIONS
    - A. OPERATE DAMPERS TO VERIFY FULL RANGE OF MOVEMENT.
    - B. OPERATE FIRE DAMPERS TO VERIFY FULL RANGE OF MOVEMENT AND VERIFY THAT PROPER HEAT-RESPONSE DEVICE IS INSTALLED.
    - C. INSPECT TURNING VANES FOR PROPER AND SECURE INSTALLATION.

(END OF SECTION 23 33 00)

## SECTION 23 33 46 - FLEXIBLE DUCTS

### PART 1 - GENERAL

1. SECTION REQUIREMENTS
  - A. SUBMITTALS: NONE REQUIRED.
2. PRODUCTS
  1. COMPLY WITH NFPA 90A AND NFPA 90B.
  2. COMPLY WITH SMACNA'S "HVAC DUCT CONSTRUCTION STANDARDS - METAL AND FLEXIBLE" FOR ACCEPTABLE MATERIALS, MATERIAL THICKNESS AND DUCT CONSTRUCTION METHODS UNLESS NOTED OTHERWISE.
  3. COMPLY WITH ASTM F 846 80M.
  4. INSULATED, FLEXIBLE DUCT UL 181, CLASS 1. FACTORY FABRICATED AND INSULATED. PROVIDED WITH INTERIOR LINER, FIBROUS-GLASS INSULATION AND VAPOR-BARRIER FILM.
  5. PRESSURE RATING: 10" W.G. POSITIVE.
  6. MAXIMUM VELOCITY: 4,000 FPM.
  7. INSULATION R-VALUE: R-6.0.
  8. FLEXIBLE DUCT CONNECTIONS SHALL BE NYLON STRAPS IN SIZES 3 THROUGH 18 INCHES TO SUIT DUCT SIZE.

### PART 3 - EXECUTION

1. INSTALLATION
  - A. INSTALL FLEXIBLE DUCTS ACCORDING TO APPLICABLE DETAILS IN SMACNA'S "HVAC DUCT CONSTRUCTION STANDARDS - METAL AND FLEXIBLE."
  - B. INSTALL IN INDOOR APPLICATIONS ONLY. FLEXIBLE DUCTWORK IS ONLY PERMITTED TO CONNECT TO SUPPLY-AIR GRILLES, REGISTERS AND DIFFUSERS. MAXIMUM LENGTH SHALL BE 60 INCHES.
  - C. CONNECT FLEXIBLE DUCTS TO METAL DUCTS WITH DRAW BANDS AND TAPE.
  - D. INSTALL DUCTS FULLY EXTENDED.
  - E. DO NOT BEND DUCTS AT SHARP CORNERS.
  - F. BENDS OF FLEXIBLE DUCTING SHALL NOT EXCEED A MINIMUM OF ONE DUCT DIAMETER.
  - G. AVOID CONTACT WITH METAL FIXTURES, WATER LINES, PIPES, ADJACENT DUCTWORK OR CONDUIT.
  - H. INSTALL FLEXIBLE DUCTS IN A DIRECT LINE, WITHOUT SAGS, TWISTS OR TURNS.
  - I. SUSPEND FLEXIBLE DUCTS WITH BANDS 1-1/2 INCHES WIDE AND SPACED A MAXIMUM OF 48 INCHES APART. PROVIDE ADDITIONAL SUPPORT AT BENDS. DUCTS MAY REST ON CEILING JOISTS OR TRUSS SUPPORTS. SPACING BETWEEN THESE ELEMENTS SHALL NOT EXCEED 48 INCHES.

(END OF SECTION 23 33 46)

## SECTION 23 34 02 - POWER VENTILATORS

### PART 1 - GENERAL

1. SECTION REQUIREMENTS
  - A. SUBMITTALS: PROVIDE SHOP DRAWINGS INDICATING THE DIMENSIONS, WEIGHTS, REQUIRED CLEARANCES, COMPONENTS, ELECTRICAL CHARACTERISTICS, CFM, STATIC PRESSURE AND FAN CURVE.
  - B. WARRANTY: SUBMIT A WRITTEN WARRANTY, SIGNED BY THE MANUFACTURER AGREEING TO REPAIR OR REPLACE COMPONENTS OF RTUS THAT FAIL IN MATERIALS OR WORKMANSHIP WITHIN THE MANUFACTURER'S STANDARD WARRANTY PERIOD.

### PART 2 - PRODUCTS

1. DESCRIPTION
  - A. CENTRIFUGAL ROOF EXHAUSTER. UPBLAST OR DOWNBLAST.
  - B. MANUFACTURERS: AS NOTED WITH THE MECHANICAL SCHEDULES. NO SUBSTITUTIONS SHALL BE PERMITTED.
  - C. CHARACTERISTICS: PROVIDED WITH
    - A. CURB: CONSTRUCTED OF GALVANIZED STEEL WITH FULLY WELDED CORNERS AND AS NOTED IN THE MECHANICAL SCHEDULES.
    - B. FAN: CONSTRUCTED OF SPUN ALUMINUM AND GALVANIZED STEEL. CENTRIFUGAL AND DIRECT DRIVE. FAN SHALL BEAR A PERMANENTLY ATTACHED NAMEPLATE DISPLAYING THE MODEL AND SERIAL NUMBER OF THE UNIT.
    - C. HOUSING: THE BASE SHALL BE CONSTRUCTED OF GALVANIZED STEEL WITH WELDED CORNERS AND SUPPORT FOR HINGING AND CLEANING AND TO PREVENT LEAKAGE INTO THE BUILDING. FAN WINDBARD SHALL BE CONSTRUCTED OF HEAVY GAUGE ALUMINUM OR GALVANIZED STEEL, SECURELY FASTENED TO THE WINDBARD WITH HORIZONTAL AND VERTICAL SUPPORTS.
    - D. WHEEL: CENTRIFUGAL, BACKWARD-INCLINED AND NON-OVERLOADING. WHEEL SHALL BE BALANCED IN TWO PLANES AND COMPLETED IN ACCORDANCE WITH AMCA STANDARD 204-96. WHEEL BLADES SHALL BE DESIGNED TO MINIMIZE TURBULANCE AND REDUCE NOISE. BLADES SHALL BE WELDED TO THE WHEEL INLET CONE. BALANCING WEIGHTS SHALL BE RETIRED TO THE BLADES OR WHEEL. WHEEL SHALL BE ATTACHED TO THE MOTOR SHAFT WITH TWO SET SCREWS.
    - E. MOTOR: 120 VOLT, PERMANENTLY LUBRICATED, RATED FOR CONTINUOUS DUTY, THERMALLY PROTECTED AND MOUNTED OUTSIDE THE AIRSTREAM. MOTOR MOUNTING PLATE SHALL BE CONSTRUCTED OF HEAVY GAUGE GALVANIZED STEEL. THE MOTOR COMPARTMENT SHALL BE COOLED BY OUTSIDE AIR. THE MOTOR COMPARTMENT SHALL BE OF A TWO-PIECE CONSTRUCTION WITH THE CAP HAVING QUICK RELEASE CLIPS.
    - F. ACCESSORIES: AS NOTED ON THE MECHANICAL SCHEDULES.

### PART 3 - EXECUTION

1. INSTALLATION
  - A. ROOF CURB: INSTALL ON ROOF STRUCTURE, LEVEL, SECURE, PER STRUCTURAL DETAILS AND PER THE MANUFACTURER'S INSTALLATION INSTRUCTIONS.
  - B. UNIT SUPPORT: INSTALL UNIT LEVEL ON STRUCTURAL CURBS PER STRUCTURAL DETAILS AND PER THE MANUFACTURER'S INSTALLATION INSTRUCTIONS.
2. CONNECTIONS
  - A. COMPLY WITH DUCT INSTALLATION REQUIREMENTS SPECIFIED IN OTHER HVAC SECTIONS. DRAWINGS INDICATE GENERAL ARRANGEMENTS OF DUCTS.
  - B. INSTALL DUCTS TO TERMINATION TO TOP OF ROOF CURB. REMOVE ROOF DECKING ONLY AS REQUIRED FOR PASSAGE OF DUCTS. DO NOT CUT OUT DECKING UNDER ENTIRE ROOF CURB. CONNECT TO FANS WITH FLEXIBLE DUCT CONNECTORS.
  - C. WHERE INSTALLING PIPING ADJACENT TO FANS, ALLOW SPACE FOR SERVICE AND MAINTENANCE.
  - D. CONNECT ELECTRICAL WIRING IN ACCORDANCE WITH THE ELECTRICAL SPECIFICATIONS.
  - E. GROUND EQUIPMENT IN ACCORDANCE WITH THE ELECTRICAL SPECIFICATIONS.
3. FIELD QUALITY CONTROL
  - A. AFTER INSTALLING FANS, TEST UNITS FOR COMPLIANCE WITH REQUIREMENTS.
  - B. INSPECT OR AND REMOVE SHIPPING BOLTS, BLOCKS AND THE DOWN STRAPS.
  - C. CONFIRM PROPER MOTOR ROTATION AND UNIT OPERATION.
  - D. TEST AND ADJUST CONTROLS AND SAFETIES. REPLACE DAMAGED AND MALFUNCTIONING CONTROLS AND EQUIPMENT.
  - E. OPERATIONAL TEST: AFTER ELECTRICAL CIRCUITRY HAS BEEN ENERGIZED, START UNITS TO CONFIRM PROPER MOTOR ROTATION AND UNIT OPERATION.

(END OF SECTION 23 34 02)



sweetgreen

3101 W. EXPOSITION BLVD.  
LOS ANGELES, CALIFORNIA 90018

THESE DRAWINGS & SPECIFICATIONS ARE CONFIDENTIAL AND SHALL REMAIN THE SOLE PROPERTY OF SWEETGREEN CORPORATION. THEY SHALL NOT BE REPRODUCED IN WHOLE OR IN PART, SHARED WITH THIRD PARTIES OR USED IN ANY MANNER ON OTHER PROJECTS OR EXTENSIONS TO THIS PROJECT WITHOUT THE PRIOR WRITTEN CONSENT OF SWEETGREEN CORPORATION. THESE DRAWINGS & SPECIFICATIONS ARE INTENDED TO EXPRESS DESIGN INTENT FOR A PROTOTYPICAL SWEETGREEN STORE WHICH IS SUBJECT TO CHANGE AT ANY TIME AND MAY NOT REFLECT ACTUAL SITE CONDITIONS. NEITHER PARTY SHALL HAVE ANY OBLIGATION NOR LIABILITY TO THE OTHER EXCEPT AS STATED ABOVE UNTIL A WRITTEN AGREEMENT IS FULLY EXECUTED.

ENGINEER OF RECORD:



EVERJ ENGINEERING, INC.  
1509 BUCK TRAIL LANE  
WORTHINGTON, OH 43085  
240-319-0822  
www.everjengineering.com  
TX ENGINEERING FIRM F-22980

STAMP:

NOT FOR  
CONSTRUCTION

05/05/2022

PROJECT INFORMATION:  
MUELLER

PROJECT INFORMATION:  
1900 ALDRICH ST.  
SUITE 140  
AUSTIN, TX 78723

DRAWN BY: JAE  
CHECKED BY: MK  
PROJECT MANAGER: JAE  
SG DESIGN MANAGER: LG  
SG CONST. MANAGER: KZ  
PROJECT NO: 210005  
TEMPLATE VERSION: 12/21/2021

REVISIONS  
REV. DATE DESCRIPTION  
1 05/05/2022 LANDLORD COMMENTS

MECHANICAL  
SPECIFICATIONS

M-010

SECTION 23 08 00 - HVAC COMMISSIONING

PART 1 - GENERAL

- 1. SECTION INCLUDES
A. COOLING AND HEATING SYSTEMS, INCLUDING DIRECT EXPANSION SYSTEMS.
2. SUBMITTALS: PROVIDE QUALIFICATION DATA FOR HVAC&R TESTING TECHNICIANS.
3. QUALITY ASSURANCE
A. TECHNICIANS PERFORMING COMMISSIONING WORK SHALL HAVE THE REQUIRED KNOWLEDGE OF THE INSTALLED SYSTEMS, ELECTRICAL CONCEPTS, BUILDING OPERATIONS AND AND/OR SERVICE TOOLS AND INSTRUMENTATION UTILIZED.

PART 2 - PRODUCTS (NOT USED)

PART 3 - EXECUTION

- A. COMMISSIONING IS INTENDED TO VERIFY AND DOCUMENT PROPER INSTALLATION AND DESIGN PARAMETERS OF EQUIPMENT AND SYSTEMS, ENSURE THAT OPERATING AND DOCUMENTATION REQUIREMENTS ARE COMPLETE AND TO PROVIDE THE OWNER WITH A FUNCTIONAL SYSTEM THAT MEETS THE CONTRACT DOCUMENTS.
B. COMMISSIONING REQUIRES COOPERATION AND INVOLVEMENT OF ALL PARTIES THROUGHOUT THE CONSTRUCTION PROCESS AND WILL ENCOMPASS AND COORDINATE TRADITIONALLY FUNCTIONAL AREAS OF: SYSTEM DOCUMENTATION, INSPECTION, PRE-FUNCTIONAL CHECKLIST AND STARTUP, CONTROL SYSTEM CALIBRATION, TESTING, ADJUSTING AND BALANCING, PERFORMANCE TESTS, CONTRACTOR DEMONSTRATION TO THE OWNER AND TRAINING OF OWNER'S PERSONNEL. ASSEMBLE ALL RELATED DOCUMENTATION INTO ONE COMMISSIONING MANUAL. PROVIDE A BOUND COPY OF THIS MANUAL TO THE OWNER'S CONSTRUCTION MANAGER AND PROVIDE A DIGITAL COPY ON FLASH DRIVE AT THE PROJECT OFFICE.
C. VERIFY THAT HVAC&R SYSTEMS HAVE BEEN INSTALLED, CALIBRATED AND STARTED AND ARE OPERATING ACCORDING TO THE CONTRACT DOCUMENTS, THE MANUFACTURER'S AND/OR SERVICE SHOP DRAWINGS AND SUBMITTALS.
D. CERTIFY THAT HVAC&R INSTRUMENTATION AND CONTROL SYSTEMS HAVE BEEN INSTALLED AND CALIBRATED, THAT THEY ARE OPERATING ACCORDING TO THE CONTRACT DOCUMENTS AND APPROVED SHOP DRAWINGS AND SUBMITTALS, AND THAT THE PRESET SET POINTS HAVE BEEN RECORDED.
E. CERTIFY THAT TAB PROCEDURES HAVE BEEN COMPLETED AND THAT TAB REPORTS HAVE BEEN SUBMITTED, DISCREPANCIES CORRECTED, AND CORRECTIVE WORK APPROVED.
F. SET SYSTEMS, SUBSYSTEMS AND EQUIPMENT INTO OPERATING MODES TO BE TESTED ACCORDING TO APPROVED TEST PROCEDURES. MODES REQUIRED TO BE TESTED INCLUDE STANDBY, NORMAL SHUTDOWN, NORMAL AUTO POSITION, NORMAL MANUAL POSITION, OCCUPIED AND UNOCCUPIED CYCLES AND ALARM.
G. CONFIRM CAPACITIES AND EFFECTIVENESS OF SYSTEMS, SUBSYSTEMS, EQUIPMENT AND COMPONENTS INCLUDING OPERATIONAL AND CONTROL FUNCTIONS.
H. TEST SYSTEMS, SUBSYSTEMS, EQUIPMENT AND COMPONENTS OPERATING MODES, INTERLOCKS, CONTROL RESPONSES AND RESPONSES TO ABNORMAL OR EMERGENCY CONDITIONS.
I. PREPARE AND SUBMIT A DETAILED CONSTRUCTION CHECKLIST FOR HVAC&R SYSTEMS, SUBSYSTEMS, EQUIPMENT AND COMPONENTS.
J. PERFORM TESTS USING DESIGN CONDITIONS WHENEVER POSSIBLE. WHERE REQUIRED SIMULATED CONDITIONS MAY BE IMPOSED USING AN ARTIFICIAL LOAD. COMMISSIONING PROCEDURES MAY DIRECT THAT SET POINTS BE ALTERED WHEN SIMULATING CONDITIONS IS IMPRACTICAL. COMMISSIONING TEST PROCEDURES MAY DIRECT THAT SENSOR VALUES BE ADJUSTED TO REFLECT NORMAL OPERATING CONDITIONS WHEN DESIGN OR SIMULATING CONDITIONS ARE UNAVAILABLE.
K. IF TESTS CANNOT BE COMPLETED BECAUSE OF A DEFICIENCY OUTSIDE THE SCOPE OF THE HVAC&R SYSTEM, DOCUMENT THE DEFICIENCY AND REPORT IT TO THE OWNER'S CONSTRUCTION MANAGER. DEFICIENCIES ARE RESOLVED, RESCHEDULE TESTS.
L. PROVIDE TECHNICIANS, INSTRUMENTATION, TOOLS AND EQUIPMENT TO COMPLETE AND DOCUMENT PERFORMANCE TESTS, COMMISSIONING TESTS AND COMMISSIONING DEMONSTRATIONS.
M. THE COMMISSIONING AGENT SHALL CONDUCT REGULAR MEETINGS DURING CONSTRUCTION TO IDENTIFY AND ASSIST IN RESOLVING ISSUES, INCLUDING BUT NOT LIMITED TO, AIRFLOW, INSTRUMENTATION QUALITY DEFICIENCIES RECEIPT OF AS-BUILT-DRAWINGS AND SCHEDULE.
N. COMMISSIONING AGENT SHALL PROVIDE A FINAL REPORT AT PROJECT TURNOVER. REPORT SHALL INCLUDE AN EXECUTIVE SUMMARY, CONSTRUCTION LIST, COMMISSIONING CHECK PROCEDURES MANUAL AND TAB REPORT.
2. SPLIT AIR-HANDLING SYSTEMS SYSTEM TESTS
A. OCCUPIED TIME CONTROL: START THE SYSTEM IN UNOCCUPIED MODE. ADVANCE TO OCCUPIED MODE SCHEDULED TIME.
B. DAMPER CONTROL: START THE SYSTEM IN UNOCCUPIED MODE. VERIFY THE MOTORIZED DAMPERS ARE IN THE CORRECT POSITIONS. ADVANCE TO OCCUPIED MODE AND VERIFY THAT DAMPERS ADJUST TO THE CORRECT POSITION.
C. COMPLETE TESTING DURING STEADY-STATE CONDITIONS, TO TEST SYSTEM REACTIONS TO CHANGES IN OPERATION CONDITIONS AND DURING EMERGENCY CONDITIONS. THE AGENT SHALL PREPARE DETAILED SYSTEMS PERFORMANCE TEST PROCEDURES FOR REVIEW AND APPROVAL UNDER THESE TEST PROCEDURES.
3. UNOCCUPIED OPERATION OF COMMISSIONING, THE GENERAL CONTRACTOR SHALL PROVIDE INSTRUCTION TO OPERATIONS PERSONNEL CONCERNING THE LOCATION, OPERATION AND CONTROL OF THE SYSTEMS.

(END OF SECTION 23 08 00)

SECTION 23 34 03 - UTILITY SET POWER VENTILATORS

PART 1 - GENERAL

- 1. SECTION REQUIREMENTS
A. SUBMITTALS: PROVIDE SHOP DRAWINGS INDICATING THE DIMENSIONS, WEIGHTS, REQUIRED CLEARANCES, COMPONENTS, ELECTRICAL CHARACTERISTICS, CFM, STATIC PRESSURE AND FAN CURVE CHARACTERISTICS AND LOCATION AND SIZE OF EACH FIELD CONNECTION FOR EACH INDOOR AND OUTDOOR UNIT.
B. WARRANTY: SUBMIT A WRITTEN WARRANTY, SIGNED BY THE MANUFACTURER AGREEING TO REPAIR OR REPLACE COMPONENTS OF RTUS THAT FAIL IN MATERIALS OR WORKMANSHIP WITHIN THE MANUFACTURER'S STANDARD WARRANTY PERIOD.

PART 2 - PRODUCTS

- 1. DESCRIPTION
A. CENTRIFUGAL UPLAST UTILITY EXHAUST VENTILATOR.
2. MANUFACTURERS: AS NOTED IN THE MECHANICAL SCHEDULES. NO SUBSTITUTIONS SHALL BE PERMITTED.
3. CHARACTERISTICS: PROVIDED WITH:
A. BASE, CONSTRUCTED OF GALVANIZED STEEL.
B. HOUSING, CONSTRUCTED OF ALUMINIZED AND GALVANIZED STEEL. FAN SCROLL SHALL BE CONTINUOUSLY SEALED AND TACK WELDED.
C. WHEEL, CENTRIFUGAL, BACKWARDS INCLINED AND NON-OVERLOADING, BALANCED IN TWO PLANES IN ACCORDANCE WITH AMCA STANDARDS. WHEEL BLADES SHALL BE AERODYNAMICALLY DESIGNED TO MINIMIZE TURBULENCE AND REDUCE NOISE. WHEEL SHALL BE CONSTRUCTED OF HEAVY GAUGE WELDED ALUMINUM. ANY BALANCING WEIGHTS SHALL BE WELDED OR RIVETED TO THE BLADES OR WHEEL. WHEEL SHALL BE FIRMLY ATTACHED TO THE MOTOR SHAFT WITH SET SCREWS.
D. MOTOR: HEAVY DUTY BALL BEARING TYPE MOUNTED OUT OF THE AIRSTREAM AT THE VOLTAGE AND PHASE NOTED IN THE SCHEDULES. MOTOR COMPARTMENT SHALL BE COOLED BY OUTSIDE AIR. MOTOR COMPARTMENT SHALL BE COMPLETELY REMOVABLE WITH THE MOTOR COVER ASSEMBLY HAVING WING BOLTS TO SECURE THE ASSEMBLY TO THE HOUSING.
E. BELTS AND DRIVES: BELTS SHALL BE HEAT AND OIL RESISTANT, NON-STATIC TYPE. DRIVES SHALL BE CAST TYPE AND SIZED FOR A MINIMUM OF 150% THE INSTALLED MOTOR HORSEPOWER. FAN OPERATING SPEED SHALL BE FACTORY SET USING ADJUSTABLE FITCH PULLEYS. MOTORS OVER 2 HP TO BE FURNISHED WITH DOUBLE-GROOVE PULLEYS.
F. ACCESSORIES: AS NOTED ON THE MECHANICAL SCHEDULES.

PART 3 - EXECUTION

- 1. INSTALLATION
A. UNIT SUPPORT: INSTALL ON ROOF RAILS ON ROOF STRUCTURE, LEVEL, SECURE, PER STRUCTURAL DETAILS AND PER THE MANUFACTURER'S INSTALLATION INSTRUCTIONS.
2. CONNECTIONS
A. COMPLY WITH DUCT INSTALLATION REQUIREMENTS SPECIFIED IN OTHER HVAC SECTIONS. DRAWINGS INDICATE GENERAL ARRANGEMENTS OF DUCTS.
B. CONNECT TO FANS WITH FLEXIBLE DUCT CONNECTORS.
C. WHERE INSTALLING PIPING ADJACENT TO FANS, ALLOW SPACE FOR SERVICE AND MAINTENANCE.
D. CONNECT ELECTRICAL WIRING IN ACCORDANCE WITH THE ELECTRICAL SPECIFICATIONS.
E. GROUND EQUIPMENT IN ACCORDANCE WITH THE ELECTRICAL SPECIFICATIONS.
3. FIELD QUALITY CONTROL
A. AFTER INSTALLING FANS, TEST UNITS FOR COMPLIANCE WITH REQUIREMENTS.
B. INSPECT OR AND REMOVE SHIPPING BOLTS, BLOCKS AND TIE-DOWN STRAPS.
C. CONFIRM PROPER MOTOR ROTATION AND UNIT OPERATIONS.
D. TEST AND ADJUST CONTROLS AND SAFETIES. REPLACE DAMAGED AND MALFUNCTIONING CONTROLS AND EQUIPMENT.
E. OPERATIONAL TEST: AFTER ELECTRICAL CIRCUITRY HAS BEEN ENERGIZED, START UNITS TO CONFIRM PROPER MOTOR ROTATION AND UNIT OPERATION.

(END OF SECTION 23 34 03)

SECTION 23 37 13 - GRILLES, REGISTERS & DIFFUSERS

PART 1 - GENERAL

- 1. SECTION REQUIREMENTS
A. SUBMITTALS: NONE REQUIRED.

PART 2 - PRODUCTS

- 1. GRILLES: MANUFACTURER, MODEL, MATERIAL, FINISH, MOUNTING AND ACCESSORIES SHALL BE AS NOTED IN THE MECHANICAL SCHEDULES. NO SUBSTITUTIONS SHALL BE PERMITTED.
2. REGISTERS: MANUFACTURER, MODEL, MATERIAL, FINISH, MOUNTING AND ACCESSORIES SHALL BE AS NOTED IN THE MECHANICAL SCHEDULES. NO SUBSTITUTIONS SHALL BE PERMITTED.
3. DIFFUSERS: MANUFACTURER, MODEL, MATERIAL, FINISH, MOUNTING AND ACCESSORIES SHALL BE AS NOTED IN THE MECHANICAL SCHEDULES. NO SUBSTITUTIONS SHALL BE PERMITTED.

PART 3 - EXECUTION

- 1. INSTALLATION
A. INSTALL GRILLES, REGISTERS & DIFFUSERS LEVEL AND PLUMB.
B. INSTALL GRILLES, REGISTERS & DIFFUSERS AS INDICATED. REFER TO ARCHITECTURAL REFLECTED CEILING PLAN FOR EXACT LOCATION.
C. INSTALL GRILLES, REGISTERS & DIFFUSERS WITH AIRTIGHT CONNECTIONS TO DUCTS AND TO ALLOW SERVICE AND MAINTENANCE OF DAMPERS, EXTRACTORS AND OTHER ACCESSORIES.
D. AFTER INSTALLATION, ADJUST REGISTERS & DIFFUSERS TO AIR PATTERNS (IF NOTED) OR AS DIRECTED BY THE TENANT'S CONSTRUCTION MANAGER PRIOR TO STARTING AIR BALANCING.

(END OF SECTION 23 37 13)

SECTION 23 81 29 - VARIABLE REFRIGERANT FLOW SYSTEMS

PART 1 - GENERAL

- 1. SECTION REQUIREMENTS
A. SUBMITTALS: PROVIDE SHOP DRAWINGS INDICATING THE DIMENSIONS, WEIGHTS, REQUIRED CLEARANCES, COMPONENTS, EFFICIENCIES, CAPACITIES, ELECTRICAL CHARACTERISTICS AND LOCATION AND SIZE OF EACH FIELD CONNECTION FOR EACH INDOOR AND OUTDOOR UNIT.
B. WARRANTY: SUBMIT A WRITTEN WARRANTY, SIGNED BY THE MANUFACTURER AGREEING TO REPAIR OR REPLACE COMPONENTS OF THE SYSTEM FOR A PERIOD OF ONE YEAR. COMPRESSORS SHALL HAVE A WARRANTY OF SEVEN YEARS.

PART 2 - PRODUCTS

- 1. DESCRIPTION
A. A VARIABLE CAPACITY, HEAT PUMP HEAT RECOVERY AIR CONDITIONING SYSTEM CAPABLE OF SIMULTANEOUS HEATING AND COOLING.
B. SYSTEM SHALL CONSIST OF AN OUTDOOR UNIT, BRANCH CIRCUIT CONTROLLER, MULTIPLE INDOOR UNITS AND AN INTEGRAL DIRECT DIGITAL CONTROLS SYSTEM.
C. EACH INDOOR UNIT OR GROUP THEREOF SHALL BE ABLE TO OPERATE IN EITHER COOLING OR HEATING MODE INDEPENDENTLY OF OTHER UNITS/GROUPS AND SHALL BE CAPABLE OF CHANGING MODE WITH NO INTERRUPTION TO SYSTEM FUNCTION.
D. ENERGY COMPLIANCE: COMPLY WITH THE APPLICABLE REQUIREMENTS OF THE ENERGY CODE LISTED ON THE COVER SHEET.
E. ELECTRICAL COMPONENTS, DEVICES AND ACCESSORIES SHALL BE LABELED AND LISTED AS DEFINED IN NFPA 70 BY A QUALIFIED TESTING AGENCY.
2. MANUFACTURERS: AS NOTED IN THE MECHANICAL SCHEDULES. ALTERNATES BY OAKEN OR PANASONIC. THIS CONTRACTOR SHALL BE RESPONSIBLE FOR COORDINATING ALL STRUCTURAL, ELECTRICAL AND OTHER REQUIREMENTS RESULTING FROM THE SUBSTITUTION. ALL CHANGE ORDERS RESULTING IN THE USE OF AN ALTERNATE SHALL BE PAID FOR BY THIS CONTRACTOR.
3. OUTDOOR UNIT CHARACTERISTICS:
A. AN AIR-COOLED, DIRECT EXPANSION MULTI-ZONE UNIT SPECIFICALLY FOR USE WITH VRF COMPONENTS.
B. UNITS SHALL BE EQUIPPED WITH A SINGLE, INVERTER DRIVEN SCROLL TYPE, HERMETIC, MULTI-PHASE COMPRESSOR. THE CAPACITY OF THE COMPRESSOR SHALL BE VARIABLE, WITH A MINIMUM TURNDOWN NOT GREATER THAN 15%.
C. UNIT SHALL BE FACTORY ASSEMBLED, PIPED AND WIRED AND RUN TESTED AT THE FACTORY.
D. OUTDOOR UNITS MAY BE COMPRISED OF MULTIPLE MODULES, CONNECTED VIA A TWINNING KIT INSTALLED IN THE FIELD.
E. ALL LINESETS TO THE INDOOR UNITS SHALL BE INSULATED IN ACCORDANCE WITH THE MANUFACTURER'S INSTALLATION INSTRUCTIONS.
F. THE OUTDOOR UNIT SHALL HAVE AN ACCUMULATOR WITH REFRIGERANT LEVEL SENSORS AND CONTROLS. UNITS SHALL ACTIVELY CONTROL LIQUID LEVEL VIA LINEAR EXPANSION VALVES.
G. THE OUTDOOR UNIT SHALL HAVE A HIGH-EFFICIENCY OIL SEPARATOR.
H. UNIT SHALL DEFROST ALL CIRCUITS SIMULTANEOUSLY DURING LOW-AMBIENT TEMPERATURES (BELOW 23 DEGREES F.), WHILE IN HOT GAS DEFROST, THE SYSTEM SHALL SHUT THE INDOOR UNIT FAN SPEED TO MAINTAIN A HIGH DISCHARGE AIR TEMPERATURE.
I. THE OUTDOOR UNIT SHALL BE FURNISHED WITH A 20 GAUGE HOT DIPPED GALVANIZED SNOW/HAIL GUARD.
J. THE OUTDOOR UNIT SHALL BE FURNISHED WITH A FOUR-LEGGED OUTDOOR MOUNTING SYSTEM FROM THE MANUFACTURER.
K. UNIT CASING SHALL BE GALVANIZED STEEL, BONDZERSED AND FINISHED.
L. OUTDOOR UNIT FAN SHALL BE DIRECT DRIVE WITH A VARIABLE SPEED PROPELLER. FAN SHALL HAVE INHERENT PROTECTION WITH PERMANENTLY LUBRICATED BEARINGS. FANS SHALL BE PROVIDED WITH A RAISED GUARD TO PREVENT CONTACT WITH MOVING PARTS.
M. OUTDOOR OIL SHALL BE A SIZED COIL ELEVATED AT LEAST 12" FROM THE BASE OF THE UNIT. COIL SHALL BE CORRUGATED PLATE FINS ON COPPER TUBING WITH FACTORY-APPLIED CORROSION RESISTANT FINISH. UNCOATED ALUMINUM COIL/FINS ARE NOT ALLOWED.
N. UNIT SHALL HAVE PREWIRED PLUGS FOR OPTIONAL PANEL HEATERS.
O. UNIT POWER SHALL BE AS NOTED IN THE EQUIPMENT SCHEDULES.
P. CONTROL CIRCUITING BETWEEN THE INDOOR UNITS, BRANCH CIRCUIT CONTROLLER AND THE OUTDOOR UNIT SHALL BE 24V DC COMPLETED USING 2-CONDUCTOR, TWISTED PAIR SHIELDED CABLE.
4. REFRIGERANT AND REFRIGERANT PIPING
A. R410A REFRIGERANT SHALL BE REQUIRED FOR SYSTEMS.
B. POLYESTER (POE) OIL SHALL BE REQUIRED FOR SYSTEMS.
C. REFRIGERANT PIPING SHALL BE PHOSPHORUS DEOXYDIZED COPPER WITH A THICKNESS AS DEFINED BY THE MANUFACTURER'S RECOMMENDATIONS.
D. ALL PIPING SHALL BE INSULATED WITH 1/2" CLOSED-CELL INSULATION WITH A FLAME SPREAD INDEX OF LESS THAN 25, AND A SMOKE DEVELOPMENT INDEX OF LESS THAN 50.
E. ALL REFRIGERANT PIPING CONNECTIONS SHALL BE BRAZED.
5. BRANCH CIRCUIT (BC) CONTROLLERS
A. BC CONTROLLERS SHALL INCLUDE MULTIPLE BRANCHES TO ALLOW SIMULTANEOUS HEATING AND COOLING.
B. BC CONTROLLERS SHALL BE EQUIPPED WITH A CIRCUIT BOARD THAT INTERFACES TO THE CONTROLS SYSTEM AND SHALL PERFORM ALL FUNCTIONS NECESSARY FOR OPERATION.
C. THE UNIT CASING SHALL BE FABRICATED OF GALVANIZED STEEL.
D. EACH CABINET SHALL HOUSE A LIQUID GAS SEPARATOR AND MULTIPLE REFRIGERATION CONTROL VALVES AND TWO TUBE-IN-TUBE HEAT EXCHANGERS.
E. REFRIGERANT SERVICE SHUT OFF VALVES SHALL BE FIELD-PROVIDED FOR EACH BRANCH TO ALLOW SERVICE TO INDOOR UNITS WITHOUT OPERATION TO OVERALL SYSTEM.
F. BC CONTROLLERS SHALL HAVE INTEGRAL RESIN DRAIN PAN.
G. UNIT POWER SHALL BE AS NOTED IN THE EQUIPMENT SCHEDULES.
H. CONTROL CIRCUITING BETWEEN THE INDOOR UNITS, BRANCH CIRCUIT CONTROLLER AND THE OUTDOOR UNIT SHALL BE 24V DC COMPLETED USING 2-CONDUCTOR, TWISTED PAIR SHIELDED CABLE.
6. HIGH-STATIC, CEILING CONCEALED, DUCTED INDOOR UNITS
A. FACTORY ASSEMBLED, WIRED AND RUN TESTED, CONTAINING FACTORY WIRING, PIPING, ELECTRONIC MODULATING LINEAR EXPANSION DEVICE, CONTROL CIRCUIT BOARD AND MOTOR.
B. UNIT CABINET SHALL BE CEILING CONCEALED, DUCTED WITH A FIXED REAR RETURN.
C. FAN SHALL BE DYNAMICALLY BALANCED, DIRECT DRIVEN BY A SINGLE MOTOR WITH PERMANENTLY LUBRICATED BEARINGS.
D. FILTER BOX SHALL BE FURNISHED WITH ALL UNITS.
E. COIL SHALL BE CONSTRUCTED OF SMOOTH PLATE FINS ON COPPER TUBING WITH INNER GROOVES.
F. UNIT POWER SHALL BE AS NOTED IN THE EQUIPMENT SCHEDULES.
G. CONTROL CIRCUITING BETWEEN THE INDOOR UNITS, BRANCH CIRCUIT CONTROLLER AND THE OUTDOOR UNIT SHALL BE 24V DC COMPLETED USING 2-CONDUCTOR, TWISTED PAIR SHIELDED CABLE.

PART 3 - EXECUTION

- 1. INSTALLATION
A. OUTDOOR UNITS: INSTALL OUTDOOR UNITS ON MANUFACTURER'S FURNISHED STANDS.
B. INDOOR UNITS: INSTALL UNITS LEVEL FROM STRUCTURE, ON NEOPRENE TYPE VIBRATION ISOLATORS AS NOTED ON THE STRUCTURAL DRAWINGS.
2. CONNECTIONS
A. COMPLY WITH DUCT INSTALLATION REQUIREMENTS SPECIFIED IN OTHER HVAC SECTIONS. DRAWINGS INDICATE GENERAL ARRANGEMENTS OF DUCTS.
B. CONNECT SUPPLY AND RETURN AIR DUCTS WITH FLEXIBLE DUCT CONNECTORS AS NOTED IN SECTION 23 34 03.
C. INSTALL CONDENSATE DRAIN WITH TRAP AND INDIRECT CONNECTION AS NOTED ON THE PLANS AND PER THE MANUFACTURER'S INSTALLATION INSTRUCTIONS.
D. CONNECT REFRIGERANT PIPING PER THE MANUFACTURER'S INSTALLATION INSTRUCTIONS.
E. INSTALL PIPING AND DUCTWORK ADJACENT TO EQUIPMENT TO ALLOW SPACE FOR SERVICE AND MAINTENANCE.
F. CONNECT CONTROLS WIRING TO THE THERMOSTAT, TEMPERATURE SENSOR AND UNIT AS DESCRIBED IN THE MANUFACTURER'S INSTALLATION INSTRUCTIONS.
G. CONNECT ELECTRICAL WIRING IN ACCORDANCE WITH THE ELECTRICAL SPECIFICATIONS.
3. FIELD QUALITY CONTROL
A. AFTER INSTALLING ALL EQUIPMENT, TEST UNITS FOR COMPLIANCE WITH REQUIREMENTS.
B. INSPECT AND REMOVE SHIPPING BOLTS, BLOCKS AND TIE-DOWN STRAPS.
C. CONFIRM PROPER MOTOR ROTATION AND UNIT OPERATIONS.
D. TEST AND ADJUST CONTROLS AND SAFETIES. REPLACE DAMAGED AND MALFUNCTIONING CONTROLS AND EQUIPMENT.
E. OPERATIONAL TEST: AFTER ELECTRICAL CIRCUITRY HAS BEEN ENERGIZED, START UNITS TO CONFIRM PROPER MOTOR ROTATION AND UNIT OPERATION.
F. CLEAN FILTER HOUSINGS AND CHANGE FILTERS PRIOR TO AIR BALANCE AND IMMEDIATELY PRIOR TO TURNOVER.

(END OF SECTION 23 81 29)




sweetgreen

3101 W. EXPOSITION BLVD.
LOS ANGELES, CALIFORNIA 90018

THESE DRAWINGS & SPECIFICATIONS ARE CONFIDENTIAL AND SHALL REMAIN THE SOLE PROPERTY OF SWEETGREEN CORPORATION. THEY SHALL NOT BE REPRODUCED (IN WHOLE OR IN PART), SHARED WITH THIRD PARTIES OR USED IN ANY MANNER ON OTHER PROJECTS OR EXTENSIONS TO THIS PROJECT WITHOUT THE PRIOR WRITTEN CONSENT OF SWEETGREEN CORPORATION. THESE DRAWINGS & SPECIFICATIONS ARE INTENDED TO EXPRESS DESIGN INTENT FOR A PROTOTYPICAL SWEETGREEN STORE WHICH IS SUBJECT TO CHANGE AT ANY TIME AND MAY NOT REFLECT ACTUAL SITE CONDITIONS. NEITHER PARTY SHALL HAVE ANY OBLIGATION NOR LIABILITY TO THE OTHER EXCEPT AS STATED ABOVE UNTIL A WRITTEN AGREEMENT IS FULLY EXECUTED.

ENGINEER OF RECORD:

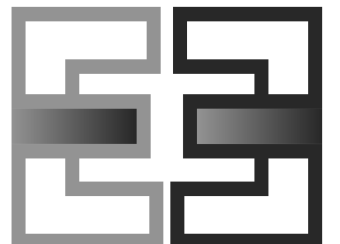

EVERJ ENGINEERING, INC.
1509 BUCK TRAIL LANE
WORTHINGTON, OH 43085
240-319-0822
www.everjengineering.com
TX ENGINEERING FIRM F-22980

STAMP:

NOT FOR CONSTRUCTION

05/05/2022

PROJECT INFORMATION:
MUELLER

PROJECT INFORMATION:
1900 ALDRICH ST.
SUITE 140
AUSTIN, TX 78723

DRAWN BY: JAE
CHECKED BY: MK
PROJECT MANAGER: JAE
SG DESIGN MANAGER: LG
SG CONSTR. MANAGER: KZ
PROJECT NO: 210005
TEMPLATE VERSION: 12/21/2021

REVISIONS
REV. DATE DESCRIPTION
1 05/05/2022 LANDLORD COMMENTS

MECHANICAL SPECIFICATIONS

M-011




sweetgreen

3101 W. EXPOSITION BLVD.  
LOS ANGELES, CALIFORNIA 90018

THESE DRAWINGS & SPECIFICATIONS ARE CONFIDENTIAL AND SHALL REMAIN THE SOLE PROPERTY OF SWEETGREEN CORPORATION. THEY SHALL NOT BE REPRODUCED OR COPIED IN ANY MANNER OR FOR ANY PURPOSES WITHOUT THE WRITTEN CONSENT OF SWEETGREEN CORPORATION. THESE DRAWINGS & SPECIFICATIONS ARE INTENDED TO EXPRESS DESIGN INTENT FOR A PROTOTYPICAL SWEETGREEN STORE WHICH IS SUBJECT TO CHANGE AT ANY TIME AND MAY NOT REFLECT ACTUAL SITE CONDITIONS. NEITHER PARTY SHALL HAVE ANY OBLIGATION OR LIABILITY TO THE OTHER EXCEPT AS STATED ABOVE UNTIL A WRITTEN AGREEMENT IS FULLY EXECUTED.

ENGINEER OF RECORD:

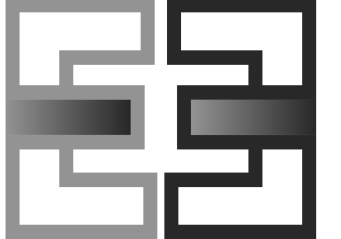

EVERJ ENGINEERING, INC.  
1509 BUCK TRAIL LANE  
WORTHINGTON, OH 43085  
240-319-0822  
www.everjengineering.com  
TX ENGINEERING FIRM F-22980

STAMP:

NOT FOR  
CONSTRUCTION

05/05/2022

PROJECT INFORMATION:

MUELLER

PROJECT INFORMATION:  
1900 ALDRICH ST.  
SUITE 140  
AUSTIN, TX 78723

DRAWN BY:

JAE

CHECKED BY:

MK

PROJECT MANAGER:

JAE

SG DESIGN MANAGER:

LG

SG CONSTR. MANAGER:

KZ

PROJECT NO:

210005

TEMPLATE VERSION: 12/21/2021

REVISIONS

REV. DATE DESCRIPTION

HVAC PLAN

M-100

### CODED NOTES

- 1 INSTALL EQUIPMENT PER MANUFACTURER'S INSTALLATION INSTRUCTION AND PER THE STRUCTURAL DETAILS.
- 2 COORDINATE MOUNTING LOCATION FOR WALK-IN COOLER CONDENSING UNIT, CU-1 ON TOP OF THE WALK-IN COOLER WITH THE KITCHEN EQUIPMENT SUPPLIER PRIOR TO ROUGH-IN. ENSURE ALL CLEARANCE REQUIREMENTS FOR THE UNIT ARE MAINTAINED THROUGH CONSTRUCTION. KITCHEN EQUIPMENT SUPPLIER SHALL PROVIDE LINESET, SPECIAL TIES AND MAKE ALL FINAL CONNECTIONS BETWEEN THE CONDENSING UNIT AND EVAPORATOR COIL.
- 3 PROVIDE SUPPLY DIFFUSER CONNECTION PER DETAIL 1/SHEET M-400.
- 4 REFER TO THE ARCHITECTURAL RCP FOR CEILING MOUNTED EQUIPMENT LOCATION. TYPICAL.
- 5 PROVIDE AUDIO/VISUAL REMOTE SMOKE DETECTOR ANNUNCIATOR WITH REMOTE KEY OPERATED RESET. WIRE A UNIT BACK TO EACH SMOKE DETECTOR. MOUNT UNIT 60" AFF. TYPICAL.
- 6 INSTALL THE OWNER-FURNISHED MAIN CONTROLLER FOR THE HVAC EQUIPMENT NOTED AT THIS LOCATION AT 48" AFF. COORDINATE WITH ELECTRICAL SWITCHING IN THE AREA AND EXTEND CONTROLS WIRING AS NOTED IN THE TRADE SHOP DRAWINGS. COORDINATE CONTROLLER LOCATION WITH WALL-MOUNTED EQUIPMENT SO THAT THE THERMOSTATS ARE NOT BLOCKED BY SHELVING, COAT RACKS OR DOORS.
- 7 INSTALL THE TEMPERATURE SENSOR FOR THE HVAC EQUIPMENT NOTED AT THIS LOCATION AT 5'-0" AFF. COORDINATION LOCATION WITH EQUIPMENT AND WALL-MOUNTED FIXTURES AS REQUIRED SUCH THAT THE SENSOR IS NOT BLOCKED.
- 8 REFER TO DETAIL 2/SHEET M-400 FOR AIR HANDLER INSTALLATION DETAILS.
- 9 THE GENERAL CONTRACTOR SHALL FURNISH A REME HALO AIR PURIFICATION SYSTEM AND REQUIRED TRANSFORMER, PURCHASED THROUGH SWEETGREEN'S VENDOR (NATIONAL TAB) AND INSTALL SYSTEM IN THE SUPPLY AIR DUCTWORK AND PER THE MANUFACTURER'S INSTALLATION INSTRUCTIONS. ADJUST AS REQUIRED FOR THE SUPPLY AIRFLOW.
- 10 PROVIDE TWO-POSITION DAMPER IN THE DUCTWORK AS SHOWN. REFER TO THE SEQUENCE OF OPERATIONS FOR MORE INFORMATION.
- 11 THE GENERAL CONTRACTOR SHALL PROVIDE A DUCT-MOUNTED SMOKE DETECTOR IN THE RETURN AIR STREAM. UPON DETECTION OF SMOKE, THE SUPPLY AIR FAN SHALL DE-ENERGIZE. COORDINATE ALL REQUIREMENTS WITH THE LANDLORD AND ALARM PROVIDER.
- 12 MAINTAIN MANUFACTURER'S RECOMMENDED CLEARANCE ZONES. NO DUCTWORK, PIPING, CONDUIT OR OTHER SYSTEMS SHALL BE PERMITTED IN THIS AREA. COORDINATE WITH SITE CONDITIONS AND WORK OF OTHER TRADES AS REQUIRED. TYPICAL.
- 13 INSTALL THE OWNER-FURNISHED REFRIGERANT PIPING BETWEEN THE BRANCH CONTROLLER AND THE AIR HANDLING UNITS PER THE MANUFACTURER'S SHOP DRAWINGS. COORDINATE LINESET PATHWAY WITH THE LANDLORD AND SITE CONDITIONS AS REQUIRED. COORDINATE LINESET LENGTH AND QUANTITIES REQUIRED WITH THE OWNER'S NATIONAL ACCOUNT REPRESENTATIVE PRIOR TO EQUIPMENT SHIPPING.
- 14 APPROXIMATE LOCATION OF CHASE TO ROOF. PROVIDE SUPPORTS WITHIN THE CHASE AS REQUIRED FOR REFRIGERANT PIPING.
- 15 INSTALL THE OWNER-FURNISHED REFRIGERANT PIPING BETWEEN THE BRANCH CONTROLLER AND THE AIR HANDLING UNITS PER THE MANUFACTURER'S SHOP DRAWINGS. COORDINATE LINESET LENGTH AND QUANTITIES REQUIRED WITH THE OWNER'S NATIONAL ACCOUNT REPRESENTATIVE PRIOR TO EQUIPMENT SHIPPING.
- 16 INSTALL THE OWNER-FURNISHED FILTER BOX FOR THE AIR HANDLING UNIT PER THE MANUFACTURER'S INSTALLATION INSTRUCTIONS.
- 17 PROVIDE DUCTED TRANSFER GRILLE IN LOCATION AS SHOWN.
- 18 INSTALL THE KES FURNISHED TYPE II HOOD, HD-2 IN LOCATION SHOWN. SUPPORT PER THE MANUFACTURER'S INSTALLATION INSTRUCTIONS. INSTALL HOOD ACCORDING TO THE REQUIREMENTS OF IT'S LISTING, THE BUILDING CODE, ALL NFPA REQUIREMENTS AND THE LOCAL AUTHORITY HAVING JURISDICTIONS REQUIREMENTS.


### SYMBOLS & ABBREVIATIONS

#### HVAC SYMBOLS

	MITERED CORNER WITH TURNING VANES		SUPPLY REGISTER
	DUCTWORK INTERNAL FREE DIMENSIONS (WIDTH/HEIGHT)		RETURN REGISTER
	RECTANGULAR TO ROUND DUCT TRANSITION		FLEXIBLE DUCT
	DUCT-MOUNTED SMOKE DETECTOR		THERMOSTAT
	MOTOR-OPERATED DAMPER		REMOTE TEMPERATURE SENSOR
	MANUAL VOLUME DAMPER		PLAN NOTE: SEE PLAN NOTES LISTED ON THE SAME SHEET FOR NOTE MEANING
	GREASE DUCT CLEANOUT		CONNECT TO EXISTING
	MITERED CORNER WITHOUT TURNING VANES		EQUIPMENT TAG: SEE EQUIPMENT SCHEDULE ON SHEET M-300 FOR EQUIPMENT INFORMATION
	CEILING DIFFUSER		AUDIO/VISUAL REMOTE SMOKE DETECTOR ANNUNCIATOR WITH REMOTE KEY OPERATED RESET
	CEILING-MOUNTED RETURN OR EXHAUST REGISTER		TAG NECK SIZE AIRFLOW [CFM]

#### HVAC ABBREVIATIONS

(E)	EXISTING
(R)	RELOCATED
AFF	ABOVE FINISHED FLOOR
AFG	ABOVE FINISHED GRADE
AHU	AIR HANDLING UNIT
BC	BLOWER COIL
CD	CEILING DIFFUSER
CU	CONDENSING UNIT
EF	EXHAUST FAN
ER	EXHAUST REGISTER
EXTG	EXISTING
GC	GENERAL CONTRACTOR
HES	TENANT'S HVAC EQUIPMENT SUPPLIER
KES	TENANT'S KITCHEN EQUIPMENT SUPPLIER
OBD	BLADE DAMPER
PL	PLENUM
RG	RETURN GRILLE
RTU	ROOFTOP UNIT
SD	SLOT DIFFUSER
SR	SUPPLY REGISTER
VSC	VARIABLE SPEED CONTROL
WSHP	WATER SOURCE HEAT PUMP

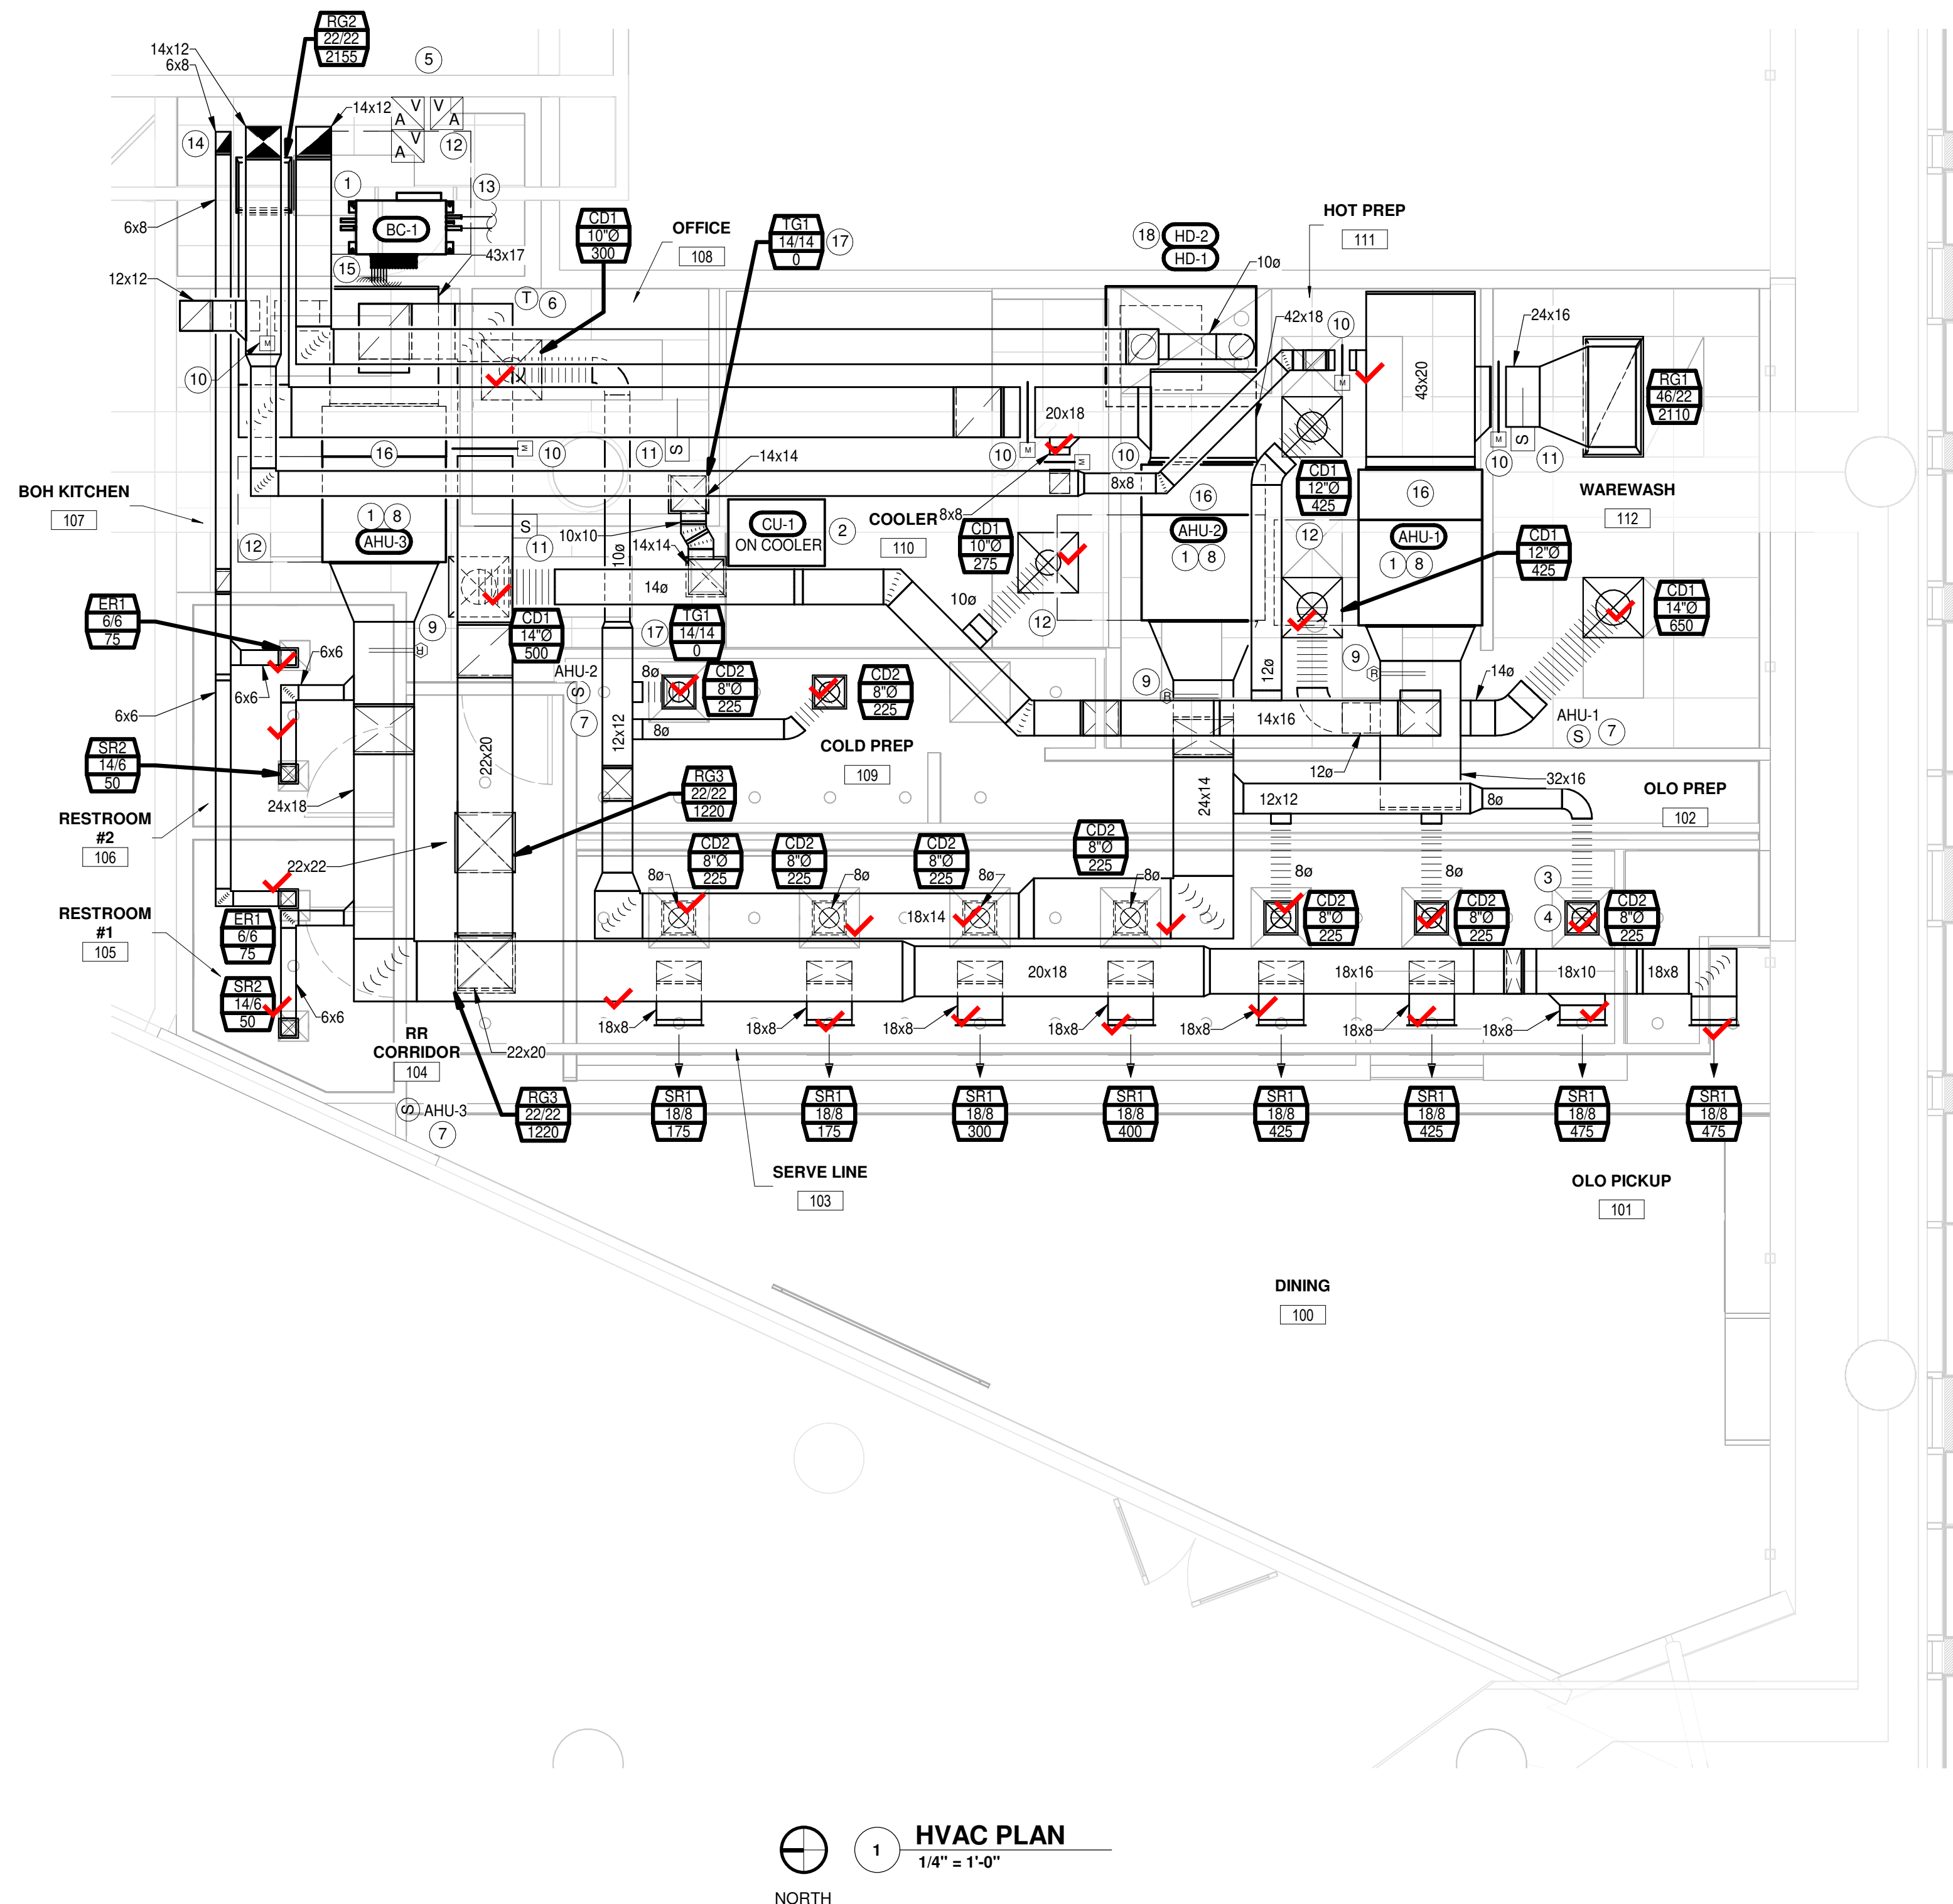

1 HVAC PLAN  
1/4" = 1'-0"  
NORTH




sweetgreen

3101 W. EXPOSITION BLVD.  
LOS ANGELES, CALIFORNIA 90018

THESE DRAWINGS & SPECIFICATIONS ARE CONFIDENTIAL AND SHALL REMAIN THE SOLE PROPERTY OF SWEETGREEN CORPORATION. THEY SHALL NOT BE REPRODUCED (IN WHOLE OR IN PART), SHARED WITH THIRD PARTIES OR USED IN ANY MANNER ON OTHER PROJECTS OR EXTENSIONS TO THIS PROJECT WITHOUT THE PRIOR WRITTEN CONSENT OF SWEETGREEN CORPORATION. THESE DRAWINGS & SPECIFICATIONS ARE INTENDED TO EXPRESS DESIGN INTENT FOR A PROTOTYPICAL SWEETGREEN STORE WHICH IS SUBJECT TO CHANGE AT ANY TIME AND MAY NOT REFLECT ACTUAL SITE CONDITIONS. NEITHER PARTY SHALL HAVE ANY OBLIGATION OR LIABILITY TO THE OTHER (EXCEPT AS STATED ABOVE) UNTIL A WRITTEN AGREEMENT IS FULLY EXECUTED.

ENGINEER OF RECORD:

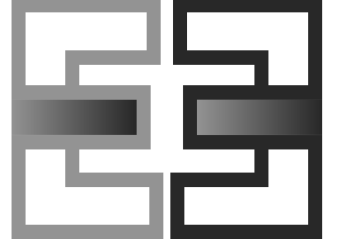

EVERJ ENGINEERING, INC.  
1509 BUCK TRAIL LANE  
WORTHINGTON, OH 43085  
240-319-0822  
www.everjengineering.com  
TX ENGINEERING FIRM F-22980

STAMP:

NOT FOR  
CONSTRUCTION

05/05/2022

PROJECT INFORMATION:  
MUELLER

PROJECT INFORMATION:  
1900 ALDRICH ST.  
SUITE 140  
AUSTIN, TX 78723

DRAWN BY: JAE  
CHECKED BY: MK  
PROJECT MANAGER: JAE  
SG DESIGN MANAGER: LG  
SG CONSTR. MANAGER: KZ  
PROJECT NO: 210005  
TEMPLATE VERSION: 12/21/2021

REVISIONS  
REV. DATE DESCRIPTION  
1 05/05/2022 LANDLORD COMMENTS

HVAC ROOF PLAN

M-101


### CODED NOTES

- 1 INSTALL EQUIPMENT MOUNTED ON OWNER-FURNISHED STANDS PER MANUFACTURER'S INSTALLATION INSTRUCTIONS.
- 2 INSTALL THE OWNER-FURNISHED TWINNING KIT PER THE MANUFACTURER'S INSTALLATION INSTRUCTIONS.
- 3 INSTALL THE OWNER-FURNISHED REFRIGERANT PIPING BETWEEN THE ROOF-MOUNTED CONDENSING UNIT AND THE BRANCH CONTROLLER PER THE MANUFACTURER'S SHOP DRAWINGS. REFER TO SHEET M-100 FOR MORE INFORMATION. COORDINATE LINESET PATHWAY WITH THE LANDLORD AND EXISTING CONDITIONS AS REQUIRED. COORDINATE LINESET LENGTH AND QUANTITIES REQUIRED WITH THE OWNER'S NATIONAL ACCOUNT REPRESENTATIVE PRIOR TO EQUIPMENT SHIPPING.
- 4 APPROXIMATE LOCATION OF CHASE TO ROOF. PROVIDE SUPPORTS WITHIN THE CHASE AS REQUIRED FOR REFRIGERANT PIPING.
- 5 INSTALL THE EXHAUST FAN, ELEVATED ABOVE THE ROOF LEVEL TO ALLOW FOR A BOTTOM CONNECTION OF THE DUCTWORK AS NOTED. REFER TO THE STRUCTURAL DRAWINGS FOR MORE INFORMATION.
- 6 INSTALL THE UTILITY-SET EXHAUST FAN ON THE ROOF PER THE STRUCTURAL DRAWINGS AND PER THE MANUFACTURER'S INSTALLATION INSTRUCTIONS.
- 7 TERMINATE VENTILATION AIR DUCTWORK WITH GOOSENECK. PROVIDE BACKDRAFT DAMPER AND BIRDSCREEN.
- 8 EXISTING MECHANICAL EQUIPMENT ON THE ROOF TO REMAIN TYPICAL.
- 9 EXHAUST DISCHARGE SHALL BE NO LESS THAN 10'-0" FROM ALL MECHANICAL FRESH AIR INTAKES AND OPERABLE OPENINGS INTO THE BUILDING.

### SYMBOLS & ABBREVIATIONS

#### HVAC ABBREVIATIONS

(E)	EXISTING
(R)	RELOCATED
AFF	ABOVE FINISHED FLOOR
AFG	ABOVE FINISHED GRADE
AHU	AIR HANDLING UNIT
BC	BLOWER COIL
CD	CEILING DIFFUSER
CU	CONDENSING UNIT
EF	EXHAUST FAN
ER	EXHAUST REGISTER
EXTG	EXISTING
GC	GENERAL CONTRACTOR
HES	TENANT'S HVAC EQUIPMENT SUPPLIER
KES	TENANT'S KITCHEN EQUIPMENT SUPPLIER
OBD	BLADE DAMPER
PL	PLENUM
RG	RETURN GRILLE
RTU	ROOFTOP UNIT
SD	SLOT DIFFUSER
SR	SUPPLY REGISTER
VSC	VARIABLE SPEED CONTROL
WSHP	WATER SOURCE HEAT PUMP

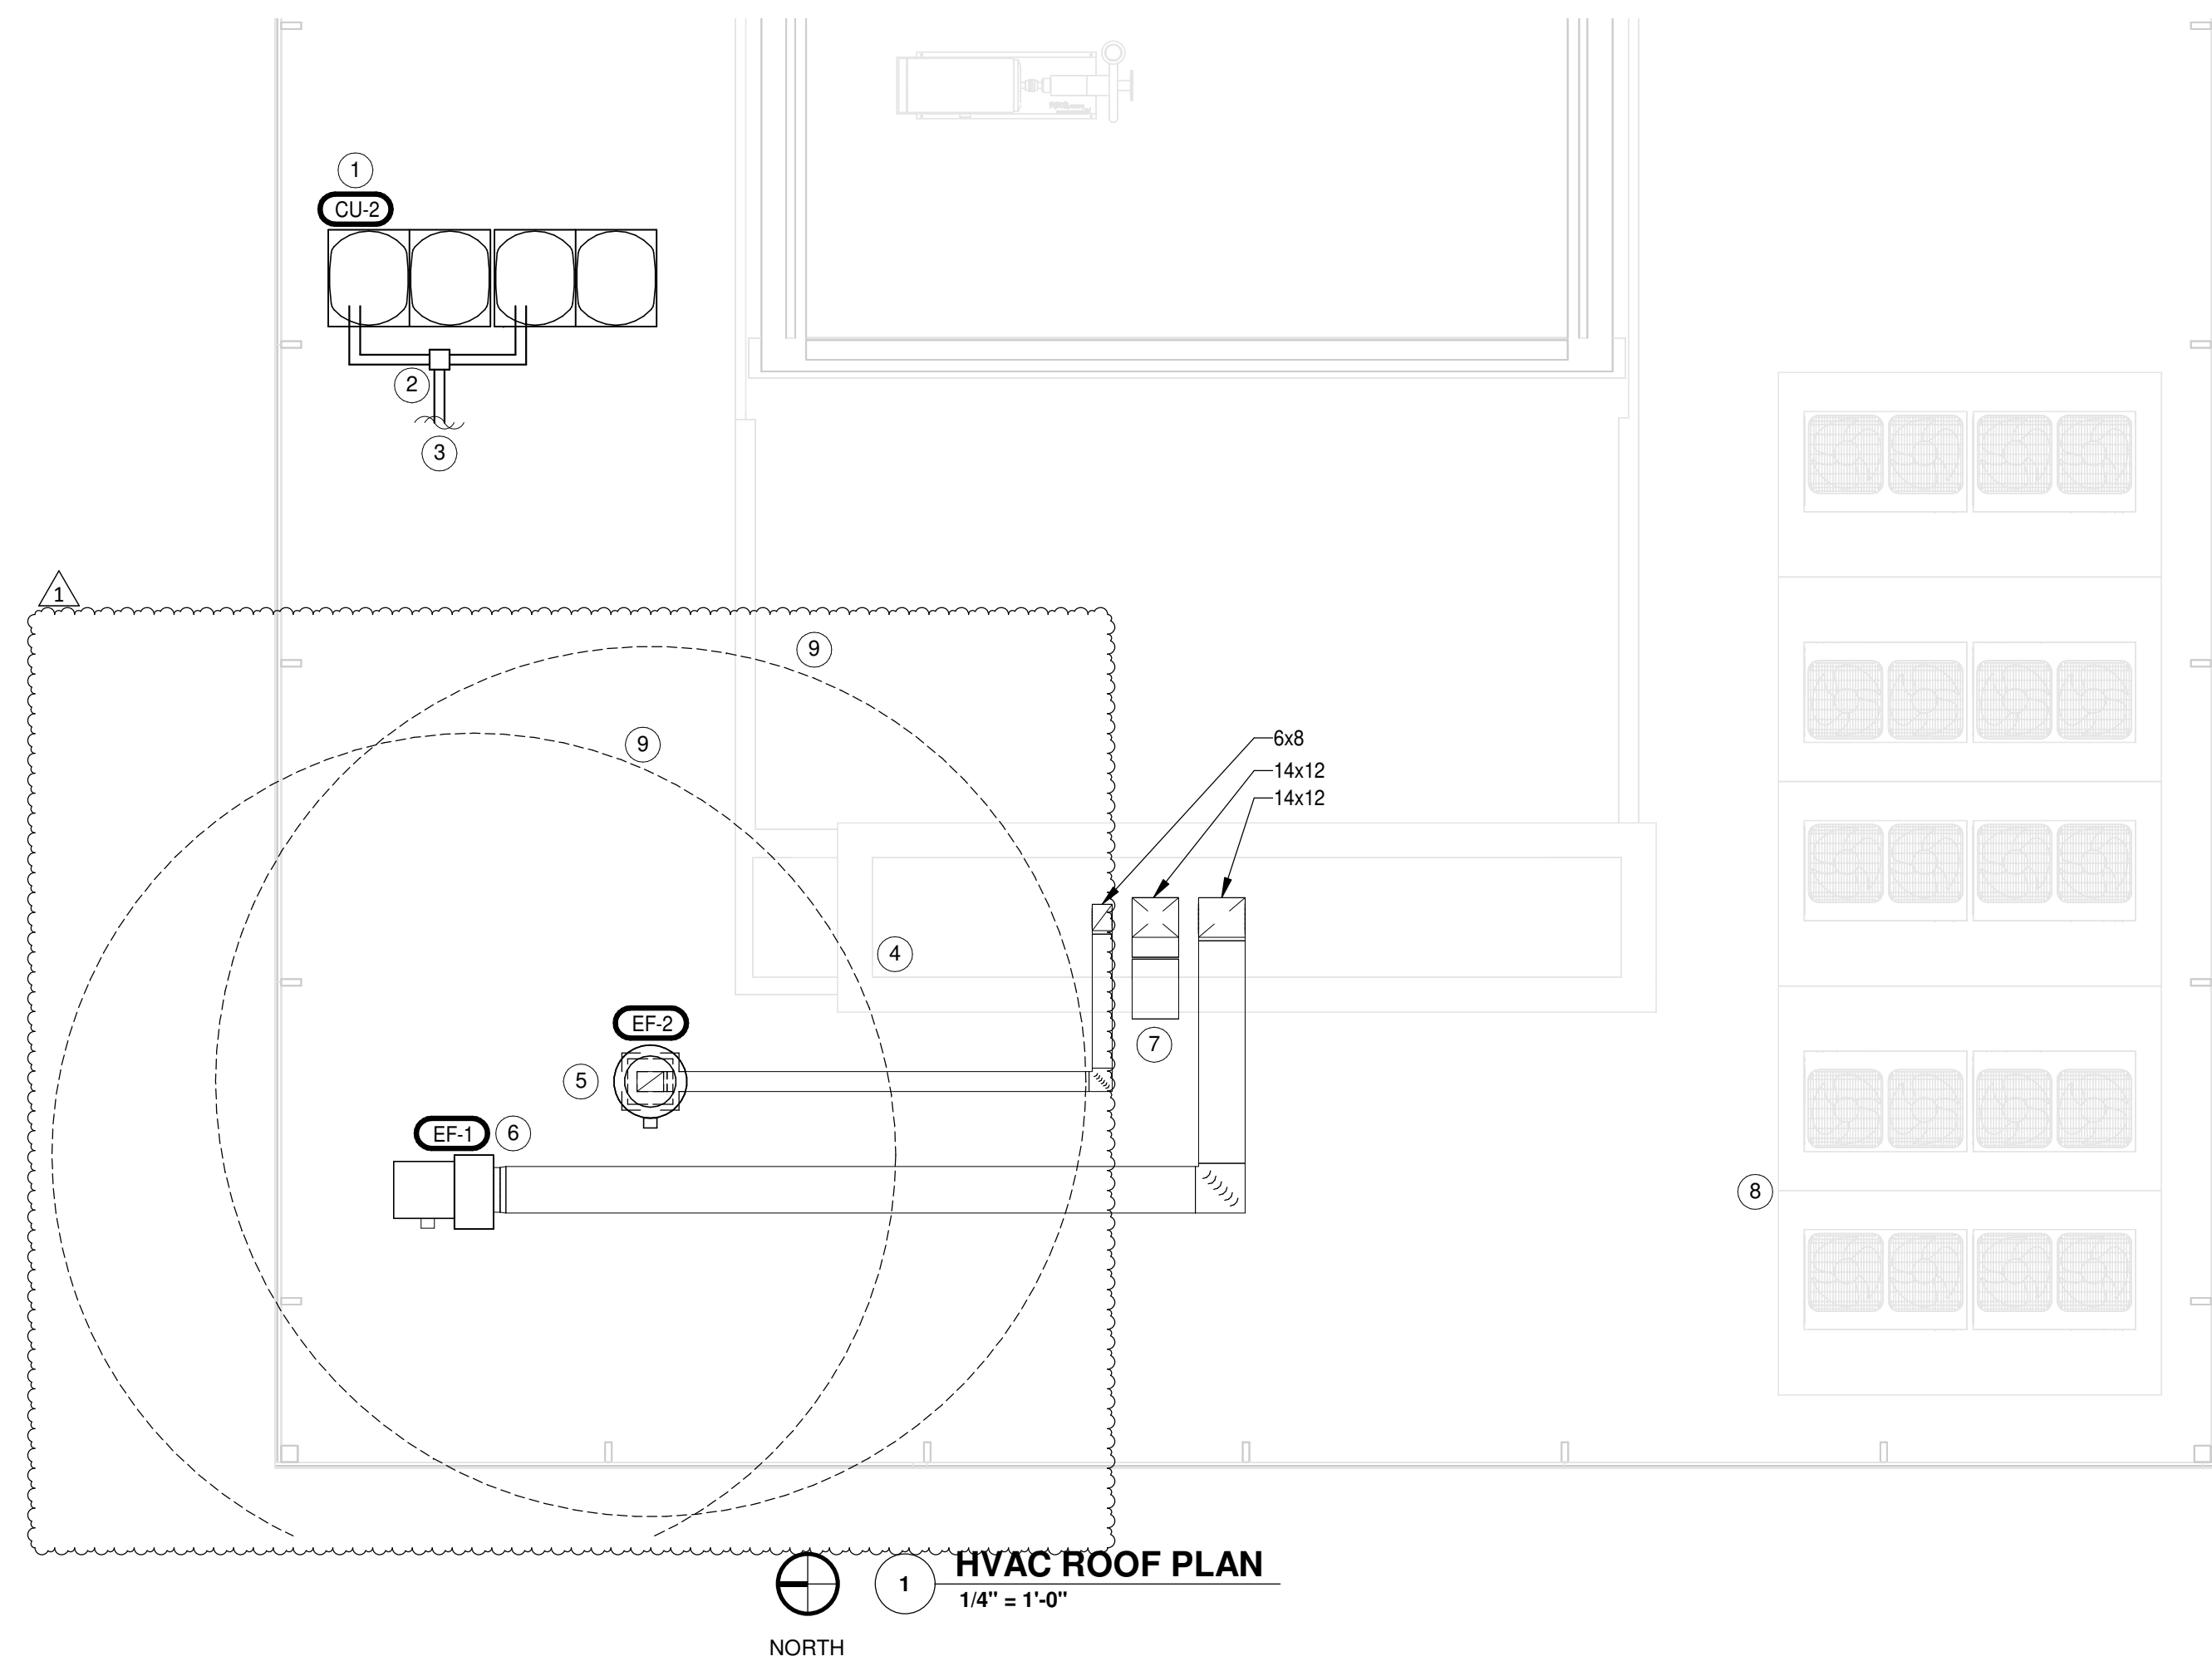




sweetgreen

3101 W. EXPOSITION BLVD.  
LOS ANGELES, CALIFORNIA 90018

THESE DRAWINGS & SPECIFICATIONS ARE CONFIDENTIAL AND SHALL REMAIN THE SOLE PROPERTY OF SWEETGREEN CORPORATION. THEY SHALL NOT BE REPRODUCED (IN WHOLE OR IN PART), SHARED WITH THIRD PARTIES OR USED IN ANY MANNER ON OTHER PROJECTS OR EXTENSIONS TO THIS PROJECT WITHOUT THE PRIOR WRITTEN CONSENT OF SWEETGREEN CORPORATION. THESE DRAWINGS & SPECIFICATIONS ARE INTENDED TO EXPRESS DESIGN INTENT FOR A PROTOTYPICAL SWEETGREEN STORE WHICH IS SUBJECT TO CHANGE AT ANY TIME AND MAY NOT REFLECT ACTUAL SITE CONDITIONS. NEITHER PARTY SHALL HAVE ANY OBLIGATION OR LIABILITY TO THE OTHER EXCEPT AS STATED ABOVE UNTIL A WRITTEN AGREEMENT IS FULLY EXECUTED.

ENGINEER OF RECORD:

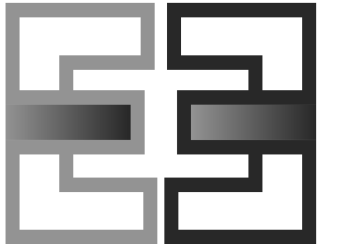

EVERJ ENGINEERING, INC.  
1509 BUCK TRAIL LANE  
WORTHINGTON, OH 43085  
240-319-0822  
www.everjengineering.com  
TX ENGINEERING FIRM F-22980

STAMP:

NOT FOR  
CONSTRUCTION

05/05/2022

PROJECT INFORMATION:  
**MUELLER**

PROJECT INFORMATION:  
**1900 ALDRICH ST.  
SUITE 140  
AUSTIN, TX 78723**

DRAWN BY: JAE  
CHECKED BY: MK  
PROJECT MANAGER: JAE  
SG DESIGN MANAGER: LG  
SG CONSTR. MANAGER: KZ  
PROJECT NO: 210005  
TEMPLATE VERSION: 12/21/2021

REVISIONS  
REV. DATE DESCRIPTION

HVAC PIPING PLAN

M-200

### CODED NOTES

- 1 PROVIDE CONDENSATE DRAIN FROM THE AIR-HANDLING UNIT AS SHOWN, PER DETAIL 2/SHEET M-400 AND PER THE MANUFACTURER'S INSTALLATION INSTRUCTIONS. PROVIDE INDIRECT DRAIN PER DETAIL 9/SHEET P-400. ALL DRAIN PIPING SHALL BE CONCEALED ABOVE CEILINGS AND WITHIN FRAMED WALLS UNLESS OTHERWISE NOTED.
- 2 REFER TO SANITARY WASTE AND VENT PLAN FOR WALK-IN COOLER CONDENSATE DRAIN ROUTING.
- 3 THE GENERAL CONTRACTOR SHALL INSTALL THE CONDENSATE PUMP (BLUE DIAMOND MAXIBLUE), FURNISHED BY SWEETGREEN'S TRANE NATIONAL ACCOUNTS REPRESENTATIVE. CONTRACTOR SHALL PROVIDE PIPING UP TO A HEIGHT SUFFICIENT ENOUGH TO DRAIN THE CONDENSATE VIA GRAVITY AND PROVIDE PIPING TO THE EXISTING CONDENSATE DRAIN LINE. ALL DRAIN PIPING SHALL BE ABOVE FINISHED CEILINGS UNLESS NOTED OTHERWISE. COORDINATE WITH FIELD CONDITIONS AS REQUIRED.
- 4 CONNECT TO THE EXISTING 3" CONDENSATE LINE ROUTED THROUGH THE SPACE. FIELD-VERIFY EXACT LOCATION PRIOR TO ROUGH-IN.


### SYMBOLS & ABBREVIATIONS

#### HVAC PIPING SYMBOLS

- ELBOW UP
- ELBOW DOWN
- CONDENSER WATER SUPPLY
- CONDENSER WATER RETURN
- CHILLED WATER SUPPLY
- CHILLED WATER RETURN
- HOT WATER SUPPLY
- HOT WATER RETURN
- CONDENSATE DRAIN
- PLAN NOTE: SEE KEYNOTES LISTED ON THE SAME SHEET FOR NOTE MEANING
- CONNECT TO EXISTING
- REDUCED PRESSURE ZONE BACKFLOW PREVENTER
- EQUIPMENT TAG: SEE EQUIPMENT SCHEDULE ON SHEET M-300 FOR EQUIPMENT INFORMATION
- VALVE
- SOLENOID-OPERATED VALVE
- CHECK VALVE
- CIRCUIT-SETTER BALANCE VALVE RATED FOR POTABLE WATER
- BTU METER

#### HVAC PIPING ABBREVIATIONS

- AFF ABOVE FINISHED FLOOR
- AFG ABOVE FINISHED GRADE
- AHU AIR HANDLING UNIT
- BC BLOWER COIL
- CD CONDENSATE DRAIN
- CHWR CHILLED WATER RETURN
- CHWS CHILLED WATER SUPPLY
- CWR CONDENSER WATER RETURN
- CWS CONDENSER WATER SUPPLY
- EXT'G EXISTING
- GC GENERAL CONTRACTOR
- HES TENANT'S HVAC EQUIPMENT SUPPLIER
- HWR HOT WATER RETURN
- HWS HOT WATER SUPPLY
- KES TENANT'S KITCHEN EQUIPMENT SUPPLIER
- RTU ROOFTOP UNIT
- WSHP WATER SOURCE HEAT PUMP

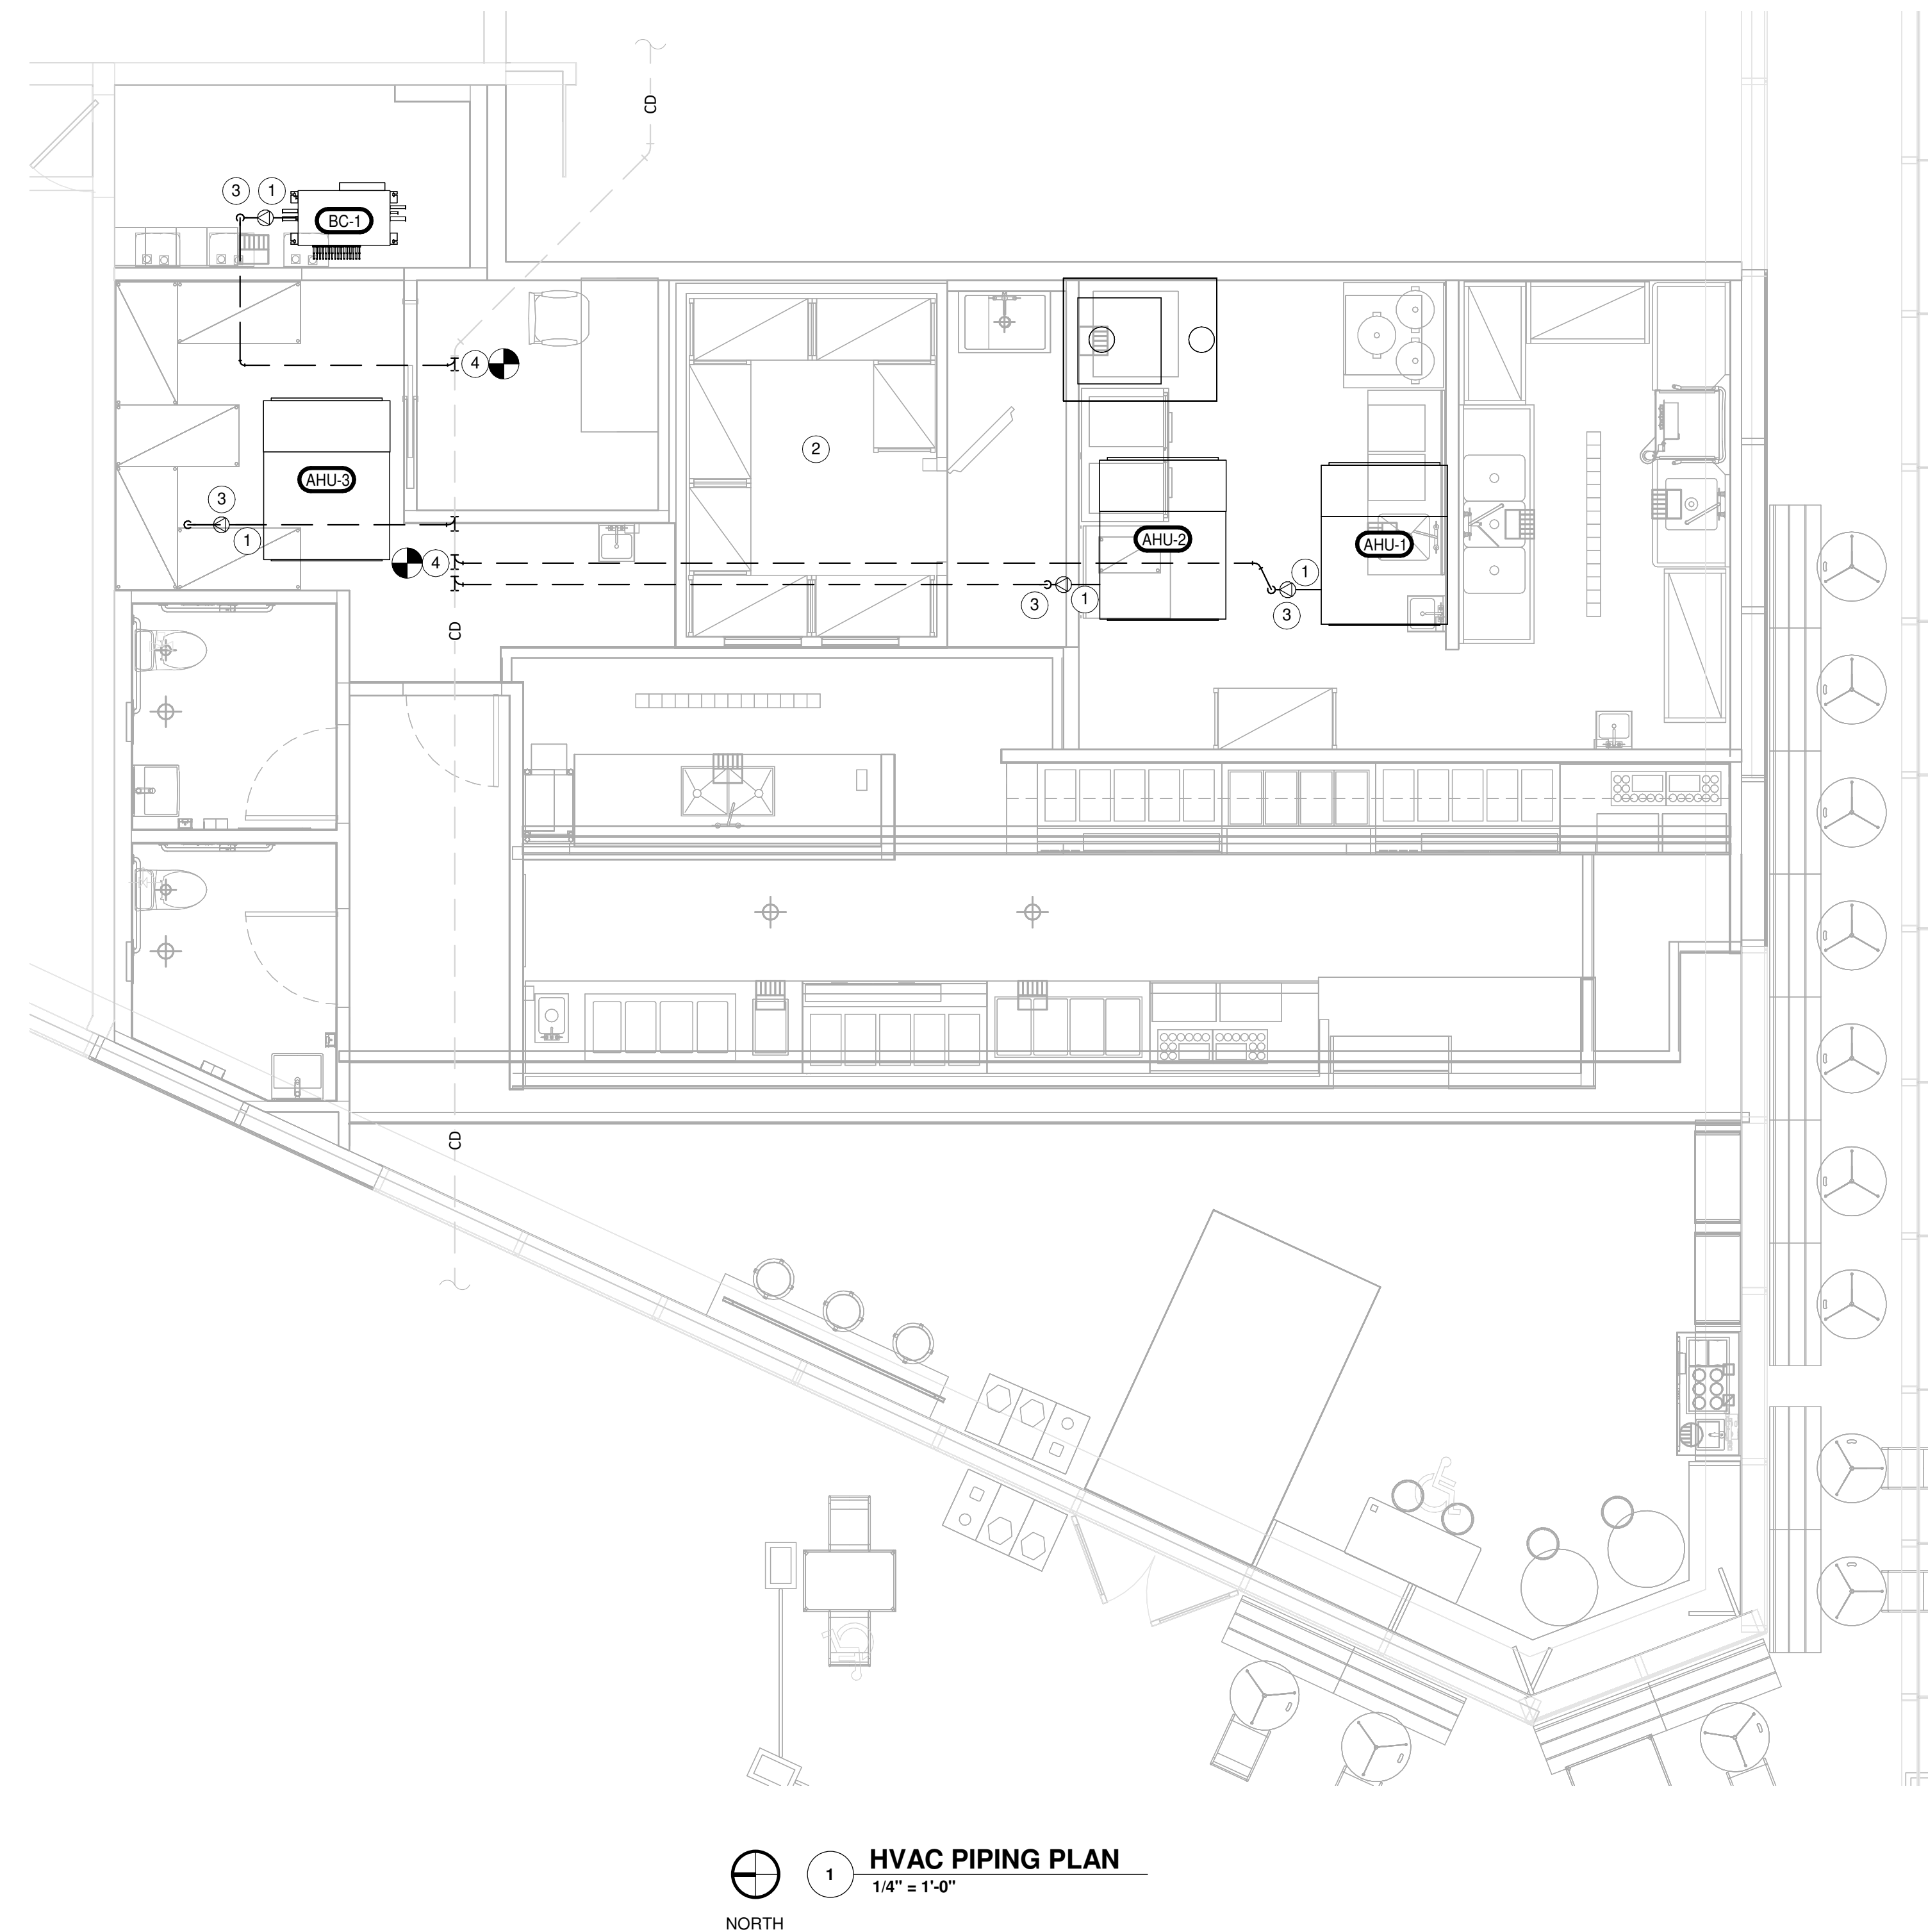




sweetgreen

3101 W. EXPOSITION BLVD.
LOS ANGELES, CALIFORNIA 90018

THESE DRAWINGS & SPECIFICATIONS ARE CONFIDENTIAL AND SHALL REMAIN THE SOLE PROPERTY OF SWEETGREEN CORPORATION...

ENGINEER OF RECORD:

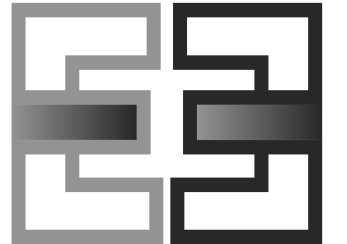

EVERJ ENGINEERING, INC.
1509 BUCK TRAIL LANE
WORTHINGTON, OH 43085
240-319-0822

STAMP:

NOT FOR CONSTRUCTION

05/05/2022

PROJECT INFORMATION:
MUELLER

PROJECT INFORMATION:
1900 ALDRICH ST.
SUITE 140
AUSTIN, TX 78723

DRAWN BY: JAE
CHECKED BY: MK
PROJECT MANAGER: JAE
SG DESIGN MANAGER: LG
SG CONSTR. MANAGER: KZ
PROJECT NO: 210005
TEMPLATE VERSION: 12/21/2021

REVISIONS
REV. DATE DESCRIPTION
1 05/05/2022 LANDLORD COMMENTS

HVAC SCHEDULES

M-300

CAPTIVEAIRE - HVAC SYSTEM INFORMATION

CONTACT THE CAPTIVEAIRE NATIONAL ACCOUNT TEAM FOR HVAC SYSTEM INFORMATION AT:
MARK PROFET
(301)825-5476
MARK.PROFET@CAPTIVEAIRE.COM

TRANE NATIONAL ACCOUNT - HVAC SYSTEM INFORMATION

CONTACT THE TRANE NATIONAL ACCOUNT TEAM FOR HVAC SYSTEM INFORMATION AT:
EMAIL - SOCIALNA@TRANE.COM
PHONE - (714)983-0505 OPTION 4 (NATIONAL ACCOUNTS TEAM)
OR ANY OF THE BELOW SOUTHERN CALIFORNIA NATIONAL ACCOUNTS TEAM MEMBERS:

MATERIAL SCHEDULE

Table with 3 columns: CATEGORY, APPLICATION, ALLOWABLE MATERIAL. Rows include EXPOSED SUPPLY, EXPOSED RETURN, EXPOSED GEN. EXHAUST, EXPOSED VENTILATION AIR, CONCEALED SUPPLY, CONCEALED RETURN, CONCEALED GEN. EXHAUST, CONCEALED VENTILATION AIR, CONDENSATE DRAINS.

AIR BALANCE SCHEDULE

Table with 6 columns: TAG, SUPPLY AIRFLOW (CFM), RETURN AIRFLOW (CFM), OUTSIDE AIRFLOW (CFM), EXHAUST AIRFLOW (CFM), SUBTOTAL (CFM). Rows include AHU-1, AHU-2, AHU-3, EF-1, EF-2, Net Pressurization [CFM].

EXHAUST SCHEDULE

Table with 9 columns: CATEGORY, AREA (SF), NUMBER OF FIXTURES, AIR RATE (CFM / FIXTURE, CFM / SF), EXHAUST REQUIRED (CFM), FLOOR AREA, VENTILATION REQUIRED (CFM), VENTILATION PROVIDED (CFM). Rows include KITCHEN, RESTROOMS, TOTAL.

VENTILATION SCHEDULE

Table with 10 columns: CATEGORY, OCCUPANT DENSITY (# / 1000 SF), AREA (SF), OCCUPANCY BY AREA (PEOPLE), AIR RATE (CFM) (CFM / PERSON, CFM / SF), VENTILATION REQUIRED (CFM) (OCCUPANCY, FLOOR AREA, EFFECTIVENESS), VENTILATION PROVIDED (CFM). Rows include CORRIDOR, DINING ROOM, KITCHEN, OFFICE, STORAGE AREAS, TOTAL.

GRILLS, REGISTERS, AND DIFFUSERS SCHEDULE

Table with 12 columns: TAG, DESCRIPTION, FACE SIZE, MATERIAL, FINISH, MOUNTING, SUPPLIER, INSTALLER, MANUFACTURER, MODEL, REMARKS. Rows include CD1, CD2, ER1, RG1, RG2, RG3, SR1, SR2, TG1.

BRANCH CONTROLLER SCHEDULE

Table with 11 columns: TAG, DESCRIPTION, NUMBER OF PORTS, ELECTRICAL (MCP (A), MCA (A), V/P/H), SUPPLIER, INSTALLER, MANUFACTURER, MODEL, REMARKS. Row includes BC-1.

RECIRCULATING HOOD SCHEDULE

Table with 11 columns: TAG, DESCRIPTION, MAX COOKING TEMP., EXHAUST PLENUM AIRFLOW (CFM), APPROXIMATE WEIGHT (lbs), SUPPLIER, INSTALLER, ELECTRICAL DATA (WATTS, V/P/H), BASIS FOR DESIGN (MANUFACTURER, MODEL), REMARKS. Row includes HD-1.

FAN SCHEDULE

Table with 13 columns: TAG, EXHAUST AIRFLOW (CFM), E.S.P. (IN. W.G.), DRIVE TYPE, MOTOR POWER (HP), WEIGHT (LBF), V/P/H, FURNISHED BY, INSTALLED BY, MANUFACTURER, MODEL, SPECIAL REMARKS. Rows include EF-1, EF-2.

TYPE II HOOD SCHEDULE

Table with 13 columns: TAG, DESCRIPTION, HOOD CONSTRUCTION (WIDTH, DEPTH, MATERIAL), MAXIMUM COOKING TEMPERATURE (DEG. F), EXHAUST COLLARS (AIRFLOW (CFM), DIAMETER (IN), PRESSURE DROP (IN. W.G.)), WEIGHT (LBF), SUPPLIER, INSTALLER, MANUFACTURER, MODEL, REMARKS. Row includes HD-2.

CONDENSING UNIT SCHEDULE


Table with 14 columns: TAG, DESCRIPTION, PAIRED WITH, NOMINAL CAPACITY (TONS), NUMBER OF COMPRESSORS, REFRIGERANT TYPE, WEIGHT (LBS), ELECTRICAL (MOC, CKT 1 (A), MCA, CKT 1 (A), MOC, CKT 2 (A), MCA, CKT 2 (A)), V/P/H, SUPPLIER, INSTALLER, MANUFACTURER, MODEL, REMARKS. Rows include CU-1, CU-2.

AIR HANDLING UNIT SCHEDULE

Table with 20 columns: TAG, DESCRIPTION, COOLING CAPACITY (TONS), EER, COP, AIRFLOW (TOTAL CFM, RETURN CFM, OA CFM), COOLING (E.S.P. (IN. W.G.), NET TOTAL (MBH), NET SENSIBLE (MBH), EAT (DEG. F) (DB, WB)), HEATING (EAT (DEG. F), TOTAL (MBH), LAT (DEG. F)), WEIGHT (LBF), ELECTRICAL (MOC (A), MCA (A)), V/P/H, SUPPLIER, INSTALLER, MANUFACTURER, MODEL, REMARKS. Rows include AHU-1, AHU-2, AHU-3.

THESE DRAWINGS & SPECIFICATIONS ARE CONFIDENTIAL AND SHALL REMAIN THE SOLE PROPERTY OF SWEETGREEN CORPORATION. THEY SHALL NOT BE REPRODUCED (IN WHOLE OR IN PART), SHARED WITH THIRD PARTIES OR USED IN ANY MANNER ON OTHER PROJECTS OR EXTENSIONS TO THIS PROJECT WITHOUT THE PRIOR WRITTEN CONSENT OF SWEETGREEN CORPORATION. THESE DRAWINGS & SPECIFICATIONS ARE INTENDED TO EXPRESS DESIGN INTENT FOR A PROTOTYPICAL SWEETGREEN STORE WHICH IS SUBJECT TO CHANGE AT ANY TIME AND MAY NOT REFLECT ACTUAL SITE CONDITIONS. NEITHER PARTY SHALL HAVE ANY OBLIGATION OR LIABILITY TO THE OTHER EXCEPT AS STATED ABOVE UNTIL A WRITTEN AGREEMENT IS FULLY EXECUTED.

ENGINEER OF RECORD:

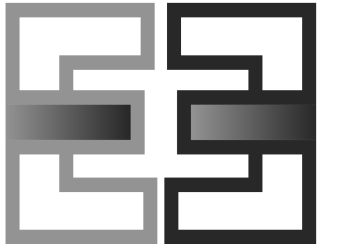

EVERJ ENGINEERING, INC.  
1509 BUCK TRAIL LANE  
WORTHINGTON, OH 43085  
240-319-0822  
www.everjengineering.com  
TX ENGINEERING FIRM F-22980

STAMP:

**NOT FOR CONSTRUCTION**

05/05/2022

PROJECT INFORMATION:  
**MUELLER**


PROJECT INFORMATION:  
**1900 ALDRICH ST.  
SUITE 140  
AUSTIN, TX 78723**

DRAWN BY: JAE  
CHECKED BY: MK  
PROJECT MANAGER: JAE  
SG DESIGN MANAGER: LG  
SG CONSTR. MANAGER: KZ  
PROJECT NO: 210005  
TEMPLATE VERSION: 12/21/2021

REV.	DATE	DESCRIPTION

**HVAC DETAILS**

**M-400**

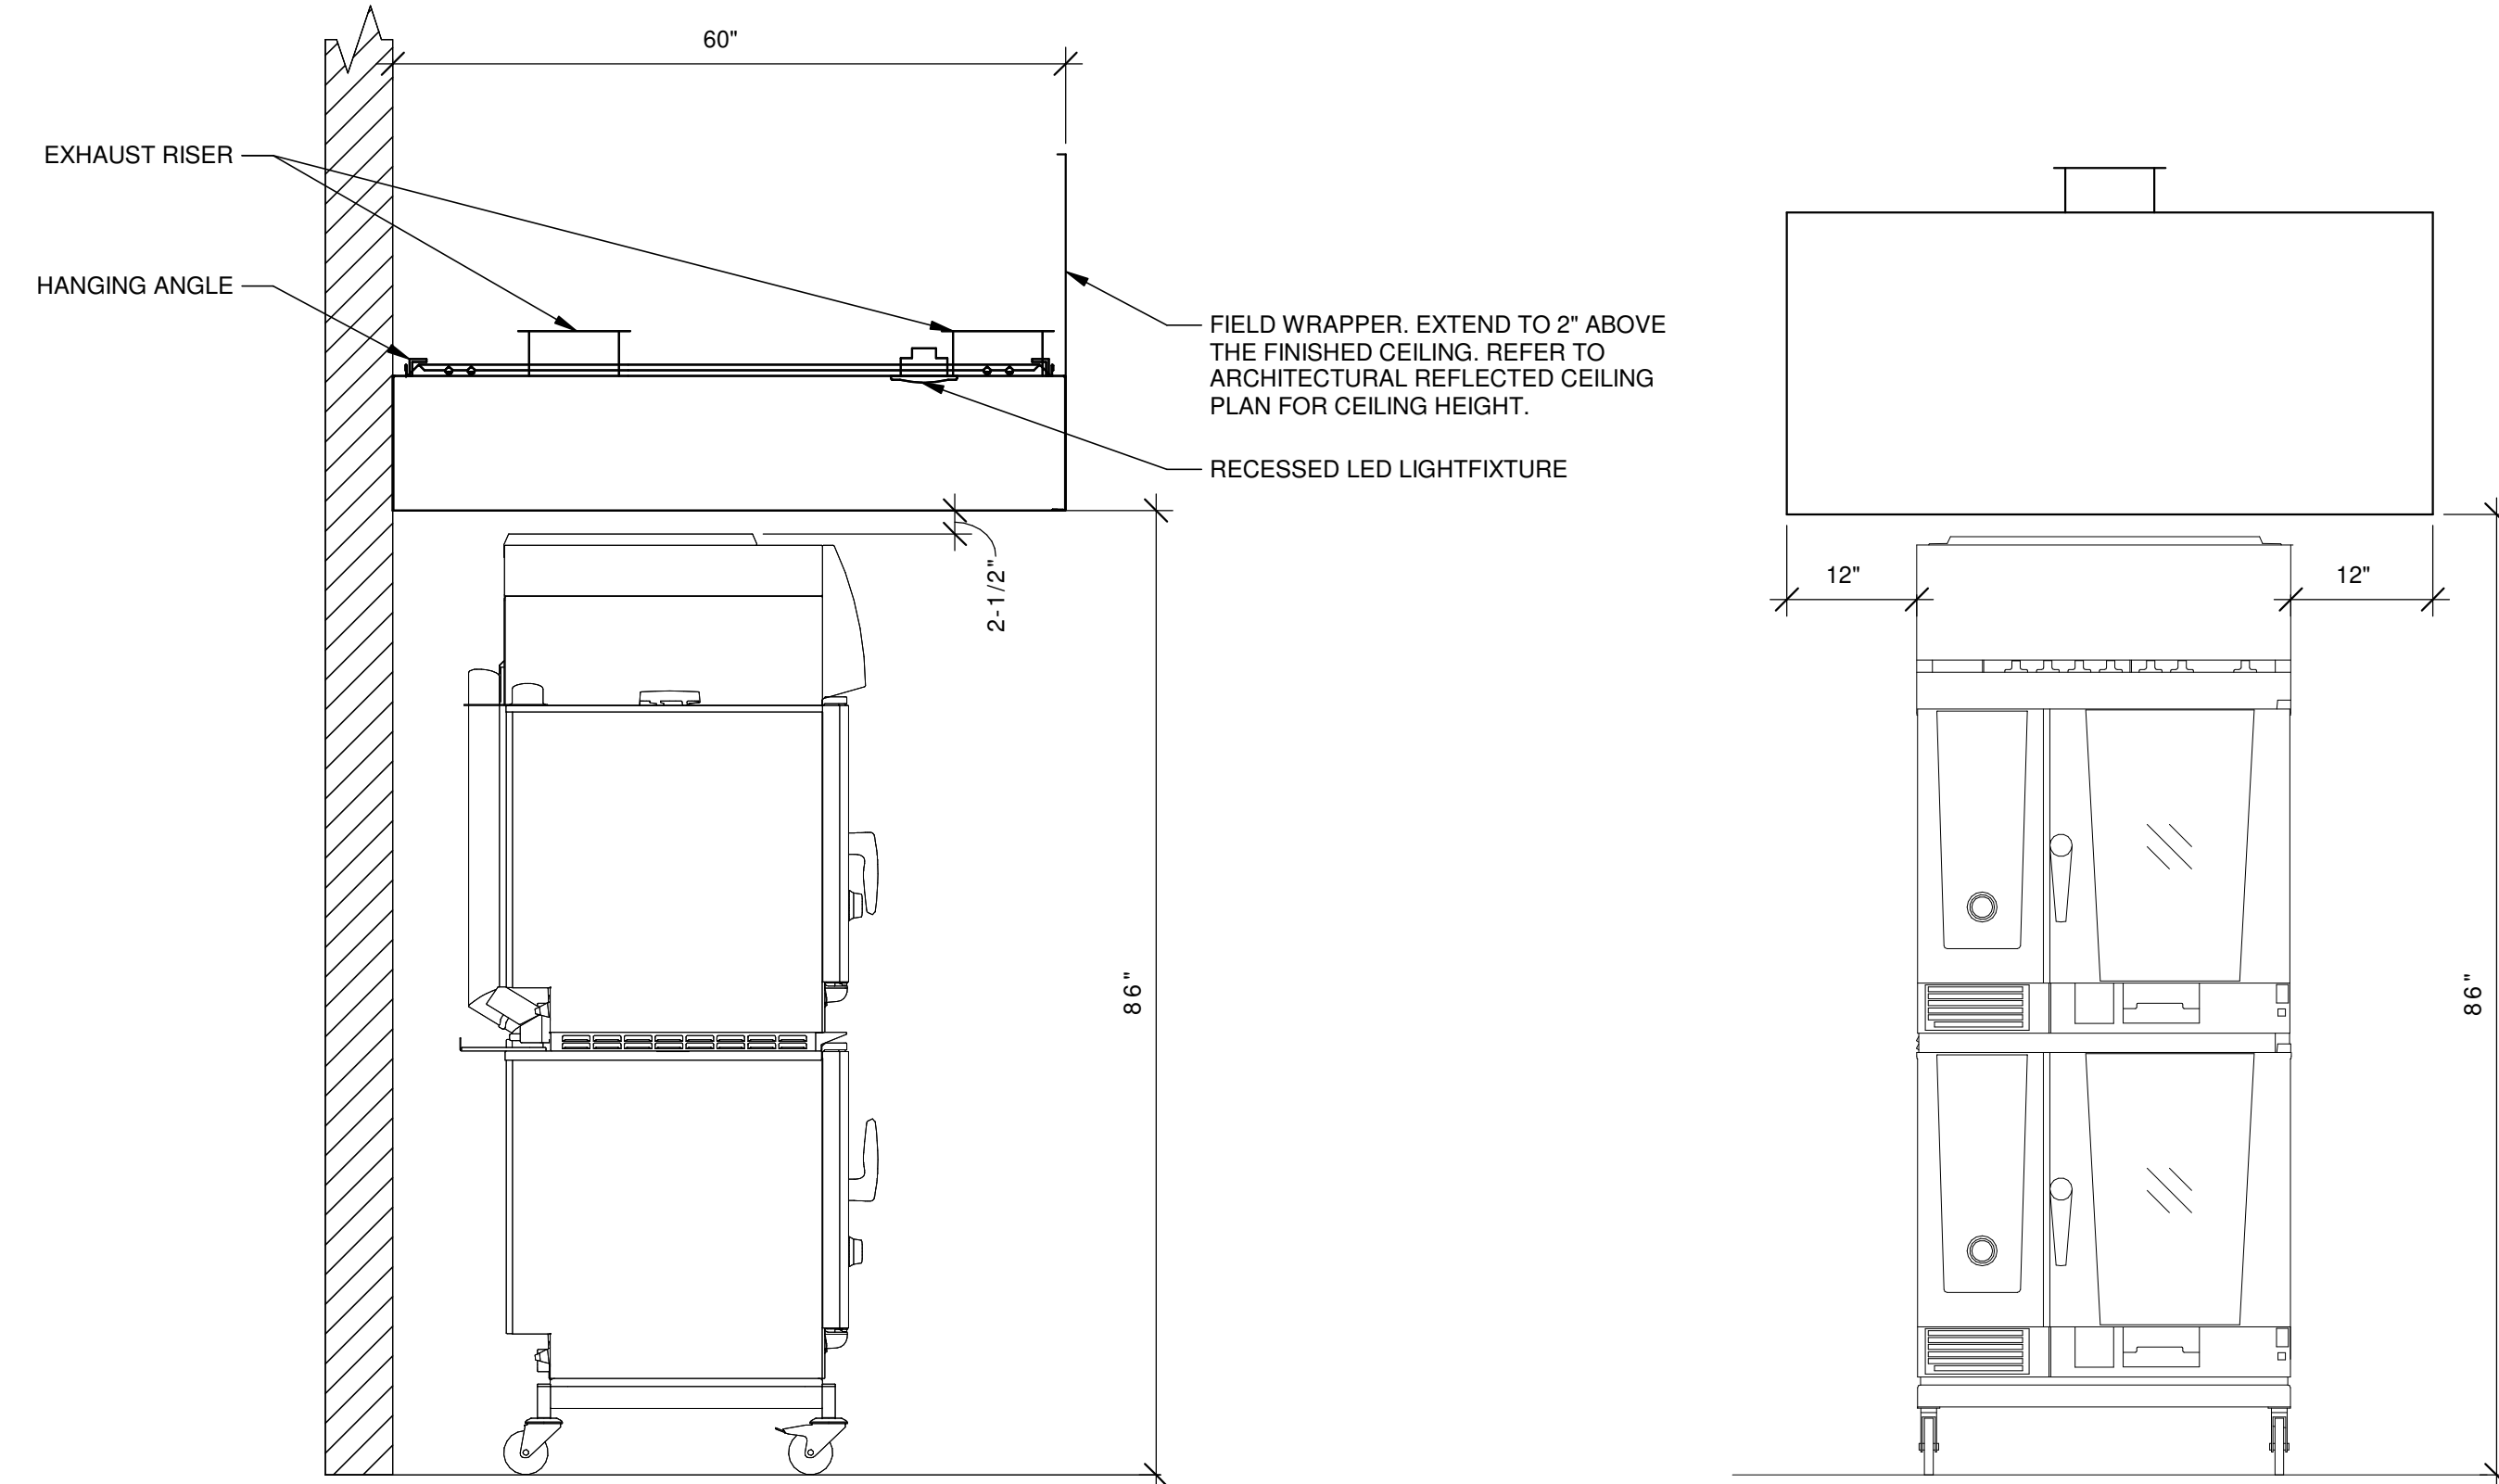

4 HOOD ELEVATIONS  
N.T.S.

**SEQUENCE OF OPERATIONS VRF GENERAL**

**GENERAL:**  
THE VRF SYSTEM SHALL BE A HEAT PUMP, HEAT RECOVERY SYSTEM CAPABLE OF SIMULTANEOUS HEATING AND COOLING. THE CONDENSING UNIT SHALL MODULATE CAPACITY AS REQUIRED TO SATISFY THE AIR HANDLING UNIT DEMAND. THE BRANCH CIRCUIT CONTROLLER SHALL PROVIDE CONTROL TO THE SYSTEM AS REQUIRED.

**SEQUENCE OF OPERATIONS AHU-1 THROUGH AHU-3**

**OCCUPIED MODE:**  
**FAN OPERATION/OUTSIDE AIR DAMPER:** WHEN SCHEDULED BY THE TIME CLOCK TO BE IN OCCUPIED MODE, THE AIR HANDLER FANS ARE TO START AND RUN CONTINUOUSLY AND THE OUTSIDE AIR DAMPER SHALL POWER TO THE OPEN POSITION.  
**HEATING:** ON A FALL IN SPACE TEMPERATURE BELOW THE SETPOINT OF 70 DEGREES (ADJUSTABLE) THE AIR HANDLING UNIT SHALL BE SWITCHED TO HEATING MODE AND THE HEATING CAPACITY SHALL MODULATE UP TO MAXIMUM TO MAINTAIN THE TEMPERATURE SETPOINT.  
**COOLING:** ON A RISE IN SPACE TEMPERATURE ABOVE THE SETPOINT OF 72 DEGREES (ADJUSTABLE) THE AIR HANDLING UNIT SHALL BE SWITCHED TO COOLING MODE AND THE COOLING CAPACITY SHALL MODULATE UP TO MAXIMUM TO MAINTAIN THE TEMPERATURE SETPOINT.

**UNOCCUPIED MODE:**  
**FAN OPERATION/OUTSIDE AIR DAMPER:** WHEN SCHEDULED BY THE TIME CLOCK TO BE IN UNOCCUPIED MODE, THE AIR HANDLER FANS ARE TO BE OFF AND THE OUTSIDE AIR DAMPER SHALL REMAIN CLOSED.  
**HEATING:** ON A FALL IN SPACE TEMPERATURE BELOW THE SETPOINT OF 65 DEGREES (ADJUSTABLE) THE AIR HANDLING UNIT FAN SHALL START AND THE UNIT SHALL BE SWITCHED TO HEATING MODE AND THE HEATING CAPACITY SHALL MODULATE UP TO MAXIMUM TO MAINTAIN THE TEMPERATURE SETPOINT.  
**COOLING:** ON A RISE IN SPACE TEMPERATURE ABOVE THE SETPOINT OF 85 DEGREES (ADJUSTABLE) THE AIR HANDLING UNIT FAN SHALL START AND THE UNIT SHALL BE SWITCHED TO COOLING MODE AND THE COOLING CAPACITY SHALL MODULATE UP TO MAXIMUM TO MAINTAIN THE TEMPERATURE SETPOINT.

**EMERGENCY MODE:**  
**FAN OPERATION/OUTSIDE AIR DAMPER:** UPON A SIGNAL FROM THE FIRE ALARM SYSTEM, THE FAN SHALL STOP AND THE OUTSIDE AIR DAMPER SHALL CLOSE.


**SEQUENCE OF OPERATIONS EF-1 & EF-2**

**OCCUPIED MODE:**  
**FAN OPERATION:** WHEN SCHEDULED BY THE TIME CLOCK TO BE IN OCCUPIED MODE, THE FANS ARE TO START AND RUN CONTINUOUSLY.


**UNOCCUPIED MODE:**  
**FAN OPERATION:** WHEN SCHEDULED BY THE TIME CLOCK TO BE IN UNOCCUPIED MODE, THE FANS SHALL REMAIN OFF.

**EMERGENCY MODE:**  
**FAN OPERATION:** UPON A SIGNAL FROM THE FIRE ALARM SYSTEM, THE FANS SHALL STOP.

3 SEQUENCE OF OPERATIONS  
N.T.S.

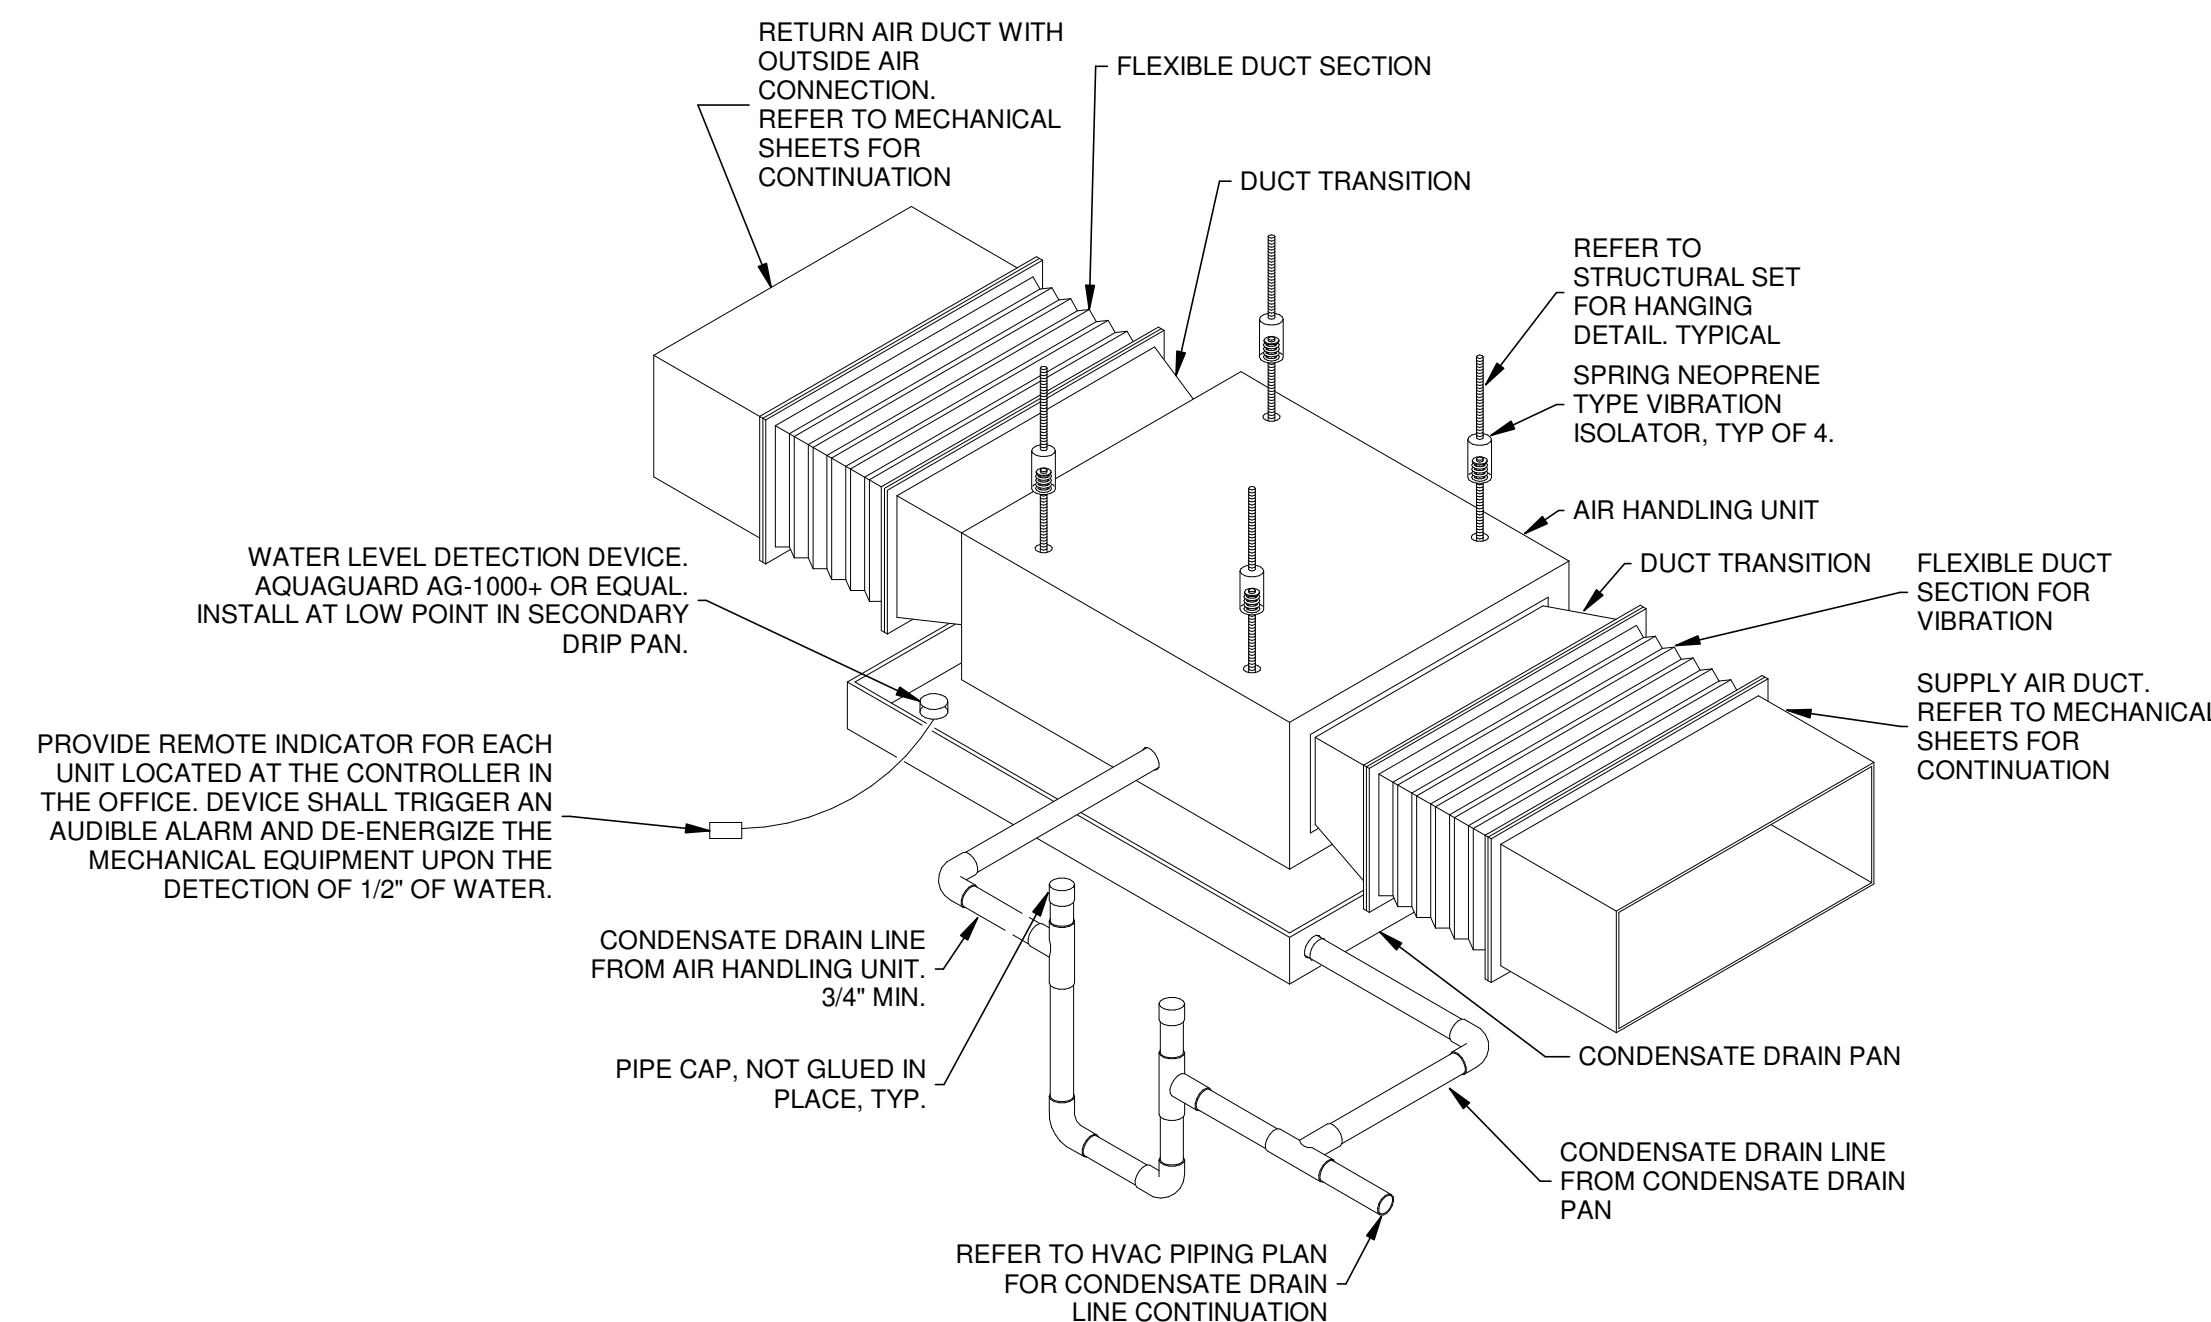

2 AIR HANDLING UNIT INSTALLATION DETAIL  
N.T.S.

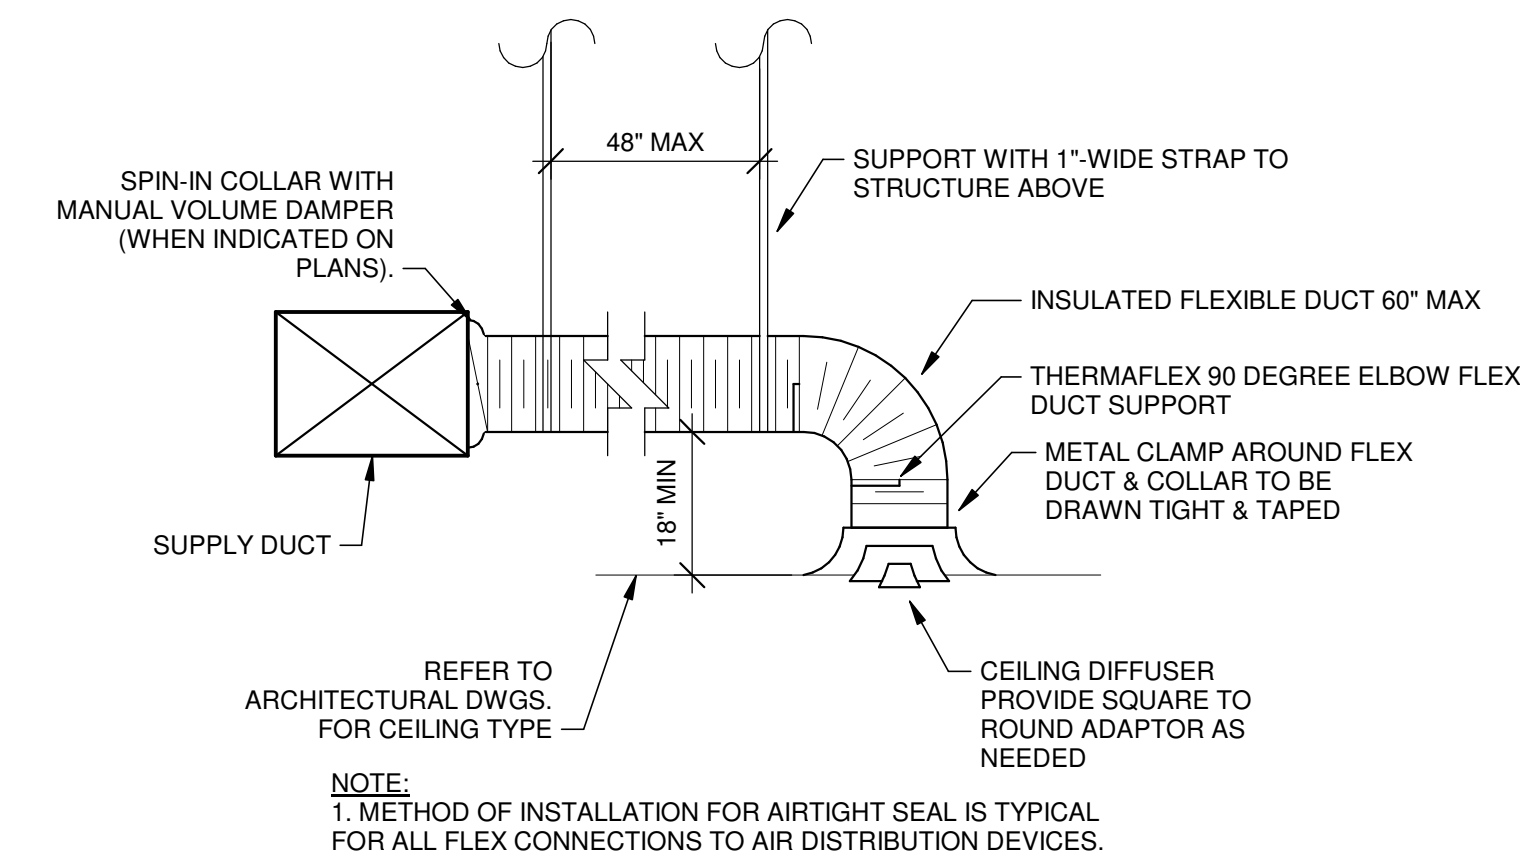

1 DIFFUSER CONNECTION  
N.T.S.