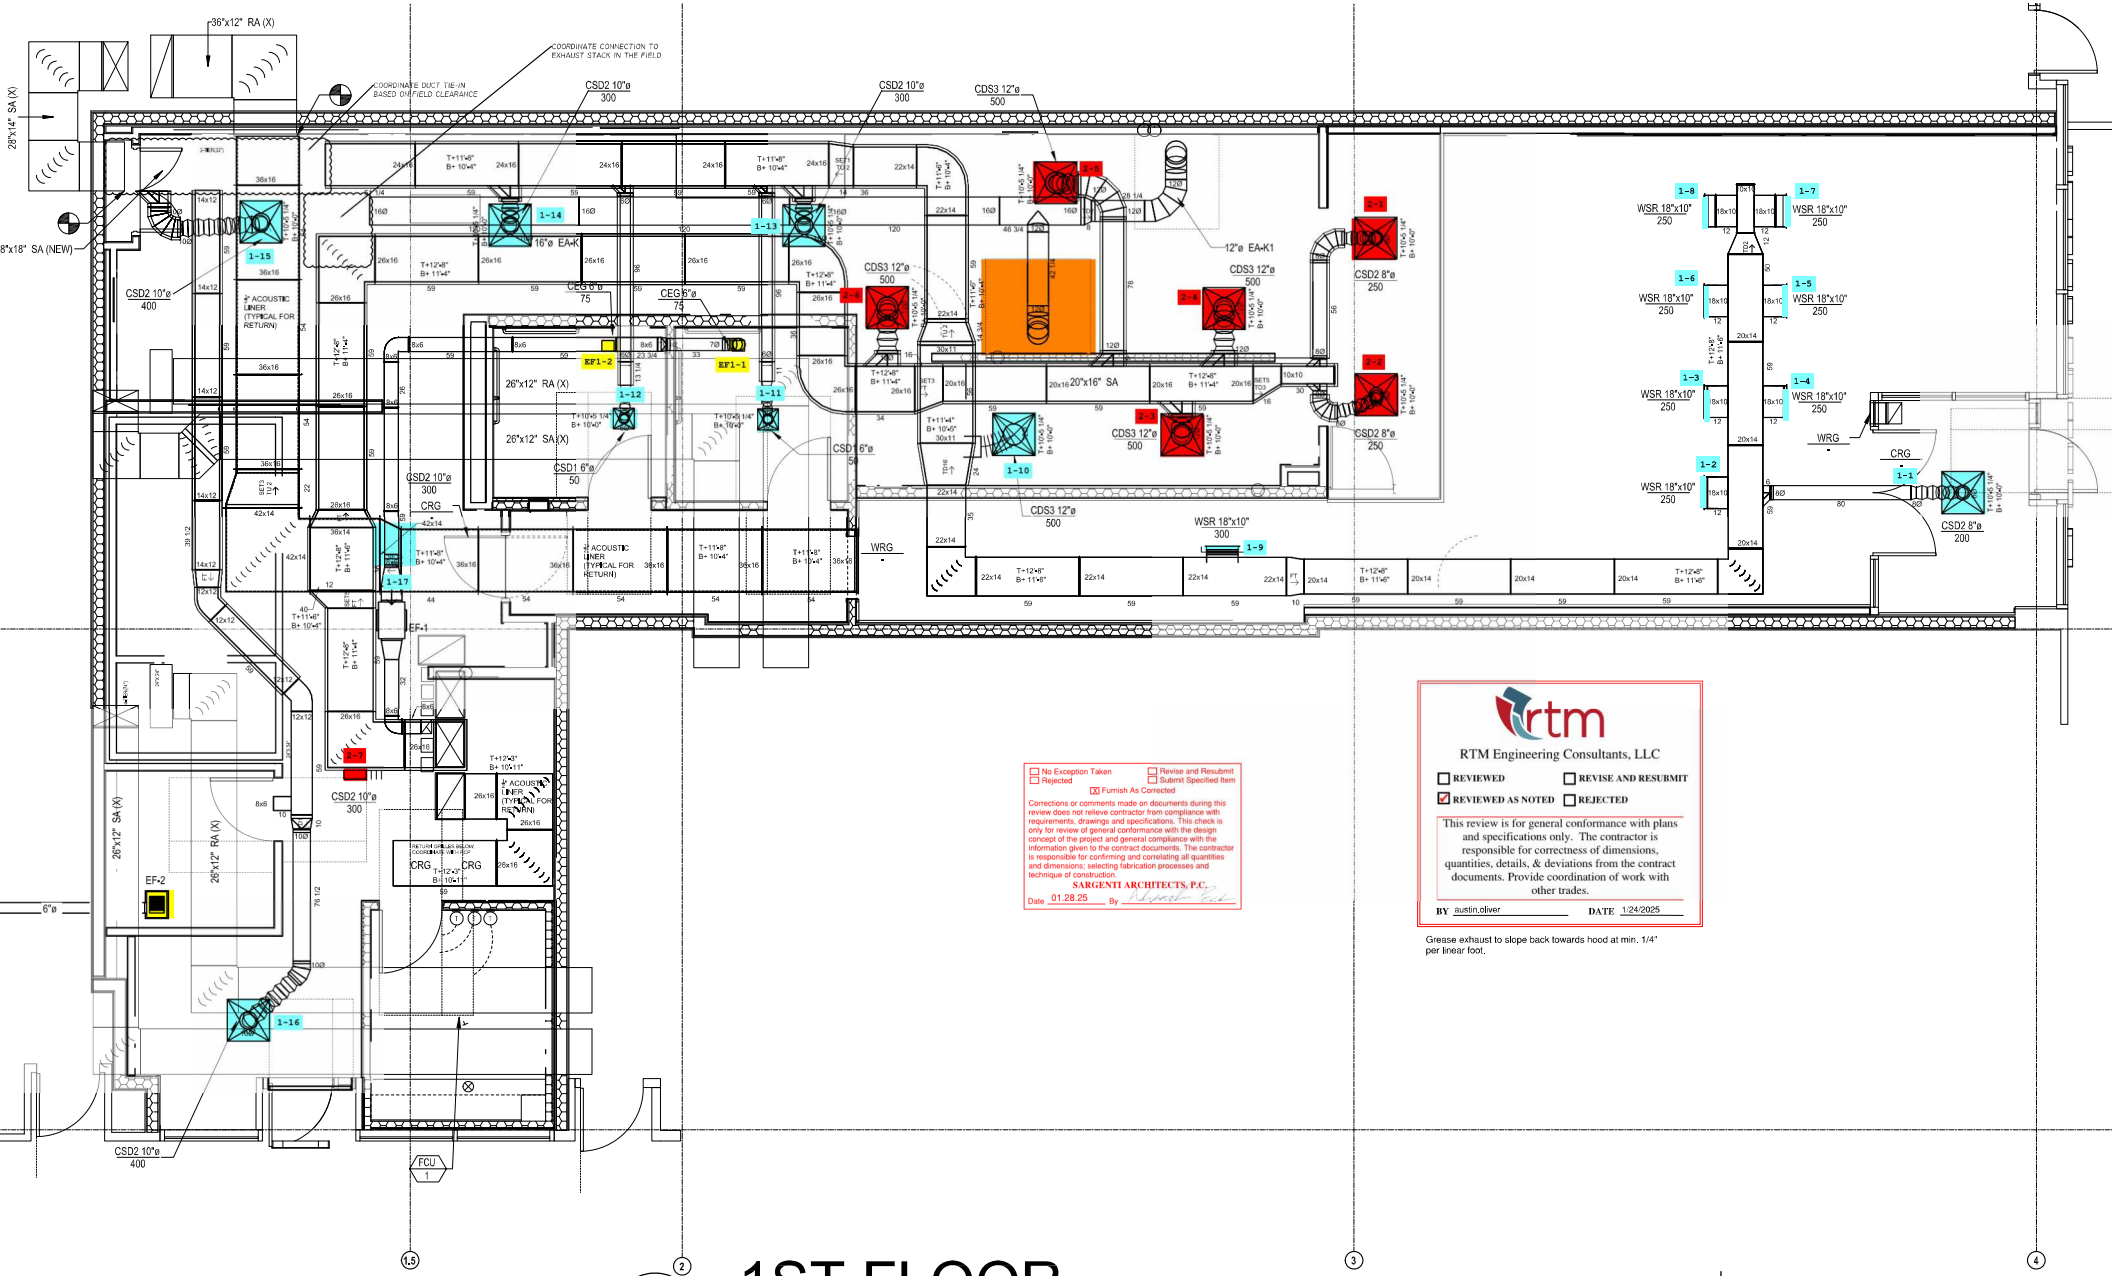

1ST FLOOR

1/4" = 1'-0"

No Exception Taken
Rejected
Revise and Resubmit
Submit Specified Item
Furnish As Corrected

Corrections or comments made on documents during this review does not relieve contractor from compliance with requirements, drawings and specifications. This check is only for review of general conformance with the design concept of the project and general compliance with the information given to the contract documents. The contractor is responsible for confirming and correlating all quantities and dimensions; selecting fabrication processes and technique of construction.

SARGENTI ARCHITECTS, P.C.

Date 01.28.25 By

RTM Engineering Consultants, LLC

REVIEWED
REVISE AND RESUBMIT
REVIEWED AS NOTED
REJECTED

This review is for general conformance with plans and specifications only. The contractor is responsible for correctness of dimensions, quantities, details, & deviations from the contract documents. Provide coordination of work with other trades.

BY austin.oliver DATE 1/24/2025

Grease exhaust to slope back towards hood at min. 1/4" per linear foot.