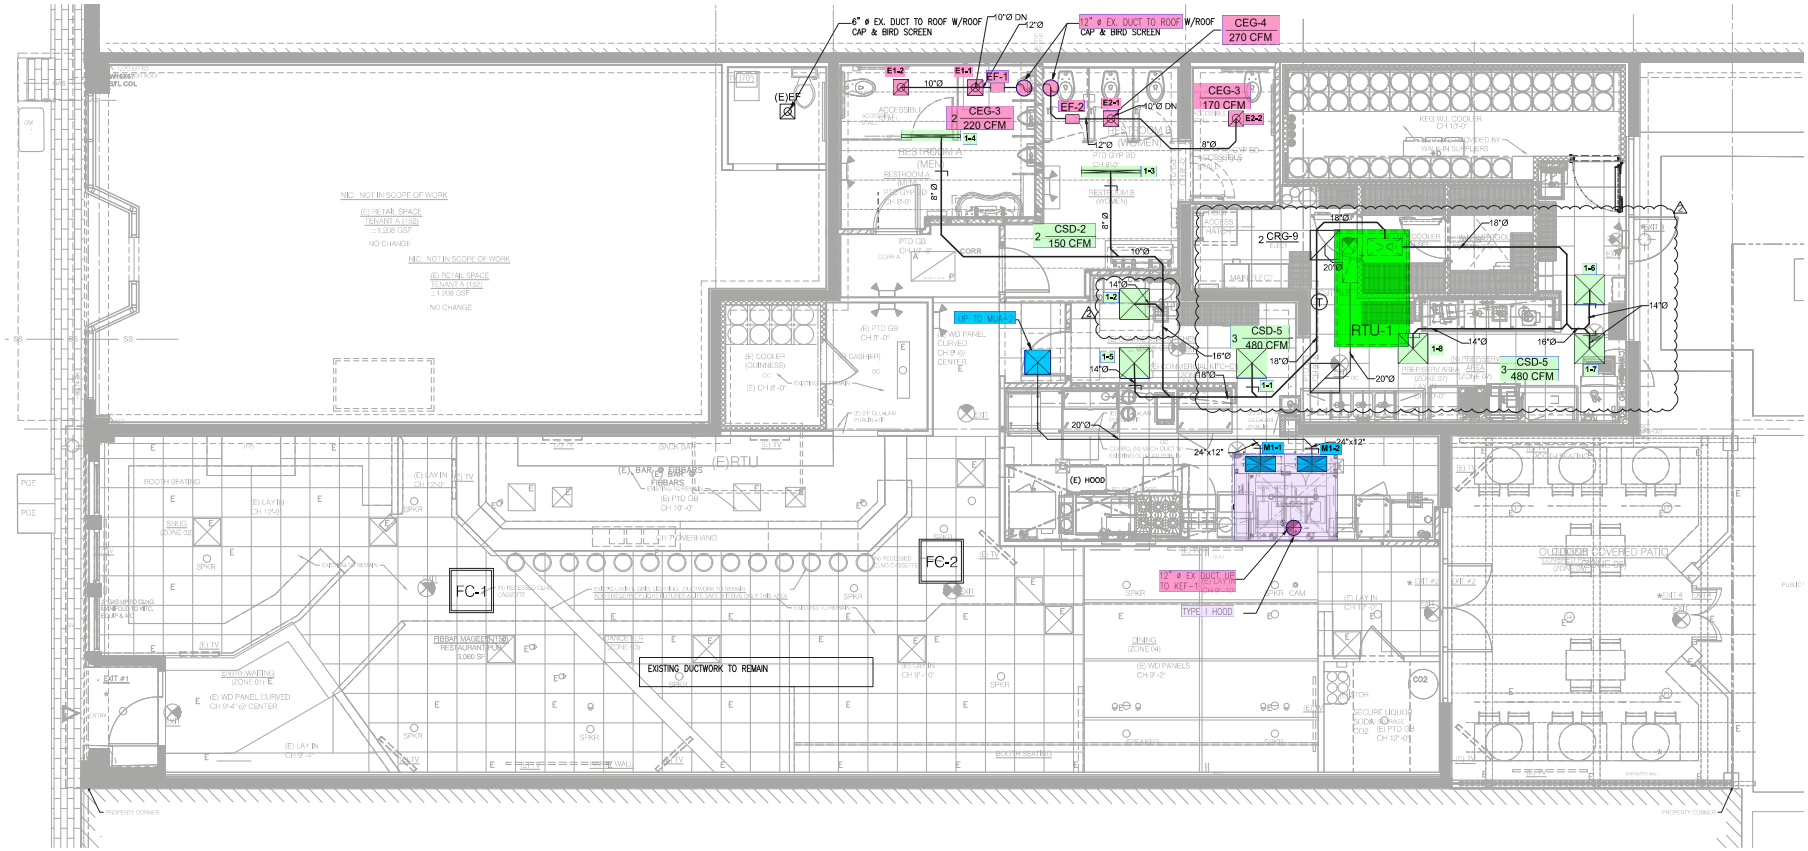

1 FLOOR PLAN HVAC
SCALE: 1/4"= 1'-0"

Building Safety Division
City of Sunnyvale
Aug 22 2023
Approved as Noted
Building Safety Division
This stamping of the plans shall not be interpreted to be an approval of the violation of any provision of any City or State Law.
JOB COPY
These plans must be kept on the job site at all times.
CITY OF SUNNYVALE

Reviewed for Code Compliance
09/21/2023
CSG CONSULTANTS, INC.

I & ENGINEERING
1610 BLOSSOM HILL ROAD, SUITE "6A"
SAN JOSE, CALIFORNIA 95124
TEL: (408) 268-3337
FAX: (408) 268-1135

REGISTERED PROFESSIONAL ENGINEER
IRADJ RAHNAMA
No. M-26257
Exp. 06/30/23
MECHANICAL
STATE OF CALIFORNIA

DRAWINGS NOT FOR CONSTRUCTION UNTIL STAMPED. JOB COPY IN BUILDING DEPARTMENT. ALL DRAWINGS AND WRITTEN MATERIAL APPEARING HEREIN CONSTITUTE ORIGINAL AND UNPUBLISHED WORK OF THE ENGINEER AND MAY NOT BE DUPLICATED, USED, OR DISCLOSED WITHOUT WRITTEN CONSENT OF THE ENGINEER.

152 AND 156 S. MURPHY AVE.
AND
159 S. SUNNYVALE AVE.
SUNNYVALE, CA 94086

PROJECT: FIBBAR MaGEE'S RENOVATION

DRAWING TITLE: FLOOR PLAN HVAC

REV	DATE	DESCRIPTION
1	4/26/23	PLAN CHECK COMMENTS
2	6/1/23	PLAN CHECK COMMENTS
3		
4		
5		
6		

JOB NO.:	22-121
CAD FILE:	
DSGN'D BY: I. R.	DRAWN BY: H. N.
CHK'D BY: I. R.	APP'D BY: I. R.
DATE: 09/14/22	SCALE: AS NOTED

DRAWING NO.: M1-1

SHEET ___ OF ___