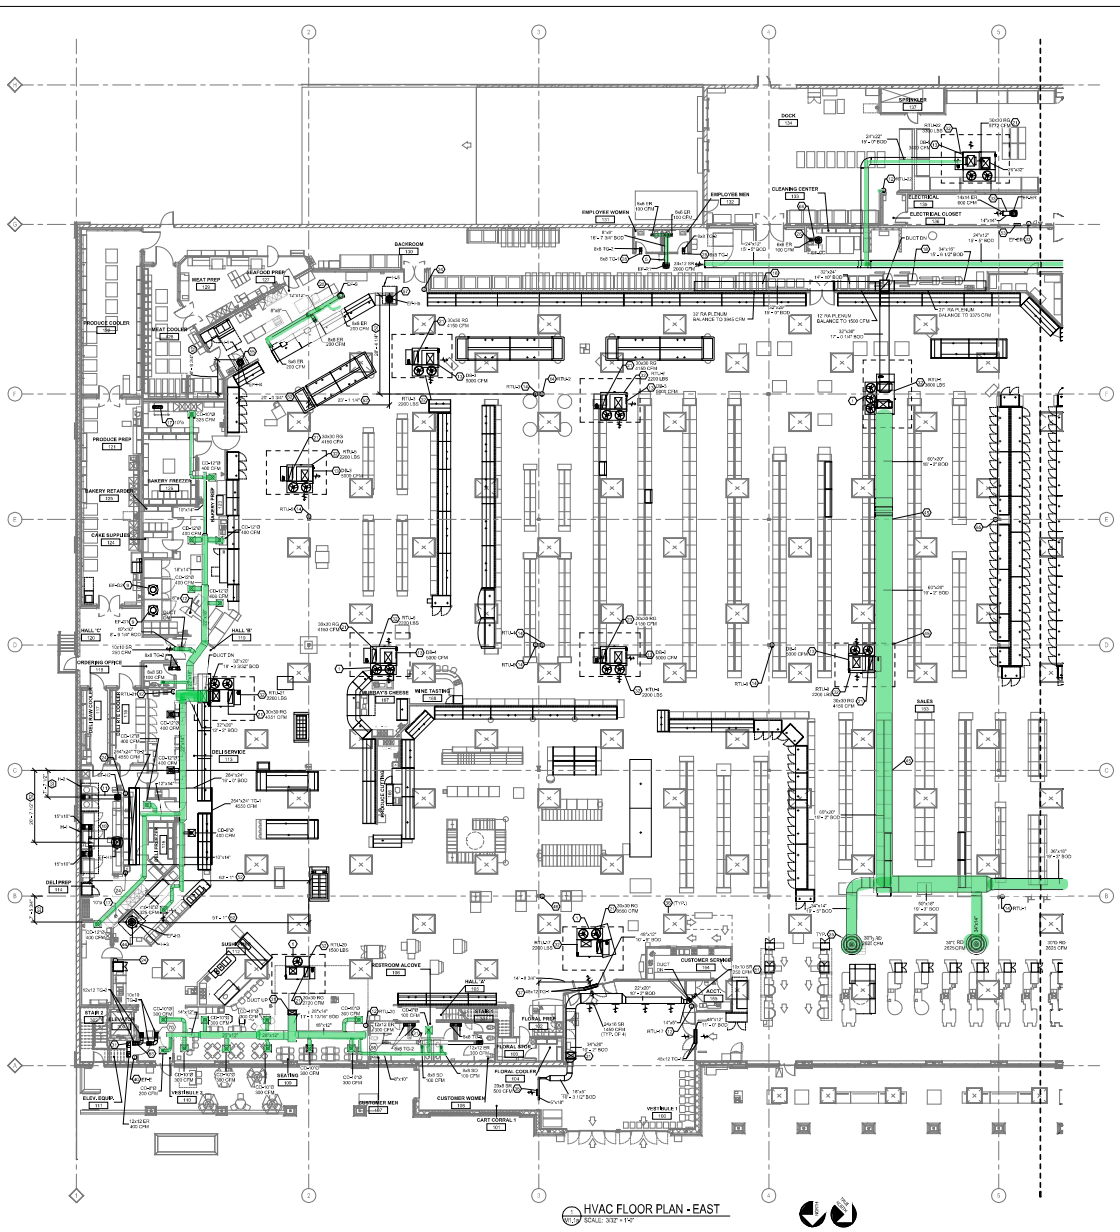

HVAC FLOOR PLAN - EAST
SCALE: 3/32" = 1'-0"

GENERAL NOTES

A. REFER TO HEATING, VENTILATING & AIR CONDITIONING SPECIFICATIONS AND GENERAL CONDITIONS FOR ADDITIONAL INFORMATION.
B. ALL DIFFUSERS AND CEILING GRILLES SHALL BE COORDINATED WITH LAY-IN CEILING GRID AND PROVIDED BY MECHANICAL CONTRACTOR, SEE SCHEDULE SHEET MEL.
C. PROVIDE BALANCING DAMPERS FOR BALANCE PURPOSES, REGISTER AND GRILLE SIZES SHOWN ARE BASED ON TITUS PRICE SCHEDULE. WHERE BRANCHES USED FOR RIGID ANGLE DUCTS OR OPTIMIZING AS REQUIRED FOR AIR BALANCING, INSTALL AT A MINIMUM OF 45 DEGREES TO MAIN DUCT. ALTERNATE THEORY WHERE PRACTICAL, REFER TO HVAC DRAWING MEL.
D. NO PROVISION HAS BEEN MADE FOR RETURN UP FROM THE BACK ROOM AS IT HAS BEEN OUR EXPERIENCE THAT ACCEPTABLE CONSTRUCTION TOLERANCES IN THE LINER RESULTS IN LEAKAGE IN THE ROOF DECK AND CAUSES DAMAGE.
E. ALL NON-STRUCT. TAKE AND INSTALL OFFICE ARE INCLUDED IN OWNERS DIRECT BUY PROGRAM, AND SHALL BE PROVIDED BY OWNER AND INSTALLED BY HVAC CONTRACTOR, UNLESS OTHERWISE NOTED.
F. SMOKE DETECTORS, WARNING DETECTORS ARE SHOWN ON ELECTRICAL SYSTEMS PLAN.
G. REFER TO ITO SCHEDULE SHEET MEL1 FOR ROOFTOP UNIT SCHEDULE.
H. PROVIDE AND INSTALL EXCEPTIONS DAMPERS FOR NON-KITCHEN EXHAUST FANS. SEE SPECIFICATIONS FOR ADDITIONAL INFORMATION.
I. THE STORES MECHANICAL DESIGN SHALL BE SILENT TO EAR IN ALL AREAS OF THE STORE.
J. SUPPLY AND RETURN DUCTWORK FROM ROOFTOP UNITS TO BE INTERNALLY INSULATED A MINIMUM OF TEN FEET FOR SOUND ATTENUATION PURPOSES.
K. REFER TO HVAC DETAILS SHEET MEL3 FOR ROOFTOP UNIT CURB INSTALLATION.
L. PROVIDE TURNING VANES IN ALL RECTANGULAR MITERED ELBOWS. ONLY ITEMS REQUIRED FOR THE OPERATION OF THE ELEVATOR ARE ALLOWED TO BE IN THE PATH THROUGH THE SUPERVISOR COMPANY ROOM.
M. ALL DIFFUSERS ARE 4-WAY UNLESS OTHERWISE INDICATED, REFER TO HVAC DETAILS SHEET MEL1.
N. BUSHELTS TO CEILING DIFFUSERS ARE THE SAME SIZE AS THE DIFFUSER, REFER TO HVAC DETAILS SHEET MEL1.
O. REFER TO HVAC DETAILS SHEET MEL1 FOR ADDITIONAL INFORMATION ON SHEET MEL1.

KEYED NOTES

1. RTU TO BE INSTALLED WITH FACTORY INSTALLED HEAT RECLAIM COIL. PROVIDE ROOFTOP UNIT FOR REPLACEMENT WITH RECLAIM COIL WITH ALL CONNECTIONS AND CURB TO PROVIDE TRANSITION.
2. EXHAUST UP TO OPENING THRU ROOF CAPPED WITH KROGER FURNISHED EXHAUST FAN AND CURB (TYP.).
3. 10" SWEAT DUCT UP FROM BACK OVEN VENT COLLAR THRU ROOF CAPPED WITH 14" RIGID CAP. FANS ONLY TO EXHAUST HEAT OF BAKE UNITS. ARE TO BE RUN STRAIGHT AND VERTICAL WHEN VISIBLE TO SALES FLOOR. REFER TO HEAT RECLAIM DETAIL.
10. 30X30 GREASE DUCT FROM HEAT HOOD ABOVE TO OPENING THRU ROOF PROVIDE AND INSTALL BY KROGER FURNISHED MECHANICAL CONTRACTOR. INTERNAL PROVISIONS MUST BE ESTIMATED TO INSULTRA THROUGH LENGTH OF GREASE DUCT FROM CEILING PENETRATION TO FAN. REFER TO DETAIL HEM-4 SHEET MEL1. REFER TO SCHEDULE SHEET MEL1.
11. 10X40 GREASE DUCT FROM EXHAUST HOOD ABOVE TO OPENING THRU ROOF PROVIDE AND INSTALL BY KROGER FURNISHED MECHANICAL CONTRACTOR. PROVISIONS MUST BE ESTIMATED TO INSULTRA THROUGH LENGTH OF GREASE DUCT FROM CEILING PENETRATION TO FAN. REFER TO DETAIL HEM-4 SHEET MEL1. REFER TO SCHEDULE SHEET MEL1.
12. TEMPERATURE SENSOR FOR ROOFTOP UNIT FURNISHED BY BUILDING CONTROLS PROVIDE INSTALL PROBE AT FAN OFF ON COLUMN. REFER TO EM DRAWINGS FOR ADDITIONAL INFORMATION.
13. DROP BOX DIFFUSER SYSTEM. REFER TO DIFFUSER SCHEDULE FOR AIRS MODEL NUMBERS AND QUANTITIES. REFER TO PLANS FOR THROW DIRECTIONS AND CFM. REFER TO DETAIL HEM-7 FOR INSTALLATION.
14. TEMPERATURE SENSOR FOR ROOF MOUNTED RTU FURNISHED BY BUILDING CONTROLS. PROVIDE BOLTS, CONTROL WIRING THROUGH RTU TO BUILDING CONTROL PANEL. MOUNT SENSOR CLOSE BY ON SALES FLOOR AREA.
17. 24X24 VENT HT INCLUDED WITH LINE AND BUTFIED BY HOBART. VENT HT AUTOMATICALLY REMOVES STEAM/CONDENSATION AT THE COMPLETION OF THE WASHWARM CYCLE. WASHWARM DOES NOT OPEN UNTIL THE VENT HT HAS REMOVED THE STEAM/CONDENSATION. PROVIDE AND INSTALL 20X20 GRILLE DUCTS TO THE VENT HT OPENING THRU ROOF AND TO TERMINATE THE END OF THE DUCT WITH WIRE LL. REFER TO DETAIL HEM-2 SHEET MEL1.
18. REHEAT THE CASH RETURN AND DUCT PLENUM CLEANCE TO CFM. REFER TO HVAC DETAILS SHEET MEL1 FOR ADDITIONAL INFORMATION. STANDARD DETAIL ROUTE 1 HOUR DUCT THROUGH CONCRETE WHEN APPLICABLE TO MINIMUM MAXIMUM BOTTOM OF DUCT CLEARANCE. CUT AND PATCH DUCT PER DRAWING STANDARD AROUND BEEDS.
20. 12X12 DUCT UP TO OPENING THRU ROOF CAPPED WITH KROGER FURNISHED EXHAUST FAN AND CURB (TYP.).
21. RETURN AIR GRILLE IN LIEU OF DUCT. DROP TITUS SIP WITH 1 INCH DEEP BORDER. REFER TO HVAC DETAILS SHEET MEL1.
22. VERIFY WALL FULL EXISTING LOCATION, COORDINATE WALL LOCATION WITH ELECTRICAL & ALZ. REFER FLOOR PLANS, PROVIDE NAMEPLATE AT STAIR ENTRY WITH NUMBER AND LOCATION.
23. MOUNT TOP OF DIFFUSER EXCEPTIONAL LIGHTING IN AREA. REFER TO DETAILS SHEET MEL1 FOR ADDITIONAL INFORMATION. FOR DIFFUSERS, REFER TO EXPANDED DUCT DIFFUSER INSTALLATION DETAIL HEM-7 SHEET MEL1 (TYP).
24. MOUNT CONVERT GRILLE ABOVE FINISHED FLOOR IN CLEANING CENTER AREA.
26. MOUNT TRANSFER GRILLE ABOVE RESTROOM DOOR.
31. REFER TO MECHANIC PLAN FOR CONTINUATION OF DUCTWORK.
32. KROGER FURNISHED & INSTALLED BY KROGER INSTALLED BY MECHANICAL CONTRACTOR. PROVIDE AND INSTALL 20X20 GRILLE DUCTS TO THE SCHEDULED CFM. REFER TO DETAIL HEM-2 SHEET MEL1.
34. 14X14 DUCT UP TO OPENING THRU ROOF CAPPED WITH KROGER FURNISHED EXHAUST FAN AND CURB (14X14). CONTRACTOR TO PROVIDE REVERSE ACTING THERMOSTAT FOR FAN ON TO ENSURE THAT KITCHEN REACHES 80 DEG F.
41. 10X10 GRAVITY DUCT FROM BY HOBART HOOD UP TO OPENING THRU ROOF PER MFG. & CAPPED WITH EAVE. MECHANICAL CONTRACTOR TO INSTALL. PROVIDE AND INSTALL 10X10 GRAVITY DUCT FROM HOOD TO THE GREASE DUCT FROM CEILING PENETRATION TO FAN. REFER TO DETAIL HEM-4 SHEET MEL1. REFER TO SCHEDULE SHEET MEL1.
42. DUCT TO BE ROUTED THROUGH STRUCTURAL MEMBERS. COORDINATE WITH STRUCTURE PRIOR TO MANUFACTURE OF DUCTWORK.
43. HUMIDITY SENSOR LINE SENSOR FOR RTU-5 FURNISHED BY BUILDING CONTROLS PROVIDED. INSTALL PROBE 24" ON COLUMN. REFER TO EM DRAWINGS FOR ADDITIONAL INFORMATION.
51. MOUNT TOP OF UP DIFFUSER AT 2'-6" ALIGNED DUE TO HVAC FACE-BREAKS & VOLUME DAMPER.
52. DIMENSIONS TO CENTER OF DOOR FOR REFERENCE ONLY. COORDINATE WITH FINAL FIXTURE PLACEMENT PRIOR TO HOOD INSTALLATION.
53. LOCATION OF DAS PANEL. REFER TO ELEVATIONS OF DRAWINGS FOR ADDITIONAL INFORMATION.
56. 12X12 DUCT UP TO OPENING THRU ROOF CAPPED WITH KROGER FURNISHED EXHAUST FAN AND CURB (TYP.).
57. 12X12 DUCT UP TO OPENING THRU ROOF CAPPED WITH KROGER FURNISHED EXHAUST FAN AND CURB (TYP.).
58. REFER TO RETURN AIR WAIT REGISTER DETAIL HEM-5A SHEET MEL1 (TYP.).
59. HUMIDITY SENSOR FOR ANTI-SWEAT FURNISHED BY BUILDING CONTROLS PROVIDE INSTALL PROBE AT 24" OFF ON COLUMN. REFER TO EM DRAWINGS FOR ADDITIONAL INFORMATION.
60. 10X10 DUCT UP TO OPENING THRU ROOF CAPPED WITH KROGER FURNISHED EXHAUST FAN AND CURB (14X14).
69. PROVIDE FIRE DAMPER IN TRANSFER DUCTWORK.
70. REFER TO TRANSFER GRILLE INSTALLATION DETAIL HEM-1 ON SHEET MEL1 (TYP.).
72. IF STAINLESS STEEL DUCT NATURAL DRAFT PER NFPA 96 FOR TOXTILA MUSTARD FIRED WOOD. TO BE USED FOR MANUFACTURER'S INSTRUCTIONS.

STATE OF TEXAS
GEORGIA LONNEMANN HOL
85060
LICENSED
MECHANICAL ENGINEER

CR architecture + design
creating outstanding places
www.crarchitecture.com
972.490.9049

CONSULTANTS

KCPES LONNEMANN HOL ENGINEERS, PLLC
MECHANICAL ELECTRICAL PLUMBING
Cincinnati 1335 Jessamine Pkwy, Suite 110 Fort Thomas, KY 41075 859-572-8280
Columbus 1500 Lake Shore Drive, Suite 210 Columbus, OH 43204 614-486-0900

OWNER

Kroger

ISSUED FOR:
04/22/2014 90% OWNER REVIEW
05/16/2014 BID/PERMIT ISSUE

PROJECT TITLE
KROGER STORE
SW572

FM 407 & McMahan Road
Barton-lle, TX 78004

COMMISSION NO. 51040
ISSUE DATE 05/16/14
SHEET TITLE
HVAC FLOOR PLAN - EAST

SHEET NO.
M1.1a

THIS DOCUMENT IS THE PROPERTY AND CREATED UNDER PROPRIETY OF CR ARCHITECTURE + DESIGN. THIS DOCUMENT MAY NOT BE REPRODUCED IN ANY FORM OR MANNER WITHOUT WRITTEN PERMISSION OF CR ARCHITECTURE + DESIGN.

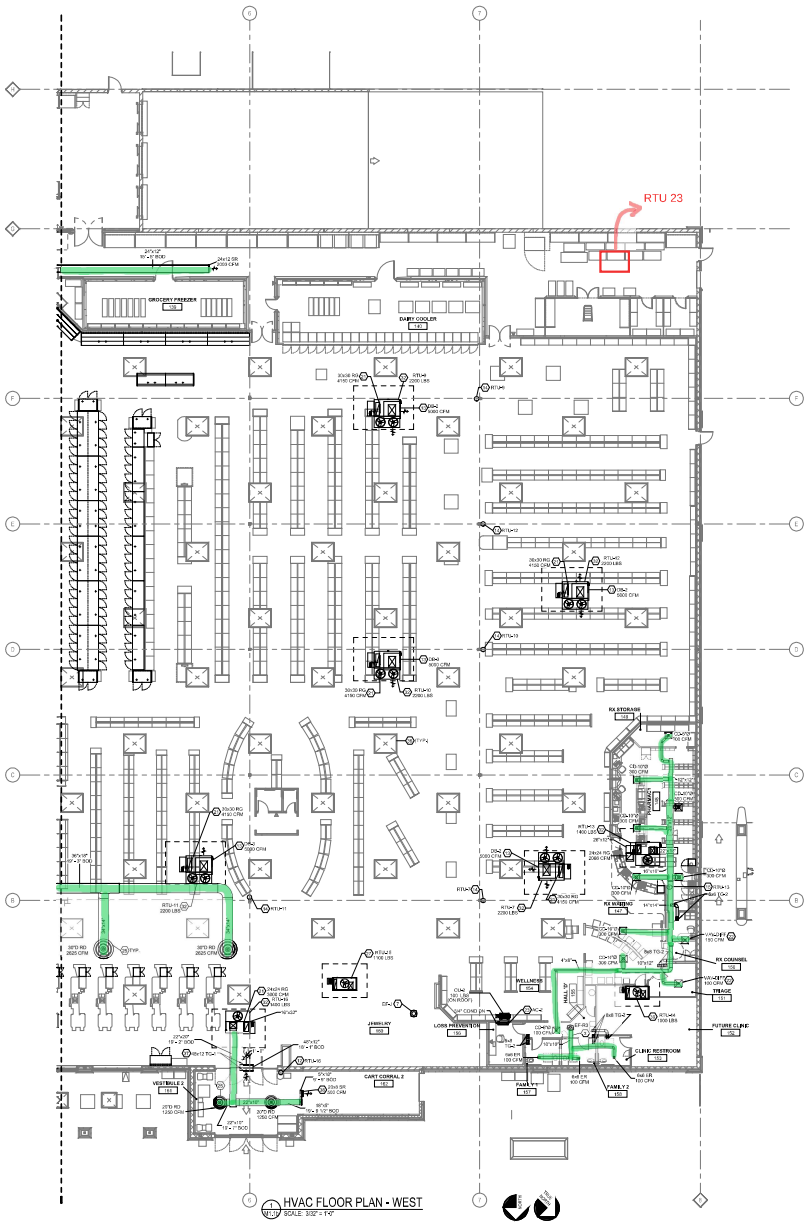

1 HVAC FLOOR PLAN - WEST
SCALE: 3/32" = 1'-0"

GENERAL NOTES

A. WHERE TO INSTALL VENTS, GRILLS, AND CONSULTING SPECIFICATIONS AND DRAWING CONFERENCE FOR ADDITIONAL REQUIREMENTS.
B. ALL DIFFUSERS AND CEILING GRILLS SHALL BE COORDINATED WITH ALL OTHER TRADES AND PROVIDED BY MECHANICAL CONTRACTOR. SEE SCHEDULE SHEET M0.1.
C. PROVIDE MAXIMUM DAMPERS ON EACH DIFFUSER, REGISTER AND GRILLE AT POINTS OF SUPPLY, RETURN, AND EXHAUST SYSTEMS WHERE DUCTS ARE TAPPED OFF MAIN TRUNKS. WHERE DIFFUSERS AS REQUIRED FOR OPTIMUM AIRFLOW, INSTALL AT A MINIMUM OF TWO DUCT LENGTHS FROM BRANCH TAKEOFF WHERE PRACTICAL. REFER TO HVAC-01 SHEET M0.1.
D. NO PROVISION HAS BEEN MADE FOR RETURN AIR FROM THE BACK OF THE SALES AREA. THE ARCHITECT HAS DESIGNED THE CONSTRUCTION TO ALLOW AIR TO FLOW FROM AREA ADJACENT TO LEAKAGE IN AN AMOUNT EQUAL TO THAT SUPPLIED.
E. ALL DIFFUSERS, REGISTERS AND GRILLES ARE INCLUDED IN GARNER DIRECT BUY PROGRAM AND SHALL BE PROVIDED BY OWNER AND INSTALLED BY HVAC CONTRACTOR, UNLESS OTHERWISE NOTED.
F. ALL HVAC DUCT SMOKE DETECTORS ARE SHOWN ON ELECTRICAL DRAWINGS.
G. REFER TO RTU SCHEDULE SHEET M0.1 FOR ROOFTOP UNIT INFORMATION.
H. PROVIDE AND INSTALL BACKDRAFT DAMPERS FOR NON-KITCHEN EXHAUST FANS. SEE SPECIFICATIONS FOR ADDITIONAL INFORMATION.
I. THE STORE'S MECHANICAL DESIGN SHALL BE TUNED TO OBTAIN ENERGY STAR CERTIFICATION.
J. ALL DUCTWORK SHALL BE ATTACHED FROM ROOFTOP UNITS TO BE INTERNALLY INSULATED A MINIMUM OF TEN FEET FOR SOUND ATTENUATION. SEE DETAIL HVAC-0, SHEET M0.1.
K. REFER TO ROOFTOP UNIT CURB DETAILS, SHEET M1.1 FOR ROOFTOP UNIT CURB INSTALLATION.
L. ALL DUCTWORK SHALL BE SEALED TO SMACNA LEAK METHOD B SEAL ONLY. FITTING REQUIRED FOR THE OPERATION OF THE ELEVATOR AREA ALLOWED TO BE JOIN PASS THROUGH THE ELEVATOR EQUIPMENT ROOM.
M. ALL DIFFUSERS ARE 4-WAY UNLESS OTHERWISE INDICATED. REFER TO DIFFUSER SCHEDULE.
N. RUNOUTS TO STRAIGHT DIFFUSERS ARE THE SAME SIZE AS THE DIFFUSER NECK UNLESS NOTED OTHERWISE.
O. REFER TO FLEXIBLE DUCTWORK INSTALLATION DETAIL HVAC-0 ON SHEET M0.1.

KEYED NOTES

2. TIE TO DUCT UP TO OPENING THRU ROOF CAPPED WITH KROGER FURNISHED EXHAUST FAN AND CURB INFO.
7. KROGER FURNISHED HFAN ON ROOF FOR JEWELRY STORE. INSTALL FAN ON ROOF. CAP ROOF OPENING IN CEILING SPACE FOR TENANT FIT OUT TO COMPLETE.
12. TEMPERATURE SENSOR FOR ROOFTOP UNIT FURNISHED BY BUILDING CONTROL PROVIDER. MOUNT SENSOR AT 54" AFF. REFER TO DM SERIES OF DRAWINGS FOR ADDITIONAL INFORMATION.
13. DROP BOX DIFFUSER SYSTEM. REFER TO DIFFUSER SCHEDULE FOR AREA NECK SUMMERS AND QUANTITIES. REFER TO FLANGE AND RISER DETAILS ON HVAC-0, SHEET M0.1 FOR ADDITIONAL INFORMATION.
14. THERMOSTAT FURNISHED BY KROGER MOUNTED TO TEMPERATURE BUILDING CONTROL PROVIDER, ROUTE CONTROL WIRING THROUGH STUD AND BACK TO BUILDING CONTROL PANEL. MOUNT SENSOR 54" AFF IN SALES FLOOR AREA.
15. SUPPLIED THROUGHOUT FURNISHED BY BUILDING CONTROL PROVIDER, SUPPLIED THROUGHOUT INSTALLED BY HVAC. REFER TO DM SERIES OF DRAWINGS FOR ADDITIONAL INFORMATION.
17. RETURN AIR FLEXIBLE DUCT DROP. TYPICAL 90' RIGHT UNDER OPENINGS OR EQUAL. REFER TO HVAC-1, SHEET M0.1.
20. MECHANICAL CONTRACTOR TO PROVIDE WIRE DIAGRAM, ACCUFIRM THERMAFORE SCOTS, TFHC-CR DESIGN INSTALL.
23. MOUNT TOP OF DIFFUSER EVEN WITH LEFT BEAM. USE 90° TO CONDENSER UNIT. PER MANUFACTURER'S SLIDE INSTALL ROUTE 3/4" INSULATED CONDENSATE TO HUB DRAIN IN AREA. REFER TO HVAC SPLIT SYSTEM DIAGRAM HSD-1 ON SHEET M0.1.
25. MOUNT TOP OF DIFFUSER EVEN WITH LEFT BEAM. USE 90° TO CONDENSER UNIT. PER MANUFACTURER'S SLIDE INSTALL ROUTE 3/4" INSULATED CONDENSATE TO HUB DRAIN IN AREA. REFER TO HVAC SPLIT SYSTEM DIAGRAM HSD-1 ON SHEET M0.1.
26. KROGER FURNISHED ROOFTOP UNIT FOR JEWELRY SPACE. CAP ROOF OPENINGS FOR TENANT FIT OUT TO COMPLETE.
27. KROGER FURNISHED ROOFTOP UNIT FOR LOSS PREVENTION INSTALLED BY MECHANICAL CONTRACTOR. HVAC CONTRACTOR TO SCHEDULE INSTALL BALANCE TO SCHEDULED CFM. REFER TO MOUNTING DETAIL, SHEET M0.1.
28. BY LIGHT SHOWN FOR COORDINATION.
37. CENTER TRANSFER GRILLE ABOVE DOOR. CONTRACTOR TO REUSE EXISTING GRILLE.
38. SUPPLY REGISTER TO BE MOUNTED IN CART CORRAL SOFFIT.
39. KROGER FURNISHED ROOFTOP UNIT FOR FUTURE TEC INSTALLED BY MECHANICAL CONTRACTOR. CAP ROOF OPENINGS FOR TENANT TO COMPLETE ENTIRELY FIT OUT.


STATE OF TEXAS
GEORGETA LONNEMANN
85060
LICENSED
PROFESSIONAL ENGINEER

CONSULTANTS
KOPRES LONNEMANN HDL ENGINEERS, PSC
MECHANICAL • ELECTRICAL • PLUMBING

OWNER
Kroger

ISSUE/REVISION	DATE
90% OWNER REVIEW	04/22/2014
BID/PERMIT ISSUE	05/16/2014

PROJECT TITLE
KROGER STORE SW572
RM 620 & McMillan Road
Barton-Ville, TX 78024

COMMISSION NO. 51040
ISSUE DATE 05/16/14
SHEET TITLE
HVAC FLOOR PLAN - WEST

SHEET NO.
M1.1b

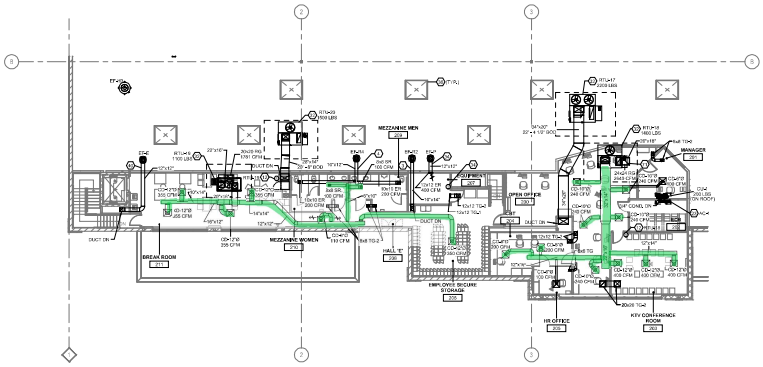

1 HVAC MEZZANINE PLAN
SCALE: 3/32" = 1'-0"

GENERAL NOTES

A. REFER TO HEATING, VENTILATING & AIR CONDITIONING SPECIFICATIONS AND GENERAL CONDITIONS FOR ADDITIONAL REQUIREMENTS.
B. DUCTWORK, PIPING AND CEILING GRILLES SHALL BE COORDINATED WITH LIGHTING AND WERE PROVIDED BY MECHANICAL CONTRACTOR, SEE SCHEDULE SHEET M6.2.
C. PROVIDE BALANCING DAMPERS FOR EACH DIFFUSER, REGISTER AND GRILLE AT POINTS ON SUPPLY, RETURN, AND EXHAUST SYSTEMS WHERE DUCTWORK BRANCHES FROM MAIN DUCTS. PROVIDE DIFFUSERS AS REQUIRED FOR AIR BALANCING, INSTALL AT A MINIMUM OF TWO DUCT WYES FROM BRANCH TAKEOFF WHERE POSSIBLE, SEE DETAIL HS3A, SHEET M6.1.
D. ALL DUCTWORK SHALL BE SEALED FOR SECTION 23 PRIOR THE BACK ROOM AS IT HAS BEEN OUR EXPERIENCE THAT ACCEPTABLE CONDITIONS TO BE ENJOYED IN THIS AREA RESULTS IN LEAKAGE IN AN AMOUNT EQUAL TO THAT SUPPLIED.
E. ALL DIFFUSERS, REGISTERS AND GRILLES ARE INCLUDED IN OWNERS DIRECT BUY PROGRAM AND SHALL BE PROVIDED BY OWNER AND INSTALLED BY HVAC CONTRACTOR, UNLESS OTHERWISE NOTED.
F. ALL HEAD DUCT SMOKE DETECTORS ARE SHOWN ON ELECTRICAL PLANS, SEE E1.1.
G. REFER TO M7.0 SCHEDULE SHEET M6.2 FOR ROOFTOP UNIT INFORMATION.
H. CONTRACTOR INSTALL SAND CRAFT BARRIERS FOR ROOFTOP UNITS WHEN POWER FIBERGLASS SPECIFICATIONS FOR ADDITIONAL INFORMATION.
I. THE STORE'S MECHANICAL DESIGN SHALL BE SUBMITTED TO EARN ENERGY STAR CERTIFICATION.
J. PROVIDE SEISMIC RESTRAINT BRACKETS FROM ROOFTOP UNITS TO BE INSTALLED BY MECHANICAL CONTRACTOR, SEE DETAIL HS3A, SHEET M6.1.
K. REFER TO ROOFTOP UNIT CURB DETAILS, SHEET M6.1 FOR ROOFTOP UNIT CURB INSTALLATION.
L. ONLY ITEMS REQUIRED FOR THE OPERATION OF THE ELEVATOR ARE ALLOWED TO BE IN OR PASS THROUGH THE ELEVATOR EQUIPMENT ROOM.
M. ALL DIFFUSERS ARE 24X24 UNLESS OTHERWISE NOTED, REFER TO HS4.1 ON SHEET M6.2.
N. RUNOUTS TO CEILING DIFFUSERS ARE THE SAME SIZE AS THE DIFFUSER NECK UNLESS NOTED OTHERWISE.
P. REFER TO HS4.1 AND DESIGN "RECTANGULAR" BRACKET DETAIL HS5-13 ON SHEET M6.1.

KEYED NOTES

3 18X18 DUCT UP TO OPENING THRU ROOF CAPPED WITH KROGER FURNISHED EXHAUST FAN AND CURB TO MATCH.
4 18X12 DUCT UP TO OPENING THRU ROOF CAPPED WITH KROGER FURNISHED EXHAUST FAN AND CURB TO MATCH.
12 TRAPPING LOW DRAIN FROM ROOFTOP UNIT FURNISHED BY BUILDING OWNER, INSTALLED BY MECHANICAL CONTRACTOR, REFER TO SH SERIES OF DRAWINGS FOR ADDITIONAL INFORMATION.
23 KROGER FURNISHED SPLIT SYSTEM PROVIDED WITH LOW AMBIENT KIT AND WIND BAFFLES AS PER OUR SPECIFICATIONS, MANUFACTURER'S RECOMMENDATIONS, YOURS INTERMIXAT LINES THRU ROOF TO INDOOR UNIT, SEE MECHANICAL PLAN FOR LOCATION OF INDOOR UNIT, INSULATED CONDENSATE TO BE DRAIN IN AREA, REFER TO HVAC SPLIT SYSTEM DIAGRAM HS5-11 ON SHEET M6.1.
32 ROOFTOP UNIT FURNISHED BY KROGER AND INSTALLED BY MECHANICAL CONTRACTOR, REFER TO SCHEDULE SHEET M6.2 BALANCE TO SCHEDULED CFM, REFER TO VENT BLOC TABLE SHEET M6.1.
34 10"X10" DUCT UP TO OPENING THRU ROOF CAPPED WITH KROGER FURNISHED EXHAUST FAN AND CURB TO MATCH, INSTALL WITH KROGER REFRIGERATING THERMOSTAT FOR FAN, FAN TO OVERIDE WHEN ROOM REACHES 85 DEG F.
35 SKYLIGHT SHOWN FOR COORDINATION.
40 12X12 DUCT UP TO OPENING THRU ROOF CAPPED WITH KROGER FURNISHED EXHAUST FAN AND CURB TO MATCH, INSTALL WITH KROGER REFRIGERATING THERMOSTAT FOR FAN, FAN TO OVERIDE WHEN ROOM REACHES 85 DEG F.
71 REFER TO DUCTED RETURN REGISTER DETAIL HS2 ON SHEET M6.1 (TYP).

STATE OF TEXAS
JOHN PAUL LOHNEMANN
85060
LICENSED
PROFESSIONAL ENGINEER

CR architecture + design
creating outstanding places
www.crarchitecture.com
CR1406/0040

CONSULTANTS

KJH
KOPPES LOHNEMANN HDL ENGINEERS, PSC
MECHANICAL • ELECTRICAL • PLUMBING

OWNER

Kroger

ISSUE/REVISION DATE
04/22/2014
90% OWNER REVIEW
05/16/2014
REDISPLAY ISSUE

PROJECT TITLE
KROGER STORE
SW572

FM 407 & McMillan Road
Barton-lle, TX 75024

COMMISSION NO. 51040
ISSUE DATE 05/16/14
SHEET TITLE
HVAC
MEZZANINE
PLAN

SHEET NO.
M1.1c

© Copyright Kopper Lohnemann Inc.

THIS DOCUMENT IS THE PROPERTY AND CONTAINS PROPRIETARY INFORMATION. REPRODUCTION OF THIS DOCUMENT MAY NOT BE REPRODUCED IN ANY FORM WITHOUT WRITTEN CONSENT OF CR DESIGN, PLANNERS, ARCHITECTS, INC.
THIS DOCUMENT IS THE PROPERTY OF CR DESIGN, PLANNERS, ARCHITECTS, INC. AND MAY BE USED FOR THIS PROJECT ONLY. THIS DOCUMENT MAY NOT BE REPRODUCED WITHOUT THE EXPRESS CONSENT OF CR DESIGN, PLANNERS, ARCHITECTS, INC.
CR1406/0040 © 2014 CR