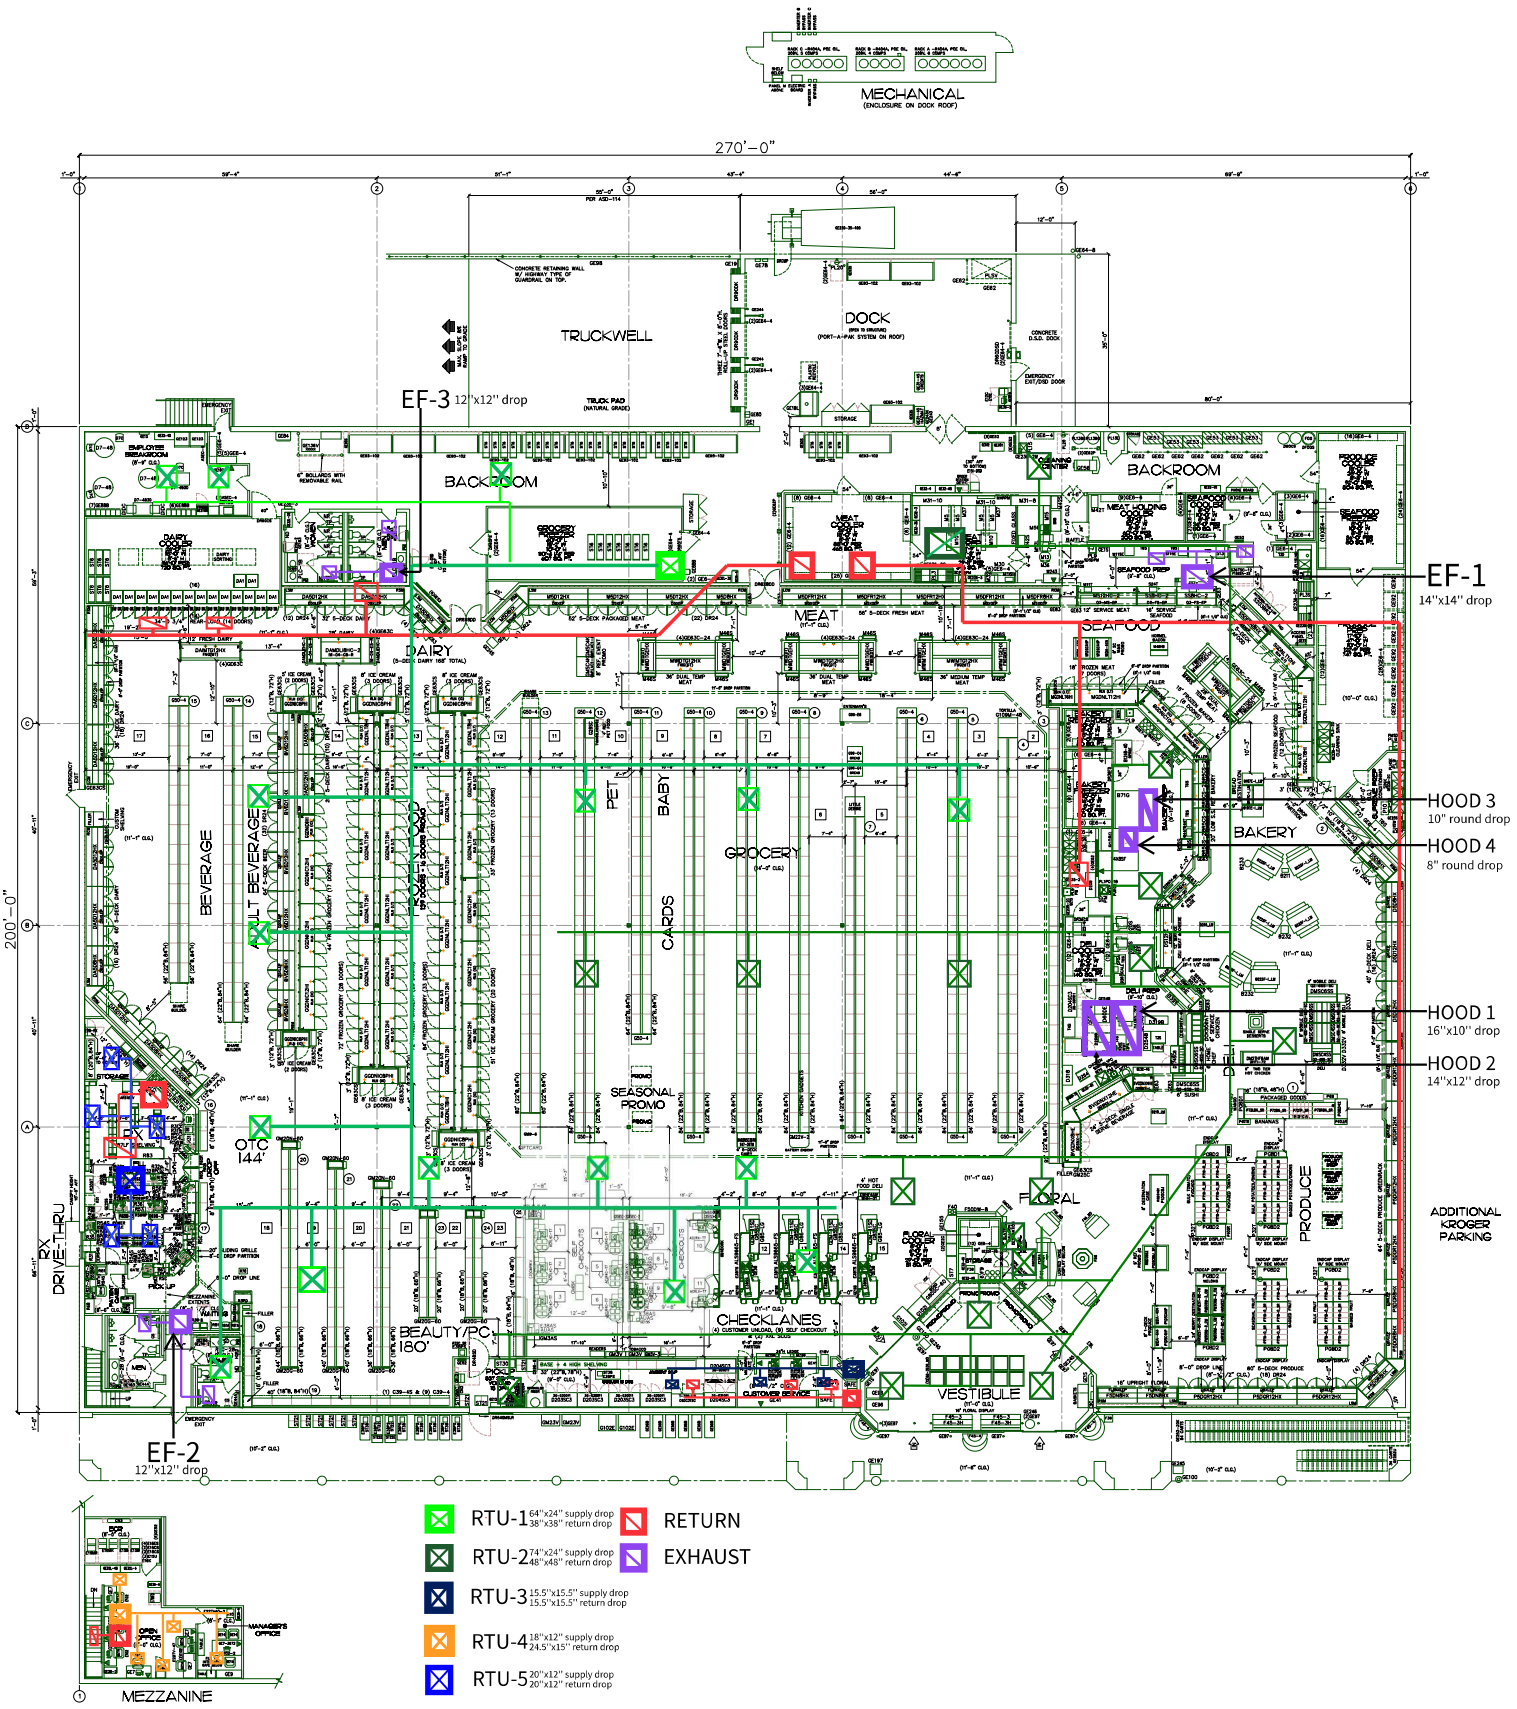
MECHANICAL
(ENCLOSURE ON DOCK ROOF)
270'-0"
200'-0"
TRUCKWELL
DOCK
EF-3 12"x12" drop
BACKROOM
BACKROOM
EF-1
14"x14" drop
MEAT
SEAFOOD
DAIRY
HOOD 3
10" round drop
HOOD 4
8" round drop
BAKERY
GROCERY
BEVERAGE
SALT BEVERAGE
PET
BABY
CARDS
HOOD 1
16"x10" drop
HOOD 2
14"x12" drop
SEASONAL PROMO
OTC
144'
FLORAL
PRODUCE
ADDITIONAL KROGER PARKING
DRIVE-THRU
BEAUTY/PC
180'
CHECKLANES
(4) CUSTOMER UNLOAD, (9) SELF CHECKOUT
VESTIBULE
CUSTOMER SERVICE
EF-2
12"x12" drop
MEZZANINE
MANAGER'S OFFICE
RTU-1 64"x24" supply drop 38"x38" return drop
RTU-2 74"x24" supply drop 48"x48" return drop
RTU-3 15.5"x15.5" supply drop 15.5"x15.5" return drop
RTU-4 18"x12" supply drop 24.5"x15" return drop
RTU-5 20"x12" supply drop 20"x12" return drop
RETURN
EXHAUST