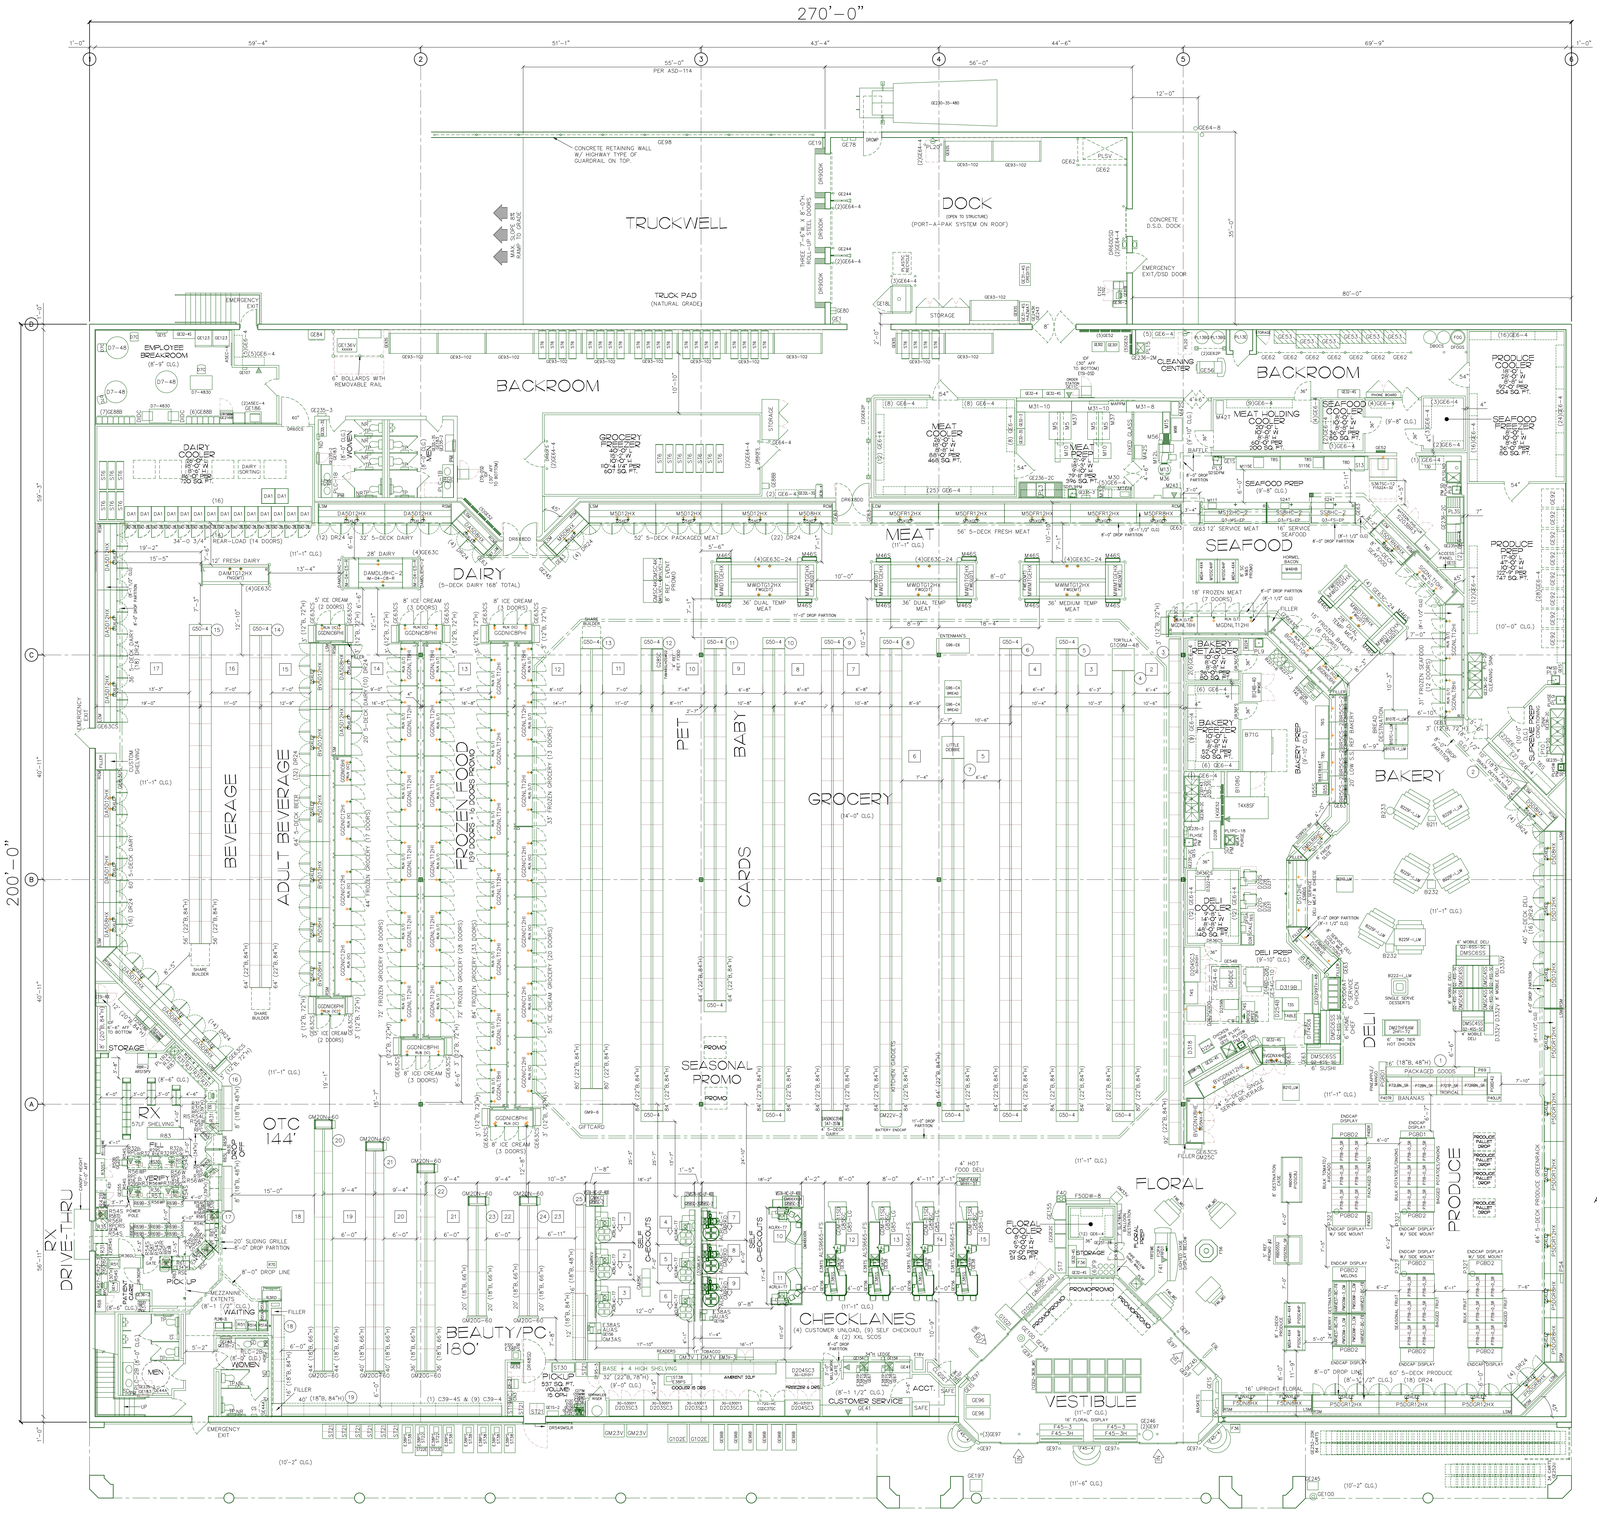

This File was Created on 5/1/2025 @ 3:39:58 PM

ADMINISTRATIVE

1	ASD-4	BANQUET CHAIR
2	ASC-4	4' CORK BULLETIN BOARD (EXCLUDED)
3	ACLR4C-TT	TD5H1BA ST SCS L-R W/ 4 BAG CARDUSEL ON RIGHT
4	ACLR4C-TT	TD5H1BA ST SCS L-R W/ 4 BAG CARDUSEL ON RIGHT
5	ACRL4C-TT	TD5H1BA ST SCS R-L W/ 4 BAG CARDUSEL ON LEFT
6	ACRL4C-TT	TD5H1BA ST SCS R-L WITH WAL BAGGING AREA ON LEFT
7	CB6W4	POS EQUIPMENT FOR SCS ATTENDANT STATION
8	CB6W4	POS EQUIPMENT FOR SCS ATTENDANT STATION
9	CSM3S	SCANNER/SCALE (NO DISPLAY)
10	CSM3S	SCANNER/SCALE (NO DISPLAY) (DISCONTINUED)
11	CSM3T2	TOUCHSCREEN POS (FOR DEM MOUNT)
12	CE1CT	BIOMETRIC READER FOR T&A
13	CE1CT	BIOMETRIC READER
14	CE7BL	CT7 PIN PAD & CONTACT CARD READER
15	CE2TS	SHREDDER
16	CE3W-2	FILE CABINET (2-DRAWER VERTICAL)
17	CE3W-4	FILE CABINET (4-DRAWER VERTICAL)
18	CE3BS	TOUCHSCREEN POS WITH STAND
19	CE4TS	12" PAPER SHREDDER/CHIPPER
20	CE5T	MONEY ORDER MACHINE (VENDOR SUPPLY)
21	CE7-D672	MANAGERS DESK
22	CE8	CHAIR
23	CE9	CREDENZA

ARCHIVE

1	ACRL4C-T	TD5H1BA W/ 4 BAG CARDUSEL ON LEFT (DEACTIVATED)
2	ALC9A45-FS	ENTERPRISE STS (BQUNTICL)/NCR FM-6P (ANDIDEACTIVATED)
3	BA4T	SERVICE DESK/PRE-PRINTER (TILESED)
4	BA4T	SERVICE DESK/PRE-PRINTER (TILESED) (DEACTIVATED)
5	BB5S	BREAD SLICER STAND (DEACTIVATED)
6	BB5S	BREAD SLICER STAND (DEACTIVATED)
7	CZR-4S	4' BEAUTY CARE LIGHT VALANCE (STATION)
8	CZR-4	4' BEAUTY CARE LIGHT VALANCE
9	DT-4R2D-208	DESK TOP PRINTER (PRINTS ONTO W/ STAND (FORD)
10	DS5T	SERVICE DESK/PRE-PRINTER (TILESED (DEACTIVATED)
11	DT-4R3D	48" X 30" TABLE
12	DT-4R3D	48" X 30" TABLE (ADA)
13	DT5C	CHAIR
14	DI3C	FONT ARMLESS DINING CHAIR
15	EC4-4	4' ENERGY CONTROL CABINET
16	EC7C	EAS CONTROLLER (MOUNT 8 12' AFF TO TOP)
17	EN4	EAS KEYPAD (TWIST PANEL)
18	EN4	EAS KEYPAD (TWIST PANEL)
19	FS2W-B	4' BULLSEYE WALL DISPLAY FIXTURE (DEACTIVATED)
20	GR5-LG	LARGE STS CHECKSTAND MERCHANDISER FOOTPRINT
21	GE1B	30"X60" TABLE (LIFT-HAND HINGED (FORD)
22	GE1B	DOUGHOLL LADDER
23	GE1S	SIGNCE FLY ZAPPER (AREAS IN CUSTOMER VIEW)
24	GE1SBK	SIGNCE FLY ZAPPER (BACK)
25	GE3	ELECTRIC SERVICE ENTRANCE
26	GE3H-6	6' ST EXHAUST HOOD
27	GE4C	4' ENERGY CONTROL CABINET
28	GEAC6	CORNER GUARD (TILEBASED)
29	GE7B	EQUIPMENT CHARGING STATION
30	GH2-4	4' GRAPHIC HANGER
31	GH5G-60	APNR GRAPHIC ENDCAP (60" X)
32	GM5DN-60	NARROW STC ENDCAP (60" X)
33	GM5V-2	2' CIGARETTE FIXTURE (DEACTIVATED)
34	GM5V-3	3' CIGARETTE FIXTURE (DEACTIVATED)
35	GMW4S	TD5H1BA RIGHT 3'/4 BAG SCO SHELVING KIT (6" SPACING)
36	H1L	AUTO-ROLLER W/4BOTTLE SCALE/LIFT TO RIGHT
37	H1L	AUTO-ROLLER W/4BOTTLE SCALE/LIFT TO RIGHT
38	M13	ROTARY BIN FOR AUTO-ROLLER
39	M13	ROTARY BIN FOR AUTO-ROLLER
40	M30	3' SLICER TABLE
41	M31-10	10' MEAT CONVEYOR
42	M35	5' MEAT CONVEYOR
43	M36	6' LABEL HOLDER (MOUNT MEAT TRAY RACK)
44	M37	6' DELIVERY MOUNT MEAT TRAY RACK
45	M38	6' LABEL HOLDER (MOUNT MEAT TRAY) (DEACTIVATED)
46	M3M	CAS LABEL APPLIER (MOUNT)
47	PL1B	30"X60" TABLE
48	PL1CE	WATER HEATER (ELECTRIC)
49	PL1S	SLOP SINK W/STRAINER (3 SIDES)
50	PL1S-NO	SLOP SINK W/STRAINER (3 SIDES)(NO-USED)
51	PL1S	3 COMPARTMENT SEAFOOD SINK (39" DB)
52	PL3	3 COMPARTMENT SINK (36" DB)
53	PL3	3 COMPARTMENT SINK (36" DB)
54	PL7L	TOILET
55	PL7L	TOILET
56	PL8	DROP-OFF COUNTER (LEFT HAND) (DEACTIVATED)
57	PL8	DROP-OFF COUNTER (RIGHT HAND) (DEACTIVATED)
58	PL9	4' SIGNATURE CAPTURE DEVICE
59	SZ4T	4' SERVICE DESK/PRE-PRINTER (TILESED) (DEACTIVATED)
60	SZ4T	4' SERVICE DESK/PRE-PRINTER (TILESED) (DEACTIVATED)
61	BLECC-2	LCW PROFILE BAKERY CASE LEFT END (DEACTIVATED)
62	BLECC-2	LCW PROFILE BAKERY CASE LEFT END (DEACTIVATED)
63	BRECC-2	LCW PROFILE BAKERY CASE RIGHT END (DEACTIVATED)
64	BVS10HW	10' FIXE-DECK BEVERAGE CASE (DEACTIVATED)
65	BVS10HW	10' FIXE-DECK BEVERAGE CASE (DEACTIVATED)
66	BVS6LHWH	6' FIXE-DECK BEVERAGE LEFT SLAB MIRRORED END
67	BVS6RHWH	6' FIXE-DECK BEVERAGE RIGHT SLAB MIRRORED END
68	BVS6HW	6' FIXE-DECK BEVERAGE CASE (DEACTIVATED)
69	BVS6HW	6' FIXE-DECK BEVERAGE CASE (DEACTIVATED)
70	BVS6HWHE	6FT NARROW GLASS DOOR BEVERAGE CASE (DEACTIVATED)
71	BVS6HWHE	6FT NARROW GLASS DOOR BEVERAGE CASE (DEACTIVATED)
72	BVS6HWRE	NARROW GLASS DOOR BEVERAGE RIGHT END PANEL
73	BVS3HSC3	3 DOOR DELI STORAGE REFRIG (SELF-CONT) (DEACTIVATED)
74	BVS3HSC3	3 DOOR DELI STORAGE REFRIG (SELF-CONT) (DEACTIVATED)
75	SDC8ICUW	ICOM SELF-CONTAINED BUCKSCHOLLER
76	DS2LEHW	10' FIXE-DECK DELI CASE (DEACTIVATED)
77	DS2LEHW	10' FIXE-DECK DELI CASE (DEACTIVATED)
78	DS6LDMEHW	FIXE-DECK DELI CASE LEFT SLAB MIRRORED END
79	DS6RDMEHW	FIXE-DECK DELI CASE RIGHT SLAB MIRRORED END
80	DS6HW	FIXE-DECK DELI CASE (DEACTIVATED)
81	DS6HW	FIXE-DECK DELI CASE (DEACTIVATED)
82	DA5LDMEHW	FIXE-DECK DAIRY LEFT CONTOURED MIRRORED END
83	DA5RDMEHW	FIXE-DECK DAIRY RIGHT CONTOURED MIRRORED END
84	DA5HWCH2H4	FIXE-DECK DAIRY CONTOURED BALANCED SASH (39"D)
85	DA5HWCMEHW	FIXE-DECK DAIRY RIGHT CONTOURED MIRRORED END
86	DA5HWCMEHW	FIXE-DECK DAIRY RIGHT CONTOURED MIRRORED END
87	DMC4S3	4' MOBILE SELF CONTAINED DELI CASE (DEACTIVATED)
88	DMC4S3	4' MOBILE SELF CONTAINED DELI CASE (DEACTIVATED)
89	DS8HC	8' SERVICE DELI CASE (DEACTIVATED)
90	DS12HC	SERVICE DELI LEFT PANEL END (DEACTIVATED)
91	DS12HC	SERVICE DELI RIGHT PANEL END (DEACTIVATED)
92	FT5HWHW	6' 5-DECK NARROW FLORAL CASE
93	FT5RLDMEHW	5-DECK NARROW FLORAL CASE LEFT SLAB MIRRORED END
94	FT5RRDMEHW	5-DECK NARROW FLORAL CASE RIGHT SLAB MIRRORED END
95	GB5TC	CHECKSTAND REFRIGERATED MERCHANDISER
96	GE1S4B	UPRIGHT REFRIGERATOR/FREEZER (DEACTIVATED)
97	GE1S4B	UPRIGHT REFRIGERATOR/FREEZER (DEACTIVATED)
98	GE2T	2' FIXE-DECK BEV WALL CASE (DEACTIVATED)
99	GE2T	2' FIXE-DECK BEV WALL CASE (DEACTIVATED)
100	MSDF812HW	12' FIXE-DECK FRESH MEAT CASE (DEACTIVATED)
101	MSDF812HW	12' FIXE-DECK FRESH MEAT CASE (DEACTIVATED)
102	MSDF8LDMEHW	FIXE-DECK FRESH MEAT CASE RIGHT CONTOURED MIRRORED END
103	MSDF8RDMEHW	FIXE-DECK FRESH MEAT CASE RIGHT CONTOURED MIRRORED END
104	MSDL6LDMEHW	FIXE-DECK DELI MEAT CASE RIGHT CONTOURED MIRRORED END
105	MSDL6RDMEHW	FIXE-DECK DELI MEAT CASE RIGHT CONTOURED MIRRORED END
106	MSDL6HW	FIXE-DECK DELI MEAT CASE (DEACTIVATED)
107	MSDL6HW	FIXE-DECK DELI MEAT CASE (DEACTIVATED)
108	PSDC6LDMEHW	6' FIXE-DECK PRODUCE CASE LEFT(GREENGRASS)(DEACTIVATED)
109	PSDC6RDMEHW	6' FIXE-DECK PRODUCE CASE RIGHT(GREENGRASS)(DEACTIVATED)
110	PSDC6HW	6' FIXE-DECK PRODUCE RIGHT SLAB MIRRORED END
111	R3T8	LABORATORY REFRIGERATOR (BIOMEDICAL) (DEACTIVATED)
112	R3T8	LABORATORY REFRIGERATOR (BIOMEDICAL) (DEACTIVATED)
113	TSDF8HW	FIXE-DECK SEAFOOD CASE (NO GLASS) (DEACTIVATED)
114	TSDF8ALCMEHW	FIXE-DECK SEAFOOD CASE LEFT CONTOURED MIRRORED END
115	TSDF8ARCMEHW	FIXE-DECK SEAFOOD CASE RIGHT SLAB MIRRORED END

BAKERY

1	B100	AIR BRUSH W/COMPRESSOR
2	B1070-1_LM	SMALL BREAD DESTINATION DOUBLE SIDED (CENTER UNIT) (LIMBER MAPLE)
3	B1070-2_LM	SMALL BREAD DESTINATION DOUBLE SIDED (CENTER UNIT) (LIMBER MAPLE)
4	B10MW-15	GAS SINGLE RACK OVEN
5	B10MW-15	RACK FOR DOUBLE OVEN (15 PAN)
6	B11-1_LM	BAKERY MINI PIE RACK (2-3 SINGLE RACKS)
7	B11C_LM	DEDICATED BAKERY TABLE (LIMBER MAPLE)
8	B211-1_LM	BAKERY MINI PIE RACK
9	B2FP-1_LM	BAKERY MINI PIE RACK W/ TIER RISER (LIMBER MAPLE)
10	B2FP-1_LM	BAKERY MINI PIE RACK W/ TIER RISER (LIMBER MAPLE)
11	B307-2	ICING CART (2 BUCKET)
12	B307-2	ICING CART (2 BUCKET)
13	B313	CULINAL COOKIE RACK
14	B323	3 BASKET DISPLAY
15	B3-4	4 BASKET DISPLAY
16	B7_LM	BAKERY DISPLAY CART (5 OAK SLANT SHELVES) (LIMBER MAPLE)
17	BPR200	CAKE TRACING MACHINE
18	BUN6DIGH	6' NARROW GLASS DOOR ICE CREAM TEMP BAKERY (4 DOORS)
19	BUN10DIGH	10' NARROW GLASS DOOR ICE CREAM TEMP BAKERY (2 DOORS)
20	BUGRLEH	NARROW GLASS DOOR BAKERY LEFT END PANEL
21	BUGRREH	NARROW GLASS DOOR BAKERY RIGHT END PANEL

CONSTRUCTION

1	GE2H4	DOCK LIGHT (17W LED) WITH STANDARD ARM MOUNT
2	GE3B	SUB FEEDER ELECTRIC PANEL (CONTRACTOR SUPPLY)
3	GE3HC-10	10' X 5' HOOD (SEE HVAC PLAN FOR ORDERING INFO)
4	GE3HC-10	10' X 5' HOOD (SEE HVAC PLAN FOR ORDERING INFO)
5	GEAP	POST FOR LIFT DOT GUARD RAIL (CONTRACTOR SUPPLY)
6	GE4-4	4' PROTECTIVE POST (BACKROOM) (CONTRACTOR SUPPLY)
7	GE4-4B	8' PROTECTIVE POST (BACKROOM)
8	GE5-4	GUARDRAIL (HIGHWAY-TYPE)
9	PL1BG	80 GAL MAIN STORE WATER HEATER (GAS)
10	PL6S	(CONTRACTOR SUPPLIES) STC WASH STATION
11	PL7-DL	7' DOUBLE ACTION SINGLE PLASTIC DOOR (ADA LEFT)
12	PL7-DR	7' DOUBLE ACTION SINGLE PLASTIC DOOR (ADA RIGHT)
13	PL5V	SPRINKLER VALVE & RISER
14	PL9CW	9' CONDENSER WALL (SUPPLY)
15	GE13W4	(PROTOCOL COMPRESSOR (W/ENTVERTICAL)

DAIRY

1	DA5ISLEH4	DAIRY ISLAND LEFT CASE END
2	DA5ORCEH4	DAIRY ISLAND RIGHT CASE END
3	DA5MTCLEH4	10' MEDIUM TEMP DAIRY ISLAND W/GLASS
4	DA4DL18HC-2	8' MULT DAIRY ISLAND CASE (UNITIZED)
5	DA4DL18HC-2	MULT DAIRY ISLAND END CASE

DELI-CHEESE

1	DS1BP4	10FT AC WALL POWER ADAPTER FOR DELI RF3 TABLET
2	DS1PS	POT RACK (WALL MOUNT) (SET)
3	DS1PS-5	PICKUP DELI3 BACK HOT HOLDING CABINET
4	DS2CC	DELI CHEESE CUTTER
5	DS5S	DELI BUSSY SLICER STAND WITH SCALE SHELF
6	DS7S48	OVEN ROASTED CHICKEN UNLOAD CART
7	DS7S48	OVEN ROASTED CHICKEN
8	DS7S8	COMPLETE CHICKEN TENDERS BREADING CART
9	DS9	MANUAL SLICER
10	DS9TS-48	48" DELI SCALE MONITOR FOR DELI MENU BOARD KIT
11	DS9TS-84	84" DELI SCALE MONITOR FOR DELI MENU BOARD KIT
12	DS10	4' SERVICE CASE SUPPLY CART (KEY RETAILING)
13	DS11	DELI TRANSFER CART
14	DS11	DELI TRANSFER CART
15	DS3D-6	6 SHELF DELI BACK STOCK CART
16	DS3H	DELI HEAT LAMP (HANG)
17	DS3H	BSAHS HEAD CONDIMENT RACK
18	DZS-20	CHICKEN WACK FRYER CART
19	DZ7V	FRYER CHICKEN (208-240 VOLT) VERSION
20	DZ7V	RICE COOKER (VENDOR SUPPLIED)
21	DBDCS	VENDOR SUPPLIED BULK OIL COLLECTION SYSTEM FOR FRYERS
22	DFCCL	VENDOR SUPPLIED CONVECTION OVEN FOR CHICKEN (LEFT SIDE)
23	DFCCL	VENDOR SUPPLIED CONVECTION OVEN FOR CHICKEN (LEFT SIDE)
24	DWFSDC	READY FOR DELIVERY COUNTER STAND FOR SAMSUNG TABLET
25	DZ7HCCA	7' GLU-CONTAINED PIZZA MAKE-UP TABLE (DEACTIVATED)
26	DZ7HCCA	7' GLU-CONTAINED PIZZA MAKE-UP TABLE
27	DCH320A7	6FT SERVICE HOT CHICKEN CASE
28	DCH320A7	6FT SERVICE HOT CHICKEN CASE
29	DMS4WHW	4' MOBILE HOT FOOD
30	DMSLRWHC	6' FRESH SLICED MULTI DECK CASE (REMOTE)
31	DMSLRWHC	6' FRESH SLICED MULTI DECK CASE (REMOTE)
32	DMSLRREHC	RIGHT END FOR FRESH SLICED MULTI DECK CASE

DOORS

4	DR3W2L	36" LEFT HINGED COOLER DOOR (84"H)
5	DR3W2L	36" LEFT HINGED COOLER DOOR (84"H)
6	DR3W2S	STRIP DOOR FOR 36" COOLER DOOR
7	DR3W2D	3' X 7' DOUBLE ACTION DOUBLE PLASTIC DOOR
8	DR3W2R	36" RIGHT HINGED COOLER DOOR (84"H)
9	DR3W2R	3'-0" RIGHT HINGED SWITCH DOOR (DIRECT BUY)
10	DR3W2S	3' SINGLE GATE (MOLDBOX)
11	DR3W2S	STRIP DOOR FOR 36" COOLER DOOR (7'H)
12	DR3W2L	3'-0" LEFT HINGED DOOR (DIRECT BUY)
13	DR3W2R	3'-0" RIGHT HINGED DOOR (DIRECT BUY)
14	DR4W2L	4'-0" LEFT HINGED DOOR (DIRECT BUY)
15	DR4W2L	4'-0" LEFT HINGED DOOR (DIRECT BUY)
16	DR4W2R	4'-0" RIGHT HINGED DOOR (DIRECT BUY)
17	DR4W2R	4'-0" RIGHT HINGED DOOR (DIRECT BUY)
18	DR4W2D	4' X 7' DOUBLE ACTION SINGLE PLASTIC DOOR
19	DR5W2D	5' X 7' DOUBLE ACTION DOUBLE PLASTIC DOOR
20	DR5W2DLR	(LEFT) 5' X 7' DOUBLE ACTION DOUBLE PLASTIC DOOR
21	DR6W2L	60" LEFT HINGED COOLER DOOR (96"H)
22	DR6W2S	STRIP DOOR FOR 60" COOLER DOOR (8'H)
23	DR6W2D	6' X 8' DOUBLE ACTION DOUBLE PLASTIC DOOR
24	DR6W2S	STRIP DOOR FOR 60" FREEZER DOOR (8'H)
25	DR6W2D	6' X 8' DOUBLE ACTION DOUBLE PLASTIC DOOR
26	DR6W2R	6' X 8' DOUBLE ACTION DOUBLE PLASTIC DOOR
27	DR9W	COMPACTOR DOOR
174	DR24	2'-0" FRENCH DOOR (PER QUOTE)

DRUG-CW

1	DM20V-2	BATTERY ENDCAP WITH LIGHTED VALANCE (VENDOR SUPPLY)
2	DM25V	PROPANE TANK CAGE (VENDOR SUPPLY)
3	DM30V	CAGE DISPENSER BACK 48" 8'
4	DM30V	CAGE DISPENSER BACK
5	DM34V	CIGARETTE FIXTURE FOR SCO ATTENDANT STATION
6	DM4V-4	4' CIGARETTE FIXTURE (VIDEO)
7	DM9-4	4FT GIFT CARD ENDCAP

ELECTRONICS

2	EN3	FAN/COIL AC UNIT FOR ECR ROOM (13 TON)
3	E11C	4'X8' PLYWOOD (WALL MOUNT)
4	E12C	AVERY PRINTER (GENERAL USE)
5	E13CS	EDGE POE SWITCH
6	E13S-12D3	12' PATCH PANEL KIT (2ED)
7	E13S-48	18' BACKAND PORT PATCH PANEL KIT (4X3)
8	E13W	KVM W/CONTROLLER
9	E13W6	6' PATCH PANEL 48 PORT PATCH PANEL, MSF BASE KIT
10	E13W6	6-POST MSF RACK
11	E13W	2-POST MSF RACK
12	E13W	2-POST MSF RACK
13	E20TV-47	VIDEOR 47"
14	E20TV-47	LCD VIDEOWORK (47")
15	E20TV-2	2 LCD VIDEOWORK MONITORS TV
16	E4	MFP (FAX PRINTER COPIER SCANNER)
17	E7WC3	CDM PRINT SCAN MFD
18	GE100-2	PC & MONITOR

FLORAL

1	F10PA	10FT AC WALL POWER ADAPTER FOR FLORAL RF3 TABLET
2	F3G	FLORAL WATERING SYSTEM (10 GALLON PORTABLE)
3	F4-4	4' PROTECTIVE POST (BACKROOM)
4	F4S	CUSTOM WILLIAMS COOLER (CONTRACTOR SUPPLY)
5	F4S-2	2 TIER OUTDOOR FLORAL DISPLAY
6	F4S-4	4 TIER OUTDOOR FLORAL DISPLAY
7	F4S-4D	4TIER (2 DEAND SET) FLORAL HOLADER DISPLAY
8	F5-4	4' PROTECTIVE POST (BACKROOM)
9	F5W	FLORAL CONSUMER BUNCH DISPLAY
10	F6W	FLORAL CONSUMER BUNCH DISPLAY
11	FWF3T	SAMSUNG TABLET FOR FLORAL READY FOR DELIVERY KIT
12	FWF3WC	READY FOR DELIVERY WALL ENCLOSURE FOR SAMSUNG TABLET

GENERAL

1	C5	SAFE-SITTER CHILD PROTECTION SEAT
2	GE100	OPEN TOP DOME TRASH CONTAINER 15 GALLON
3	GE100	OPEN TOP DOME TRASH CONTAINER 15 GALLON
4	GE153	VENDING MACHINE (VENDOR SUPPLY)
5	GE155	COIN COUNTER (VENDOR SUPPLY)
6	GE156	MICROWAVE AND HOOD CABINET
7	GE186	MICROWAVE
8	GE197	OUTDOOR TRASH CONTAINER
9	GE2-4	4' PROTECTIVE POST (DEEP AND AREAS IN CUSTOMER VIEW)
10	GE2	FLY ZAPPER (SEDU/ BACKDOR HALLWAY)
11	GE230-35-480	35 (SUCT) YARD MOBILE COMPACTOR & MECEIVER (480 VOLT)
12	GE2S-2	2 LEVER SPRAY DOWN PROPORTIONER (VENDOR SUPPLY)
13	GE2S-2	2 LEVER SPRAY DOWN PROPORTIONER (VENDOR SUPPLY)
14	GE2S-3	3 LEVER SPRAY DOWN PROPORTIONER (VENDOR SUPPLY)
15	GE2S-4	4 LEVER SPRAY DOWN PROPORTIONER (VENDOR SUPPLY)
16	GE2W-PM	2 BUTTON PROPORTIONER FOR MOP SINK (VENDOR SUPPLY)
17	GE243	HAZMAT CONTAINMENT TOTE
18	GE3-4	4' ENERGY CONTROL CABINET (VENDOR SUPPLY)
19	GE4HL	BAG RECYCLE BIN (VENDOR SUPPLY)
20	GE5T3-18	18" MOP & BROOM HOLDER (PREP AREAS)
21	GE5T3-18K	18" MOP & BROOM HOLDER (CLN. CAPACITY)
22	GE7DU	URINA BAGSMART
23	GE301	INSTANT LOTTERY TICKET VENDING MACHINE
24	GE3C	CHAIR (ADA)
25	GE30	COOLER DAKE CLEANER
26	GE4	4' ENERGY CONTROL CABINET (CONTRACTOR SUPPLY)
27	GE4AA	BABY CHANGING STATION
28	GE4CC-24	PROTECTIVE CORNER GUARD
29	GE4CC-4	PROTECTIVE CORNER GUARD
30	GE4S	REMOVABLE PROTECTIVE POST (SALES AREA)
31	GE6-3	3' SIGNATURE CAPTURE
32	GE6B	DISPLAY BRACKETS
33	GE6BB	LOCKER (3 TIER/LOUVERED DOORS)
34	GE6C	CHAIR
35	GE9A	ELECTRONIC SHOPPING CART (REAR DRIVE)
36	GE9E	ELECTRONIC SHOPPING CART (FRONT DRIVE)
37	GH2	2' GRAPHIC HANGER POST
38	GH2	STEEL HANGER
39	H	COAT HOOK (BY PARTITION SUPPLIER)
40	H1	HOOK (BY PARTITION SUPPLIER)
41	NE	SANITARY NAPKIN DISPENSER, RECEPTACLE
42	PM	MECHANICAL PAPER TOWEL DISPENSER (VENDOR SUPPLY)
43	PM	PAPER TOWEL DISPENSER (VENDOR SUPPLY)
44	TP	TOILET PAPER DISPENSER (VENDOR SUPPLY)
45	TR	TRASH RECEPTACLE

GROCERY

2	G10DT	PRIMO WATER BOTTLE RETURN (EXTERIOR DISPLAY)
3	G10DT	PRIMO WATER (INSIDE DISPLAY)
4	G10M-48	TORTILLA END CAP
5	G1CM-4_MD	4' CHRISTMAS END CAP (MID-MONTH) (MILLENIUM DAY)
6	G1D-4	4' UNIVERSAL END DISPLAY (DF2)
7	G1N-C4	COMMERCIAL BAKERY 4 WAY UPRIGHT DISPLAY
8	G1N-C4	COMMERCIAL BAKERY 4 WAY UPRIGHT DISPLAY
9	GM4SHVR	TD5H1BA STORE RIGHT 4FT SLIDE 48" SHELVING KIT
10	GM4SHVLR	TD5H1BA STORE 7 LEFT (ENTRY VIA) SLIDE SHELVING KIT
11	GM5V	TD5H1BA STORE 7 LEFT (ENTRY VIA) SLIDE SHELVING KIT
12	GM5V	TD5H1BA SYSTEM 7 RIGHT 4 BAG SCO LIFT SHELVING KIT-V
13	GM8V	TD5H1BA SYSTEM 7 RIGHT 4 BAG SCO LIFT SHELVING KIT-V
14	GM9V	9' CIGARETTE FIXTURE (DEACTIVATED)
15	GR5DC-60	60 SQ. FT. (MERCHANDISER (5.5 C.F.)
16	GR5DSC-8	CHECKSTAND REFRIGERATED MERCHANDISER
17	GS1DSC-4	4' CIGARETTE FIXTURE (VENDOR SUPPLY) (DEACTIVATED)
18	GS2DSC1SH1	6' NARROW GLASS DOOR SIDE ICE CREAM TEMP GROCERY (5 DOORS)
19	GS2DSC1SH1	6' NARROW GLASS DOOR SIDE ICE CREAM TEMP GROCERY (2 DOORS)
20	GS2DSC1SH2	6' NARROW GLASS DOOR SIDE ICE CREAM TEMP GROCERY
21	GS2DSC1SPH2	6' NARROW GLASS DOOR GROCERY PRIMO (1 DOOR)
22	GS2N_EH	NARROW GLASS DOOR GROCERY LEFT END PANEL
23	GS2N_EH1	6' NARROW GLASS DOOR SIDE ICE CREAM TEMP GROCERY (5 DOORS)
24	GS2N_EH1	6' NARROW GLASS DOOR SIDE ICE CREAM TEMP GROCERY (3 DOORS)
25	GS2NREH1	NARROW GLASS DOOR GROCERY RIGHT END PANEL

MEAT

1	M10	MEAT-SPW
2	M10	ENERGY EFFICIENT WRAPPER (TABLE TOP)
3	M2W3	MEAT LIGHT VALANCE
4	M2W3	MEAT LIGHT CAMP
5	M3C	MANUAL SLICER
6	M3C	MANUAL SLICER
7	M4ST	TALL MEAT CART
8	M4W3-B	MEAT LIGHT VALANCE
9	M9B	MEAT (TOTES) BACKN FIXTURE (VENDOR SUPPLIED)
10	M4PPM	AUTOMATED PRODUCTION PLANNING MONITOR KIT
11	M5DL6HW	6' FIXE-DECK MEAT CASE LEFT SLAB MIRRORED END
12	M5DL6LEH1	NARROW GLASS DOOR MEAT LEFT END PANEL
13	M5DL7LEH1	10' NARROW GLASS DOOR SIDE ICE TEMP MEAT (5 DOORS)
14	M5DL7HW	7' FIXE-DECK MEAT CASE (NO GLASS) (DEACTIVATED)
15	M5DRE6H1	6' NARROW GLASS DOOR MEAT RIGHT END PANEL
16	M5LH6-C	10' SERVICE MEAT CASE
17	M5RDC-4	SERVICE MEAT RIGHT END PANEL
18	M5RDC-8	SERVICE MEAT RIGHT END PANEL
19	MW3TSCLEHX	12' DUAL TEMP WIDE ISLAND MEAT W/GLASS
20	MW3TSCLEHX	12' DUAL TEMP WIDE ISLAND MEAT W/GLASS
21	MW3TSCLEHX	DUAL TEMP WIDE ISLAND MEAT WALL W/GLASS
22	MW4MCLEHX	12' MEDIUM TEMP WIDE ISLAND MEAT W/GLASS
23	MW4MCLEHX	MEDIUM TEMP WIDE ISLAND MEAT WALL W/GLASS
24	MW7TMEP	WIDE ISLAND MEAT TOP PIPE KIT

PHARMACY

6	R1-16IE	16' ISLAND SHELF END PANEL
7	R1-16W	16' WALL SHELF
8	R1-16WE	16' WALL SHELF END PANEL
9	R1-16W	16' WALL SHELF
10	R2T-3	3' PHARMACY PRINTER
11	R2T-3	3' PHARMACY WALL CABINET W/ DOORS
12	R2T-4	4' PHARMACY WALL CABINET W/ DOORS
13	R3C	3' MEDICINE CABINET (SLIDE OUT DUTY SLIDE-OUT
14	R3D1	TALL NARCOTICS CART
15	R31	5 DRAWER CABINET
16	R3S	3' MEDICINE CABINET
17	R3S	SINK CABINET
18	R35	CABINET W/DOOR & (2) SHELVES
19	R3P3	3' MEDICINE CABINET W/ DOORS DESTRUCTION
20	R3P3	HRODUCT HEALTH TESTING DEVICE DISPENSER (VENDOR SUPPLIED)
21	R5DB	PRESCRIPTION VALIDATION & DISPENSING DEVICE
22	R5S	5' MEDICINE CABINET W/ DOORS
23	R5S	PHARMACY WAITING CHAIR
24	R7S	28" FINISHED PANEL END
25	R7S	28" FINISHED PANEL END
26	R9W	RX WELDED TO WALL MOUNTING POLE
27	R9W4P	RX WORKSTAT