NOTES:

1. PLEASE REFER TO DWGS FOR SCHEDULES:
   5446-022-MH601-20 - HVAC SCHEDULE I
   5446-022-MH602-20 - HVAC SCHEDULE II
   5446-022-MH603-20 - HVAC SCHEDULE III
   5446-022-MH604-20 - HVAC SCHEDULE IV
   5446-022-MH605-20 - HVAC SCHEDULE V
   5446-022-MH606-20 - HVAC SCHEDULE VI
   5446-022-MH607-20 - HVAC SCHEDULE VII
   5446-022-MH608-20 - HVAC SCHEDULE VIII
   5446-022-MH609-20 - HVAC SCHEDULE IX
   5446-022-MH610-20 - HVAC SCHEDULE X

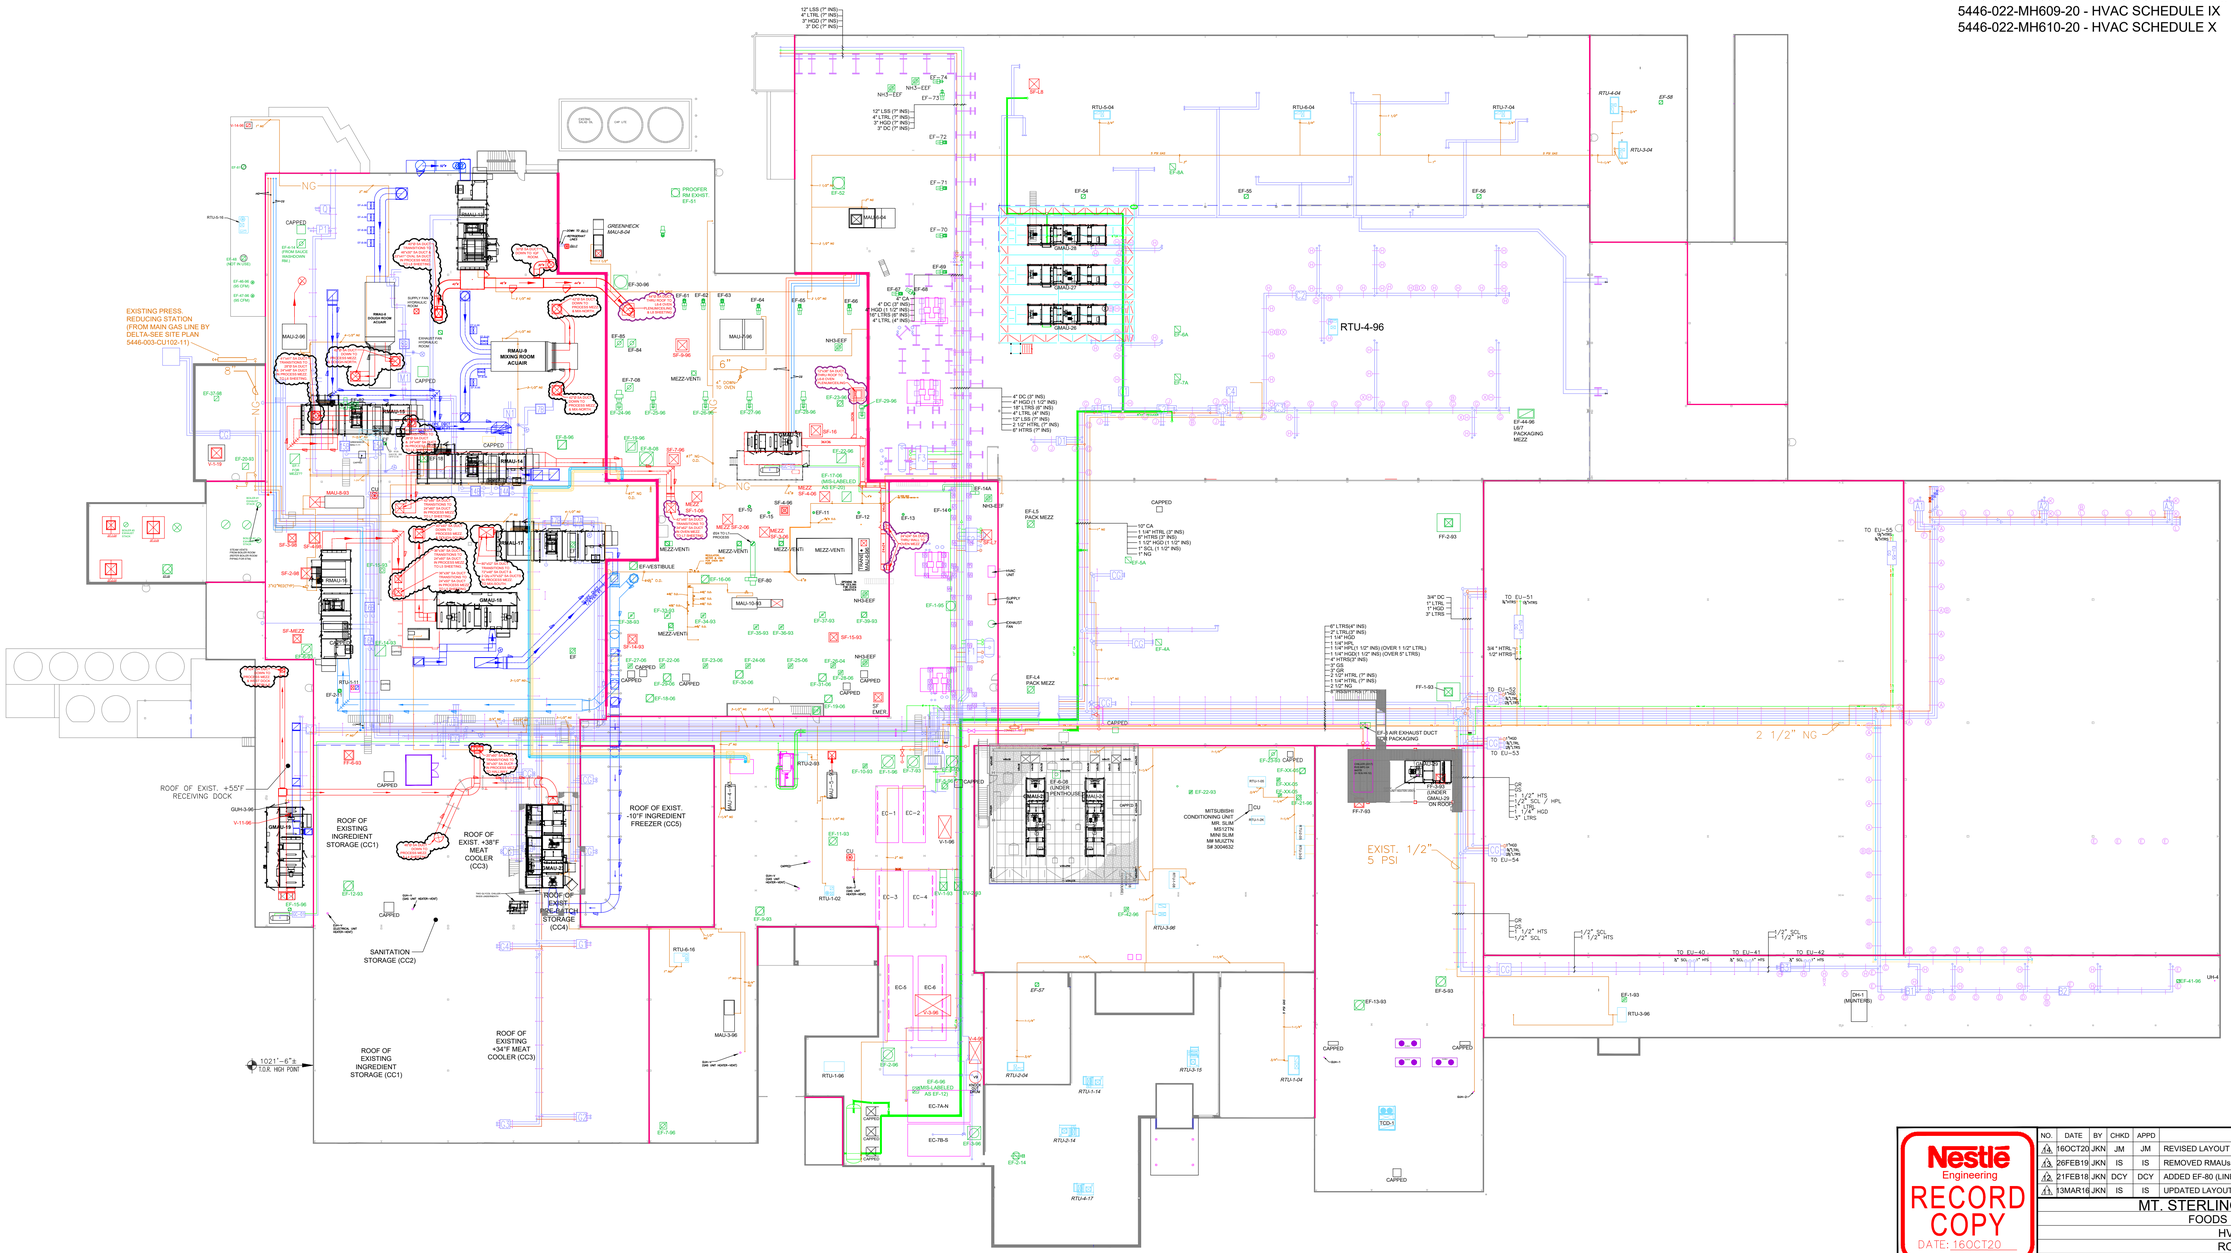

HVAC ROOF PLAN

SCALE: 1/32" = 1'-0" (ANSI-D)

N

NO.	DATE	BY	CHKD	APPD	REMARKS
4	16OCT20	JKN	JM	JM	REVISED LAYOUT TO SHOW SUPPLY, RETURN & EXHAUST.
3	26FEB19	JKN	IS	IS	REMOVED RMAUs 2, 11 & 12 FROM PACKAGING ROOF.
2	21FEB18	JKN	DCY	DCY	ADDED EF-80 (LINE 7). REVISED NGAS ON L7 OVEN ROOF AREA.
1	13MAR16	JKN	IS	IS	UPDATED LAYOUT PER L7 COOK/COOL PROJECT.

Nestlé Engineering
RECORD COPY
DATE: 16OCT20

MT. STERLING, KENTUCKY
FOODS DIVISION
HVAC
ROOF
ROOF EQUIPMENT AND PIPING

Nestlé Good Food, Good Life

ORIGINATOR: HOT POCKETS / FOODS DIVISION / 5446
ADDRESS: 150 OAK GROVE DRIVE
CITY/STATE: MT. STERLING / KENTUCKY / 40353
TEL NO.: (859) 498-4300
FAX NO.: (859) 498-4363
E-MAIL: jeff.ng@us.nestle.com

THIS DRAWING WAS NOT BEEN PUBLISHED. IT IS THE EXCLUSIVE PROPERTY OF NESTLÉ USA. IT IS TO BE USED AND IS PROVIDED TO RECIPIENT FOR THEIR USE ONLY, UPON THE FOLLOWING CONDITIONS: RECIPIENT SHALL RETURN THE DRAWING TO NESTLÉ IMMEDIATELY UPON REQUEST, AND SHALL NOT REPRODUCE, COPY, DISCUSS OR DISCLOSE INFORMATION CONTAINED IN THE DRAWING TO A THIRD PARTY OR OTHERWISE DISPOSE OF, DIRECTLY OR INDIRECTLY. THE ORIGINAL OR ANY EXACT COPIES OF THIS DRAWING WITHOUT THE PRIOR WRITTEN CONSENT OF NESTLÉ.

DRAWN BY:	DATE:	CHKD BY:	DATE:	APPD BY:	DATE:	DATE ISSUED:
JKN	16OCT20	JM	16OCT20	JM	16OCT20	16 OCTOBER 2020

PROJECT NO:	REV NO:	SHEET SIZE	SCALE:
N/A	14	ANSI - D (22 x 34)	1/32" = 1'-0"

CAD DWG FILE:	SHEET NO:
5446-022-MH101-10	MH101