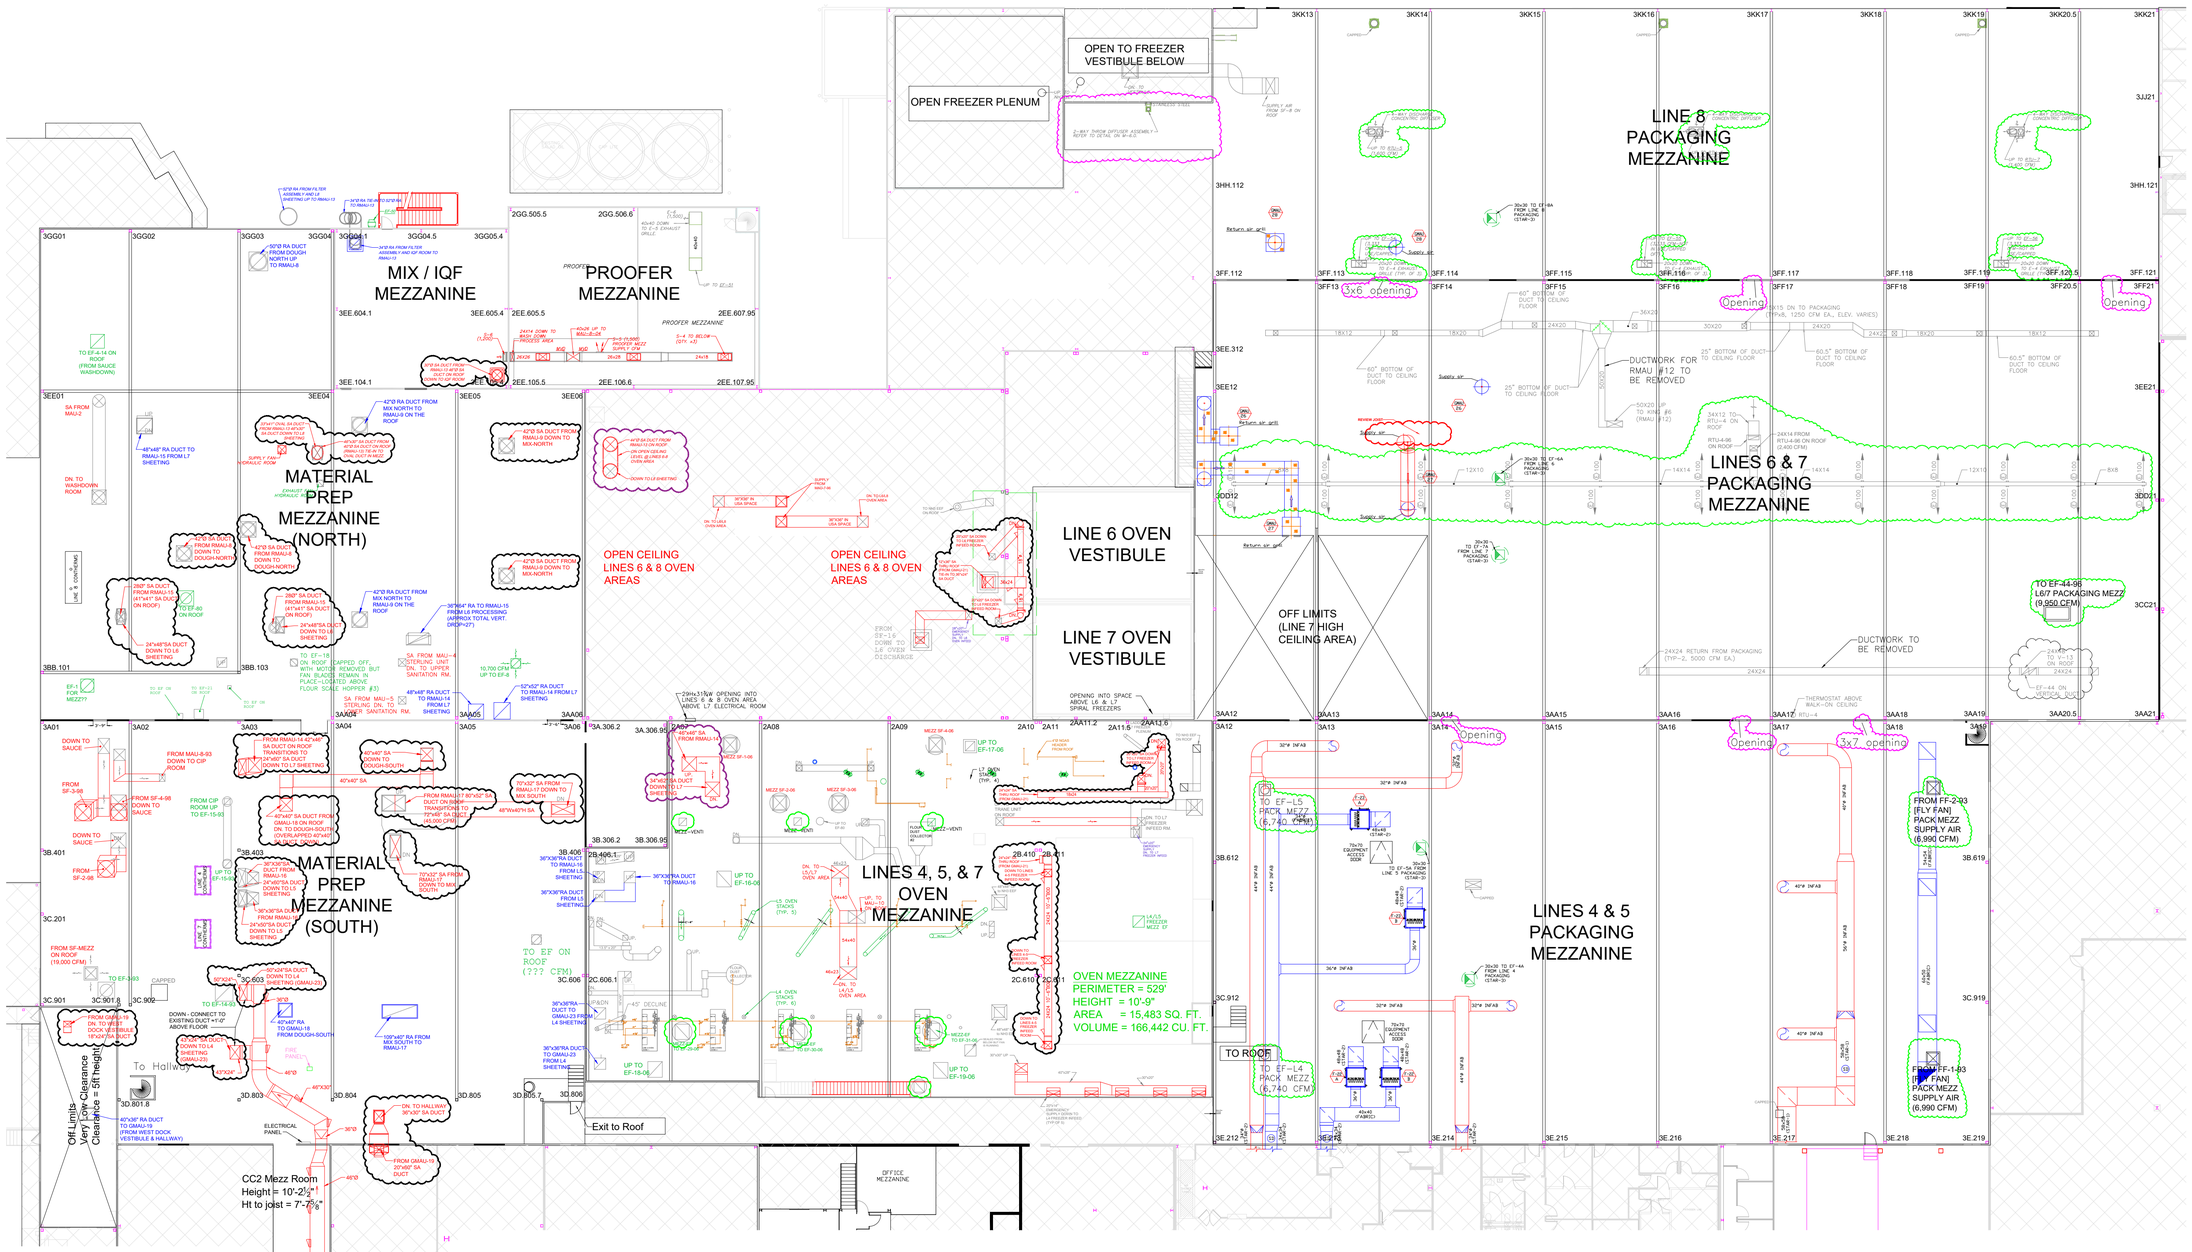

HVAC MEZZANINE PLAN

SCALE: 1" = 20'-0" (ANSI-D)

Nestlé Engineering RECORD COPY DATE: 16OCT20

NO.	DATE	BY	CHKD	APPD	REMARKS
4.					
3.					
2.					
1.	16OCT20	JKN	JM	JM	REVISED LAYOUT TO SHOW SUPPLY, RETURN & EXHAUST.

MT. STERLING, KENTUCKY
FOODS DIVISION
HVAC
MEZZANINE
DUCTWORK PLAN

Nestlé Good Food, Good Life

ORIGINATOR: HOT POCKETS / FOODS DIVISION / 5446
ADDRESS: 150 OAK GROVE DRIVE
CITY/STATE: MT. STERLING / KENTUCKY / 40353
TEL NO: (859) 498-4300
FAX NO: (859) 498-4363
E-MAIL: jeff.ng@us.nestle.com

THIS DRAWING AND NOT BOOK CONTAINS THE EXCLUSIVE PROPERTY OF NESTLÉ. THIS DRAWING IS FOR USE AND USE ONLY UPON THE FOLLOWING CONDITIONS: RECIPIENT SHALL RETURN THE DRAWING TO NESTLÉ IMMEDIATELY UPON REQUEST, AND SHALL NOT REPRODUCE, COPY, DISCLOSE OR DISCLOSE INFORMATION CONTAINED IN THE DRAWING TO A THIRD PARTY OR OTHERWISE DISPOSE OF, DIRECTLY OR INDIRECTLY, THE ORIGINAL OR ANY DUPLICATES OF THIS DRAWING WITHOUT THE PRIOR WRITTEN CONSENT OF NESTLÉ.

DRAWN BY:	DATE:	CHKD BY:	DATE:	APPD BY:	DATE:	DATE ISSUED:
JKN	16OCT20	JM	16OCT20	JM	16OCT20	16 OCTOBER 2020

PROJECT NO:	REV NO:	SHEET SIZE	SCALE:
N/A	1	ANSI - D (22 x 34)	1" = 20'-0"

CAD DWG FILE: 5446-022-MH103-10

SHEET NO: MH103