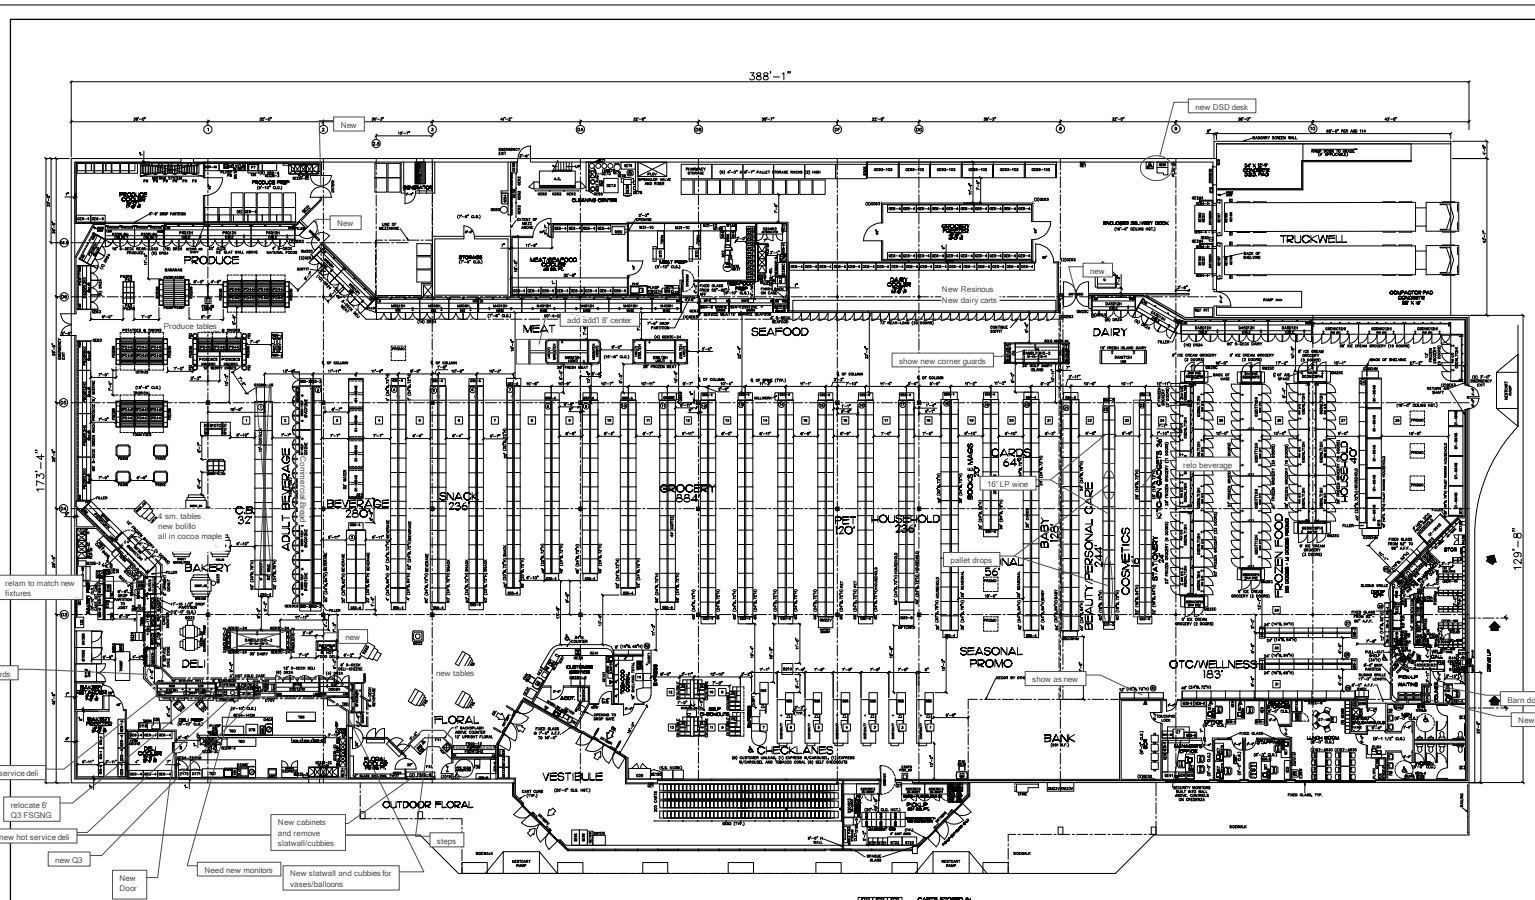

Walk Notes:

- Relaminate bakery case to match new fixtures
- Leave drawers below new cabinets in floral
- Most doors need DAC 55's
- Most walk in doors need timer switches
- New seals for dairy walk in door
- Skins & Trim
- Paint bakery/deli cooers in dept.
- Fix produce valance
- M/SF pushers
- Walk for paint scope since keeping decor
-Check motor room for leak opportunities
- check to secure tobacco & baby formula fixture on FE from tipping
- add marlite and top cap to new wall for smart safe
- New carpet at vestibules
- Change wall wash lights to spot lights
- Meat project will be seperate to take care of a few items

-Ext. signage will be done this year
-check with maintenance for asphalt replacement

-BID AITERNATES:
- Remove produce decor ring and put track lighting on grid pattern
- Wood floor replacement at produce
- VCT replacement at offices to LVT
- Front end power feed to overhead

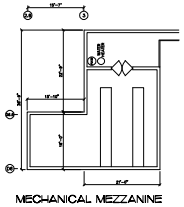

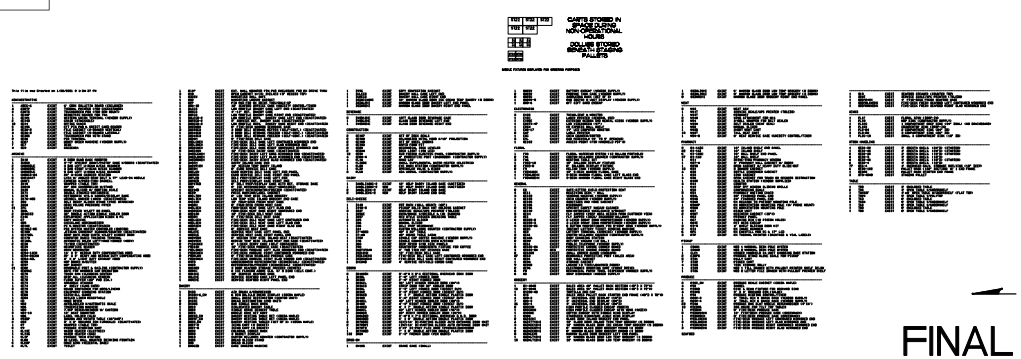

N

FINAL PLAN

GENERAL NOTES :

DALLAS
(EXIST) BOUNTIFUL
751 FREEPORT PARKWAY
COPPELL, TX
PHONE 4469 648-7949
FAX 4469 648-7981

Kroger
GENERAL OFFICE
FACILITY ENGINEERING

MINOR CAPITAL
DAL-402
3612 N. BELTLINE RD
IRVING,TX

PROJECT PLAN DATE	1/28/2021
GENERAL PLAN DATE	1/28/2021
DESIGNER	K.PANGALLO
DESIGNED	C.WOLTMANN
REVISIONS	
DESIGNED PLANNING GRID	1/16"=1'-0"
BUILDING STATS	
TOTAL SHELVING	2723 LF
SALES AREA	47,894 SF
BASE STORE	64,647 SF
MEZZANINE	1,001 SF
DOCK / UTILITY	1,723 SF
GROSS BUILDING	67,422 SF

FINAL
FIXTURE PLAN

DEBT PARTNER
Not Applicable

DAL-402

F1

AND FILE DAL-402FLOWS