

MECHANICAL SYMBOLS

THIS IS A MASTER LEGEND AND NOT ALL SYMBOLS OR ABBREVIATIONS ARE USED.

V2.01

STANDARD MOUNTING HEIGHT	
THERMOSTATS (USER ADJUSTABLE)(TOP OF DEVICE)	48" CONROLS (TOP OF DEVICE) 48"
USE THE DEFAULT MOUNTING HEIGHTS SHOWN ABOVE UNLESS NOTED OTHERWISE IN THE SPECIFICATIONS OR ELSEWHERE. MOUNTING HEIGHTS LISTED ARE ABOVE FINISHED FLOOR (AFF) OR ABOVE FINISHED GRADE (AFG) TO TOP OF DEVICE. ALL DEVICES SHALL BE INSTALLED IN COMPLIANCE WITH CURRENT ADA AND LOCAL REQUIREMENTS.	
ANNOTATION	
	MECHANICAL PLAN NOTE CALLOUT
	MECHANICAL EQUIPMENT DESIGNATION (CONTRACTOR FURNISHED AND INSTALLED UNLESS NOTED OTHERWISE)
	CONNECTION POINT OF NEW WORK TO EXISTING
	DETAIL REFERENCE. UPPER NUMBER INDICATES DETAIL NUMBER LOWER NUMBER INDICATES SHEET NUMBER
	SECTION CUT DESIGNATION

ABBREVIATIONS			
A/C	AIR CONDITIONING	HWP	HEATING WATER PUMP
ACCU	AIR COOLED CONDENSING UNIT	IN W/C	INCHES OF WATER COLUMN
AFC	ABOVE FINISHED CEILING	L	LOUVER
AFF	ABOVE FINISHED FLOOR	LAT	LEAVING AIR TEMPERATURE
AFG	ABOVE FINISHED GRADE	LDB	LEAVING DRY BULB
AHJ	AUTHORITY HAVING JURISDICTION	LP	LOW PRESSURE
AHU	AIR HANDLING UNIT	LWB	LEAVING WET BULB
AI	ANALOG INPUT	LWT	LEAVING WATER TEMPERATURE
AO	ANALOG OUTPUT	MAX	MAXIMUM
AP	ACCESS PANEL	MBH	1000 BTU PER HOUR
APD	AIR PRESSURE DROP	MD	MOTORIZED DAMPER
AWG	AMERICAN WIRE GAUGE	MFR	MANUFACTURER
BAS	BUILDING AUTOMATION SYSTEM	MIN	MINIMUM
BB	BACKBONE	N/A	NOT APPLICABLE
BD	BACKDRAFT DAMPER	NC	NORMALLY CLOSED
BD	BLOWDOWN	NO	NORMALLY OPEN
BFC	BELOW FINISHED CEILING	NOM	NOMINAL
BFF	BELOW FINISHED FLOOR	NC	NOISE CRITERIA
BHP	BRAKE HORSEPOWER	NF	NON-FUSED
BI	BINARY INPUT	NI	NOT IN CONTRACT
BO	BINARY OUTPUT	OA	OUTSIDE AIR
BOD	BOTTOM OF DUCT	PICV	PRESSURE INDEP. CONTROL VALVE
BOS	BOTTOM OF STRUCTURE	PROVIDE	FURNISH AND INSTALL
BTU	BRITISH THERMAL UNIT	QTY	QUANTITY
CFM	CUBIC FEET PER MINUTE	RA	RETURN AIR
CLG	COOLING	RC	ROOM CRITERIA
CP	CONDENSATE PUMP	RD	RETURN DUCT
CPT	CONTROL POWER	REA	RELIEF AIR
CP	TRANSFORMER	RF	RETURN FAN
CV	CONTROL VALVE	RRR	REFRIGERANT RELIEF
CWP	CONDENSER WATER PUMP	RH	RELATIVE HUMIDITY
CU	CONDENSING UNIT	RH	ROOF HOOD
CHWP	CHILLED WATER PUMP	RPM	REVOLUTIONS PER MINUTE
DB	DECIBELS	SA	SUPPLY AIR
DBA	DECIBEL AVERAGE	SD	SMOKE DUCT DETECTOR
DDC	DIRECT DIGITAL CONTROL	SD	SUPPLY DUCT
DI	DIGITAL INPUT	SF	SUPPLY FAN
DISC	DISCONNECT	SH	SENSIBLE HEAT CAPACITY
DN	DOWN	SCOW	SCOPE OF WORK
DS	DUCT SILENCER	SP	STATIC PRESSURE
DX	DIRECT EXPANSION	ST	STEAM TRAP
E	EXISTING	STM	STEAM
EA	EXHAUST AIR	TBD	TO BE DETERMINED
EAT	ENTERING AIR TEMPERATURE	TC/C	TEMPERATURE CONTROLS CONTRACTOR
ED	ENTERING DRY BULB	TCF	TEMPERATURE CONTROL PANEL
EDB	ENTERING DRY BULB	TF	TRANSFER FAN
EFF	EFFICIENCY	TH	TOTAL HEAT CAPACITY
EMS	ENERGY MANAGEMENT SYSTEM	TSP	TOTAL STATIC PRESSURE
ESP	EXTERNAL STATIC PRESSURE	TH	TYPICAL UNIT HEATER
ETR	EXISTING TO REMAIN	UNO	UNLESS NOTED OTHERWISE
EWB	ENTERING WET BULB	VAV	VARIABLE AIR VOLUME
EWT	ENTERING WATER TEMPERATURE	VEL	VELOCITY
FCU	FAN COIL UNIT	VAV	VARIABLE FLOW VELOCITY
FF	FINISHED FLOOR	VRF	VARIABLE REFRIGERANT FLOW
FPI	FEET PER INCH	W	WITH
FPM	FEET PER MINUTE	W/O	WITHOUT
GC	GENERAL CONTRACTOR	WB	WET BULB
GPM	GALLONS PER MINUTE	WC	WATER COLUMN
HP	HORSEPOWER	WPD	WATER PRESSURE DROP
HTG	HEATING		

HVAC DUCTWORK AND ACCESSORIES	
	LINEAR SLOT DIFFUSER
	INSULATED FLEXIBLE DUCT (MAX. 5'-0" LONG)
	BRANCH DUCT WITH 45° RECTANGLE-ROUND BRANCH FITTING AND MANUAL VOLUME DAMPER
	ELBOW WITH TURNING VANES
	BRANCH DUCT WITH BELL-MOUTH FITTING & MANUAL VOLUME CONTROL DAMPER
	RETURN, EXHAUST, OR OUTSIDE AIR DUCT UP
	RETURN, EXHAUST, OR OUTSIDE AIR DUCT DOWN
	SUPPLY AIR DUCT UP
	SUPPLY AIR DUCT DOWN
	EQUIPMENT WITH FLEXIBLE DUCT CONNECTION
	10" (NECK SIZE) CSD-1 (TYPE) 300 CFM (CFM OF SUPPLY DIFFUSER)
	24x24 (NECK SIZE) CEG-1 (TYPE) 800 CFM (CFM OF EXHAUST GRILLE)
	MANUAL VOLUME DAMPER
	SQUARE TO ROUND TRANSITION
	DUCT MOUNTED SMOKE DETECTOR (SD=SUPPLY/VD=RETURN)
	RISER DESIGNATION
	FIRE DAMPER
	FIRE SMOKE DAMPER
	SMOKE DAMPER
	VOLUME DAMPER
	MOTORIZED DAMPER
	BACKDRAFT DAMPER

ALL DUCT DIMENSIONS SHOWN ON DRAWINGS ARE INSIDE DIMENSIONS. REFER TO DUCTWORK SPECIFICATIONS FOR DUCTWORK INSULATION AND LINER INFORMATION.

HVAC CONTROL DEVICES	
	HUMIDISTAT
	THERMOSTAT
	STATIC PRESSURE SENSOR
	TEMPERATURE SENSOR
	CARBON MONOXIDE SENSOR
	CARBON DIOXIDE SENSOR
	DIFFERENTIAL PRESSURE SENSOR
	FLOW SWITCH
	HUMIDITY SENSOR
	PULL STATION

PIPING SYMBOLS	
	DIRECTION OF FLOW
	CONTROL VALVE
	THREE-WAY CONTROL VALVE
	SHUTOFF VALVE
	CHECK VALVE
	BALANCING VALVE WITH PRESSURE PORTS
	TRIPLE DUTY VALVE WITH PRESSURE PORTS
	STRAINER
	STRAINER WITH BLOWDOWN VALVE
	RELIEF / SAFETY VALVE
	SOLENOID VALVE
	PRESSURE REDUCING VALVE
	GAS PRESSURE REGULATOR
	THERMOSTATIC MIXING VALVE
	PIPE ANCHOR
	EXPANSION JOINT
	PIPE GUIDE
	PIPING SUPPORT
	F & T TRAP
	BUCKET TRAP
	THERMOSTATIC TRAP
	BACKFLOW PREVENTER
	PRESSURE GAUGE
	THERMOMETER
	PRESSURE AND TEMPERATURE TEST PLUG
	UNION
	FLANGE CONNECTION
	VACUUM RELIEF VALVE
	AUTOMATIC AIR VENT
	MANUAL AIR VENT
	PRESSURE / VACUUM SWITCH
	CLEANOUT
	CAP
	ELBOW UP
	ELBOW DOWN
	TEE UP
	TEE DOWN
	ELBOW UP WITH SHUT-OFF VALVE (SOV)
	ELBOW DOWN WITH SHUT-OFF VALVE (SOV)
	TEE UP WITH SHUT-OFF VALVE (SOV)
	TEE DOWN WITH SHUT-OFF VALVE (SOV)
	REDUCER
	RECIRCULATION PUMP
	P-TRAP
	GAS COCK
	TOP BEAM CLAMP
	TRAPEZE HANGER

PIPING LINETYPES	
	CONDENSATE DRAIN (CD)
	AUXILIARY CONDENSATE DRAIN (ACD)
	NON-POTABLE WATER (NPW)
	NATURAL GAS (G)
	NATURAL GAS ON ROOF (G)
	MEDIUM PRESSURE NATURAL GAS (MPG)
	MED. PRESSURE NAT. GAS ON ROOF (MPG)
	FUEL OIL SUPPLY (FOS)
	FUEL OIL RETURN (FOR)
	FUEL OIL VENT (FOV)
	LIQUEFIED PETROLEUM GAS (LPG)
	BOILER FEED WATER (BFW)
	HIGH PRESSURE STEAM SUPPLY (HPS)
	HIGH PRESSURE STEAM CONDENSATE (HPC)
	MEDIUM PRESSURE STEAM SUPPLY (MPS)
	MED. PRESSURE STEAM CONDENSATE (MPC)
	LOW PRESSURE STEAM SUPPLY (LPS)
	LOW PRESSURE STEAM CONDENSATE (LPC)
	CONDENSATE PUMP DISCHARGE (PD)
	HEATING HOT WATER SUPPLY (HWS)
	HEATING HOT WATER RETURN (HWR)
	CHILLED WATER SUPPLY (CHWS)
	CHILLED WATER RETURN (CHRW)
	HOT / CHILLED WATER SUPPLY (HCS)
	HOT / CHILLED WATER SUPPLY (HCR)
	CONDENSER WATER SUPPLY (CWS)
	CONDENSER WATER RETURN (CWR)
	HEAT PUMP WATER SUPPLY (HPWS)
	HEAT PUMP WATER RETURN (HPWR)
	REFRIGERANT LIQUID (RL)
	REFRIGERANT DISCHARGE (HOT GAS) (RD)
	REFRIGERANT SUCTION (RS)
	REFRIGERANT DISCHARGE BYPASS (ROB)
	REFRIGERANT VENT (RV)

LINETYPE LEGEND	
	THROUGHOUT THE DRAWINGS DIFFERENT LINETYPES ARE USED IN COMBINATION WITH THE SYMBOLS TO INDICATE THE STATUS OF ITEMS AS EXISTING, TO BE DEMOLISHED, TO BE INCLUDED AS PART OF NEW WORK AND/OR ITEMS WHICH ARE ANTICIPATED TO BE PROVIDED IN THE FUTURE. THE STATUS OF ITEMS USING THESE LINETYPES ARE RELATIVE TO THE VIEW IN WHICH THEY APPEAR. PHASING SHOWN IN DRAWINGS IS NOT INTENDED TO FULLY DESCRIBE ALL NECESSARY CONSTRUCTION PHASING, WHICH IS DETERMINED BY THE CONTRACTOR AS PART OF THEIR RESPONSIBILITIES. ANY SUCH PHASING DESCRIBED IN THE CONSTRUCTION DOCUMENTS ARE GENERAL AND ONLY INTENDED TO INDICATE A BROAD ORDER FOR THE SAKE OF DESCRIBING THE PROJECT. THE FOLLOWING LINETYPES MAY BE USED ON ANY DEVICE, EQUIPMENT, NOTE, LINE, SHAPE, ETC.
	EXISTING
	DEMOLISH
	NEW
	FUTURE

MECHANICAL DEMOLITION GENERAL NOTES:

- COORDINATE ALL DEMOLITION WITH WHAT IS SHOWN ON ARCHITECTURAL PLANS. NOTIFY ARCHITECT OF ANY DISCREPANCIES.
- PRIOR TO SUBMITTING BID, VISIT THE JOB SITE AND BECOME FULLY ACQUAINTED WITH THE EXISTING CONDITIONS OF THE PROJECT. REVIEW GENERAL NOTES, SPECIFICATIONS AND OTHER DRAWINGS FOR ADDITIONAL REQUIREMENTS THAT MAY NOT BE SPECIFICALLY CALLED OUT IN THIS PORTION OF THE CONSTRUCTION DOCUMENTS. NOTIFY ARCHITECT, ENGINEER OR OWNER, AS DEFINED IN BID DOCUMENTS, OF CONFLICTS OR DISCREPANCIES PRIOR TO SUBMISSION OF BID.
- OWNER RETAINS RIGHTS OF SALVAGE FOR EQUIPMENT AND FIXTURES TO BE REMOVED. COORDINATE WITH OWNER THE EQUIPMENT AND FIXTURES TO BE SALVAGED AND THE LOCATION FOR STORAGE. AVOID DAMAGE TO SALVAGED EQUIPMENT, FIXTURES AND DEVICES DURING DEMOLITION WORK AND DURING TRANSPORT TO OWNER'S DESIGNATED STORAGE LOCATION.
- REMOVE ITEMS SHOWN HEAVY-LINED DASHED, AND/OR NOTED TO BE REMOVED.
- AVOID DAMAGING EXISTING SURFACES AND EQUIPMENT TO REMAIN FOR NEW INSTALLATION. REPAIR DAMAGE CAUSED DURING WORK AT NO EXTRA COST TO THE OWNER.
- SEAL PENETRATIONS THROUGH FLOORS, WALLS, CEILING AND ROOFS WHERE MECHANICAL COMPONENTS ARE REMOVED AND WHERE THE EXISTING PENETRATION IS NOT USED FOR THE NEW INSTALLATION. REPAIR DAMAGED SURFACES TO MATCH ADJACENT AREAS OR AS INDICATED ON THE ARCHITECTURAL DRAWINGS.
- REMOVE HANGERS AND SUPPORTS WHERE DUCTWORK, PIPING AND/OR EQUIPMENT ARE REMOVED AND THE EXISTING HANGERS AND SUPPORTS ARE NOT USED FOR THE NEW INSTALLATION.
- INSTALL PERMANENT CAPS WHERE DUCTWORK AND PIPING IS REMOVED AND THE EXISTING TAPS ARE NOT USED FOR THE NEW INSTALLATION. WHERE DUCTWORK AND PIPING ARE REMOVED AND THE EXISTING TAPS WILL BE USED FOR THE NEW INSTALLATION, INSTALL TEMPORARY CAPS TO PROTECT THE INTERIOR SURFACES UNTIL NEW DUCTWORK AND PIPING IS INSTALLED.
- INSPECT EXISTING EQUIPMENT TO REMAIN TO VERIFY THAT EQUIPMENT IS OPERATING PROPERLY. NOTIFY OWNER OF DAMAGED AND/OR MALFUNCTIONING COMPONENTS.
- WHERE SHUTDOWN OF EXISTING SYSTEMS IS REQUIRED DURING DEMOLITION, COORDINATE SHUTDOWN TIME AND DURATION WITH OWNER TO MINIMIZE DOWNTIME. NOTIFY OWNER SEVEN (7) DAYS PRIOR TO INTERRUPTION OF SERVICE.
- CEASE WORK AND IMMEDIATELY NOTIFY THE OWNER SHOULD ANY HAZARDOUS MATERIALS BE ENCOUNTERED DURING THE PERFORMANCE OF THE WORK.
- REMOVAL, RECOVERY, RECYCLING, AND DISPOSAL OF REFRIGERANT, CONTAINED IN ANY EQUIPMENT TO BE REMOVED, SHALL BE PERFORMED IN STRICT ACCORDANCE WITH CURRENT EPA GUIDELINES.

COMMISSIONING / FUNCTIONAL TESTING:

CONTRACTOR'S BID SHALL INCLUDE PROVISIONS TO PROVIDE ALL SERVICES RELATED TO THE CODE REQUIRED BUILDING SYSTEMS COMMISSIONING INCLUDING A COMMISSIONING PLAN, FUNCTIONAL TESTING, AND RELATED DOCUMENTATION, REPORTS, AND OWNER TRAINING. THIS INCLUDES RETAINING THE SERVICES OF A 3RD PARTY REGISTERED DESIGN PROFESSIONAL OR APPROVED AGENCY. REFER TO THE LATEST ADOPTED EDITION OF THE ENERGY CODE FOR MORE INFORMATION. CONTRACTOR SHALL COMPLETE ALL RELATED COMMISSIONING REQUIREMENTS PRIOR TO FINAL INSPECTIONS IN ACCORDANCE WITH THE CONSTRUCTION DOCUMENTS, CODE, AND MANUFACTURER'S INSTRUCTIONS.

APPLICABLE MECHANICAL CODES:

NOTE: PROJECT IS DESIGNED IN COMPLIANCE WITH THE FOLLOWING CODES. THIS IS NOT AN EXHAUSTIVE LIST. PROJECT SHALL COMPLY WITH ALL APPLICABLE CODES, STANDARDS AND LOCAL REQUIREMENTS. REFER TO THE SPECIFICATIONS FOR ADDITIONAL REQUIREMENTS.

MECHANICAL CODE: 2018 INTERNATIONAL MECHANICAL CODE
BUILDING CODE: 2018 INTERNATIONAL BUILDING CODE
ENERGY CODE: 2018 INTERNATIONAL ENERGY CONSERVATION CODE

NOTE: GENERAL NOTES SHOWN HERE SHALL GOVERN FOR ALL ELECTRICAL SHEETS.

MECHANICAL GENERAL NOTES:

- PRIOR TO SUBMITTING BID, VISIT THE JOB SITE AND BECOME FULLY ACQUAINTED WITH THE EXISTING CONDITIONS OF THE PROJECT. REVIEW THE GENERAL NOTES, SPECIFICATIONS AND OTHER DRAWINGS FOR ADDITIONAL REQUIREMENTS WHICH MAY NOT BE SPECIFICALLY CALLED OUT IN THIS PORTION OF THE CONSTRUCTION DOCUMENTS. NOTIFY ARCHITECT, ENGINEER AND/OR OWNER OF CONFLICTS OR DISCREPANCIES PRIOR TO SUBMISSION OF BID.
- PROVIDE SEISMIC RESTRAINTS AS NEEDED FOR THE MECHANICAL SYSTEMS IN THE PROJECT BASED ON THE SEISMIC ANALYSIS REQUIRED BY THE SPECIFICATIONS.
- EXISTING CONDITIONS WERE TAKEN FROM ORIGINAL DRAWINGS AND SITE VISITS AND MAY NOT REFLECT EXACT "AS-BUILT" CONDITIONS. FIELD VERIFY EXISTING CONDITIONS PRIOR TO SUBMITTING FINAL BIDS. COORDINATE NEW WORK AND DEMOLITION WITH EXISTING CONDITIONS AND EXISTING CONDITIONS PRIOR TO CONSTRUCTION.
- COORDINATE THE INSTALLATION OF THE MECHANICAL SYSTEMS WITH OTHER TRADES TO ENSURE A NEAT AND ORDERLY INSTALLATION. INSTALL DUCTWORK AND PIPING AS TIGHT TO STRUCTURE AS POSSIBLE. COORDINATE WITH OTHER TRADES TO AVOID CONFLICTS. COORDINATE INSTALLATION OF DUCTWORK AND PIPING TO AVOID CONFLICTS WITH ELECTRICAL PANELS, LIGHTING FIXTURES, ETC. ANY MODIFICATIONS REQUIRED DUE TO LACK OF COORDINATION WILL BE THE RESPONSIBILITY OF THE CONTRACTOR AT NO EXTRA COST TO THE OWNER.
- WHERE SHUTDOWN OF EXISTING SYSTEMS IS REQUIRED DURING NEW WORK, COORDINATE SHUTDOWN TIME AND DURATION WITH THE OWNER TO MINIMIZE DOWNTIME (NOTIFY OWNER SEVEN (7) DAYS PRIOR TO INTERRUPTION OF SERVICE).
- DURING INSTALLATION OF NEW WORK, AVOID DAMAGING EXISTING SURFACES AND EQUIPMENT TO REMAIN. REPAIR DAMAGE CAUSED DURING CONSTRUCTION AT NO EXTRA COST TO THE OWNER.
- PROVIDE TEMPORARY BARRIERS TO CONTAIN DUST AND DEBRIS RESULTING FROM THE PERFORMANCE OF THE WORK TO AVOID DAMAGE TO OTHERS BEING PERFORMED.
- ALL MECHANICAL EQUIPMENT SHOWN ON THE MECHANICAL PLANS SHALL BE PROVIDED BY DIVISION 23 UNLESS OTHERWISE NOTED.
- NEW MECHANICAL EQUIPMENT, DUCTWORK AND PIPING ARE SHOWN AT APPROXIMATE LOCATIONS. FIELD MEASURE FINAL DUCTWORK AND PIPING LOCATIONS PRIOR TO FABRICATION AND MAKE ADJUSTMENTS AS REQUIRED TO FIT THE DUCTWORK AND PIPING WITHIN THE AVAILABLE SPACE. VERIFY THAT FINAL EQUIPMENT LOCATIONS MEET MANUFACTURER'S RECOMMENDATIONS REGARDING SERVICE CLEARANCE AND PROPER AIRFLOW CLEARANCE AROUND EQUIPMENT.
- REFER TO ARCHITECTURAL DRAWINGS FOR RELATED CONSTRUCTION DETAILS AS APPLICABLE TO THE HVAC SYSTEM. VERIFY CHASES AND PENETRATIONS SHOWN ON ARCHITECTURAL DRAWINGS THAT ARE INTENDED FOR DUCTWORK AND PIPING MEET REQUIREMENTS.
- COORDINATE LOCATION OF ROOF MOUNTED HVAC EQUIPMENT AND ROOF PENETRATIONS WITH THE ARCHITECTURAL AND STRUCTURAL DRAWINGS.
- INDOOR AIR QUALITY MEASURES: PROTECT INSIDE OF INSTALLED AND DELIVERED DUCTWORK AND HVAC UNITS FROM EXCESSIVE DUST, DIRT, AND MOISTURE. REPLACE INSULATION THAT HAS BECOME WET AT ANY TIME DURING CONSTRUCTION, DRYING THE INSULATION IS NOT ACCEPTABLE. REPAIR ANY TEARS OR JOINTS OF INTERNAL FILTERS THAT WERE REMOVED DURING THE CONSTRUCTION PERIOD AFTER NEW FILTERS ARE INSTALLED AND PRIOR TO TURNING SYSTEM OVER TO THE OWNER. THE INTERNAL SURFACES AND ASSOCIATED AIRWAYS OF ANY HVAC UNITS THAT WERE OPERATED SHALL ALSO BE CLEANED.
- INSTALL DUCTWORK AND PIPING PARALLEL TO BUILDING COLUMN LINES UNLESS OTHERWISE SHOWN OR NOTED.
- OVERHEAD HANGERS AND SUPPORTS FOR EQUIPMENT, DUCTWORK AND PIPING SHALL BE FASTENED TO BUILDING JOISTS OR BEAMS. DO NOT ATTACH HANGERS AND SUPPORTS TO THE ABOVE FLOOR SLAB OR ROOF EXCEPT WHERE CONCRETE INSERTS IN CONCRETE SLABS ARE ALLOWED BY THE SPECIFICATIONS.
- COORDINATE LOCATION OF EQUIPMENT SUPPORTS WITH LOCATION OF EQUIPMENT ACCESS PANELS/DOORS TO ENABLE SERVICE OF EQUIPMENT AND/OR FILTER REPLACEMENT.
- COORDINATE THE EXACT MOUNTING SIZE AND FRAME TYPE OF DIFFUSERS, REGISTERS AND GRILLES WITH THE SUPPLIER TO MEET THE CEILING, WALL AND DUCT INSTALLATION REQUIREMENTS.
- ADJUST LOCATION OF CEILING DIFFUSERS, REGISTERS AND GRILLES AS REQUIRED TO ACCOMMODATE FINAL CEILING GRID AND LIGHTING LOCATIONS.
- LOCATE AND SET THERMOSTATS AND SENSORS AT LOCATIONS SHOWN ON PLANS. VERIFY EXACT LOCATIONS WITH ARCHITECT PRIOR TO INSTALLATION. INSTALL DEVICES WITH TOP OF DEVICE AT MAXIMUM 48" AFF TO MEET ADA REQUIREMENTS UNLESS OTHERWISE ON PLANS. PROVIDE INSULATED BACKING FOR THERMOSTATS MOUNTED ON EXTERIOR BUILDING WALLS. INSTALL WIRING IN CONDUIT PROVIDED BY DIVISION 26. AT A MINIMUM, PROVIDE CONDUIT IN THE WALL FROM THE JUNCTION BOX TO 6" ABOVE THE CEILING.
- COORDINATE THE LOCATION AND ELEVATION OF WALL-MOUNTED DEVICES WITH PRESENTATION BOARDS, DISPLAY CABINETS, SHELVES OR OTHER COMPONENTS SHOWN ON THE ARCHITECTURAL DRAWINGS THAT ARE TO BE INSTALLED UNDER OTHER DIVISIONS. CONTRACTOR WILL NOT BE REIMBURSED FOR RELOCATION OF WALL-MOUNTED DEVICES CAUSED BY A LACK OF COORDINATION.
- PROVIDE A MANUAL BALANCING DAMPER IN EACH DUCT TAKEOFF FROM SUPPLY, RETURN, OUTDOOR AND EXHAUST AIR DUCTS.
- PROVIDE A PREFABRICATED 45 DEGREE, HIGH EFFICIENCY, RECTANGULAR/ROUND BRANCH DUCT TAKEOFF FITTING FOR BRANCH DUCT CONNECTIONS AND TAKE-OFFS TO INDIVIDUAL DIFFUSERS, REGISTERS AND GRILLES. PROVIDE WITH INTEGRAL MANUAL BALANCING DAMPER AND LOCKING QUADRANT WHERE INDICATED ON PLANS.
- BRANCH DUCTWORK TO AIR OUTLETS SHALL BE SAME SIZE AS OUTLET NECK SIZE UNLESS OTHERWISE NOTED.
- REFER TO SPECIFICATIONS FOR DUCTWORK AND PIPING INSULATION REQUIREMENTS. DUCT SIZES ON MECHANICAL PLANS INDICATE CLEAR INSIDE AIRFLOW DIMENSIONS, INCREASE SHEET METAL SIZES ACCORDINGLY TO ACCOUNT FOR THICKNESS OF DUCT LINER.
- FLEXIBLE DUCTWORK SHALL NOT EXCEED 5'-0" IN LENGTH AND SHALL BE INSTALLED AND SUPPORTED TO AVOID SHARP BENDS AND SAGGING. REFER TO SPECIFICATIONS FOR ADDITIONAL REQUIREMENTS.
- RIGIDLY SUSPEND UNIT HEATER FROM STRUCTURE WITH SUPPORTING ANGLES AND ALL-THREAD HANGING RODS IN ACCORDANCE WITH MANUFACTURER'S RECOMMENDATIONS.
- PROVIDE A NEW SET OF AIR FILTERS IN UNITS PRIOR TO TESTING, ADJUSTING AND BALANCING AND BEFORE TURNING SYSTEM(S) OVER TO OWNER.

MECHANICAL EMS NOTES:

- COORDINATE ALL CONTROLS, EQUIPMENT ACCESSORIES, AND ASSOCIATED WORK WITH EMS VENDOR PRIOR TO ALL EQUIPMENT PURCHASES AND INSTALLATION.
- GENERAL CONTRACTOR IS RESPONSIBLE FOR COORDINATING WITH EMS VENDOR TO PROVIDE A FULLY FUNCTIONAL SYSTEM AT START-UP. FAILURE TO COORDINATE CONTROLS AND REQUIRED EQUIPMENT ACCESSORIES RESULTING IN MODIFICATIONS SHALL BE RESPONSIBILITY OF THE CONTRACTOR AT NO EXTRA COST TO THE OWNER.
- PROVIDE CARRIER ROOFTOP UNITS, AS APPLICABLE, WITH FACTORY INSTALLED BACKDRAFT OPEN BOARD CONTROLLER WITH SUPPLY AND OUTSIDE AIR TEMPERATURE SENSORS.
- THERMOSTATS AND SENSORS SHALL BE FURNISHED BY EMS VENDOR AND INSTALLED BY DIVISION 26 CONTRACTOR UNLESS NOTED OTHERWISE.
- PROVIDE ALL MOTORIZED DAMPERS ON PLAN, AS APPLICABLE, TO BE ABLE TO CONNECT TO ACTUATOR PROVIDED BY EMS VENDOR. MOTORIZED DAMPERS SHALL BE ACCESSIBLE FROM WITHIN SPACE VIA DUCT ACCESS PANELS. REFER TO SPECIFICATIONS FOR MORE INFORMATION.
- OUTDOOR SENSORS ASSEMBLY FOR ECONOMIZER CONTROL IS PROVIDED BY EMS VENDOR. PROVIDE CHASE LARGE ENOUGH FOR 1/4" POLY-TUBE AND (2) WIRE PULLS FOR EMS CONTROLS.

Architect:



ARCHITECT OF RECORD:
BRR ARCHITECTURE, INC.
315 WEST MAIN ST.
SUITE 300

www.brrarch.com
TEL: 913-262-9095
FAX: 913-262-9044

COPYRIGHT NOTICE

This drawing was prepared for use on a specific site contemporaneous with the issue date and it is not suitable for use on a different project or at a later date. Use of this drawing for reference or example on any other project without the written consent of properly licensed architects and engineers. Reproduction of this drawing for reuse on another project is not authorized and may be subject to legal action.

Engineer:



3545 LENEVA DRIVE, SUITE 300
LENEVA, KS 66214
TEL 913.742.5000 FAX 913.742.5001

WWW.HENDERSONENGINEERS.COM

21600231
AZ CORPORATE NO. 10470-0
EXPIRES 6/30/2023

Project Owner:



NIKE, Inc.
One Bowerman Drive
Beaverton, OR 97005
(503) 671-6453
www.nike.com

Project Address:

NIKE CLEARANCE STORE
TUCSON SPECTRUM
5325 S. CALLE SANTA CRUZ
TUCSON, AZ 85714
TEMPLATE ISSUE DATE: 11/28/2018

PROJECT DESIGN CONDITIONS

CLIMATE CONDITONS				BUILDING OPERATING HOURS:			
WEATHER STATION:		TUCSON INTL. AZ, USA		MONDAY - FRIDAY		TBD BY OWNER	
CLIMATE ZONE:		2B		SATURDAY		TBD BY OWNER	
HEATING (DB):		99.6% 31.8 °F		SUNDAY		TBD BY OWNER	
DESIGN HEATING CONDITIONS (DB):		29.4 °F		HOLIDAY		TBD BY OWNER	
HUMIDIFICATION (DP) HRV (MCOB):		99.6% -1.0 °F/ 5.7 gr/lb 61.2 °F					
COOLING (DB/MCOB):		0.4% 105.8 °F 66.0 °F					
DESIGN ENTHALPY CONDITIONS (DB/h):		0.4% 87.7 °F 37.8 °F					
DEHUMIDIFICATION (DP) HRV (MCOB):		0.4% 69.3 °F/ 118.2 gr/lb 76.3 °F					

UNIT / SPACE DESCRIPTION	SET POINTS												SPACE OPERATING HOURS OCCUPIED / UNOCCUPIED			NOTES
	COOLING / DEHUMIDIFICATION				HEATING				HUMIDIFICATION				ZONE VENTILATION RESET			
	OCC	UNOCC	MAX	MIN	OCC	UNOCC	MIN	MAX	CONTROL METHOD	BASE	MAXIMUM	PPM	PPM	M.F.	SAT	
RTU-1 BACK OF HOUSE	72	77	60%	NA	70	60	NA	NA	CO2	400	750	TBD	TBD	TBD	TBD	A - D
RTU-2 STOCKROOM	72	77	60%	NA	70	60	NA	NA	CO2	400	750	TBD	TBD	TBD	TBD	A - D
RTU-3,4,5,6 SALES FLOOR	72	77	60%	NA	70	60	NA	NA	CO2	400	750	TBD	TBD	TBD	TBD	A - D
RTU-7 SOLAR ZONE	72	77	60%	NA	70	60	NA	NA	NA	NA	NA	TBD	TBD	TBD	TBD	B - D

- NOTES:
- ZONE LEVEL VENTILATION RESET / DEMAND CONTROL VENTILATION (DCV) CONTROL METHOD: CARBON DIOXIDE SENSOR (CO2).
 - ZONE LEVEL SET POINT CONDITIONS SHALL BE AS SCHEDULED UNLESS OTHERWISE SCHEDULED OR NOTED ON THE DRAWINGS FOR ROOM SPECIFIC SPACE CONDITIONS.
 - ZONE LEVEL OCCUPANCY HOUR SCHEDULE SHALL BE PER BUILDING OPERATING HOURS UNLESS OTHERWISE SCHEDULED.
 - ZONE LEVEL CONTROLS SHALL BE CAPABLE OF OPERATING WITH INDEPENDENT OCCUPANCY SCHEDULES.

ROOFTOP UNIT CONTROL MATRIX

CONTROL FEATURE	UNITS	RTU-1 SETPOINT OR Y/N	RTU-2 SETPOINT OR Y/N	RTU-3,4,5,6 SETPOINT OR Y/N	RTU-7 SETPOINT OR Y/N	POINT TYPE INTERFACE WITH DCC (READ/WRITE)	NOTES
BUILDING AUTOMATION SYSTEM (BAS)							
ENERGY MANAGEMENT SYSTEM INTERFACE		Y	Y	Y	Y	BACNET	A
SETPOINTS							
COOLING - EFFECTIVE OCCUPIED COOLING SETPOINT	°F	72	72	72	72	READWRITE	
COOLING - EFFECTIVE UNOCCUPIED COOLING SETPOINT	°F	77	77	77	77	READWRITE	
COOLING - MINIMUM COOLING SUPPLY AIR TEMPERATURE (SAT) SETPOINT	°F	50	50	50	50	READWRITE	F
COOLING - LOCKOUT TEMPERATURE SETPOINT	°F	55	55	55	55	READWRITE	
DEAD BAND - MINIMUM HEATING AND COOLING TEMPERATURE SETPOINT DIFFERENCE	°F	2	2	2	2	READWRITE	
HEATING - EFFECTIVE OCCUPIED HEATING SETPOINT	°F	70	70	70	70	READWRITE	
HEATING - EFFECTIVE UNOCCUPIED HEATING SETPOINT	°F	60	60	60	60	READWRITE	
HEATING - MAXIMUM HEATING SUPPLY AIR TEMPERATURE (SAT) SETPOINT	°F	120	120	120	120	READWRITE	F
HEATING - LOCKOUT TEMPERATURE SETPOINT	°F	55	55	55	55	READWRITE	
PROGRAMMED CONTROL FEATURES							
DEMAND CONTROL VENTILATION (DCV) HIGH ALARM SETPOINT - CO2 SENSOR FEEDBACK	PPM	750	750	750	N/A	READWRITE	
EQUIPMENT ACCESSORIES AND CONTROL MODULES							
OUTSIDE AIR DAMPER - MOTOR OPERATED (MODULATING)	Y	Y	Y	Y	Y	READWRITE	M
INTEGRATED ECONOMIZER - DIFFERENTIAL DRY BULB AND DIFFERENTIAL ENTHALPHY	Y	Y	Y	Y	Y	READWRITE	G, H
ECONOMIZER FAULT DETECTION AND DIAGNOSTICS (FDD) SYSTEM	Y	Y	Y	Y	Y	READ	O
RELIEF - BAROMETRIC DAMPER	Y	Y	Y	Y	Y	READ	O
RELIEF - CONSTANT VOLUME POWERED EXHAUST FAN	N	N	Y	Y	Y	READ STATUS	N, O
HEAT PUMP COIL WITH REVERSING VALVE	Y	Y	Y	Y	Y	READ STATUS	E, F, K
SUPPLY FAN CONTROL METHOD							
ON DURING OCCUPIED HOURS	Y	Y	Y	Y	Y	READ	B
CYCLE WITH LOADS DURING UNOCCUPIED HOURS	Y	Y	Y	Y	Y	READ	B
UNIT START AND FAN OFF DELAY	Y	Y	Y	Y	Y	READ	B
OPTIMUM START SEQUENCE	Y	Y	Y	Y	Y	READ	C
VARIABLE VOLUME - 2-SPEED FAN CONTROL	Y	Y	Y	Y	Y	READ STATUS	C
SAFETIES, INTERLOCKS, AND ALARMS							
SUPPLY AIR SMOKE DETECTOR - FIRE SAFETY SHUTDOWN	Y	Y	Y	Y	Y	READ	D
RETURN AIR SMOKE DETECTOR - FIRE SAFETY SHUTDOWN	Y	Y	Y	Y	Y	READ	D
SAFETY CHAIN - SAFETY SHUTDOWN	Y	Y	Y	Y	Y	READ	D
SAT ALARM - SAFETY SHUTDOWN	Y	Y	Y	Y	Y	READ	D
SPT ALARM - SAFETY SHUTDOWN	Y	Y	Y	Y	Y	READ	D

EMS VENDOR SHALL PROVIDE CONTROL PANEL, RELAYS, THERMOSTATS, TEMPERATURE SENSORS, HUMIDITY SENSORS, AND/OR CO2 SENSORS WHERE SHOWN ON THE DRAWINGS AND AS REQUIRED TO FACILITATE THE SCHEDULED SEQUENCE OF OPERATION. EACH UNIT SHALL CONTROL BASED ON ITS OWN INTERNAL SAFETIES, TIME DELAYS, AND SEQUENCES UNLESS NOTED OTHERWISE. COORDINATE WITH OWNER FINAL BUILDING AND EQUIPMENT SCHEDULES DURING STARTUP.

- NOTES:
- EMS SHALL PROVIDE REMOTE SETPOINT ADJUSTMENT, SCHEDULING, AND MONITORING OF THE POINTS LISTED IN THE SCHEDULE FOR EACH UNIT. THE RTU SHALL BE SCHEDULED WITH A MINIMUM OF AN OCCUPIED AND UNOCCUPIED SCHEDULE. ADDITIONAL UNIT SCHEDULES SHALL BE AVAILABLE FOR REMOTE IMPLEMENTATION IF REQUIRED.
 - THE SUPPLY FAN SHALL RUN CONTINUOUSLY IN OCCUPIED MODE AND SHALL CYCLE ON AND OFF IN UNOCCUPIED MODE. A UNIT START DELAY IS USED WHEN TRANSITIONING FROM UNOCCUPIED TO OCCUPIED. FAN OFF DELAY ALLOWS THE SUPPLY FAN TO CONTINUE TO OPERATE AFTER HEATING AND COOLING STAGES.
 - VIA FACTORY W/D, THE CARRIER RTU OPEN BOARD SHALL DETERMINE FAN SPEED REQUIRED FOR HEATING AND COOLING. FACTORY VFD SHALL CONTROL, TO 2 FAN SPEEDS. LOW SPEED SHALL NOT EXCEED 60% OF FULL SPEED AND SHALL DRAW NO MORE THAN 40% OF FAN POWER AT FULL SPEED. DURING FAN ONLY OR SINGLE STAGE COOLING, SUPPLY FAN SHALL OPERATE AT LOW SPEED DURING HEATING, SECOND STAGE COOLING, DEHUMIDIFICATION OR FULL ECONOMIZER OPERATION. FAN SHALL OPERATE AT HIGH SPEED.
 - IF A LOCAL UNIT CONTROL ALARM IS ACTIVE, THE SUPPLY FAN TURNS OFF IMMEDIATELY REGARDLESS OF OCCUPANCY STATE OR DEMAND.
 - COOLING STAGES ARE CONTROLLED BY THE CARRIER RTU OPEN COOLING CONTROL, PID LOOP AND COOLING STAGES CAPACITY ALGORITHM. THEY CALCULATE THE REQUIRED NUMBER OF STAGES NEEDED TO SATISFY THE SPACE BY COMPARING THE SPACE TEMPERATURE TO THE EFFECTIVE OCCUPIED COOLING SETPOINT IN OCCUPIED MODE AND THE EFFECTIVE UNOCCUPIED COOLING SETPOINT IN UNOCCUPIED MODE. THE FOLLOWING CONDITIONS MUST BE TRUE FOR THE COOLING ALGORITHM TO OPERATE:
 - THE OUTDOOR AIR TEMPERATURE IS GREATER THAN THE COOLING LOCKOUT TEMPERATURE SETPOINT.
 - THE SUPPLY FAN HAS BEEN ON FOR AT LEAST 30 SECONDS.
 - THE UNIT HAS A VALID SUPPLY AIR TEMPERATURE INPUT.
 - THE UNIT HAS A VALID SPACE TEMPERATURE INPUT.
 - HEATING MODE IS NOT ACTIVE AND THE TIME GUARD BETWEEN MODES HAS EXPIRED.
 - ECONOMIZER IS UNAVAILABLE OR ECONOMIZER IS ACTIVE AND THE FOLLOWING ARE TRUE: (1) ECONOMIZER IS GREATER THAN 80% OPEN, (2) SUPPLY AIR TEMPERATURE IS GREATER THAN 5 DEGREES ABOVE THE MINIMUM COOLING SAT SETPOINT, AND (3) SPACE TEMPERATURE IS GREATER THAN 1.5 DEGREES ABOVE THE EFFECTIVE OCCUPIED TEMPERATURE SETPOINT.
 - WHEN THE COOLING ALGORITHM PRECONDITIONS ARE MET, THE COMPRESSORS ARE ENERGIZED IN STAGES, AS APPLICABLE. ANTI-RECYCLE TIMERS ARE EMPLOYED TO PROTECT THE EQUIPMENT FROM SHORT-CYCLING. THERE ARE FIXED THREE-MINUTE MINIMUM ON-TIMES AND FIVE-MINUTE OFF-TIMES FOR EACH COMPRESSOR OUTPUT.
 - DURING COMPRESSOR OPERATION, THE RTU OPEN CONTROL LOGIC MAY REDUCE THE NUMBER OF ACTIVE STAGES IF THE SUPPLY AIR TEMPERATURE FALLS BELOW THE MINIMUM COOLING SAT SETPOINT. A COMPRESSOR STAGED OFF IN THIS FASHION MAY BE STARTED AGAIN AFTER THE NORMAL TIME-GUARD PERIOD HAS EXPIRED IF THE SUPPLY AIR TEMPERATURE HAS INCREASED ABOVE THE MINIMUM COOLING SAT SETPOINT.
 - THE SYSTEM SHALL UTILIZE THE FACTORY MODULATING ECONOMIZER FOR FREE COOLING WHEN OUTDOOR AIR CONDITIONS ARE SUITABLE. FOR THE ECONOMIZER TO OPERATE DURING OCCUPIED HOURS, THE FOLLOWING CONDITIONS MUST BE TRUE:
 - OUTDOOR AIR TEMPERATURE IS LESS THAN THE SPACE TEMPERATURE AND LESS THAN THE ECONOMIZER HIGH OUT LOCKOUT SETPOINT.
 - THE INDOOR FAN HAS BEEN ON FOR AT LEAST 30 SECONDS.
 - THE UNIT HAS A VALID SUPPLY AIR TEMPERATURE INPUT.
 - THE UNIT HAS A VALID SPACE TEMPERATURE INPUT.
 - OUTDOOR AIR ENTHALPY IS LESS THAN THE SPACE ENTHALPY. (ENTHALPY STATUS SHALL READ 'LOW').
 - IF ANY OF THE PRECEDING CONDITIONS ARE NOT TRUE AND THE SUPPLY FAN IS ON HIGH SPEED, THE ECONOMIZER SHALL BE SET TO THE DCV MINIMUM OUTDOOR AIR DAMPER POSITION (TBD BY TAB CONTRACTOR). IF ANY OF THE PRECEDING CONDITIONS ARE NOT TRUE AND THE SUPPLY FAN IS ON LOW SPEED, THE ECONOMIZER SHALL BE SET TO THE LOW FAN ECONOMIZER MINIMUM DAMPER POSITION (TBD BY TAB CONTRACTOR). IF ALL OF THE PRECEDING CONDITIONS ARE TRUE, THE ECONOMIZER PID LOOP SHALL MODULATE THE DAMPER. THE ECONOMIZER POSITION SHALL BE REDUCED AS THE SUPPLY AIR TEMPERATURE FALLS TO WITHIN 5 DEGREES OF THE MINIMUM COOLING SAT SETPOINT, BUT SHALL NEVER CLOSE BELOW THE DCV MINIMUM OUTDOOR AIR DAMPER POSITION.
 - DURING UNOCCUPIED HOURS, UNOCCUPIED FREE COOLING SHALL BE ENABLED. THE ECONOMIZER SHALL REMAIN CLOSED UNLESS THE FOLLOWING CONDITIONS ARE TRUE:
 - OUTDOOR AIR TEMPERATURE IS BELOW THE ECONOMIZER HIGH OUT LOCKOUT SETPOINT.
 - OUTDOOR AIR TEMPERATURE IS LESS THAN THE SPACE TEMPERATURE.
 - OUTDOOR AIR ENTHALPY IS LESS THAN THE SPACE ENTHALPY. (ENTHALPY STATUS SHALL READ 'LOW').
 - IF ALL OF THE PRECEDING CONDITIONS ARE TRUE AND THE SPACE TEMPERATURE RISES 1 DEGREE ABOVE THE EFFECTIVE UNOCCUPIED COOLING SETPOINT, THE SUPPLY FAN SHALL START AND THE ECONOMIZER DAMPER SHALL OPEN AS NECESSARY TO COOL THE SPACE. THE DAMPER SHALL REMAIN OPEN UNTIL THE SPACE IS SATISFIED OR THE PRECEDING CONDITIONS ARE NO LONGER TRUE.
 - IF ANY OF THE PRECEDING CONDITIONS ARE NOT TRUE, THE ECONOMIZER SHALL CLOSE COMPLETELY.
 - DURING HEATING OPERATION, THE RTU OPEN CONTROL LOGIC MAY REDUCE THE NUMBER OF ACTIVE STAGES IF THE SUPPLY AIR TEMPERATURE EXCEEDS THE MAXIMUM HEATING SAT SETPOINT. A HEAT STAGE TURNED OFF IN THIS FASHION MAY BE STARTED AGAIN AFTER THE NORMAL TIME-GUARD PERIOD HAS EXPIRED IF THE SUPPLY AIR TEMPERATURE HAS DECREASED BELOW THE MAXIMUM HEATING SAT SETPOINT.
 - THE SYSTEM SHALL UTILIZE A CO2 SENSOR FOR THE SALES AREA, FITTING ROOM, STOCKROOM AND EACH OFFICE (HIGHEST READING WILL BE TAKEN FOR OFFICE DCV CONTROL). DCV IS CONTROLLED BY THE INDOOR AIR CO2 ALGORITHM. THE ALGORITHM CALCULATES THE CO2 MINIMUM DAMPER POSITION USING A PID LOOP. THE CALCULATED CO2 MINIMUM DAMPER POSITION IS THEN COMPARED AGAINST THE DCV MINIMUM POSITION SETPOINT AND THE GREATEST VALUE BECOMES THE FINAL MINIMUM DAMPER POSITION. DURING OCCUPIED HOURS, THE INDOOR AIR CO2 SEQUENCE SHALL BE ENABLED. THE FOLLOWING CONDITIONS MUST BE TRUE FOR THE INDOOR AIR CO2 ALGORITHM TO OPERATE:
 - THE SUPPLY FAN HAS BEEN ON FOR AT LEAST 30 SECONDS.
 - THE UNIT HAS A VALID CO2 SENSOR READING.
 - IF ALL OF THE PRECEDING CONDITIONS ARE TRUE, THE FACTORY OUTDOOR AIR DAMPER SHALL MODULATE BETWEEN ITS MINIMUM (ABS. MIN. O/A CFM) AND MAXIMUM (MIN. O/A CFM) POSITION (TBD BY TAB CONTRACTOR). THE SYSTEM SHALL START TO MODULATE THE DAMPER OPEN WHEN CO2 LEVEL RISES TO 100 PPM (ADJUSTABLE) ABOVE AMBIENT CO2 LEVEL (400 PPM) AND SHALL CONTINUE TO OPEN TO ITS MAXIMUM POSITION AS CO2 LEVEL RISES TO AND ABOVE THE DCV HIGH ALARM SETPOINT. AS THE CO2 LEVEL DROPS, THE DAMPER SHALL START TO MODULATE TO ITS MINIMUM POSITION. DURING UNOCCUPIED HOURS, THE INDOOR AIR CO2 SEQUENCE SHALL BE DISABLED.
 - POWERED EXHAUST FAN SHALL STAGE ON AND OFF ACCORDING TO DAMPER POSITION.
 - DEVICE SHALL BE FACTORY MOUNTED AND PRE-WIRED FOR OPERATION SUBJECT TO THE RTU OPEN CONTROLLER.

OUTSIDE AIR REQUIREMENTS, IMC-2018 (IP)

SYSTEM DESIGNATION	SYSTEM TYPE:	SINGLE-ZONE SYSTEMS		MULTI-ZONE SYSTEMS		FLOOR AREA SERVED BY SYSTEM (A _F) [SF]	SYSTEM AVERAGED AREA-BASED OUTDOOR AIR RATE (CFM/SF)	SYSTEM POPULATION [P ₀] (PEOPLE)	SYSTEM AVERAGED PEOPLE-BASED OUTDOOR AIR RATE (CFMP)	REQUIRED OA INTAKE FLOW [V ₀] (CFM)	REQUIRED DCV OA INTAKE FLOW [V ₀] (CFM)	DESIGN OA INTAKE FLOW [V ₀] (CFM)	DESIGN DCV OA INTAKE FLOW [V ₀] (CFM)	NOTES
		VENTILATION SYSTEM ASSOCIATED WITH	WORST CASE ZONE AIR DISTRIBUTION EFFECTIVENESS [E _Z]	SYSTEM VENTILATION EFFICIENCY [E _V]	SYSTEM AVERAGED OUTDOOR AIR RATE (CFM/SF)									
RTU-1	MULTI-ZONE	-	-	0.60	1.87	1,187	0.052	16.00	5.0	237	103	250	125	ALL
RTU-2	MULTI-ZONE	-	-	0.89	4.84	1,392	0.119	1.51	10.0	657	640	700	640	ALL
RTU-3,4,5,6,7	SINGLE-ZONE	SALES FLOOR	1.00	-	-	-	0.120	200.88	7.5	3,114	1,807	3,200	1,620	ALL
TOTALS										4,066	2,380	4,150	2,425	

- NOTES:
- VENTILATION CALCULATIONS BASED ON 2018 INTERNATIONAL MECHANICAL CODE.
 - SYSTEM POPULATIONS BASED ON MAX SEATING AND/OR CODE MAXIMUM VALUES.
 - MULTI-ZONE RECYCLATING SYSTEMS: CALCULATOR TAKES THE MAXIMUM OUTSIDE AIRFLOW REQUIRED BY IMC. ON A SYSTEM LEVEL. THE CALCULATION USED TO DETERMINE VENTILATION AIRFLOW IN COMPLIANCE WITH VRP AND SECTION 60.4. VENTILATION RATE SHOWN IS ACTUAL, CALCULATED WITH CORRECTION FACTORS INCLUDED. EACH ZONE IS CALCULATED WITH ITS WORST CASE ZONE AIR DISTRIBUTION EFFECTIVENESS (HEATING/COOLING) AS PART OF CALCULATIONS TO FIND E_Z.

ROOFTOP UNIT SCHEDULE (DX HEAT PUMP)

MARK	MANUFACTURER	MODEL	NOMINAL TONS	SUPPLY FAN				COOLING COIL										HEAT PUMP HEATING COIL				MIN O/A CFM	ABS O/A MIN	ELECTRICAL			WEIGHT (LBS)	NOTES	
				CFM	ESP (IN)	BHP (Y/N)	TH (MBH)	SH (MBH)	EAT (°F WB)	LAT (°F DB)	REFR (°F WB)	MIN EFF (EER)	MIN EFF (EEER)	MIN NO STAGES	MIN OUT (MBH)	AMBIENT (°F DB)	EAT (°F DB)	LAT (COP)	MIN EFF	MCA	MCCP								
RTU-1	CARRIER	50GCC005A	4	1,500	0.9	0.85	N	37.2	27.8	74.6	63.1	56.2	54.5	R-410A	-	16.2	2	35.2	25	57.9	85	3.4	700	640	2083	44	50	1300	A - V, Z
RTU-2	CARRIER	50HCC090	7.5	2,250	1.0	0.82	Y	77.5	57.5	76.4	64.1	53.8	53.3	R-410A	12.3	13.6	2	69.2	25	57.9	85	3.4	700	640	2083	44	50	1300	A - V, Z
RTU-3	CARRIER	50HCC012D	10	3,000	1.2	1.72	Y	93.2	63.3	76.5	64.5	55.6	53.8	R-410A	12.3	13.6	2	81.6	25	58.3	85	3.5	800	455	2083	53	60	1900	A - V, Z
RTU-4	CARRIER	50HCC012D	10	3,000	1.2	1.72	Y	93.2	63.3	76.5	64.5	55.6	53.8	R-410A	12.3	13.6	2	81.6	25	58.3	85	3.5	800	455	2083	53	60	1900	A - V, Z
RTU-5	CARRIER	50HCC012D	10	3,000	1.2	1.72	Y	93.2	63.3	76.5	64.5	55.6	53.8	R-410A	12.3	13.6	2	81.6	25	58.3	85	3.5	800	455	2083	53	60	1900	A - V, Z
RTU-6	CARRIER	50HCC012D	10	3,000	1.2	1.72	Y	93.2	63.3	76.5	64.5	55.6	53.8	R-410A	12.3	13.6	2	81.6	25	58.3	85	3.5	800	455	2083	53	60	1900	A - V, Z
RTU-7	CARRIER	50HCC090	7.5	3,750	1.0	2.09	Y	98.7	84.4	74.0	67.7	61.9	48.9	R-410A	12.0	13.8	2	69.0	25	69.0	85	3.4	0	0	2083	48	60	1300	A - V, Z

MODEL NUMBERS AND NOMINAL TONS LISTED SHALL NOT BE CONSIDERED COMPLETE AND MATERIAL SHALL NOT BE ORDERED BY MANUFACTURER. MODEL NUMBERS, OR NOMINAL TONS ONLY. REVIEW THE COMPLETE DESCRIPTION, NOTES AND SPECIFICATIONS TO DETERMINE THE EXACT MATERIAL AND ACCESSORIES TO BE ORDERED. THE MANUFACTURERS LISTED ARE THE BASIS FOR THE DESIGN.

- NOTES:
- REFER TO ROOFTOP UNIT CONTROL MATRIX FOR CONTROL FEATURES, MODULES, AND ACCESSORIES THAT SHALL BE PROVIDED WITH THE EQUIPMENT.
 - EQUIPMENT SIZED FOR 25° AMBIENT TEMPERATURE DURING HEATING MODE AND 115° AMBIENT TEMPERATURE DURING COOLING MODE.
 - PROVIDE 2 INCH MERV 13 EFFICIENT PLEATED THROWAWAY AIR FILTERS.
 - PROVIDE FACTORY MOUNTED DISCONNECT INSTALLED ON SERVICE SIDE OF UNIT.
 - STARTERS FOR ALL MOTORS SHALL BE FURNISHED INTEGRAL WITH UNIT.
 - PROVIDE FACTORY MOUNTED VARIABLE FREQUENCY DRIVE OR SPEED MOTOR TO FACILITATE STAGED FAN SPEED CONTROL.
 - PROVIDE SHAFT GROUNDING SYSTEM ON MOTOR. REFER TO MOTOR SPECIFICATION FOR ADDITIONAL INFORMATION.
 - PROVIDE SINGLE POINT POWER CONNECTION.
 - COORDINATE SIZE OF CONDUCTOR TERMINATION LUGS WITH CONDUCTOR SIZES SHOWN ON ELECTRICAL DRAWINGS.
 - PROVIDE 125 VAC, 20 AMP DUPLEX CONVENIENCE RECEPTACLE MOUNTED TO UNIT READY FOR FIELD WIRING WITH A COVER UL LISTED FOR WET AND DAMPER LOCATIONS WHEN IN USE.
 - SPECIFIED FAN ESP ACCOUNTS FOR DUCT LOSSES EXTERNAL TO UNIT.
 - PROVIDE MOTOR HORSERPOWER TO OVERCOME INTERNAL STATIC PRESSURE DROP PLUS SPECIFIED EXTERNAL STATIC PRESSURE DROP. NOMINAL MOTOR HP SHALL BE NO LARGER THAN THE FIRST AVAILABLE NOMINAL MOTOR SIZE GREATER THAN THE REQUIRED BHP.
 - DIVISION 23 SHALL PROVIDE ROOF CURB ADAPTER FROM EXISTING CURB PENETRATION TO NEW UNIT. COORDINATE CURB ADAPTER TYPE WITH EXISTING CURB CONDITIONS AND EQUIPMENT MANUFACTURER.
 - SCHEDULED WEIGHT IS THE MAXIMUM ALLOWABLE OPERATING WEIGHT OF THE EQUIPMENT AND CURB ADAPTER.
 - COOLING COIL LAT IS LEAVING AIR TEMPERATURE OF THE UNIT.
 - PROVIDE GUARDS TO PROTECT CONDENSER COIL FROM HAL OR OTHER DAMAGE.
 - TOTAL HEAT PUMP HEATING COIL CAPACITY AT THE AMBIENT DRY BULB TEMPERATURE LISTED. HEAT PUMP HEATING COIL MINIMUM EFFICIENCY IS CALCULATED AT 47°F.
 - SELECT EQUIPMENT FOR ELEVATION OF 2500 FEET ABOVE SEA LEVEL.
 - ABS. MIN. O/A IS THE ABSOLUTE MINIMUM OUTSIDE AIR CFM USING VENTILATION RESET OR DEMAND CONTROL VENTILATION.
 - PROVIDE UNIT WITH FACTORY MOUNTED UNIT CONTROLLER WITH SUPPLY AND OUTSIDE AIR TEMPERATURE SENSORS. UNIT MOUNTED CONTROLLED SHALL BE ABLE TO INTERFACE WITH EMS CONTROLS AND BE BACNET MSTP COMPATIBLE. COORDINATE ALL CONTROLS WITH EMS VENDOR PRIOR TO PURCHASE.
 - PROVIDE WITH DUCT SMOKE DETECTOR KIT. SMOKE DETECTORS SHALL SHUT DOWN UNIT UPON ALARM.
 - PROVIDE UNIT WITH FACTORY INSTALLED BACNET OPEN BOARD CONTROLLER WITH SUPPLY AND OUTSIDE AIR TEMPERATURE SENSORS. COORDINATE ALL CONTROLS WITH EMS VENDOR PRIOR TO PURCHASE.


CARRIER NATIONAL ACCOUNT CONTACT
 MATT MURPHY
 STRATEGIC ACCOUNT MANAGER
 CARRIER CORPORATION
 MOBILE: 830.235.1616
 EMAIL: MATT.MURPHY@CARRIER.COM

FAN SCHEDULE


MARK	SERVICE DESCRIPTION	MANUFACTURER	MOUNTING	MODEL	CFM	ESP (IN)	BHP	NOM HP	FAN RPM	DRIVE (BELT/DIRECT)	VFD	ELECTRICAL	WEIGHT (LBS)	NOTES
EF-1	RESTROOM	GREENHECK	ROOF	G-680-VG	325	0.5	0.05	1/16	1548	DIRECT	N	120V1	30	B, C, D, F, G, H, L
EF-2	IT CLOSET	GREENHECK	INLINE	SQ-100-VG	1000	0.3	0.13	1/4	1385	DIRECT	N	120V1	45	A, E, F, G, H, K

MODEL NUMBERS SHALL NOT BE CONSIDERED COMPLETE AND MATERIAL SHALL NOT BE ORDERED BY MANUFACTURER AND MODEL NUMBERS ONLY. REVIEW THE COMPLETE DESCRIPTION, NOTES AND SPECIFICATIONS TO DETERMINE THE EXACT MATERIAL AND ACCESSORIES TO BE ORDERED. THE MANUFACTURERS LISTED ARE THE BASIS FOR THE DESIGN.

- NOTES:
- INSTALL FAN WITHIN 18"-0" ABOVE FLOOR OR WITHIN 12" OF CEILING FOR SERVICEABILITY. COORDINATE LOCATION WITH STRUCTURE, LIGHTS, PIPING, AND DUCTWORK SUCH THAT FAN IS FULLY ACCESSIBLE.
 - CONTRACTOR SHALL PROVIDE BIRDSHIELD AND MOTORIZED DAMPER CAPABLE OF ACCEPTING ACTUATOR PROVIDED BY EMS VENDOR. COORDINATE CONNECTIONS WITH EMS VENDOR PRIOR TO INSTALLATION.
 - PROVIDE INSULATED ROOF WITH MINIMUM HEIGHT REQUIRED TO MAINTAIN BOTTOM OF EQUIPMENT A MINIMUM OF 18 INCHES ABOVE FINISHED ROOF SURFACE. PROVIDE SLOPED CURB IF NEEDED TO MATCH ROOF SLOPE. COORDINATE WITH ROOF INSULATION THICKNESS AND ROOF TAPER AT INSTALLED LOCATION. COORDINATE CURB TYPE WITH DRAWINGS.
 - INSTALL EXHAUST FAN OR EXTERIOR DUCT TERMINATION TO MAINTAIN A MINIMUM OF 15'-0" FROM AIR INTAKES.
 - PROVIDE WITH RUBBER IN SHEAR ISOLATION AND ALL-THREAD HANGING RODS.
 - PROVIDE WITH FACTORY MOUNTED STARTER AND DISCONNECT SWITCH.
 - PROVIDE WITH FACTORY MOUNTED CONTROL POWER TRANSFORMER CAPABLE OF ACCEPTING A 24V RELAY FROM EMS.
 - PROVIDE WITH MANUFACTURER'S ELECTRONICALLY COMMUTATED (EC) MOTOR. CONTRACTOR SHALL USE FAN POTENTIOMETER FOR BALANCING PURPOSES.
 - INTERLOCK FAN OPERATION WITH SPACE TEMPERATURE SENSOR. 24V RELAY FURNISHED BY EMS VENDOR.
 - INTERLOCK FAN OPERATION WITH EMS. 24V RELAY FURNISHED BY EMS VENDOR.

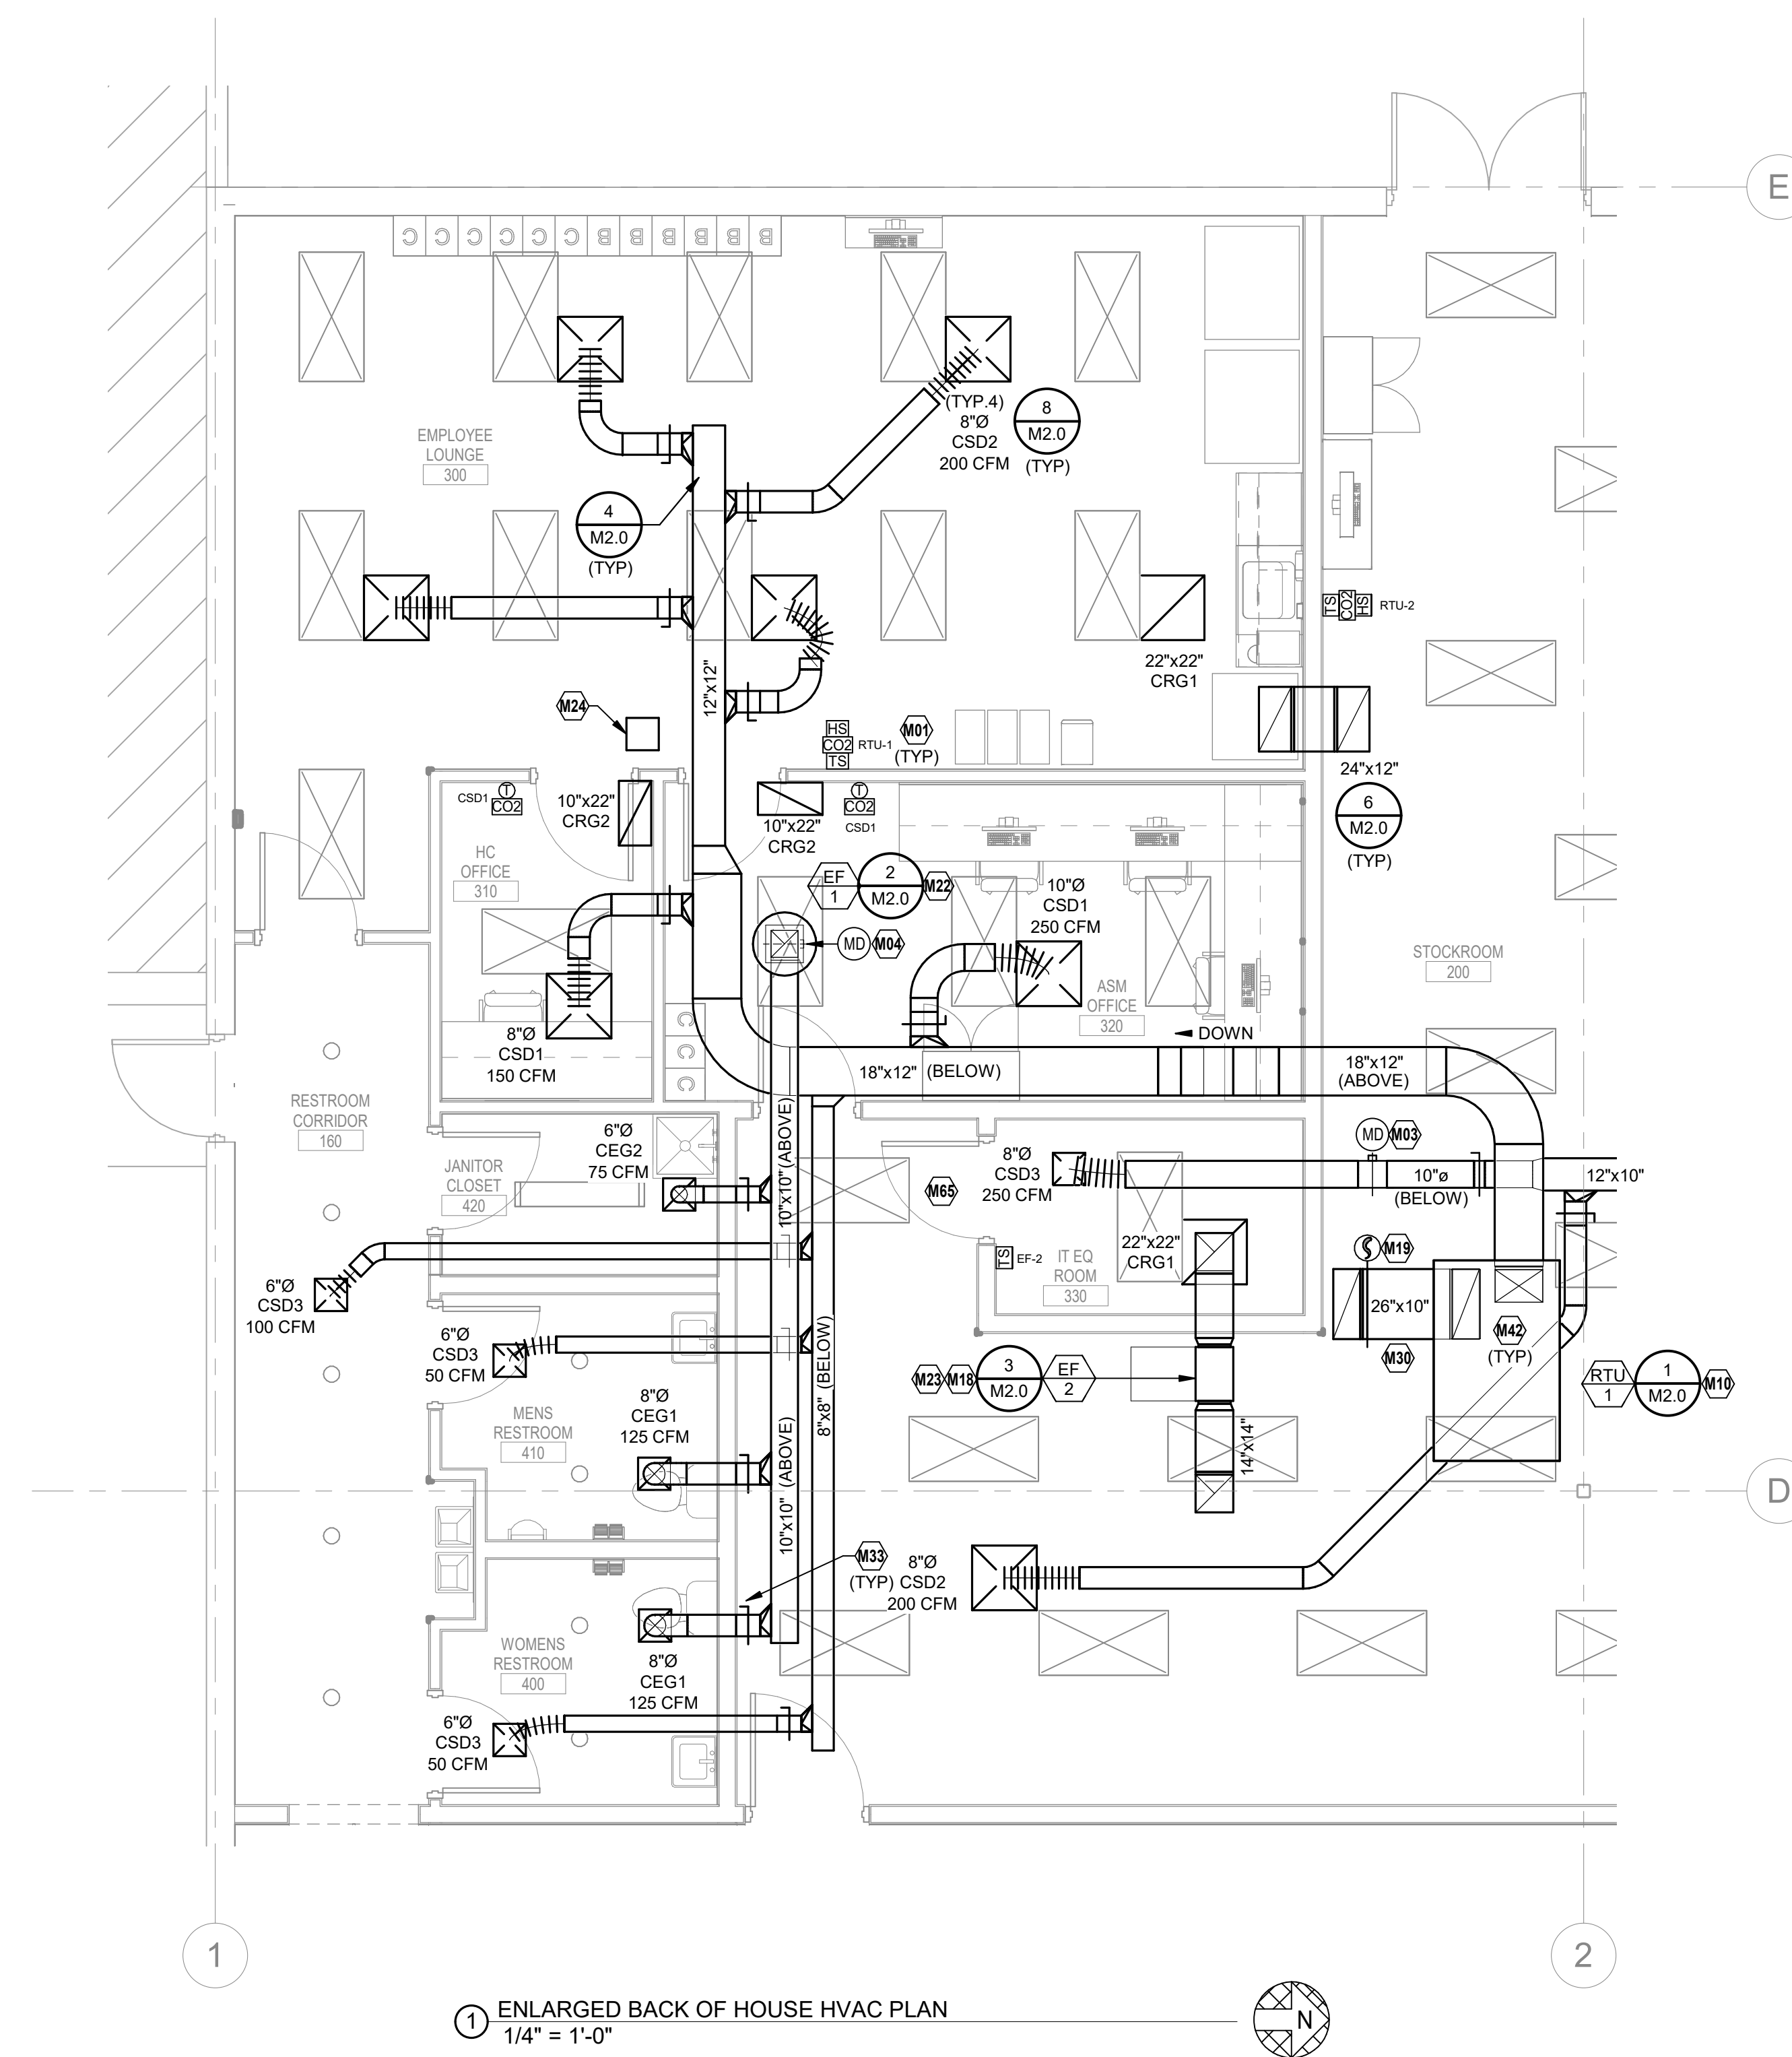

1 ENLARGED BACK OF HOUSE HVAC PLAN
1/4" = 1'-0"

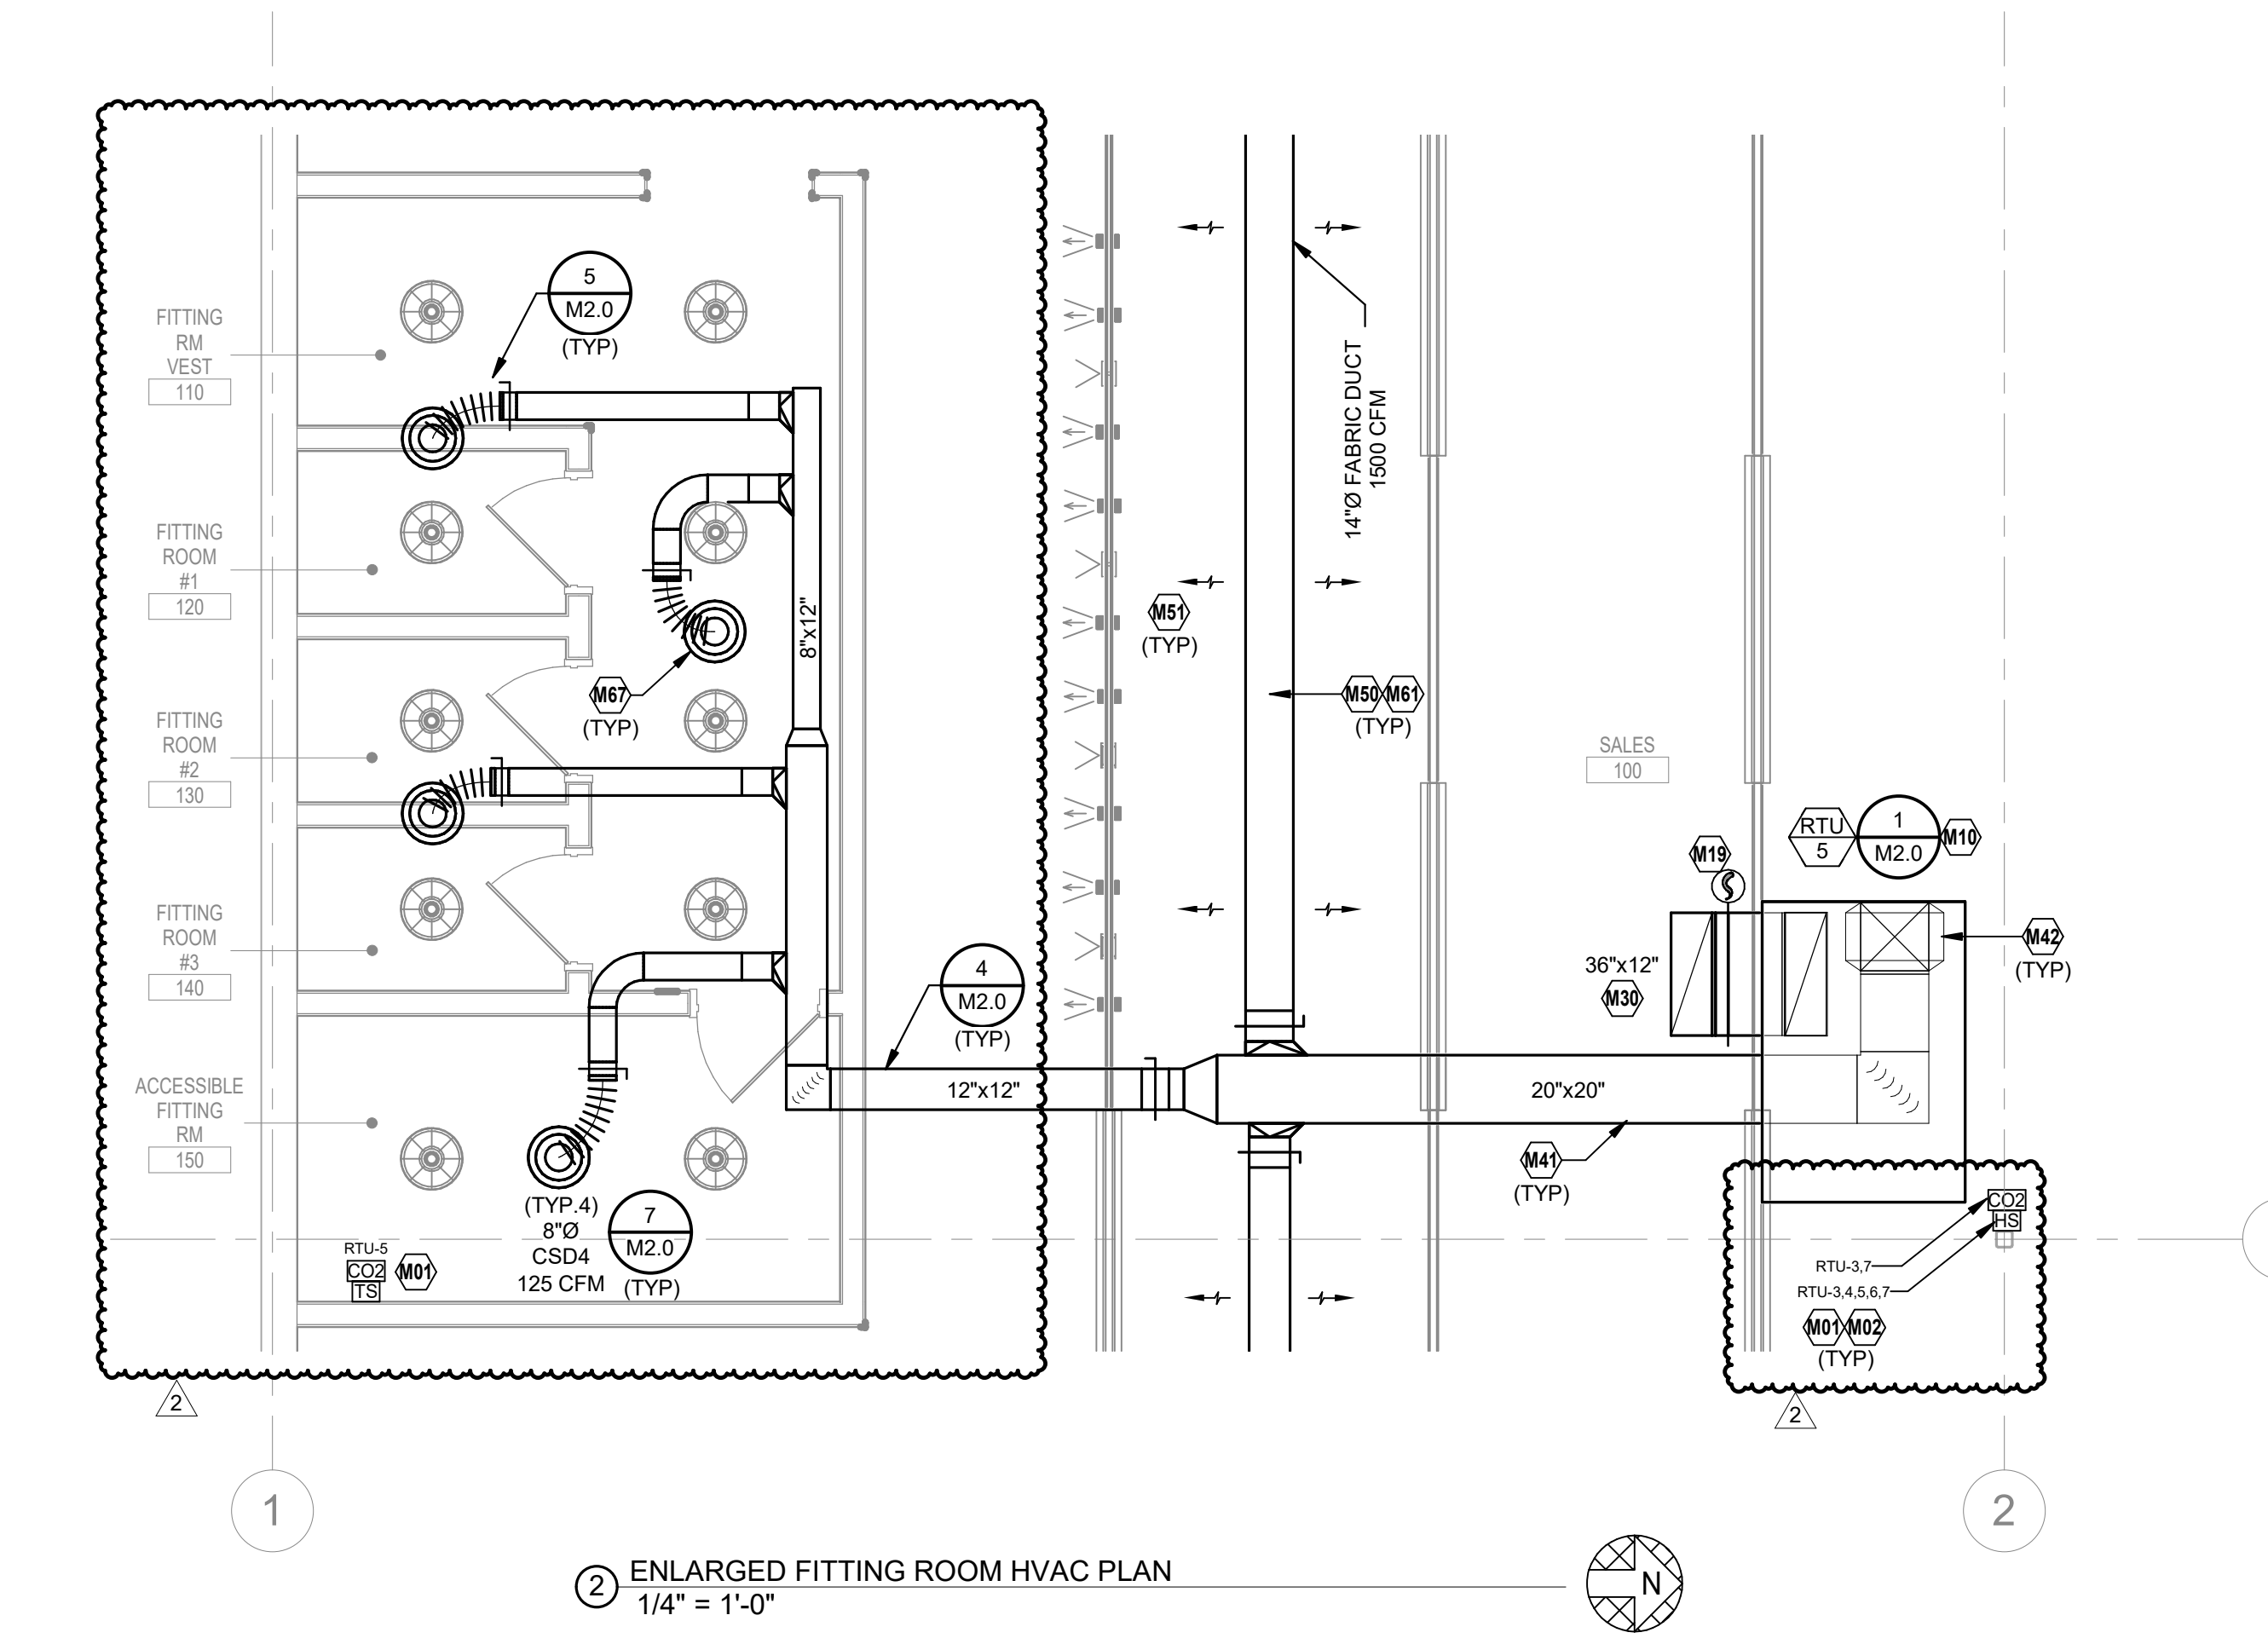

2 ENLARGED FITTING ROOM HVAC PLAN
1/4" = 1'-0"

KEYNOTES ARE PROTOTYPICAL. MISSING KEYNOTE NUMBERS INDICATE A PROTOTYPICAL NOTE IS NOT USED OR REMOVED.

MECHANICAL PLAN NOTES

- M01 ALL THERMOSTATS AND SENSORS ARE FURNISHED BY EMS VENDOR AND INSTALLED BY DIVISION 26, UNLESS NOTED OTHERWISE.
- M02 DO NOT INSTALL SENSORS ON WALL GRAPHICS. CONFIRM LOCATIONS OF SENSORS WITH PM PRIOR TO INSTALLATION.
- M03 INSTALL DAMPER AND ACTUATOR IN LOCATION INDICATED DAMPER FURNISHED BY DIVISION 23. ACTUATOR FURNISHED BY EMS VENDOR.
- M04 MOTORIZED DAMPER SHALL BE ACCESSED THROUGH FAN ON ROOF AND IS SHOWN ON PLAN FOR REFERENCE ONLY. REFER TO MECHANICAL SCHEDULES FOR MORE INFORMATION.
- M10 PROVIDE NEW ROOFTOP UNIT AS SCHEDULED WITH NEW CURB ADAPTER FROM EXISTING CURB. PROVIDE A NEW SET OF MERV 13 AIR FILTERS IN UNIT BEFORE TURNING SYSTEM OVER TO OWNER. COORDINATE CONDENSATE PIPING WITH DIVISION 25.
- M18 ACCESS TO HVAC EQUIPMENT SHALL BE FROM LAY-IN CEILING. NO CEILING DEVICES SHALL BE PLACED IN THIS LOCATION. COORDINATE FINAL INSTALLED LOCATION SUCH THAT THE HVAC EQUIPMENT REMAINS ACCESSIBLE. VERIFY NO OTHER PIPING, ELECTRICAL CONDUIT, STRUCTURE, AND/OR CEILING SUPPORTS IMPEDE ACCESS IN ANY WAY. INSTALL HVAC EQUIPMENT WITHIN 24" ABOVE CEILING FOR SERVICEABILITY.
- M19 SMOKE DETECTORS AND WIRING IN RETURN AIR DUCTS SHALL BE PROVIDED BY DIVISION 26 CONTRACTOR. SMOKE DETECTORS SHALL SHUT-DOWN UNIT UPON ALARM.
- M22 PROVIDE NEW ROOF-MOUNTED EXHAUST FAN AS SCHEDULED FOR GENERAL RESTROOM EXHAUST.
- M23 EXHAUST FAN SERVES TO PROVIDE TRANSFER AIR ONLY AND SHALL DISCHARGE AIR INTO THE STOCKROOM PLENUM.
- M24 INSTALL VAV POWER MODULE FOR CONTROL OF OFFICE VAV DIFFUSERS IN AN ACCESSIBLE LOCATION ABOVE THE CEILING. DIVISION 26 CONTRACTOR SHALL PROVIDE 120V POWER TO MODULE. REFER TO ELECTRICAL DRAWINGS FOR DETAILS.
- M30 ROUTE SHEET METAL RETURN AIR DUCT AS SHOWN WITH TERMINATION DIRECTED UPWARD. SIZE PLENUM FULL SIZE OF RETURN AIR INLET. PROVIDE DUCT LINER IN RETURN AIR DUCTWORK FOR SOUND ATTENUATION. COVER INLET WITH 1/2"x1/2" BIRD SCREEN.
- M33 EXHAUST AIR DAMPERS SHALL BE ACCESSIBLE FROM STOCKROOM LAY-IN CEILING. COORDINATE FINAL INSTALLED LOCATION SUCH THAT THE DAMPERS REMAIN ACCESSIBLE.
- M41 COORDINATE DUCT ROUTING WITH LIGHTS AND STRUCTURE. ROUTE ALL SALES DUCTWORK AT SAME ELEVATION BELOW STRUCTURE AND ABOVE LIGHTING.
- M42 ROUTE SUPPLY AND RETURN DUCTWORK TO ROOF CURB DUCT CONNECTIONS AND TRANSITION DUCTWORK IN RISER AS NECESSARY.
- M50 INSTALL FABRIC DUCT ABOVE ARCHITECTURAL LIGHTING GRID. REFER TO BOXED NOTES FOR ADDITIONAL INFORMATION.
- M51 ARROWS INDICATE DIRECTION AND DISPERSION OF AIRFLOW VOLUME. PROVIDE VENTS ON FABRIC DUCT TO DIRECT AIRFLOW AS SHOWN ON PLAN.
- M61 SUPPORT FABRIC DUCTWORK WITH MANUFACTURER'S DOUBLE-CABLE CROSS BRACING SUPPORTS. COORDINATE REQUIREMENTS WITH FABRIC DUCT MANUFACTURER.
- M65 LOUVERED DOOR FOR MAKEUP AIR BY GENERAL CONTRACTOR. REFER TO ARCHITECTURAL DRAWINGS FOR MORE INFORMATION.
- M67 COORDINATE LOCATION OF FITTING ROOM DIFFUSERS WITH LIGHTS, SPRINKLERS, SPEAKERS, AND OTHER CEILING DEVICES FOR A NEAT AND ORDERLY INSTALLATION. INSTALL CEILING DEVICES IN-LINE WITH EACH OTHER WHERE POSSIBLE.

INSTALL DUCTWORK AND PIPING AS TIGHT TO STRUCTURE AS POSSIBLE. COORDINATE WITH OTHER TRADES TO AVOID CONFLICTS. COORDINATE INSTALLATION OF DUCTWORK AND PIPING TO AVOID CONFLICTS WITH ELECTRICAL PANELS, LIGHTING FIXTURES, ETC. DO NOT INSTALL DUCTWORK BELOW THE BOTTOM OF THE LIGHT FIXTURES. NOTIFY CONSTRUCTION PROJECT MANAGER OF CONFLICTS.

FABRIC DUCT GENERAL NOTES:
 PROVIDE FABRIC DUCT THROUGHOUT THE SPACE AS SHOWN ON PLAN. FABRIC DUCT SHALL NOT REPLACE RECTANGULAR DUCT DROPS OR EXHAUST DUCTS. BASIS OF DESIGN SHALL BE "PRHODA" NMW NONPOROUS FABRIC WITH "PERFORATIONS" (AIR OPENINGS) WITH ADJUSTABLE FLOW DEVICES (I.E. AFD'S) AT OPENINGS, AND ONE ROW, GALVANIZED CABLE. INTERNAL HOOP SUPPORT SYSTEM SHALL BE PROVIDED ON ALL FABRIC DUCT UNLESS NOTED OTHERWISE. INCLUDE ALL COMPONENTS AND ACCESSORIES REQUIRED TO MAKE A COMPLETE SYSTEM AS RECOMMENDED BY PRHODA DURING BID PHASE, INCLUDING HANGING STRAPS AND CLIPS, END-CAPS, CONNECTIONS TO METAL DUCTS, ETC. PRHODA FABRIC DUCT SHALL BE SIZED PER FACTORY RECOMMENDATIONS TO PROVIDE MINIMUM AIRFLOWS IN BRANCH DUCTS AS SHOWN. CONFIRM FABRIC DUCT COLOR WITH ARCHITECT PRIOR TO ORDERING ON ALL PROJECTS. (FOR UNITE FIXTURE PACKAGE, WHITE IS BASIS OF DESIGN) (FOR GLOBAL 3.0 FIXTURE PACKAGE, PANTONE 420 - LIGHT GREY IS BASIS OF DESIGN). CONTACT PRHODA SALES DEPARTMENT (E-MAIL: SALES@PRHODA-NA.COM, PHONE: 1-855-774-4652) FOR PRICING INFORMATION.

FABRIC DUCT DESIGN GUIDELINE:
 DISTRIBUTE AIRFLOW EVENLY ALONG FABRIC DUCT IN THE DIRECTION OF FLOW ARROWS. ORIENT AND SIZE FABRIC DUCT DIFFUSER OPENINGS TO PROVIDE A 50 FPM THROUGH VELOCITY HALF WAY TO THE NEAREST ADJACENT FABRIC DUCT OR TO THE NEAREST PARTITIONING WALL AS APPLICABLE. VENTS ON FABRIC DUCT SHALL BE LOCATED AT 22.5 DEGREES BELOW HORIZONTAL UNLESS NOTED OTHERWISE.

FABRIC DUCT COORDINATION NOTE:
 DURING THE FIRST WEEK OF THE PROJECT, THE GENERAL CONTRACTOR'S SUPERINTENDENT, MECHANICAL SUB-CONTRACTOR, AND A REPRESENTATIVE FROM PRHODA SHALL MEET AT THE PROJECT SITE FOR CONFIRMATION OF ALL FIELD DIMENSIONS AND POTENTIAL OBSTRUCTIONS. THIS EVENT MUST PRECEDE THE ORDERING OF ANY MATERIALS FROM PRHODA. CHANGE ORDERS AND EXPANDING FEES WILL NOT BE APPROVED DUE TO LACK OF ON-SITE COLLABORATION AND/OR MEASUREMENT DURING SITE MEETINGS AT PROJECT COMMENCEMENT.

FABRIC DUCT INSTALLATION NOTE:
 INSTALL FABRIC DUCT ABOVE ARCHITECTURAL LIGHTING SYSTEM. COORDINATE FABRIC DUCT INSTALLATION WITH GENERAL CONTRACTOR AND DIVISION 26. GENERAL CONTRACTOR SHALL VERIFY FABRIC DUCT IS INSTALLED SUCH THAT IT DOES NOT CLASH WITH ARCHITECTURAL LIGHTING SYSTEM, INCLUDING LIGHT FIXTURES, ARCHITECTURAL LIGHTING SYSTEM GRID AND SUSPENSION CABLES, OR ANY OTHER SUSPENDED FIXTURES WHEN DEFLATED.

THE DUCTWORK LAYOUT INDICATED ON THE DRAWINGS IS SCHEMATIC AND SHOWS DESIGNED INTENT ONLY. PRIOR TO FABRICATION AND INSTALLATION OF DUCTWORK, DIVISION 23 SHALL HAVE A QUALIFIED, EXPERIENCED SKETCHER PREPARE AND SUBMIT SHEET METAL SHOP DRAWINGS. SHOP DRAWINGS SHALL TAKE INTO ACCOUNT ALL EXISTING CONDITIONS, INCLUDING BUT NOT LIMITED TO, STRUCTURAL MEMBERS, CONDUITS AND PIPING TO REMAIN. SHOP DRAWINGS SHALL ALSO TAKE INTO ACCOUNT ALL NEW DESIGN CONDITIONS, INCLUDING BUT NOT LIMITED TO, STRUCTURAL MEMBERS, PIPING, CEILINGS, SOFFIT HEIGHTS, AND LIGHT FIXTURES.

SHOP DRAWINGS SHALL INDICATE ALL REVISIONS TO THE LAYOUT REQUIRED TO ACCOMMODATE THE EXISTING CONDITIONS AND/OR MAINTAIN THE CEILING HEIGHTS AND CLEARANCES REQUIRED. NOTIFY THE ARCHITECT AND ENGINEER OF ANY LOCATION WHERE THE DESIGN INTENT CANNOT BE MET PRIOR TO FABRICATION AND INSTALLATION OF DUCTWORK. REVISIONS TO DUCTWORK, EQUIPMENT, CONDUIT AND/OR PIPING REQUIRED BY CONTRACTOR'S FAILURE TO SUBMIT PROPERLY PREPARED SHOP DRAWINGS SHALL BE THE RESPONSIBILITY OF DIVISION 23 AT NO ADDITIONAL COST TO THE CLIENT OR DELAY TO THE PROJECT SCHEDULE.

GENERAL CONTRACTOR IS RESPONSIBLE FOR PROVIDING TO ARCHITECT, ENGINEER, LANDLORD, AND BUILDING OFFICIAL/INSPECTOR A FINAL TEST AND BALANCE REPORT PER THE SPECIFICATIONS. PROVIDE TEST AND BALANCE REPORT TO ARCHITECT, ENGINEER, AND LANDLORD PRIOR TO THE FINAL BUILDING INSPECTION.

LANDLORD REQUIREMENTS:
 LANDLORD APPROVED ROOFING CONTRACTOR SHALL BE RESPONSIBLE FOR MAKING ALL CUTS THROUGH THE EXISTING ROOF, MODIFYING EXISTING OPENINGS, AND/OR ALTERING CURB FLASHING AT GENERAL CONTRACTOR'S EXPENSE. COORDINATE WITH GENERAL CONTRACTOR.

EMS CONTROLS:
 CONTRACTORS ARE RESPONSIBLE FOR COORDINATING ALL EQUIPMENT CONTROLS WITH EMS VENDOR PRIOR TO PURCHASE AND INSTALLATION. CONTRACTORS SHALL COORDINATE WITH EMS VENDOR TO PROVIDE ALL NECESSARY EQUIPMENT AND ACCESSORIES FOR A FULLY FUNCTIONING SYSTEM.

TEMPERATURE CONTROLS:
 EMS VENDOR SHALL FURNISH SENSORS AND CONTROL COMPONENTS AS INDICATED ON PLANS AND AS NECESSARY TO ACCOMPLISH THE INTENT OF THE DRAWINGS. ALL CONTROLS SHALL BE TIED INTO THE EMS SYSTEM UNLESS NOTED OTHERWISE.

GENERAL CONTRACTOR SHALL INSTALL CARRIER FURNISHED TEMPORARY THERMOSTATS AND FEED THE WIRING DOWN INTO THE SPACE FOR START UP AND CONTROL OF RTU(S) UNTIL THE EMS SYSTEM IS OPERABLE. REFER TO M3.0 FOR CARRIER CONTACT INFORMATION.

PROVIDE RFIID DUCTWORK MESH OVER TRANSFER GRILLS BELOW 15'-0" AFF BETWEEN THE STOCKROOM AND THE SALES FLOOR, IF APPLICABLE. COORDINATE REQUIREMENTS WITH CONSTRUCTION PROJECT MANAGER.

Architect:
brr
 ARCHITECT OF RECORD:
 BRR ARCHITECTURE, INC.
 815 WEST 4TH ST
 SUITE 500
 OVERLAND PARK, KS 66204
 www.brrarch.com
 TEL: 913-252-9095
 FAX: 913-252-9044

Engineer:
HENDERSON
 ENGINEERS
 5345 LENEXA DRIVE, SUITE 300
 LENEXA, KS 66241
 TEL: 913.742.5000 FAX: 913.742.5001
 WWW.HENDERSONENGINEERS.COM
 250002018
 AZ CORPORATE NO. 19470-0
 EXPIRES 6/30/2023

Project Owner:
NIKE, Inc.
 One Bowerman Drive
 Beaverton, OR 97005
 (503) 671-6453
 www.nike.com

Project Address:
NIKE CLEARANCE STORE
TUCSON SPECTRUM
 5325 S. CALLE SANTA CRUZ
 TUCSON, AZ 85714
 TEMPLATE ISSUE DATE: 11/28/2018

Fixture Package:
CLEARANCE

Stamp:
 EXPIRES ON: 06/30/2024
 PROFESSIONAL ENGINEER
 JUSTIN M. OLDER
 ARIZONA U.S.A.
 09/30/2022

Issued For:
CONSTRUCTION

Issue Date:
02/22/2022

NO.	REASON	DATE
2	BULLETIN #1	10/14/22

PROJECT MANAGER:
 MK

CHECKED BY:
 Author

DRAWN BY:
 Author

Project Number:
62301432

Sheet Title:
MECHANICAL ENLARGED PLANS

Sheet Number:
M1.1

Division 23: HEATING, VENTILATING, AND AIR CONDITIONING

1. GENERAL INSTRUCTIONS

A. GENERAL REQUIREMENTS

All requirements under Division 01 and the general and supplementary conditions of these specifications apply to this section and division. Where the requirements of the section and division exceed those of Division 01, this section and division take precedence. Become thoroughly familiar with all its contents as to requirements that affect this division, section, or both. Work required under this division includes all equipment, appliances, transmitters, sensors, and labor required to complete the entire system as required by the drawings and specifications, or reasonably inferred to be necessary to facilitate the function of each system as required by the design and the equipment specified.

The specifications and drawings for the project are complementary, and any portion of work described in them is to be provided and installed in accordance with the requirements, notify the Engineer and request clarification prior to proceeding with the work involved.

Drawings are graphic representations of the work upon which the contract is based. They show the materials and their relationship to one another, including sizes, shapes, locations, and connections. They indicate the sequence of work, the general arrangement of the systems without showing all of the detail as to elevations, offsets, control lines, and other installation requirements. Use the drawings as a guide when laying out the work and when the materials and equipment will not conform to the designated sizes, and which when installed per manufacturer's requirements, will ensure a complete, coordinated, satisfactory, and properly operating system.

B. DEFINITIONS

Division: References contained in this specification follow the numbering system defined in the Construction Specifications Institute (CSI) MasterFormat 2004 Edition. Specification Divisions 01 through 13 provided with this project may refer to the CSI MasterFormat 1995 Edition. The corresponding division references between the 2004 Edition and 1995 Edition are as follows:

2004 Edition	1995 Edition
1. Division 21 - Fire Suppression	Division 15
Division 22 - Plumbing	Division 15
3. Division 23 - HVAC	Division 15
4. Division 26 - Electrical	Division 16
6. Division 27 - Communications	Division 16
6. Division 28 - Electronic Safety and Security	Division 16

Furnish: "to supply and deliver to the project site, ready for unloading, unpacking, assembly, installation and other operations."

Install: "to perform all operations at the project site including, but not limited to, the actual unloading, unpacking, assembling, erecting, placing, anchoring, applying, working, putting in operation, finishing, curing, ducting, etc. Painting, leveling, commissioning, starting up and similar operations, and care necessary for the intended use."

Provide: "to furnish and install."

Furnished by Owner (or Owner-Furnished) or Furnished by Others: "an item furnished by the Owner or under other divisions or contracts, and installed under the requirements of this project, installation and ready for immediate use, including all items and services incidental to the work necessary for proper installation and operation. Include the installation under the warranty required by this division."

Engineer: Where referenced in this division, "Engineer" is the Engineer of Record and the Design Professional for the work under this division, and is a consultant to, and an authorized representative of the Architect, as defined in the General and/or Supplementary Conditions. When used in this division, "Engineer" means certified involvement by and additional responsibility by the Engineer and obligations to the Architect.

AHJ: The local code official inspecting authority (Authority Having Jurisdiction over the work.

NRTL: Nationally recognized testing agency, as defined and listed by OSHA in 29 CFR 1910.7 (e.g., UL, ETL, CSA, and acceptable to the AHJ over the project. Nationally recognized testing laboratories and standards that characterize the characteristics, safety, and reliability of an item are not intended to restrict the use of other NRTLs that are acceptable to the AHJ and standards that meet the specified criteria.

Substitution: Changes in products, materials, equipment, and methods of construction from those required by the Contract Documents and approved by the Engineer. Substitutions include Value Engineering proposals.

1. Substitutions for Cause: Changes proposed by Contractor that are required due to changed Project conditions, such as unavailability of product, regulatory changes, or unavailability of required warranty.
2. Substitutions for Convenience: Changes proposed by Contractor or Owner that are not required in order to meet other Project requirements but may offer advantage to Contractor or Owner.

The term "approved equal," "equivalent," or "equal" is used synonymously and shall mean "accepted by or acceptable to the Engineer or manufacturer specified." The term "approved" shall mean labeled, listed, or both, by an NRTL, and acceptable to the AHJ over this project.

C. PREBID SITE VISIT

Prior to submitting bid, visit the site of the proposed work and become fully informed as to the conditions under which the work is to be done. Failure to comply with this requirement shall not be considered sufficient justification to require or obtain extra compensation over and above the contract price.

D. MATERIAL AND WORKMANSHIP

Provide new materials, equipment, and apparatus under this contract unless otherwise stated herein, of best quality normally used for the purpose in good commercial practice, and free from defects. Install material and equipment in accordance with manufacturer's instructions. Model numbers listed in the Contract Documents or shown on the drawings are not necessarily intended to designate the required item, written descriptions of the trim given model numbers.

Pipe, pipe fittings, pipe specialties and valves shall be manufactured in plants located in the United States or certified to meet the specified ASTM and ANSI standards.

Work performed under this contract shall provide a neat and "workmanlike" appearance when completed, to the satisfaction of the Architect and Engineer. Workmanship shall be the finest possible by experienced mechanics. Installations shall comply with applicable codes and laws.

The complete installation shall function as designed and intended with respect to efficiency, capacity, noise level, etc. Abnormal noise caused by rattling equipment, piping, ducts, air devices, and squeaks in rotating components shall not be acceptable. Materials and equipment shall be of commercial specification grade in quality. Light duty residential grade equipment shall not be accepted unless otherwise indicated.

Remove from the premises waste material present as a result of work, including cartons, crating, paper, stickers, and/or excavation material used in backfilling, etc. Clean equipment installed under the contract to present a neat and clean installation at the termination of the work.

Repair or replace public and private property damaged as a result of work performed under this contract to the satisfaction of the Architect and Engineer. Provide all safety lights, guards, and warning signs required for the performance of the work and for the safety of the public.

E. MANUFACTURERS

In other articles where lists of manufacturers are introduced, subject to compliance with requirements, provide products by one of the manufacturers specified.

Where a list is provided, manufacturers are listed alphabetically and not in accordance with any ranking or preference.

Where manufacturers are not listed, provide products subject to compliance with requirements from manufacturers that have been actively involved in manufacturing the specified product for no less than 5 years.

F. COORDINATION

Coordinate work with that of other trades so that the various components of the systems are installed at the proper time, in the available space, and will allow proper service access to those items requiring maintenance. Components which are related but not shown on the drawings shall be relocated at no additional cost to the Owner.

Unless otherwise indicated, the General Contractor shall provide chase and openings in building construction required for installation of the systems specified herein. Contractor shall furnish the General Contractor with information where chase and openings are required. Contractor shall keep informed as to the work of other trades engaged in the construction of the project and shall execute work in a manner as to not interfere with or delay the work of other trades.

Figured dimensions shall be taken in preference to scale dimensions. Contractor shall take his own measurements at the building, as variations may occur. Contractor shall be held responsible for errors that have been avoided by proper checking and inspection.

Provide materials with trim that will properly fit the types of ceiling, wall, or floor finishes actually installed. Model numbers listed in the specifications or shown on the drawings are not intended to designate the required item.

G. ORDINANCES AND CODES

Work performed under this contract shall, at a minimum, be in conformance with applicable national, state and local codes having jurisdiction. Equipment furnished and associated installation work performed under this contract shall be in strict compliance with current applicable codes adopted by the local AHJ, including any amendments and standards as set forth by the following:

1. National Electrical Code (NEC)
2. National Fire Protection Association (NFPA)
3. International Labor Relations Board (ILRB)
4. Occupational Safety and Health Administration (OSHA)
5. American Society of Mechanical Engineers (ASME)
6. American Society of Heating, Refrigerating, and Air Conditioning Engineers (ASHRAE)
7. American National Standards Institute (ANSI)
8. American Society of Testing and Materials (ASTM)
9. Other national standards and codes where applicable.

Where the contract documents describe the requirements of the referenced codes, standards, etc., the contract documents shall take precedence. Where conflicts between various codes, ordinances, rules, and regulations exist, comply with the most stringent.

Promptly bring all conflicts observed between codes, ordinances, rules, regulations, referenced standards, and these documents to the attention of the Architect and Engineer for final resolution. Contractor will be held responsible for any violation of the law.

Procure and pay for permits and licenses required for the accomplishment of the work herein described. Where required, obtain, pay for, and furnish certificates of inspection to Owner.

H. PROTECTION OF EQUIPMENT AND MATERIALS

Store and protect from damage equipment and materials delivered to job site. For materials and equipment susceptible to changing weather conditions, store in frames mounted directly to the structure with upper floating section with conditioned floors. For materials and equipment not susceptible to these conditions, cover with waterproof, tear-resistant, heavy tarp or polyethylene plastic as required to protect from plaster, dust, dirt, rain, water, or physical damage. All directional easements and openings shall be minimum 14 inch thick. During the insulation or air installation, seal any tears or joints of internal fiberglass insulation. Equipment and material damaged by construction activities shall be replaced and Contractor shall furnish new equipment and material if it is not like a new one expense.

Keep premises clean and debris material created during work performed under the contract. Piping, equipment, etc. shall have a neat and clean appearance at the termination of the work. Remove debris from ceiling/return air plenum, including dust.

Plug, seal, cap open ends of ductwork and piping systems while stored and installed during construction when in use to prevent the entry of dirt and debris into the systems. Remove temporary protection prior to starting equipment and tuning the system over to the owner.

I. SUBSTITUTIONS

Materials, products, equipment, and systems described in the Bidding Documents establish a standard of required product, dimension, appearance and quality to be met by the proposed substitution. The base bid shall include only the products from manufacturers specifically named in the drawings and specifications. To request a substitution, request a written Request Form from the Architect or Engineer. Complete and send the Substitution Request Form for each material, product, equipment, or system that is proposed to be substituted. The burden of proof of the merit of the proposed substitution is upon the proposer.

Unless stated otherwise in writing to the Engineer by the Contractor, contractor warrants to the Engineer, Architect, and Owner the following:

1. Proposed substitution has been fully investigated and determined to meet or exceed the specified Work in all respects unless stated otherwise in the substitution request.
2. Proposed substitution is consistent with the Contract Documents and will produce indicated results, including functional characteristics, maintenance service, and sourcing of replacement parts.
3. Proposed substitution has been investigated and determined to be consistent with the Contract Documents.
4. Same warranty will be furnished for proposed substitution as for specified work.
5. If approved substitution fails to perform as required, Contractor shall replace substitute material or service, or both, with that originally specified and requested by the Architect or Engineer.
6. Coordination, installation facilities and changes in the Work as necessary for accepted substitution will be complete in all respects.

No substitutions will be considered unless the Substitution Request Form is completed and attached with the appropriate supporting information. No substitution will be considered until receipt of a Request Form written request for approval to bid has been received by the Engineer at least ten (10) calendar days prior to the date for receipt for bids.

If the proposed substitution is approved prior to receipt of bids, such approval will be stated in an addendum. Bidders shall be notified of any substitutions made in an addendum to the Request Form. No substitutions will be considered after the contract is awarded unless specifically provided in the contract documents.

J. SUBMITTALS

Assemble and submit for review shop drawings, material lists, manufacturer product literature for equipment to be furnished, and items requiring coordination between contractors under this contract. Provide submittals in sufficient detail to ensure compliance with the Contract Documents and to allow for review and the design concept. Prior to transmitting submittals, verify that the equipment submitted is mutually compatible and suitable for the intended use, will fit the available space, and maintain manufacturer's recommended service clearances. If the size of equipment furnished makes necessary any change in location or configuration, submit a shop drawing showing the proposed layout.

Transmit submittals as early as required to support the project schedule. Allow two to three weeks Engineer review time, plus sufficient mailing time to the Architect, plus a duplication of this time for resubmittal, if required. Only resubmit items that are specifically approved by the Engineer.

Submittals shall contain the project name, applicable specification section, submittal date, equipment identification acronym as used on the drawings, and the Contractor's stamp. The stamp shall certify that the submittal has been checked by the Contractor, complies with the drawings and specifications, and is consistent with other applicable contract documents. Submittals shall include the following information: product data, performance sheets, samples and other submittals required by this division. Highlight, mark, list, or indicate the materials, performance sheets, and accessories that are being proposed. General product catalog data not readily needed by the Architect or Engineer shall be rejected and returned without review.

Submittals and shop drawings shall not contain the firm name, logo, seal, or signature of the Engineer. They shall not be copies of work product of the Engineer. If the Contractor desires to use elements of such product, refer to paragraph "Electronic Drawing Files" procedures to be used.

Separate submittals according to individual specification sections. Illegible submittals will be rejected and returned without review. Call 24-hour details, identify, label, and label as to a 3-ring binder. Each item or model number shall be clearly marked and accessories indicated. Label the catalog data with the equipment identification acronym or number as used on the drawings and include the following information: product data, performance sheets, samples, wiring diagrams, electrical requirements and deviations from specified equipment or materials. For equipment with motor starters or VFDs, include short circuit current ratings. Mark out illegible items. Shop drawings will be returned without review if the above mentioned requirements are not met.

Provide the quantity of submittals required by Division 01. If not indicated and hard-copy sets are provided, submit a minimum of six (6) copies. Refer to Division 01 for acceptance of electronic submittals and for information regarding submittals. Provide a submittal schedule for UL listing, location, wall or floor rating and installation drawing for each penetration fire stop system.

Provide prefabricated roof curbs where pipes and/or ductwork penetrate elevated slabs or the roof or the exterior. Provide cover over curbs of weather-resistant material and seal duct or pipe penetrations through the cover. Provide pipe collar of weather-resistant material with stainless steel pipe clamps for piping penetrations.

2. GENERAL MATERIALS AND INSTALLATION

A. BUILDING OPERATION

Comply with the schedule of operations as outlined in the architectural portions of this specification. Accomplish work requiring interruption of building operation at a time when the building is not in operation and only with written approval of building Owner and/or tenant. Coordinate interruption of building operation with the Owner and/or tenant a minimum of seven (7) days in advance of work.

B. EXISTING EQUIPMENT REUSE AND REMOVAL

Remove all unused equipment, ductwork, piping, and associated supports. Cap ductwork and piping at mains and seal air and water tight.

Final items of HVAC systems modification required because of building remodeling, as noted on the drawings or necessary for proper operation. Match existing materials and construction techniques when modifying existing systems unless specified otherwise. Coordinate additional requirements with General Contractor and Architect.

C. COINCIDENTAL DAMAGE

Repair stairs, sidewalks, drives, paving, walls, finishes, and other facilities damaged in the course of the work. Repair materials shall match existing conditions. Repair work shall meet all requirements of the Owner, local authorities having jurisdiction, and meet the satisfaction of the Architect.

D. CUTTING AND PATCHING

Conform to the requirements in Division 01. Cut walls, floor ceilings, and other portions of the facility as required to install work under this division. Obtain permission from the Architect prior to cutting. Do not exceed the specified structural members without prior approval from the Architect and Structural Engineer. For post-tension slabs, pry nails and closely coordinate all core drill locations with Architect and Structural Engineer prior to any work. Obtain approval from Architect and Structural Engineer for all core drills and penetrations in concrete slabs. Obtain approval from Architect and Structural Engineer for all possible while maintaining required clearances between the building element penetrated and the application. Patch around openings to match the adjacent concrete including fire ratings, if applicable.

Repair and retinal areas disturbed by work to the condition of adjoining surfaces in a manner satisfactory to the Architect.

E. ROUGH-IN

Coordinate without delay all rough-ins with other divisions. Conceal piping, conduit, and rough-in except in unfinished areas and where otherwise shown.

F. STRUCTURAL SUPPORT SYSTEMS

Structural steel used for support of equipment, ductwork and piping shall be new, clean, and conform to ASTM Designation A-36.

Support mechanical components from the building structure. Do not support mechanical components from ceilings, other mechanical or electrical components, and other non-structural elements.

K. VIBRATION ISOLATION (CONT.)

1. Type CMB (Curb Mounted Base): Curb mounted base for roof-mounted equipment shall be a pre-engineered structural steel frame mounted directly to the structure with an upper floating section with adjustable steel springs. The upper frame shall provide continuous support for the equipment. Steel springs shall rest on minimum 1/4 inch thick elastomeric pads and have a minimum static deflection of 2 inches. Paint, water, or physical damage shall be repaired and replaced. All directional easements and openings shall be minimum 14 inch thick. All hardware shall be cadmium or zinc electroplated to provide a rust resistant finish. Provide continuous galvanized flexible ductwork installed on the roof, coordinate with pre-engineered roof equipment support structure to determine the quantity and size of hold-down brackets, isolators, and fasteners, with installation instructions, for each equipment to meet the design requirements specified under Article "PRE-ENGINEERED ROOF EQUIPMENT SUPPORTS AND CURBS".

2. Type NR (Necropne Bushing): Provide necropne, rubber-in-shear bushings for lightweight (less than 100 pounds), suspended equipment supported from structure with threaded rod angle iron or U-bolts. Select for a maximum diameter of 50 mm or designed for 15 percent strain, with a static deflection of 0.15 inches. Provide Mason Industries Type HMB6 or equal.

L. AIR FILTERS

Provide AP-13 rated, pleated, throwaway type filters, minimum MERV 13, or similar as manufactured by Air Filter, Inc., American Air Filter, Flanders, or approved equal, unless otherwise indicated.


Temporary filters used to protect personnel in ductwork and inside equipment when permanent HVAC equipment is used during the construction period shall be pleated, throwaway type filters, minimum MERV 6.

M. REFRIGERANT AND OIL

Provide full refrigerant and oil charge in new air conditioning refrigeration systems, and maintain it for full term of the guarantee.

N. IDENTIFICATION

Provide stenciled signs for equipment identification at Contractor's option or where distance of required identification requires lettering greater than 1 inch height. Stencil panel shall be exterior type, oil-based, alkali enamel, minimum 1/4 inch letter or larger as required for long distance identification

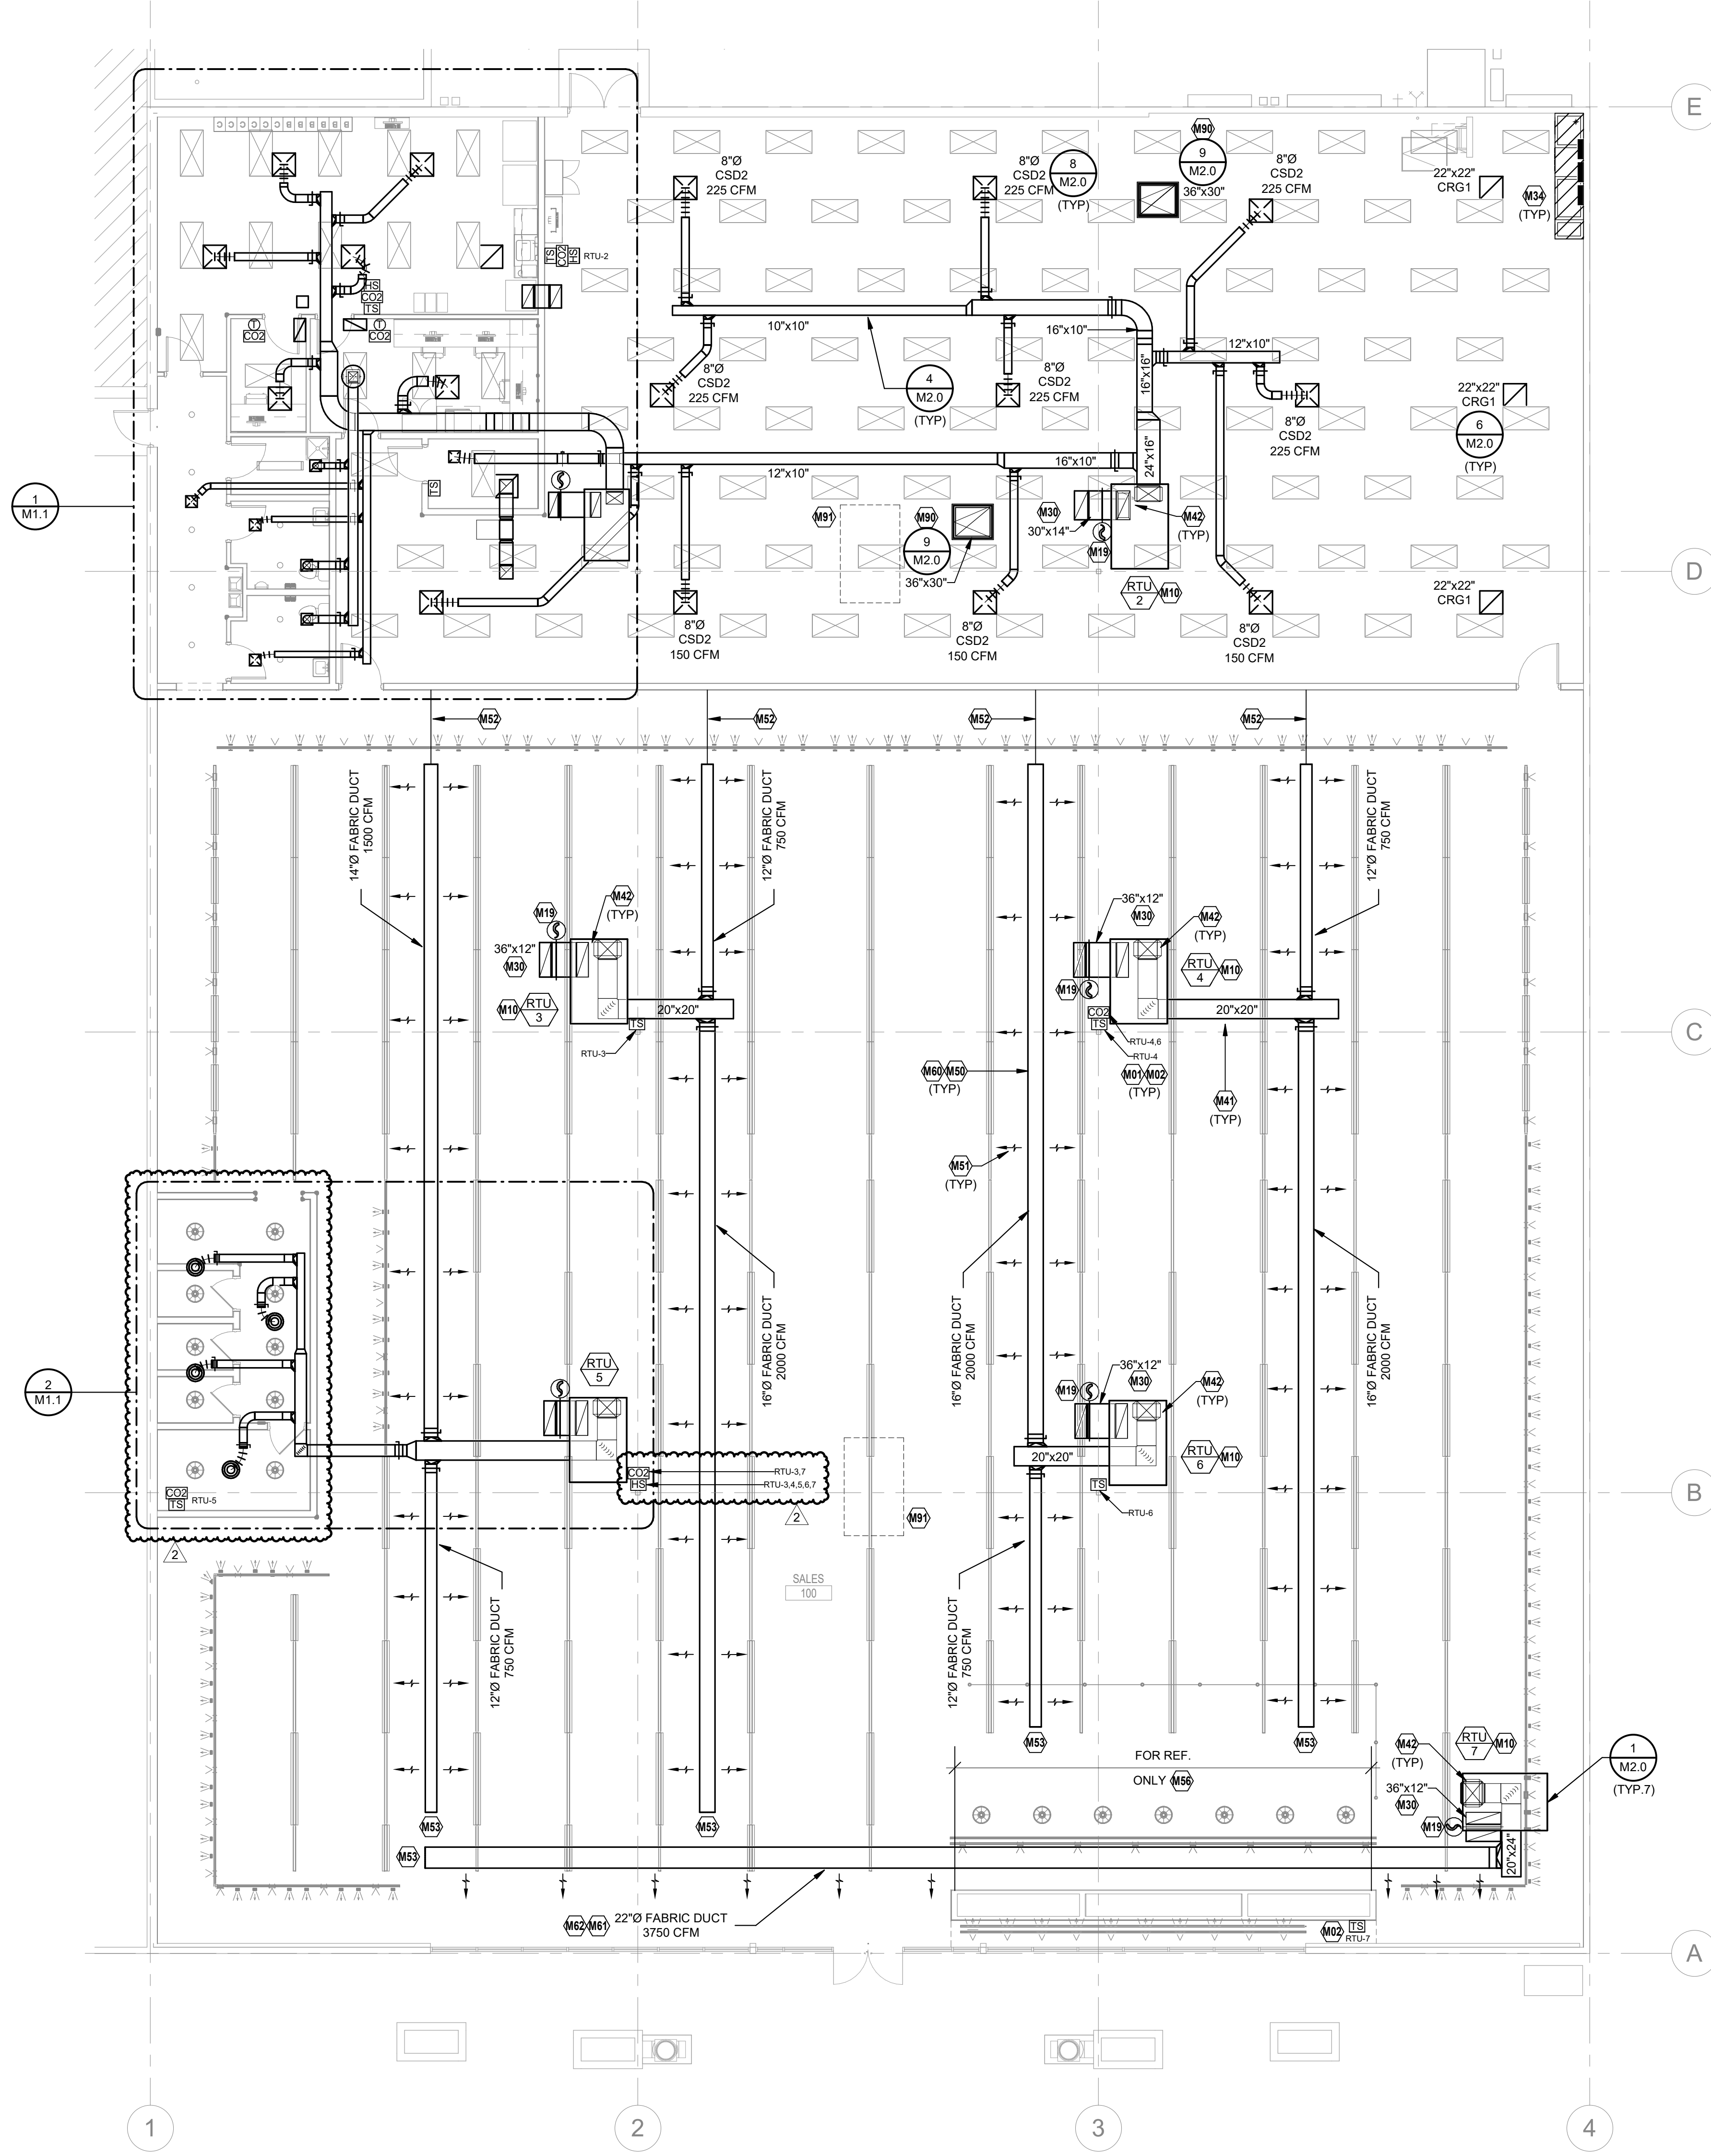

1 HVAC PLAN
1/8" = 1'-0"

KEYNOTES ARE PROTOTYPICAL. MISSING KEYNOTE NUMBERS INDICATE A PROTOTYPICAL NOTE IS NOT USED OR REMOVED.

MECHANICAL PLAN NOTES

- M01 ALL THERMOSTATS AND SENSORS ARE FURNISHED BY EMS VENDOR AND INSTALLED BY DIVISION 26, UNLESS NOTED OTHERWISE.
- M02 DO NOT INSTALL SENSORS ON WALL GRAPHICS. CONFIRM LOCATIONS OF SENSORS WITH PM PRIOR TO INSTALLATION.
- M10 PROVIDE NEW ROOF TOP UNIT AS SCHEDULED WITH NEW CURB ADAPTER FROM EXISTING CURB. PROVIDE A NEW SET OF MERV 13 AIR FILTERS IN UNIT BEFORE TURNING SYSTEM OVER TO OWNER. COORDINATE CONDENSATE PIPING WITH DIVISION 25.
- M19 SMOKE DETECTORS AND WIRING IN RETURN AIR DUCTS SHALL BE PROVIDED BY DIVISION 28 CONTRACTOR. SMOKE DETECTORS SHALL SHUT-DOWN UNIT UPON ALARM.
- M30 ROUTE SHEET METAL RETURN AIR DUCT AS SHOWN WITH TERMINATION DIRECTED UPWARD. SIZE PLENUM FULL SIZE OF RETURN AIR INLET. PROVIDE DUCT LINER IN RETURN AIR DUCTWORK FOR SOUND ATTENUATION. COVER INLET WITH 1/2"x1/2" BIRD SCREEN.
- M34 DO NOT ROUTE DUCTWORK OVER ELECTRICAL EQUIPMENT. NOTIFY ENGINEER OF CONFLICTS IN FIELD.
- M41 COORDINATE DUCT ROUTING WITH LIGHTS AND STRUCTURE. ROUTE ALL SALES DUCTWORK AT SAME ELEVATION BELOW STRUCTURE AND ABOVE LIGHTING.
- M42 ROUTE SUPPLY AND RETURN DUCTWORK TO ROOF CURB DUCT CONNECTIONS AND TRANSITION DUCTWORK IN RISER AS NECESSARY.
- M50 INSTALL FABRIC DUCT ABOVE ARCHITECTURAL LIGHTING GRID. REFER TO BOXED NOTES FOR ADDITIONAL INFORMATION.
- M51 ARROWS INDICATE DIRECTION AND DISPERSION OF AIRFLOW VOLUME. PROVIDE VENTS ON FABRIC DUCT TO DIRECT AIRFLOW AS SHOWN ON PLAN.
- M52 EXTEND AND TIGHTEN HANGING CABLE TO WALL. GENERAL CONTRACTOR TO PROVIDE 2X WOOD BACKING. COORDINATE REQUIREMENTS WITH FABRIC DUCT MANUFACTURER.
- M53 FIELD FABRICATE L-BRACKET FOR SUPPORTING END OF FABRIC DUCT. COORDINATE REQUIREMENTS WITH FABRIC DUCT MANUFACTURER.
- M56 DO NOT INSTALL AIR VENTS ON FABRIC DUCT ADJACENT TO BACKWALL. WALL DIMENSION SHOWN FOR REFERENCE ONLY.
- M60 PROVIDE FABRIC DUCT WITH AIRFLOW PERFORATIONS AT AN ANGLE OF 22.5° FROM HORIZONTAL TOWARDS THE SALES FLOOR.
- M61 SUPPORT FABRIC DUCTWORK WITH MANUFACTURER'S DOUBLE-CABLE CROSS BRACING SUPPORTS. COORDINATE REQUIREMENTS WITH FABRIC DUCT MANUFACTURER.
- M62 PROVIDE FABRIC DUCT WITH AIRFLOW PERFORATIONS AT AN ANGLE OF 45° FROM HORIZONTAL TOWARDS THE SALES FLOOR POINTED TOWARD GLAZING.
- M90 SMOKE/HEAT VENT IS PROVIDED BY DIVISION 21. DO NOT INSTALL DUCTWORK, PIPING, SUPPORTS, OR EQUIPMENT BELOW VENT LOCATION. COORDINATE EXACT LOCATION PRIOR TO CONSTRUCTION.
- M91 DASHED LINE REPRESENTS LOCATION OF EXISTING ROOF TOP UNIT TO BE DEMOLISHED. UNIT ROOF CURB SHALL BE COMPLETELY CARPED AND SEALED. REFER TO ARCHITECTURAL DETAILS FOR ADDITIONAL INFORMATION.

INSTALL DUCTWORK AND PIPING AS TIGHT TO STRUCTURE AS POSSIBLE. COORDINATE WITH OTHER TRADES TO AVOID CONFLICTS. COORDINATE INSTALLATION OF DUCTWORK AND PIPING TO AVOID CONFLICTS WITH ELECTRICAL PANELS, LIGHTING FIXTURES, ETC. DO NOT INSTALL DUCTWORK BELOW THE BOTTOM OF THE LIGHT FIXTURES.

FABRIC DUCT GENERAL NOTES:
 PROVIDE FABRIC DUCT THROUGHOUT THE SPACE AS SHOWN ON PLAN. FABRIC DUCT SHALL NOT REPLACE RECTANGULAR DUCT DROPS OR EXHAUST DUCTS. BASIS OF DESIGN SHALL BE "PRIHODA," NM1 NONPOROUS FABRIC WITH "PERFORATIONS" (AIR OPENINGS) WITH ADJUSTABLE FLOW DEVICES (I.E. AFD'S) AT OPENINGS, AND ONE ROW, GALVANIZED CABLE. INTERNAL HOOP SUPPORT SYSTEM SHALL BE PROVIDED ON ALL FABRIC DUCT UNLESS NOTED OTHERWISE. INCLUDE ALL COMPONENTS AND ACCESSORIES REQUIRED TO MAKE A COMPLETE SYSTEM AS RECOMMENDED BY PRIHODA DURING BID PHASE, INCLUDING HANGING STRAPS AND CLIPS, END-CAPS, CONNECTIONS TO METAL DUCTS, ETC. PRIHODA FABRIC DUCT SHALL BE SIZED PER FACTORY RECOMMENDATIONS TO PROVIDE MINIMUM AIRFLOWS IN BRANCH DUCTS AS SHOWN. CONFIRM FABRIC DUCT COLOR WITH ARCHITECT PRIOR TO ORDERING ON ALL PROJECTS. (FOR GLOBAL 3.0 FIXTURE PACKAGE, PANTONE 420 - LIGHT GREY IS BASIS OF DESIGN). CONTACT PRIHODA SALES DEPARTMENT (E-MAIL: SALES@PRIHODA-NA.COM, PHONE: 1-855-774-4832) FOR PRICING INFORMATION.

FABRIC DUCT DESIGN GUIDELINE:
 DISTRIBUTE AIRFLOW EVENLY ALONG FABRIC DUCT IN THE DIRECTION OF FLOW ARROWS. ORIENT AND SIZE FABRIC DUCT DIFFUSER OPENINGS TO PROVIDE A 50 FPM THROW VELOCITY HALF WAY TO THE NEAREST ADJACENT FABRIC DUCT OR TO THE NEAREST PARTITION/DEMISING WALL AS APPLICABLE. VENTS ON FABRIC DUCT SHALL BE LOCATED AT 22.5 DEGREES BELOW HORIZONTAL UNLESS NOTED OTHERWISE.

FABRIC DUCT COORDINATION NOTE:
 DURING THE FIRST WEEK OF THE PROJECT, THE GENERAL CONTRACTOR'S SUPERINTENDENT, MECHANICAL SUB-CONTRACTOR, AND A REPRESENTATIVE FROM "PRIHODA" SHALL MEET AT THE PROJECT SITE FOR CONFIRMATION OF ALL FIELD DIMENSIONS AND POTENTIAL OBSTRUCTIONS. THIS EVENT MUST PRECEDE THE ORDERING OF ANY MATERIALS FROM "PRIHODA." CHANGE ORDERS AND EXPEDITED FEES WILL NOT BE APPROVED DUE TO LACK OF ON-SITE COLLABORATION AND/OR MEASUREMENT DURING SITE MEETING AT PROJECT COMMENCEMENT.

FABRIC DUCT INSTALLATION NOTE:
 INSTALL FABRIC DUCT ABOVE ARCHITECTURAL LIGHTING SYSTEM. COORDINATE FABRIC DUCT INSTALLATION WITH GENERAL CONTRACTOR AND DIVISION 26. GENERAL CONTRACTOR SHALL VERIFY FABRIC DUCT IS INSTALLED SUCH THAT IT DOES NOT CLASH WITH ARCHITECTURAL LIGHTING SYSTEM. FABRIC DUCT SHALL BE INSTALLED ABOVE ARCHITECTURAL LIGHTING SYSTEM GRID AND SUSPENSION CABLES, OR ANY OTHER SUSPENDED FIXTURES WHEN DEFLATED.

THE DUCTWORK LAYOUT INDICATED ON THE DRAWINGS IS SCHEMATIC AND SHOWS DESIGNED INTENT ONLY. PRIOR TO FABRICATION AND INSTALLATION OF DUCTWORK, DIVISION 23 SHALL HAVE A QUALIFIED, EXPERIENCED SKETCHER PREPARE AND SUBMIT SHEET METAL SHOP DRAWINGS. SHOP DRAWINGS SHALL TAKE INTO ACCOUNT ALL EXISTING CONDITIONS, INCLUDING BUT NOT LIMITED TO, STRUCTURAL MEMBERS, CONDUITS AND PIPING TO REMAIN. SHOP DRAWINGS SHALL ALSO TAKE INTO ACCOUNT ALL NEW DESIGN CONDITIONS, INCLUDING BUT NOT LIMITED TO, STRUCTURAL MEMBERS, PIPING, CEILINGS, SOFFIT HEIGHTS, AND LIGHT FIXTURES.

SHOP DRAWINGS SHALL INDICATE ALL REVISIONS TO THE LAYOUT REQUIRED TO ACCOMMODATE THE EXISTING CONDITIONS AND/OR MAINTAIN THE CEILING HEIGHTS AND CLEARANCES REQUIRED. NOTIFY THE ARCHITECT AND ENGINEER OF ANY LOCATION WHERE THE DESIGN INTENT CANNOT BE MET PRIOR TO FABRICATION AND INSTALLATION OF DUCTWORK. REVISIONS TO DUCTWORK, EQUIPMENT, CONDUIT AND/OR PIPING REQUIRED BY CONTRACTOR'S FAILURE TO SUBMIT PROPERLY PREPARED SHOP DRAWINGS SHALL BE THE RESPONSIBILITY OF DIVISION 23 AT NO ADDITIONAL COST TO THE CLIENT OR DELAY TO THE PROJECT SCHEDULE.

GENERAL CONTRACTOR IS RESPONSIBLE FOR PROVIDING TO ARCHITECT, ENGINEER, LANDLORD, AND BUILDING OFFICIALS/INSPECTOR A FINAL TEST AND BALANCE REPORT PER THE SPECIFICATIONS. PROVIDE TEST AND BALANCE REPORT TO ARCHITECT, ENGINEER, AND LANDLORD PRIOR TO THE FINAL BUILDING INSPECTION.

LANDLORD REQUIREMENTS:
 LANDLORD APPROVED ROOFING CONTRACTOR SHALL BE RESPONSIBLE FOR MAKING ALL CUTS THROUGH THE EXISTING ROOF, MODIFYING EXISTING OPENINGS, AND/OR ALTERING CURB FLASHING AT GENERAL CONTRACTOR'S EXPENSE. COORDINATE WITH GENERAL CONTRACTOR.

EMS CONTROLS:
 CONTRACTORS ARE RESPONSIBLE FOR COORDINATING ALL EQUIPMENT CONTROLS WITH EMS VENDOR PRIOR TO PURCHASE AND INSTALLATION. CONTRACTORS SHALL COORDINATE WITH EMS VENDOR TO PROVIDE ALL NECESSARY EQUIPMENT AND ACCESSORIES FOR A FULLY FUNCTIONING SYSTEM.

TEMPERATURE CONTROLS:
 EMS VENDOR SHALL FURNISH SENSORS AND CONTROL COMPONENTS AS INDICATED ON PLANS AND AS NECESSARY TO ACCOMPLISH THE INTENT OF THE DRAWINGS. ALL CONTROLS SHALL BE TIED INTO THE EMS SYSTEM UNLESS NOTED OTHERWISE.

GENERAL CONTRACTOR SHALL INSTALL CARRIER FURNISHED TEMPORARY THERMOSTATS AND FEED THE WIRING DOWN INTO THE SPACE FOR START UP AND CONTROL OF RTU(S) UNTIL THE EMS SYSTEM IS OPERABLE. REFER TO M3.0 FOR CARRIER CONTACT INFORMATION.

PROVIDE RFID DUCTWORK MESH OVER TRANSFER GRILLS BELOW 15'-0" AFF BETWEEN THE STOCKROOM AND THE SALES FLOOR, IF APPLICABLE. COORDINATE REQUIREMENTS WITH CONSTRUCTION PROJECT MANAGER.

Architect:
brr
 ARCHITECT OF RECORD:
 BRR ARCHITECTURE, INC.
 815 WEST 44TH AVENUE
 SUITE 500
 OVERLAND PARK, KS 66204
 www.brrarch.com
 TEL 913-253-9095
 FAX 913-253-9044
COPYRIGHT NOTICE
 This drawing was prepared for use on a specific site contemporaneously with the issue date and it is not suitable for use on a different project. No part of this drawing may be reproduced, stored in a retrieval system, or transmitted in any form or by any means, electronic, mechanical, photocopying, recording, or by any information storage and retrieval system, without the prior written permission of the architect and engineer. Reproduction of this drawing for reuse on another project is not authorized and may be subject to legal action.

Engineer:
HENDERSON
 ENGINEERS
 8345 LENEXA DRIVE, SUITE 300
 LENEXA, KS 66214
 TEL 913.742.5000 FAX 913.742.5001
 www.hendersonengineers.com
 PLS020219
 AZ CORPORATE NO. 19470-0
 EXPIRES 6/30/2023

Project Owner:
NIKE, Inc.
 One Bowerman Drive
 Beaverton, OR 97005
 (503) 671-6463
 www.nike.com

Project Address:
NIKE CLEARANCE STORE
TUCSON SPECTRUM
 5325 S. CALLE SANTA CRUZ
 TUCSON, AZ 85714
 TEMPLATE ISSUE DATE: 11/28/2018

EXPIRES ON: 06/30/2024

 09/30/2022

Issued For:
CONSTRUCTION

Issue Date:
02/22/2022

NO.	REASON	DATE
2	BULLETIN #1	10/14/22

PROJECT MANAGER:
 SAC

CHECKED BY:
 Author

DRAWN BY:
 Author

Project Number:
62301432

Sheet Title:
MECHANICAL PLAN

Sheet Number:
M1.0

